
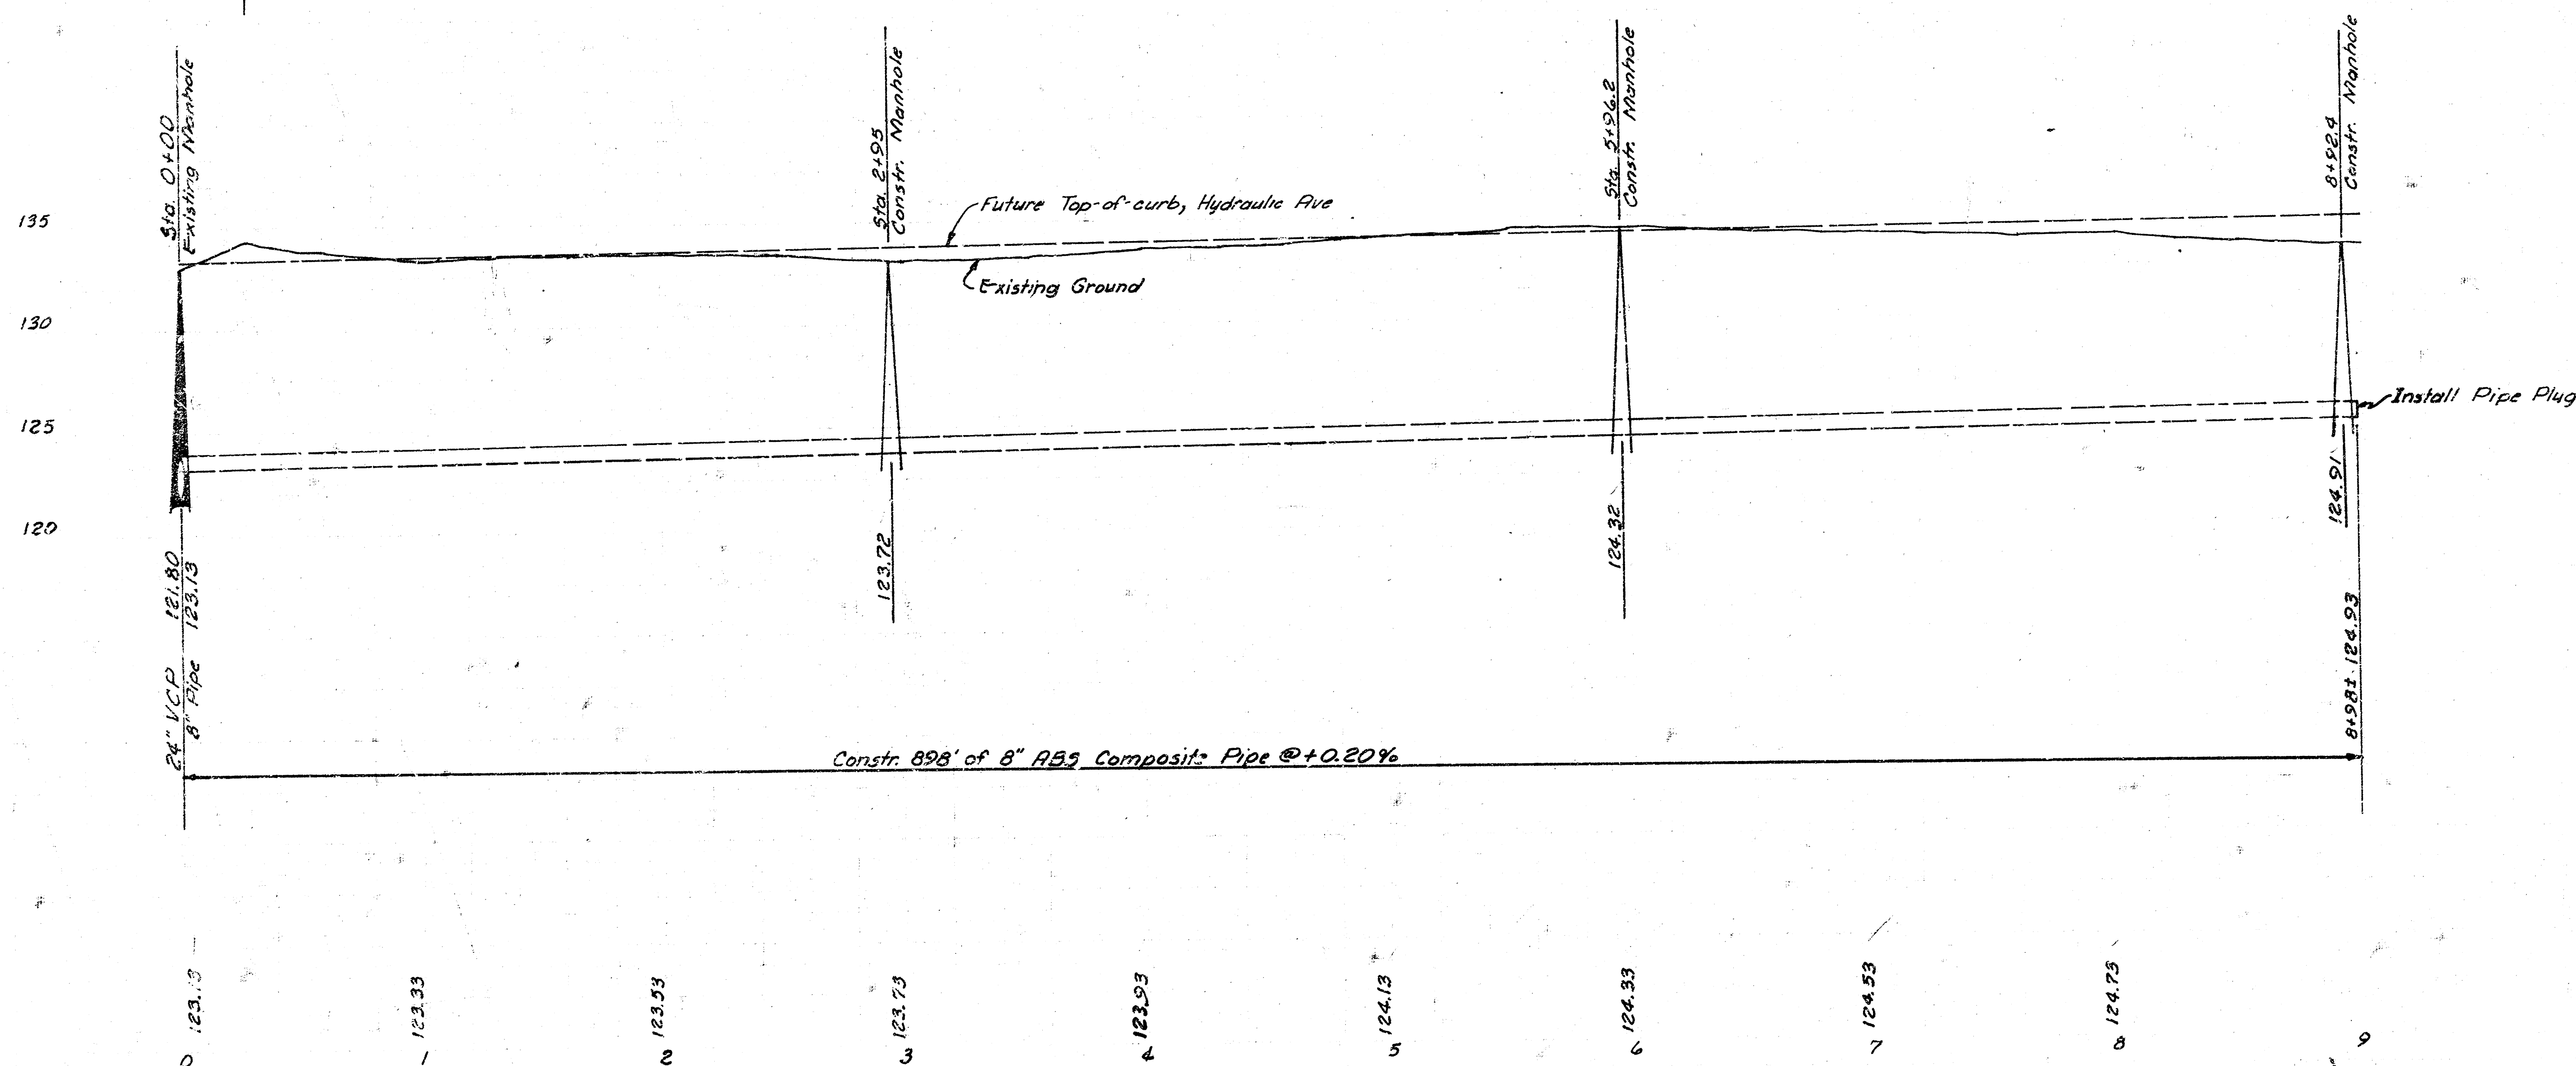


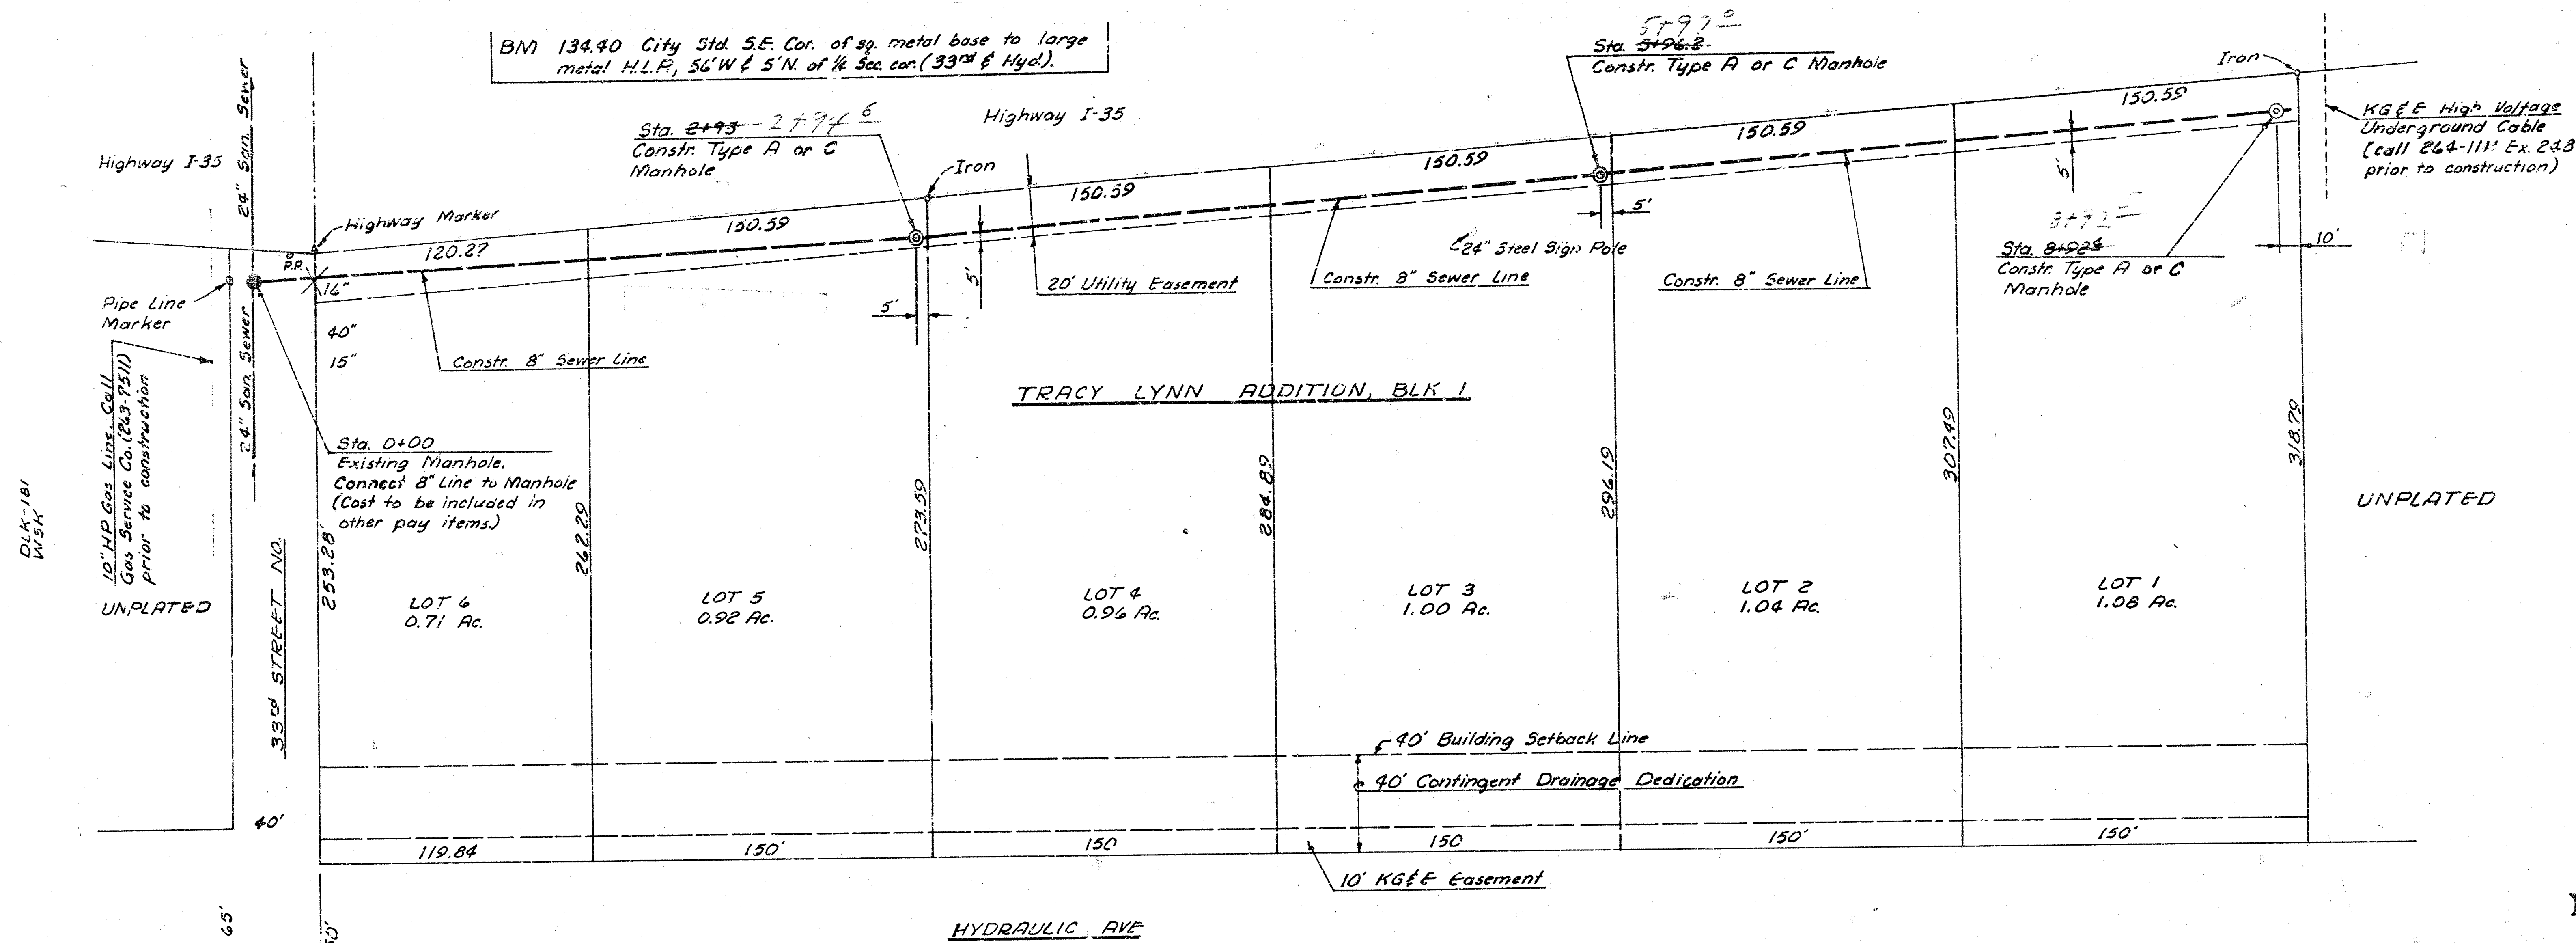

As built 1-4-77

LAT. 82, MAIN 4, S 5 #23
CITY OF WICHITA
 R. W. LINN, CITY ENGINEER
 DATE: Nov 1976
 Project No. DBKL 574051
 Sheet 1 of 1