


CITY OF WICHITA
DEPARTMENT OF PUBLIC WORKS

Lateral 102, Main 4, S.S. #23

PROJECT NO. 468-76-245-80928-000-000-001

ACTING CITY ENGINEER - DEAN SELLERS

NOTE: CONTRACTOR'S CONSTRUCTION OPERATIONS SHALL BE SUCH THAT WILL PROVIDE VEHICULAR ACCESS DURING BUSINESS HOURS TO PARKING LOT FOR INSTO-IMPALA INC. AT 1106 E. 37TH STREET NORTH. FIELD ENGINEER SHALL VERIFY THAT PLAN ELEVATION FLOW OUT OF MANHOLE AT STATION 252 + 27.69 ON THE NORTH SIDE OF 37TH STREET NORTH AND WEST OF OHG IS SUCH THAT WILL INTERCEPT FLOW FROM EXISTING 6 INCH LINE SERVING INSTO-IMPALA INC.

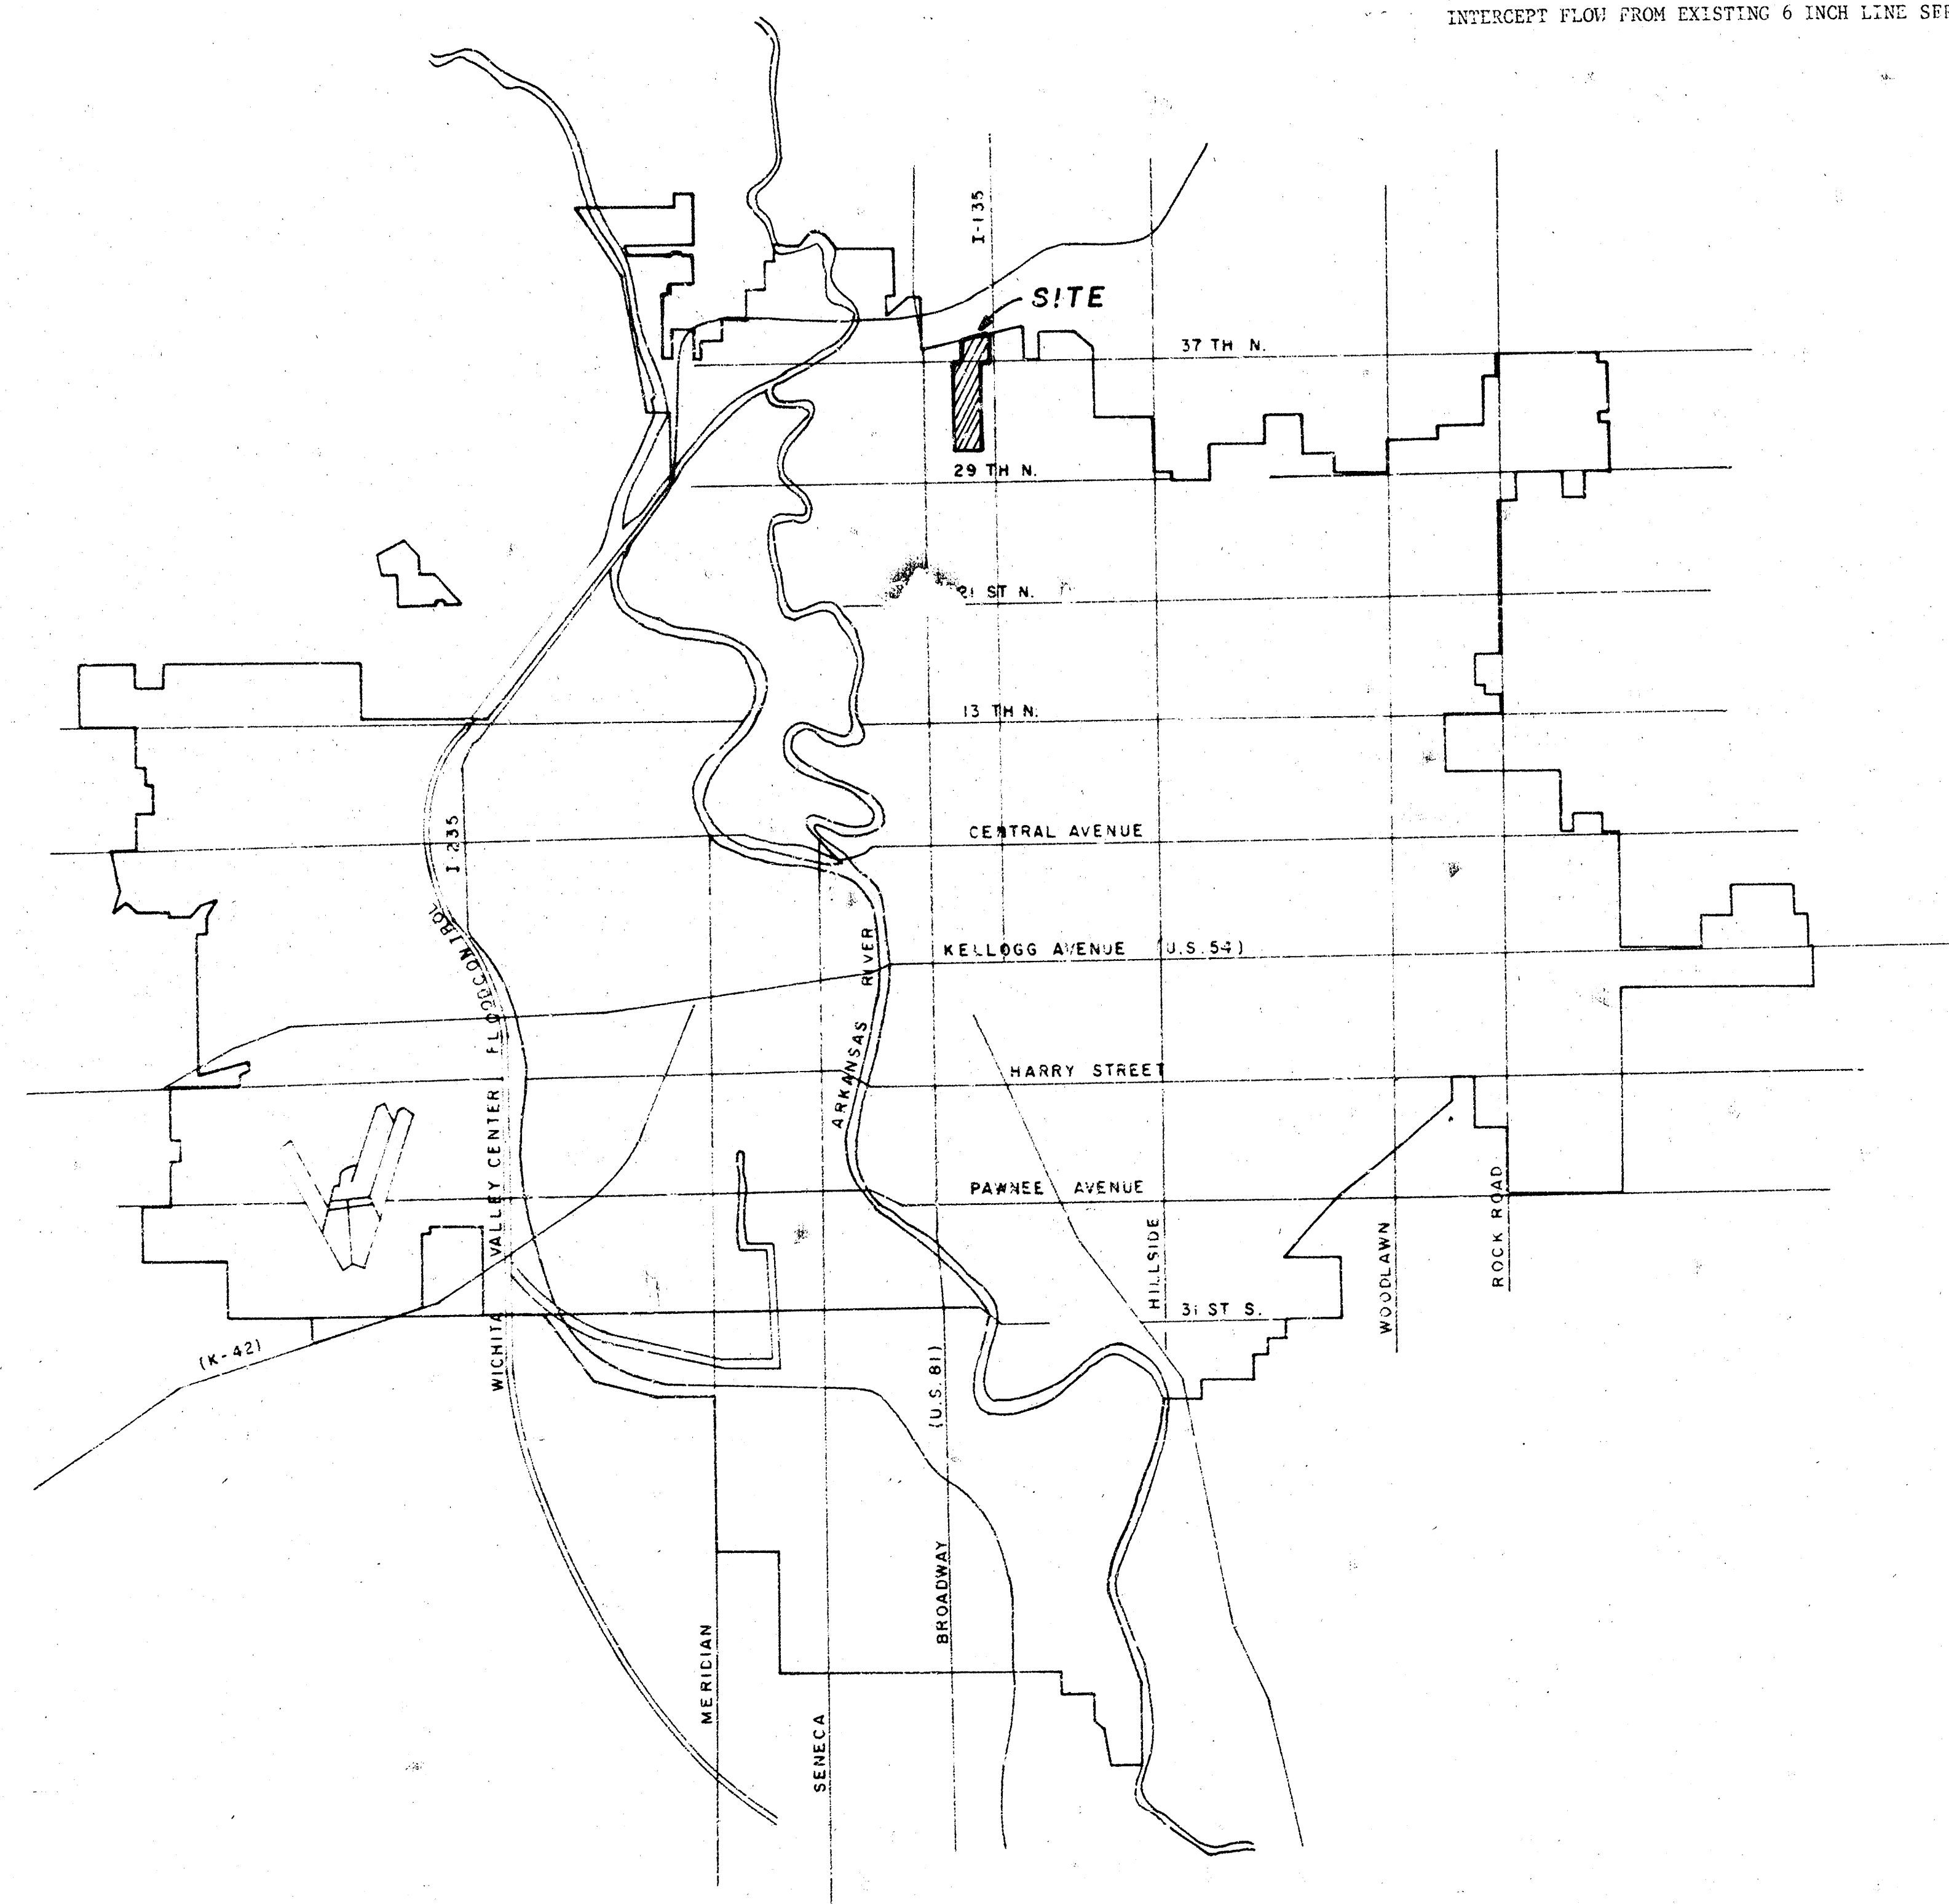


INDEX

1. Title Sheet
2. Layout Map
3. Line BP 3 Sta. 122+93.11 to Sta. 136+67.90
4. Line BP 3 Sta. 136+67.90 to Sta. 149+55.69
5. Line BP 3 Sta. 149+55.69 to Sta. 154+88.55
6. Line BP 2
7. Location Map-8" Sewer Abandonment
8. Standard Details
9. Standard Details
10. Standard Details


As Built
3-81
JOC



POE & ASSOCIATES OF KANSAS, INC.
CONSULTING ENGINEERS

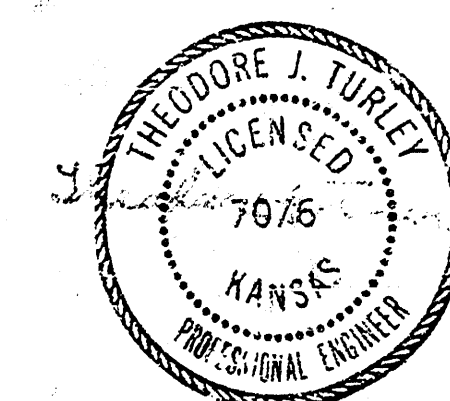


Water 1/2 in 3
18' 7" of E
12"

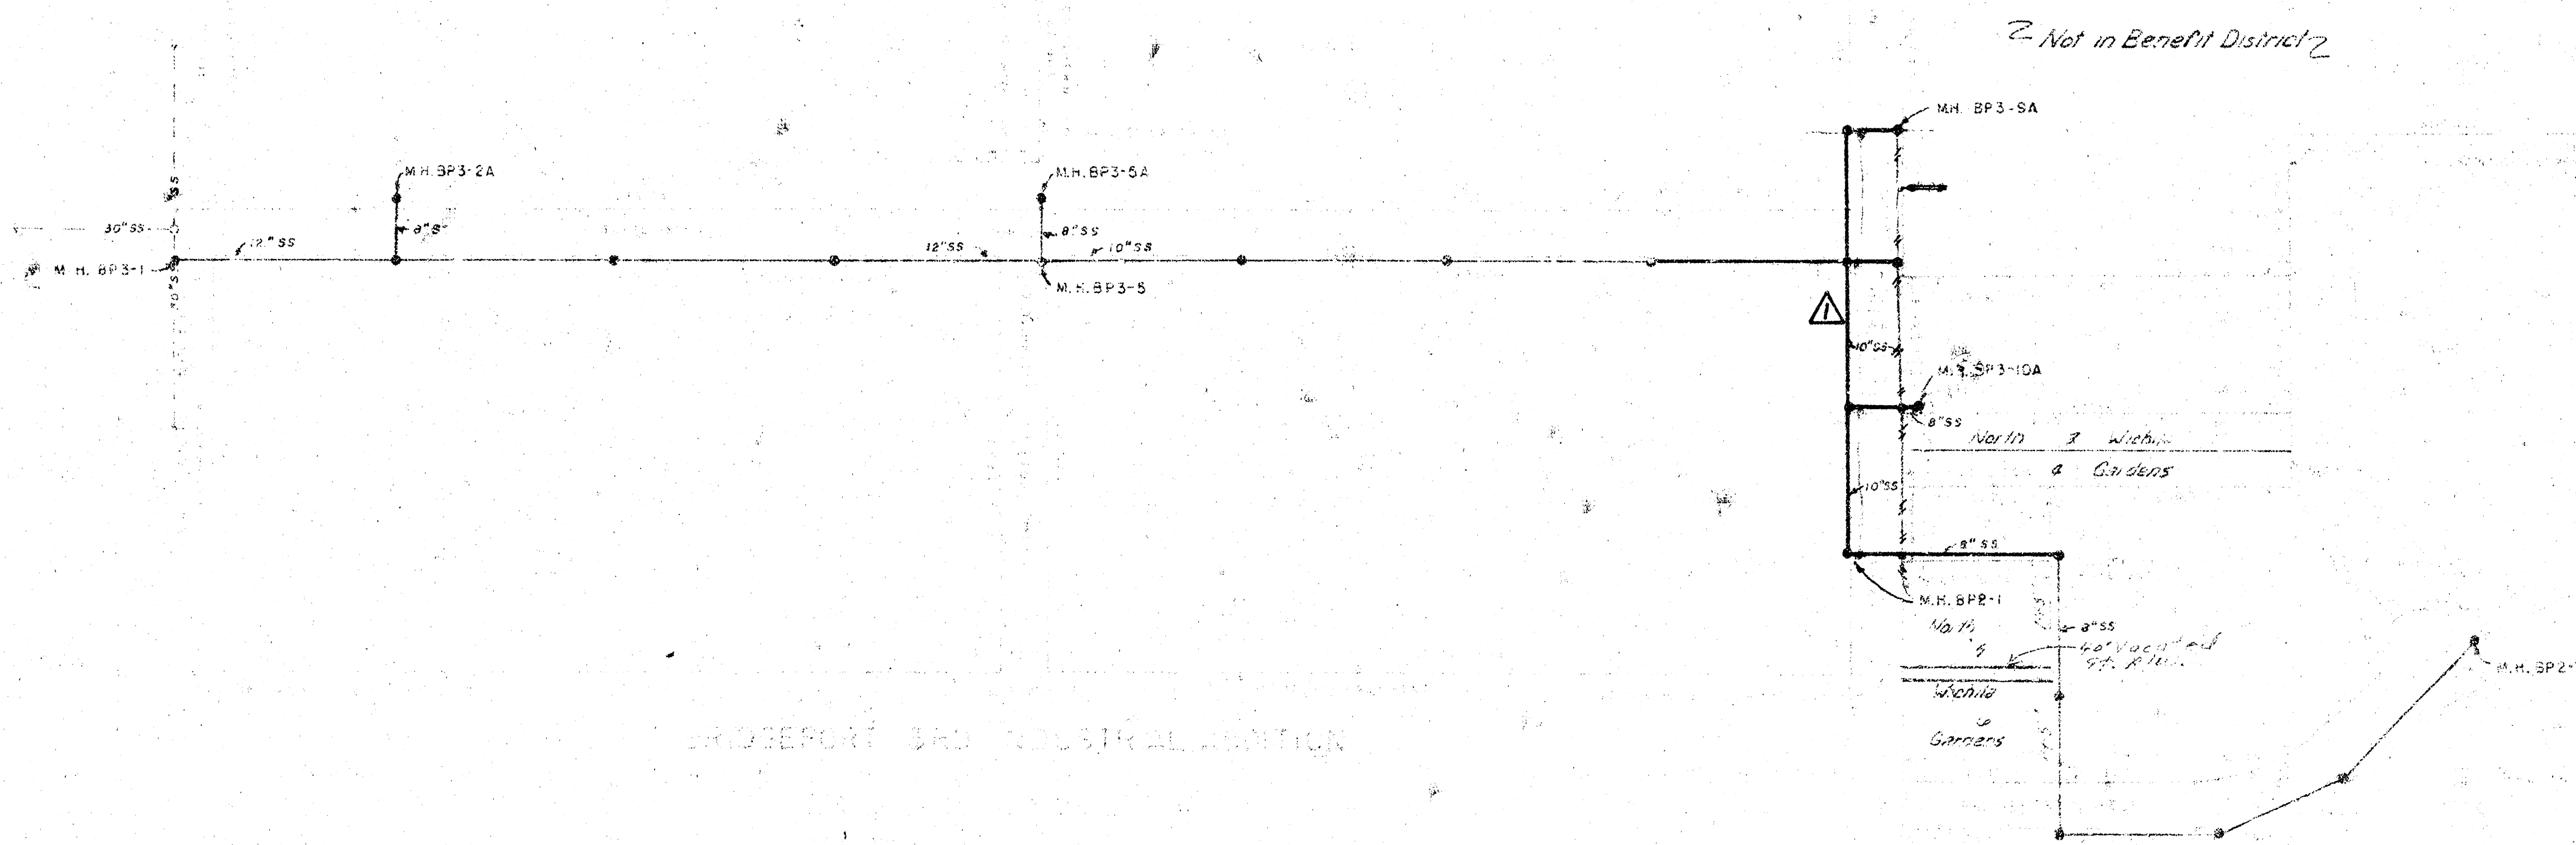

ROOSEVELT SANITARIUM LOCATION

ROOSEVELT SANITARIUM, PARK 2

NO.	Revised Alignment	JP	JMT	9-19-80
	REVISION	BY	APP.	DATE

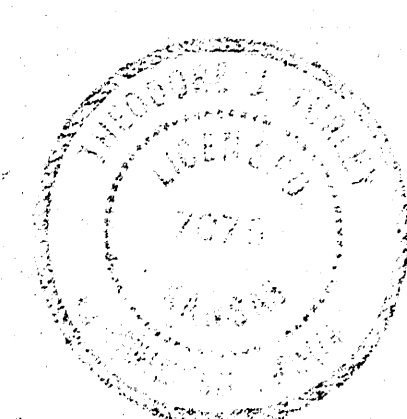



CITY OF WICHITA
Dept. Public Works

LAYOUT V&P

11

PLAN	SURVEYED _____		BY _____	DATE _____
	PLOTTED _____			
NOTE BOOK NO. _____	ALIGNMENT CHECKED _____		BY _____	DATE _____
	RT. OF WAY CHECKED _____			

PROFILE SURVIVED. PLOTTED GRADES CHECKED. NOTE BOOK B. M. NOTED. NO. _____ STRUCTURE NOTATIONS CHK'D	BY _____ DATE _____
---	------------------------

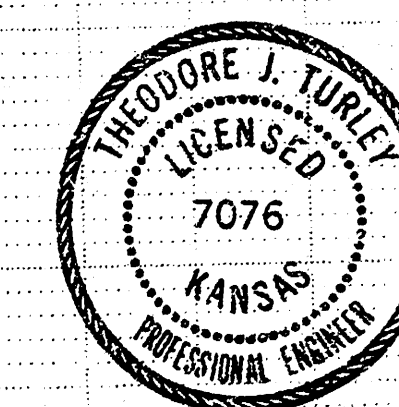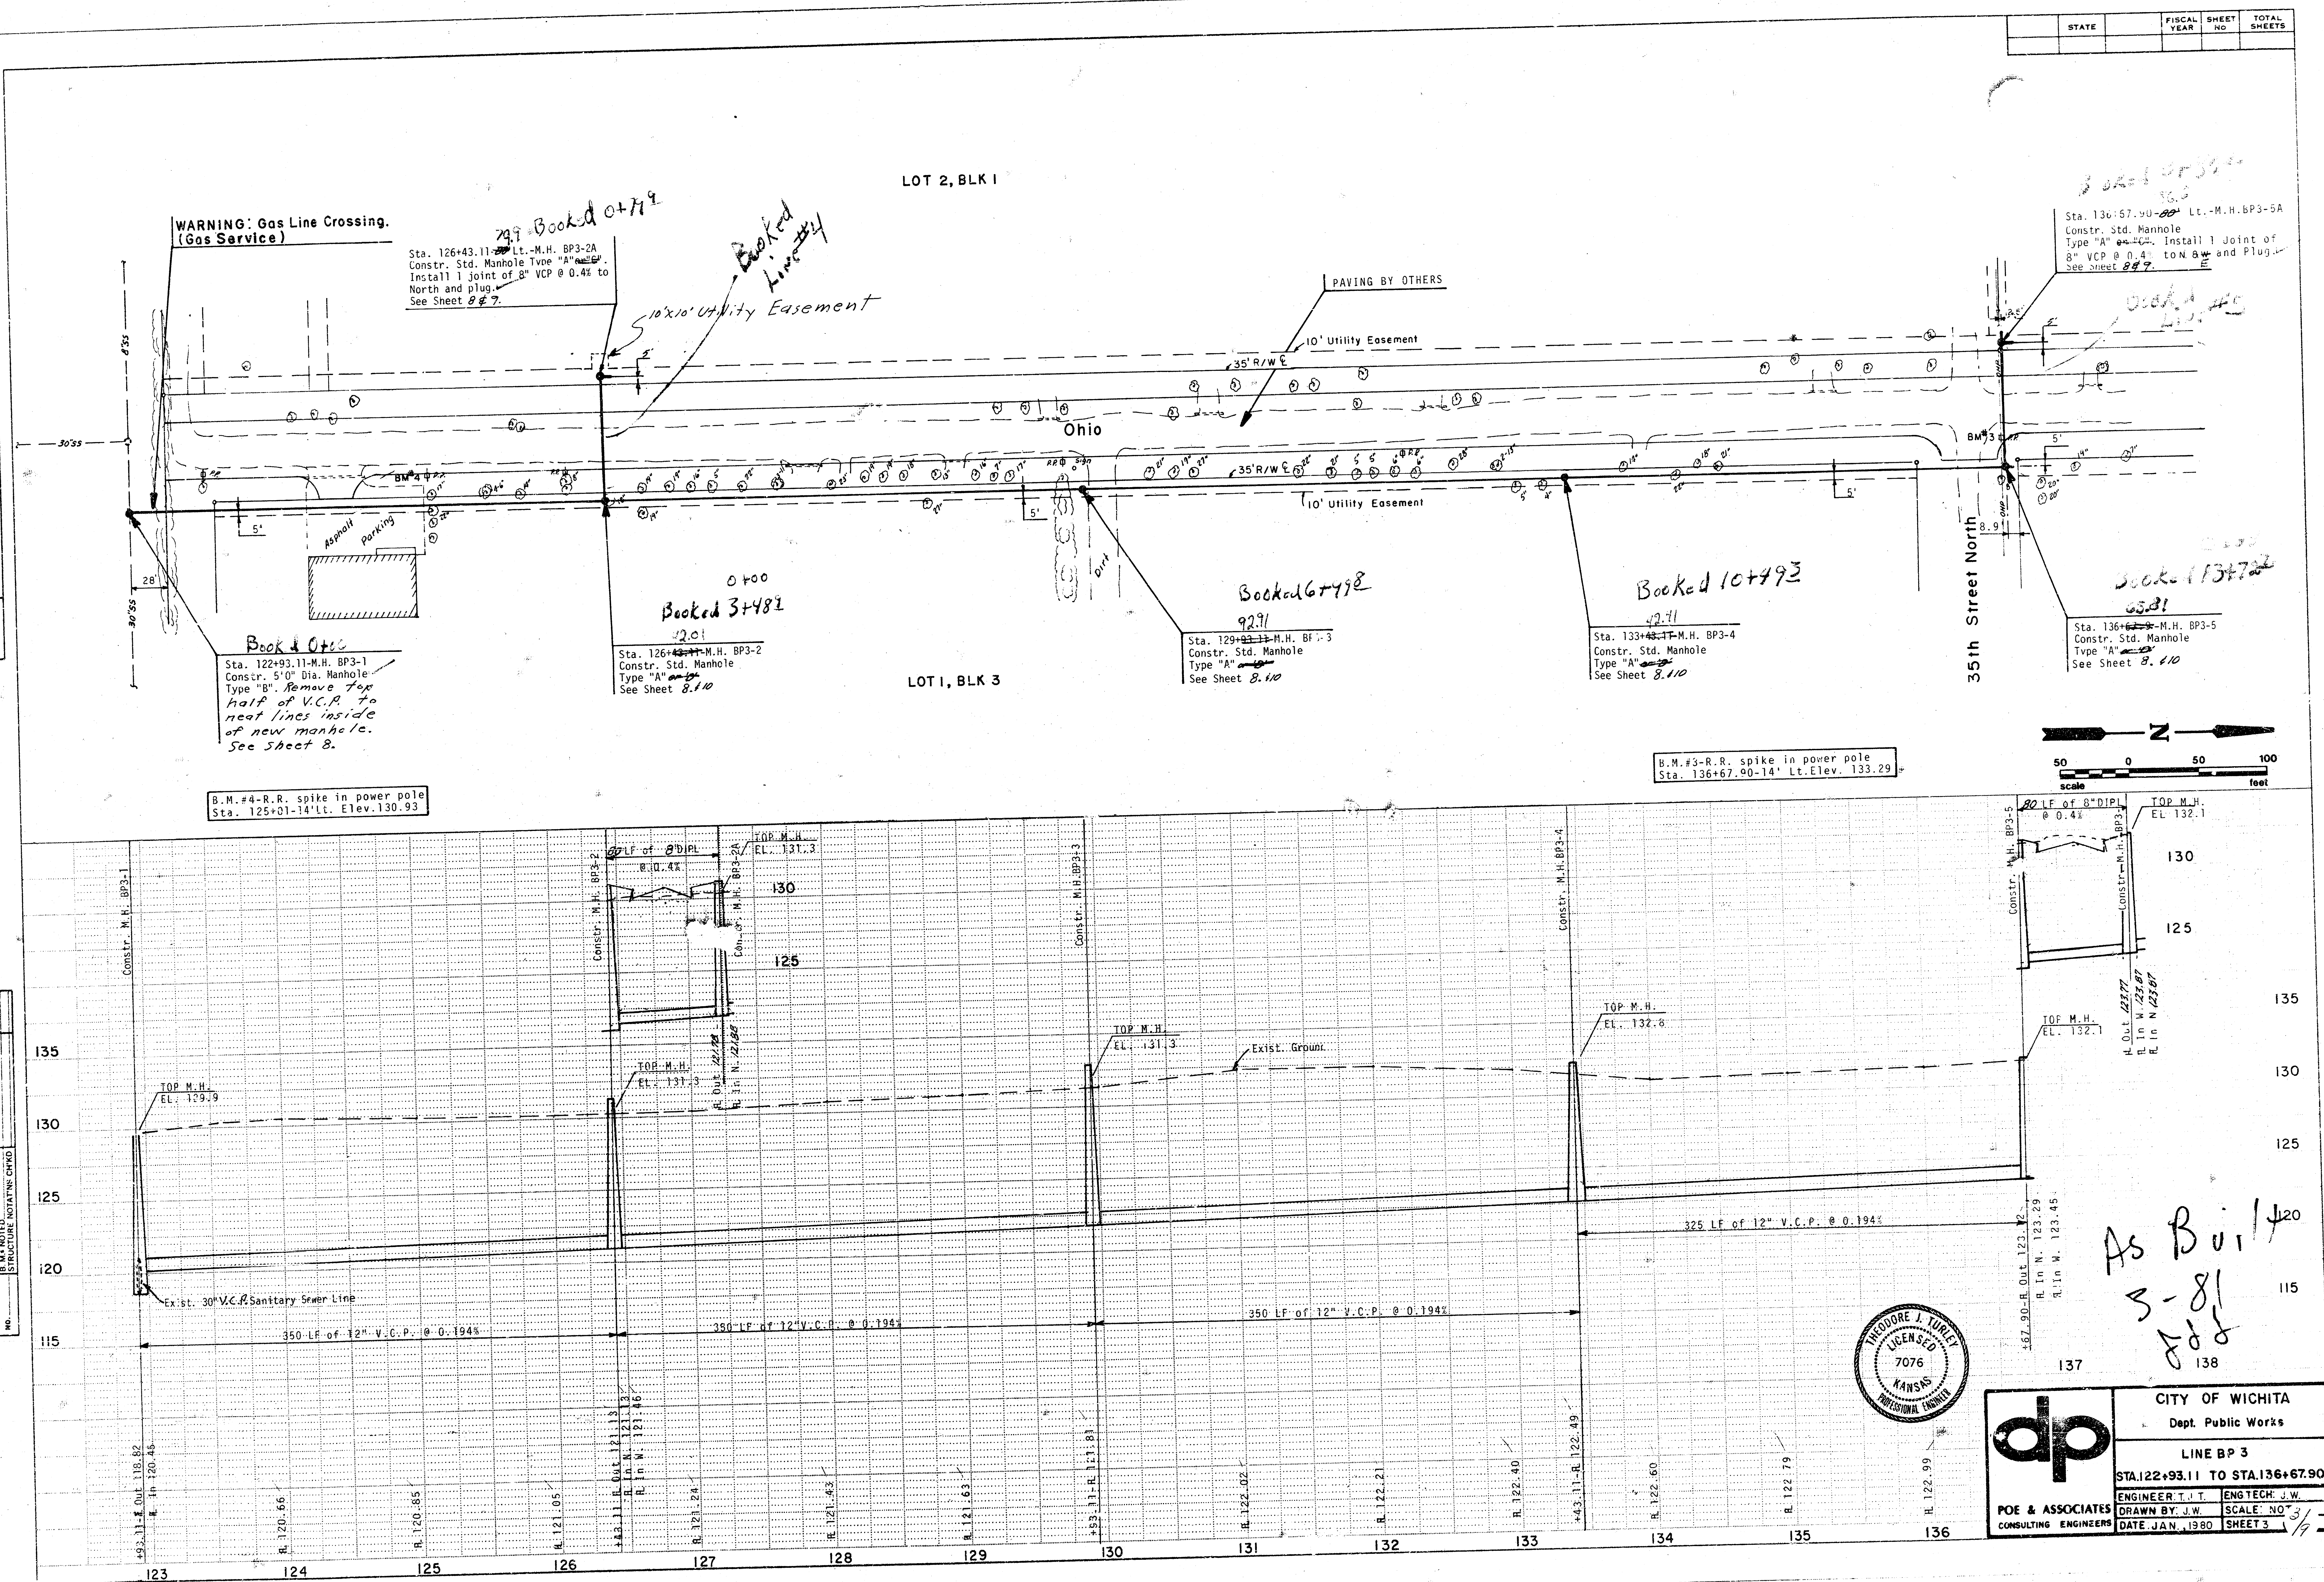

dp

CITY OF WICHITA
Dept. Public Works

LINE BP 3

STA. 122+93.11 TO STA. 136+67.90


ENGINEER: T. J. T.	ENG. TECH: J. W.
DRAWN BY: J. W.	SCALE: NO. 1
DATE: JAN. 1980	SHEET 3

POE & ASSOCIATES
CONSULTING ENGINEERS

PLAN	DATE
SURVEYED	BY
PLotted	DATE
NOTED	DATE
NO.	DATE

PROFILE	DATE
SURVEYED	BY
PLotted	DATE
NOTED	DATE
NO.	DATE



STATE	FISCAL YEAR	SHEET NO.	TOTAL SHEETS

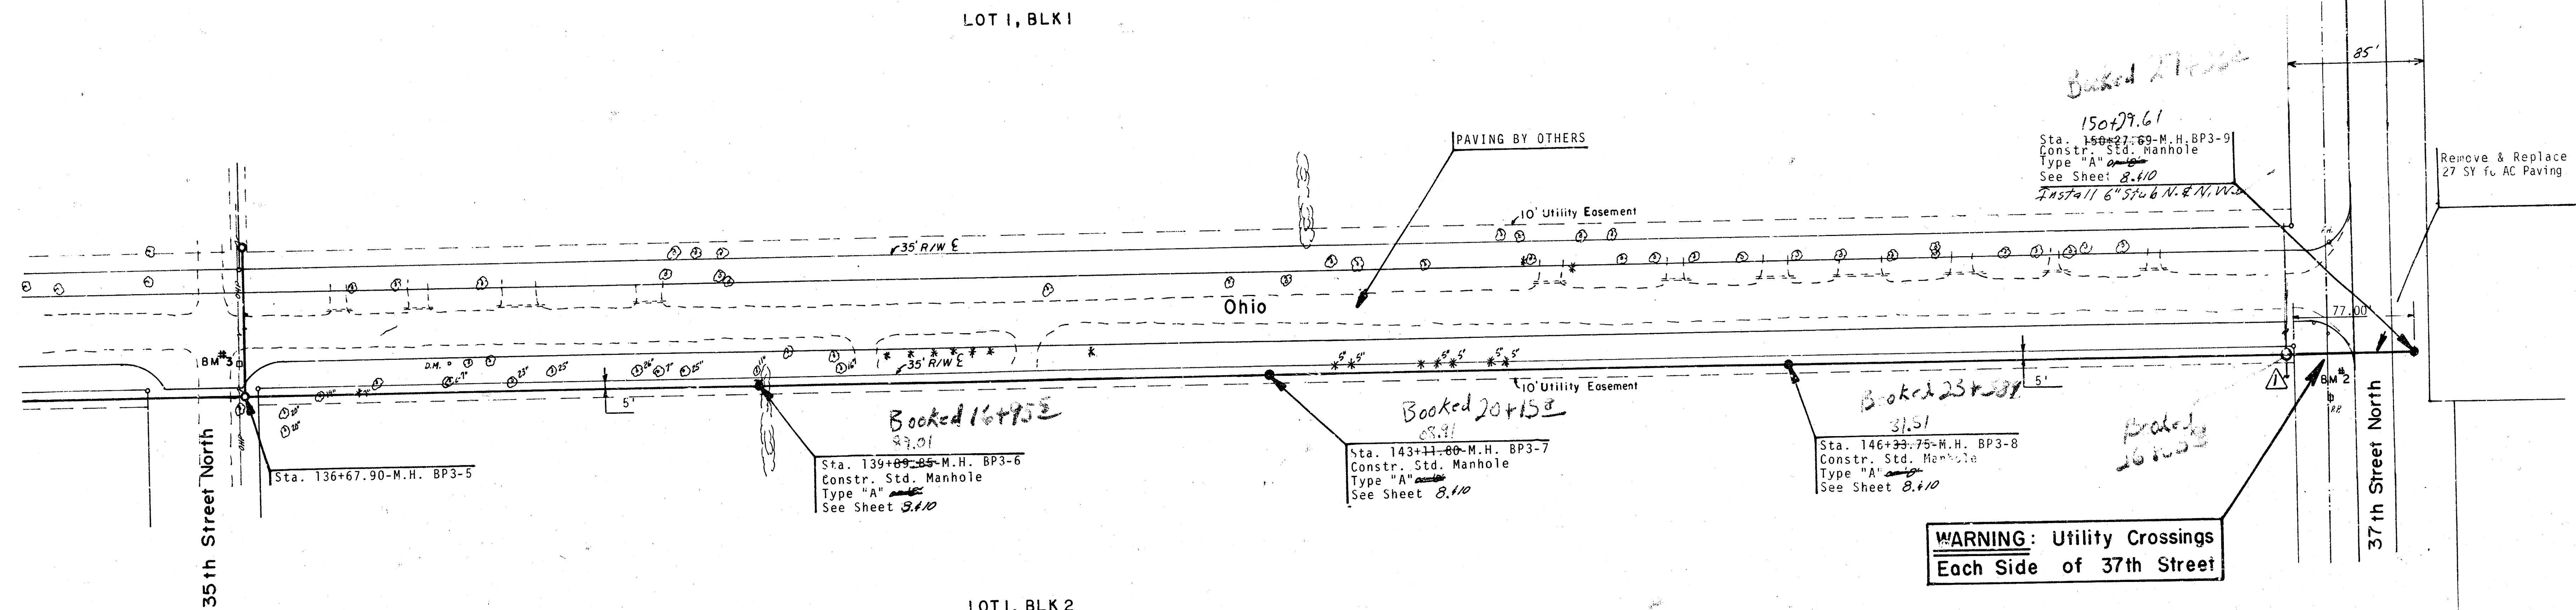

B.M. #3-R.R. spike in power pole
Sta. 136+65.14 Lt. Elev. 133.29

NO.	REVISION	BY	APP.	DATE
1	Revised Alignment See Sht. 5A	JP	JMT	9-19-80

B.M. #2-R.R. spike in south side of power pole
Sta. 149+55.69-17.31 Lt. Elev. 136.25

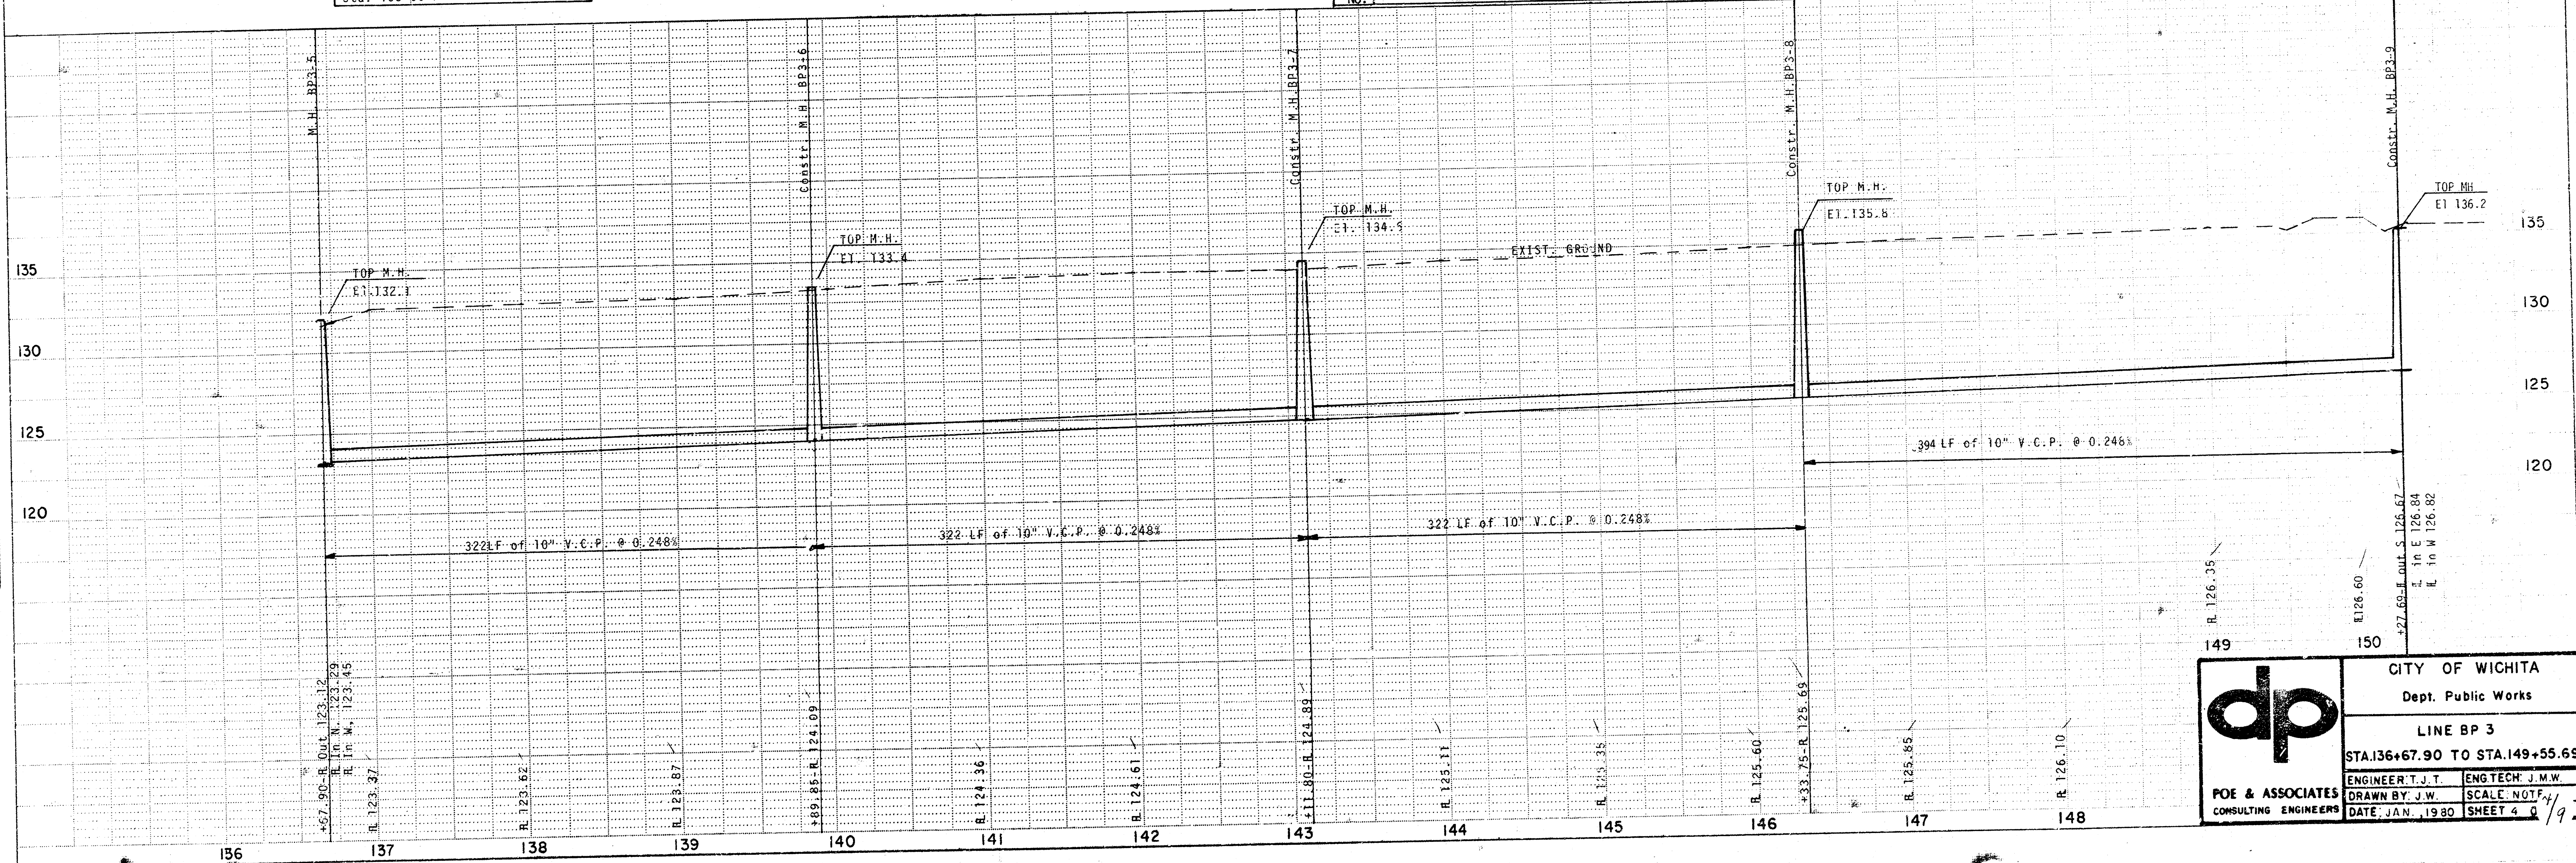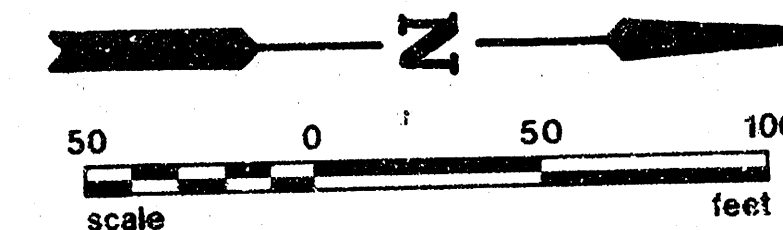



CITY OF WICHITA
Dept. Public Works
LINE BP 3
STA. 136+67.90 TO STA. 149+55.69
ENGINEER: T.J.T. ENGINEER: J.M.W.
DRAWN BY: J.W. SCALE: NOT TO SCALE
DATE: JAN. 1980 SHEET 4 OF 9

POE & ASSOCIATES
CONSULTING ENGINEERS


PLAN	DATE	BY
REVISIONS		
1. ALIGNED CHANGED		
2. UTILITY		
3. R/W		
4. EASEMENT		
5. OTHER		
6. NOTE BOOK		
7. NO		

PROFILE	DATE	BY
REVISIONS		
1. CHANGED		
2. UTILITY		
3. R/W		
4. EASEMENT		
5. OTHER		
6. NOTE BOOK		
7. NO		

STATE	FISCAL YEAR	SHEET NO.	TOTAL SHEETS

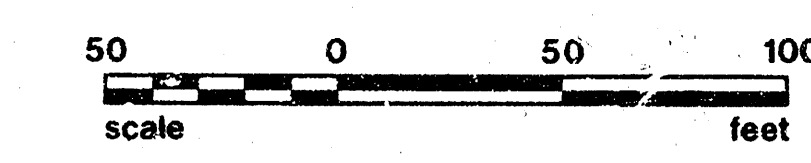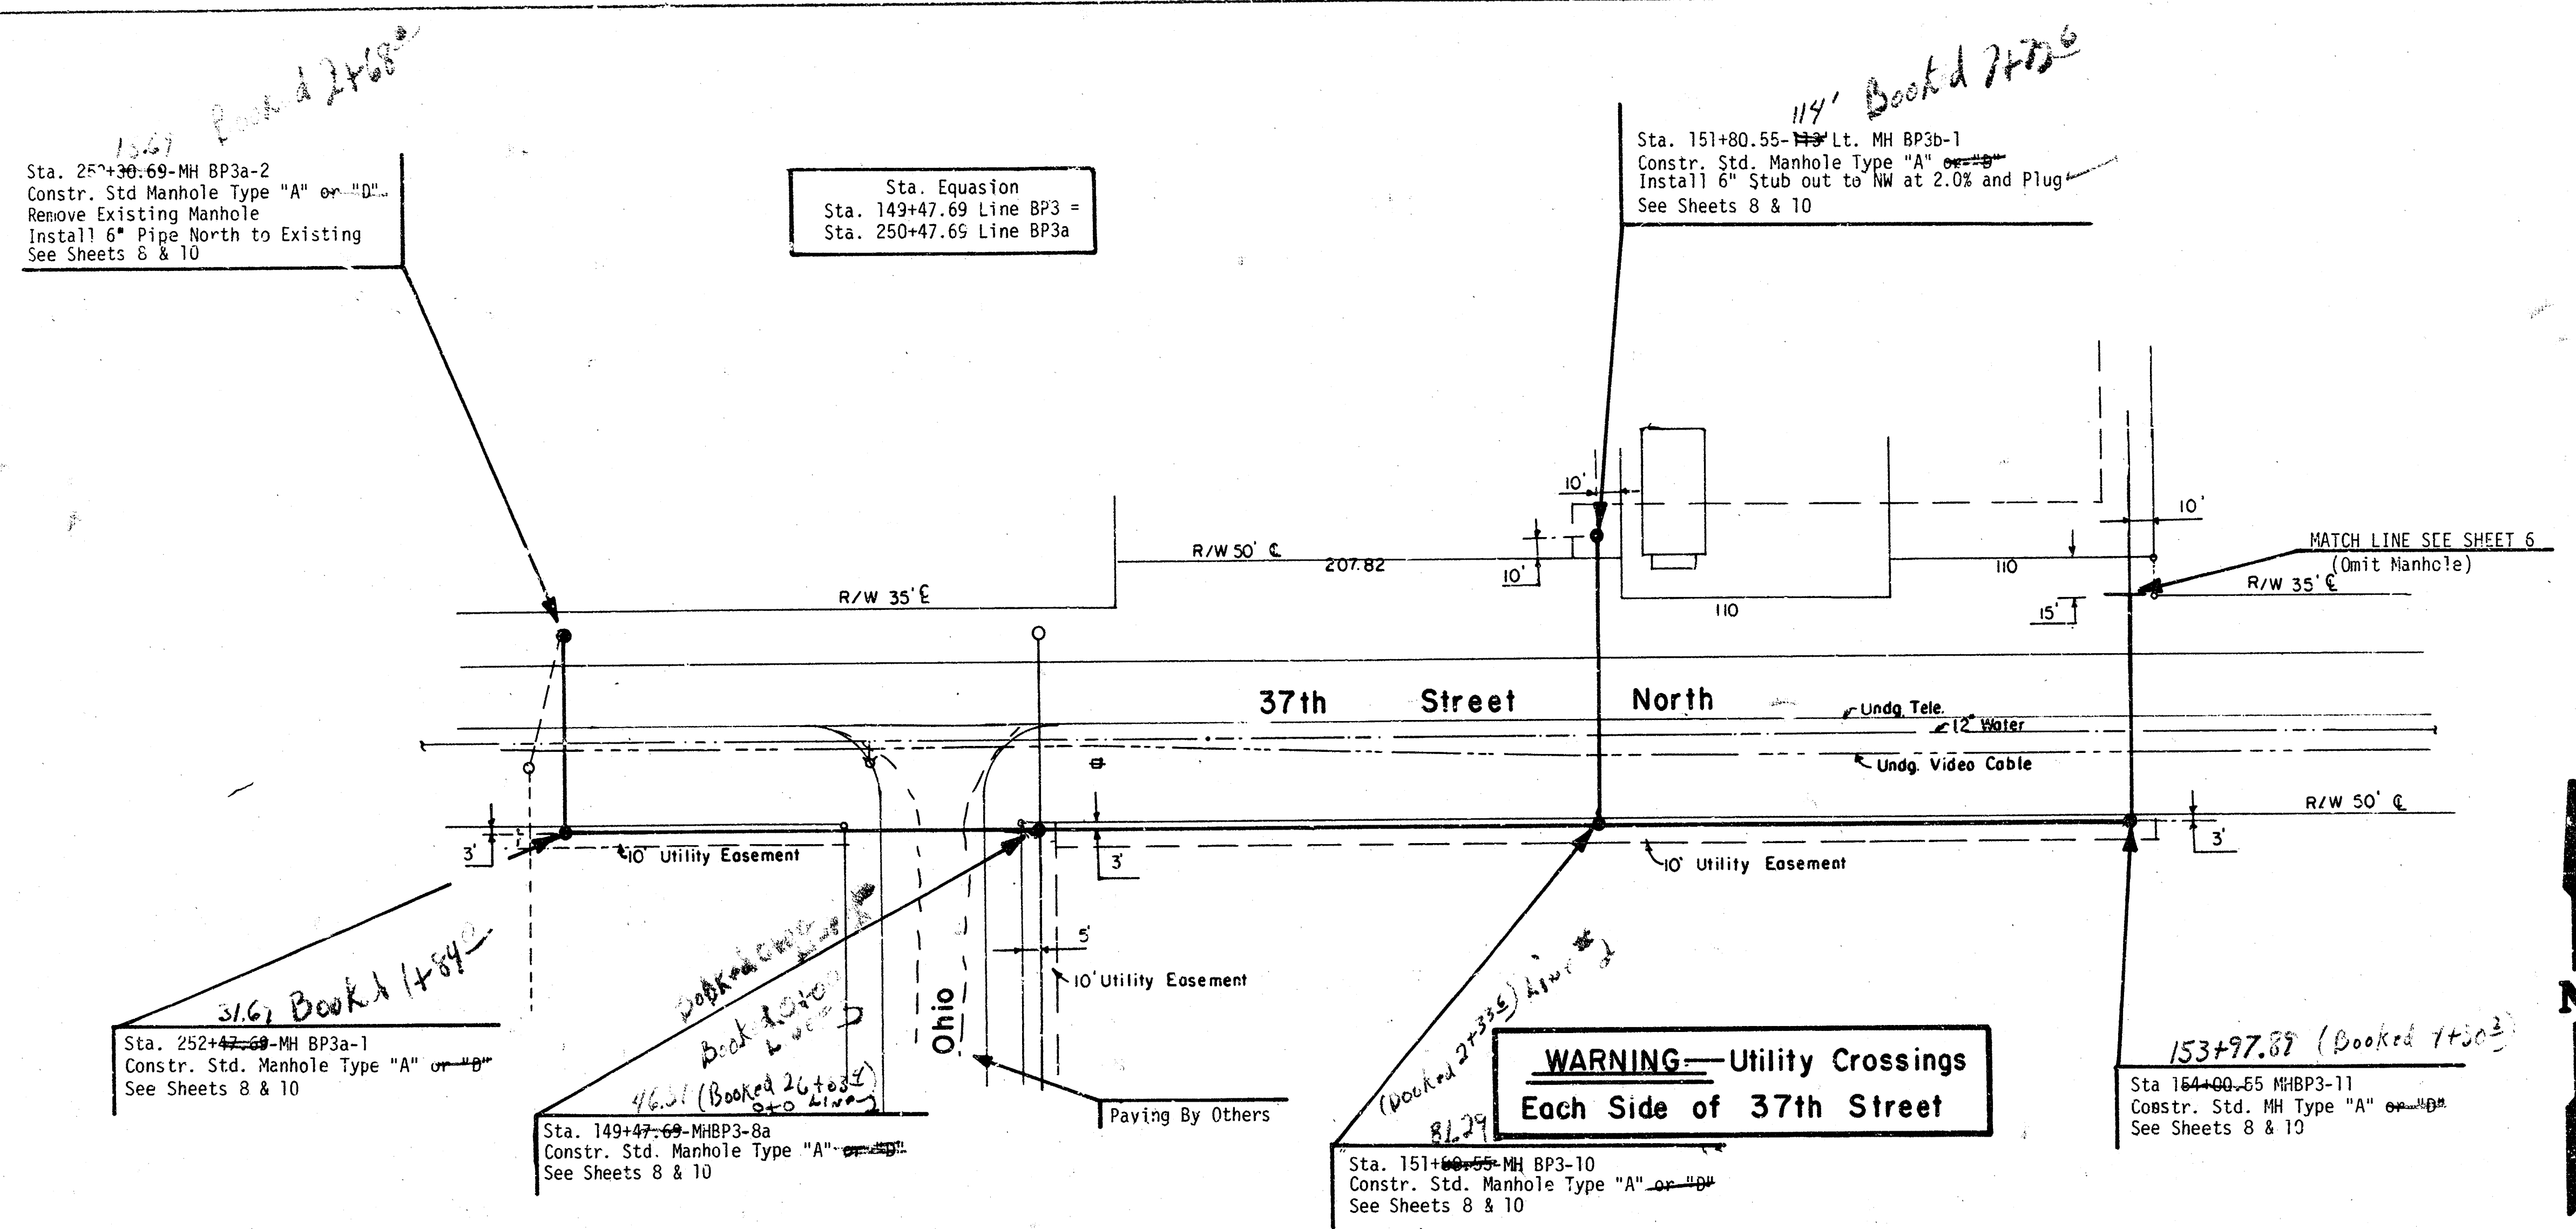

Revised Alignment	JP	JMT	9-19-80
REVISION	BY	APP.	DATE

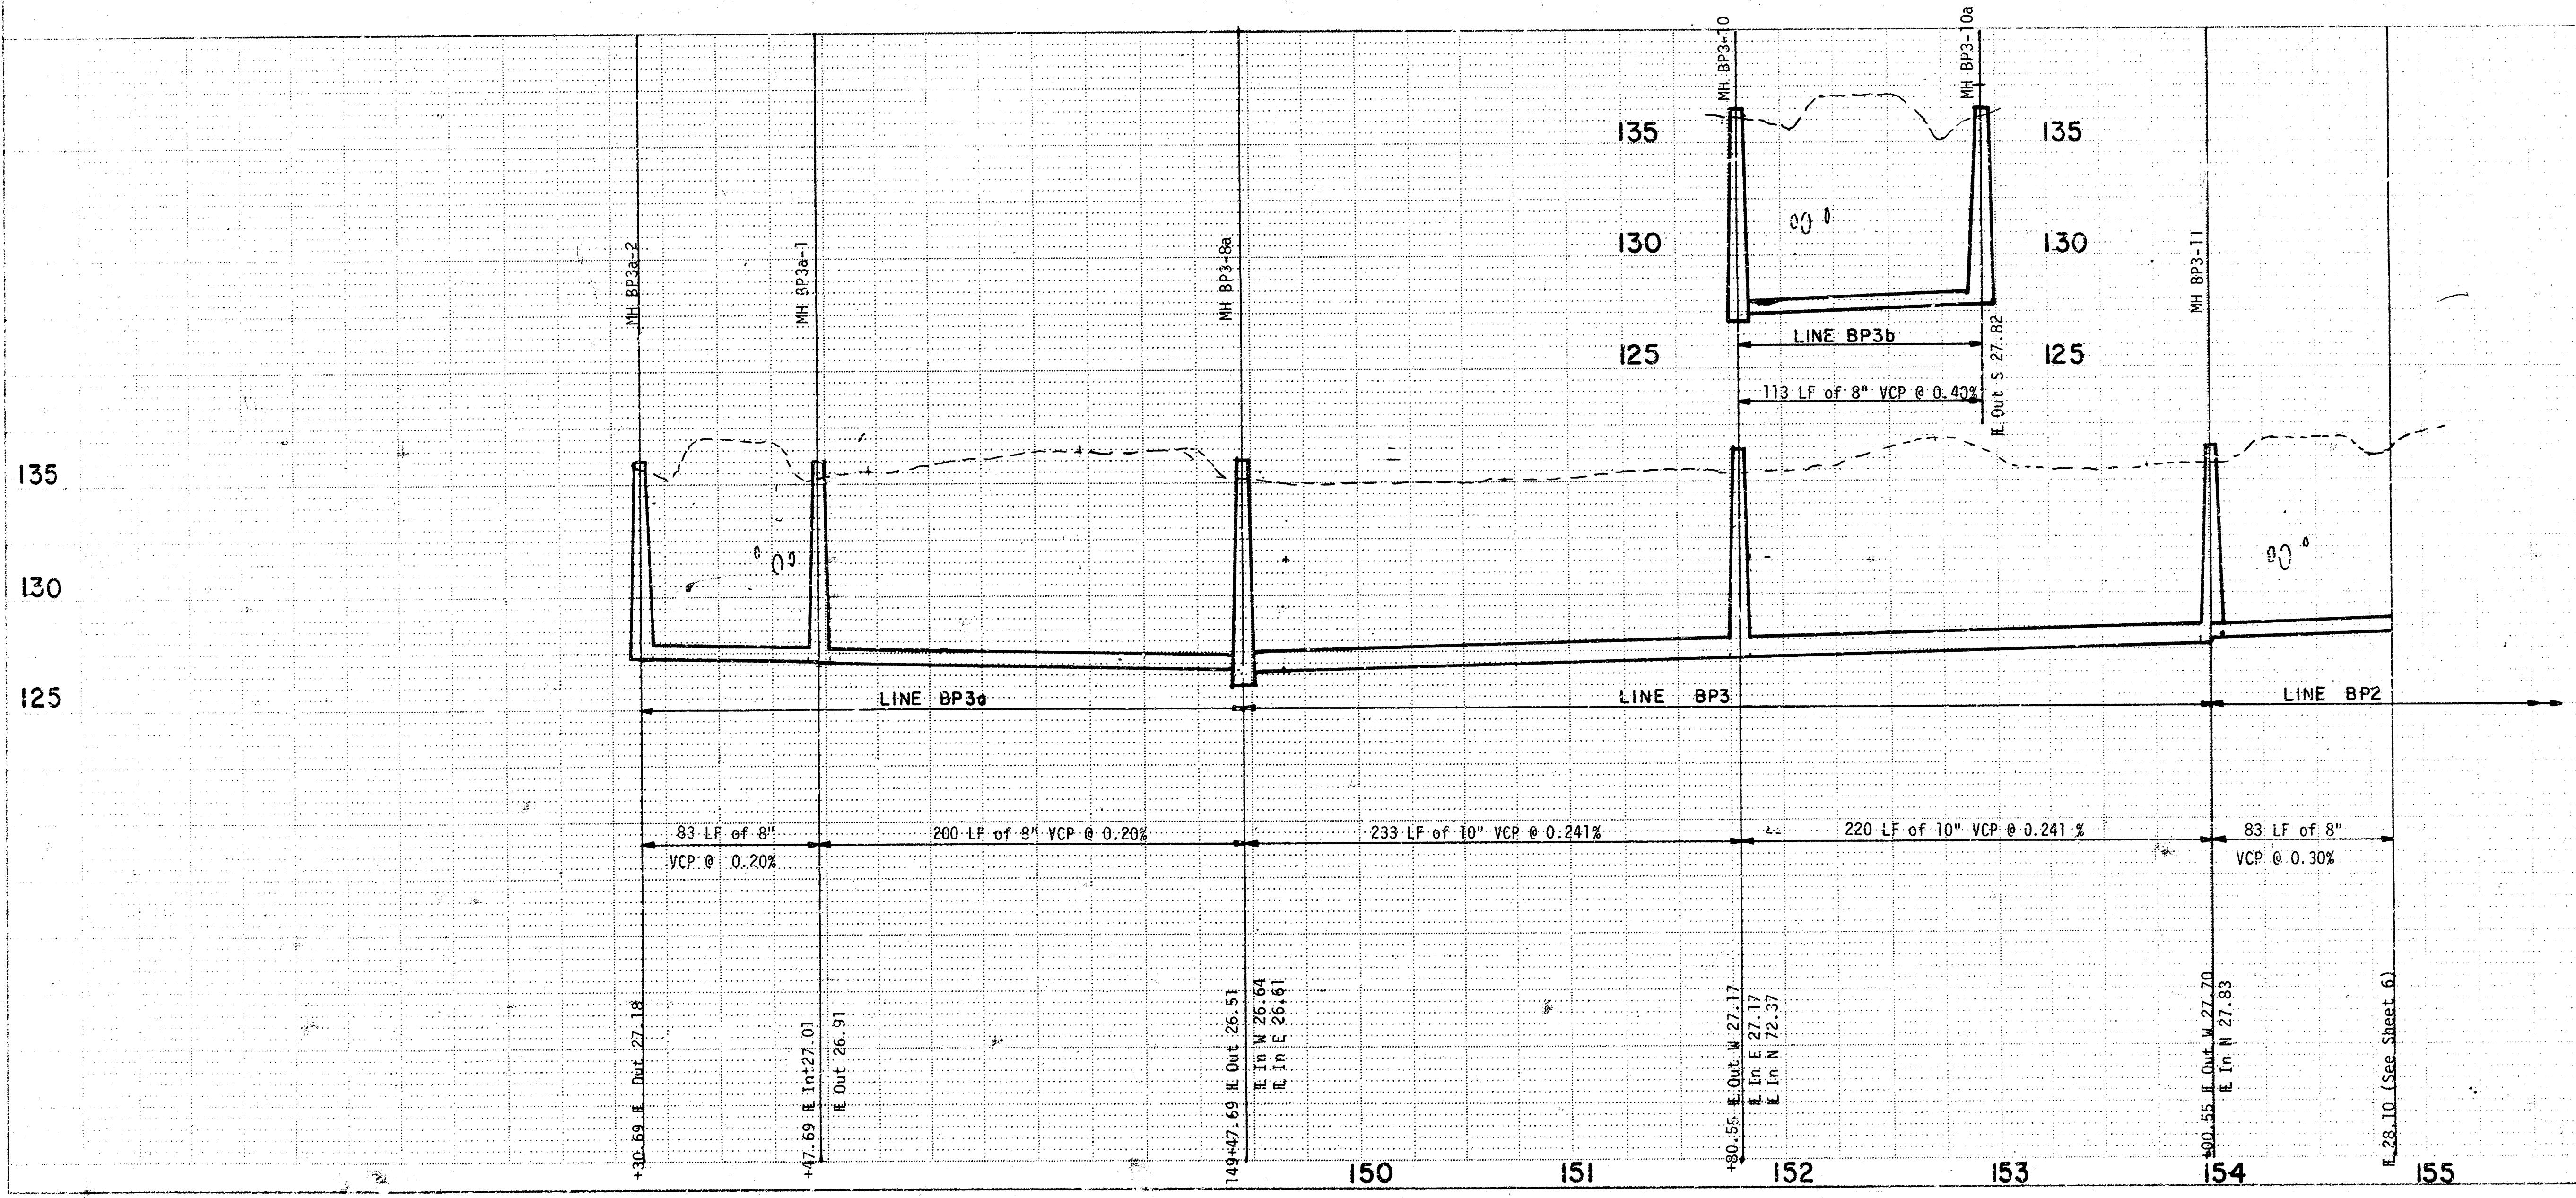


POE & ASSOCIATES
CONSULTING ENGINEERS


CITY OF WICHITA
Dept. of Engineering

REVISED ALIGNMENT
SHEET 5 VOID

ENGINEER JMT
DRAWN BY JP
DATE: 9-19-80

ENGTECH JW
SCALE NOT 5/1
SHEET 50 OF 51

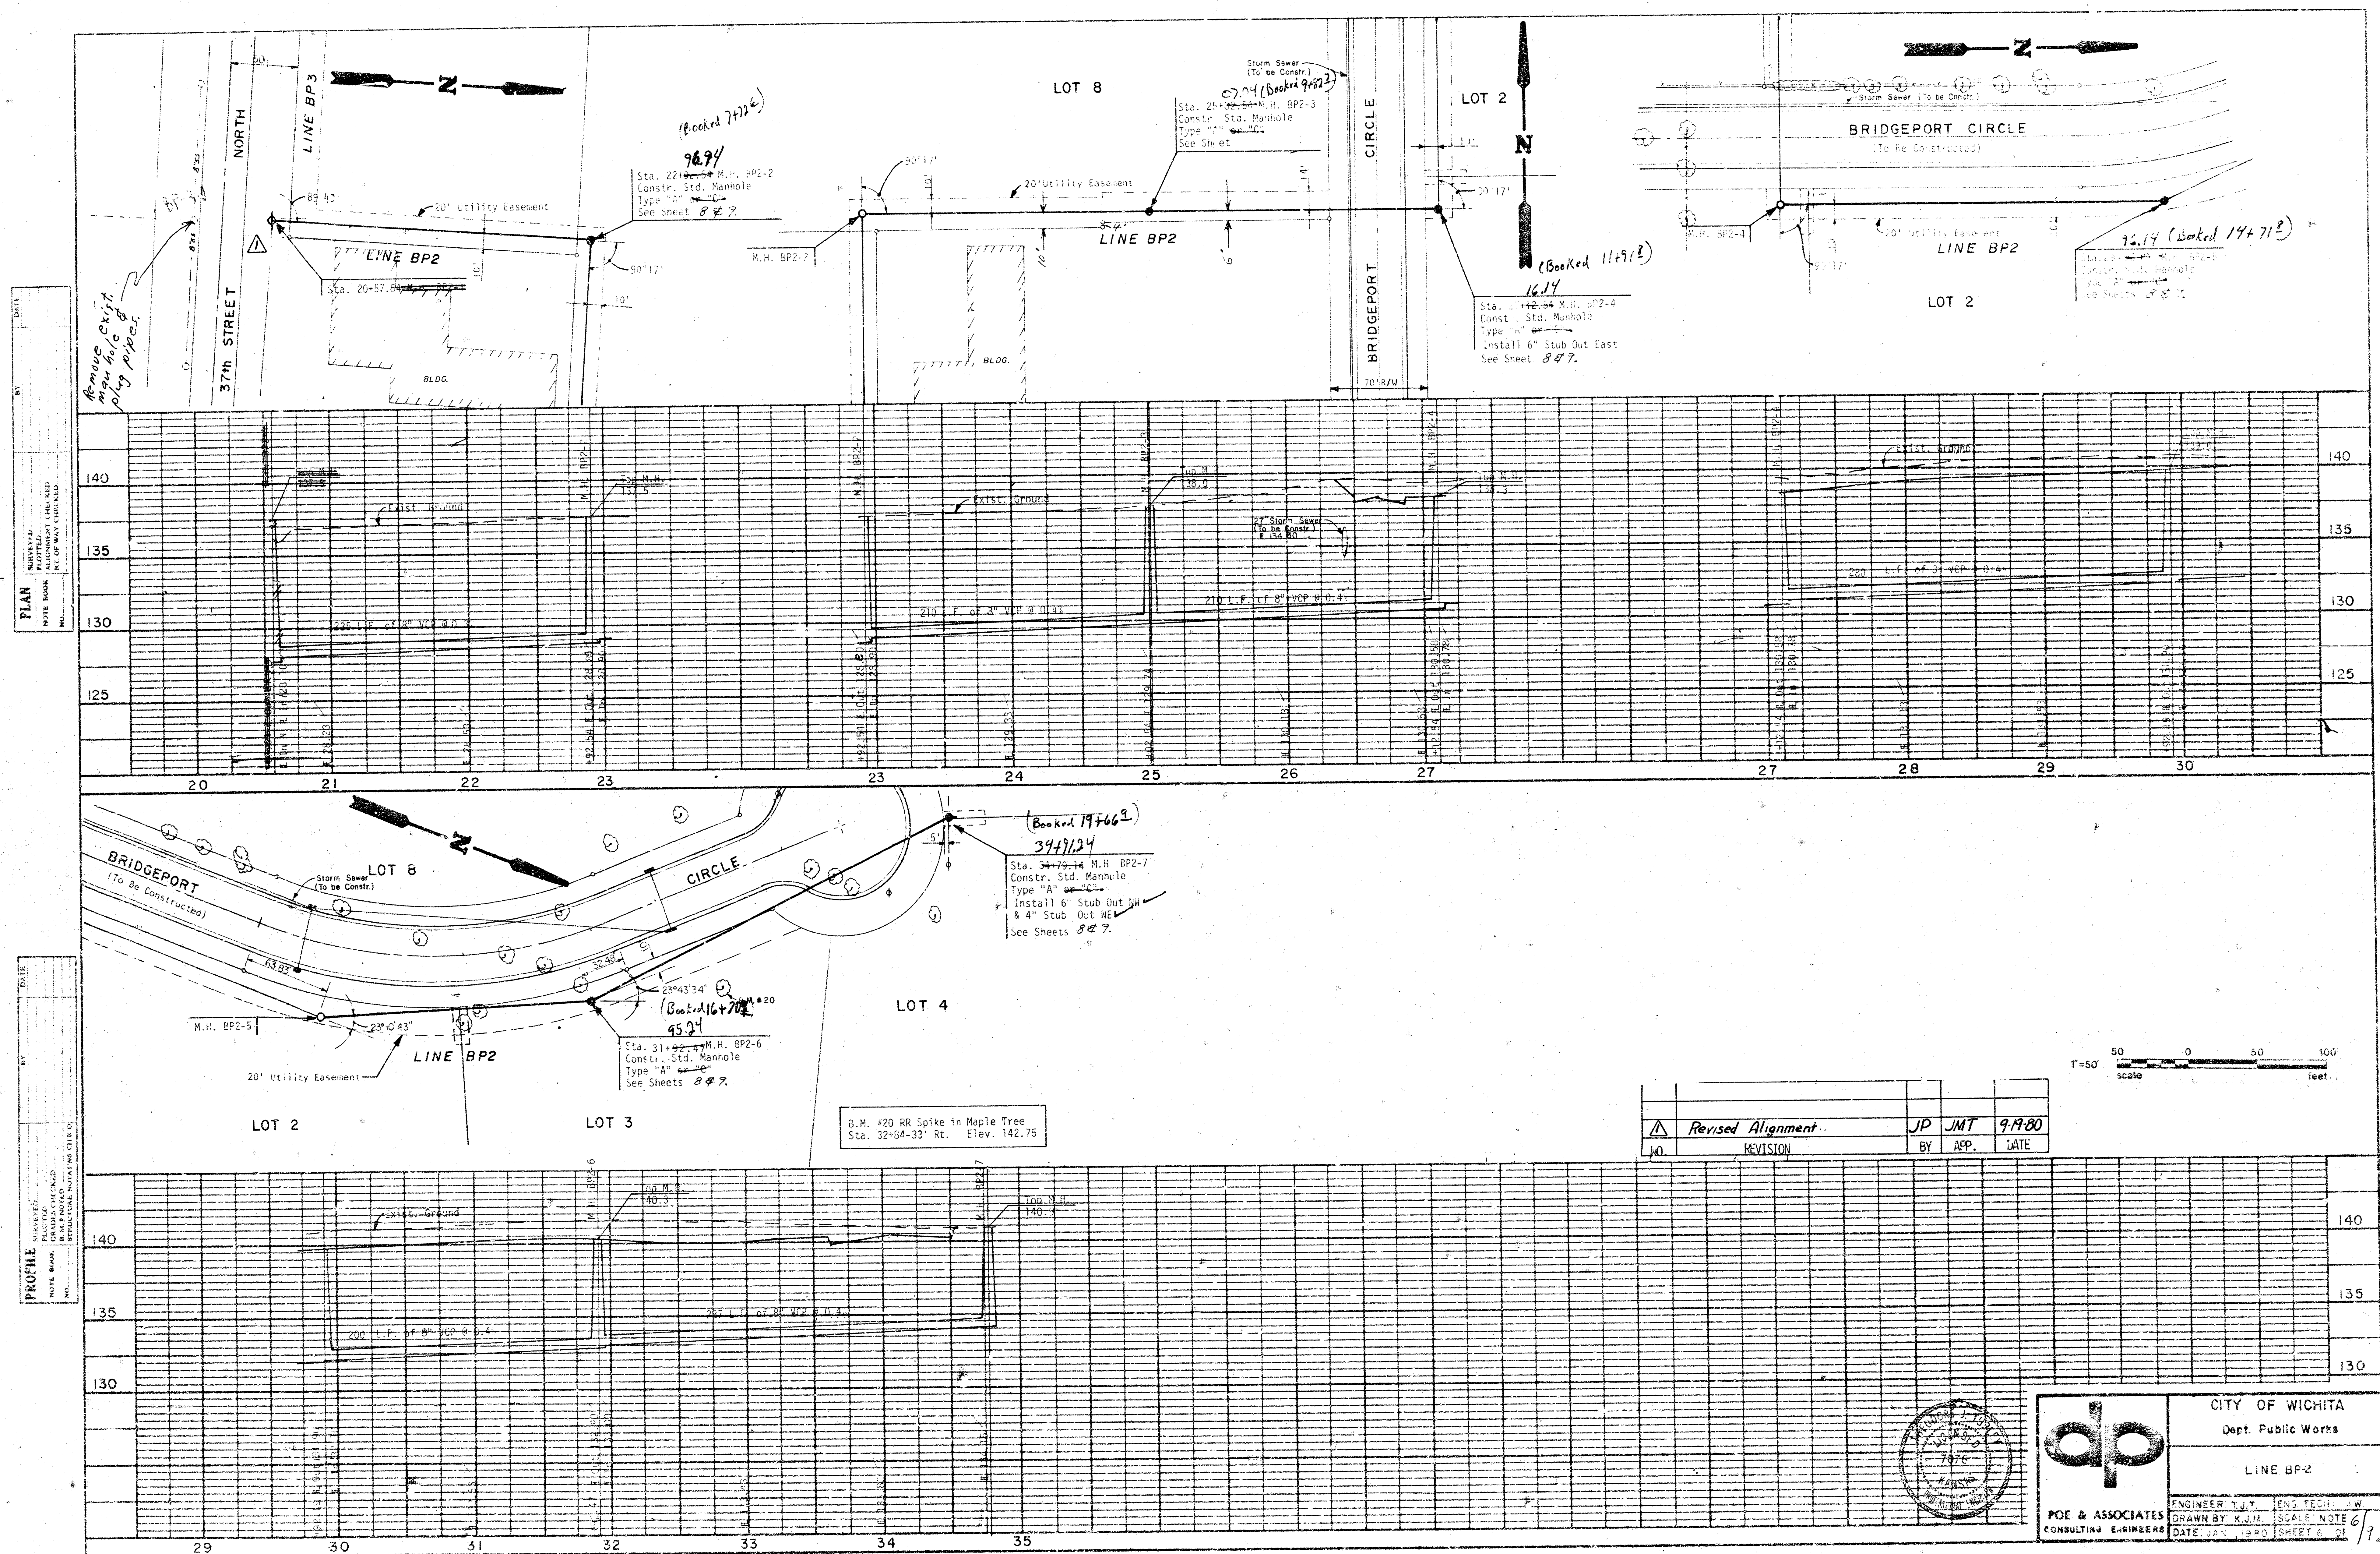


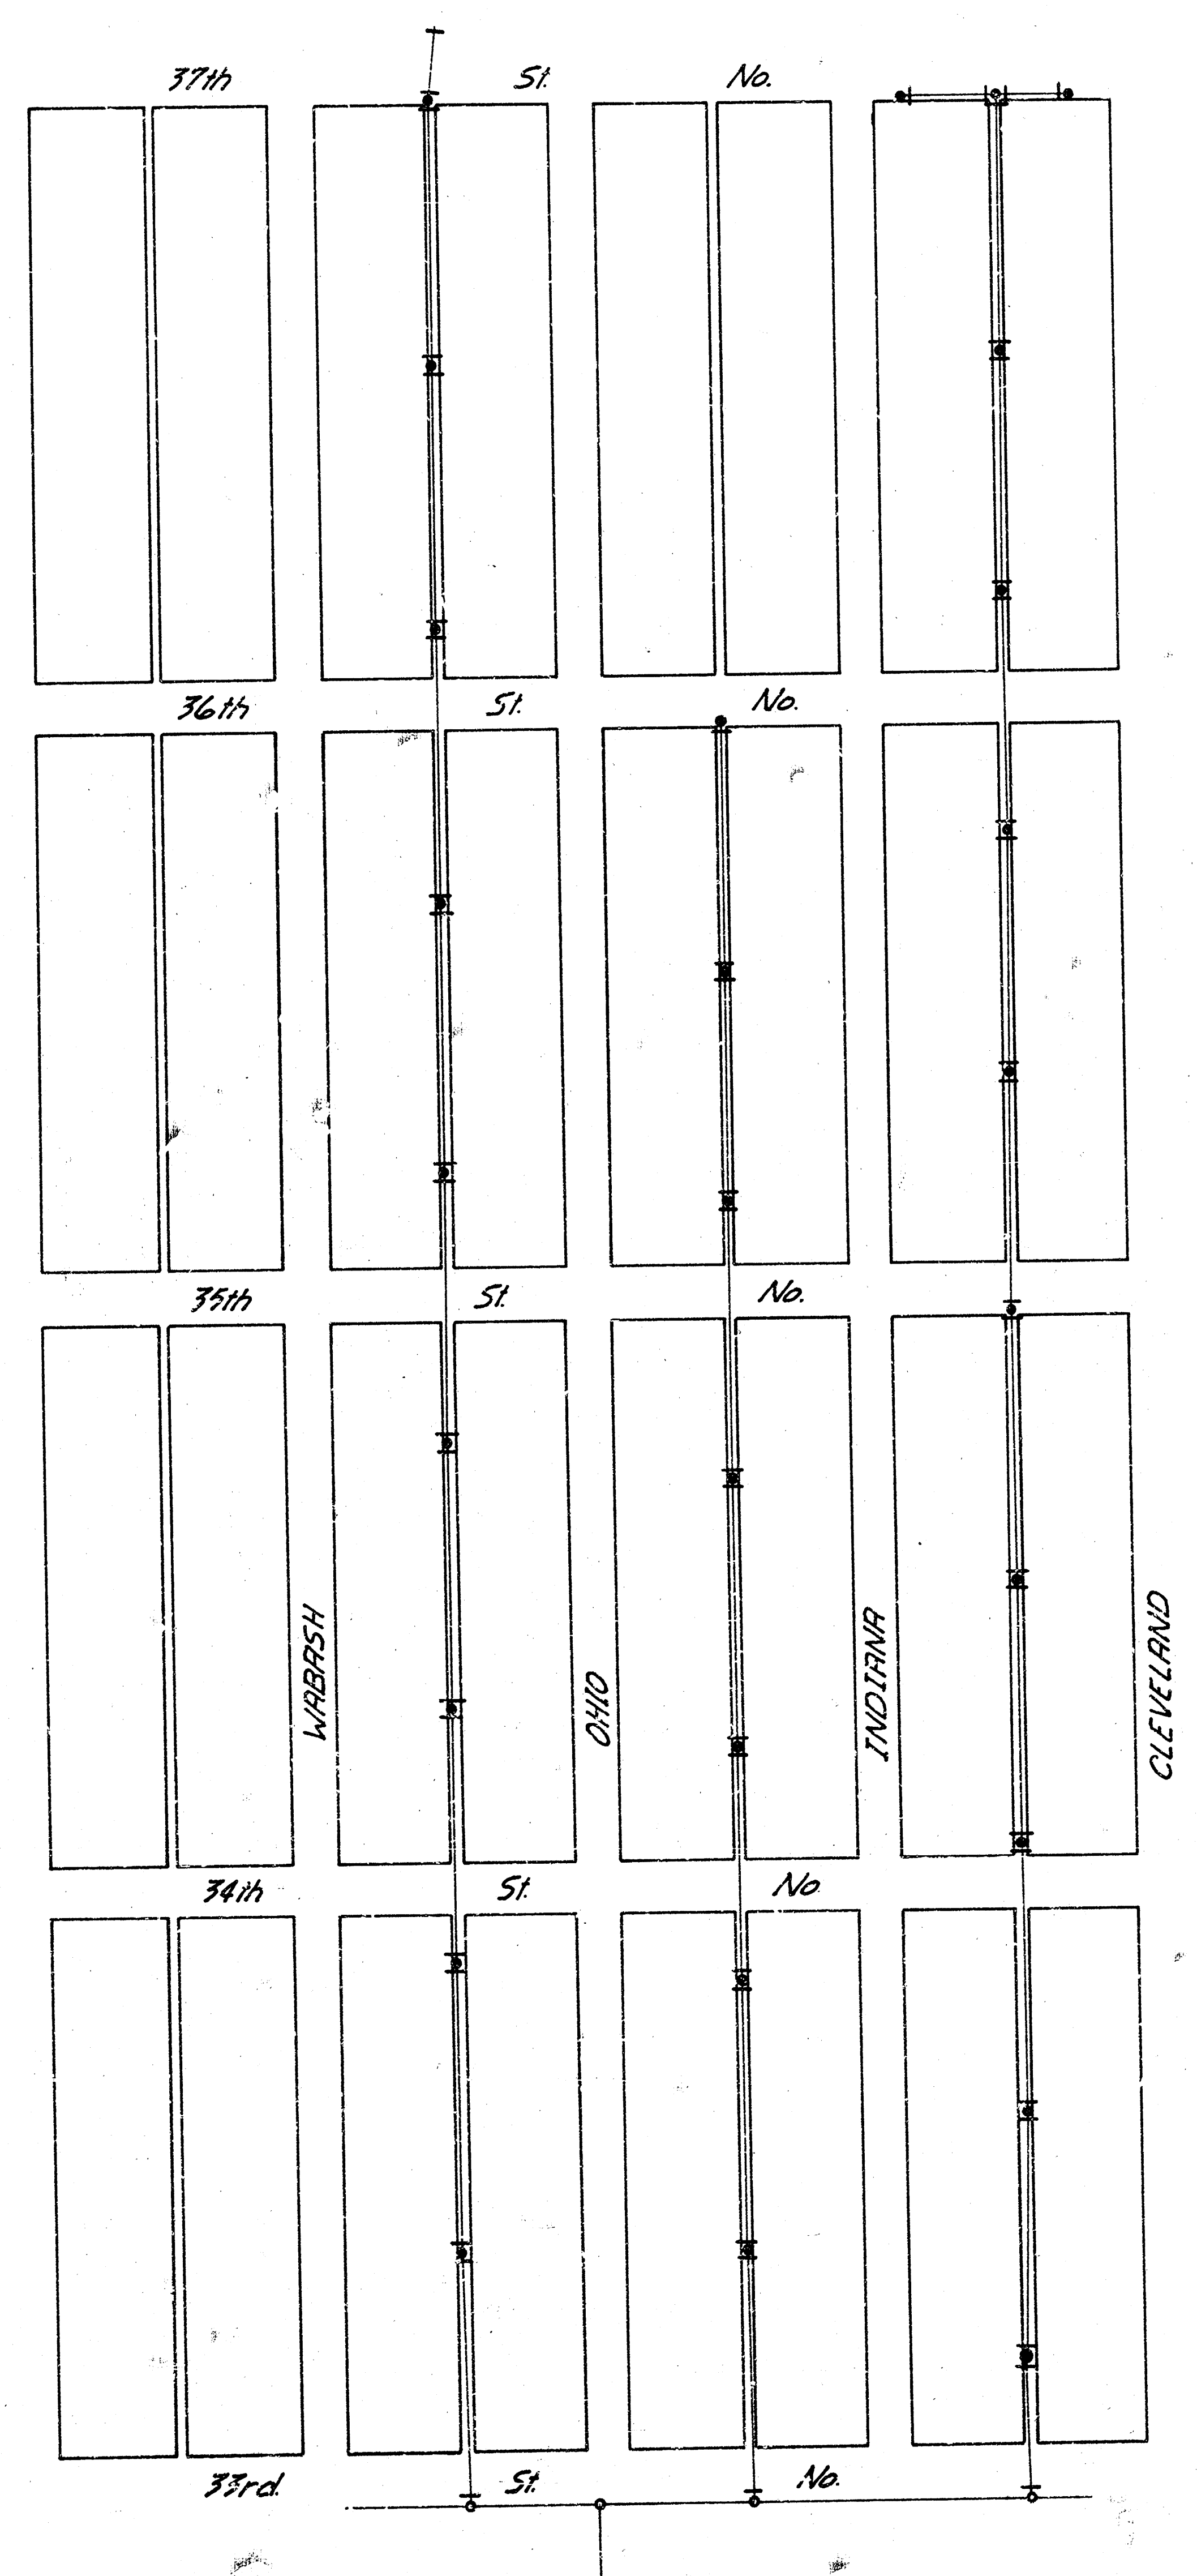


- Manholes to be Abandoned
- Manholes to Remain in Service
- + Pipes to be Plugged

NOTE
The Existing Sewer Line between
Wabash & Ohio is not to be Abandoned
Until the Proposed Line is in Place
and in Service.


GROUT IN UNPAVED AREAS TYP.

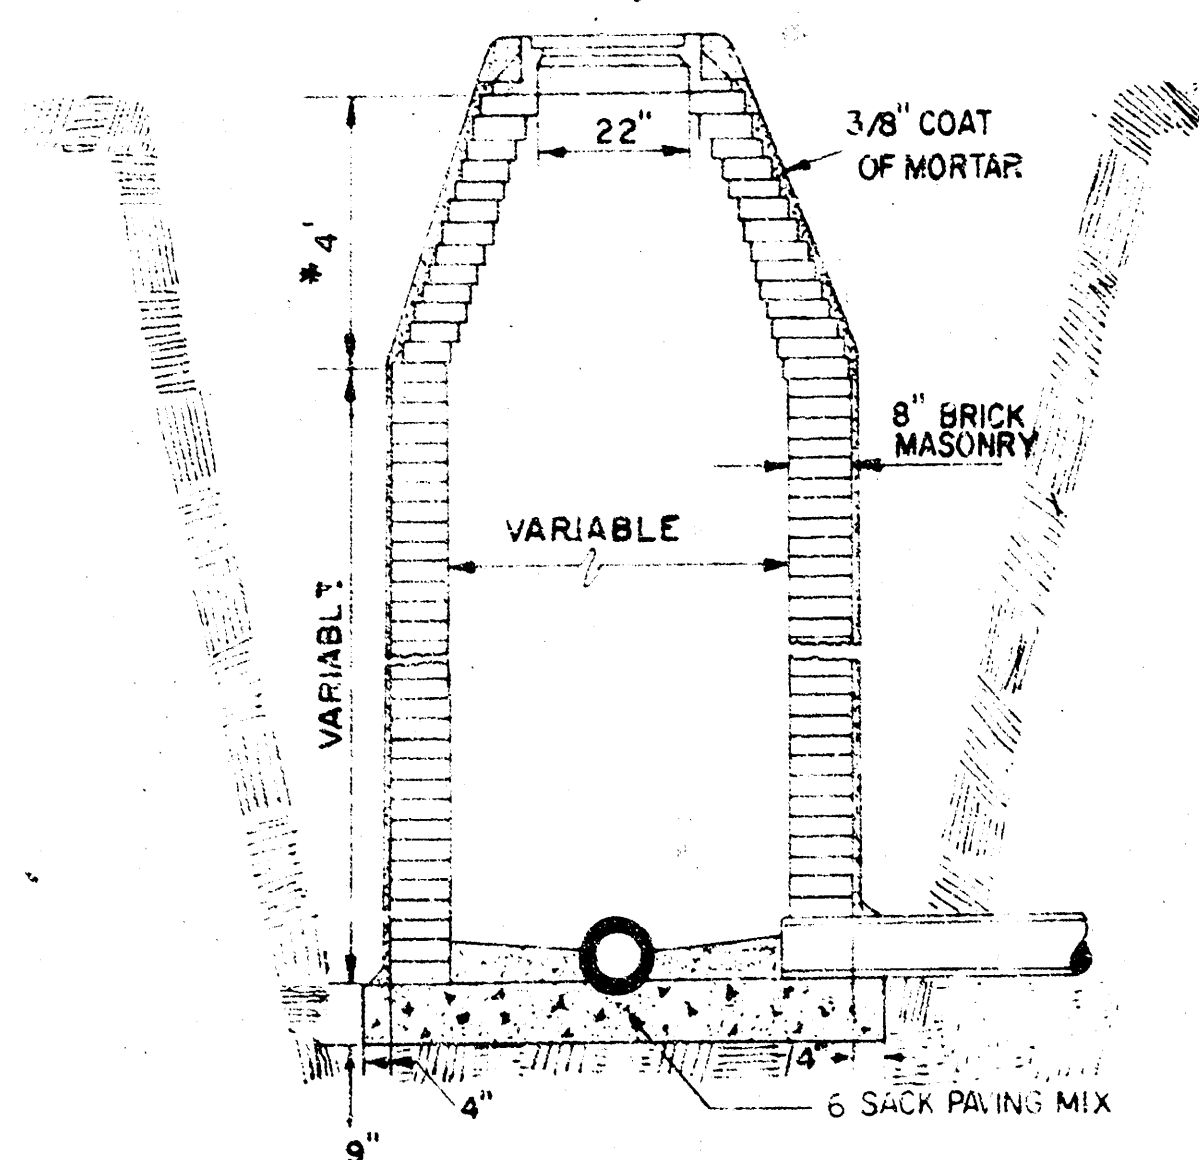


STANDARD MANHOLE
TYPE "A"

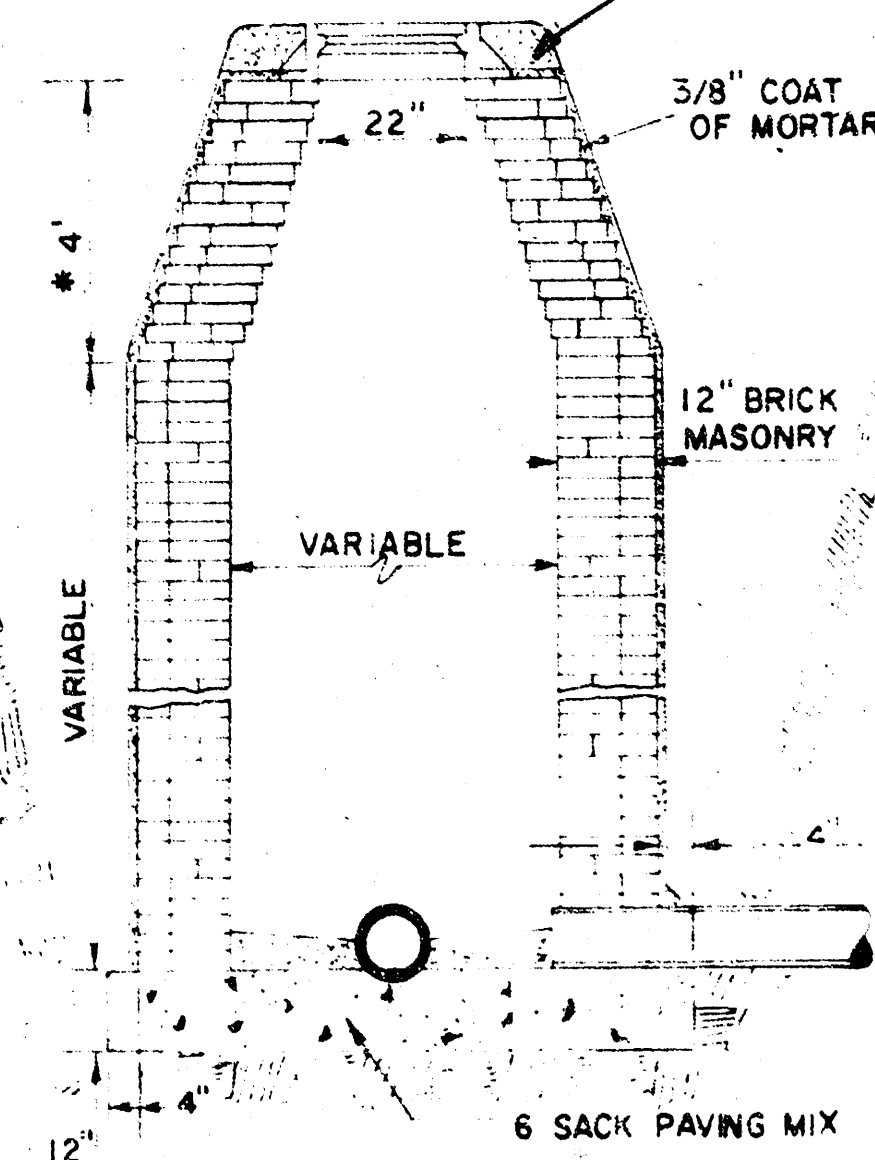


STANDARD MANHOLE
TYPE "B"

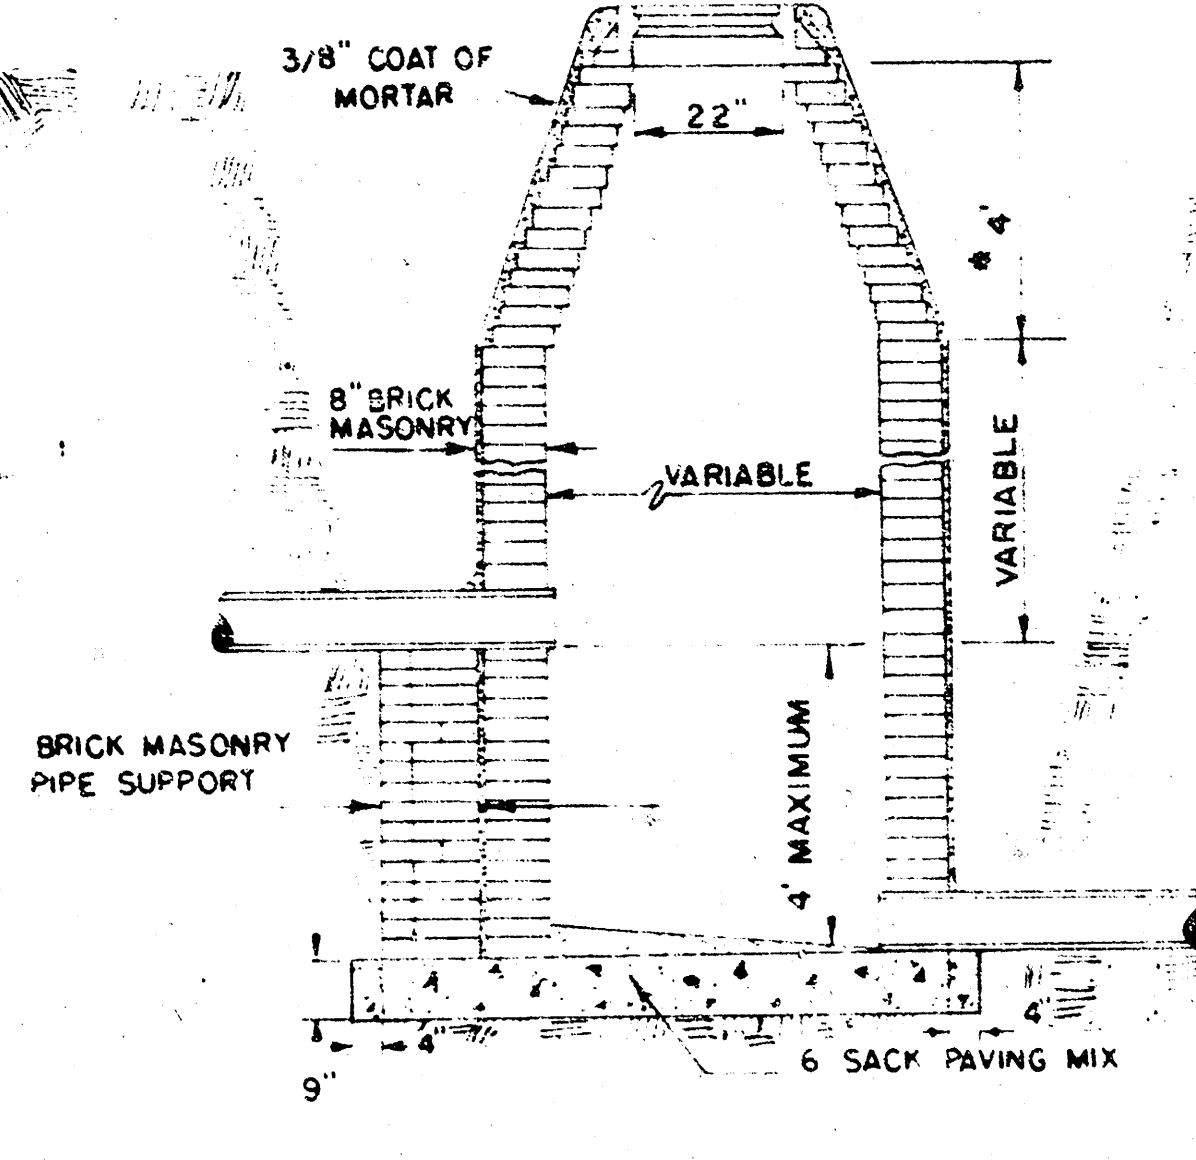


DROP MANHOLE
TYPE "A"

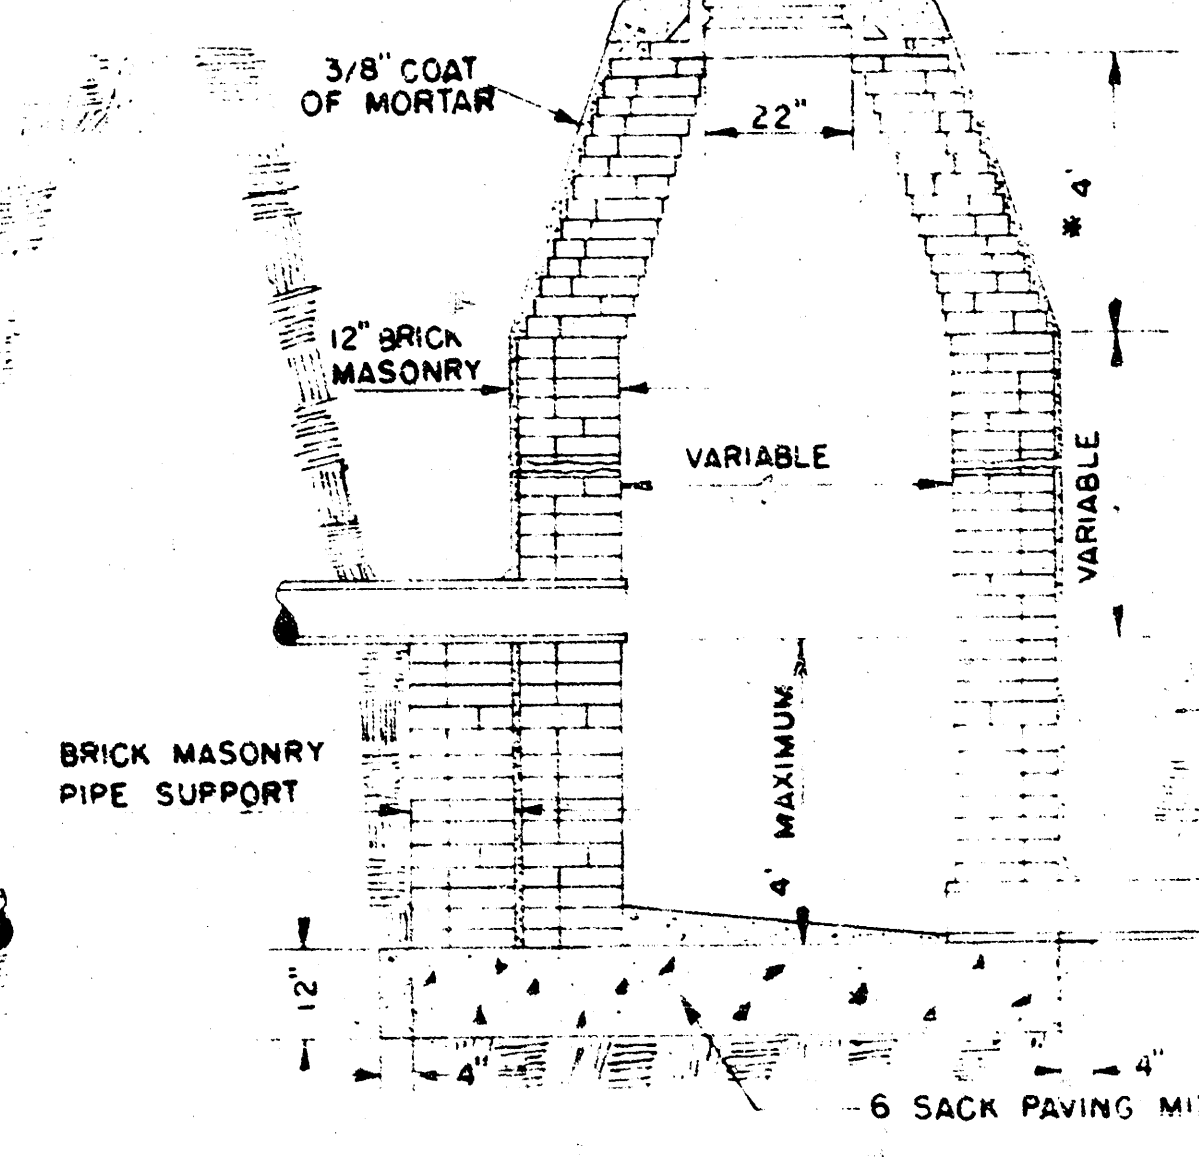

DROP MANHOLE
TYPE "B"

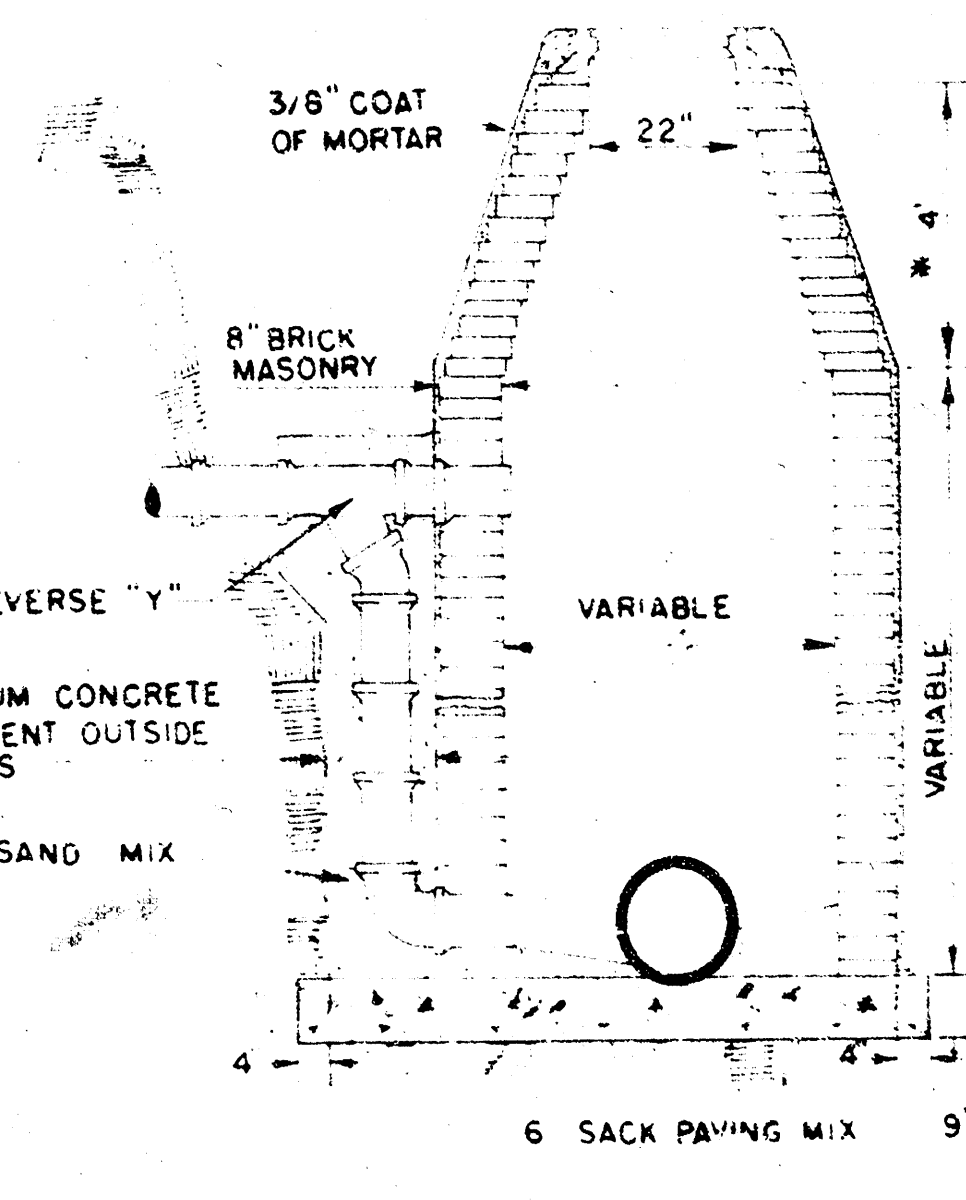


OUTSIDE DROP MANHOLE
TYPE "A"

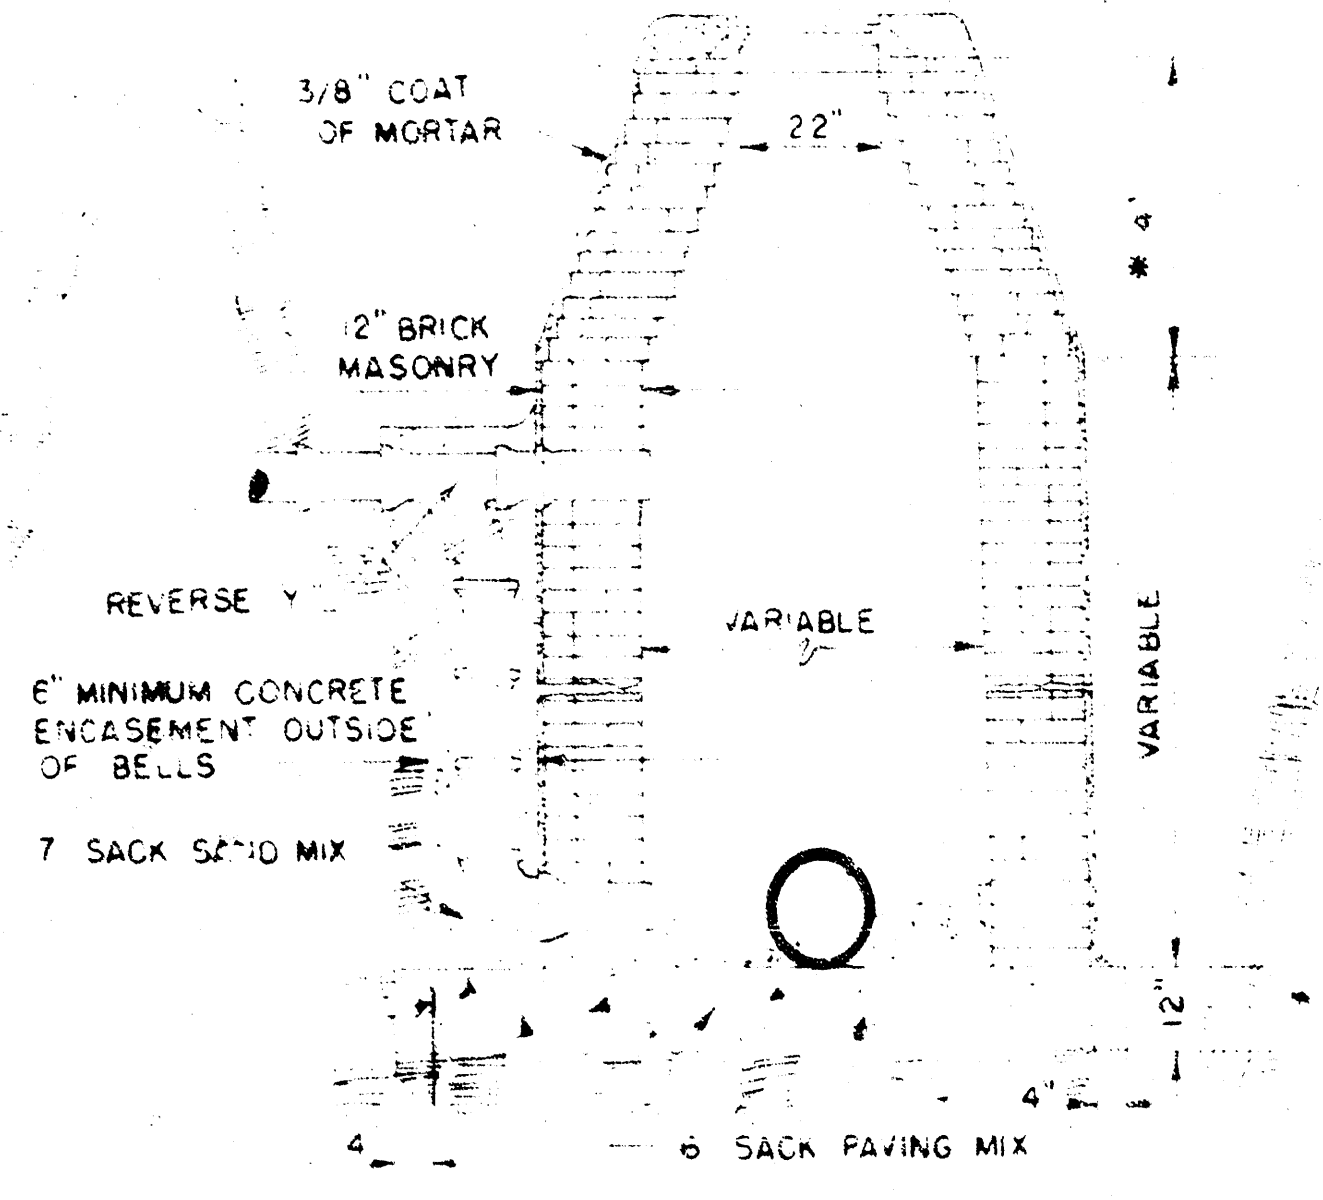


OUTSIDE DROP MANHOLE
TYPE "B"

* DRAW = 6' ON 5' DIA. M.H.


NOTE: REINFORCING STEEL SHALL BE INSTALLED IN THE MANHOLE BASES 6" ABOVE THE BOTTOM. REINFORCING STEEL SHALL CONSIST OF NO. 4 BARS PLACED ON 6" CENTERS IN BOTH DIRECTIONS. THE COST OF REINFORCING STEEL IS TO BE INCLUDED IN THE PRICE BID FOR THE MANHOLE.

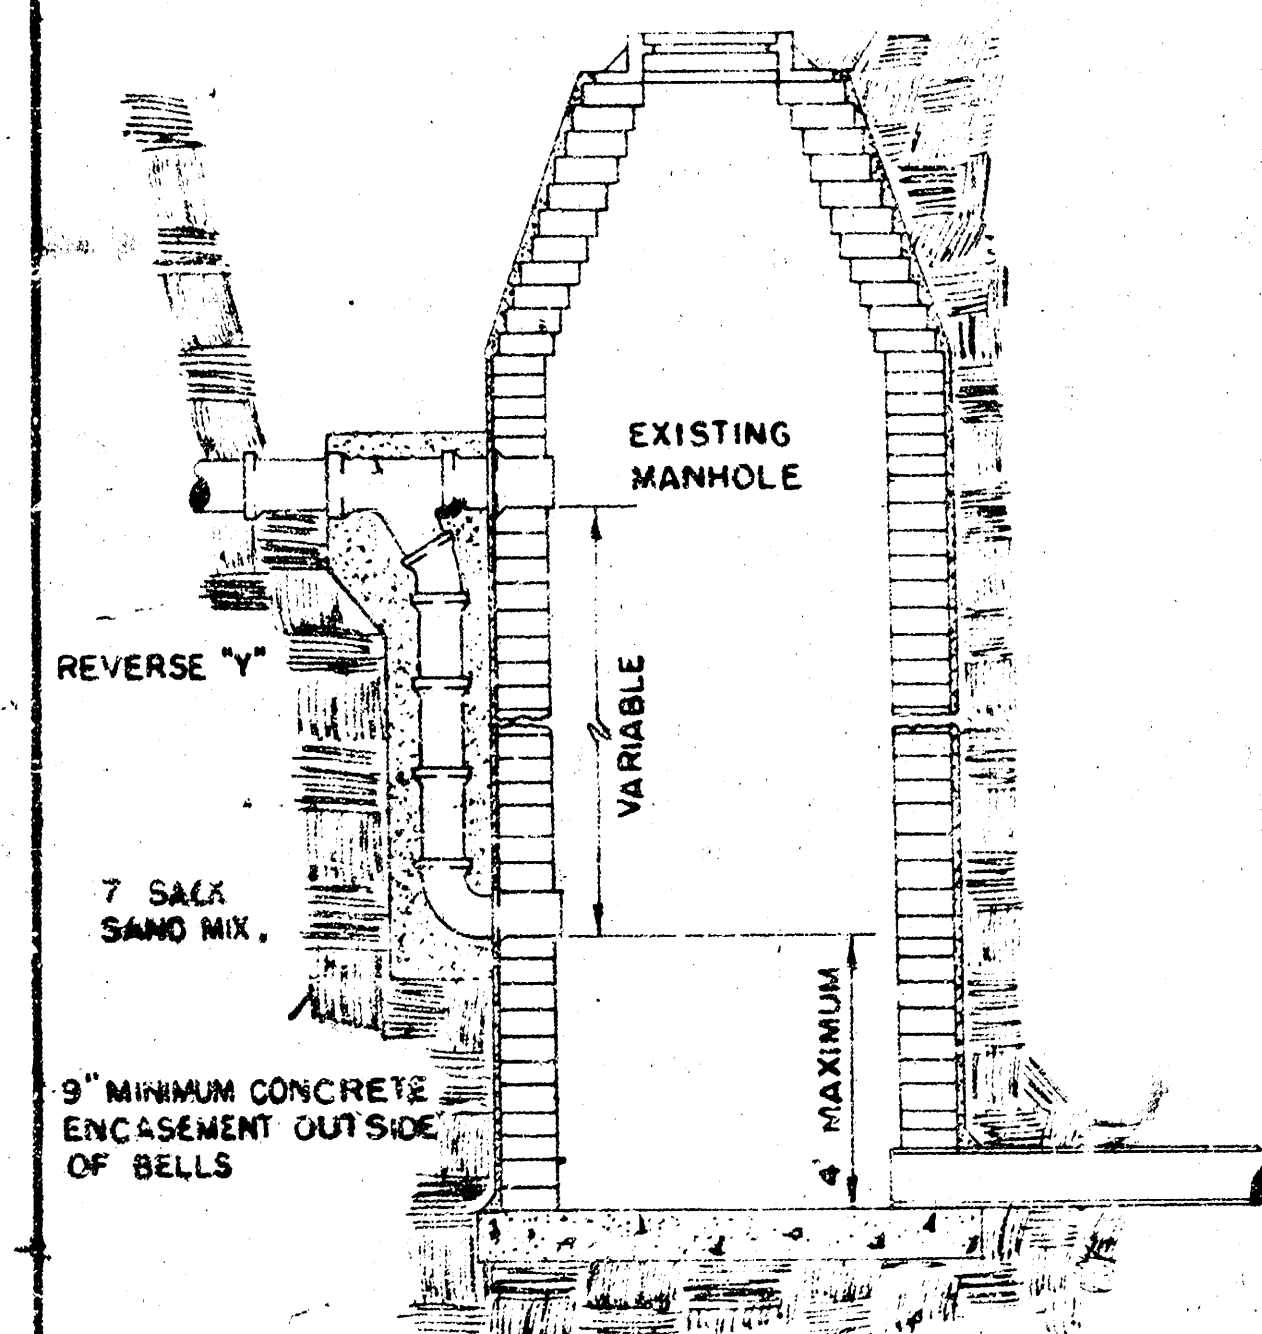


DETAIL OF DROP STACK
FOR EXISTING MANHOLES IN GROUND WATER

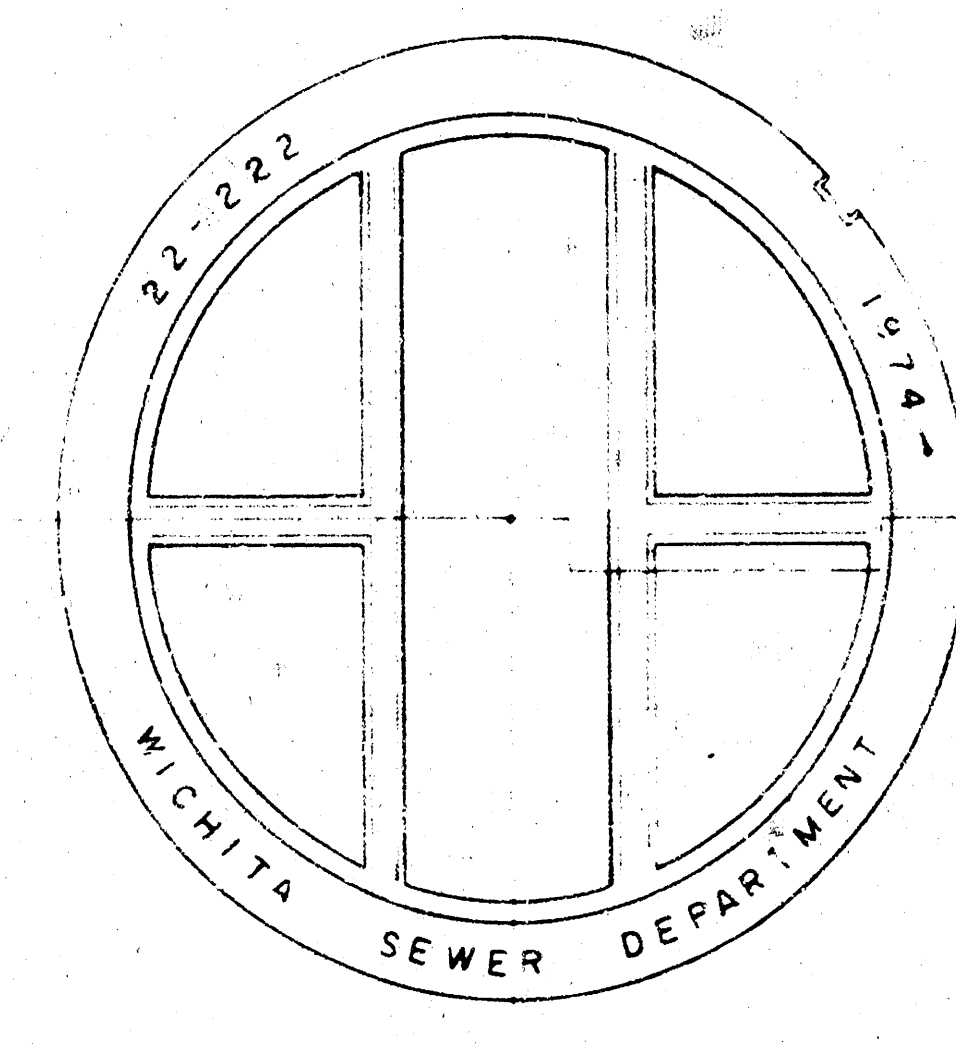


TOP VIEW
MANHOLE COVER
WEIGHT 110 LBS.

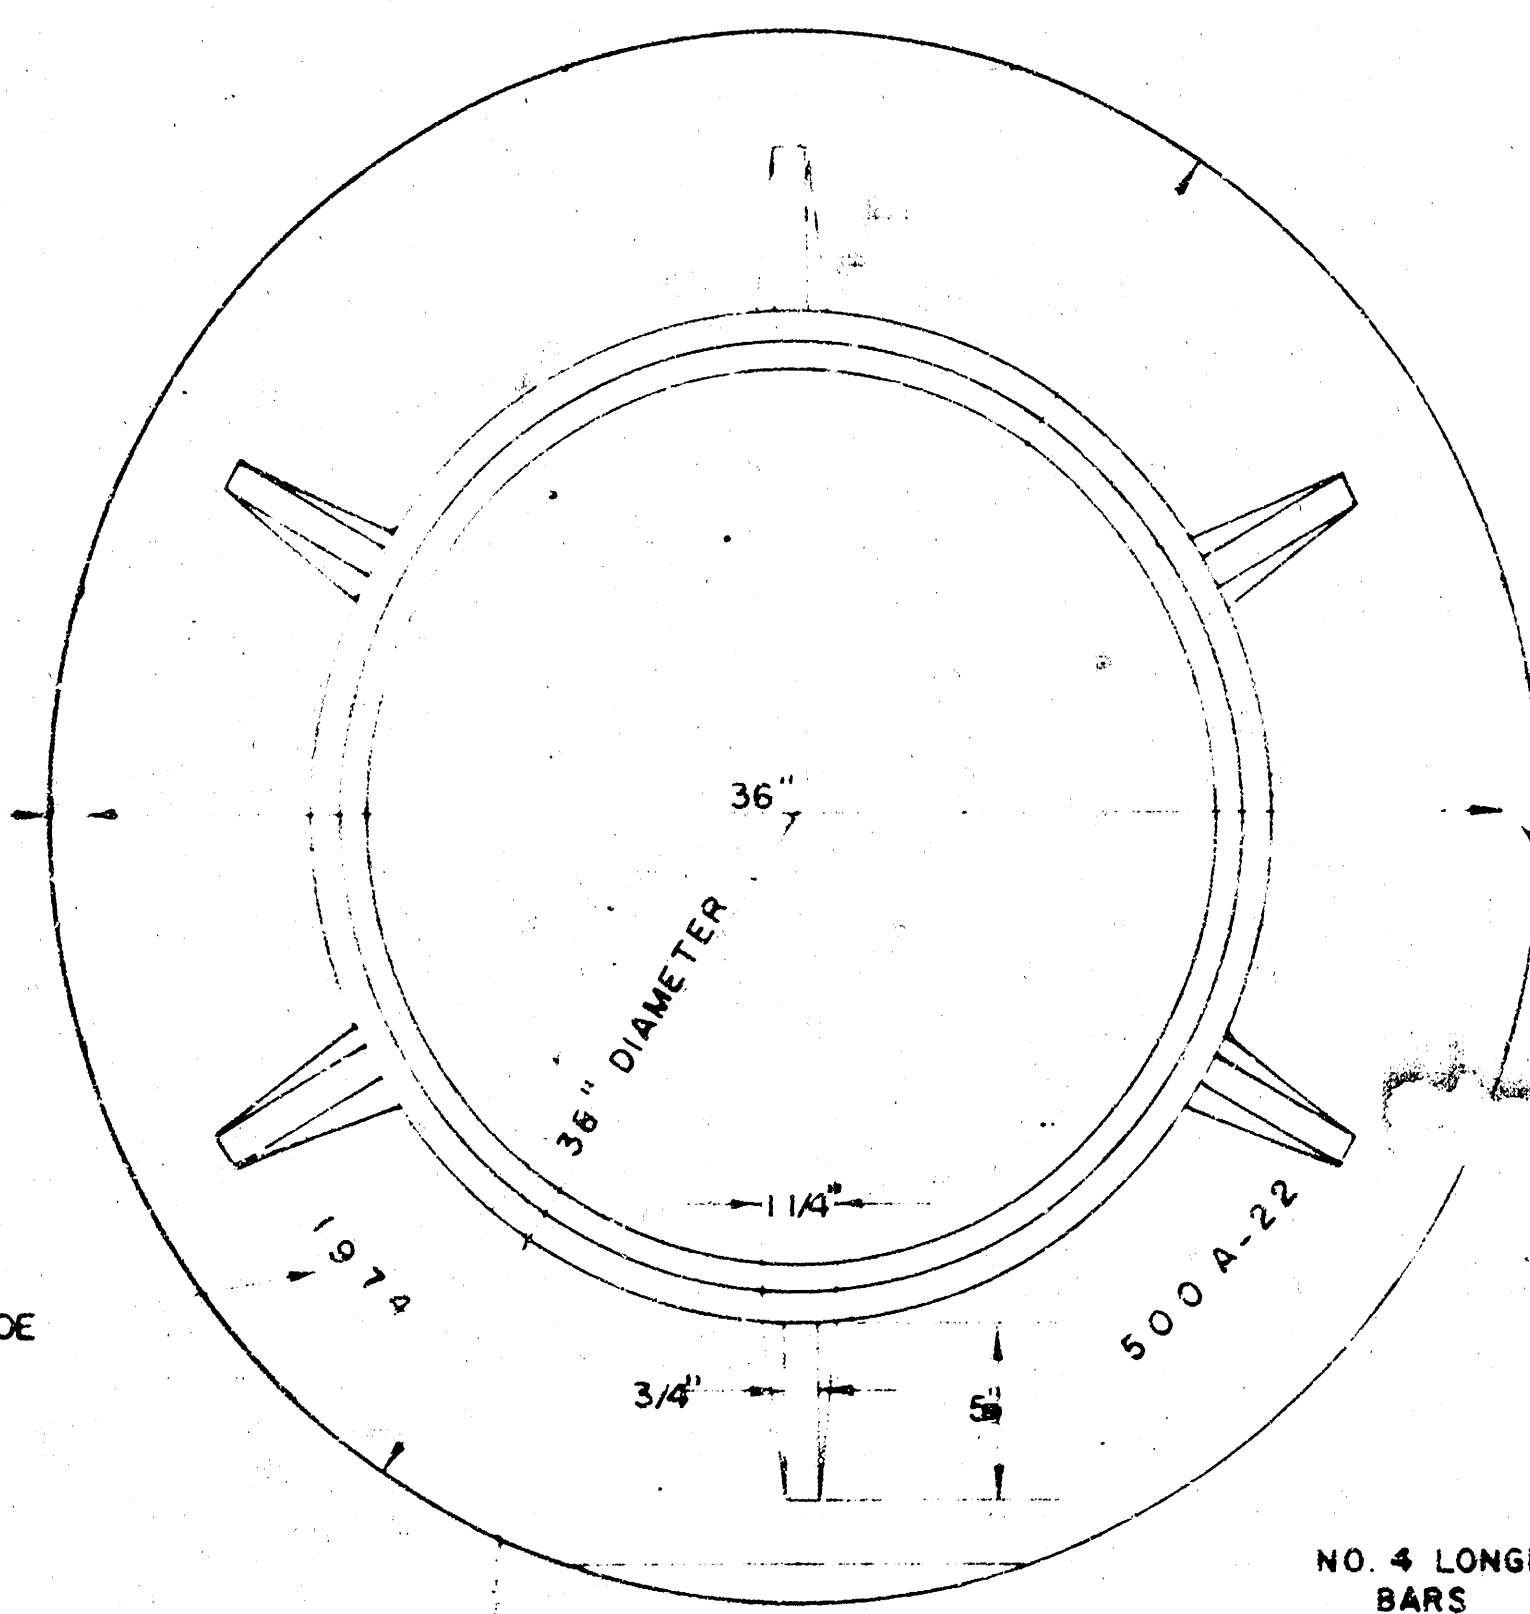

TOP VIEW
MANHOLE RING
WEIGHT 325 LBS. RING NO. 500A
WEIGHT 800 LBS. RING NO. 500AS

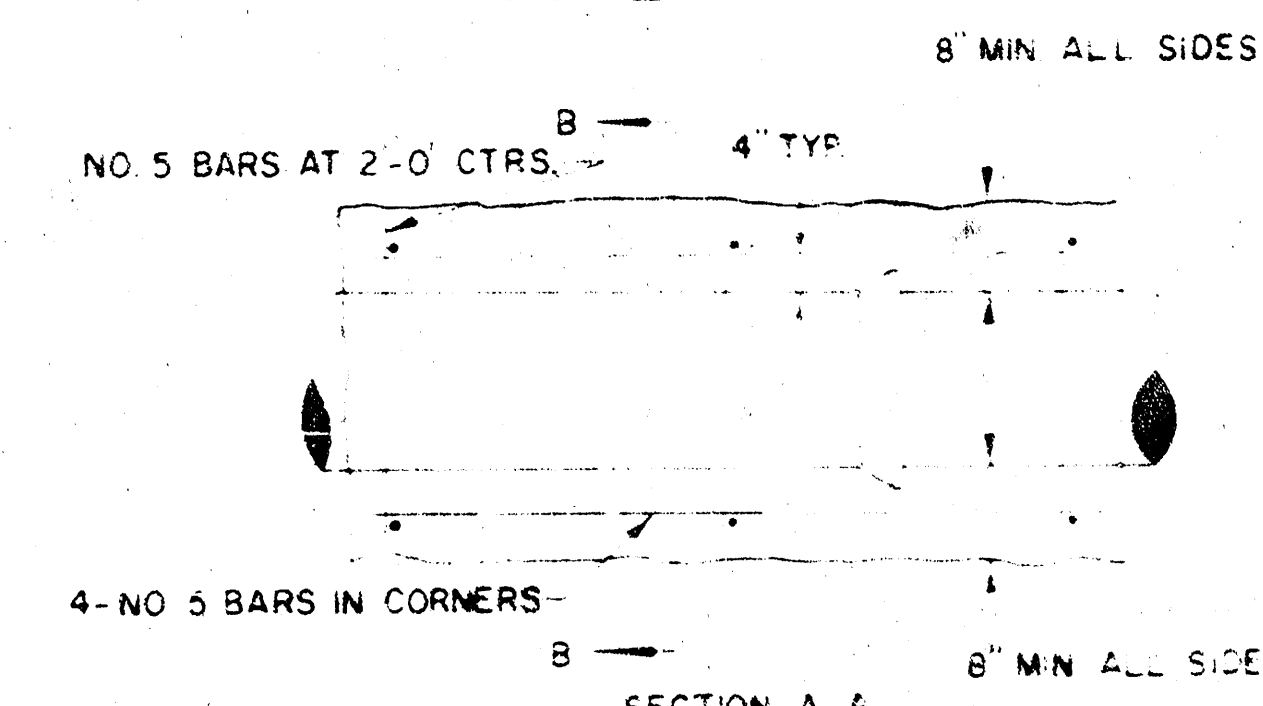


SECTION A-A
REINFORCED CONCRETE ENCASEMENT

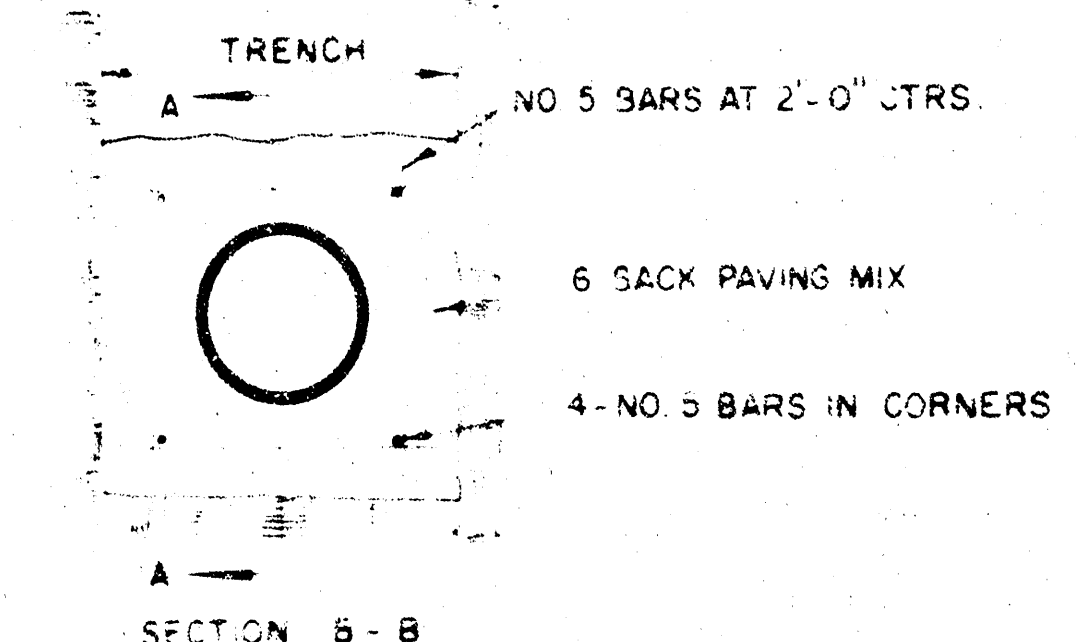


GENERAL NOTES



- MORTAR USED IN MASONRY CONSTRUCTION SHALL CONTAIN 8 SACKS OF CEMENT PER CUBIC YARD.
- STANDARD MANHOLES TYPE "A" OR TYPE "B" AND STANDARD DROP MANHOLES TYPE "A" OR TYPE "B" SHALL BE BID AS STANDARD MANHOLES FOR THE TYPE AND DIAMETER INDICATED.
- OUTSIDE DROP MANHOLES SHALL BE BID AS STANDARD OUTSIDE DROP MANHOLES FOR THE TYPE AND DIAMETER INDICATED. ALL MANHOLE DIAMETERS WILL BE 4' UNLESS INDICATED OTHERWISE.
- MANHOLES WITH PIPE SIZES LARGER THAN 24" SHALL BE 5' DIAMETER.
- THE FLOORS OF ALL MANHOLES SHALL BE SHAPED TO INCREASE HYDRAULIC EFFICIENCY USING 8 SACK SAND MIX CONCRETE.
- PIPES INSTALLED WITHIN THE MANHOLE EXCAVATION SHALL BE CRADLED WITH CONCRETE TO THE LIMITS OF THE MANHOLE EXCAVATION. COST OF CRADLE WITHIN MANHOLE EXCAVATION SHALL BE INCLUDED IN THE PRICE BID FOR THE MANHOLE.

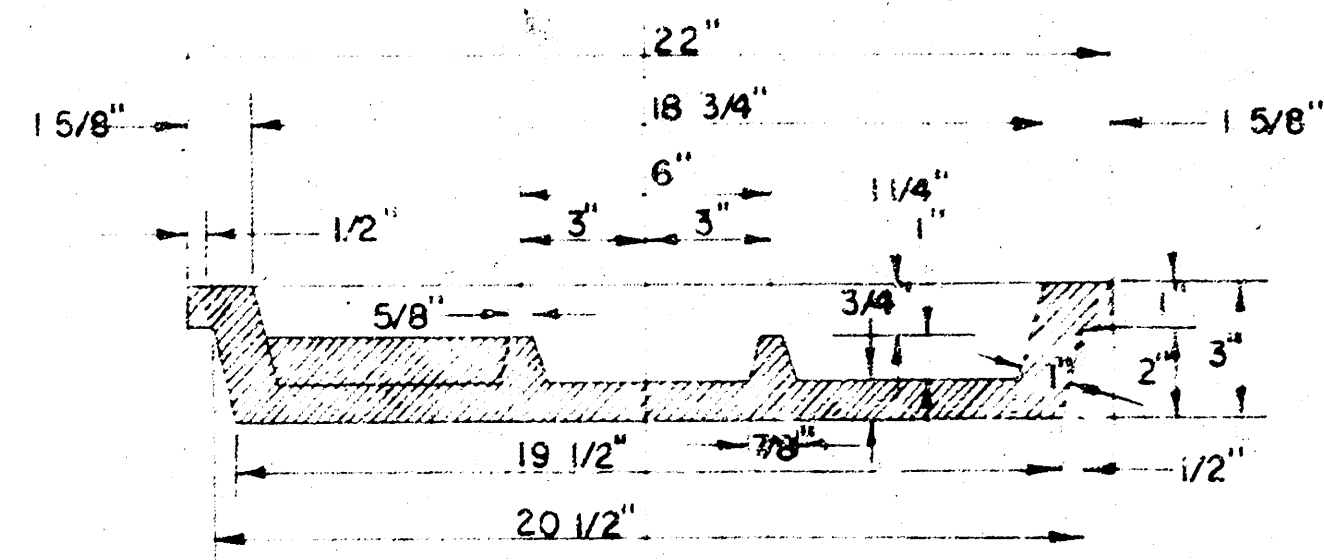

SECTION A-A
MANHOLE COVER

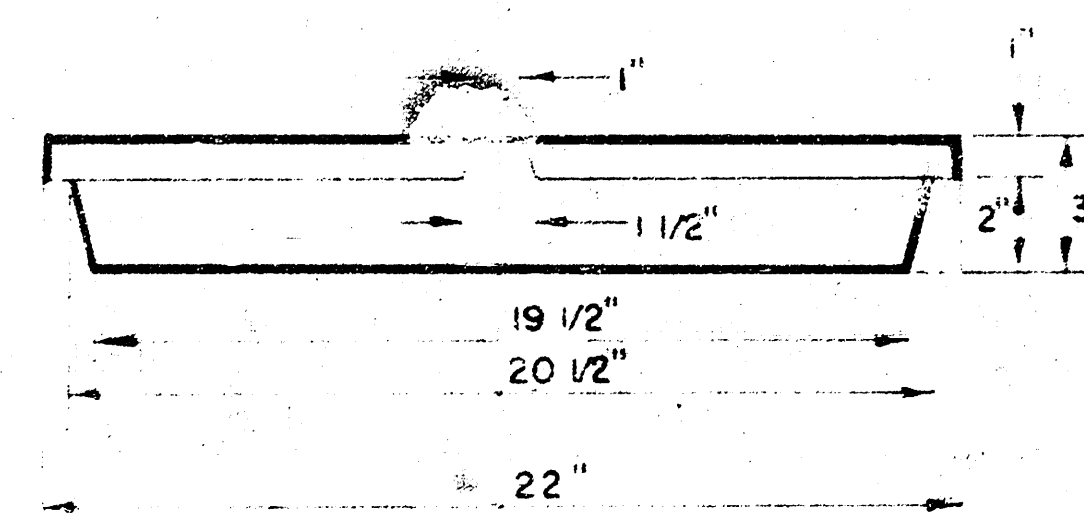


SIDE VIEW
MANHOLE COVER

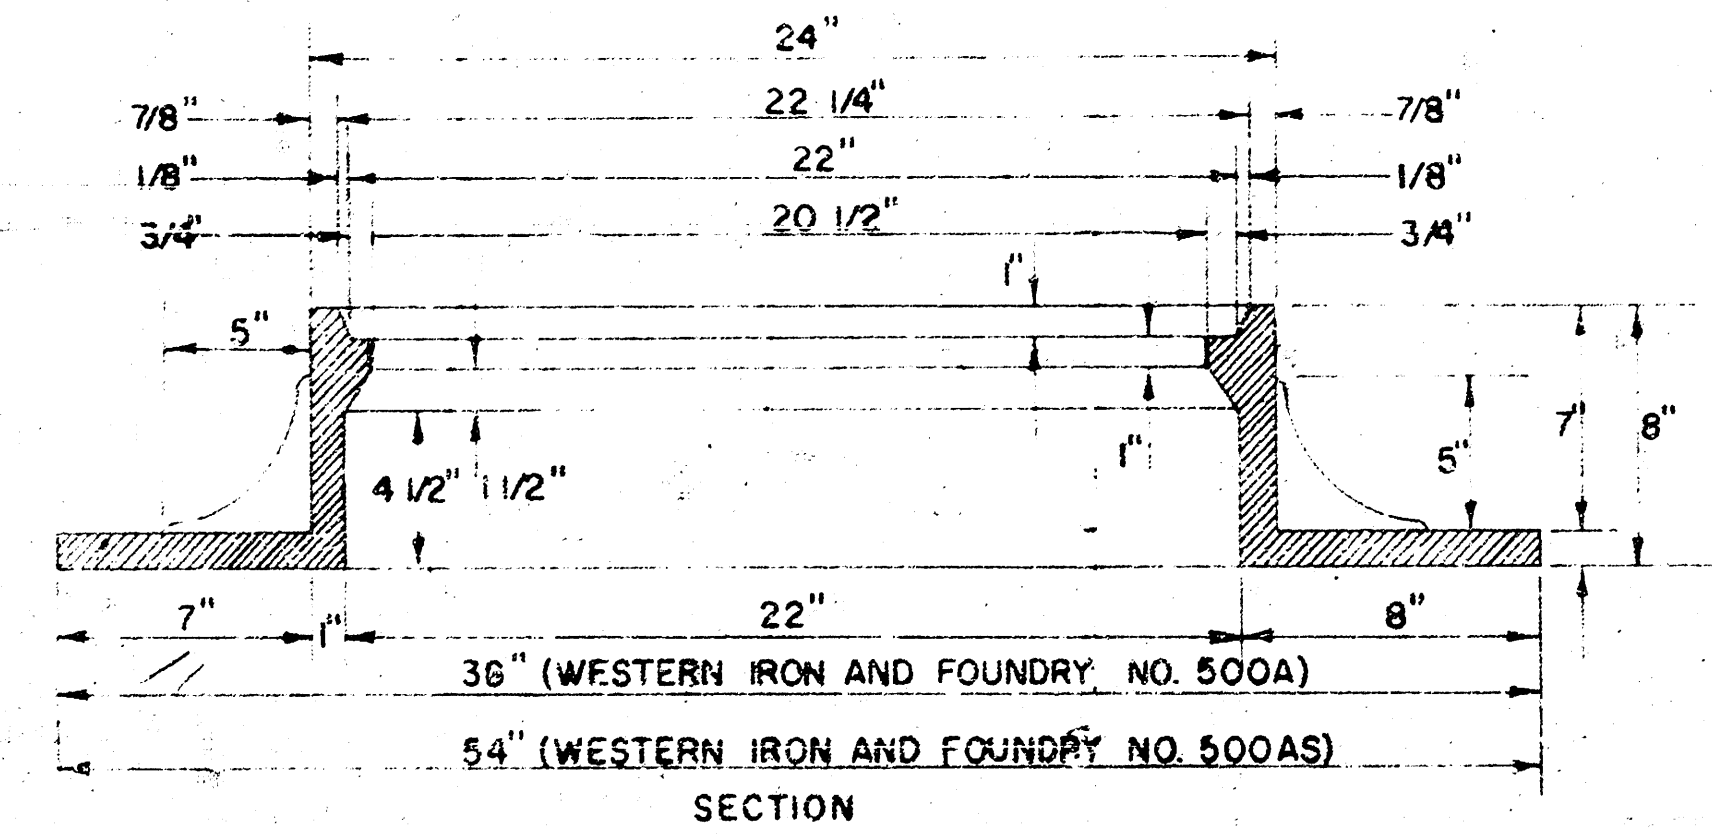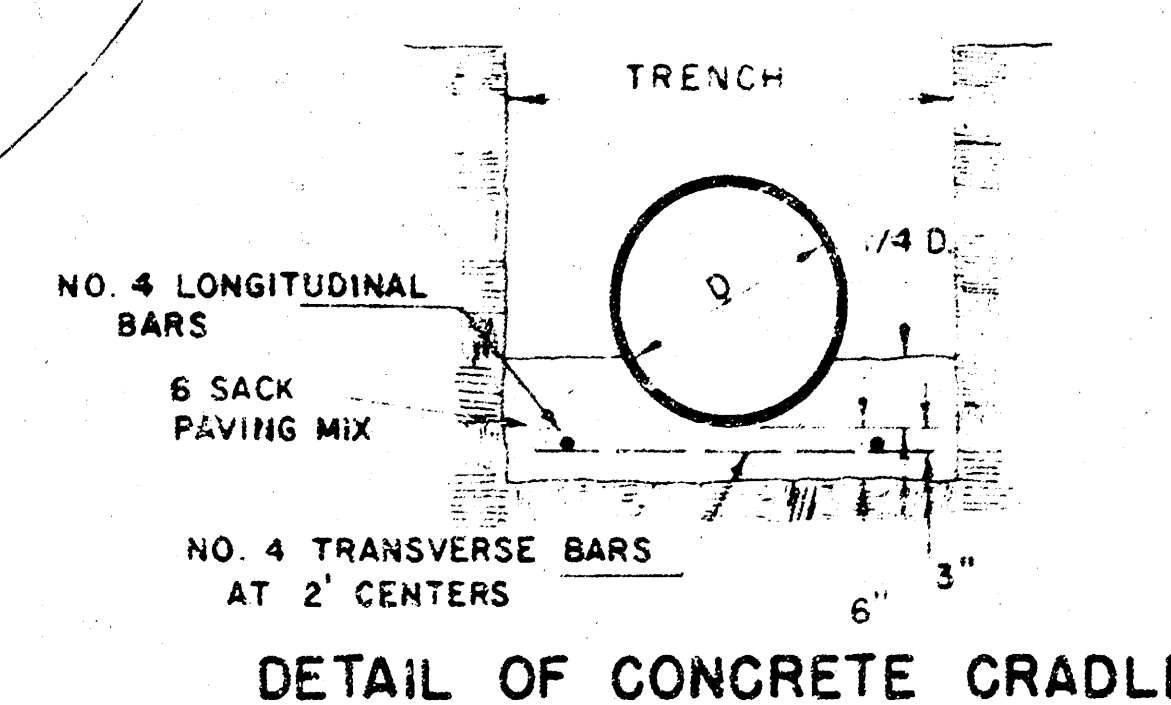

SECTION
MANHOLE RING

OUTSIDE CIRCUMFERENCE OF COVER AND THE INNER FACE AND SEAT OF RING TO BE MACHINE FIT.

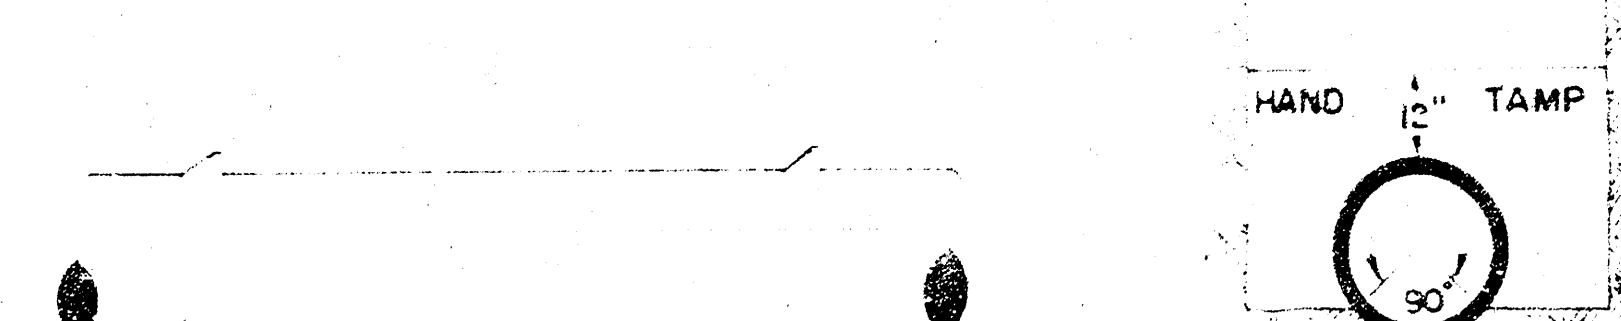

ORDINARY BEDDING METHOD
STORM SEWER PIPE



REVISED 4-13-77

DETAILS OF
SEWER APPURTENANCES
ADOPTED AS STANDARD DESIGN
BY
ENGINEERING DIVISION
CITY OF WICHITA, KANSAS
R. W. LINN CITY ENGINEER
1974


Sht. 2 of 5

STANDARD MANHOLE, TYPE "C"


RING AND LID AS SPECIFIED

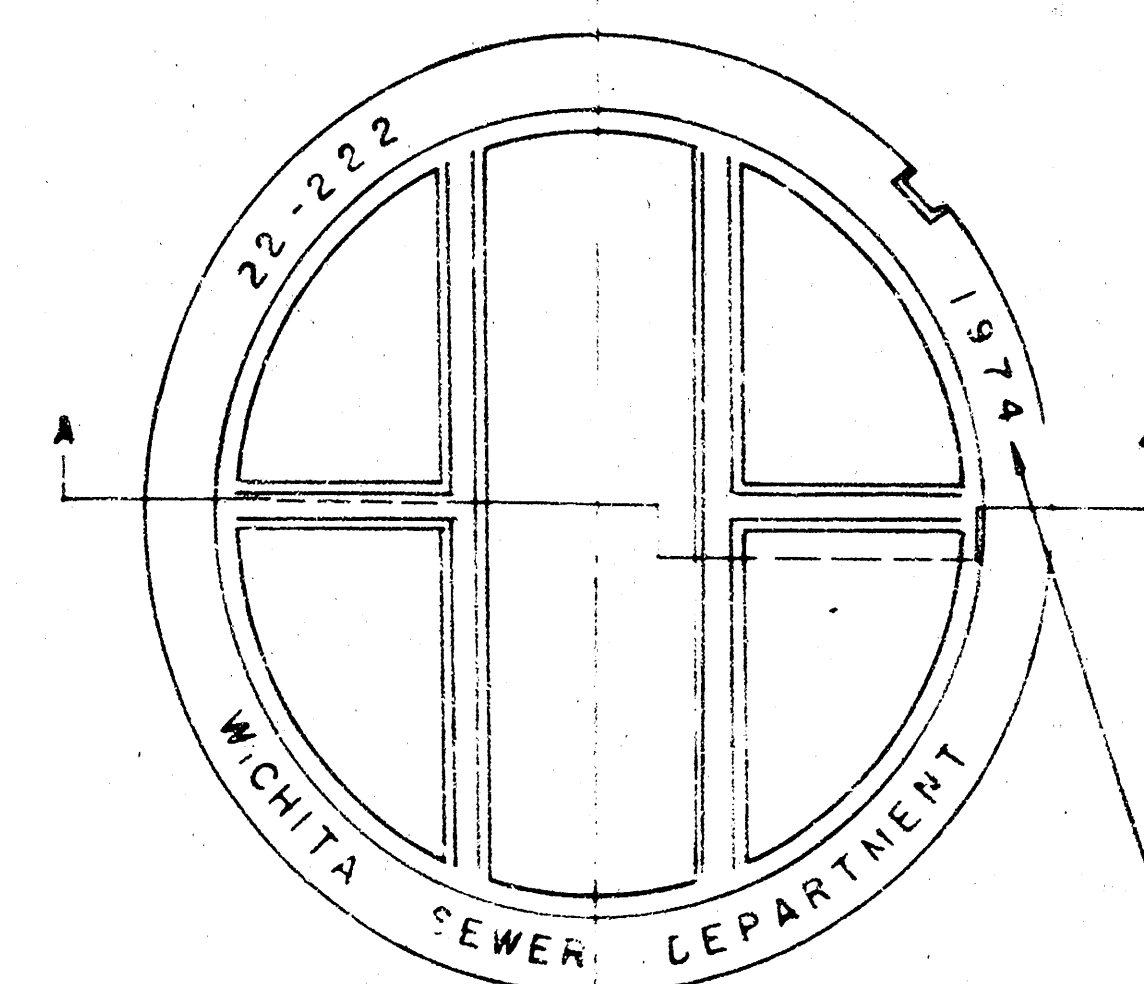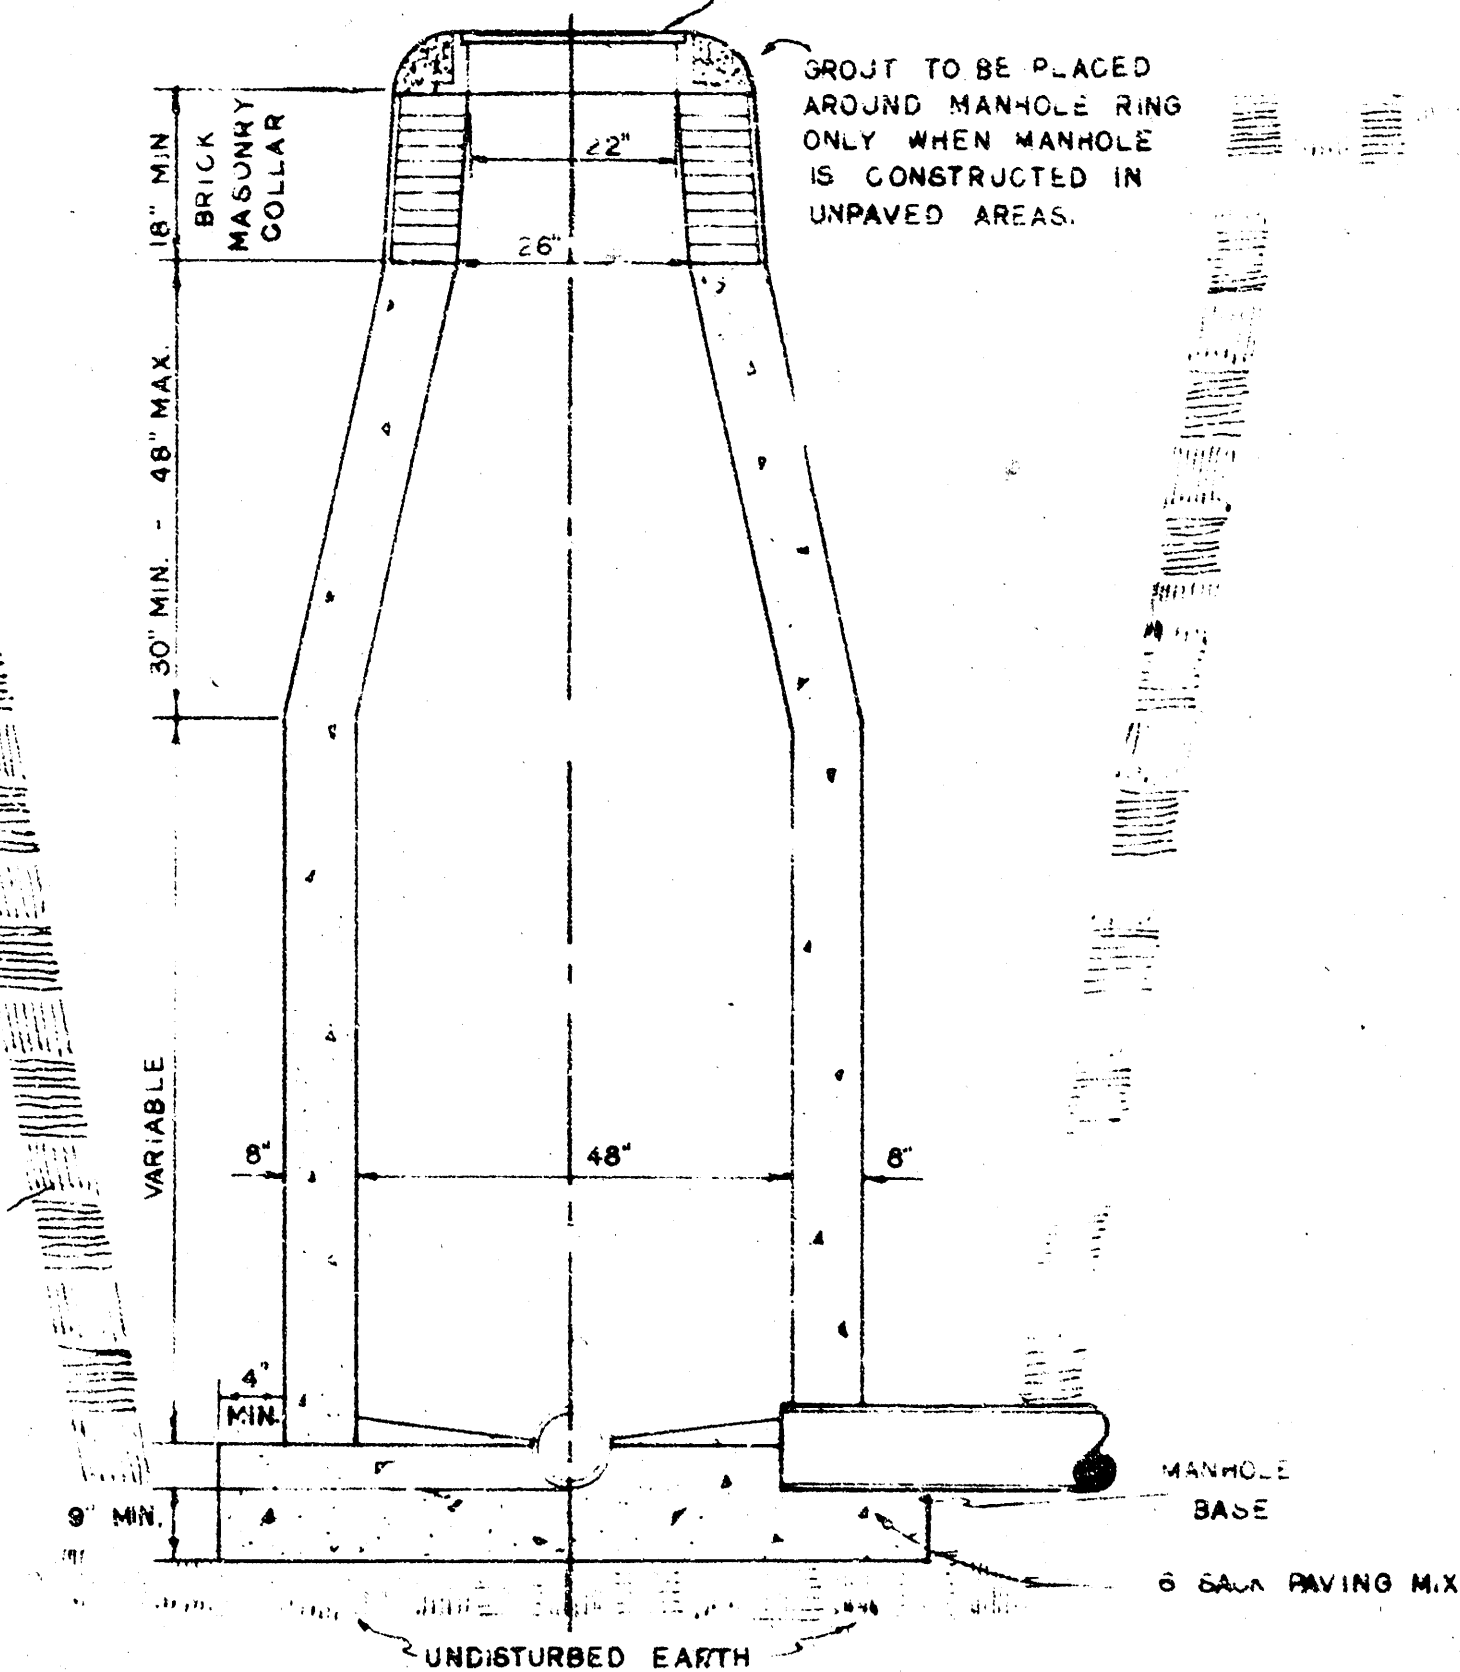

MANHOLE COVER

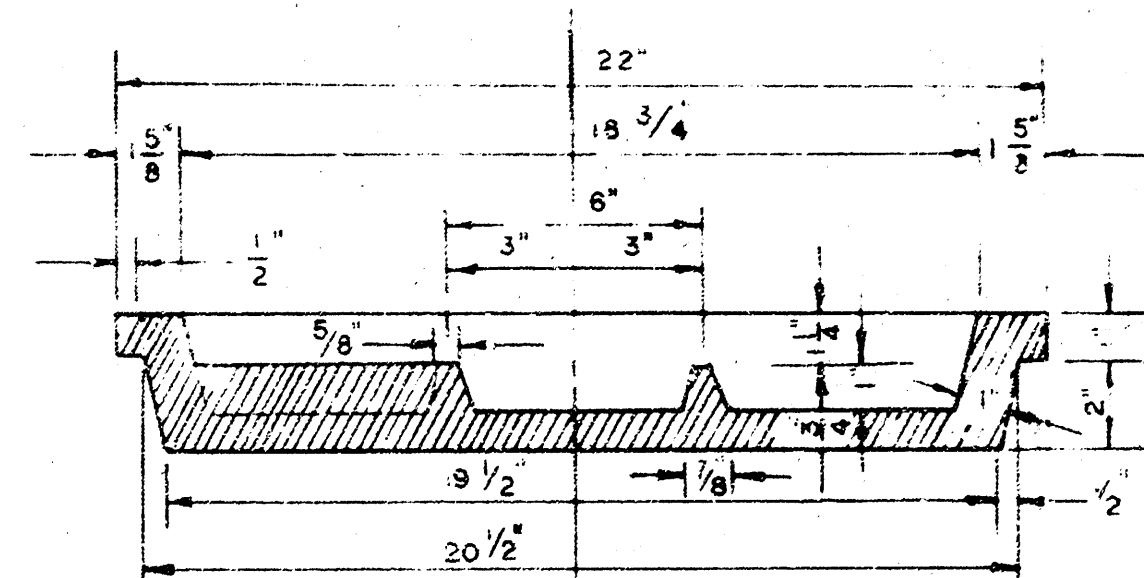



MANHOLE COVER

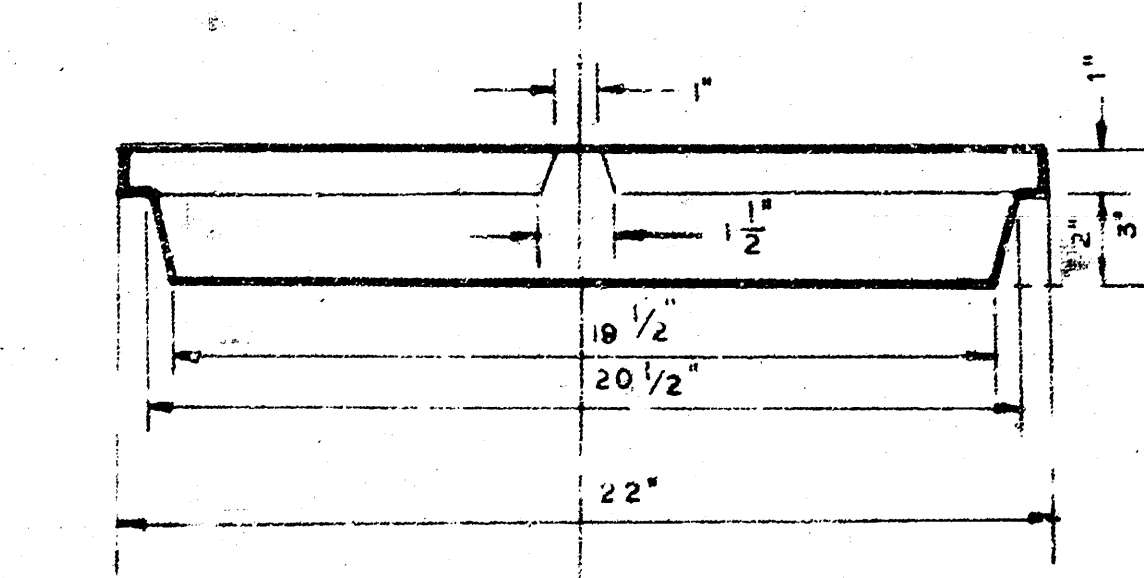

MANHOLE COVER


DROP MANHOLE, TYPE "C"

RING AND LID AS SPECIFIED

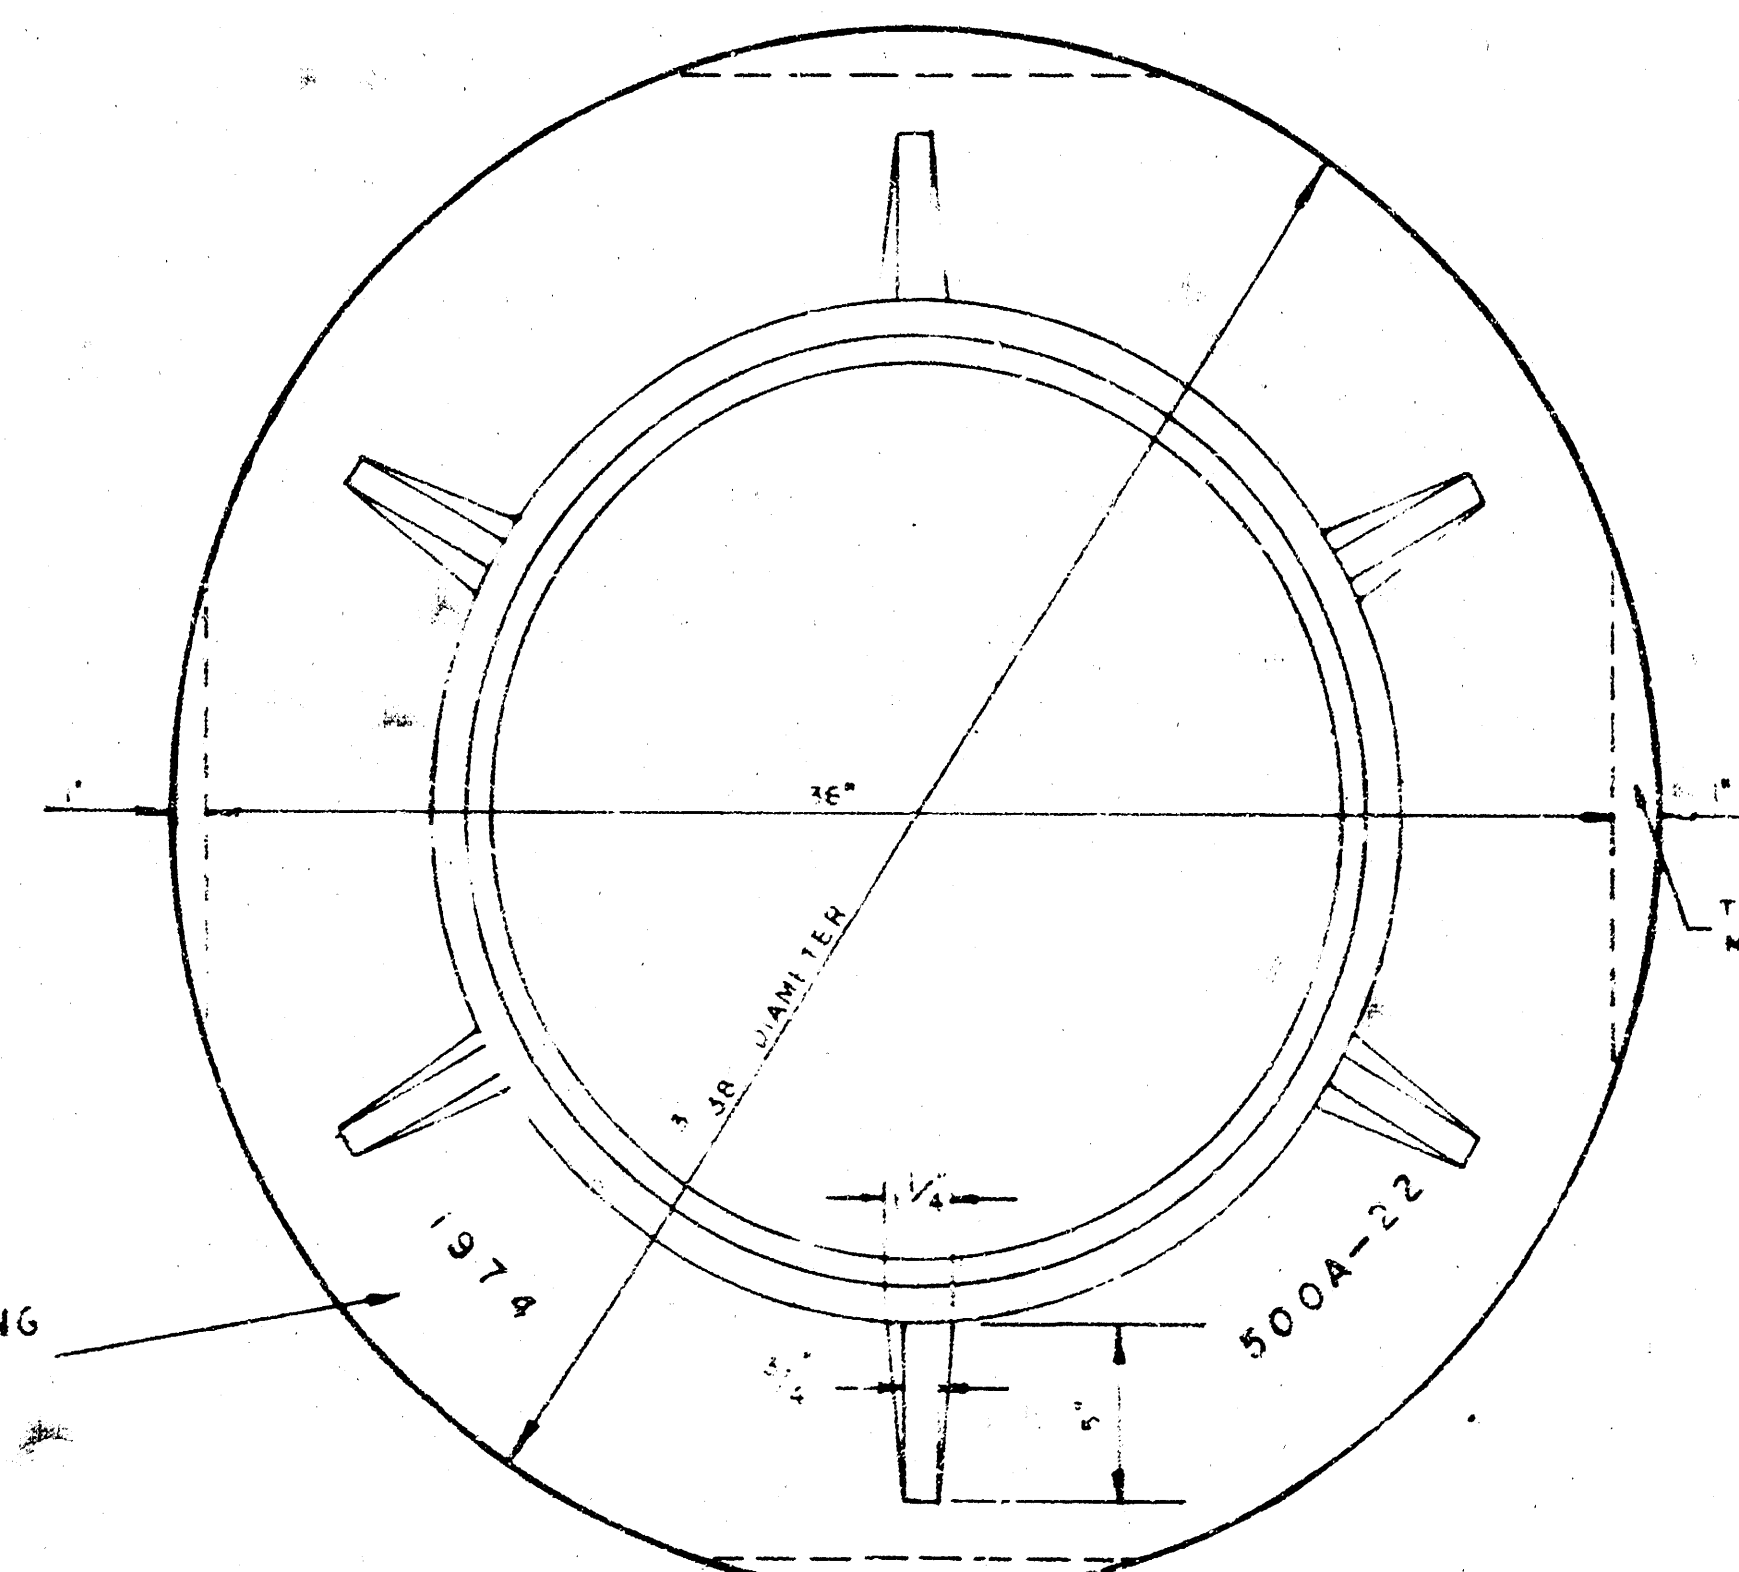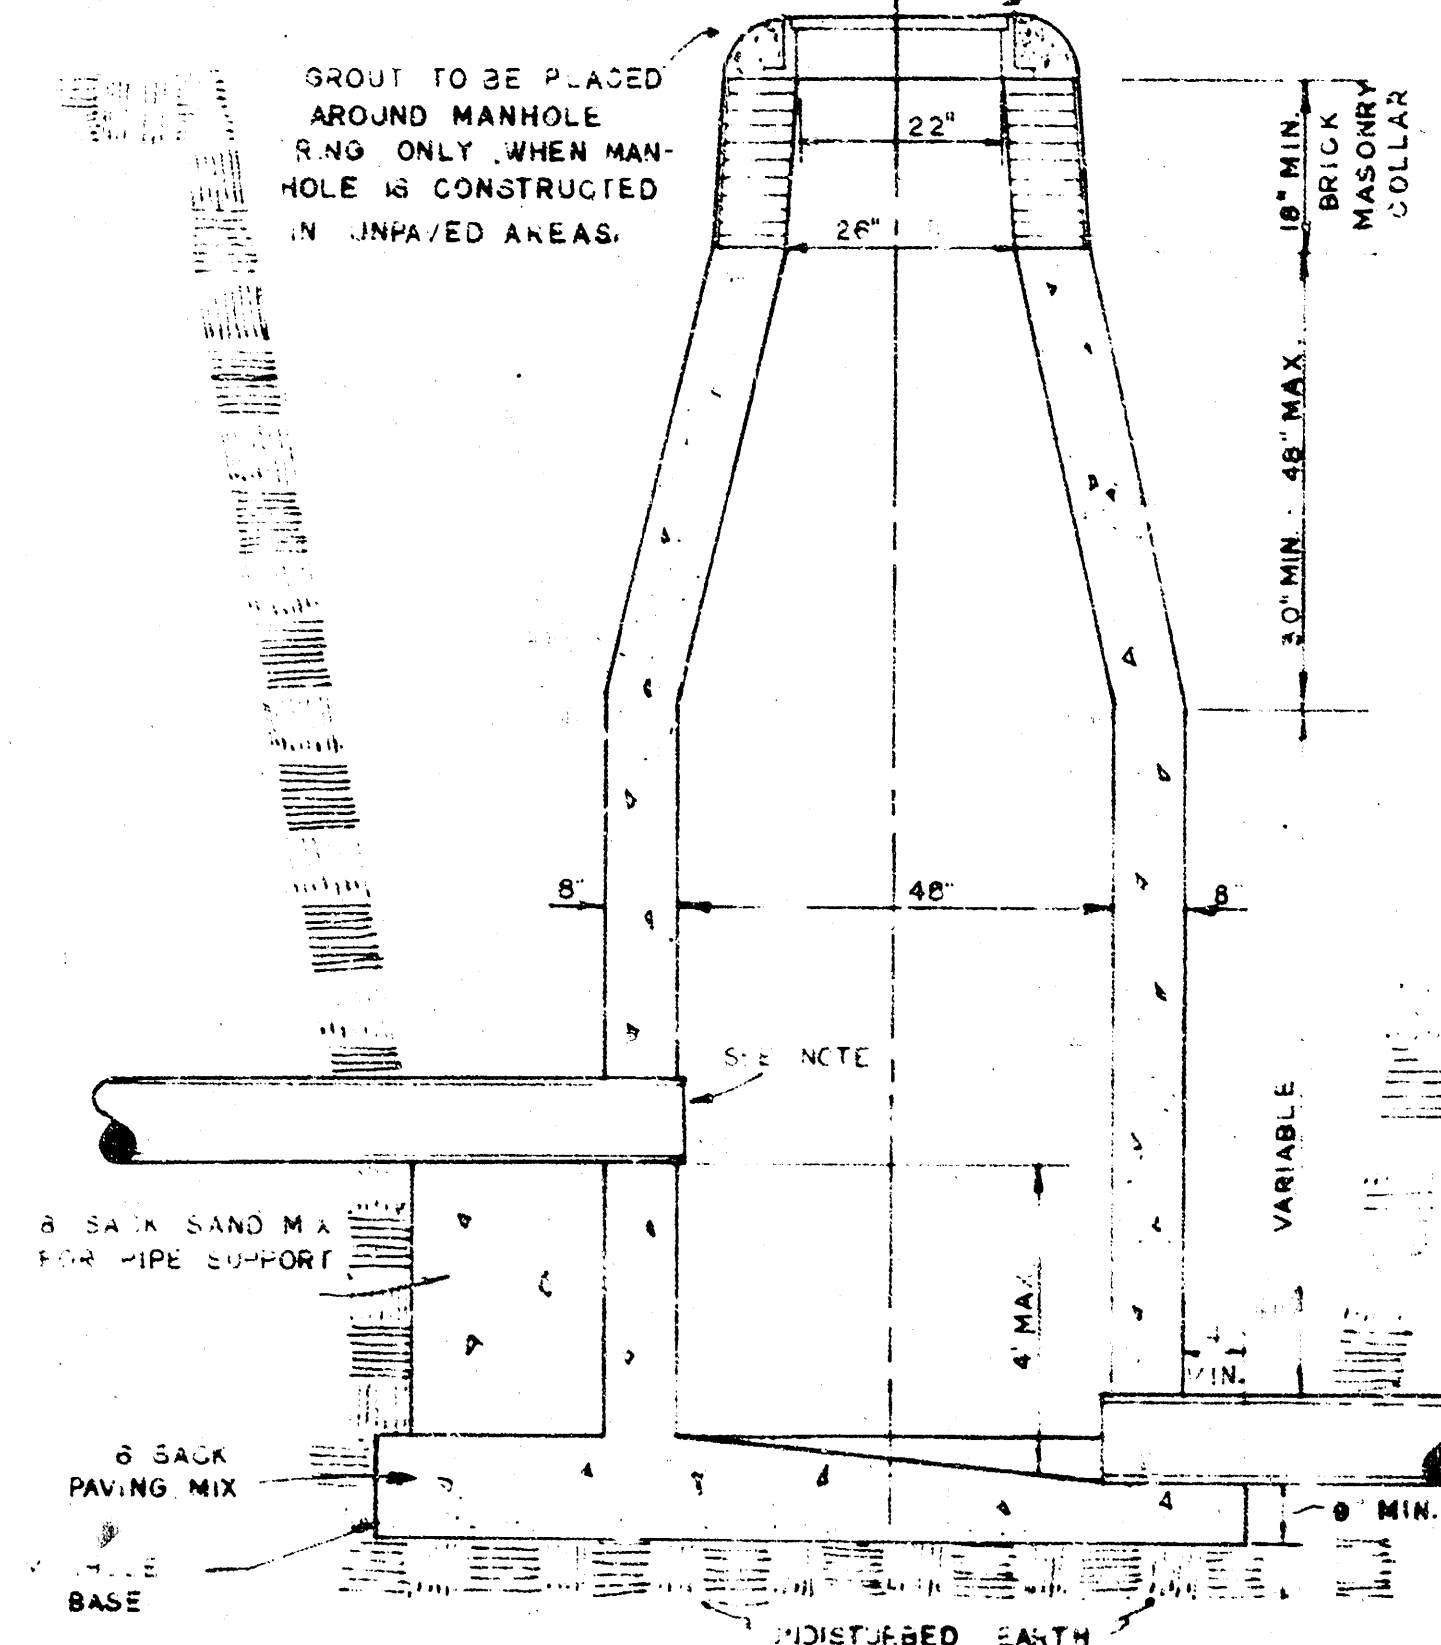

MANHOLE RING


WEIGHT 325 LBS. RING NO. 500A
WEIGHT 800 LBS. RING NO. 500AS

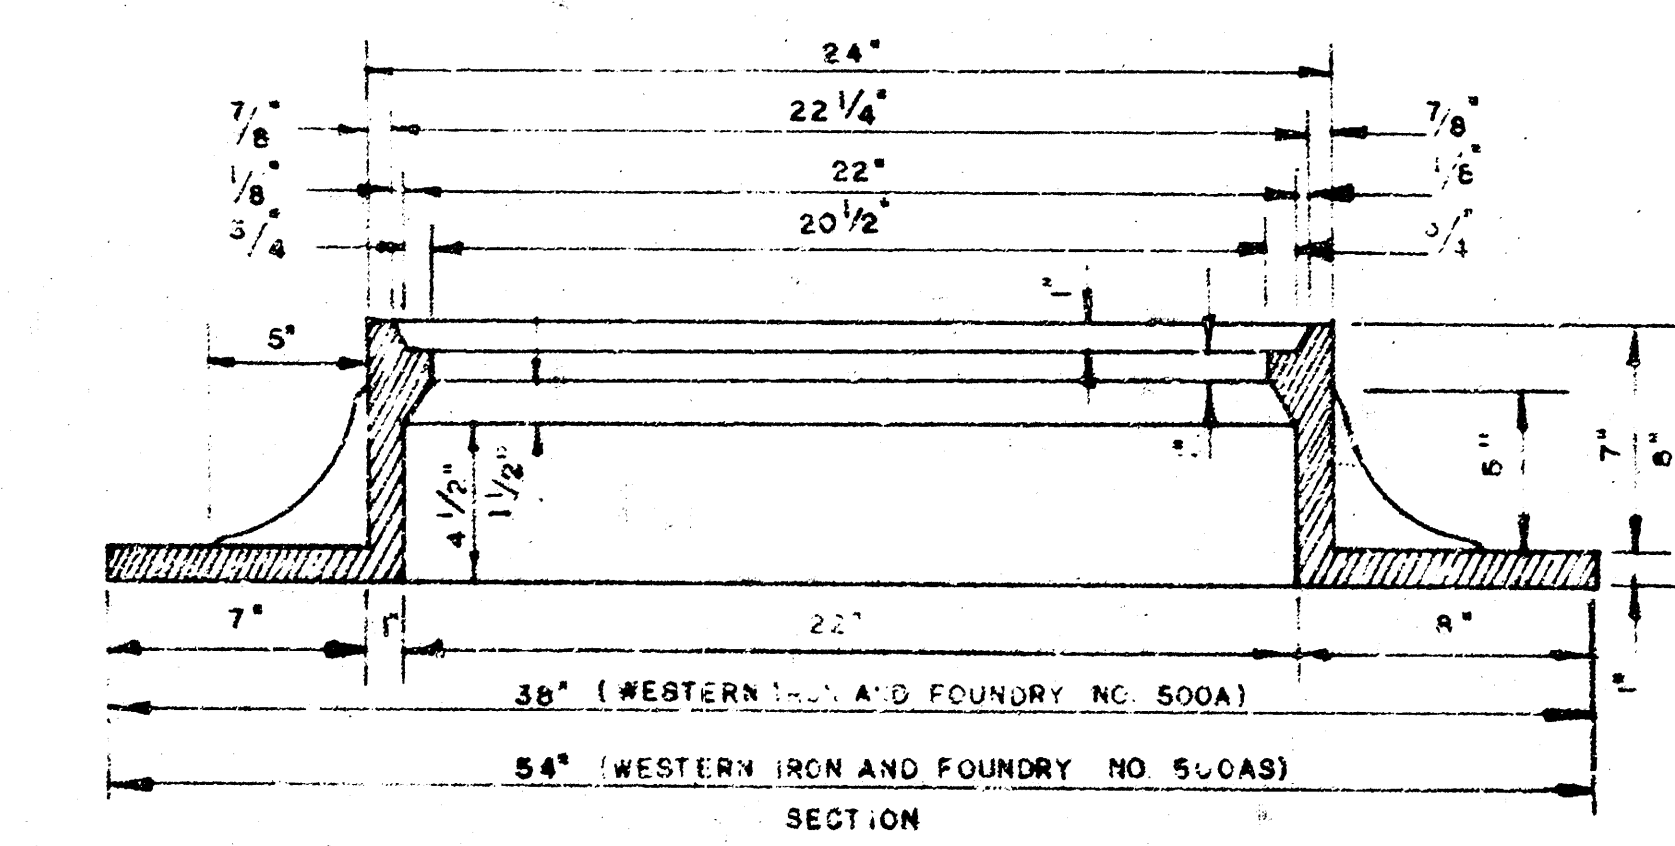


MANHOLE RING

OUTSIDE DROP MANHOLE, TYPE "C"

RING AND LID AS SPECIFIED

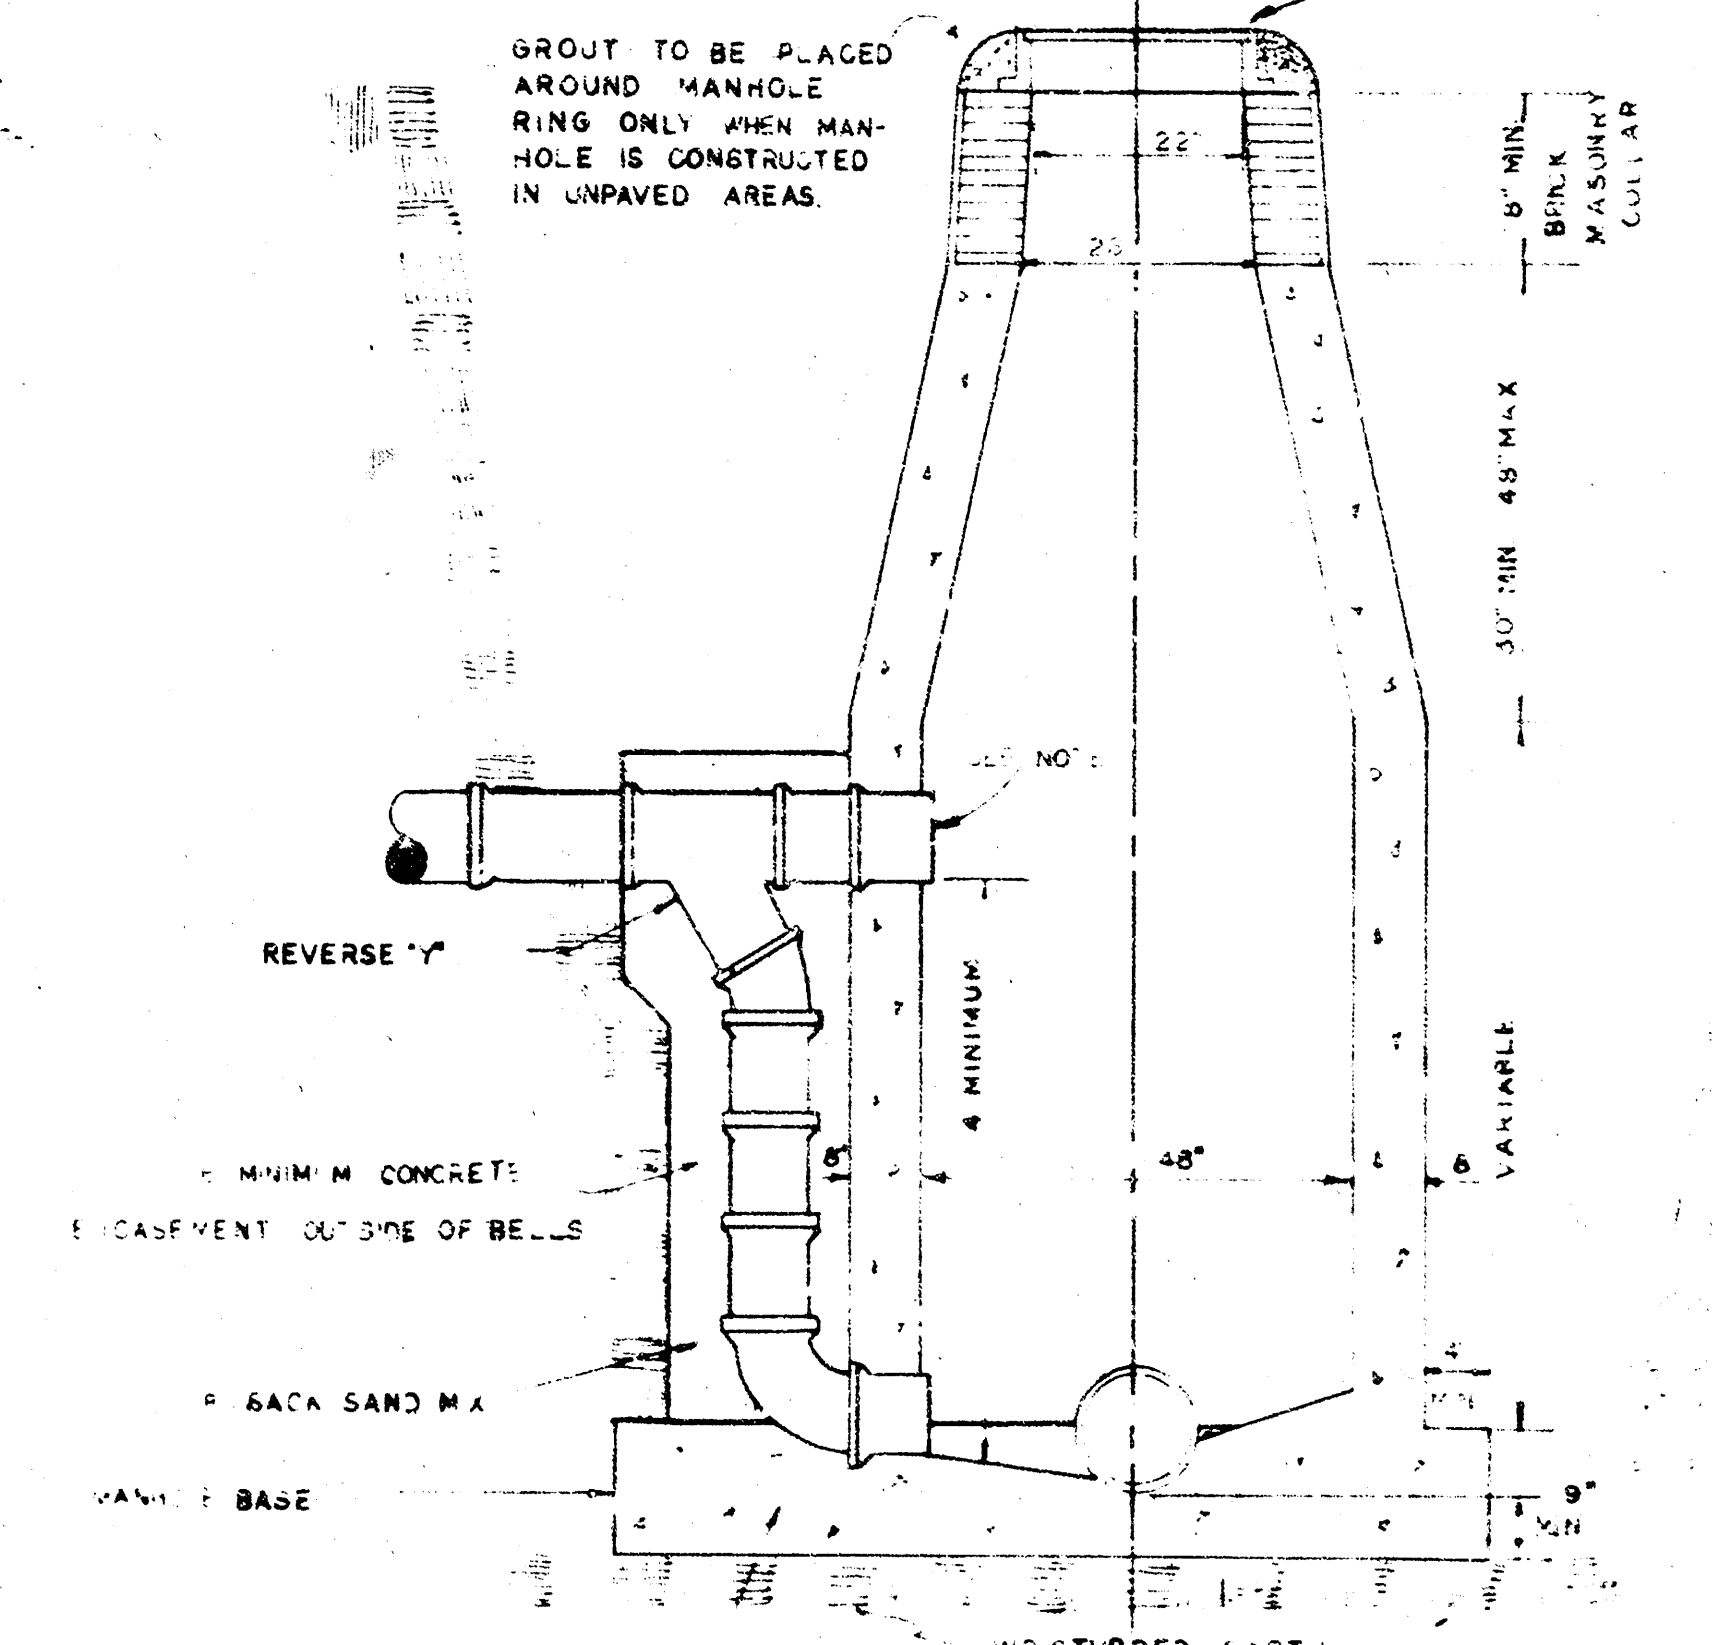

NOTE: REINFORCING STEEL SHALL BE INSTALLED IN THE MANHOLE BASES 6" ABOVE THE BOTTOM. REINFORCING STEEL SHALL CONSIST OF NO. 4 BARS PLACED ON 6" CENTERS IN BOTH DIRECTIONS. THE COST OF REINFORCING STEEL IS TO BE INCLUDED IN THE PRICE BID FOR THE MANHOLE.

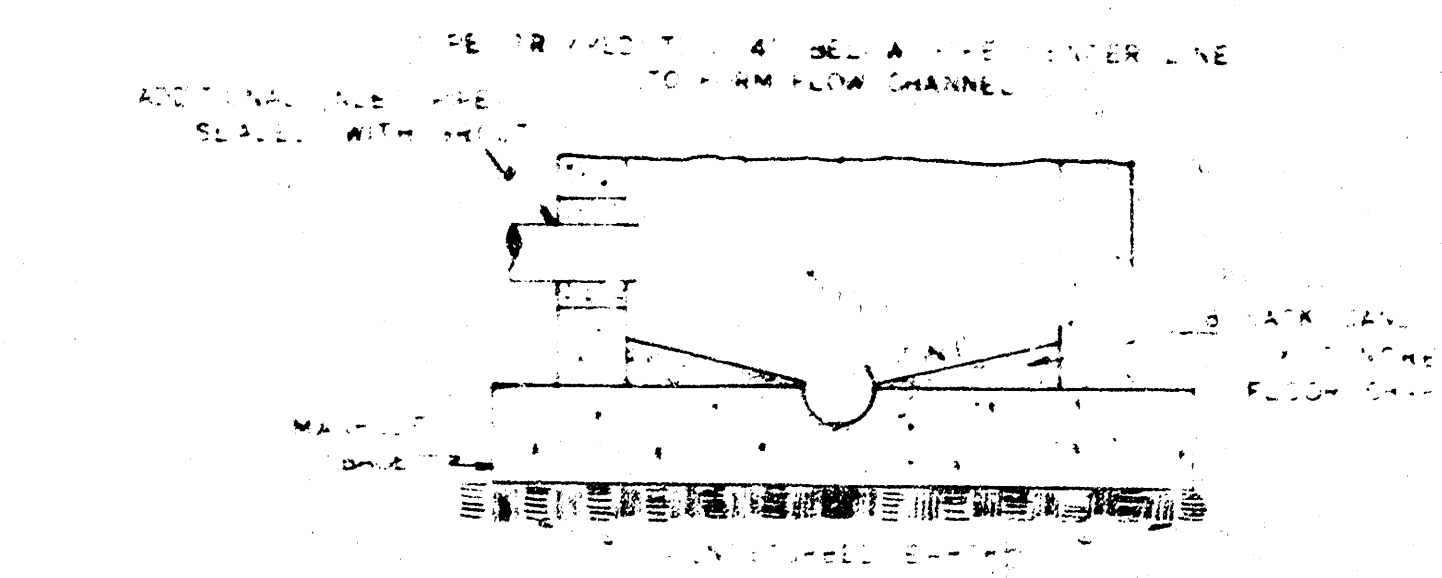

SECTIONAL ELEVATION-INVERT

NOTE: OPENING FOR INLET PIPE CUT IN MANHOLE WALL AND PIPE GROUTED IN PLACE WITH NON-SHRINKING GROUT. EXTERIOR OF COMPLETED CONNECTION TO BE SEALED WITH APPROVED COATING.

GENERAL NOTES

MORTAR USED IN MASONRY CONSTRUCTION SHALL CONTAIN 8 SACKS OF CEMENT PER CUBIC YARD.

STANDARD MANHOLES TYPE "C" AND STANDARD DROP MANHOLES TYPE "C" SHALL BE BID AS STANDARD MANHOLES FOR THE TYPE AND DIAMETER INDICATED.

OUTSIDE DROP MANHOLES TYPE "C" SHALL BE BID AS STANDARD OUTSIDE DROP MANHOLES FOR THE TYPE AND DIAMETER INDICATED. ALL MANHOLE DIAMETERS WILL BE 4 FT. UNLESS INDICATED OTHERWISE. MANHOLES WITH PIPE SIZES LARGER THAN 24" SHALL BE 5 FT. DIAMETER.

THE FLOORS OF ALL MANHOLES SHALL BE SHAPED TO INCREASE HYDRAULIC EFFICIENCY USING 8 SACK SAND MIX CONCRETE.

CAST IN PLACE CIRCULAR CONCRETE MANHOLES ARE TO BE CONSTRUCTED ONLY ON SEWERS NOT SUBJECT TO DETERIORATION OF CONCRETE DUE TO FORMATION OF HYDROGEN SULFIDE GAS AND IN LOCATIONS WHERE IT IS OBVIOUS THAT ANY ADJUSTMENT OF THE MANHOLE TOP ELEVATION WHICH MAY BE NECESSARY WILL NOT REQUIRE MODIFICATION OF THE CONCRETE BARREL.

PIPES INSTALLED WITHIN THE MANHOLE EXCAVATION SHALL BE CRADLED WITH CONCRETE TO THE LIMITS OF THE MANHOLE EXCAVATION. COST OF CRADLE WITHIN MANHOLE EXCAVATION SHALL BE INCLUDED IN THE PRICE BID FOR THE MANHOLE.

REVISED 4-13-77

DETAILS OF
SEWER APPURTENANCES
ADOPTED AS STANDARD DESIGN
BY
ENGINEERING DIVISION
CITY OF WICHITA, KANSAS
R. W. LINN CITY ENGINEER
1974

SH. 9 of SH. 9