



B.M. 127.21 SE Cor. Conc. M.H. Base Approx. 62' S. of N.L. 30th St. N. and 42' E. of EL MOSLEY
 B.M. 129.32 RR Spt. N. Face P.P. SW Cor. 30th St. N. and St. FRANCIS Being 1st P.P. S. of RR Tracks

SCALE
 PLAN 1" = 40'
 PROFILE 1" = 40'
 Horiz 1" = 40'
 Vert 1" = 5'

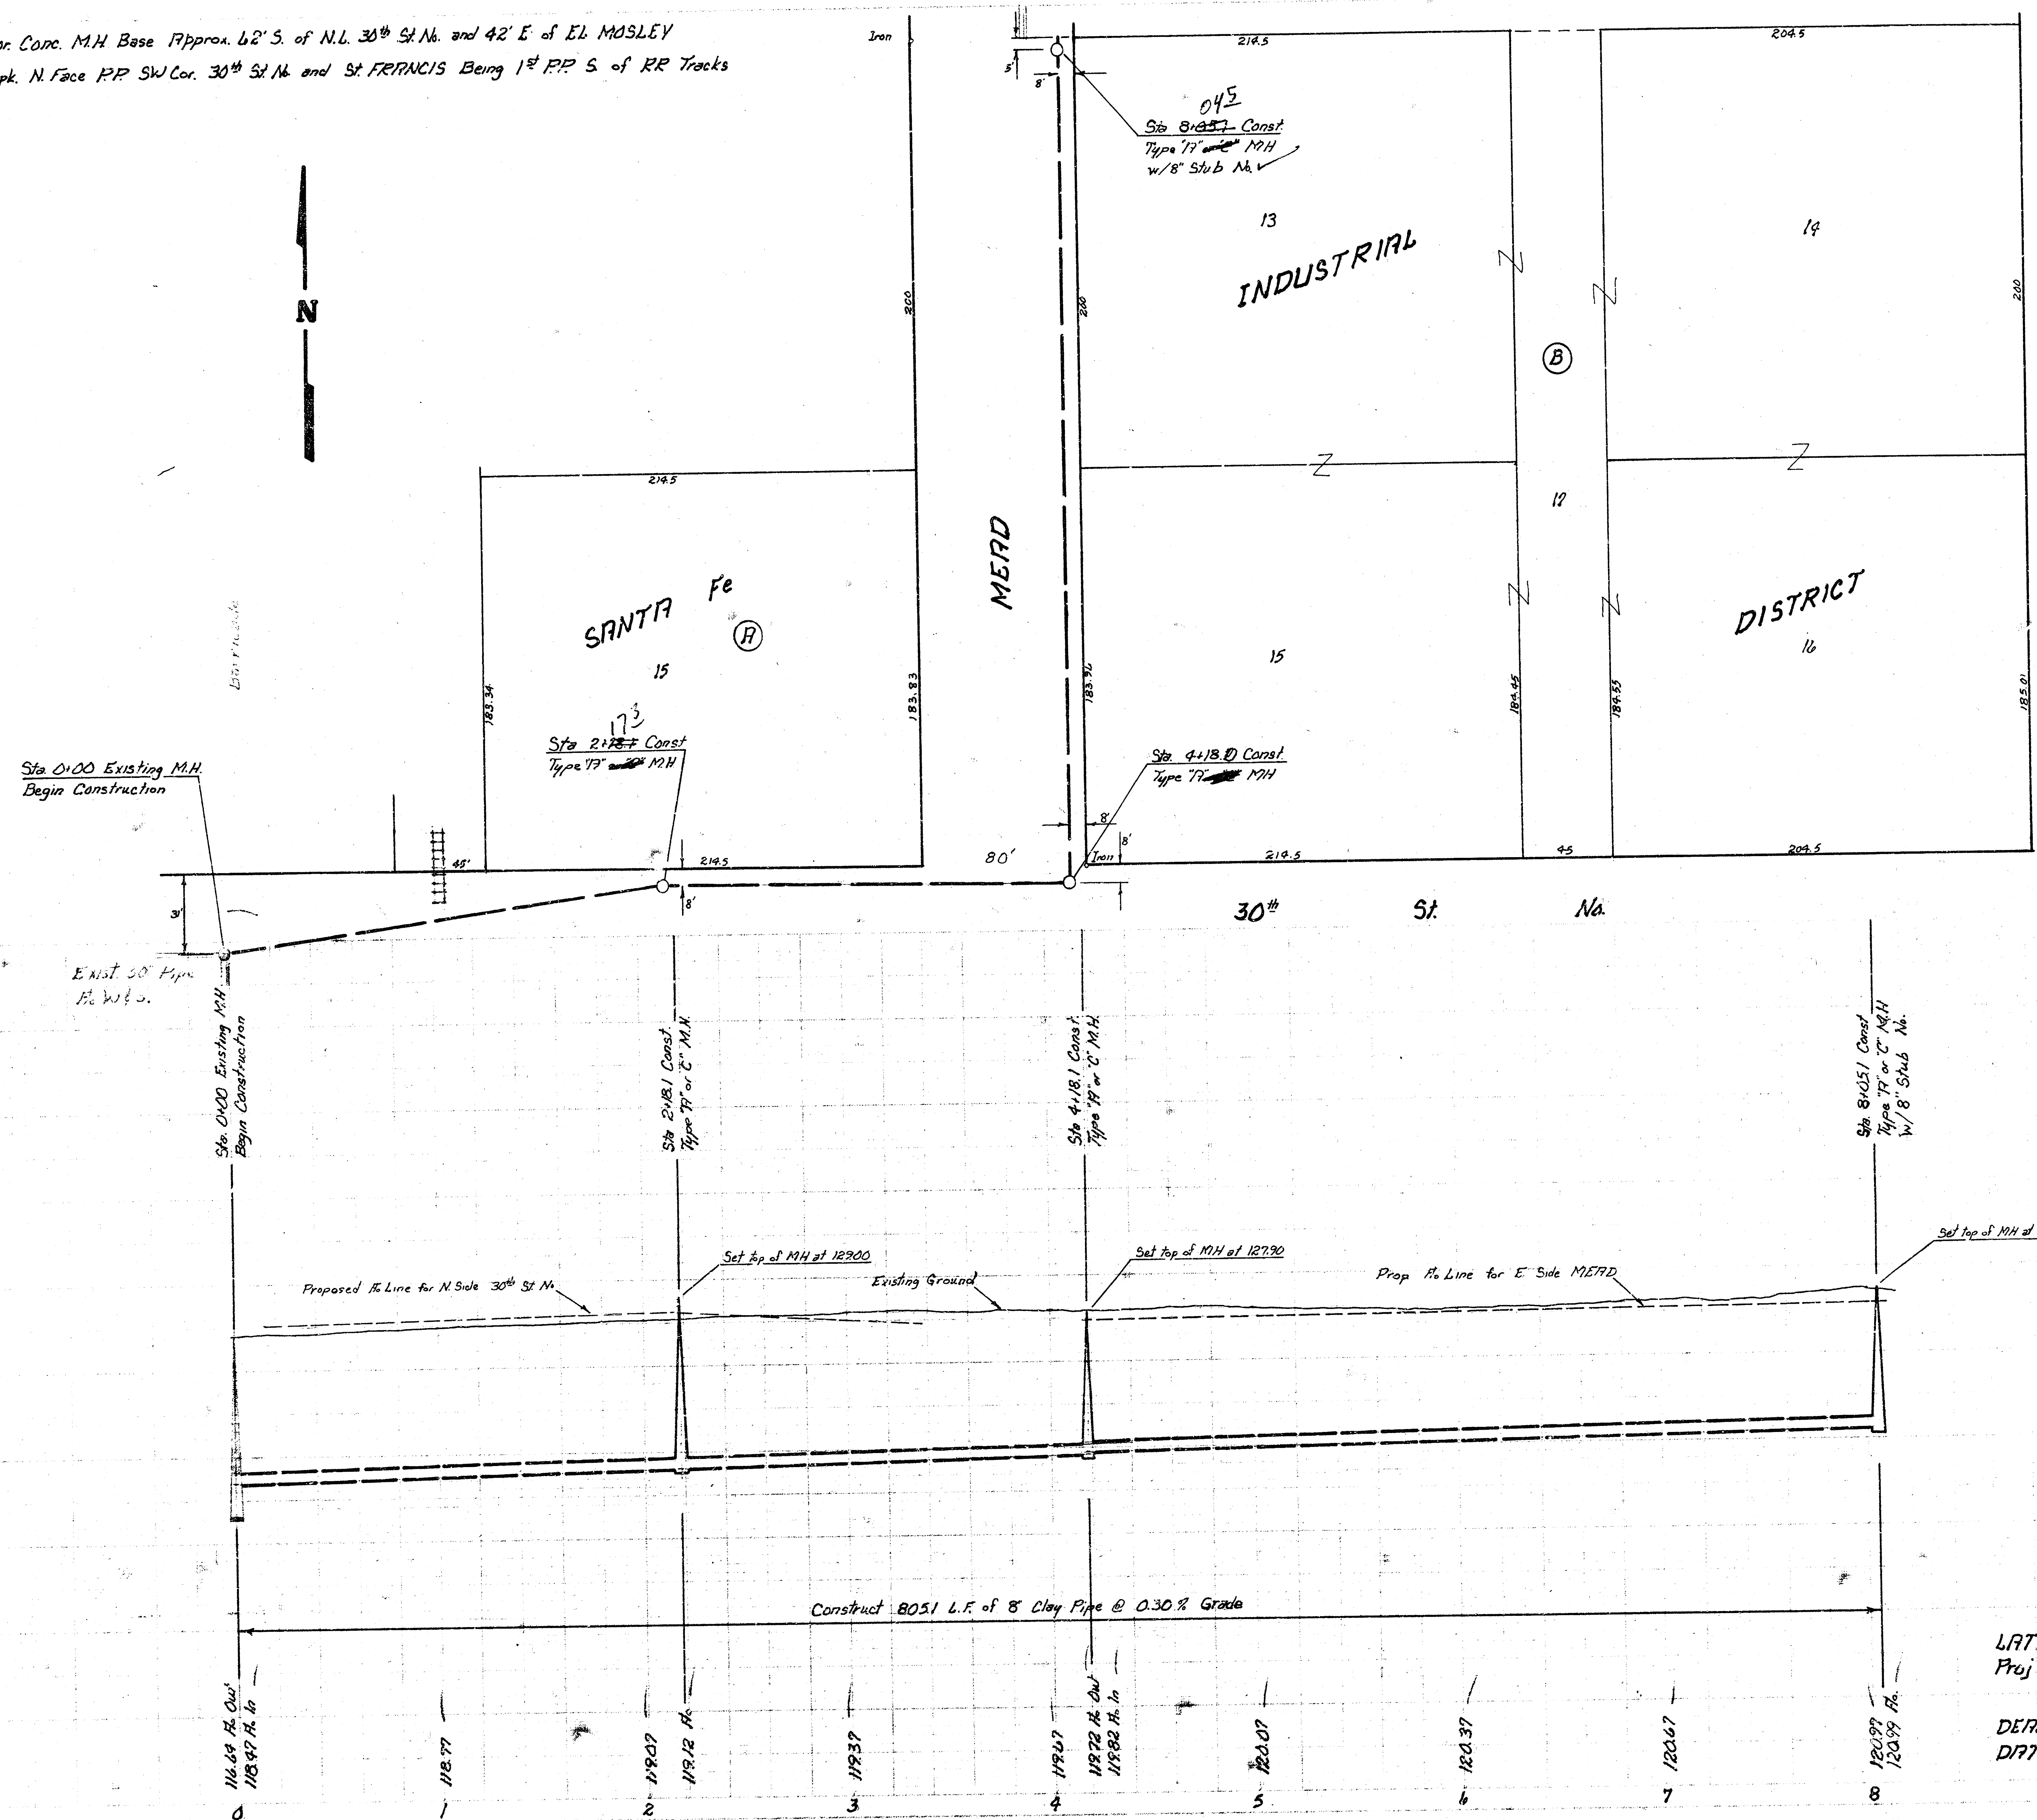

As Built
 2-17-81
 Jdf

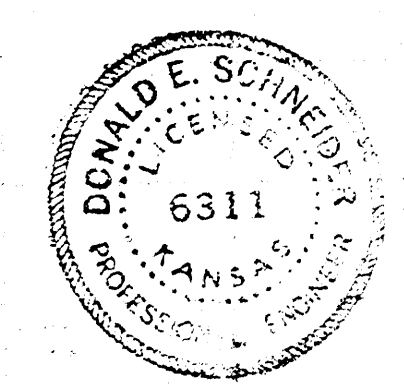

LATERAL 105, MAIN & SANITARY SEWER 23
 Proj. No.: 468-76-245-80760-000-000-001
 WICHITA, KANSAS
 DEAN SELLERS - Acting CITY ENGINEER
 DATE