

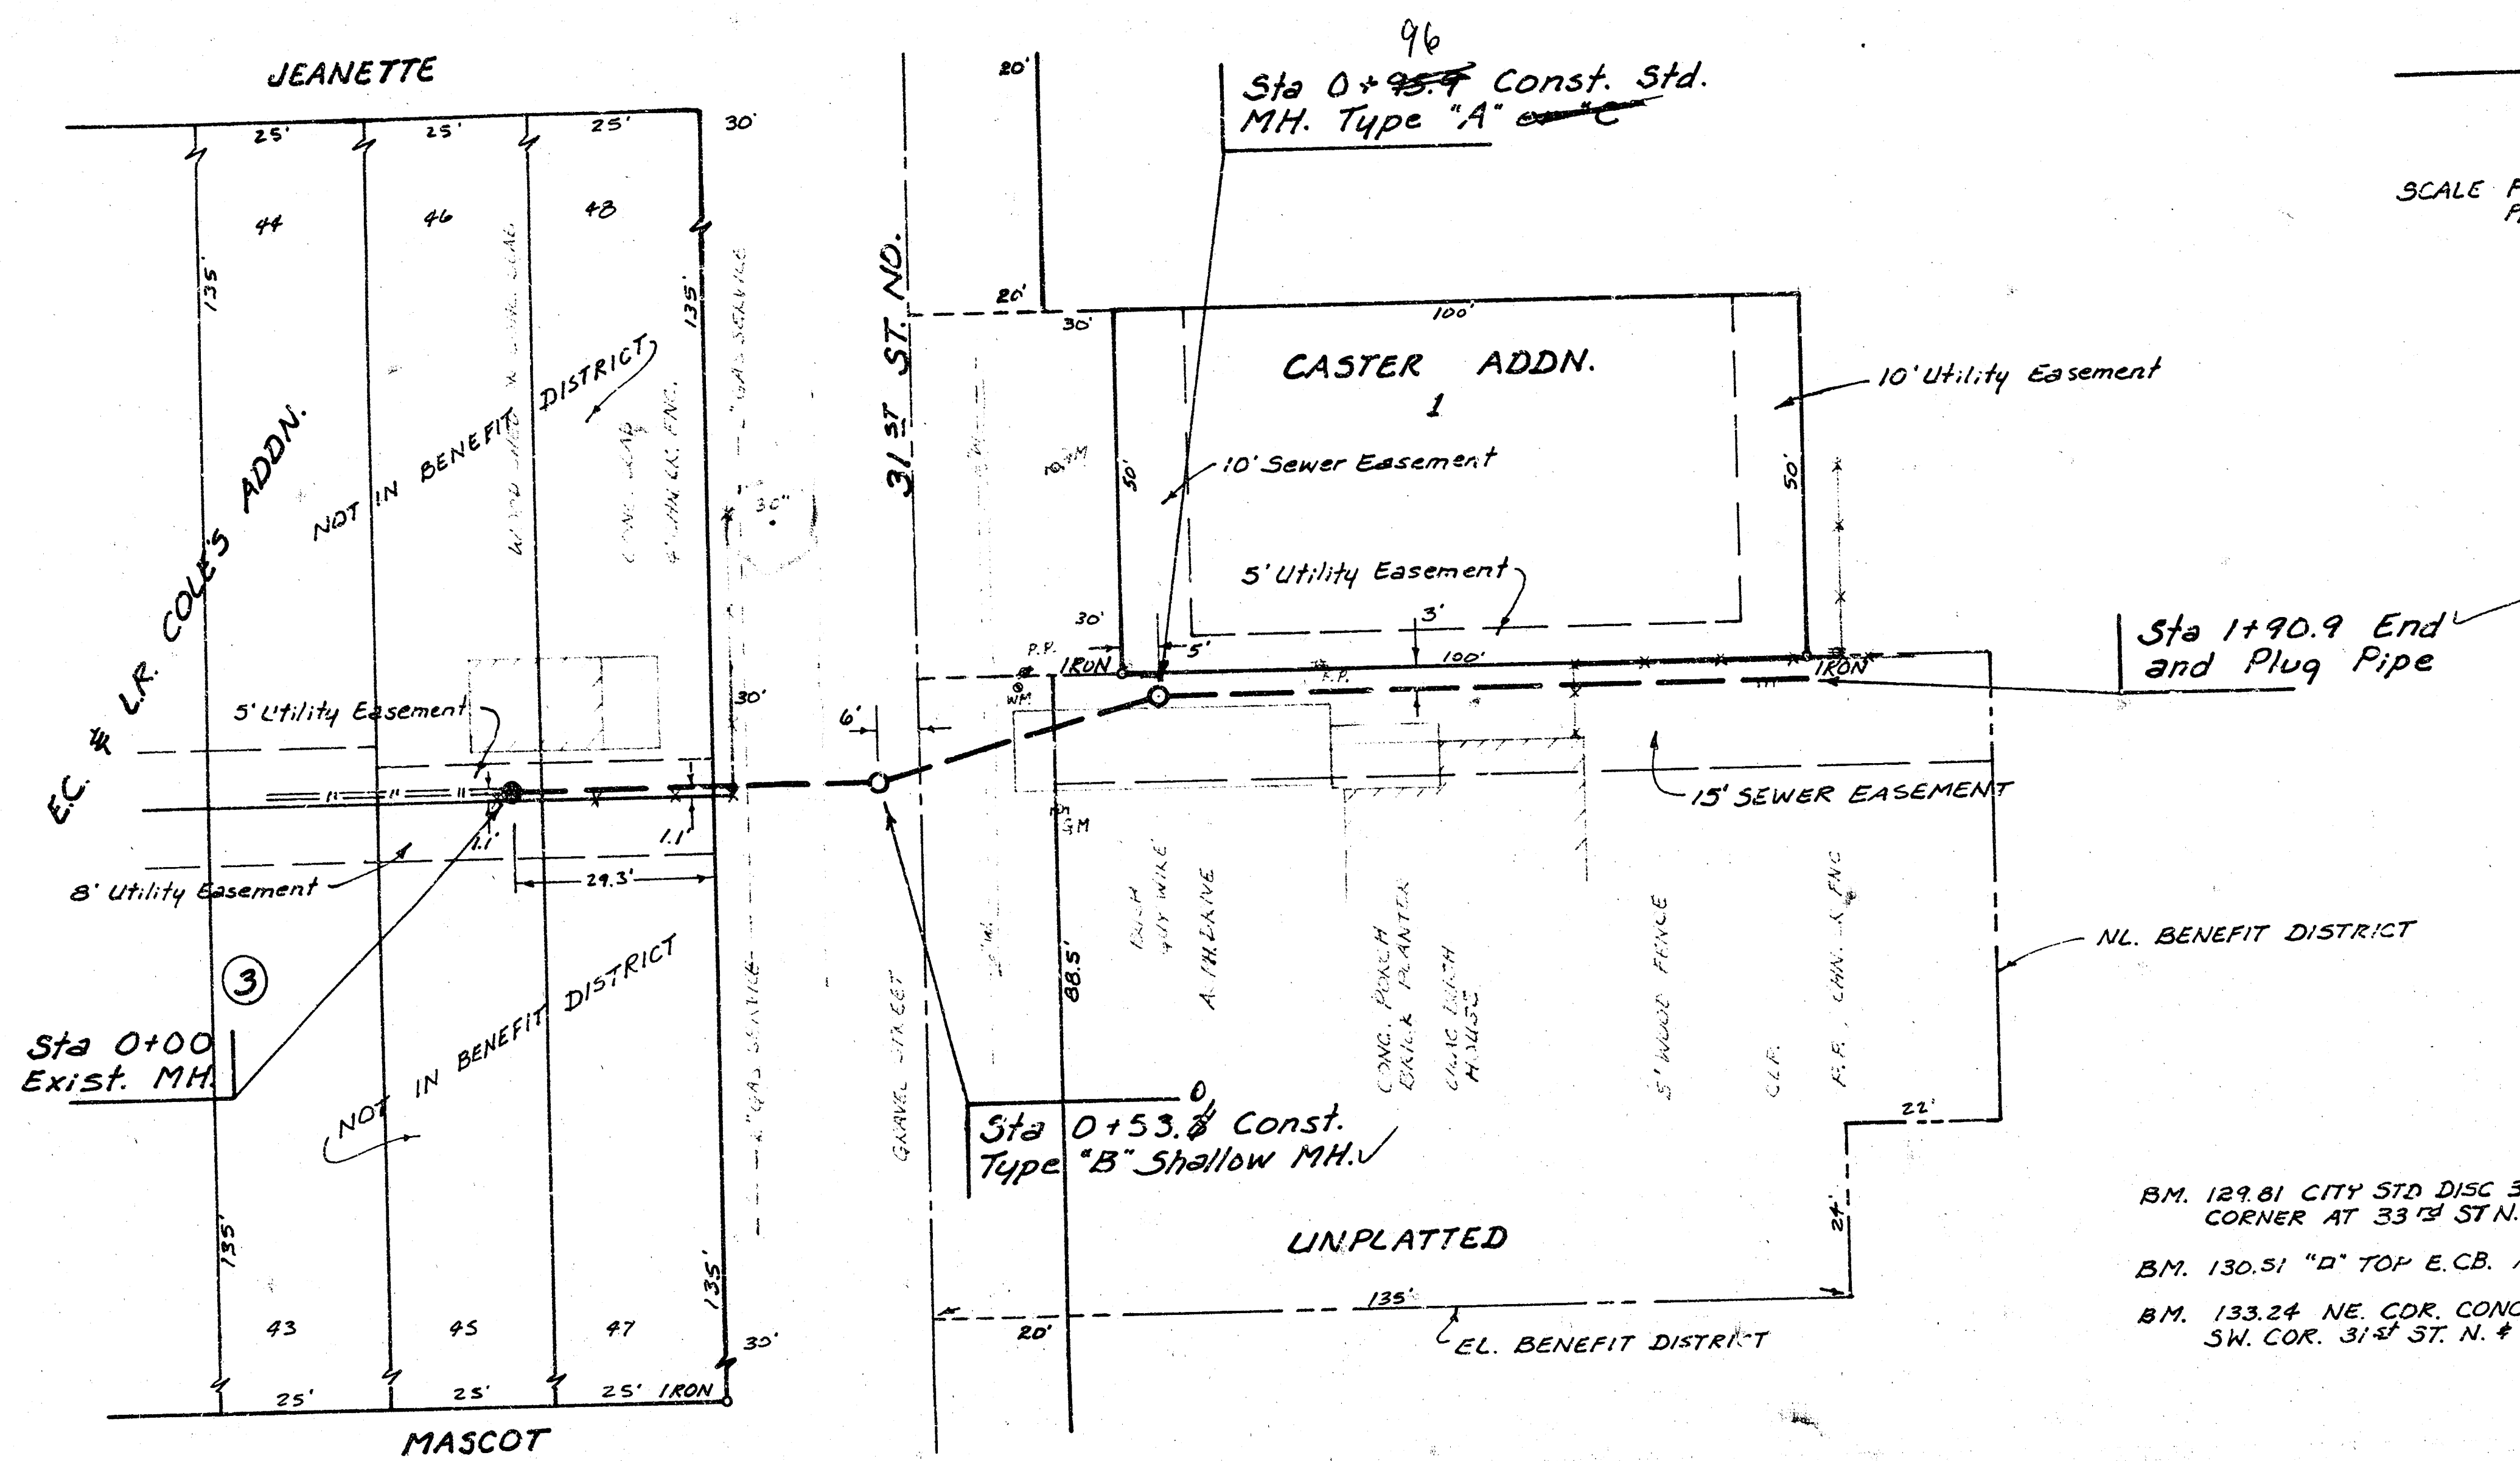


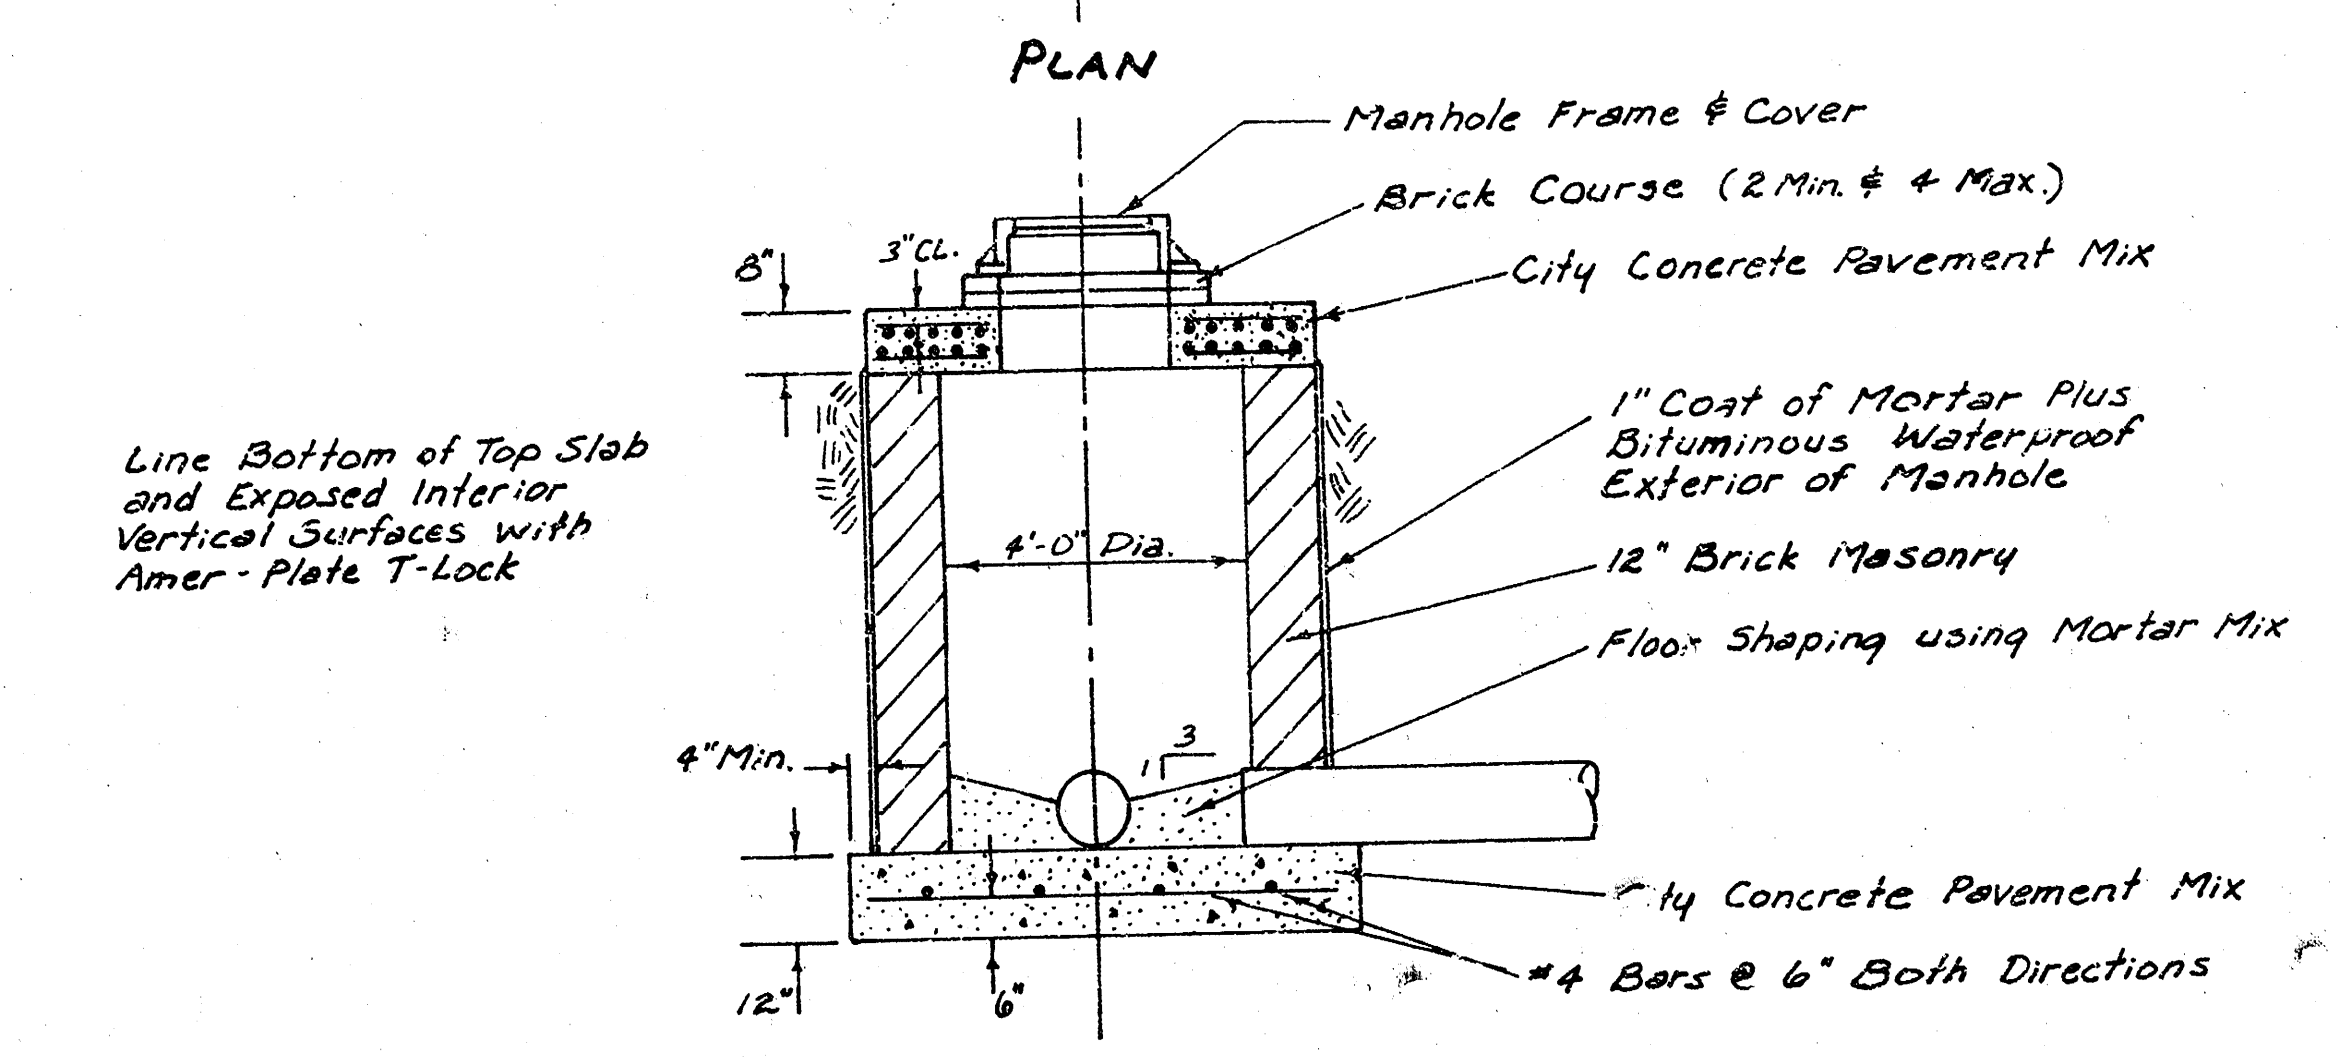


SCALE PLAN 1" = 20'
PROFILE 1" = 20' HORIZ.
1" = 5' VERT.

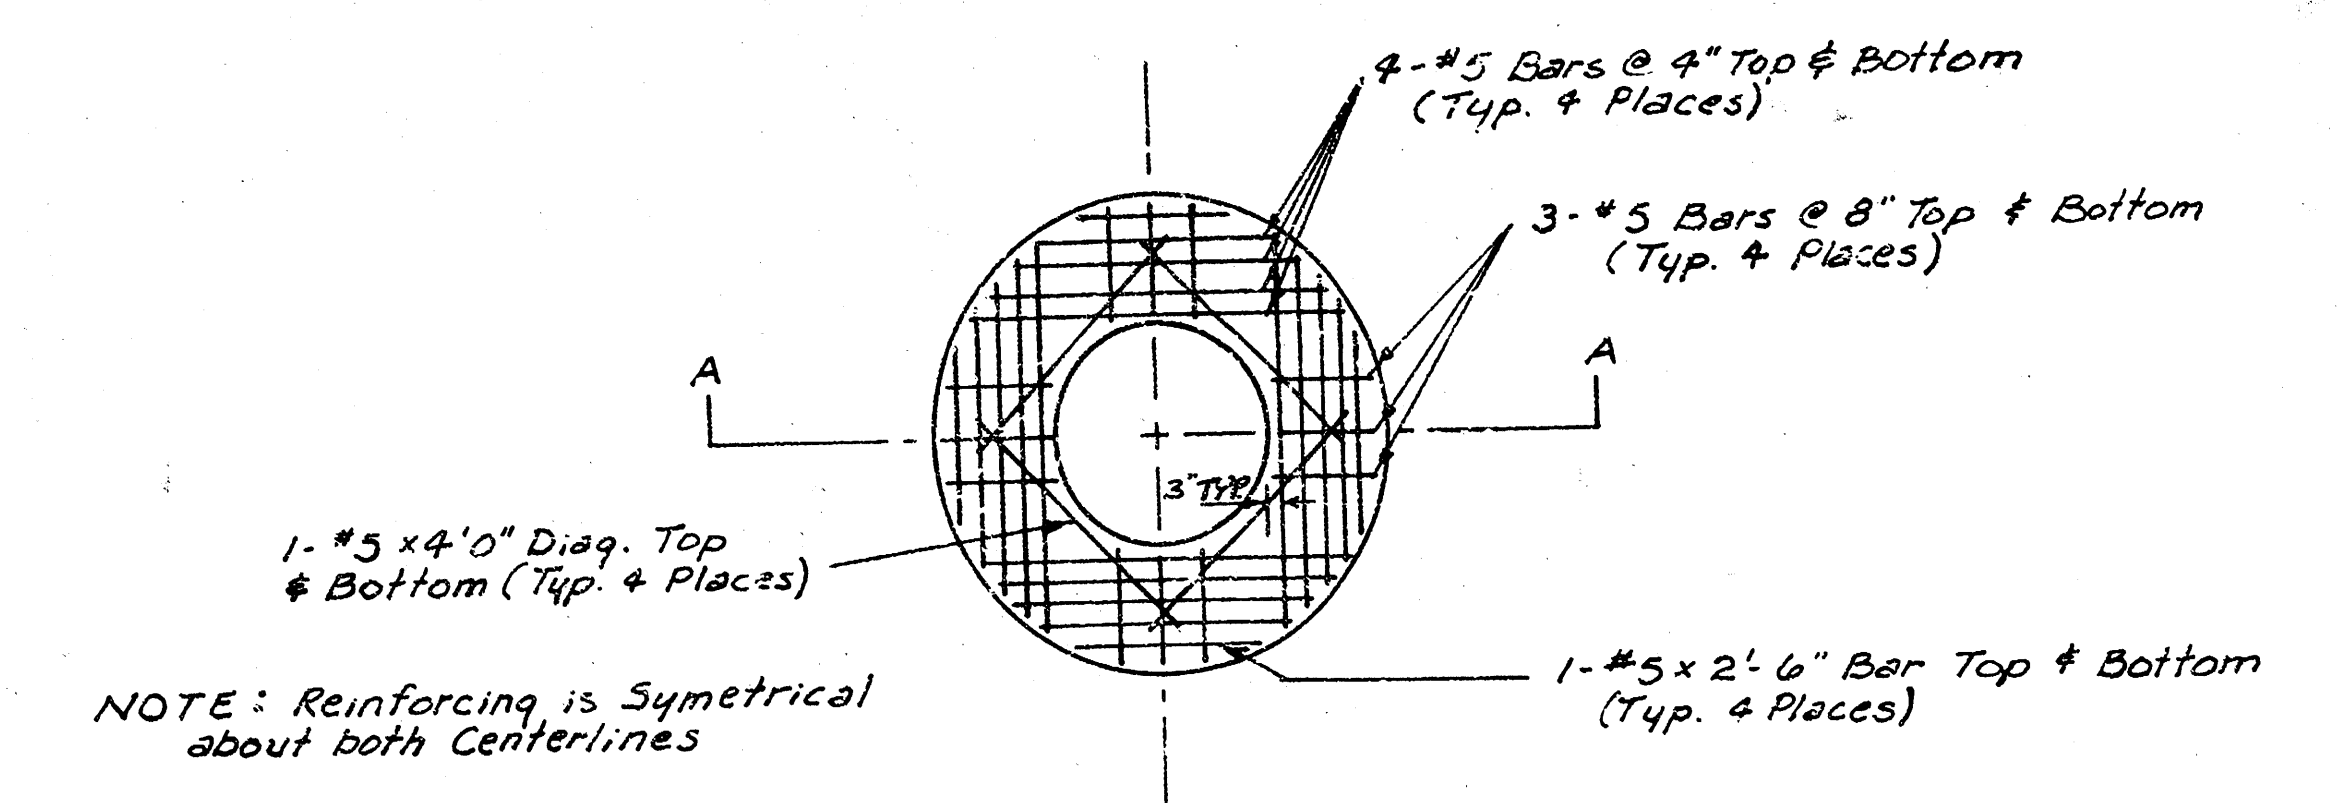


SECTION A
TYPE B SHALLOW MH.
No SCALE

B.M. 129.81 CITY STD. DISC 32' S & 22' E OF 1/4 SEC CORNER AT 33 1/2 ST. N. & ARKANSAS.
B.M. 130.51 "D" TOP E.C.B. ARKANSAS AT SL. 32 1/2 ST. NO.
B.M. 133.24 NE. COR. CONC. PORCH OF HOUSE AT SW. COR. 31 1/2 ST. N. & MASCOT.

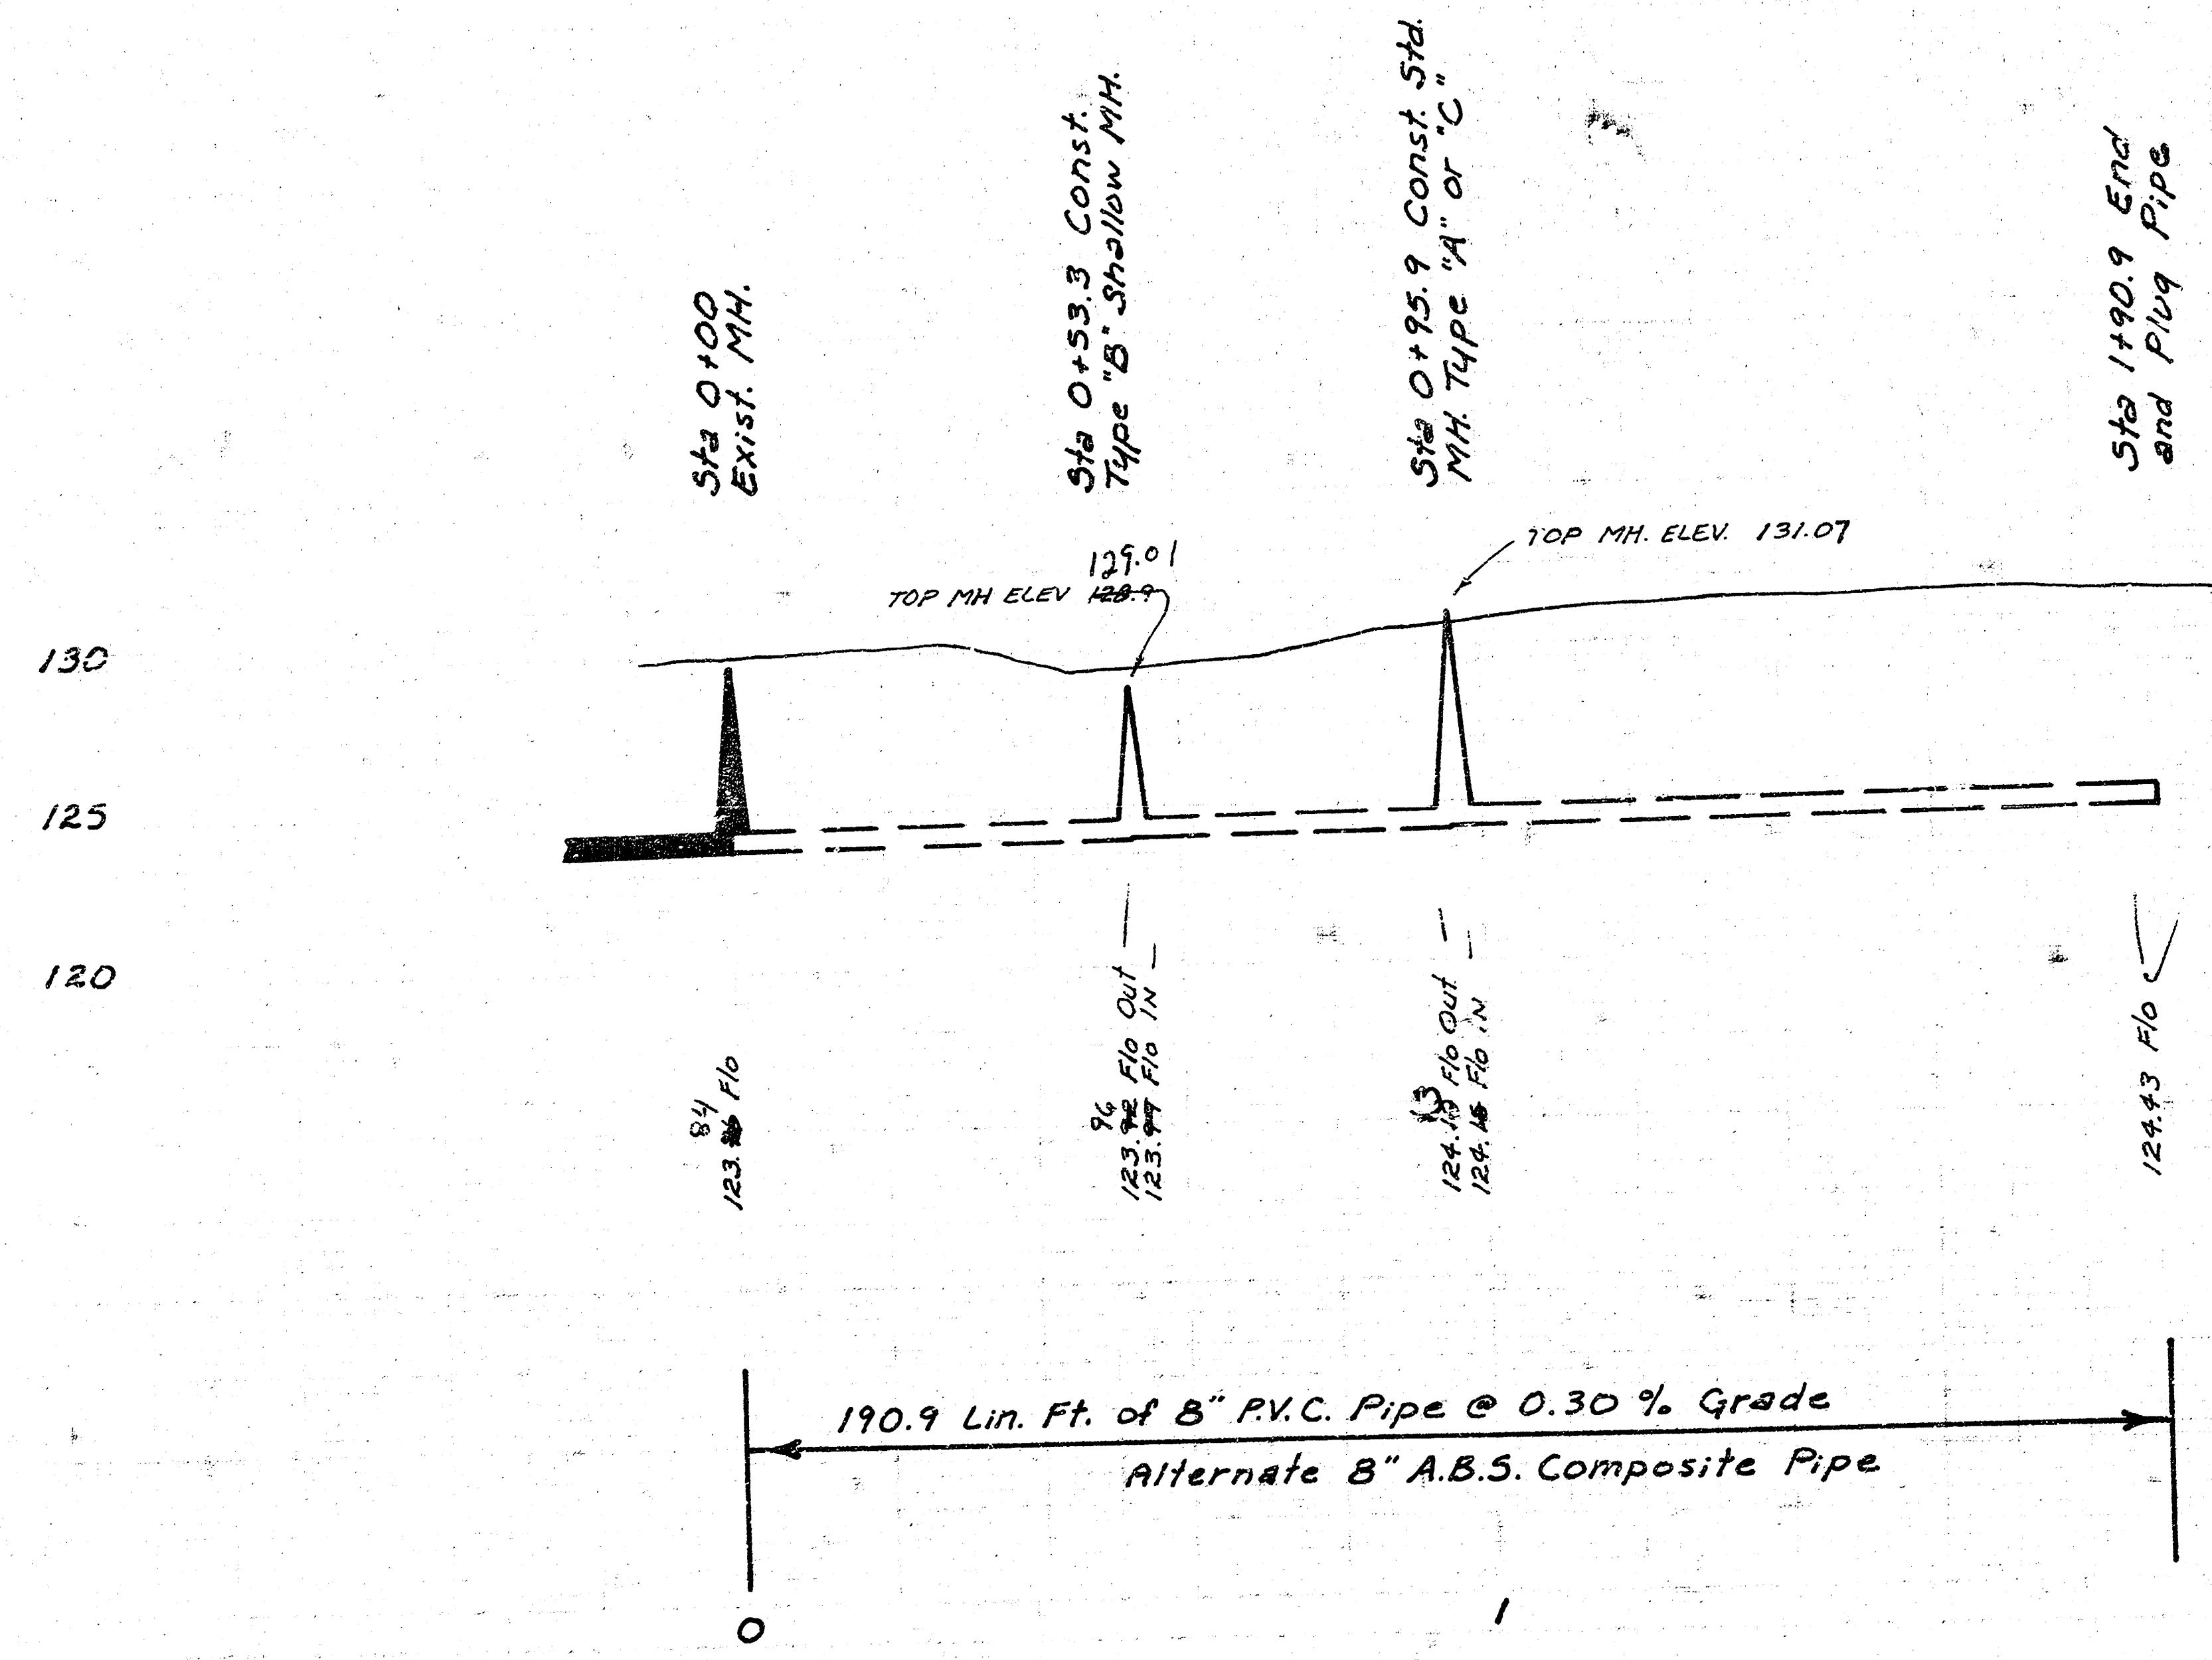

As Built
J.L.L.
9-28-82

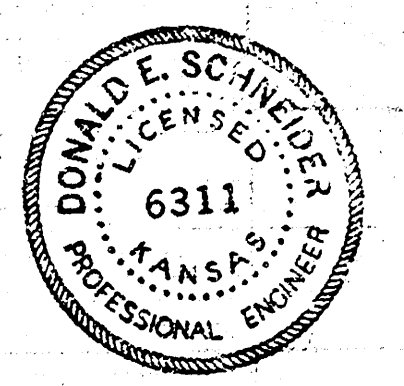

PROJECT DESCRIPTION	
LAT 107, MAIN 4,	
S. S. NO. 23	
PROJECT NUMBER	
468-78-245-81127-000-001	
BOOK NO. MGP-15	APPROVED BY
DRAWN BY LDM/LS	DATE 5/82
CITY OF WICHITA	
DEPARTMENT OF ENGINEERING	
DIRECTOR OF ENG. CITY ENGINEER	
R. W. BRUGEMAN	
SCALE	