



SCALE PLAN 1" = 20' HORZ. PROFILE 1" = 20' VERT.

NOTE: CONTRACTOR TO NOTIFY ALL PROPERTY OWNERS 48 HRS. PRIOR TO CONSTRUCTION.

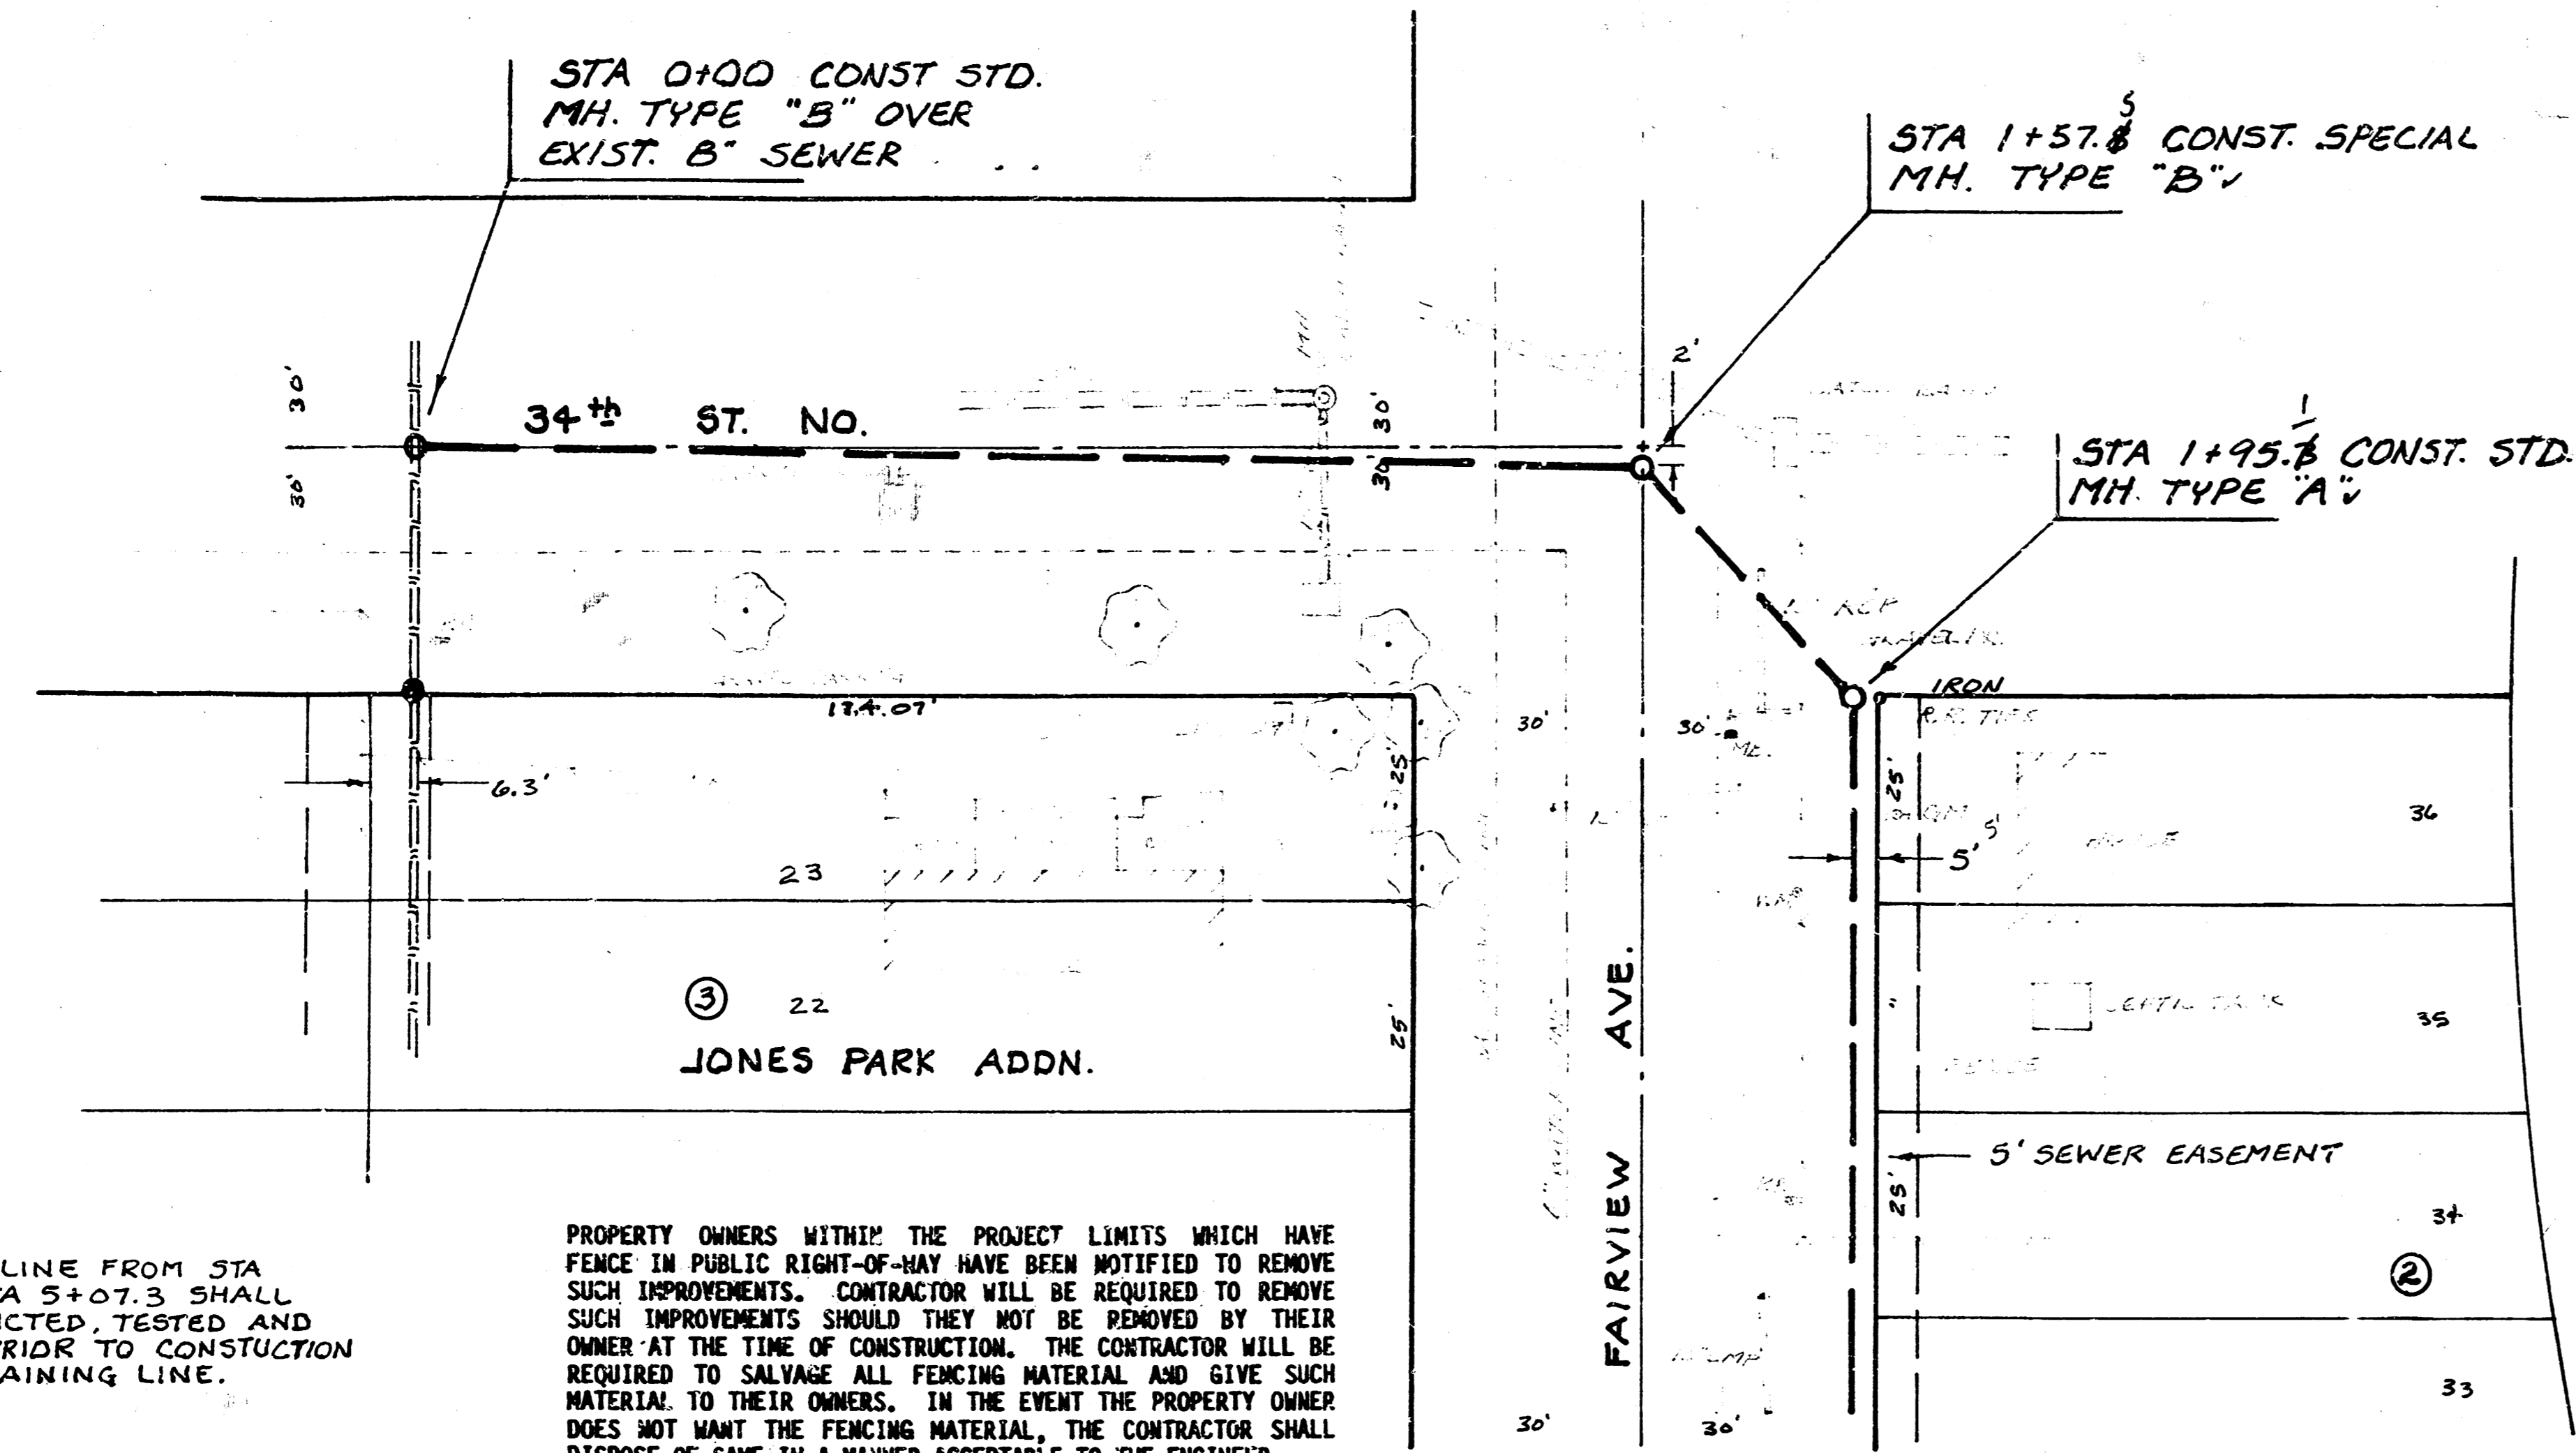


NOTE: THE LINE FROM STA 0+00 TO STA 5+07.3 SHALL BE CONSTRUCTED, TESTED AND ACCEPTED PRIOR TO CONSTRUCTION OF THE REMAINING LINE.


PROPERTY OWNERS WITHIN THE PROJECT LIMITS WHICH HAVE FENCE IN PUBLIC RIGHT-OF-WAY HAVE BEEN NOTIFIED TO REMOVE SUCH IMPROVEMENTS. CONTRACTOR WILL BE REQUIRED TO REMOVE SUCH IMPROVEMENTS SHOULD THEY NOT BE REMOVED BY THEIR OWNER AT THE TIME OF CONSTRUCTION. THE CONTRACTOR WILL BE REQUIRED TO SALVAGE ALL FENCING MATERIAL AND GIVE SUCH MATERIAL TO THEIR OWNERS. IN THE EVENT THE PROPERTY OWNER DOES NOT WANT THE FENCING MATERIAL, THE CONTRACTOR SHALL DISPOSE OF SAME IN A MANNER ACCEPTABLE TO THE ENGINEER.

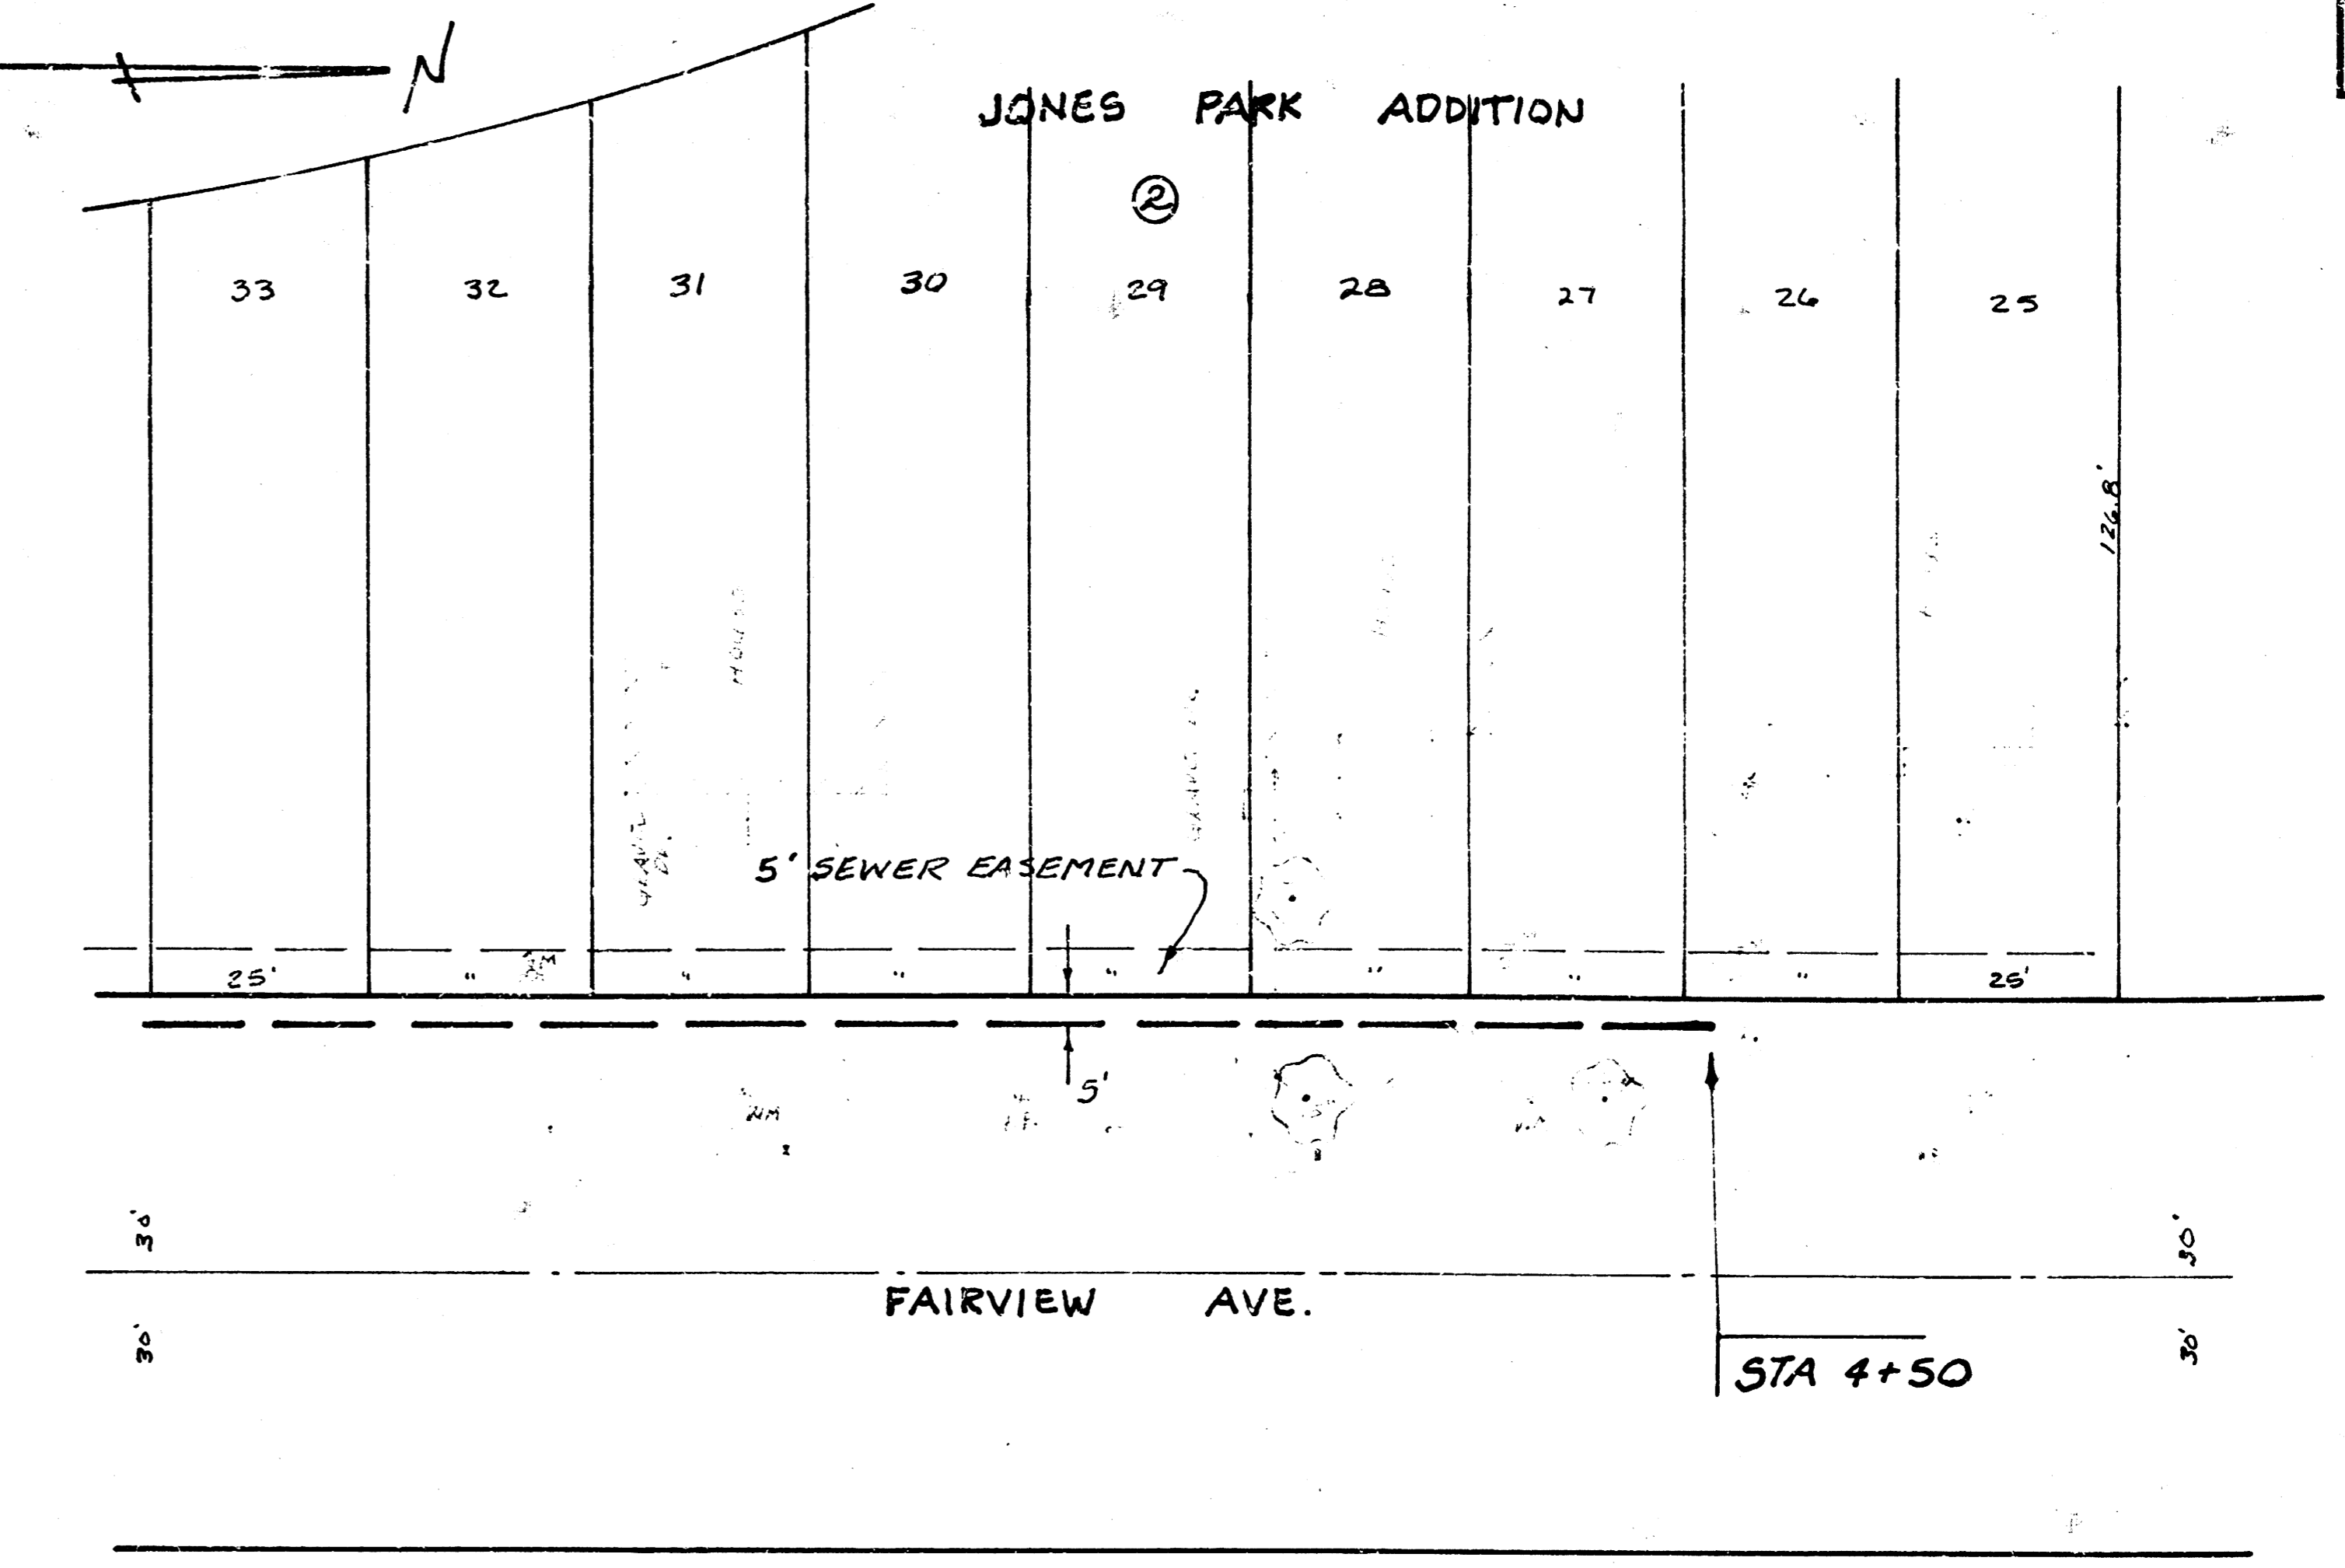

- BM. 130.25 R.R. SPIKE N. FACE P.P. S. SIDE OF 34th ST. NO. 135 FT. E. OF E.L. FAIRVIEW.
- BM. 129.24 R.R. SPIKE W. FACE P.P. WEST SIDE OF FAIRVIEW 2nd P.P. N. OF N.L. 34th ST. NO.
- BM. 129.56 R.R. SPIKE S. FACE P.P. NORTH SIDE 35th ST. NO. 2nd P.P. W. OF FAIRVIEW.

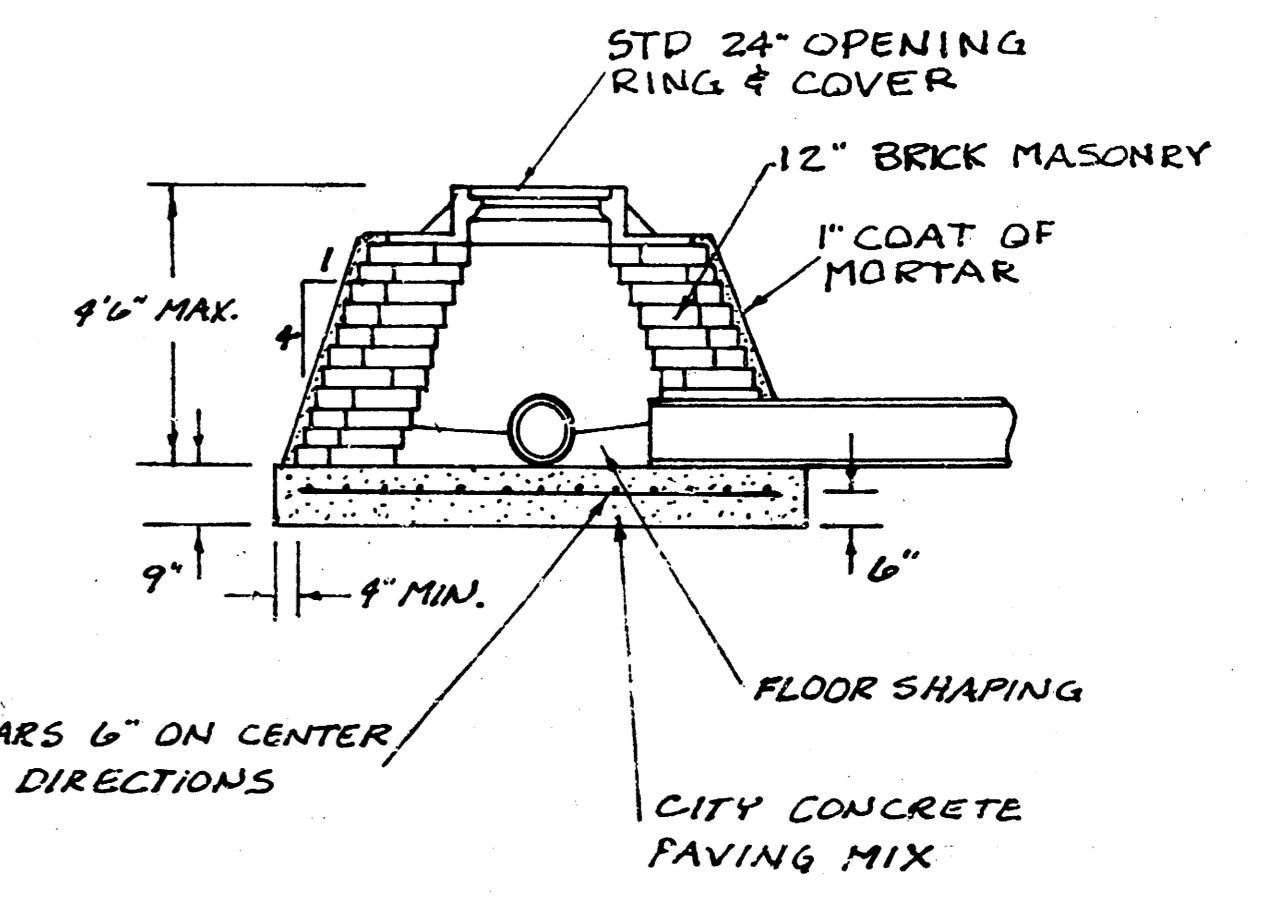

As Built
J.L.L.
784

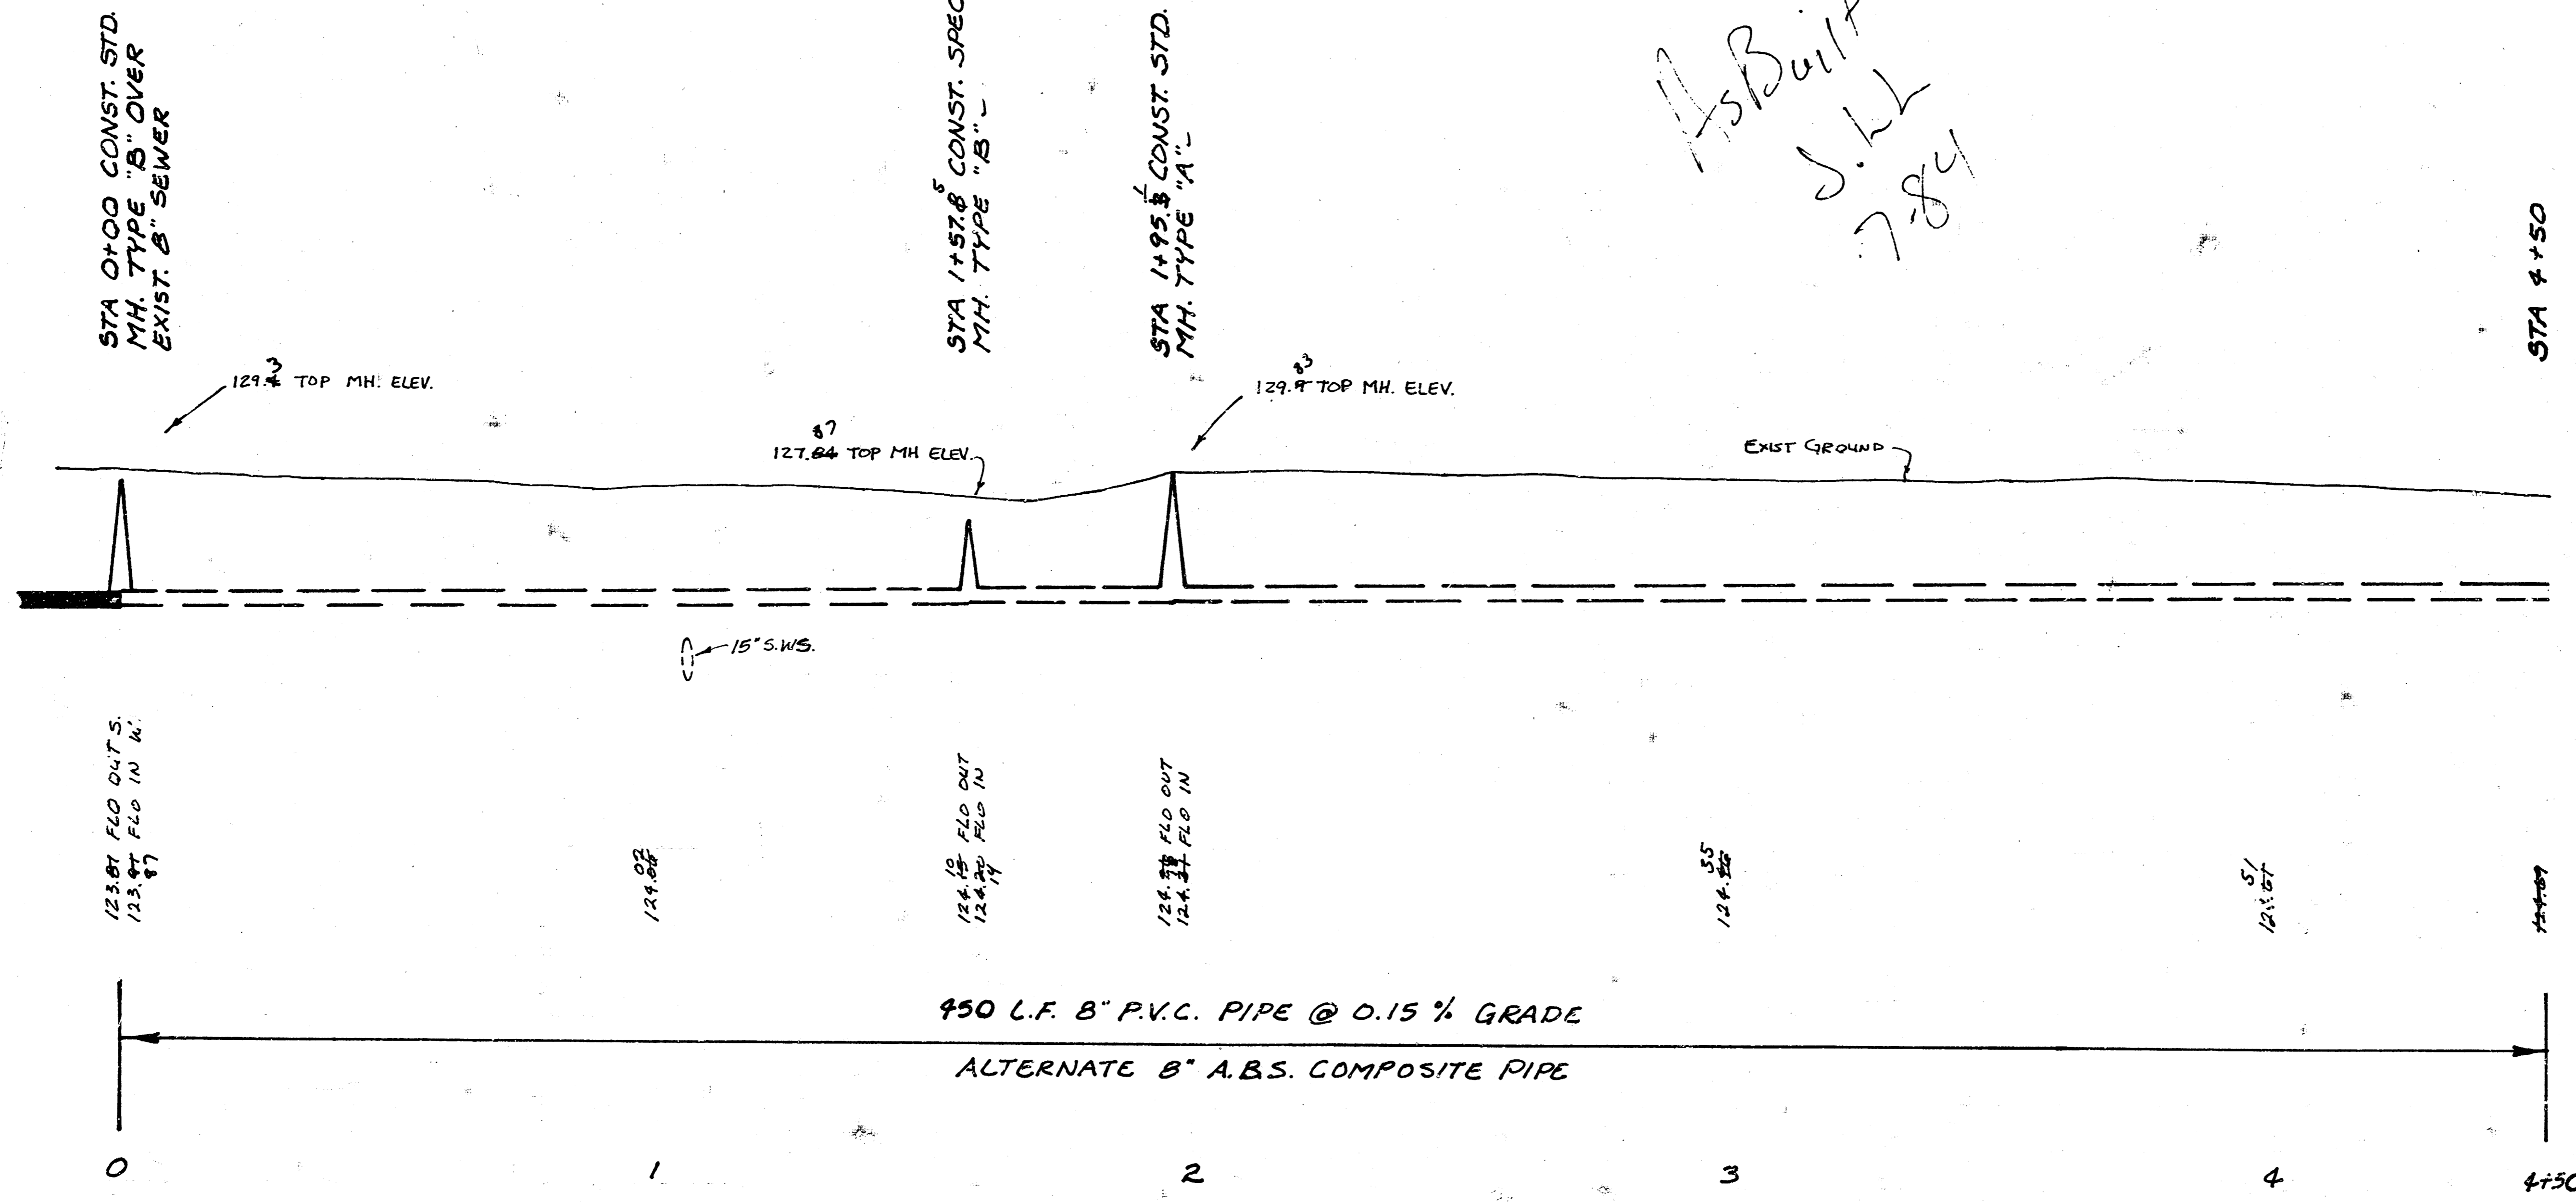

PROJECT DESCRIPTION	
LAT. 110, MAIN 4, S. S. NO. 23	
PROJECT NUMBER	
468-76-245-81258-000-001	
BOOK NO. JLA-35	APPROVED BY
DRAWN BY LDM:15	DATE
CITY OF WICHITA	
DEPARTMENT OF ENGINEERING	
M. E. LINDEBAK - CITY ENGINEER	SIGNATURE

FILMED FROM THE BEST AVAILABLE COPY.....

