
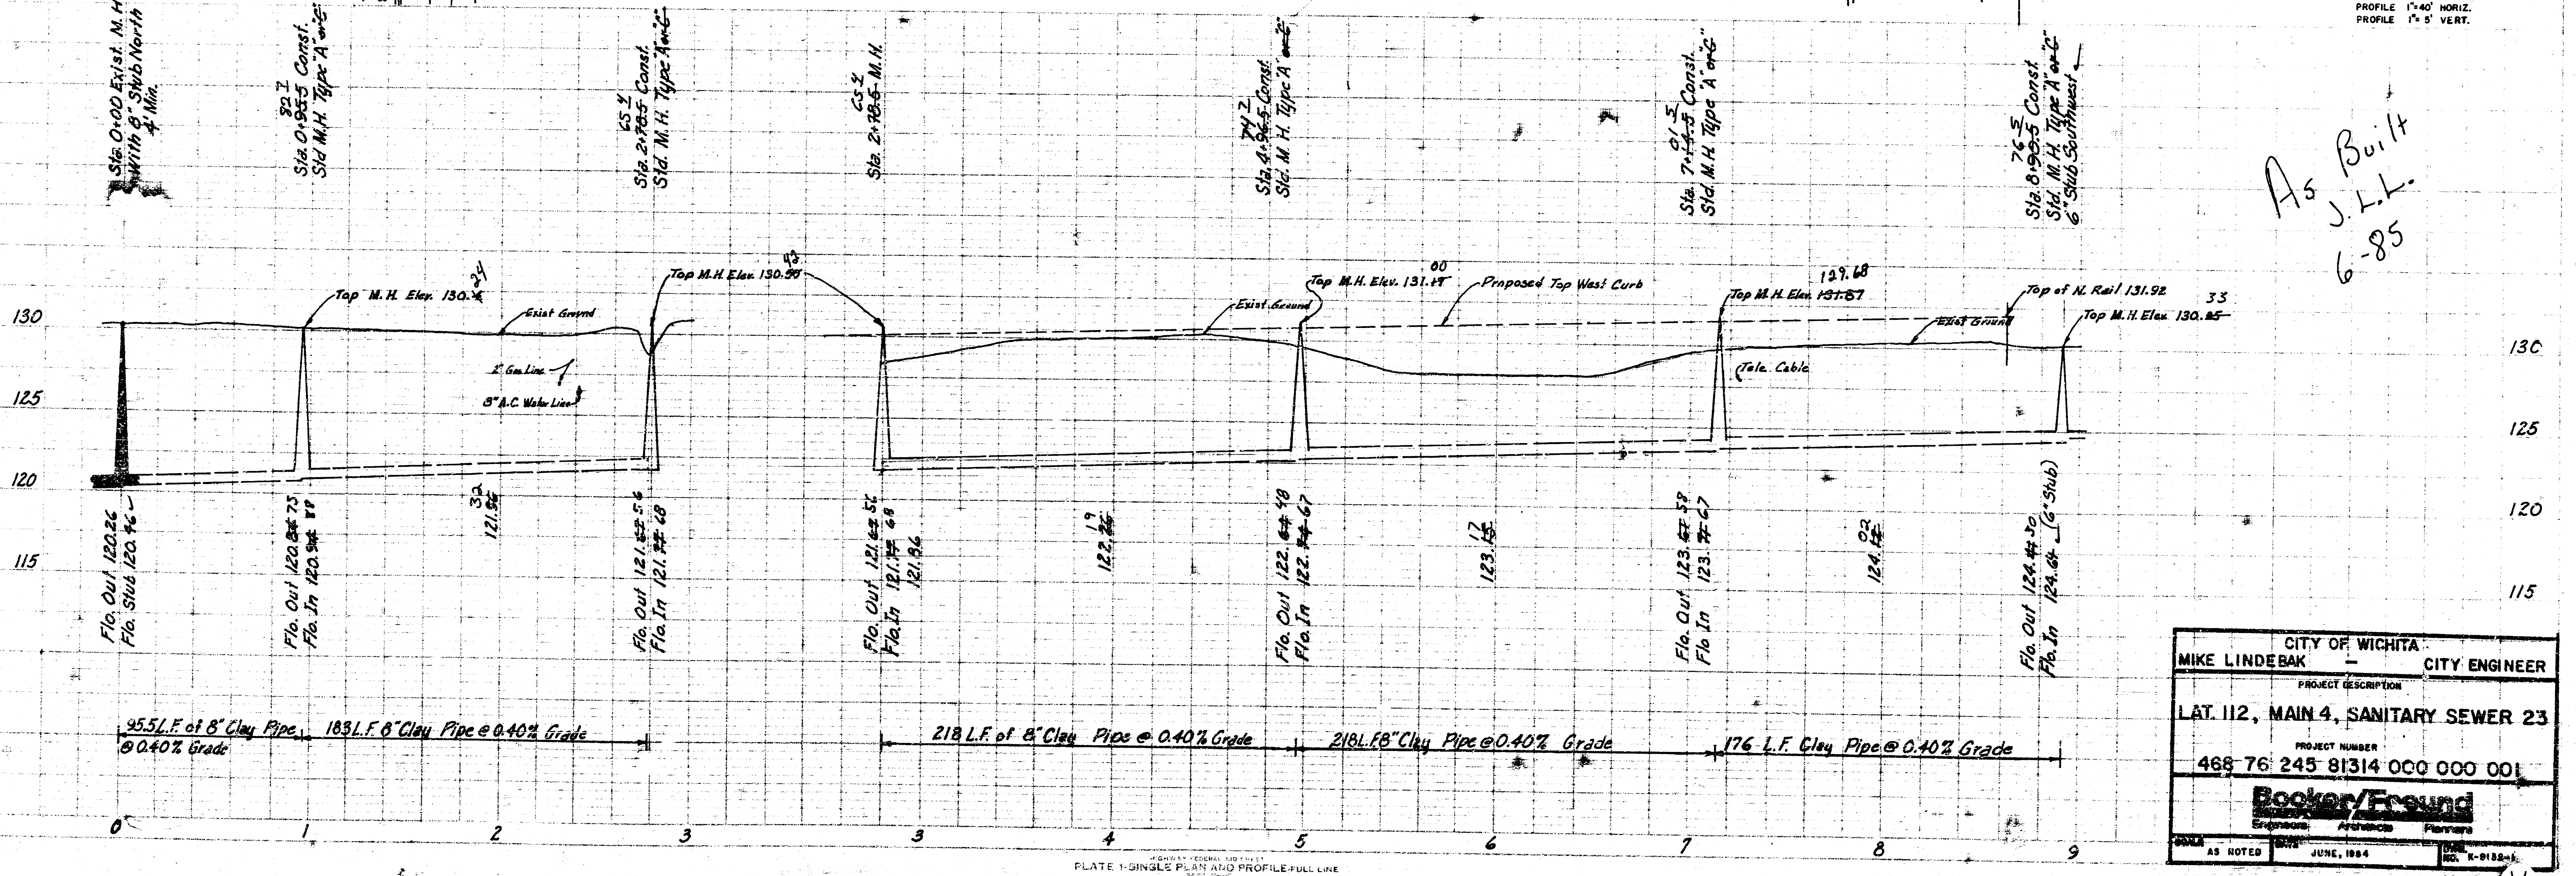


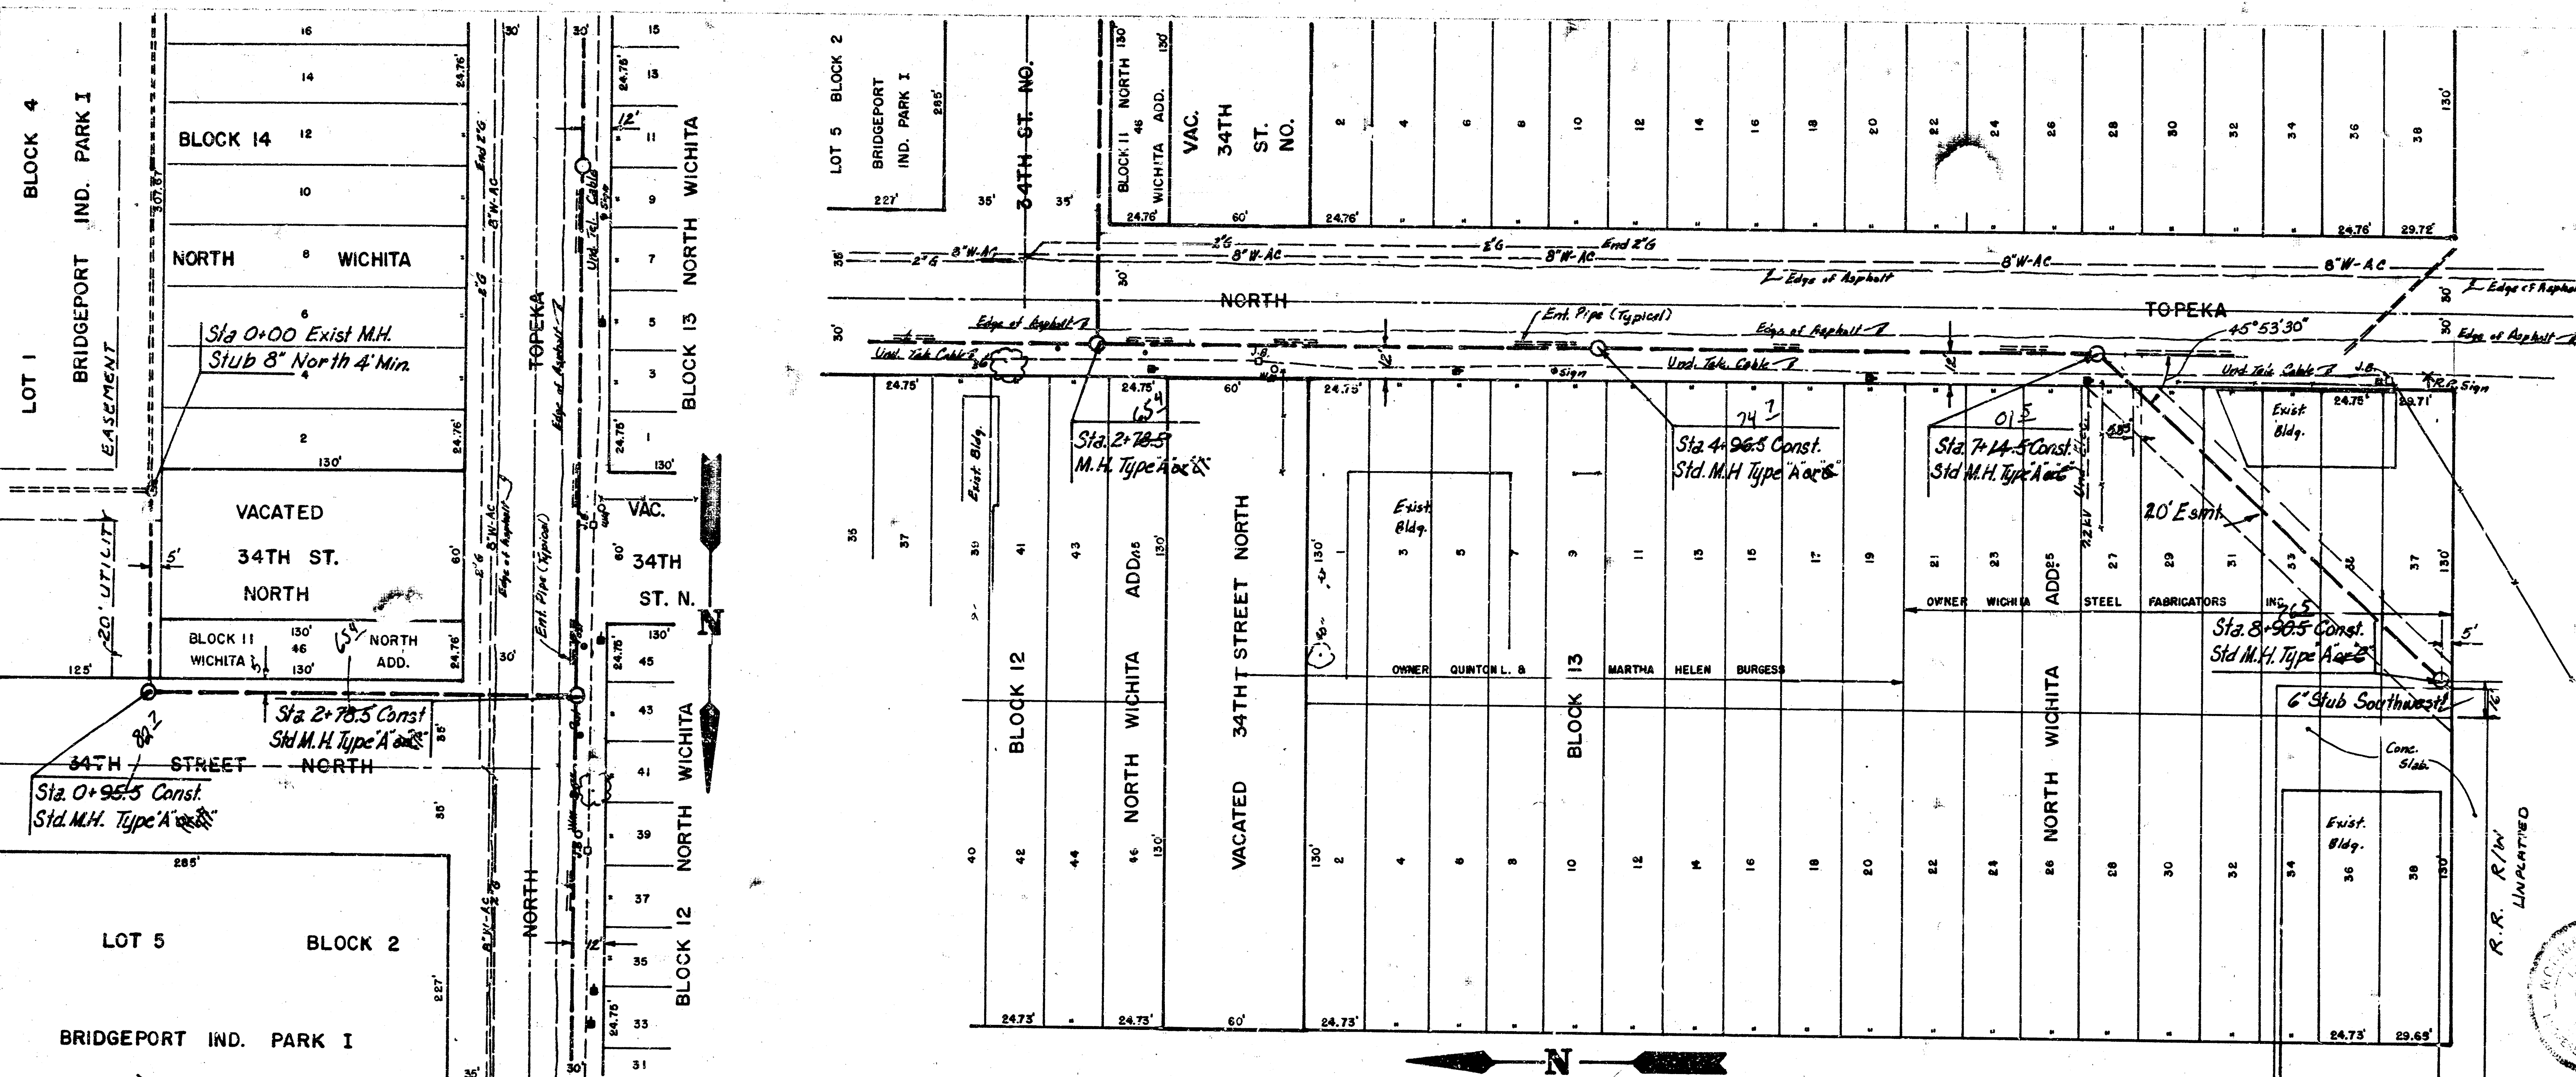

GENERAL NOTES

1. Removal and replacement of any or all entrance pipes shall be incidental to the project.
2. The contractor shall be responsible for preserving property irons. The contractor shall be required to re-establish any property irons which are damaged or destroyed by his construction operations. Such irons shall be re-established by a Registered Land Surveyor or a Licensed Professional Engineer in accordance with state laws.
3. Notify the following companies prior to any trenching.


ARKLA Gas Co.	942-8350
Bell Telephone Co.	268-3078
Cablevision	266-6817
Gas Service Co.	263-7511
Kansas Gas & Electric Co.	261-6248
Derby Refining Co.	267-0361
Kan-U-Dig-It	267-2889

- | | |
|-------------|--|
| B.M. 130.98 | R.R. Spike in Power Pole 150' North of 33rd St. N. & Topeka |
| B.M. 130.86 | 60d Step in Power Pole 30' W. 35th St. N. & Topeka |
| B.M. 132.51 | R.R. Spike in Power Pole 100' N. & 130' E. 34th St. & Topeka |
| B.M. 130.45 | 60d Step in Power Pole SW Corner of 34th & Emporia |

SCALE
PLAN 1"=40'
PROFILE 1"=40' HORIZ.
1"=5' VERT.

As Built
J.L.L.
6-85

CITY OF WICHITA	
MIKE LINDEBAK	CITY ENGINEER
PROJECT DESCRIPTION	
LAT. 112, MAIN 4, SANITARY SEWER 23	
PROJECT NUMBER	
468 76 245 81314 000 000 001	
Booker/Ernst	
AS NOTED	JUNE, 1984

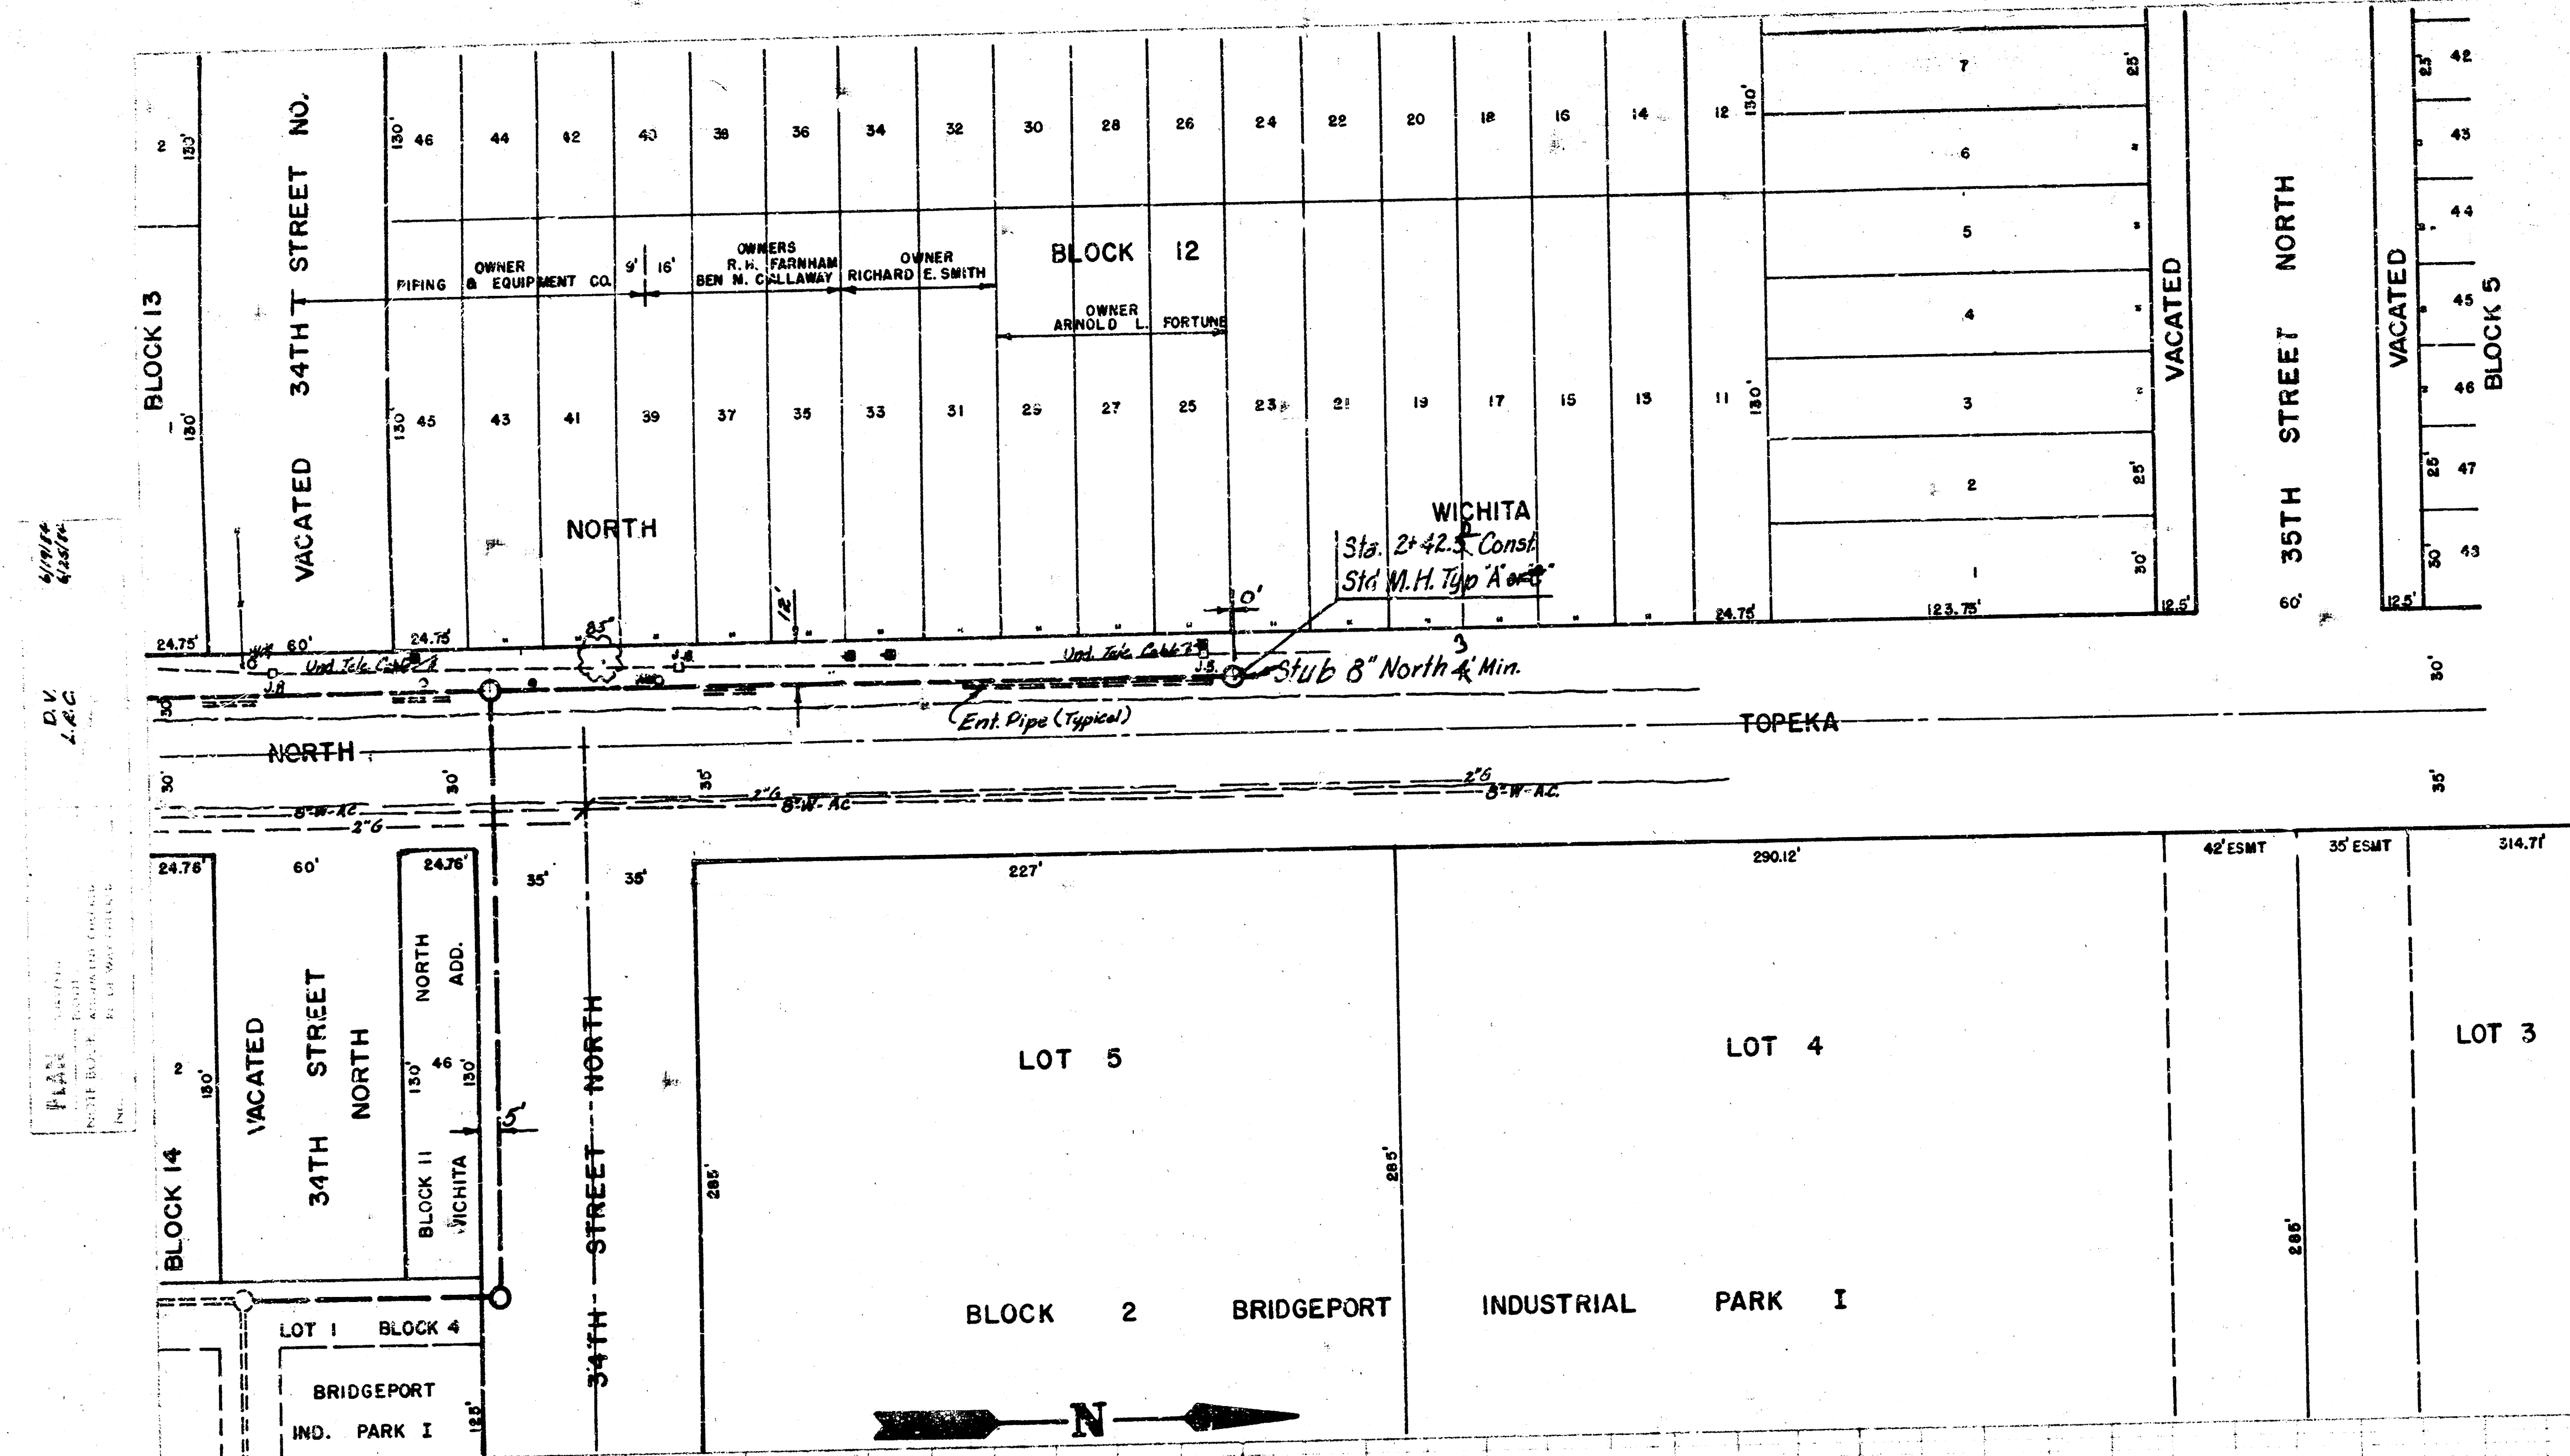


26	25
28	27
30	29
32	31
34	33
36	35
38	37
40	39
42	41
44	43
46	45
VACATED 34th STREET NORTH	
2	1
4	3
6	5
8	7
10	9
12	11
14	13
16	15
18	17
20	19
22	21
24	23
26	25
28	27
30	29
32	31
34	33
36	35
38	37

BENEFIT DISTRICT MAP
Scale 1" = 100'

- B.M. 130.98 R.R. Spike in Power Pole 150' North of 33rd St. N. & Topeka
- B.M. 130.86 60d Step in Power Pole 30' W of 35th St. N. & Topeka
- B.M. 132.31 R.R. Spike in Power Pole 100' N. & 130'E. 34th St. N. & Topeka
- 130.45 60d Step in Power Pole SW Corner of 34th & Emporia

SCALE
PLAN 1"=40'
PROFILE 1"=40' HORIZ.
PROFILE 1"=5' VERT.

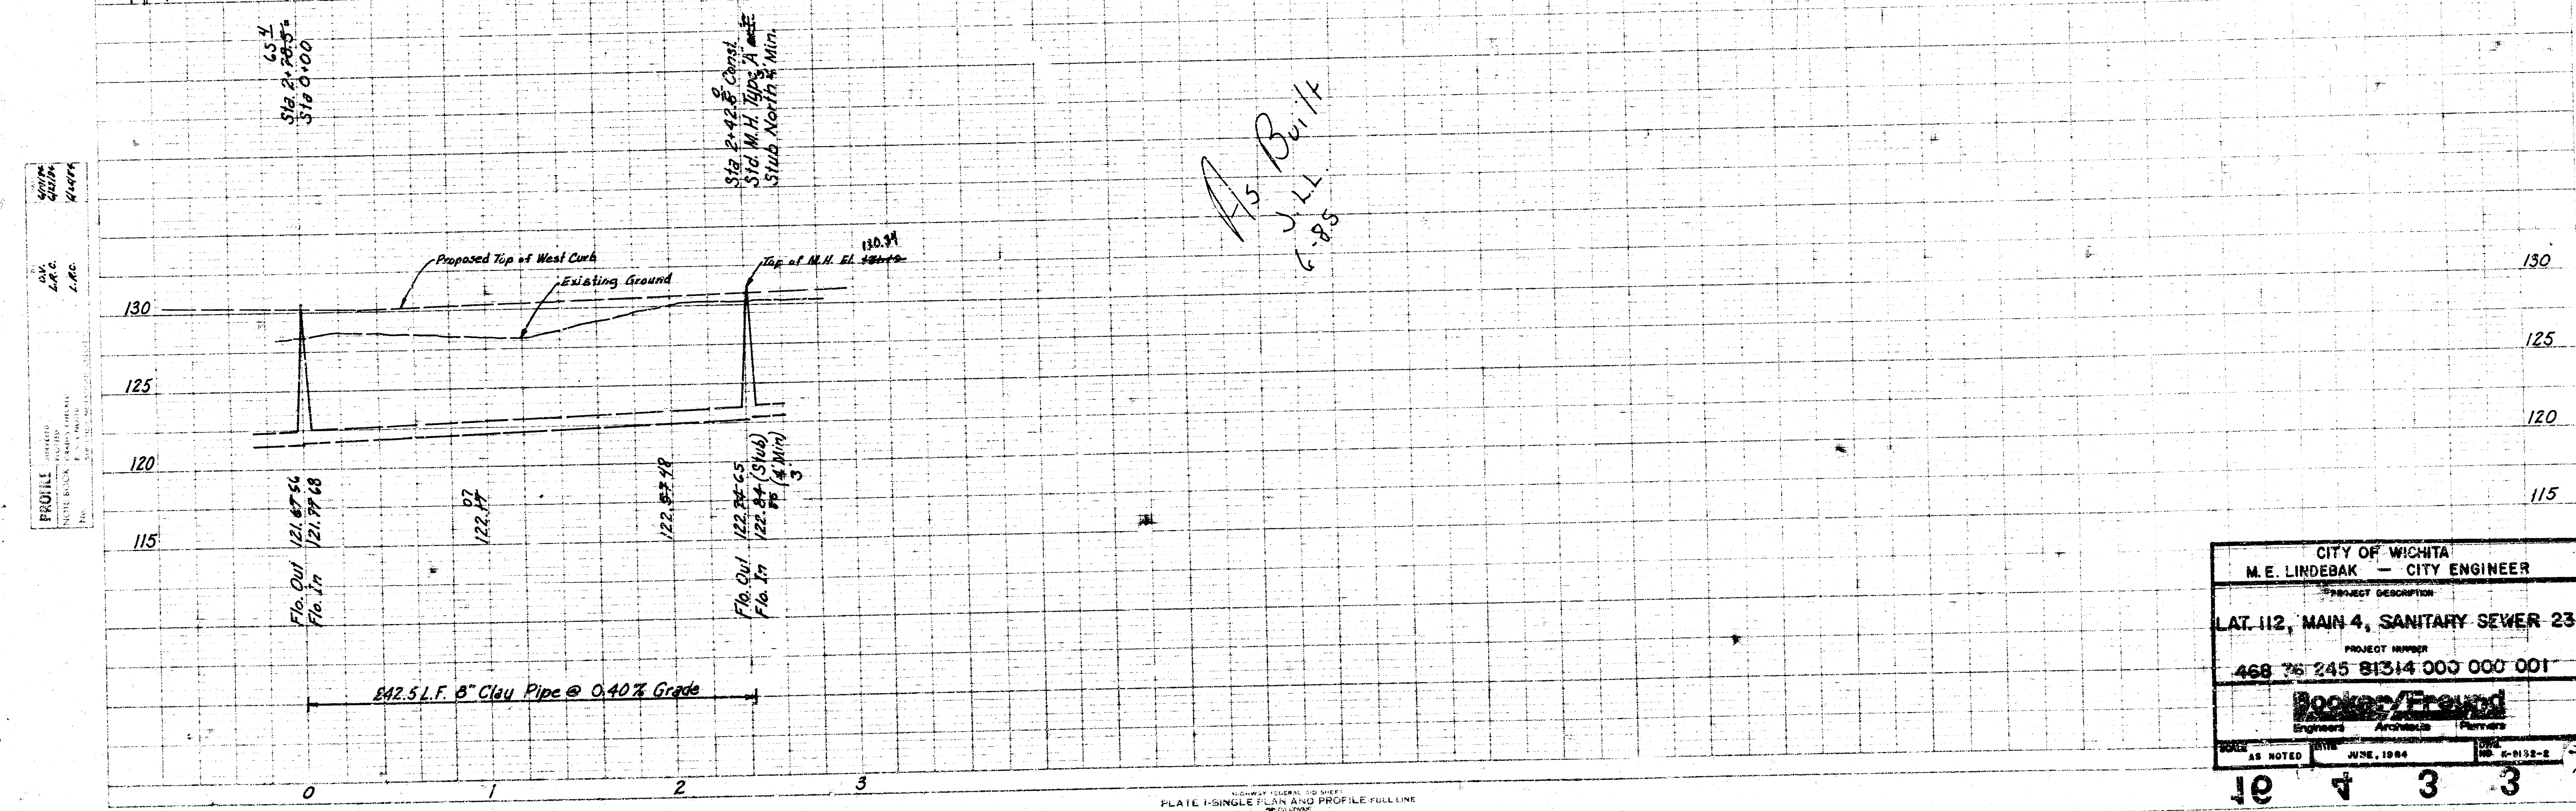

CITY OF WICHITA	
M.E. LINDEBAK - CITY ENGINEER	
PROJECT DESCRIPTION	
LAT. 112, MAIN 4, SANITARY SEWER 23	
PROJECT NUMBER	
468 76 245 81314 000 000 001	
Docket/Fraud	
Engineers Architects Planners	
DATE AS NOTED	DATE JUNE, 1984
NO. 1-1132-2	