
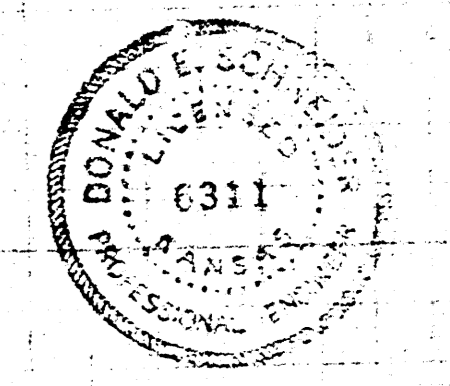
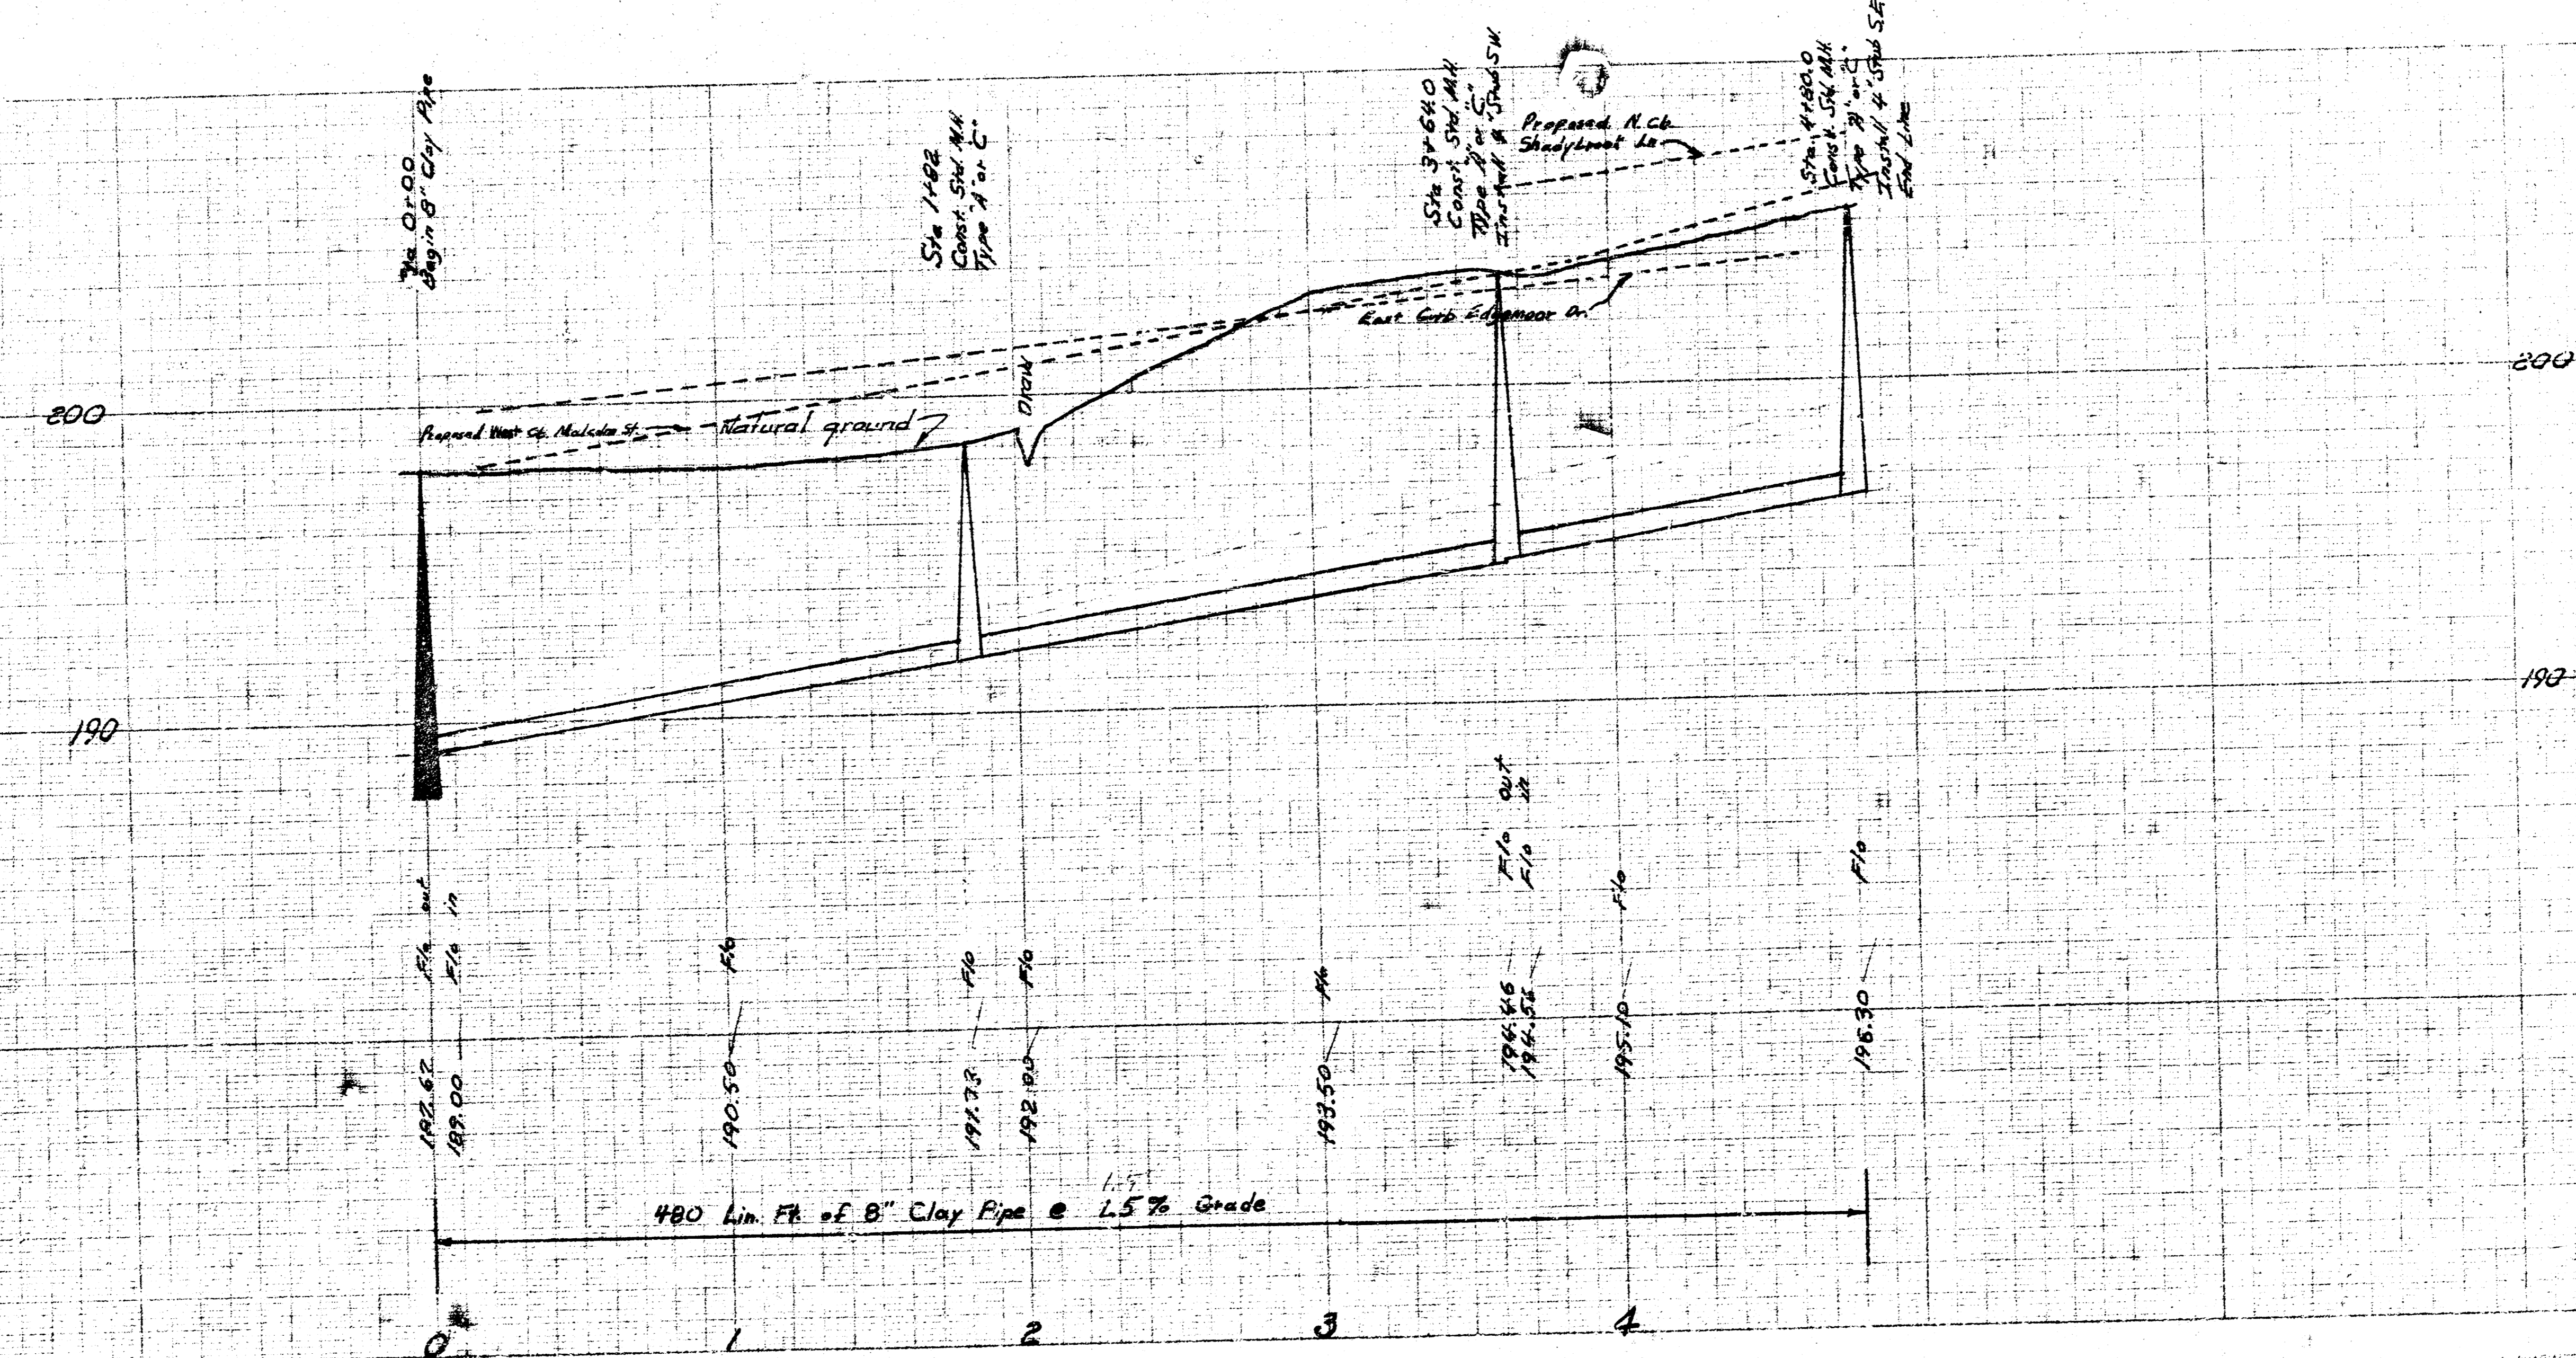


B. M. 204.69 "a" Top N. end W. clyt Headwall ent.  
 clyt. N. S. 21st. 200' E. of Edgemoor.

Surveyed by G.Y. Book No. 237-Y  
 Plan by U.W.  
 Checked by

Plan Scale 1" = 40' Horiz.  
 Profile Scale 1" = 4' Vert.

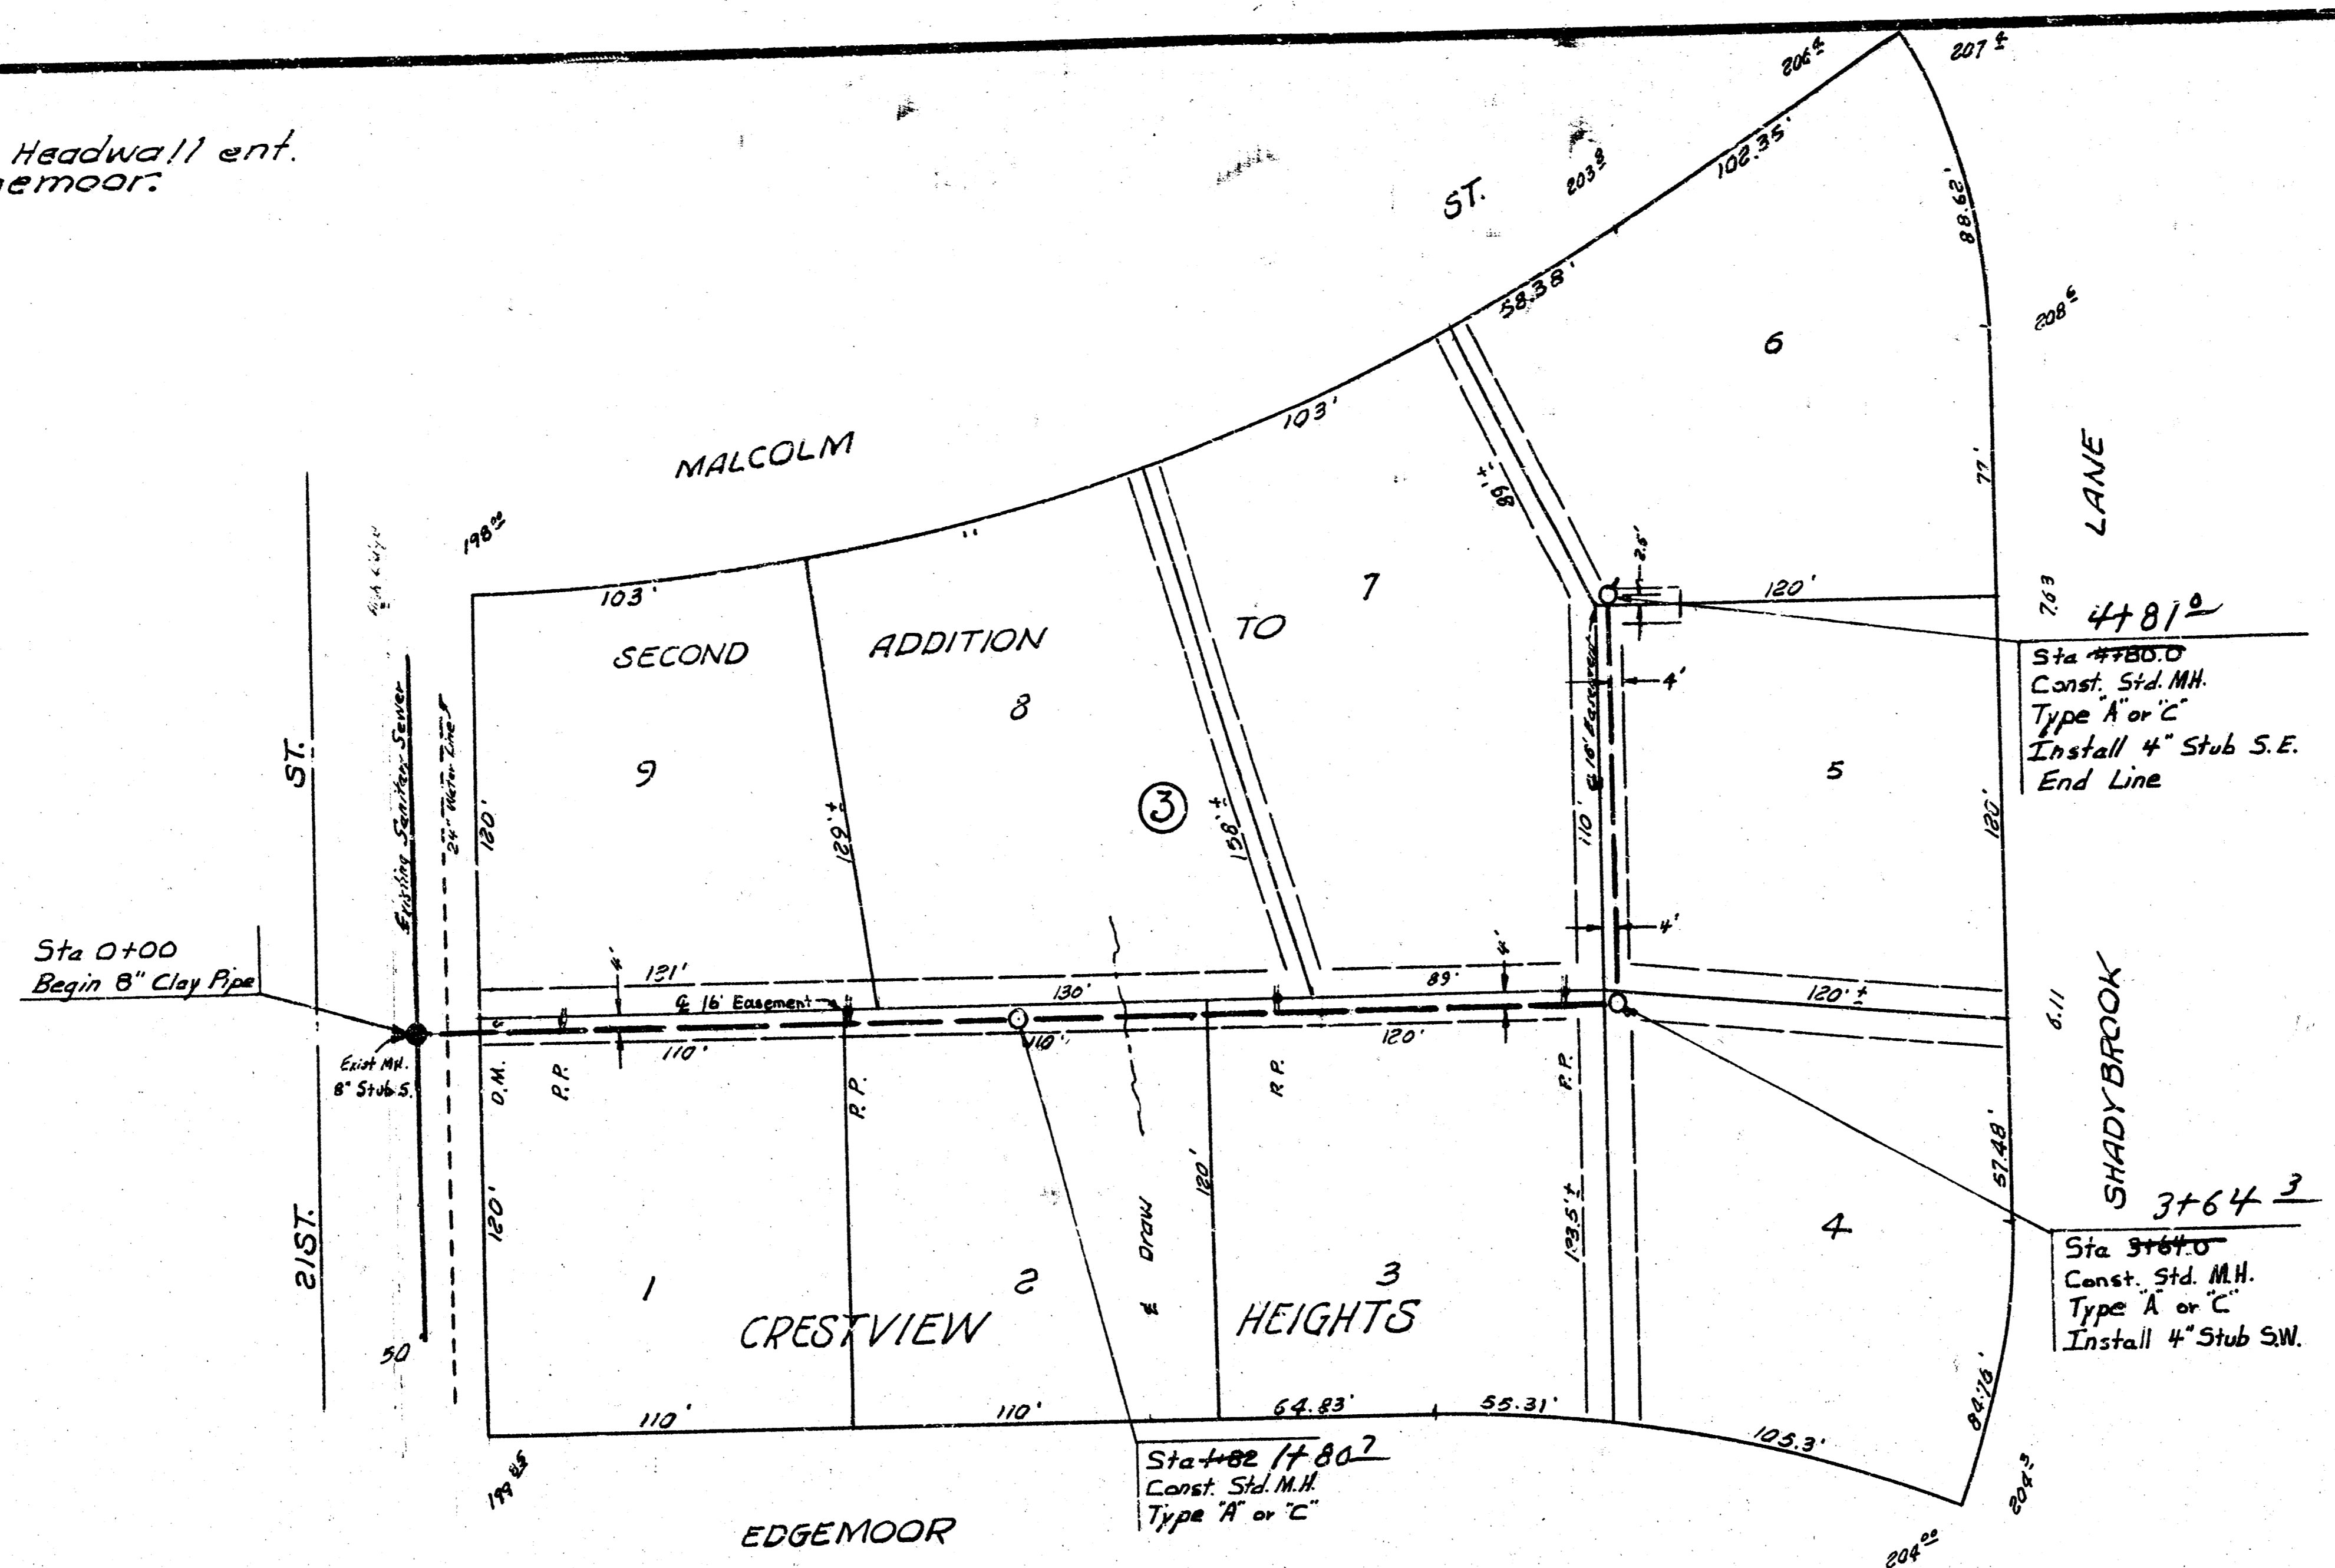

As Built 3-11-76  
 LAT. II, SUBMAIN 5, S. S. NO. 23  
 CITY OF WICHITA, KANSAS  
 R. W. LINN CITY ENGINEER  
 PROJECT DBKL566040

W. J. BARNETT  
 2311 S. 10TH ST.  
 WICHITA, KANSAS 67202