




B. M. 204.69 Top N. end W. c/vt. Headwall
Ent. c/vt. N. S. 21st 200' E. of Edgemoor.

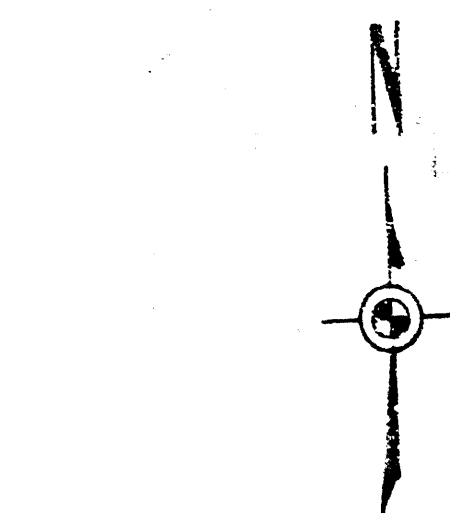

Plan Scale 1" = 40'
Profile Scale 1" = 10' vert.

Survey by G.Y. Book 237-Y
Plan by J.R.W.
Checked by

NOTE:
Use extreme caution in
excavating stub at Sta.
0+00.0 as end of pipe
may be farther east of
manhole than indicated
by plan.

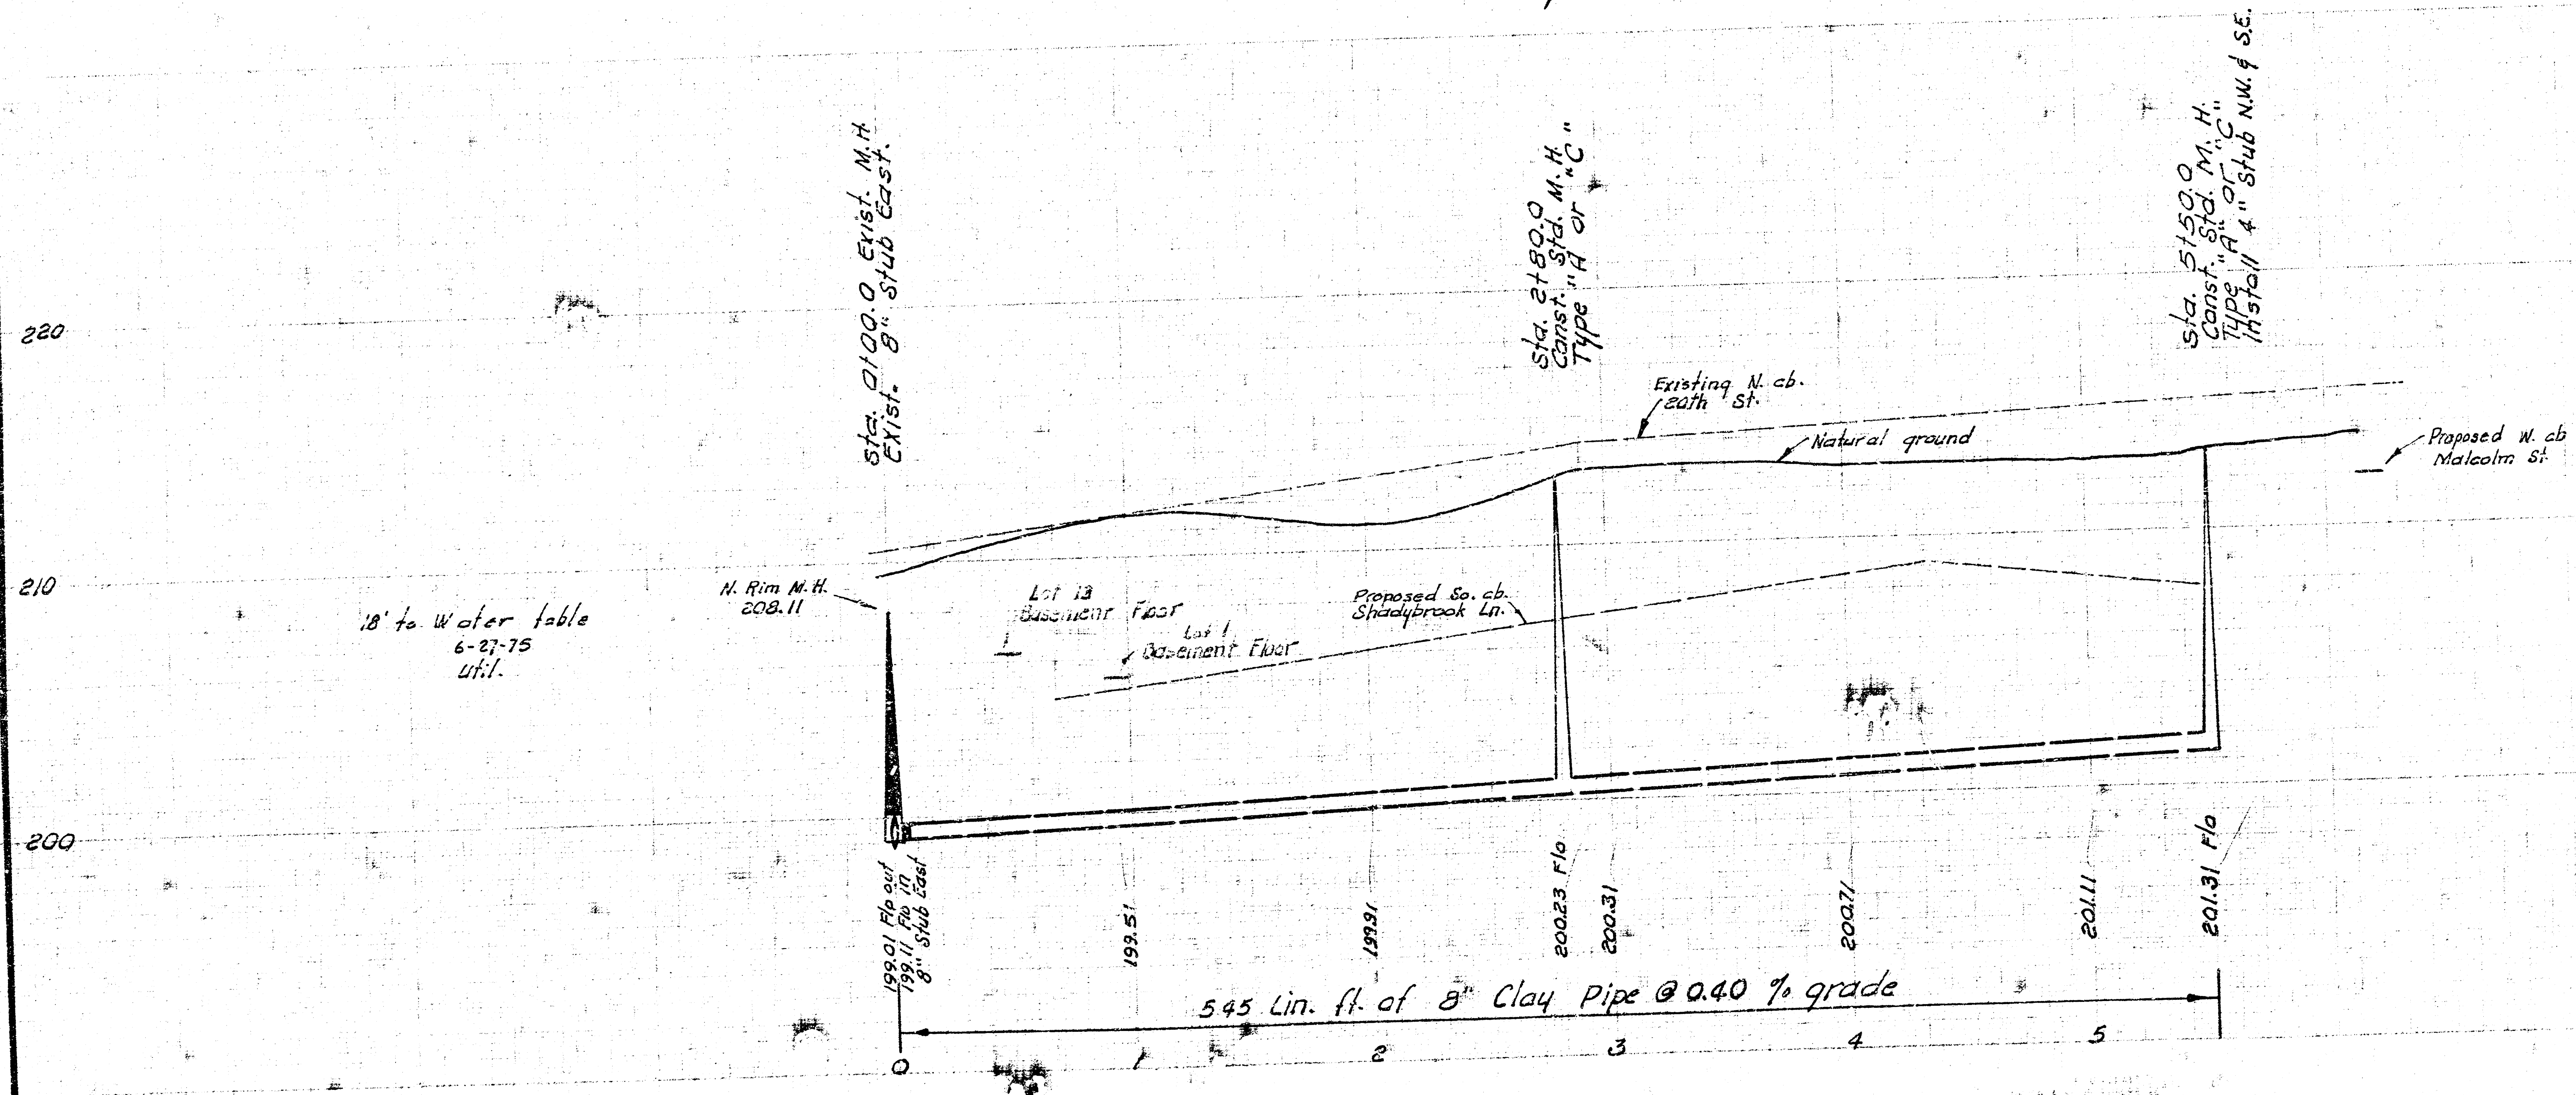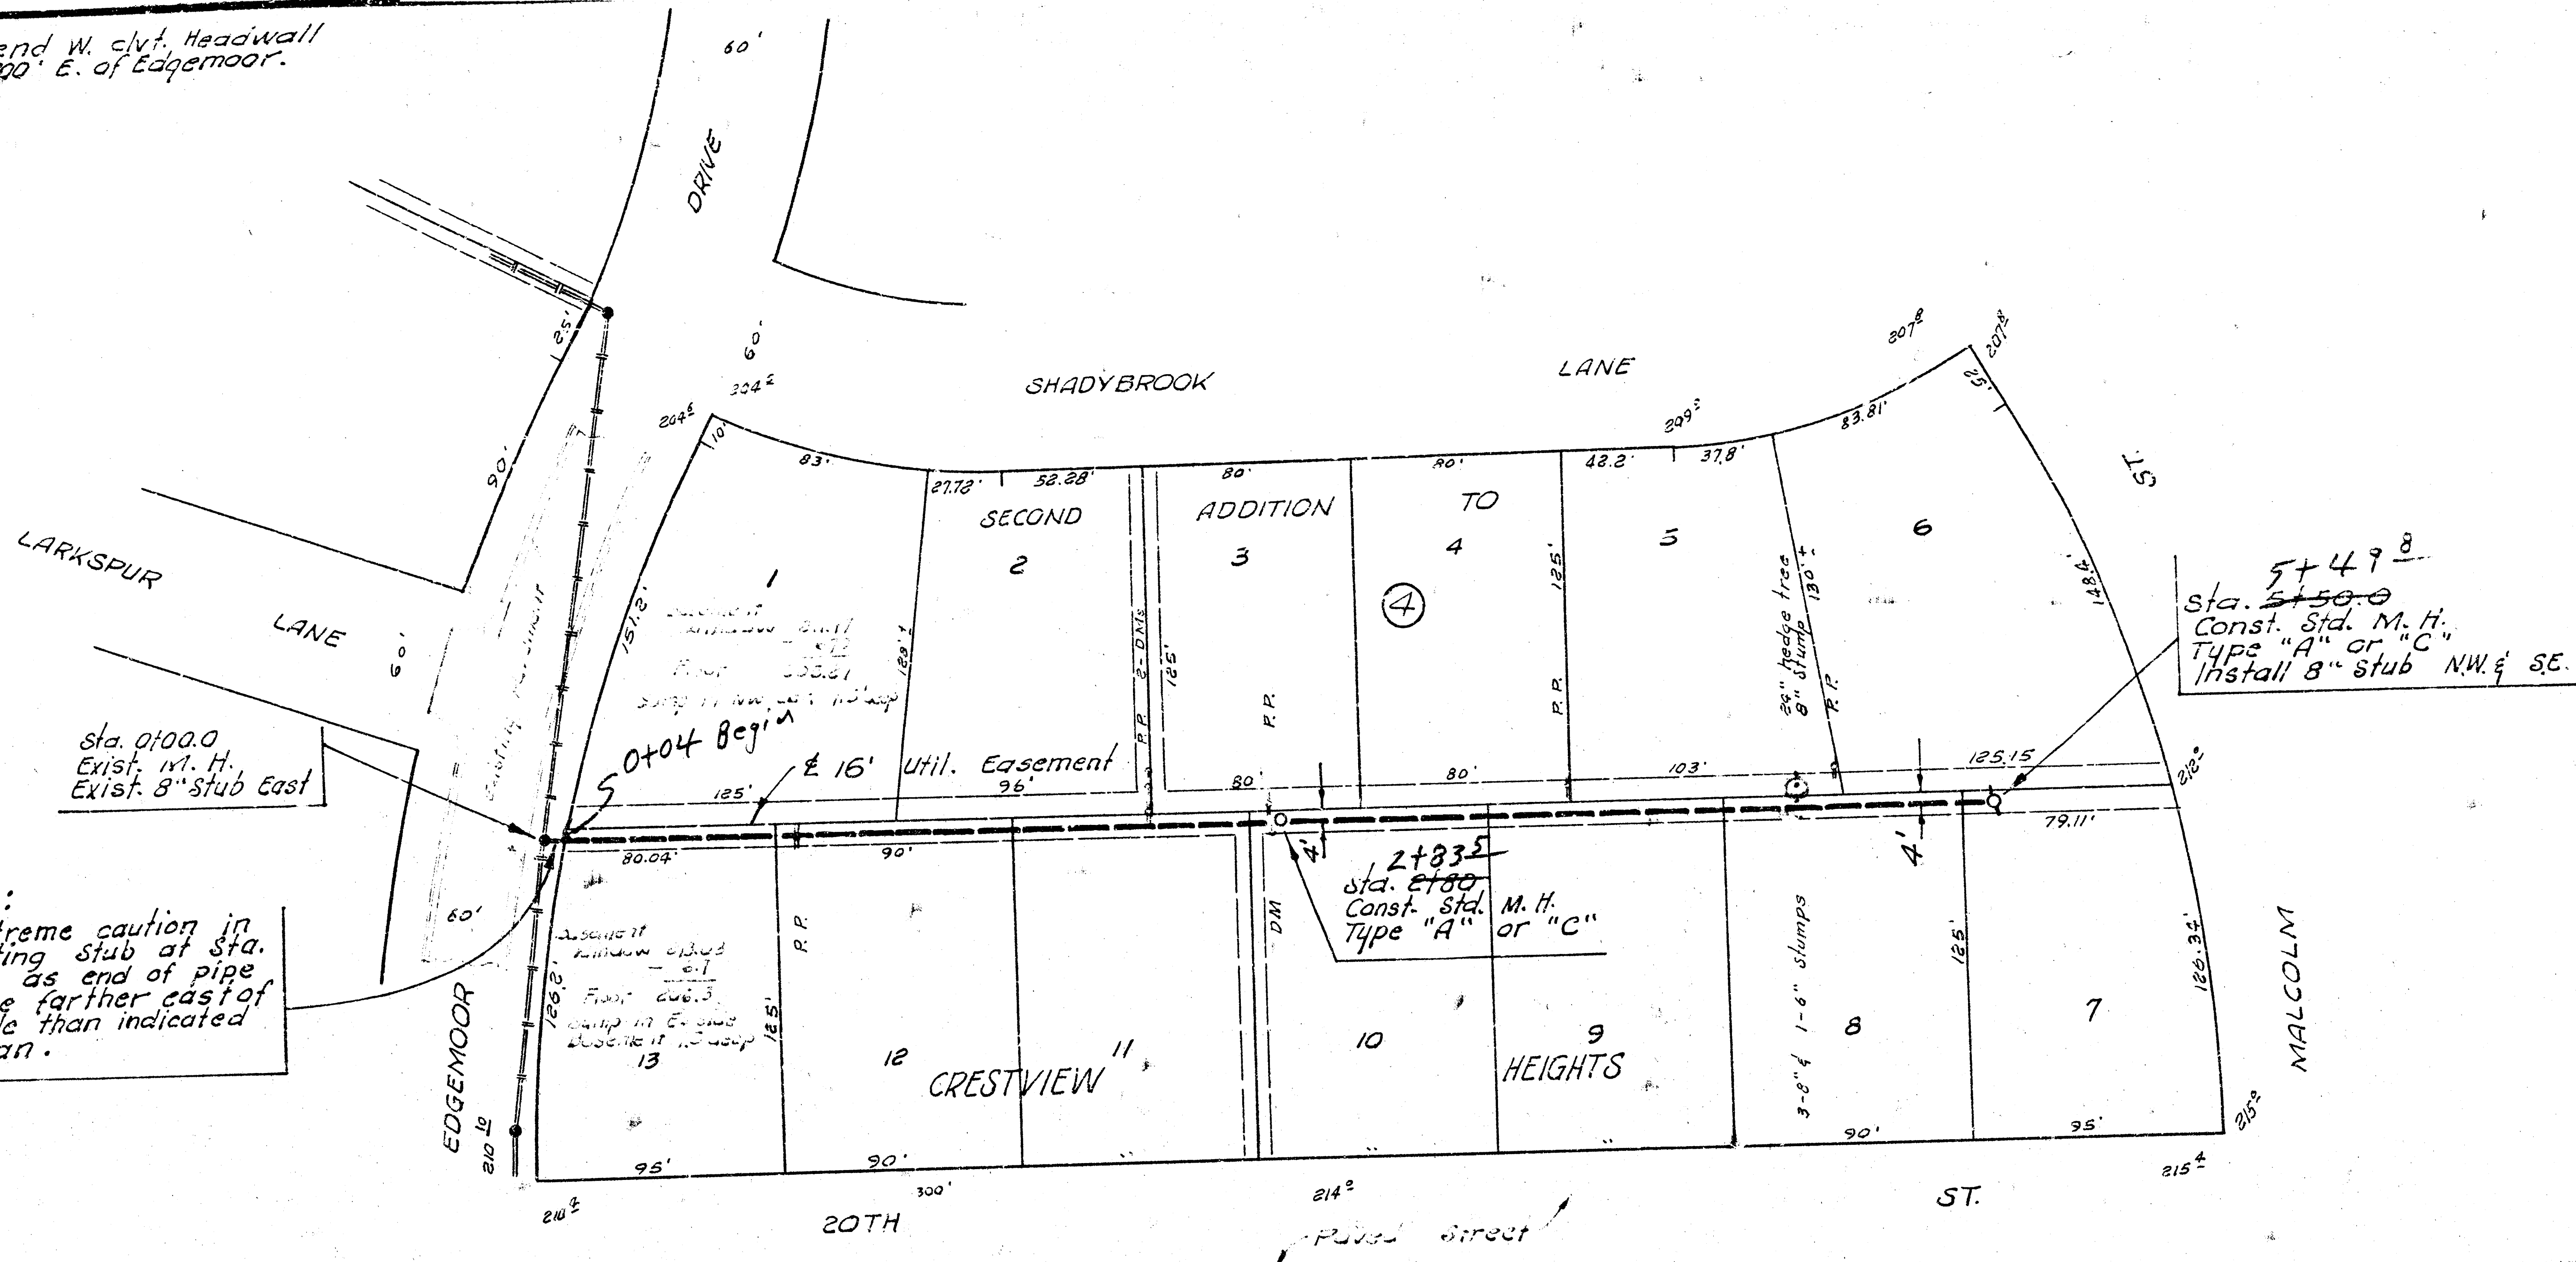

As Built 10-14-75
LAT. 12, SUBMAIN 5, S. S. NO. 23
CITY OF WICHITA, KANSAS
R. W. LINN — CITY ENGINEER
DATE: PROJECT NO. DBKL566041