



T.B.M. 218.72 60" nail W.S.P.P. S.E. cor
lot 5 Block 12 Crestview Hqts. 1st.

Survey by G. Y. Book 241-Y 237-Y
Plan by J. W. & D. E. C.
Checked by _____

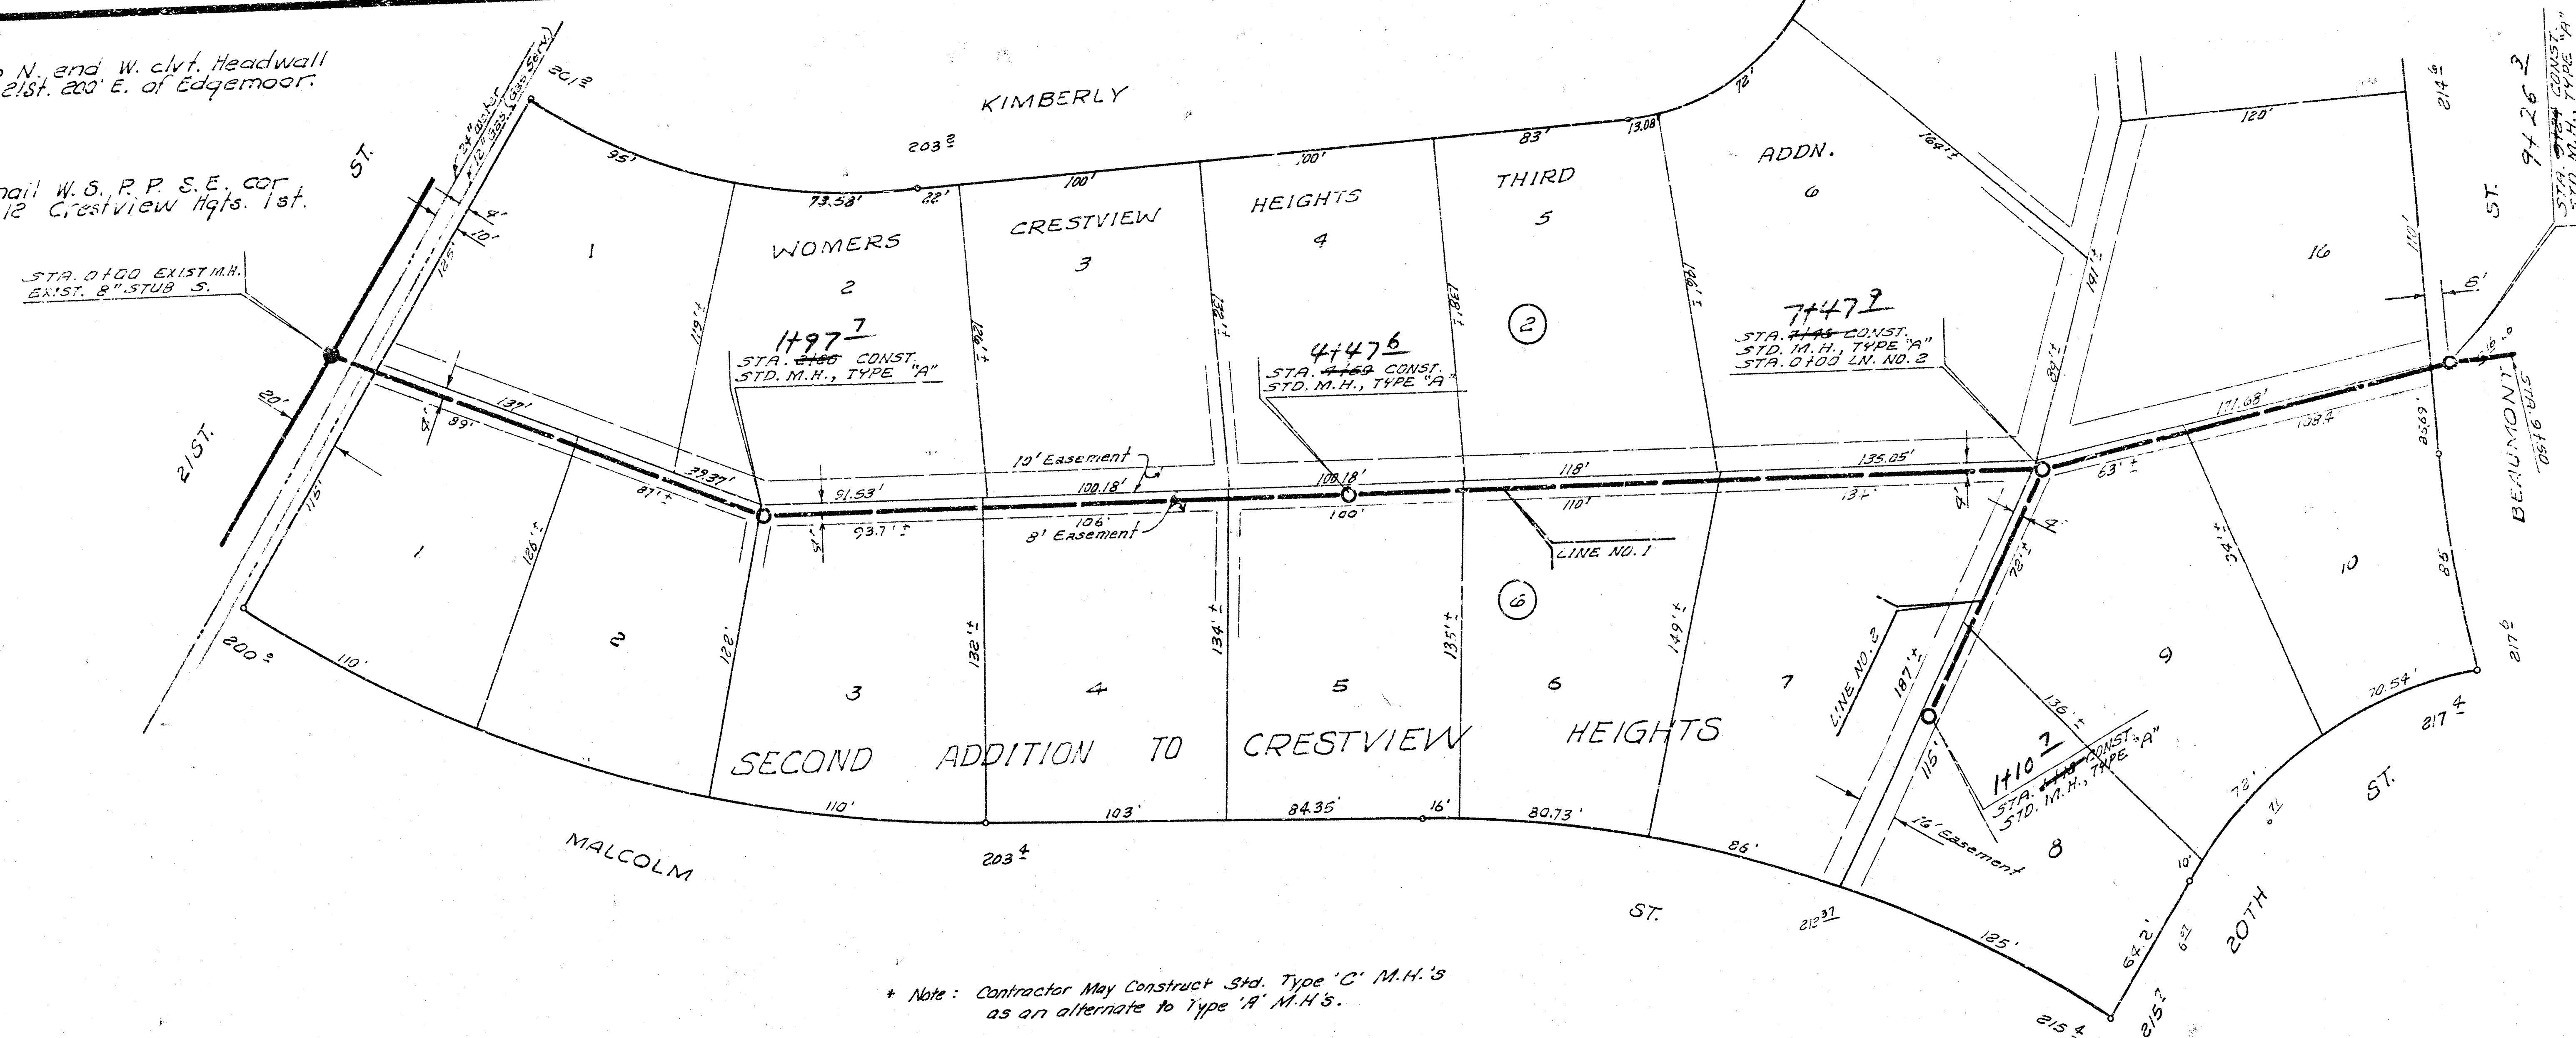

* Note: Contractor May Construct Std. Type 'C' M.H.'s
as an alternate to Type 'A' M.H.'s.

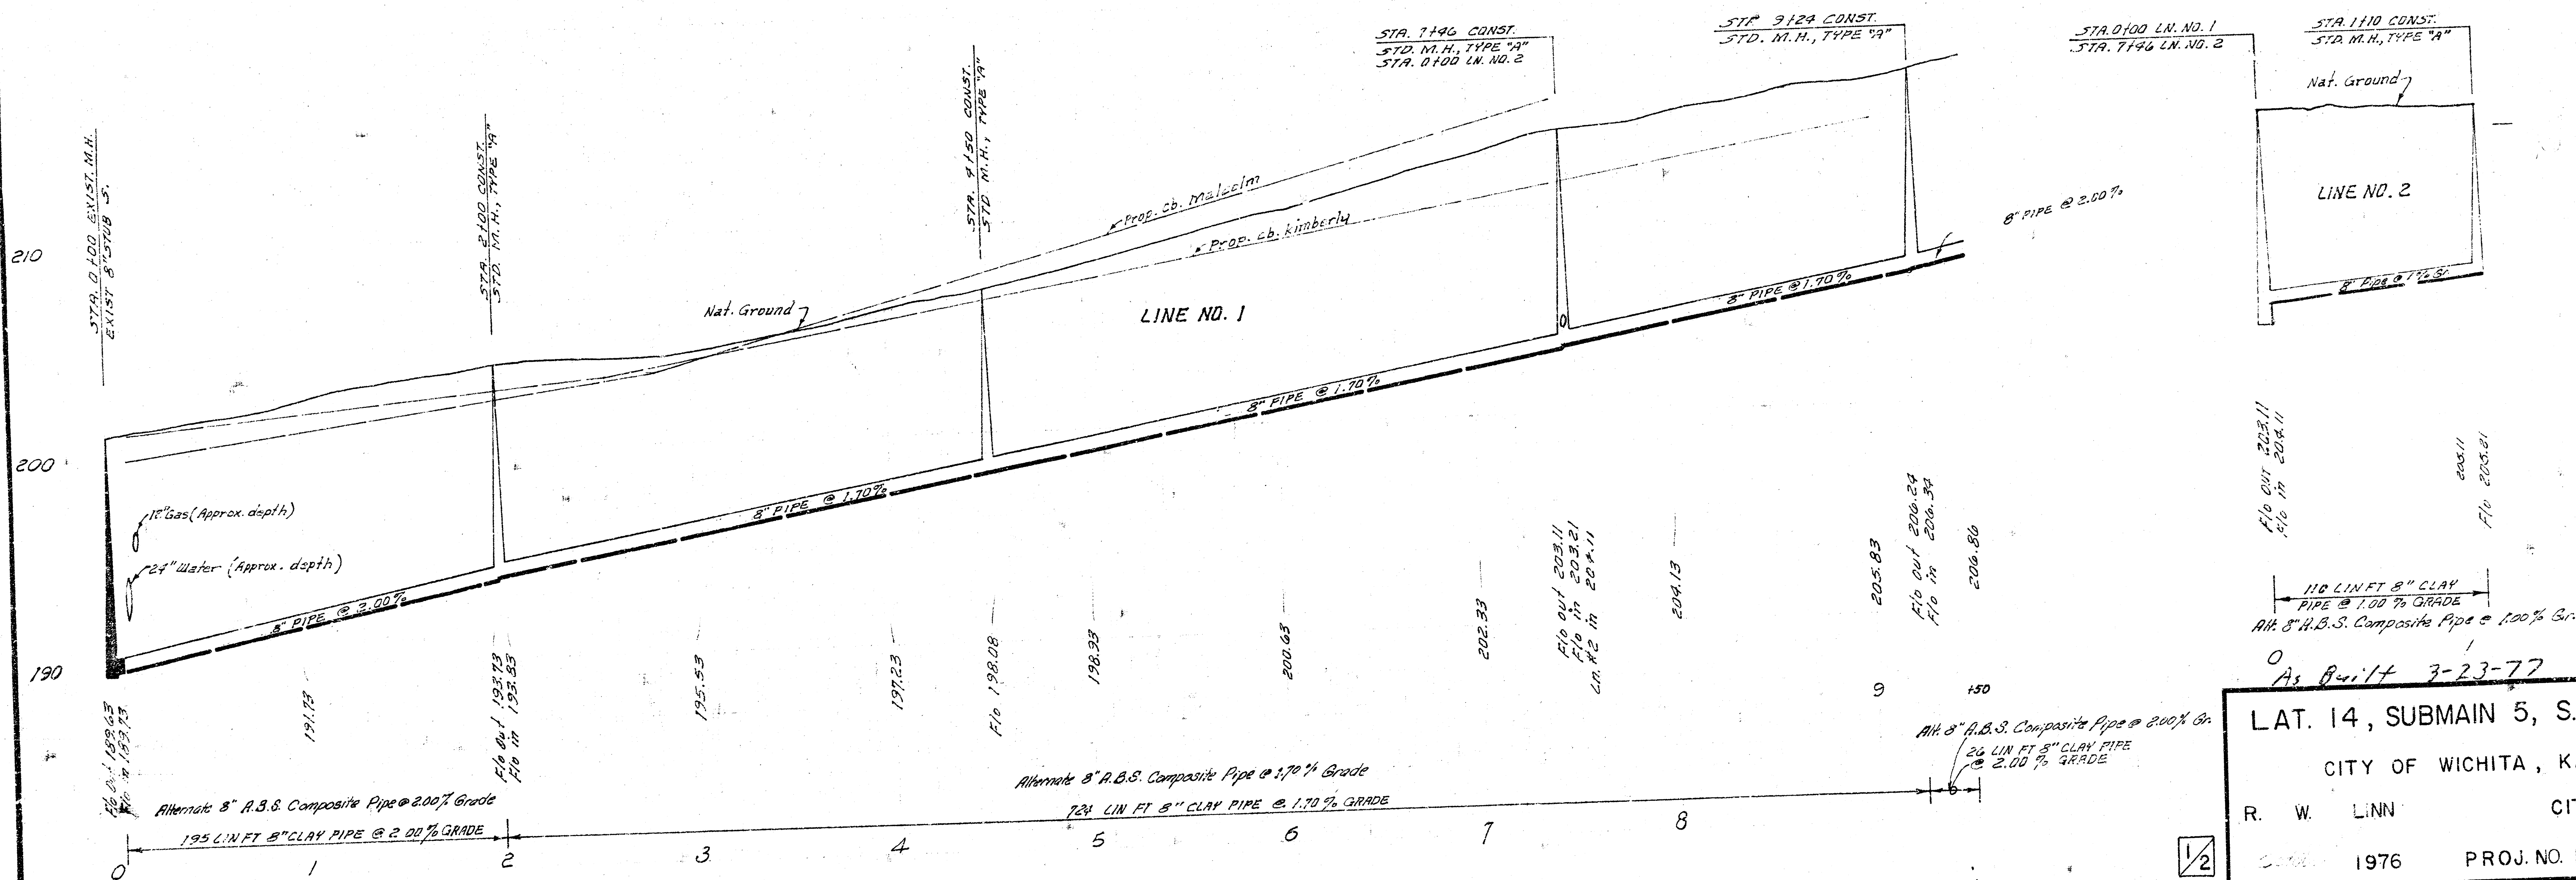


LAT. 14, SUBMAIN 5, S. S. NO. 23

CITY OF WICHITA, KANSAS

R. W. LINN CITY ENGINEER

1976 PROJ. NO. DBKL 566043

Bk. 237-Y

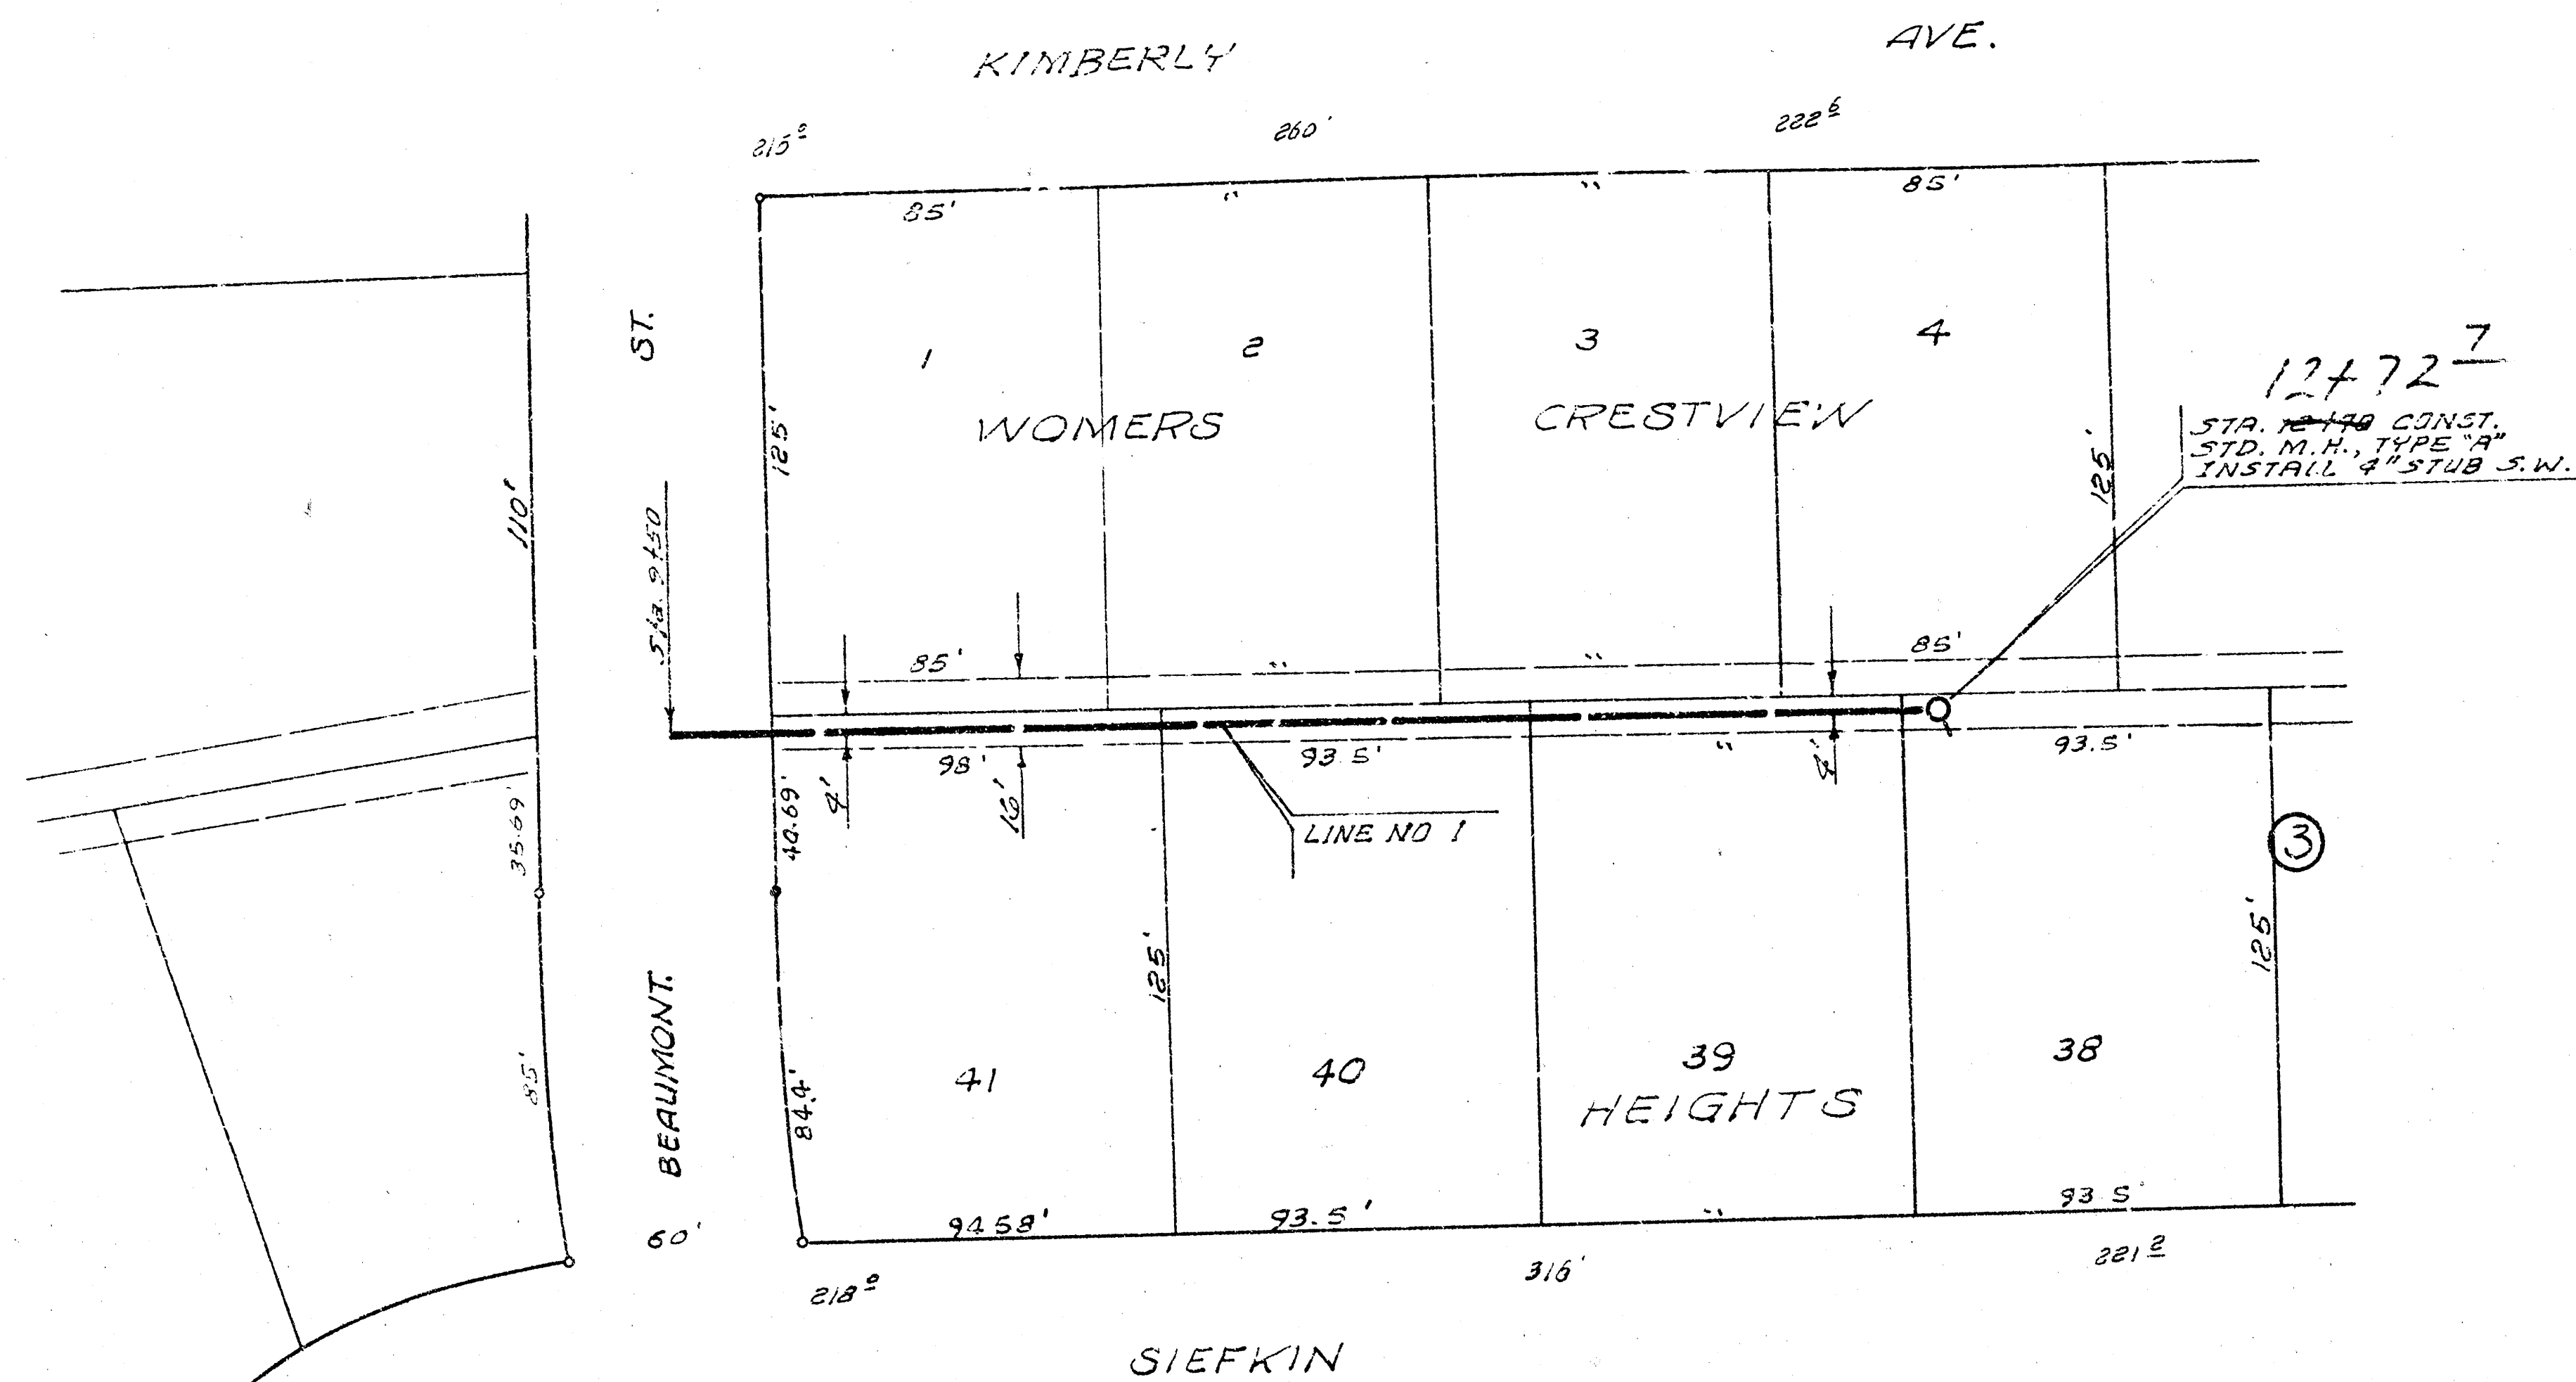


B.M. 217.94' top N. cb 19th
10' E. W. of Beaumont.

220

210

200

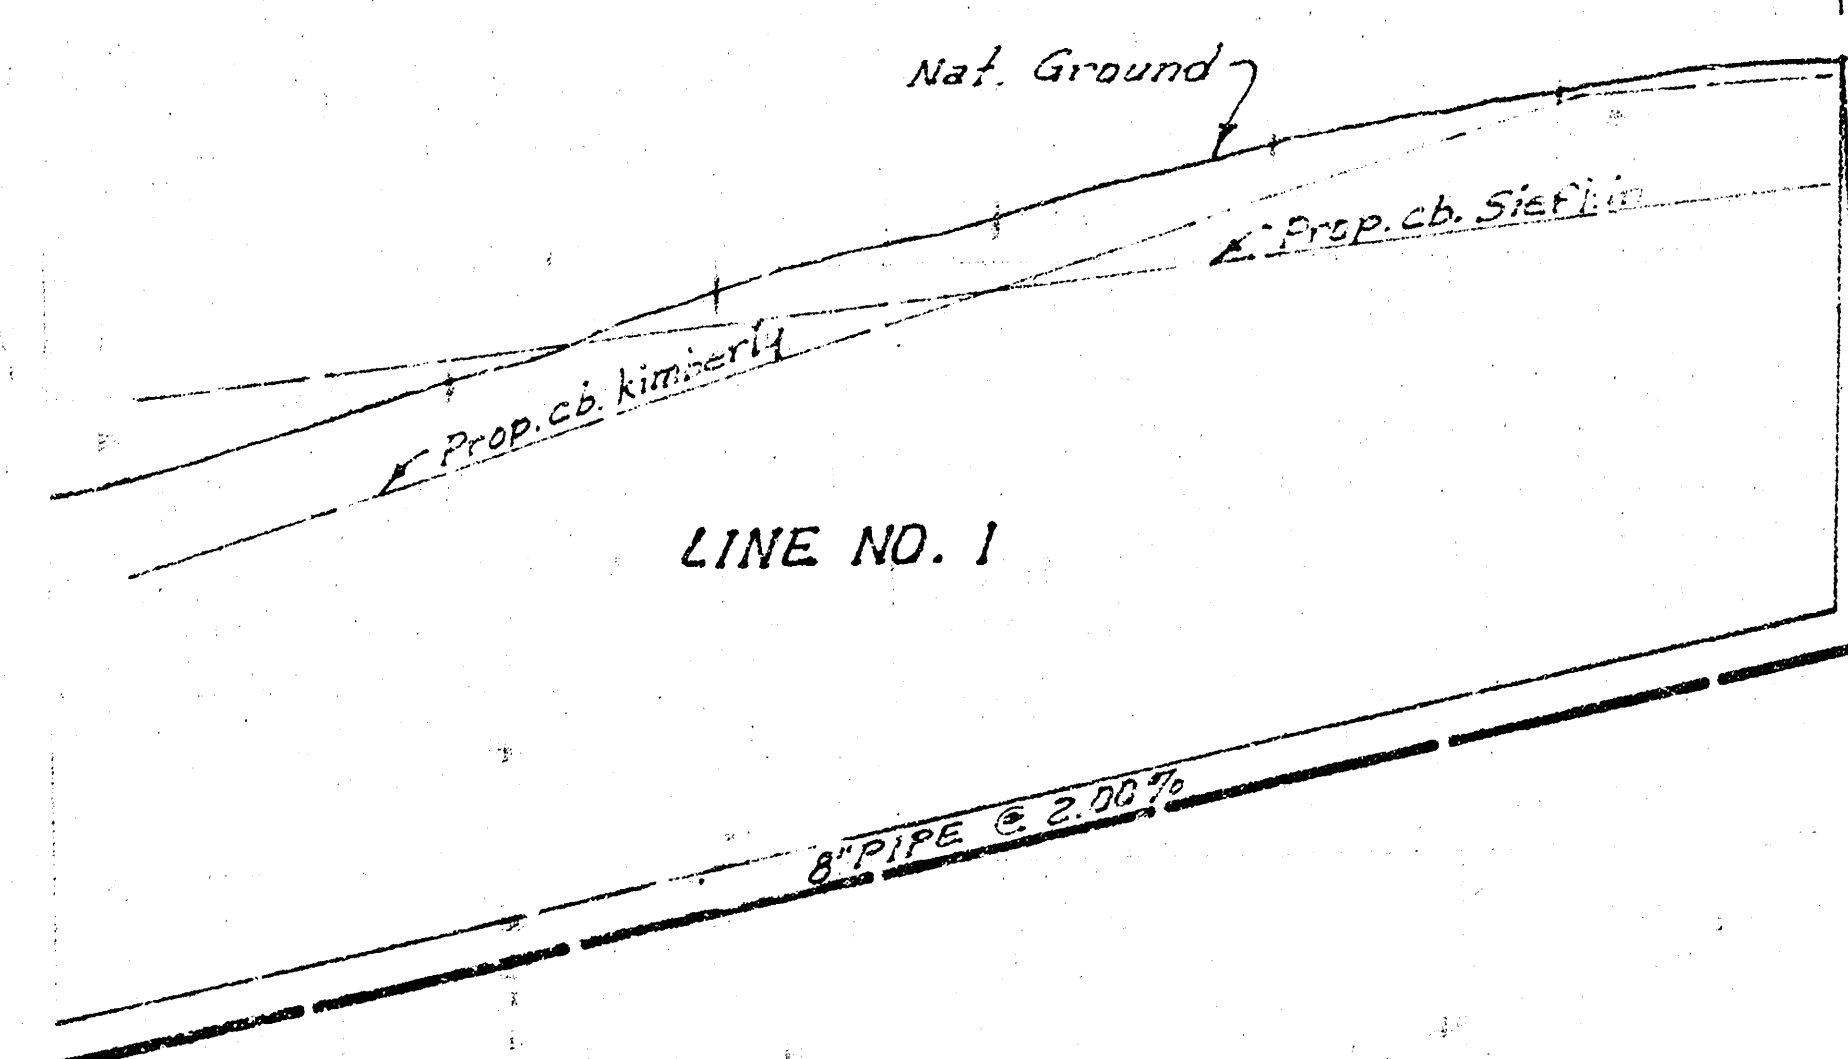

220

210

200

9 10 11 12

320 LIN. FT. 8\"/>

2/2

L AT. 14, SUBMAIN 5, S. S. NO. 23
PROJECT NO. DBKL 564023