

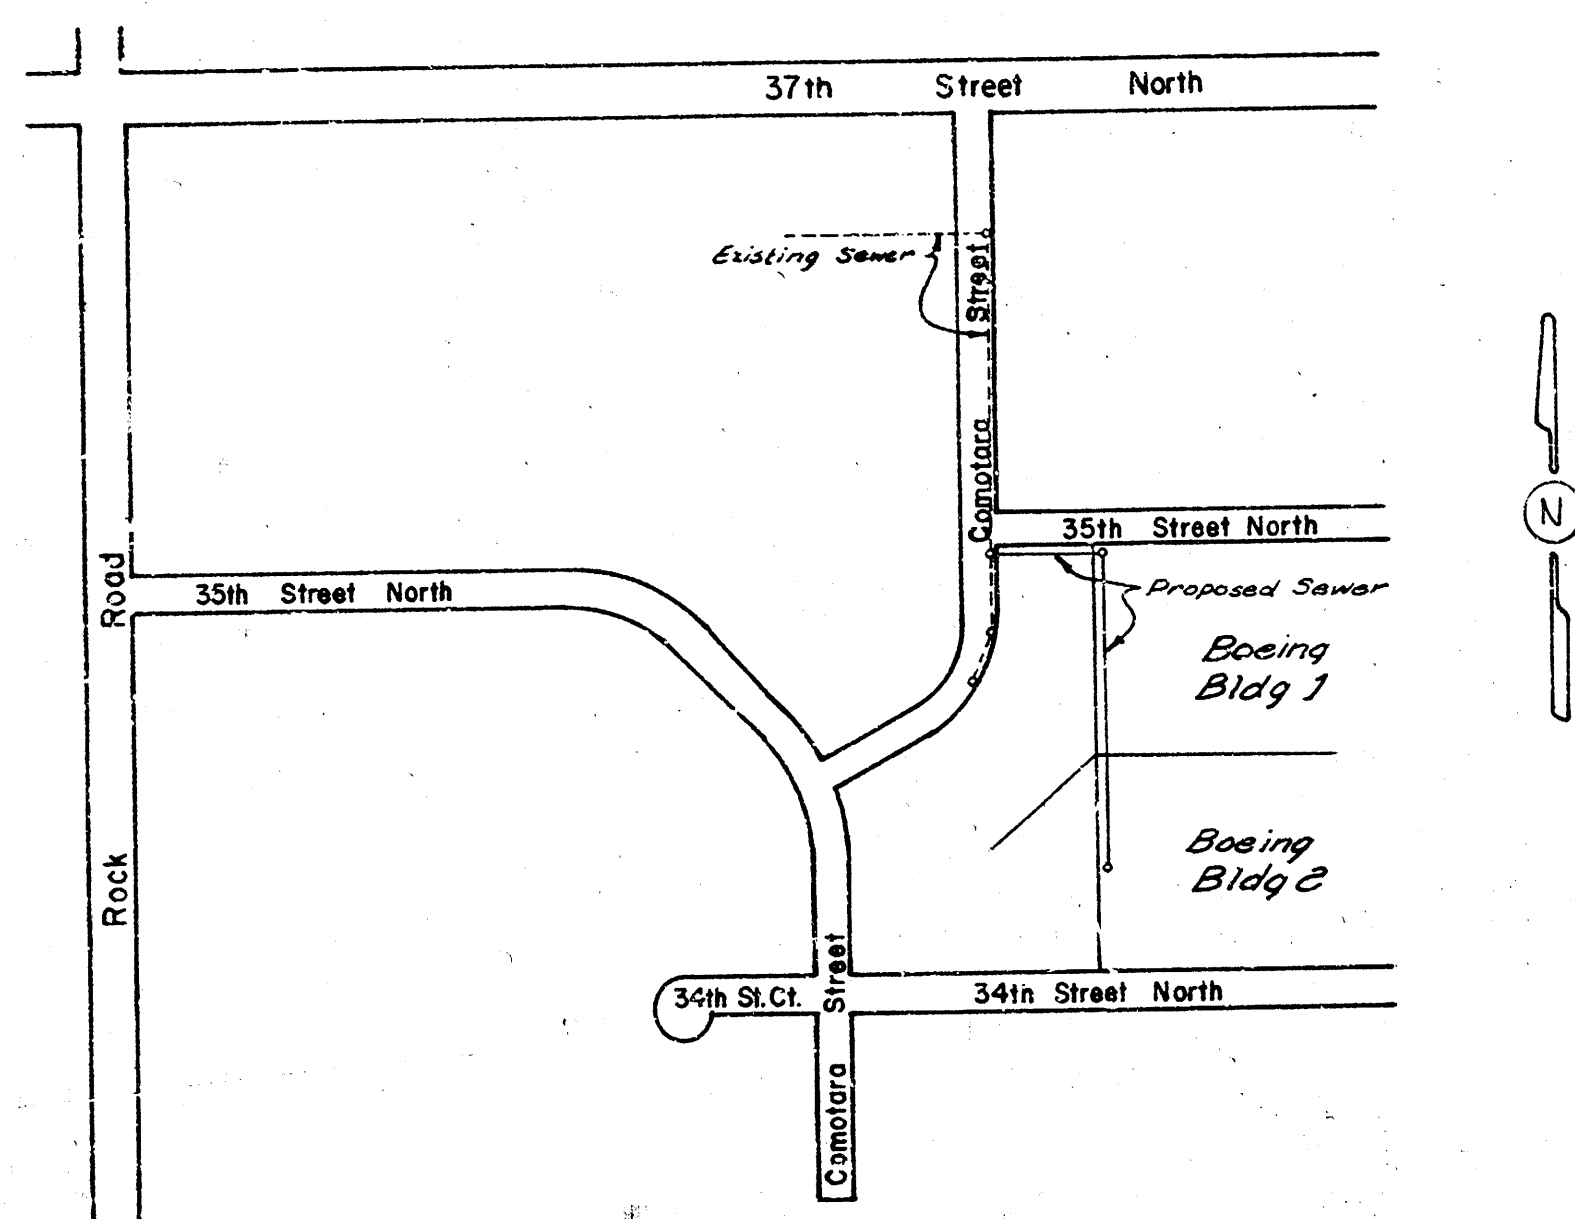


LATERAL 15, MAIN 7, S.S. 23
 Project No.
 468-76-245-80667-000-000-001

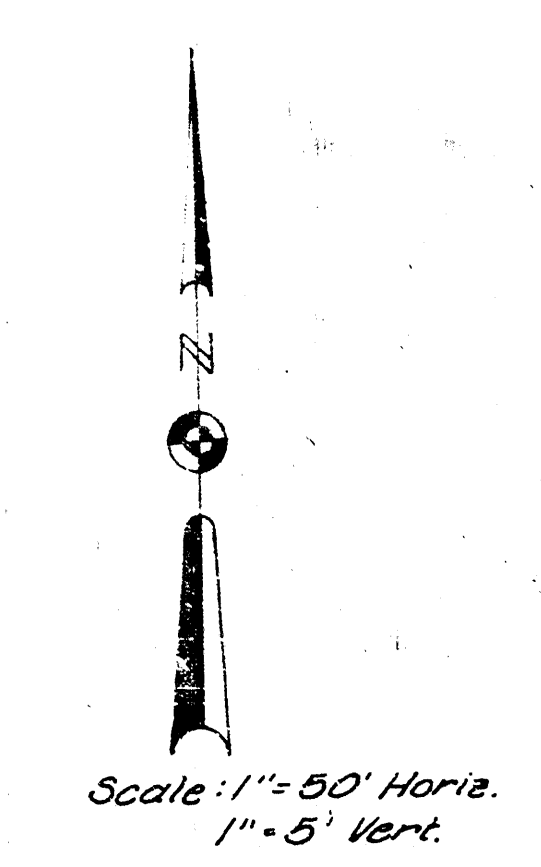

LOCATION MAP

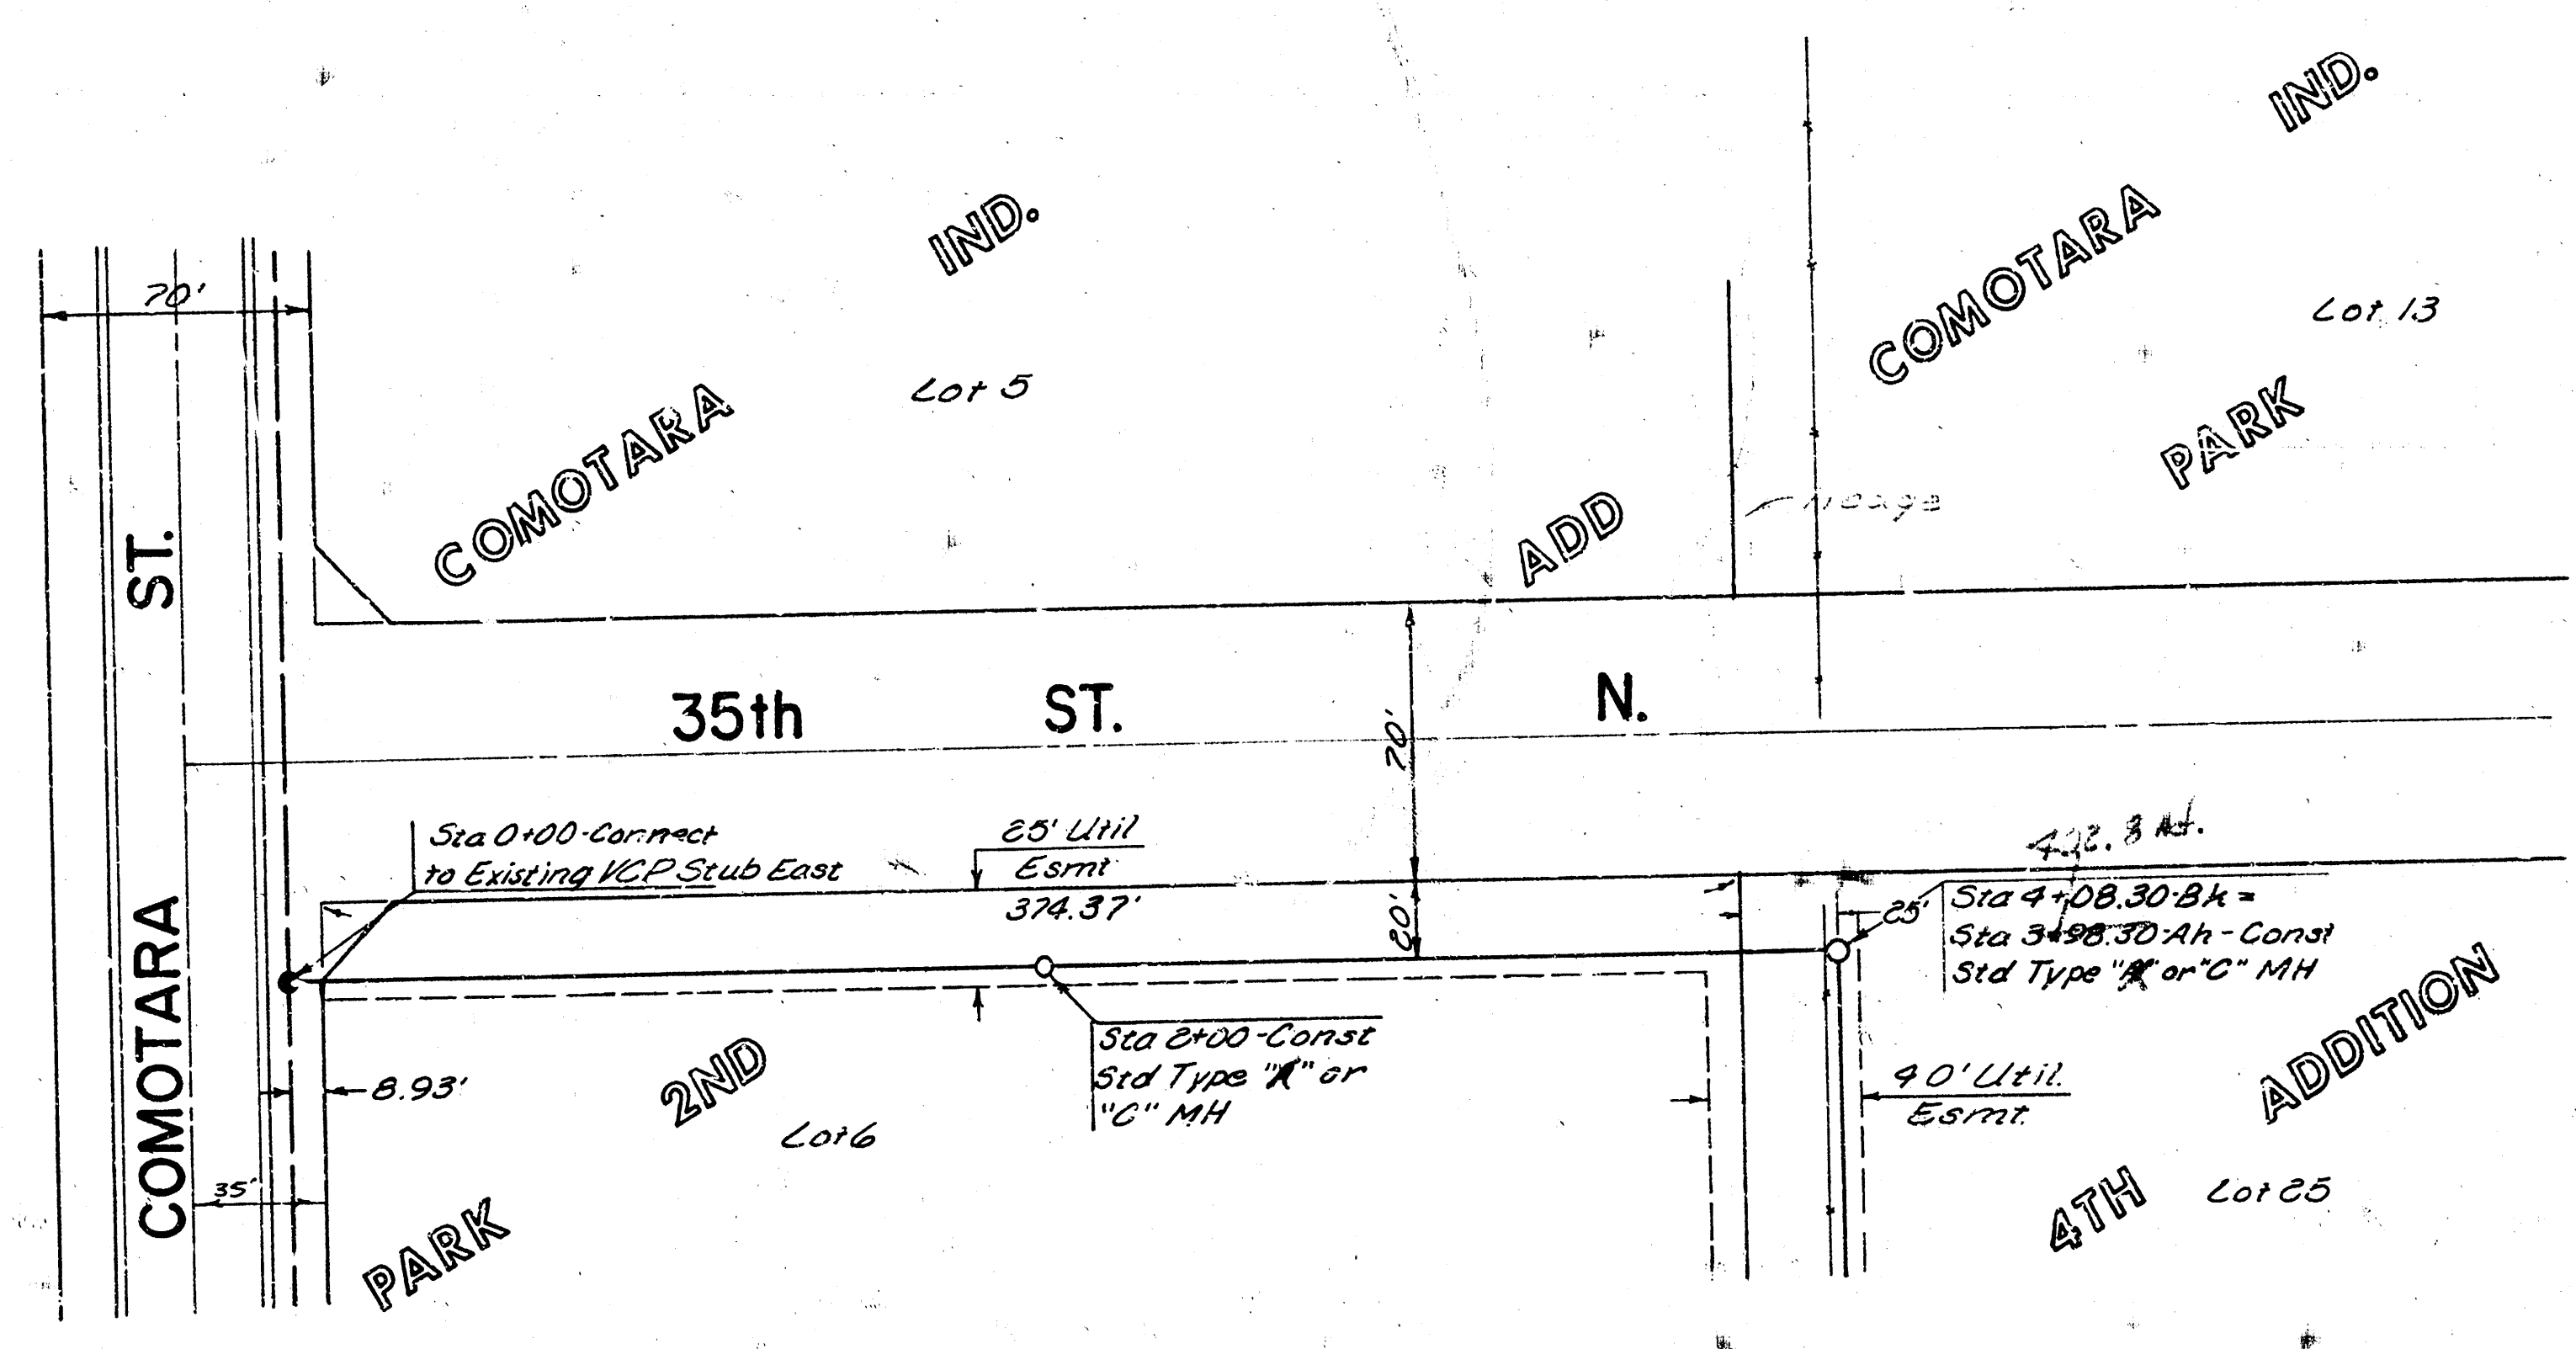


BM: Top of Iron 61.36' E of the NW cor Lot 25 Elev = 231.03

Benefit Dist.
 Lot 25 & 26 Comotara Ind. Park 4th
 Lot 2 Comotara Ind. Park 5th

NOTE: SEE RESOLUTION FOR BENEFIT DISTRICT.


Revised 12-27-78. Sewer line moved 10' East to avoid conflict with new H&E power poles

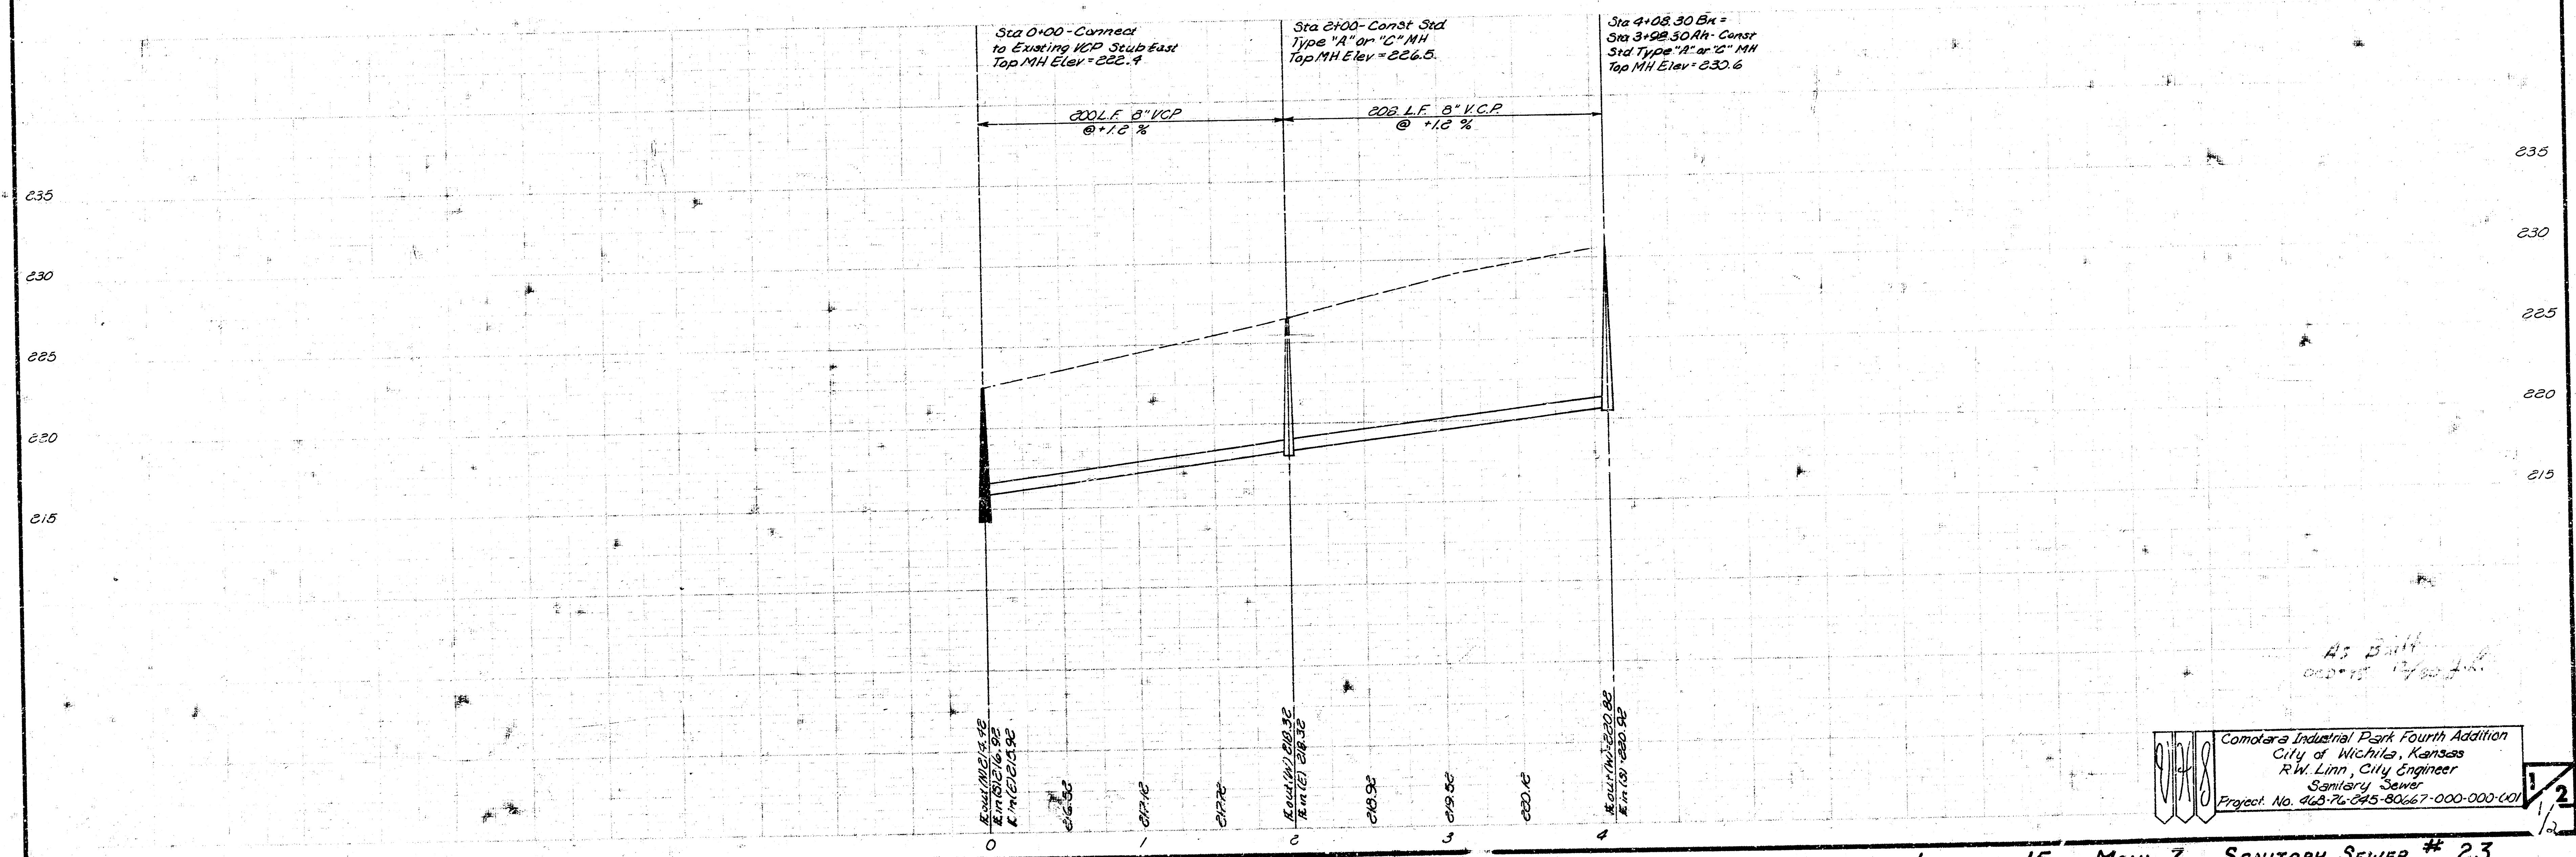


Comotara Industrial Park Fourth Addition
 City of Wichita, Kansas
 R.W. Linn, City Engineer
 Sanitary Sewer
 Project No. 468-76-245-80667-000-000-001

LATERAL 15, MAIN 7, S.S. 23
 Project No.
 469-76-245-80667-000-000-001

Scale: 1" = 50' Horiz.
 1" = 5' Vert.
 B.M.: Top of Iron 61.36' E of
 the NW cor. Lot 25
 Elev. 231.03

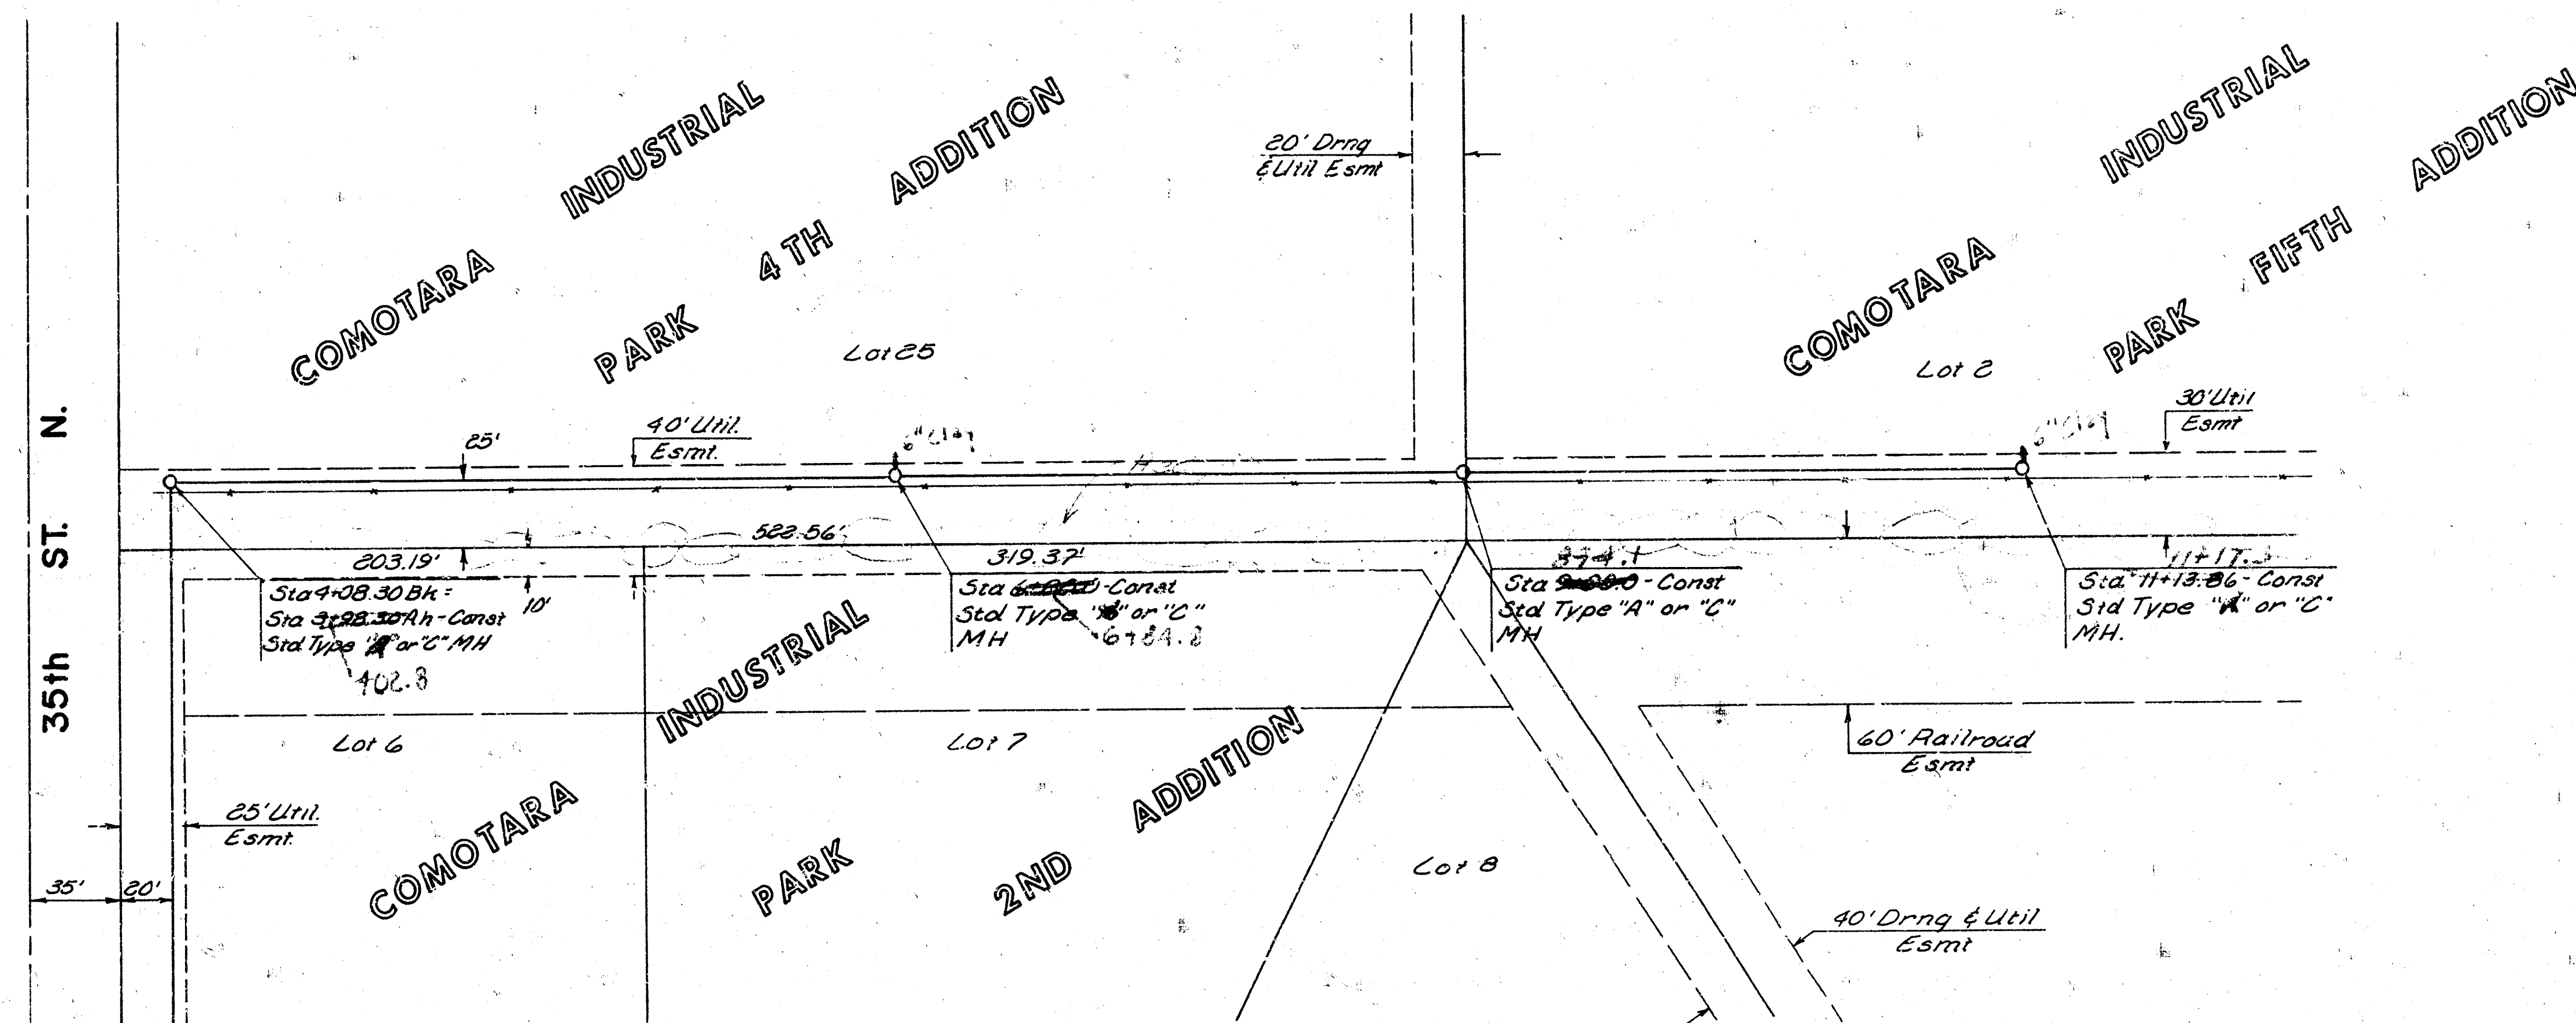

NOTE: FIELD ENGINEER SHALL VERIFY LOCATION AND ELEVATION OF 6" STUBS IN MANHOLES AT STATION 6+80 & 11+13.86 FOR CONNECTION TO BUILDING SEWER.

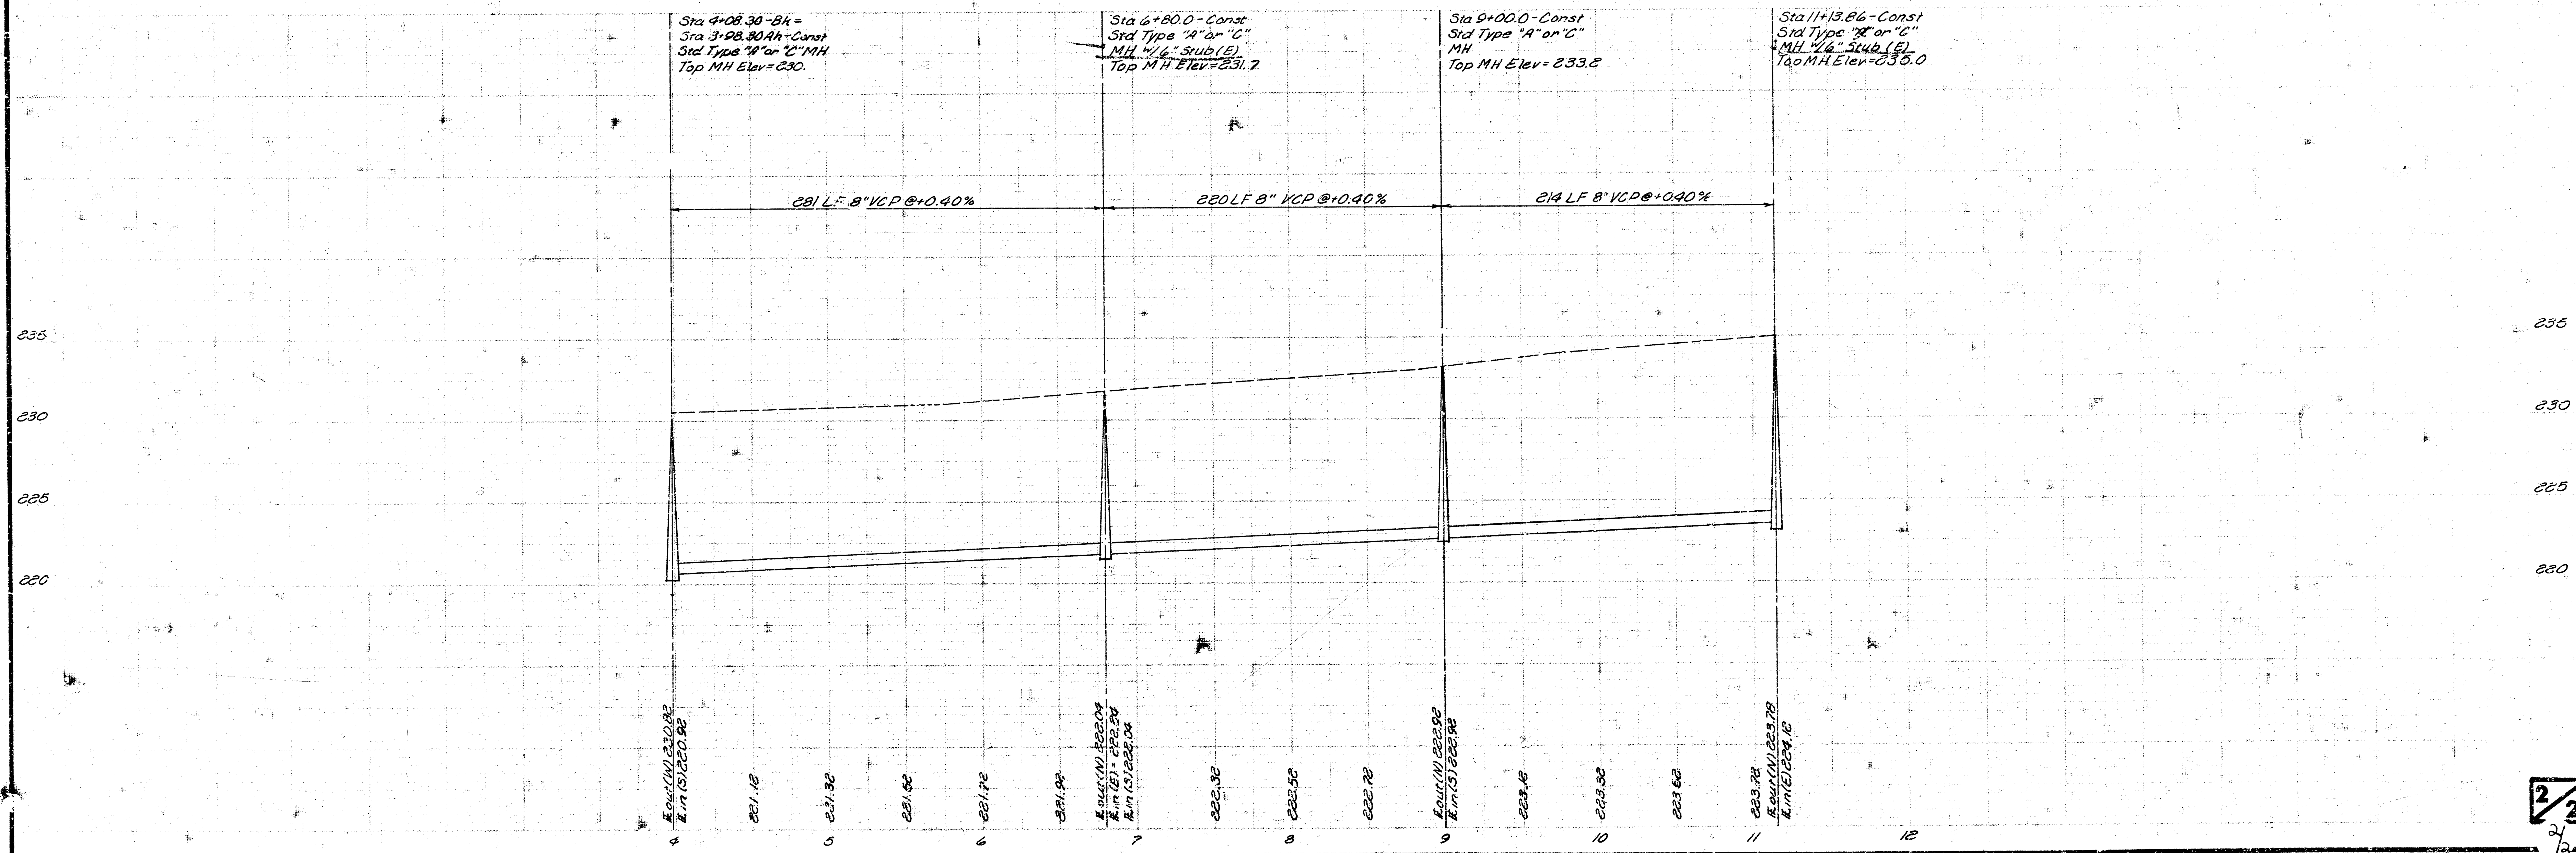

2/2

14 5 3 11