

MANHOLE ON MAIN 9, SANITARY SEWER 23 FOR

WILLOWBEND CLUBHOUSE

PROJECT NO.

468-76-245-80001-000-000-106

CITY OF WICHITA, KANSAS

MICHAEL E. LINDEBAK, CITY ENGINEER


GENERAL NOTES

1. THE CONTRACTOR SHALL BE RESPONSIBLE FOR PRESERVING PROPERTY IRONS. THE CONTRACTOR SHALL BE REQUIRED TO RE-ESTABLISH ANY PROPERTY IRONS WHICH ARE DAMAGED OR DESTROYED BY HIS CONSTRUCTION OPERATIONS. SUCH IRONS SHALL BE RE-ESTABLISHED BY A LICENSED LAND SURVEYOR OR A LICENSED PROFESSIONAL ENGINEER IN ACCORDANCE WITH STATE LAWS.
2. CONTRACTOR SHALL NOTIFY THE FOLLOWING COMPANIES PRIOR TO ANY EXCAVATION:

ARKLA GAS COMPANY	942-8350
BELL TELEPHONE	1-316-571-2115
CABLEVISION	262-0661
GAS SERVICE COMPANY	263-7511
KANSAS GAS & ELECTRIC	
KANSAS ONE-CALL	1-800-344-7233
3. EXISTING UTILITIES AND THEIR LOCATIONS, AS SHOWN ON THE PLANS, REPRESENT THE BEST INFORMATION OBTAINABLE FOR DESIGN. LOCATION INFORMATION HAS BEEN OBTAINED FROM THE VARIOUS UTILITY COMPANIES AND IS EITHER FROM COMPANY RECORD DRAWINGS OR COMPANY PROVIDED FIELD LOCATIONS. THE PLAN LOCATIONS SHOWN ARE NOT GUARANTEED. ADDITIONAL EXISTING UTILITIES MAY ALSO BE ENCOUNTERED.
4. ALL STUBS AND PLUGGED PIPES SHALL BE LOCATED WITH GREEN PLASTIC TAPE IN THE SAME MANNER AS RISERS.
5. COST OF EXCAVATION, HAULING, AND DUMPING OF EXCESS EXCAVATION SHALL BE SUBSIDIARY TO THE PROJECT.

BENCHMARKS

B.M. "a" out on N.E. cor. of Inlet at the S.W. cor. of Lot 2, Block 1, Willowbend 1st. Elev. 191.82

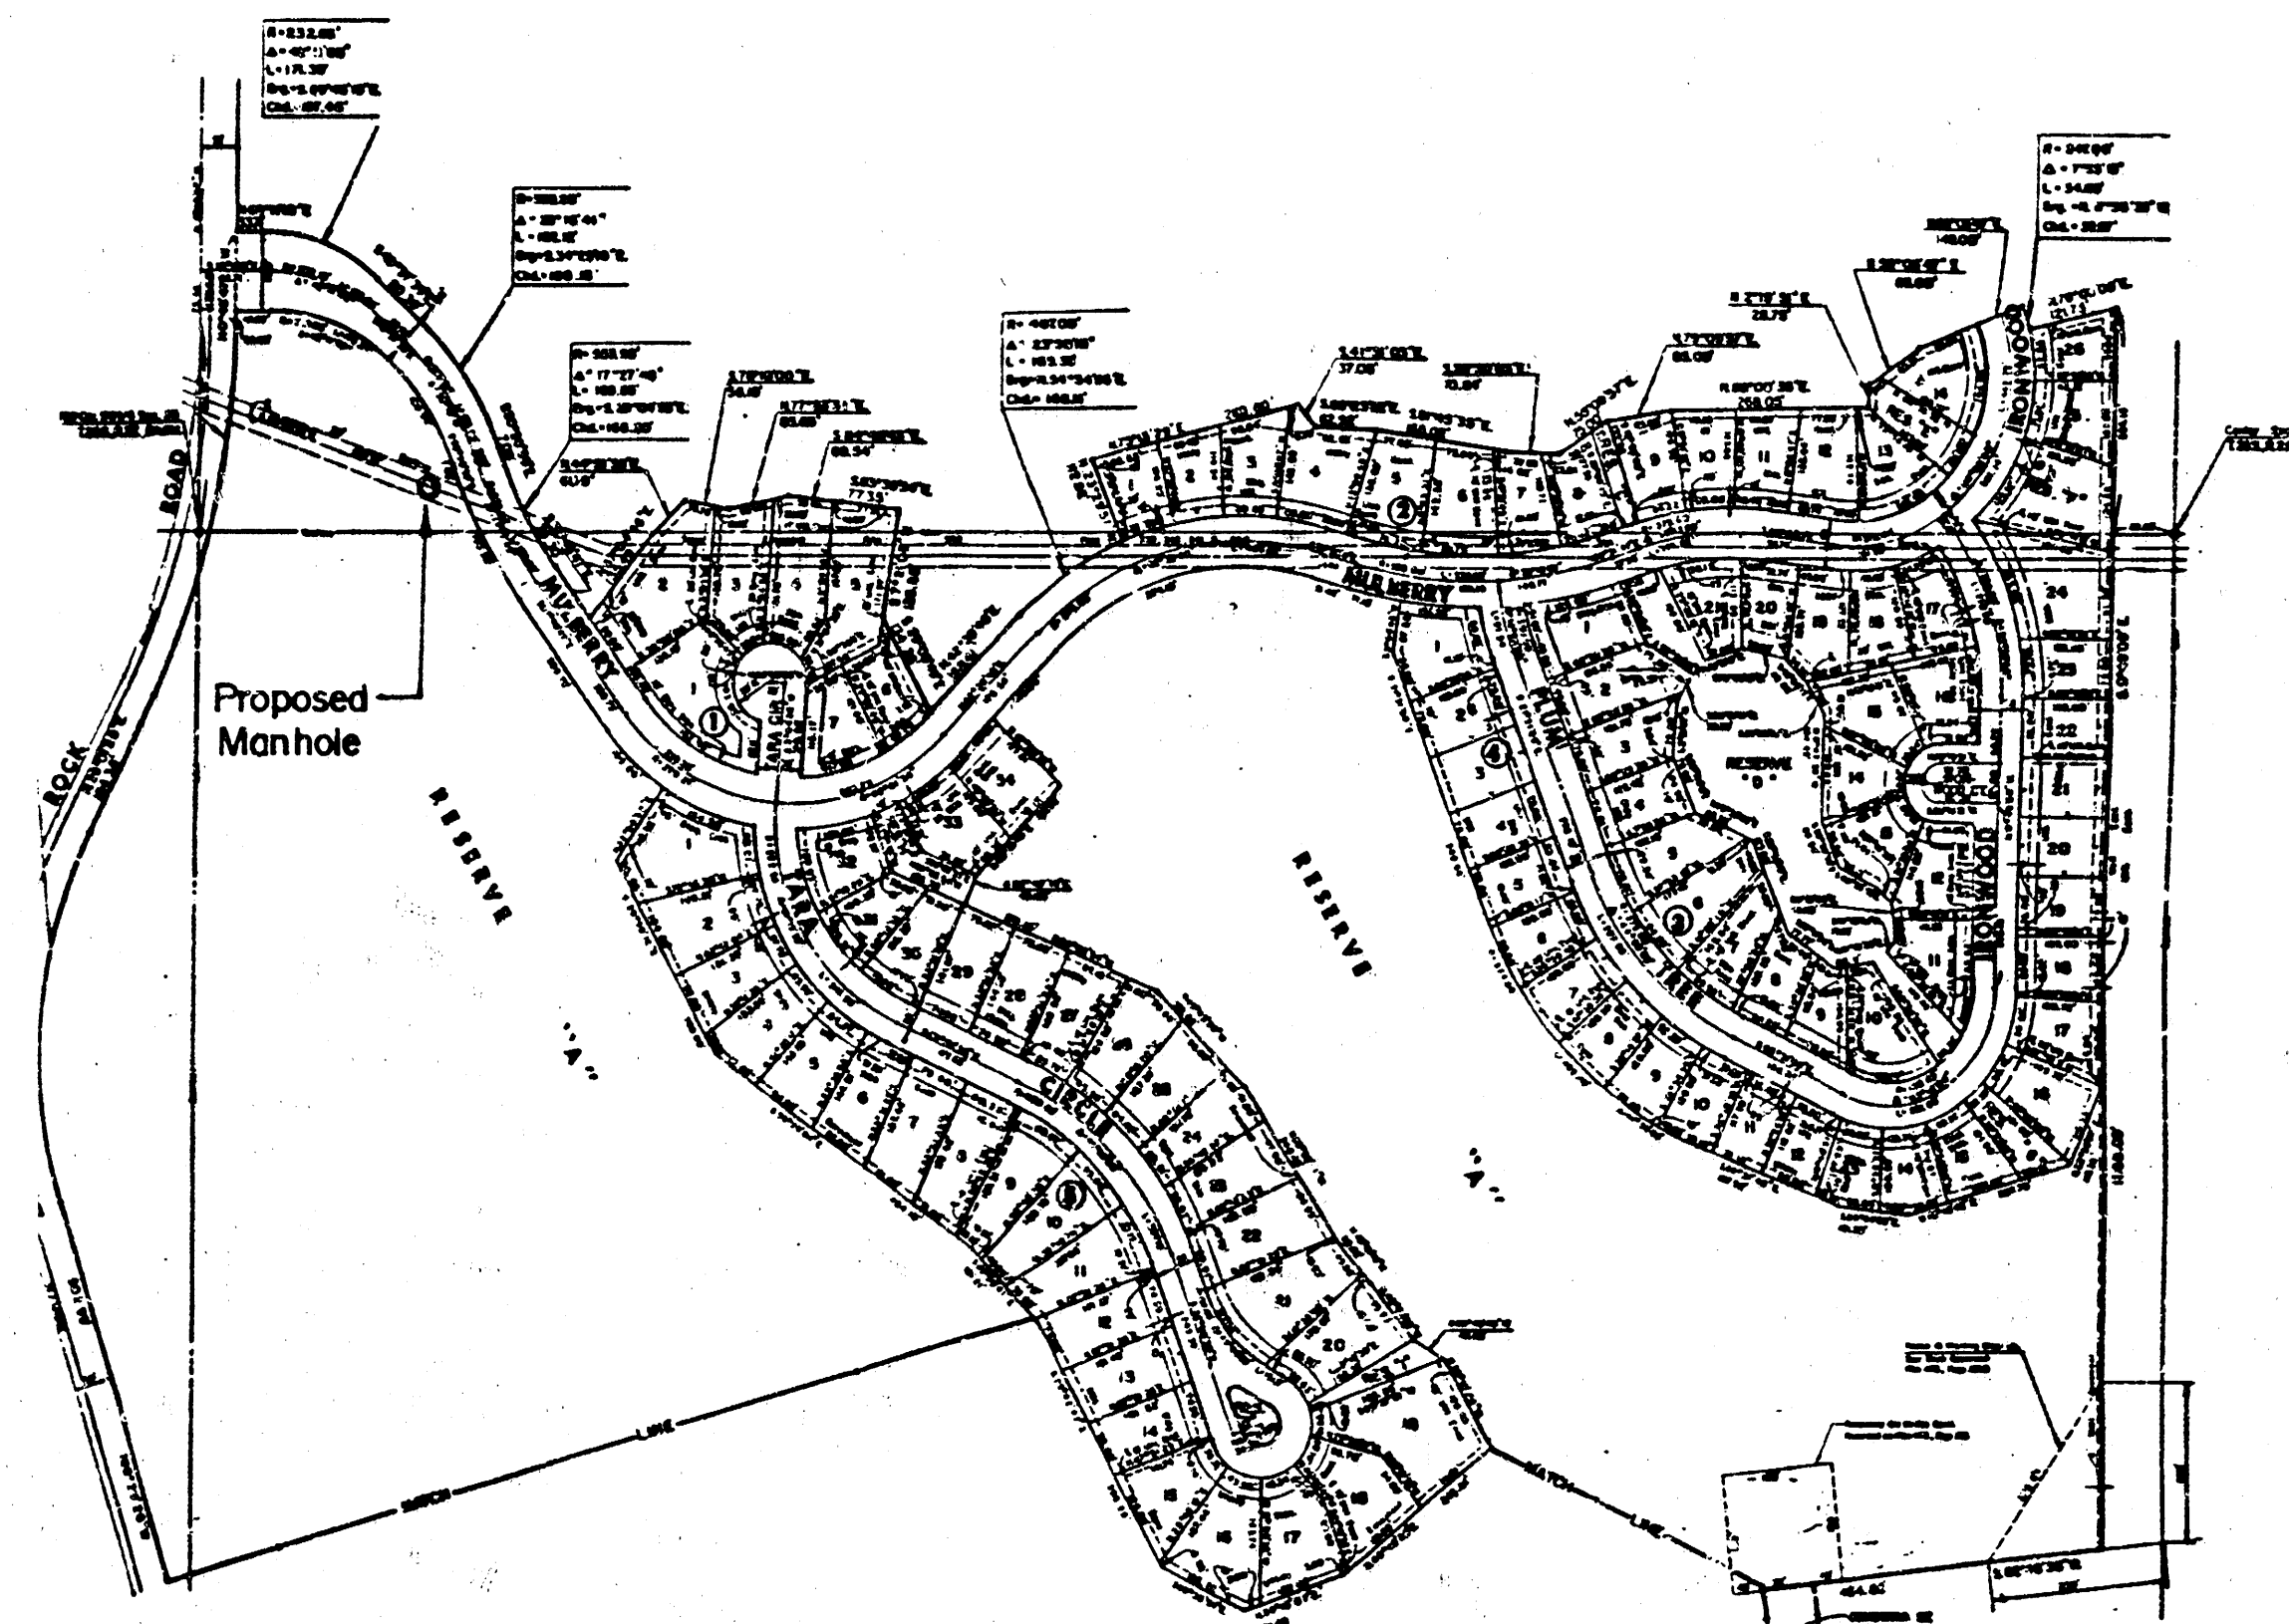

INDEX TO SHEETS

SHEET NO.	DESCRIPTION
1	Title Sheet
2	Plan / Profile



NOT BUILT

WON'T BE BUILT

APPROVED AS NOTED
By CITY ENGINEER OF WICHITA
Sanitary Sewers COB 3/25/87
Storm Sewers _____
Driveway Approaches _____
Water Mains _____
Dwelling _____

NOTE TO CONTRACTOR

This project will be constructed under the supervision of the CITY ENGINEER and conforming to the SPECIFICATIONS of the CITY OF WICHITA. The CONTRACTOR will pay the City of Wichita for all costs of plan review, inspection and booking per contract.

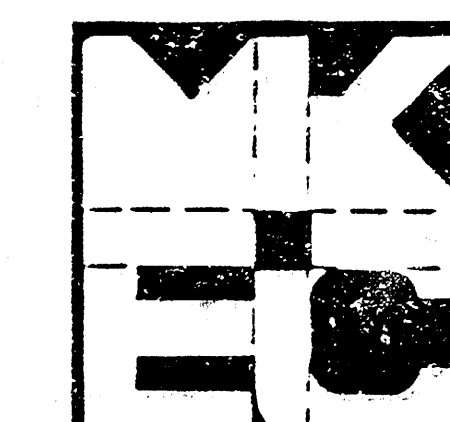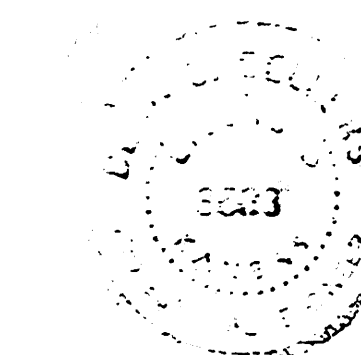

**WILLOWBEND
CLUBHOUSE
SANITARY SEWER
MANHOLE PLANS**


MID-KANSAS ENGINEERING CONSULTANTS PA
3500 NORTH ROCK ROAD
BUILDING #800
WICHITA, KANSAS 67226

682-6561

Design
D S
Drawn by
SM
Checked by
Date
March, 1987
Job No.

Sheet 1
of 2

MANHOLE ON MAIN 9, SAN. SEW. 23
FOR WILLOWBEND CLUBHOUSE
PROJ. 468-76-245-80001-000-000-106

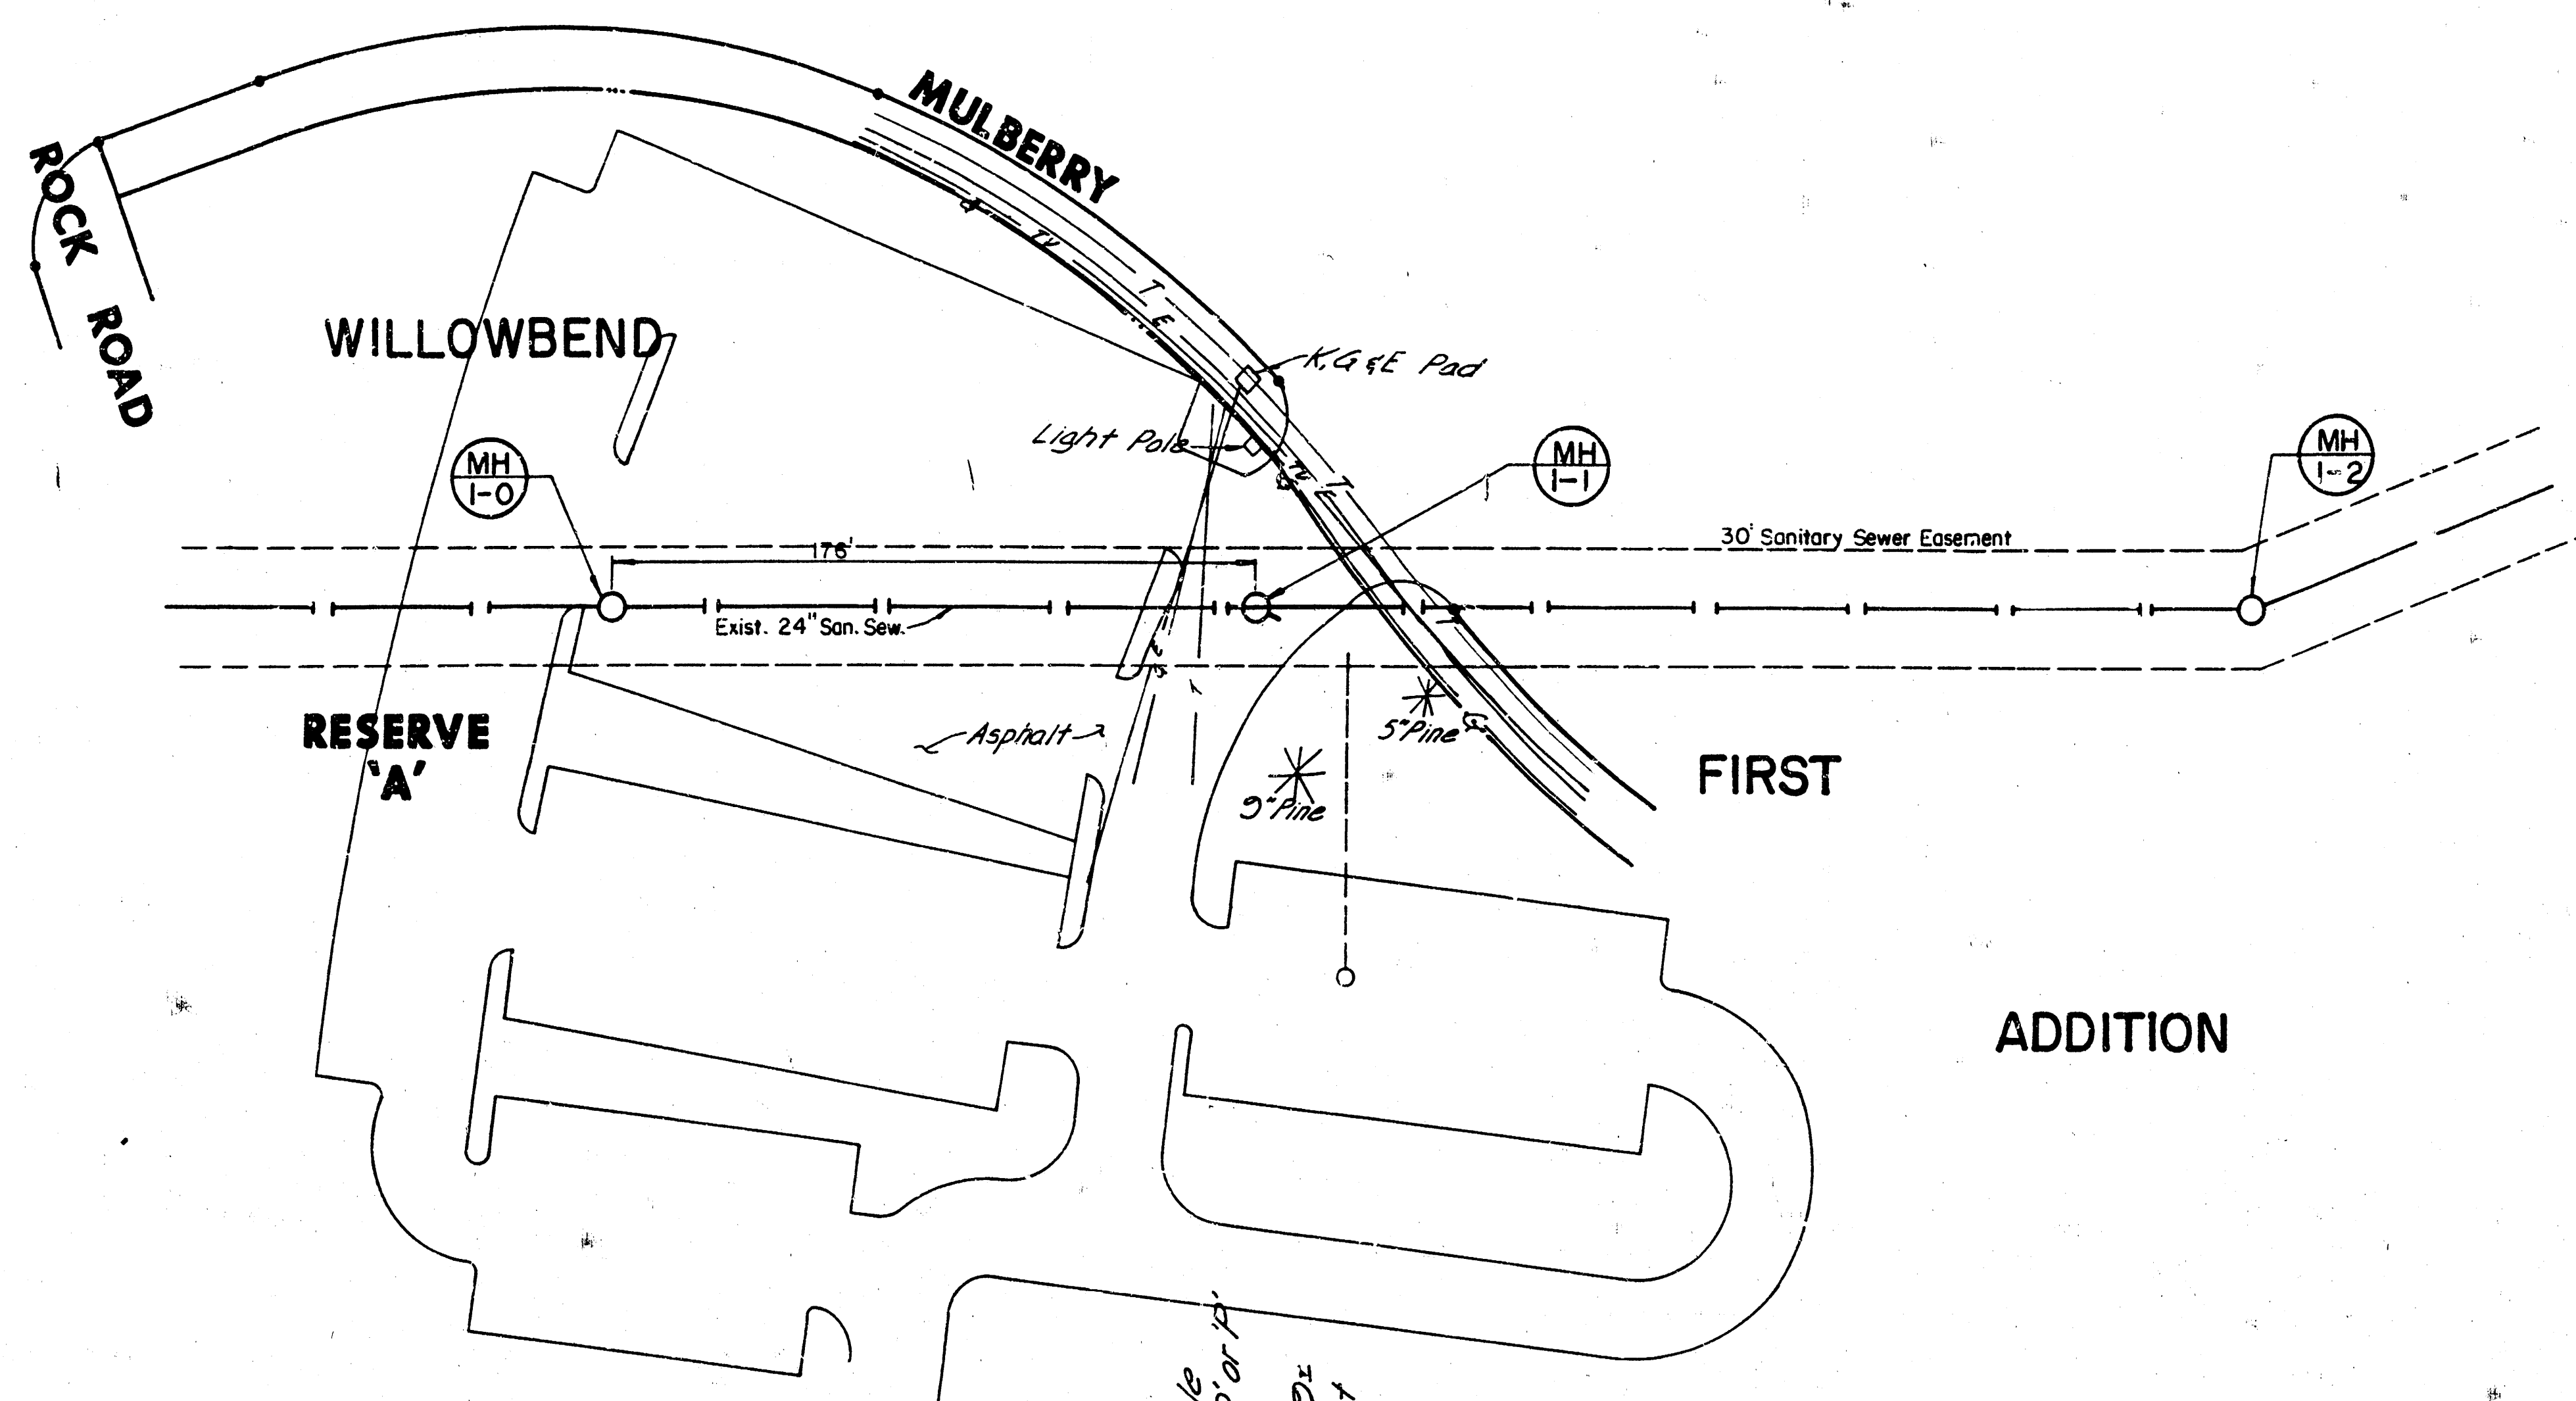

N
SCALE: 1" = 40' Horiz.
1" = 5' Vert.

