

SANITARY SEWER NO. 23 LATERAL 10 , MAIN 9 THE RENAISSANCE

PROJECT NO.
468-76-245-81283-000-000-001

CITY OF WICHITA , KANSAS
MIKE LINDEBAK , CITY ENGINEER
FEBRUARY , 1984

GENERAL NOTES



1. RISER PIPE SHALL BE INSTALLED TO SERVE INDIVIDUAL LOTS OR TRACTS IN CONJUNCTION WITH NEW SANITARY SEWER CONSTRUCTION, UNLESS OTHERWISE ORDERED BY THE ENGINEER, BECAUSE OF GROUND WATER, UNSTABLE SOIL OR UNUSUALLY DEEP CONSTRUCTION. RISER LOCATIONS SHALL BE AS APPROVED BY THE PROPERTY OWNER WITH THE CONCURRENCE OF THE ENGINEER. INSTALLATION OF RISERS ON SEWERS BECAUSE OF UNUSUAL DEPTH WILL BE REQUIRED WHEN THE SEWER IS DEEPER THAN TWELVE FEET (12'). THE CONTRACTOR WILL BE REQUIRED TO FILE WRITTEN DOCUMENTATION WITH THE ENGINEER IN A FORM APPROVED BY THE ENGINEER INDICATING THE LOCATIONS WHERE RISERS ARE TO BE INSTALLED AS REQUESTED BY THE PROPERTY OWNER OR HIS AUTHORIZED REPRESENTATIVE. RISER PIPE CONSTRUCTION SHALL CONFORM TO THE REQUIREMENTS AS SHOWN ON THE STANDARD RISER DETAIL SHEET.
2. THE CONTRACTOR SHALL BE RESPONSIBLE FOR PRESERVING PROPERTY IRONS. THE CONTRACTOR SHALL BE REQUIRED TO RE-ESTABLISH ANY PROPERTY IRONS WHICH ARE DAMAGED OR DESTROYED BY HIS CONSTRUCTION OPERATIONS. SUCH IRONS SHALL BE RE-ESTABLISHED BY A LICENSED LAND SURVEYOR OR A LICENSED PROFESSIONAL ENGINEER IN ACCORDANCE WITH STATE LAWS.
3. A PORTION OF EXCESS EXCAVATED MATERIAL SHALL BE MOUNDING AROUND MANHOLES WHICH EXCEED MORE THAN ONE (1) FOOT ABOVE THE EXISTING GROUND. SUCH MOUNDS SHALL BE CONSTRUCTED WITH A SIX (6) FEET DIAMETER FLAT TOP WITH 4 TO 1 SIDE SLOPES DOWN TO THE ORIGINAL GROUND. THE ELEVATION OF THE FLAT TOP OF THE MOUND SHALL BE 0.4 FOOT BELOW THE TOP OF THE MANHOLE.
4. TREES TO BE REMOVED ARE MARKED WITH AN 'X'. ALL TREES WHICH IN THE OPINION OF THE FIELD ENGINEER CAN BE SAVED SHALL BE SAVED.
5. CONTRACTOR SHALL NOTIFY THE UTILITY COMPANIES OF CONSTRUCTION SCHEDULING AND LOCATION OF ANY UNDERGROUND LINES.
6. EXISTING UTILITIES AND THEIR LOCATIONS, AS SHOWN ON THE PLANS, REPRESENT THE BEST INFORMATION OBTAINABLE FOR DESIGN. LOCATION INFORMATION HAS BEEN OBTAINED FROM THE VARIOUS UTILITY COMPANIES AND IS EITHER FROM COMPANY RECORD DRAWINGS OR COMPANY PROVIDED FIELD LOCATIONS. THE PLAN LOCATIONS SHOWN ARE NOT GUARANTEED. ADDITIONAL EXISTING UTILITIES MAY BE ENCOUNTERED.

BENCH MARKS

- B.M. #1 City Disc. 44' N. & 48' E. 1/4
Cor. 1/2 Mile N. 29th St. N. &
Rock Road.
Elev. = 202.23
- B.M. #2 "X" on T.C. 32nd St. N. & 100'
W. of C.L. Rock Road.
Elev. = 204.86
- B.M. #3 M.H. Rim 890' W. & 1096' S. of
the N.E. Cor. N.E. 1/4, Section
31, T. 26 S., R. 2 E.
Elev. = 188.68

CAUTION:


HIGH PRESSURE COOP.
PIPELINE. CONTACT 24 HRS. PRIOR
TO EXCAVATION. CALL BILL STULL
AT 1-316-221-2107

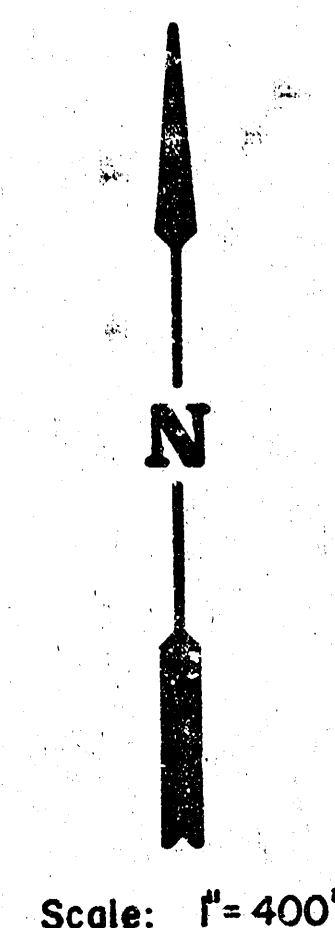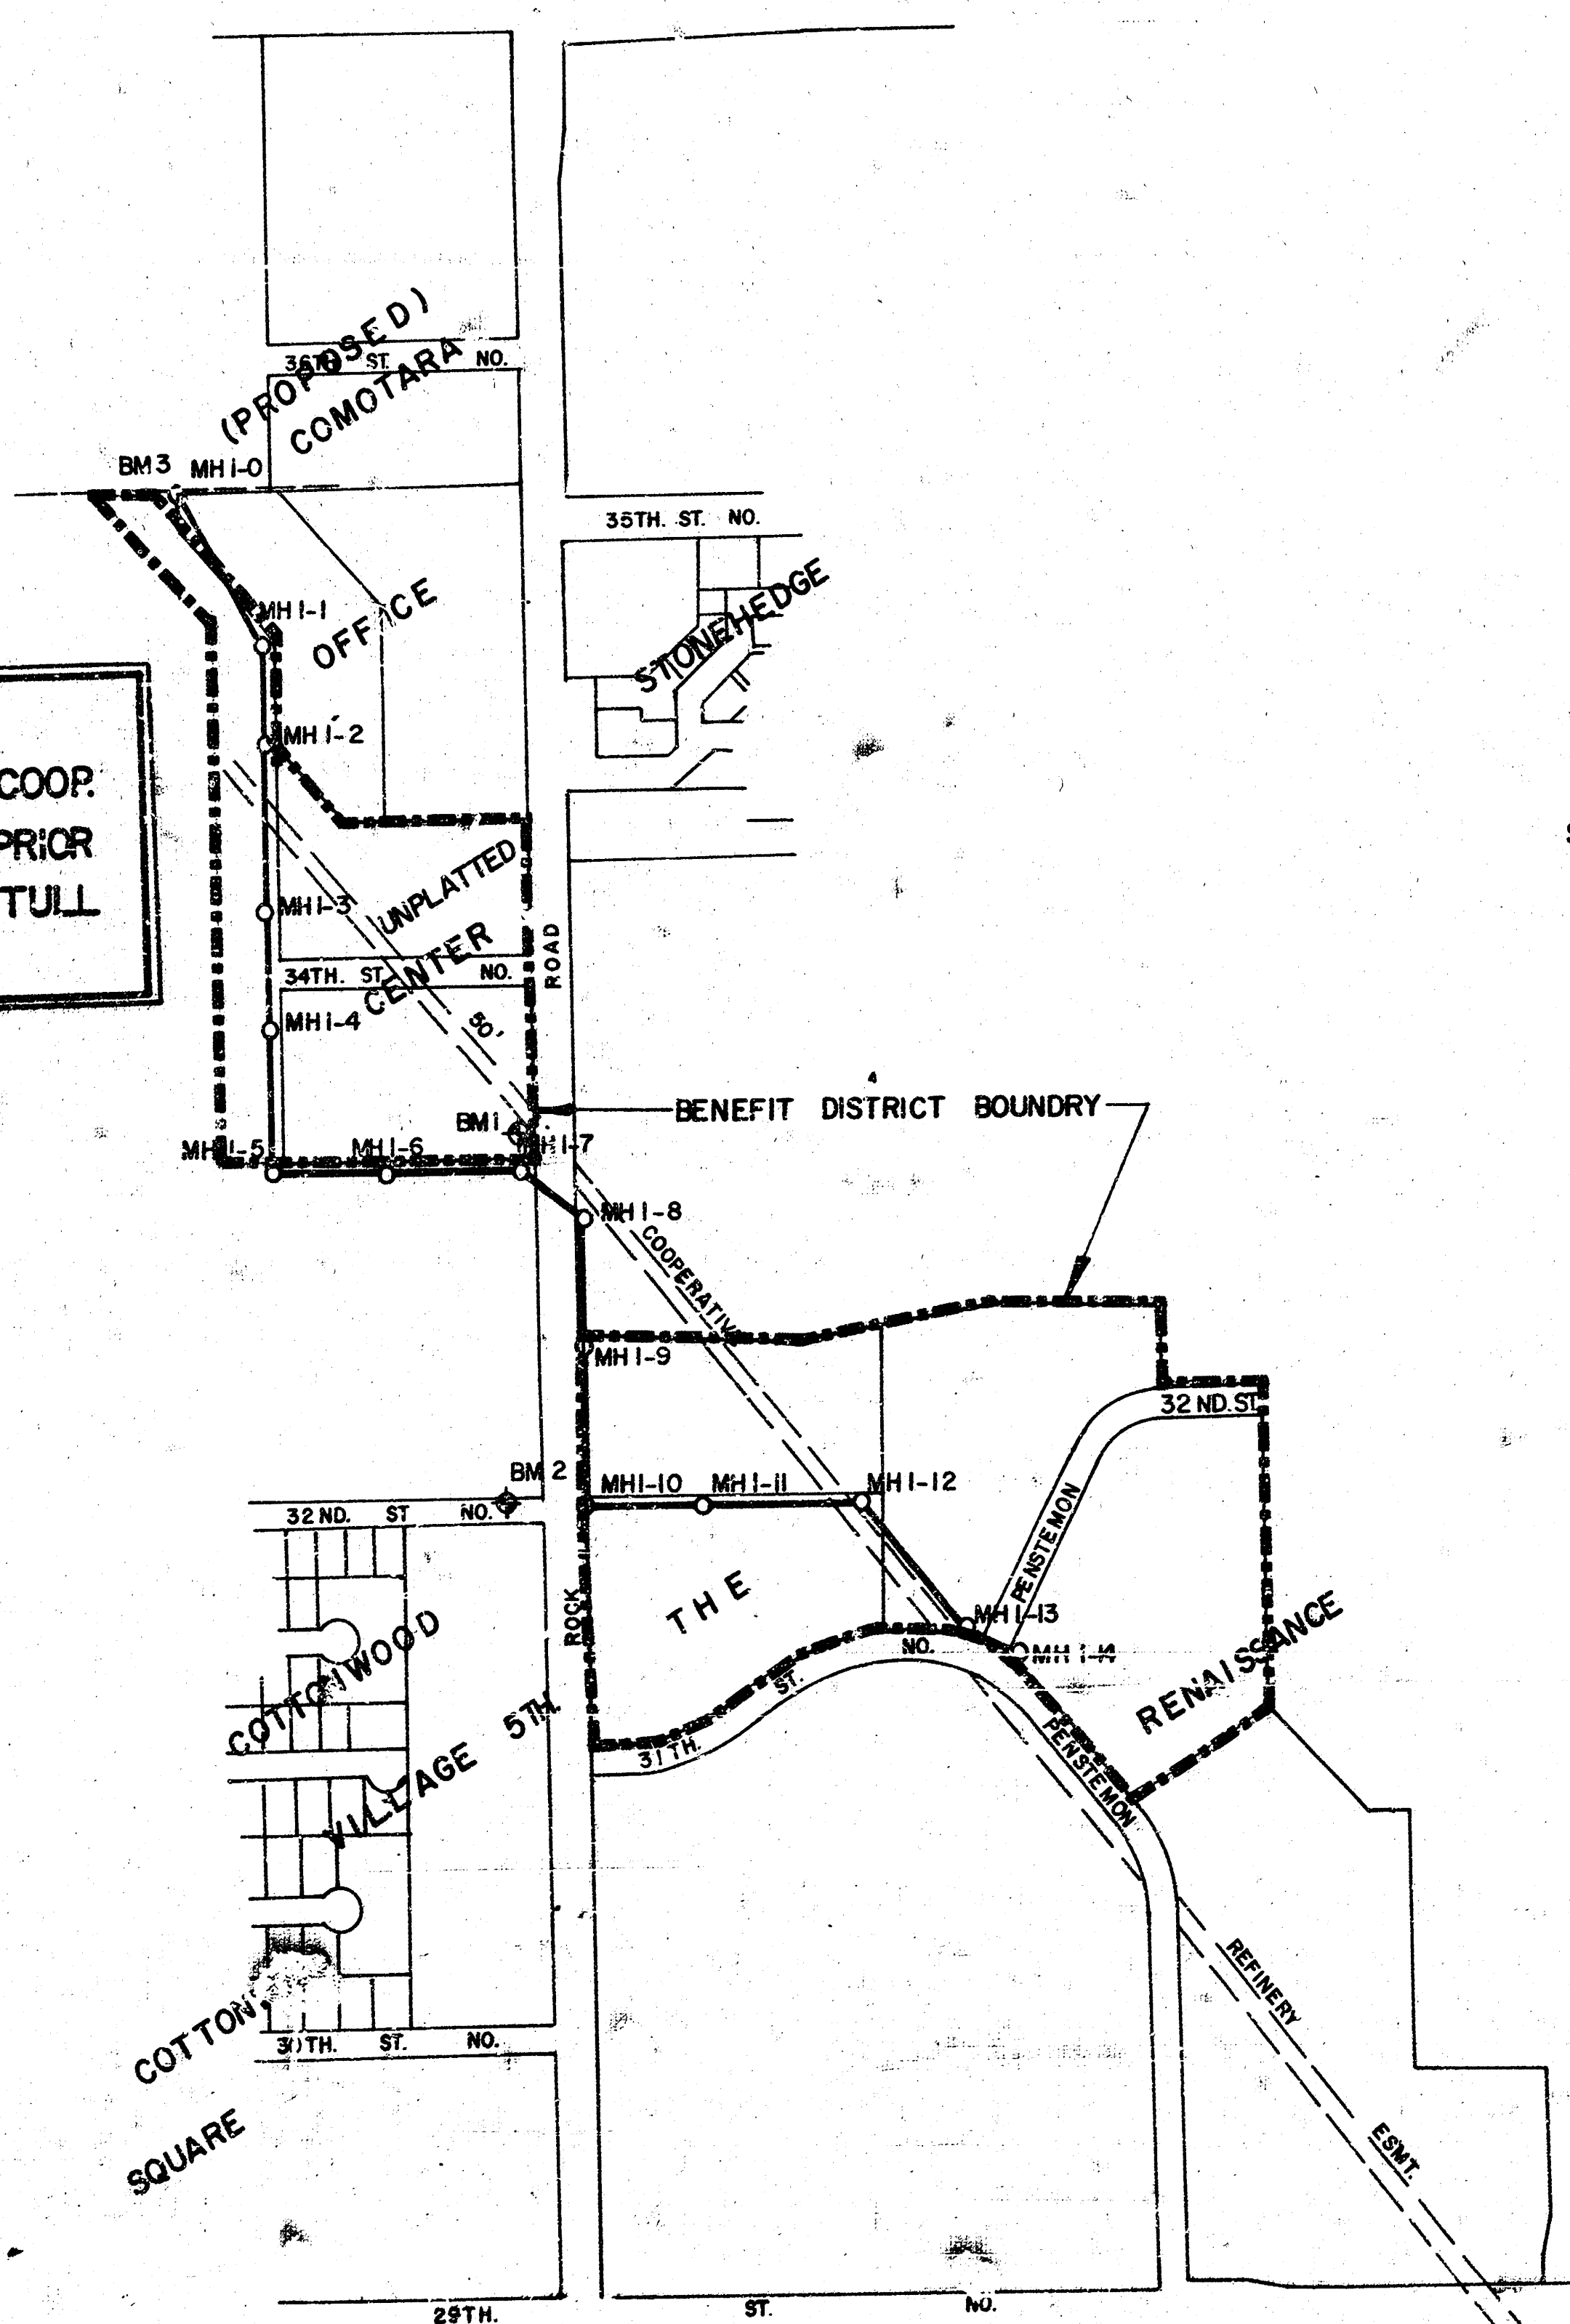

INDEX TO DRAWINGS

SHEET NO.	DISCRIPTION
1	TITLE SHEET
2-6	LINE 1
7	MANHOLE DETAILS
8-10	FINAL PLATS

As Built
S.L.L.
8.84

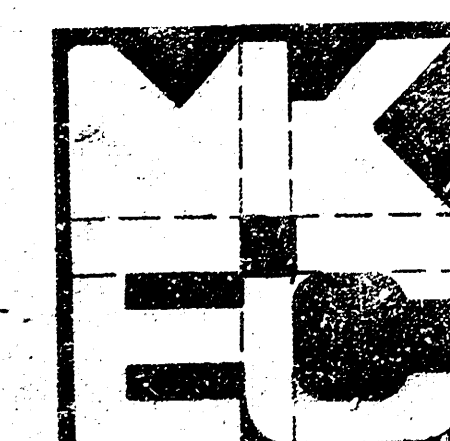

**SANITARY SEWER
EXTENSION
THE RENAISSANCE**


MID-KANSAS ENGINEERING CONSULTANTS PA
240 NORTH ROCK ROAD
SUITE 130
WICHITA, KANSAS 67206

662-6561


Design: AMS
Drawn by: DLM
Checked by: MDH
Date: 1984
Job no.

Sheet:
1
of 10

THE RENAISSANCE S.S. NO. 23
 LAT 10 MAIN 9 PROJ. NO.
 468-76-245-81283 -000-000-001

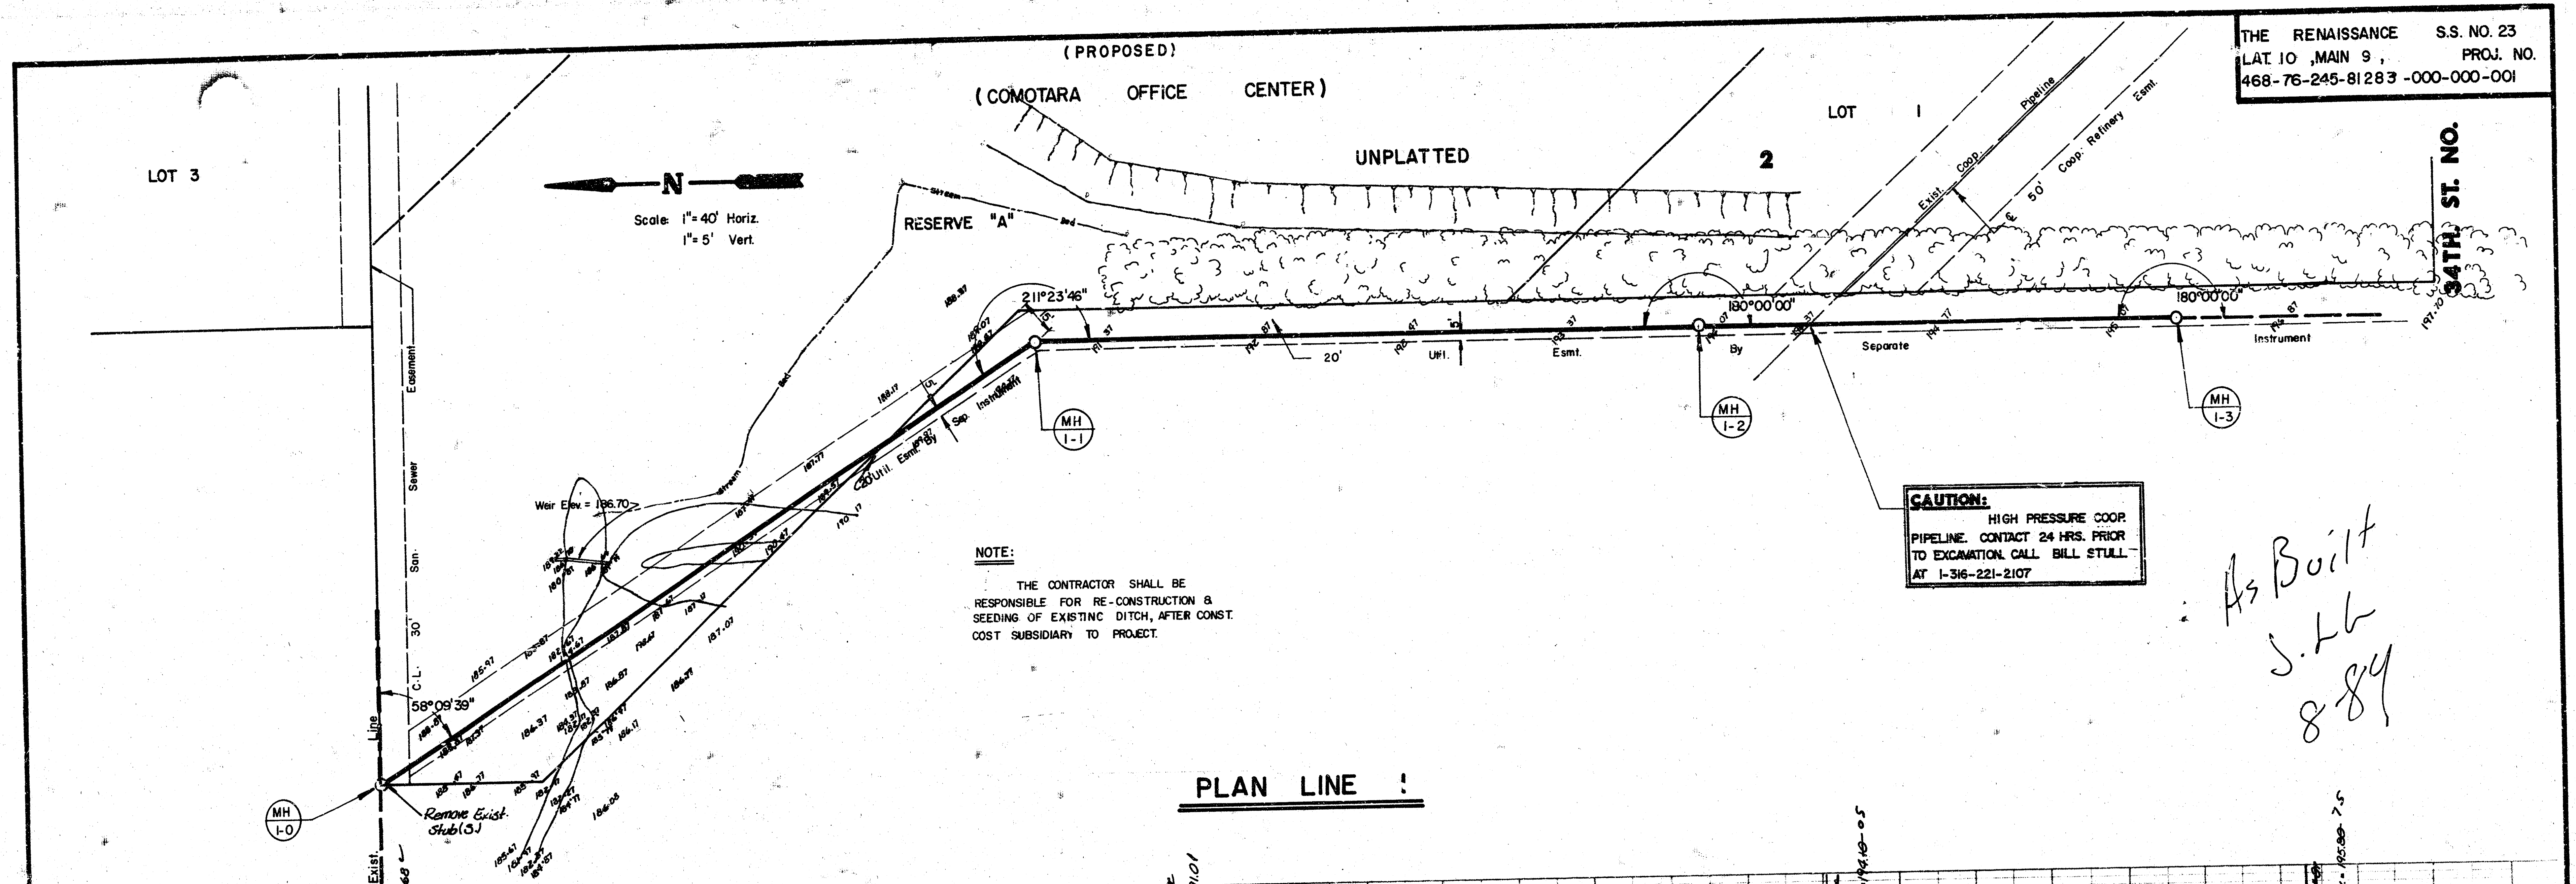


*As Built
 J.L.
 8/84*

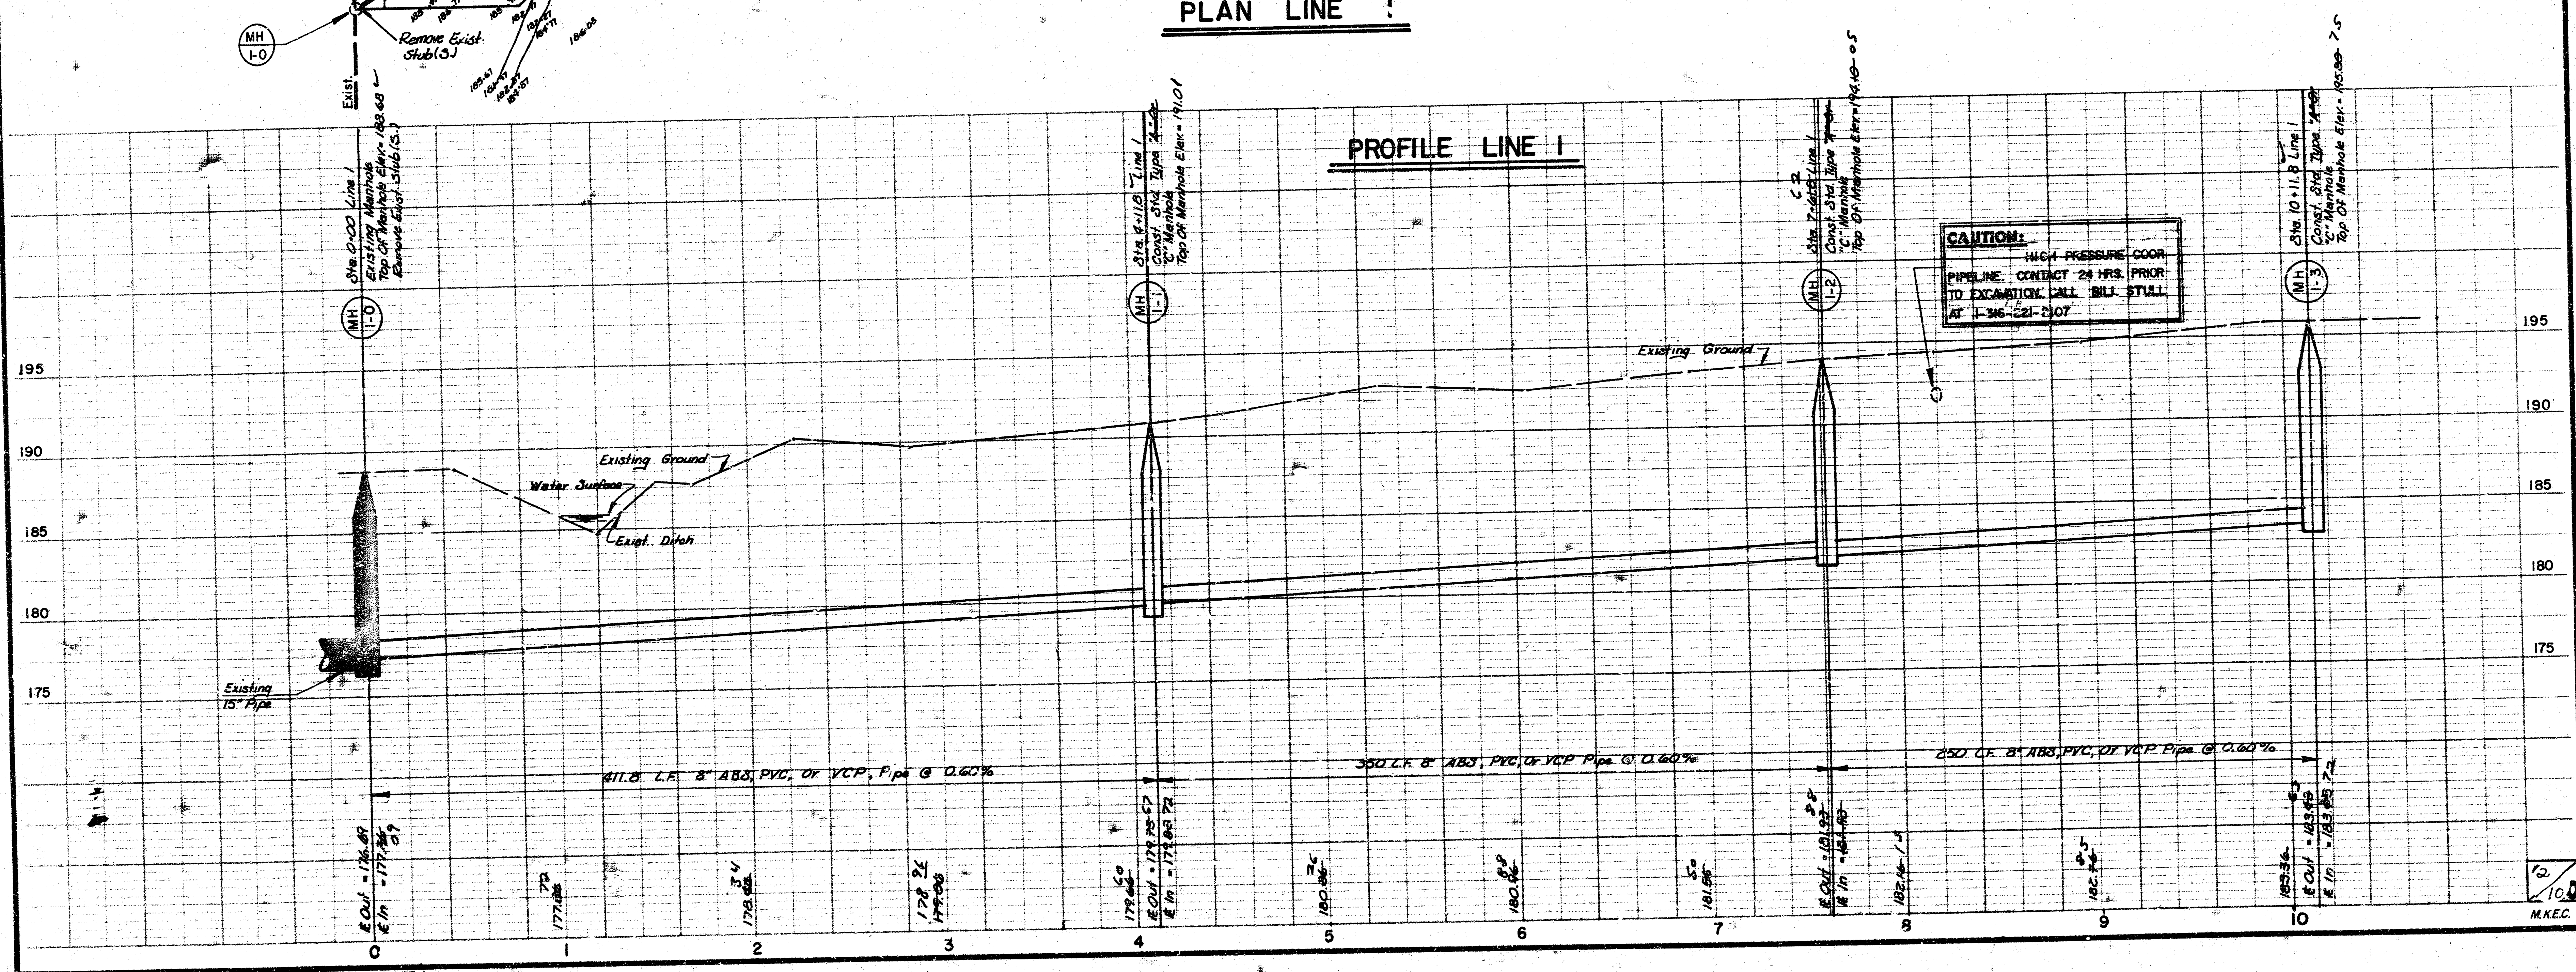

10
 M.K.E.C.


THE RENAISSANCE S.S. NO. 23
 LAT. 10, MAIN 9, PROJ. NO.
 468-76-245-81283 -000-000-001

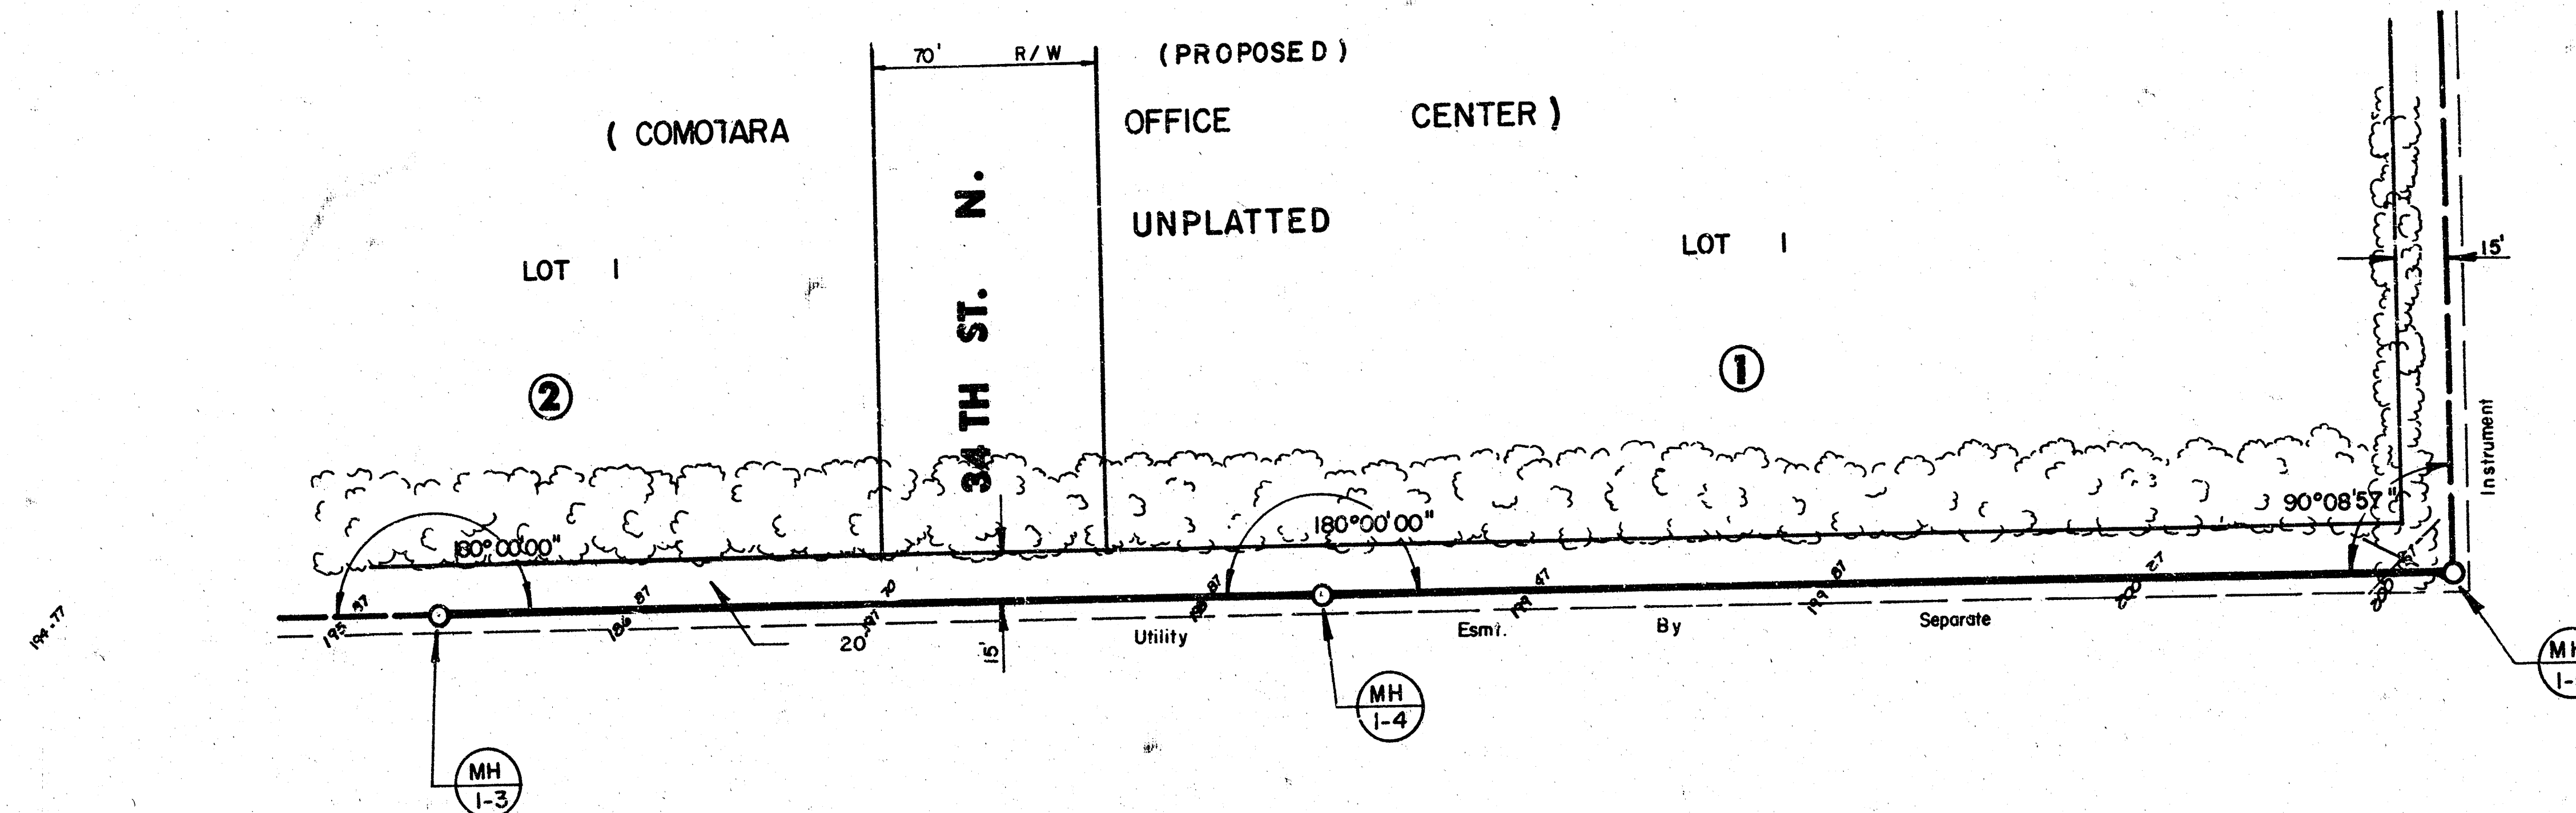


Scale: 1" = 40' Horiz.
 1" = 5' Vert.


As Built
J.L.G.
8-84

PLAN LINE 1

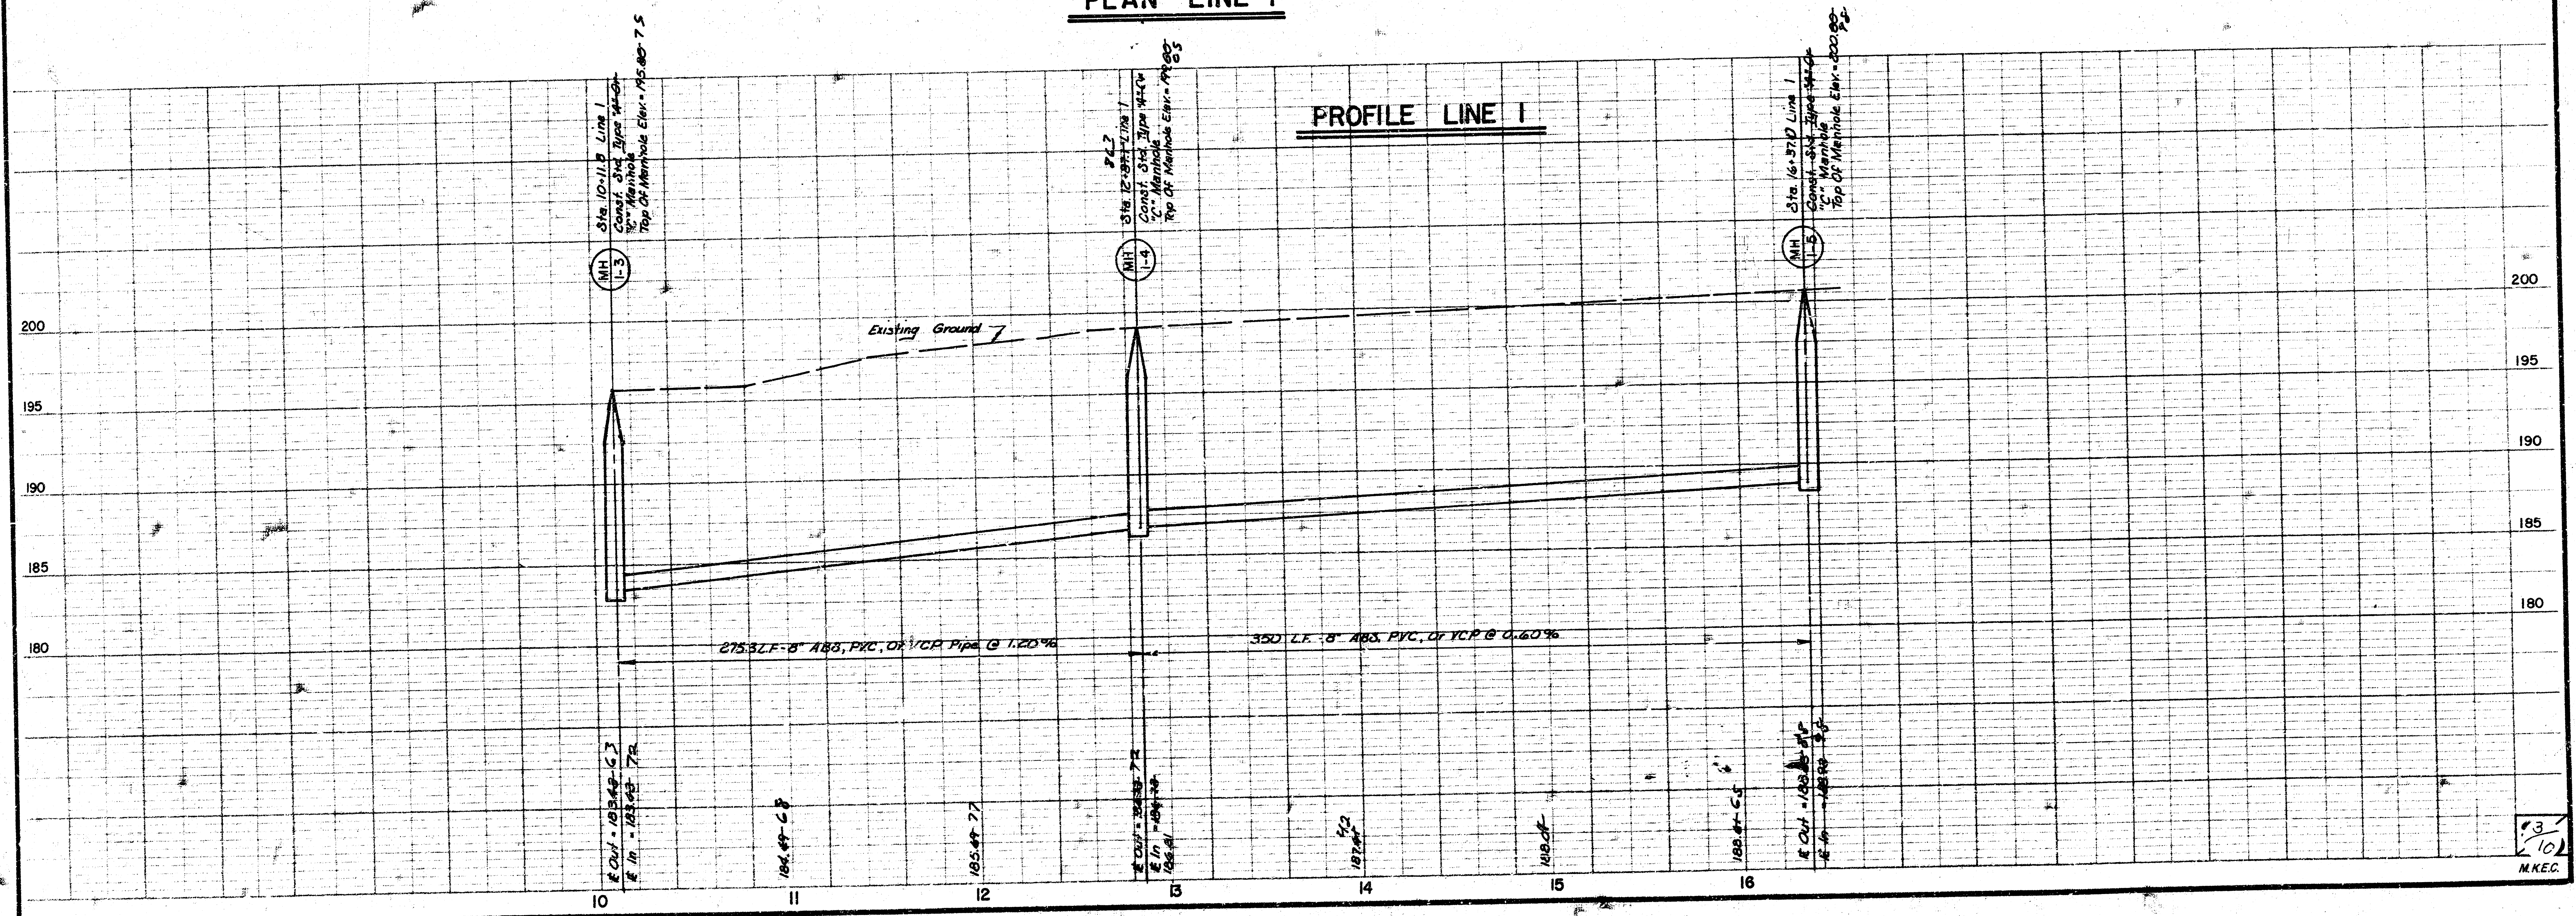

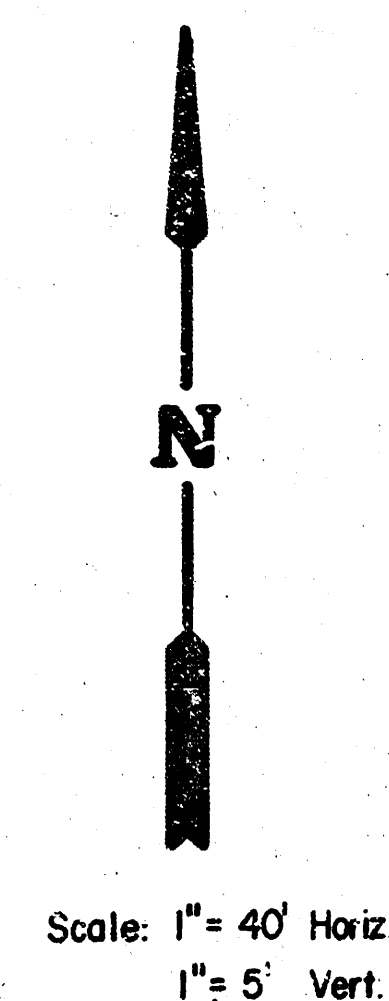


PROFILE LINE 1

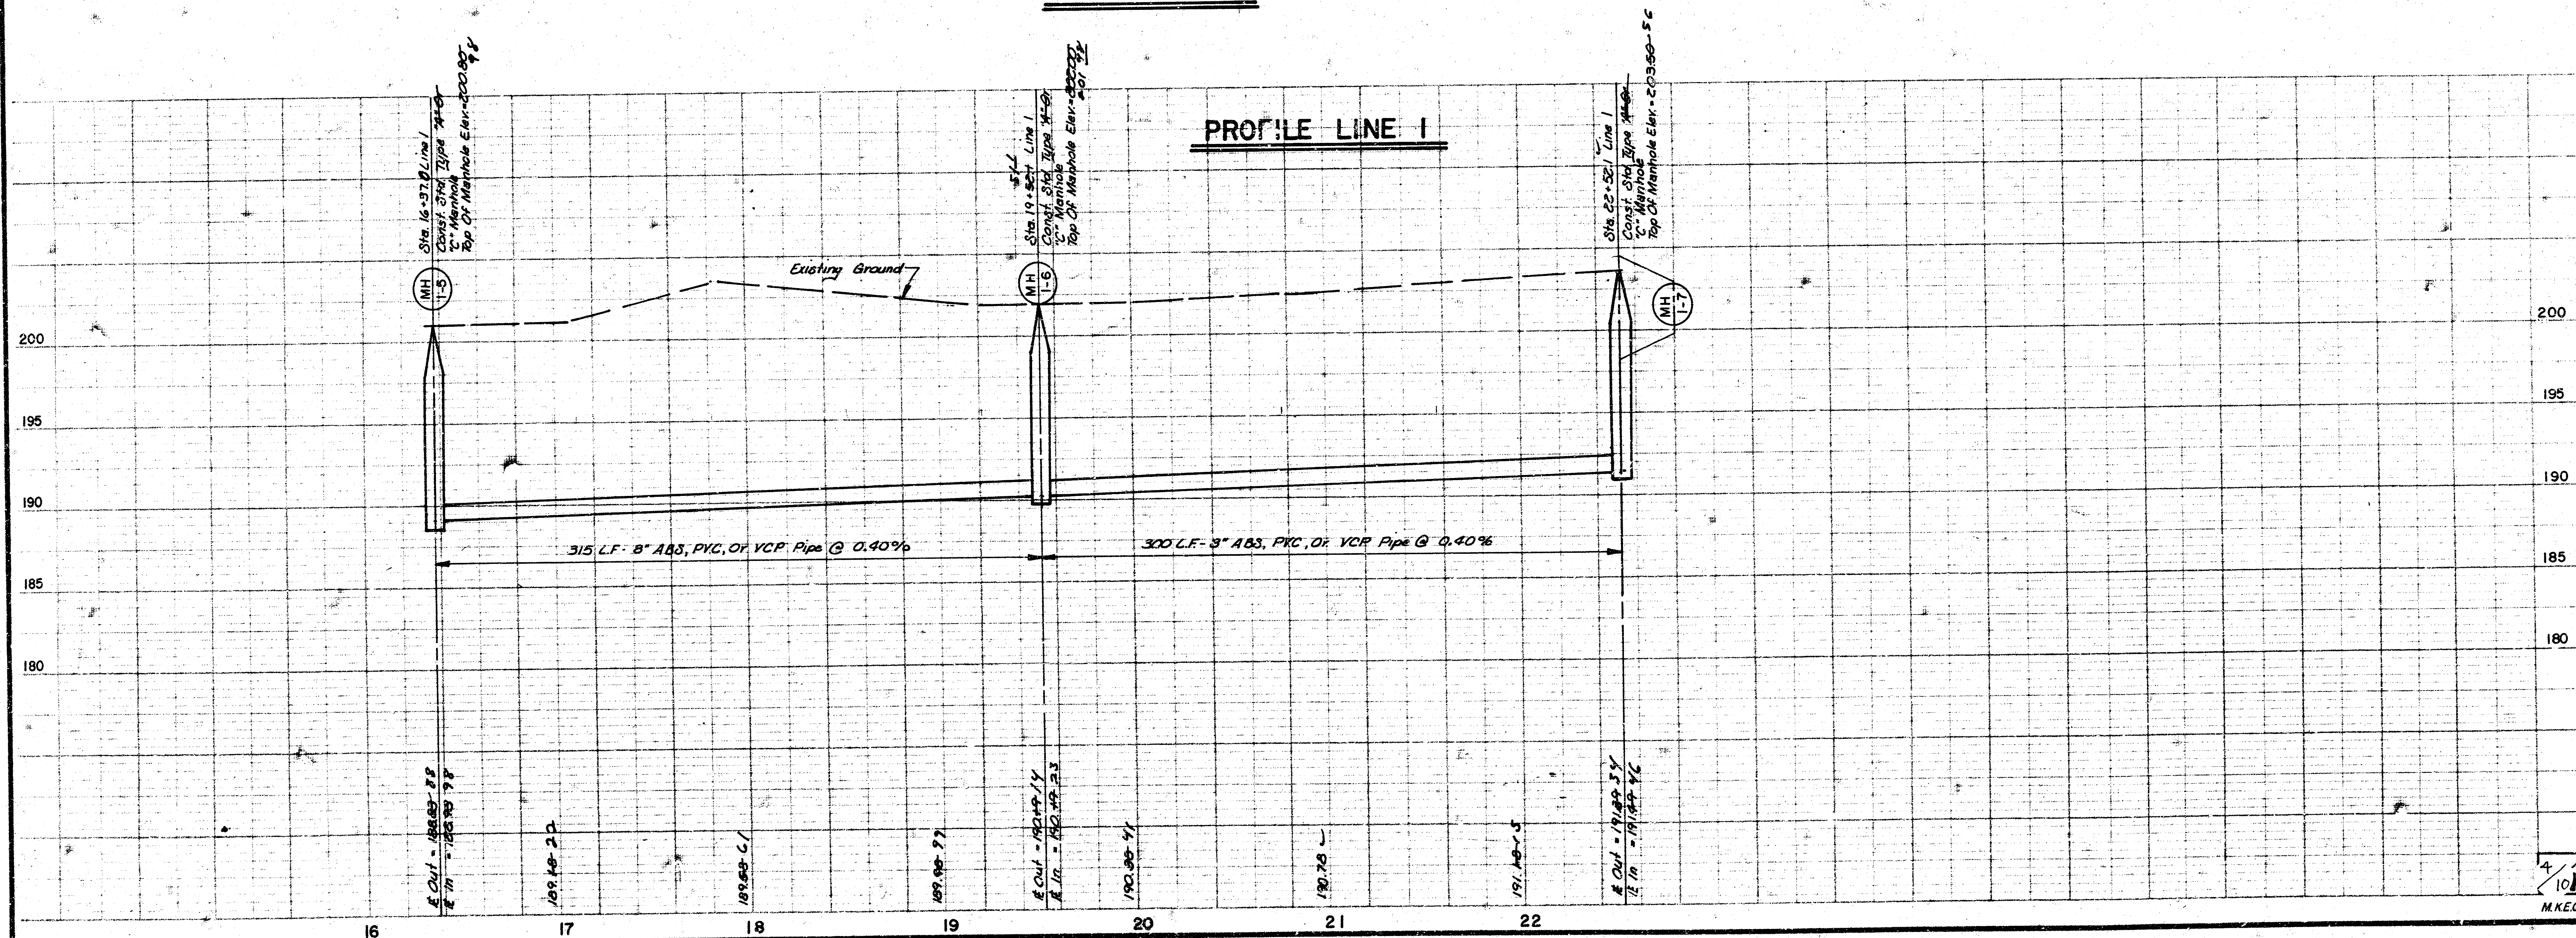


Scale: 1" = 40' Horiz.
1" = 5' Vert.


As Bill
S. L.
8-8

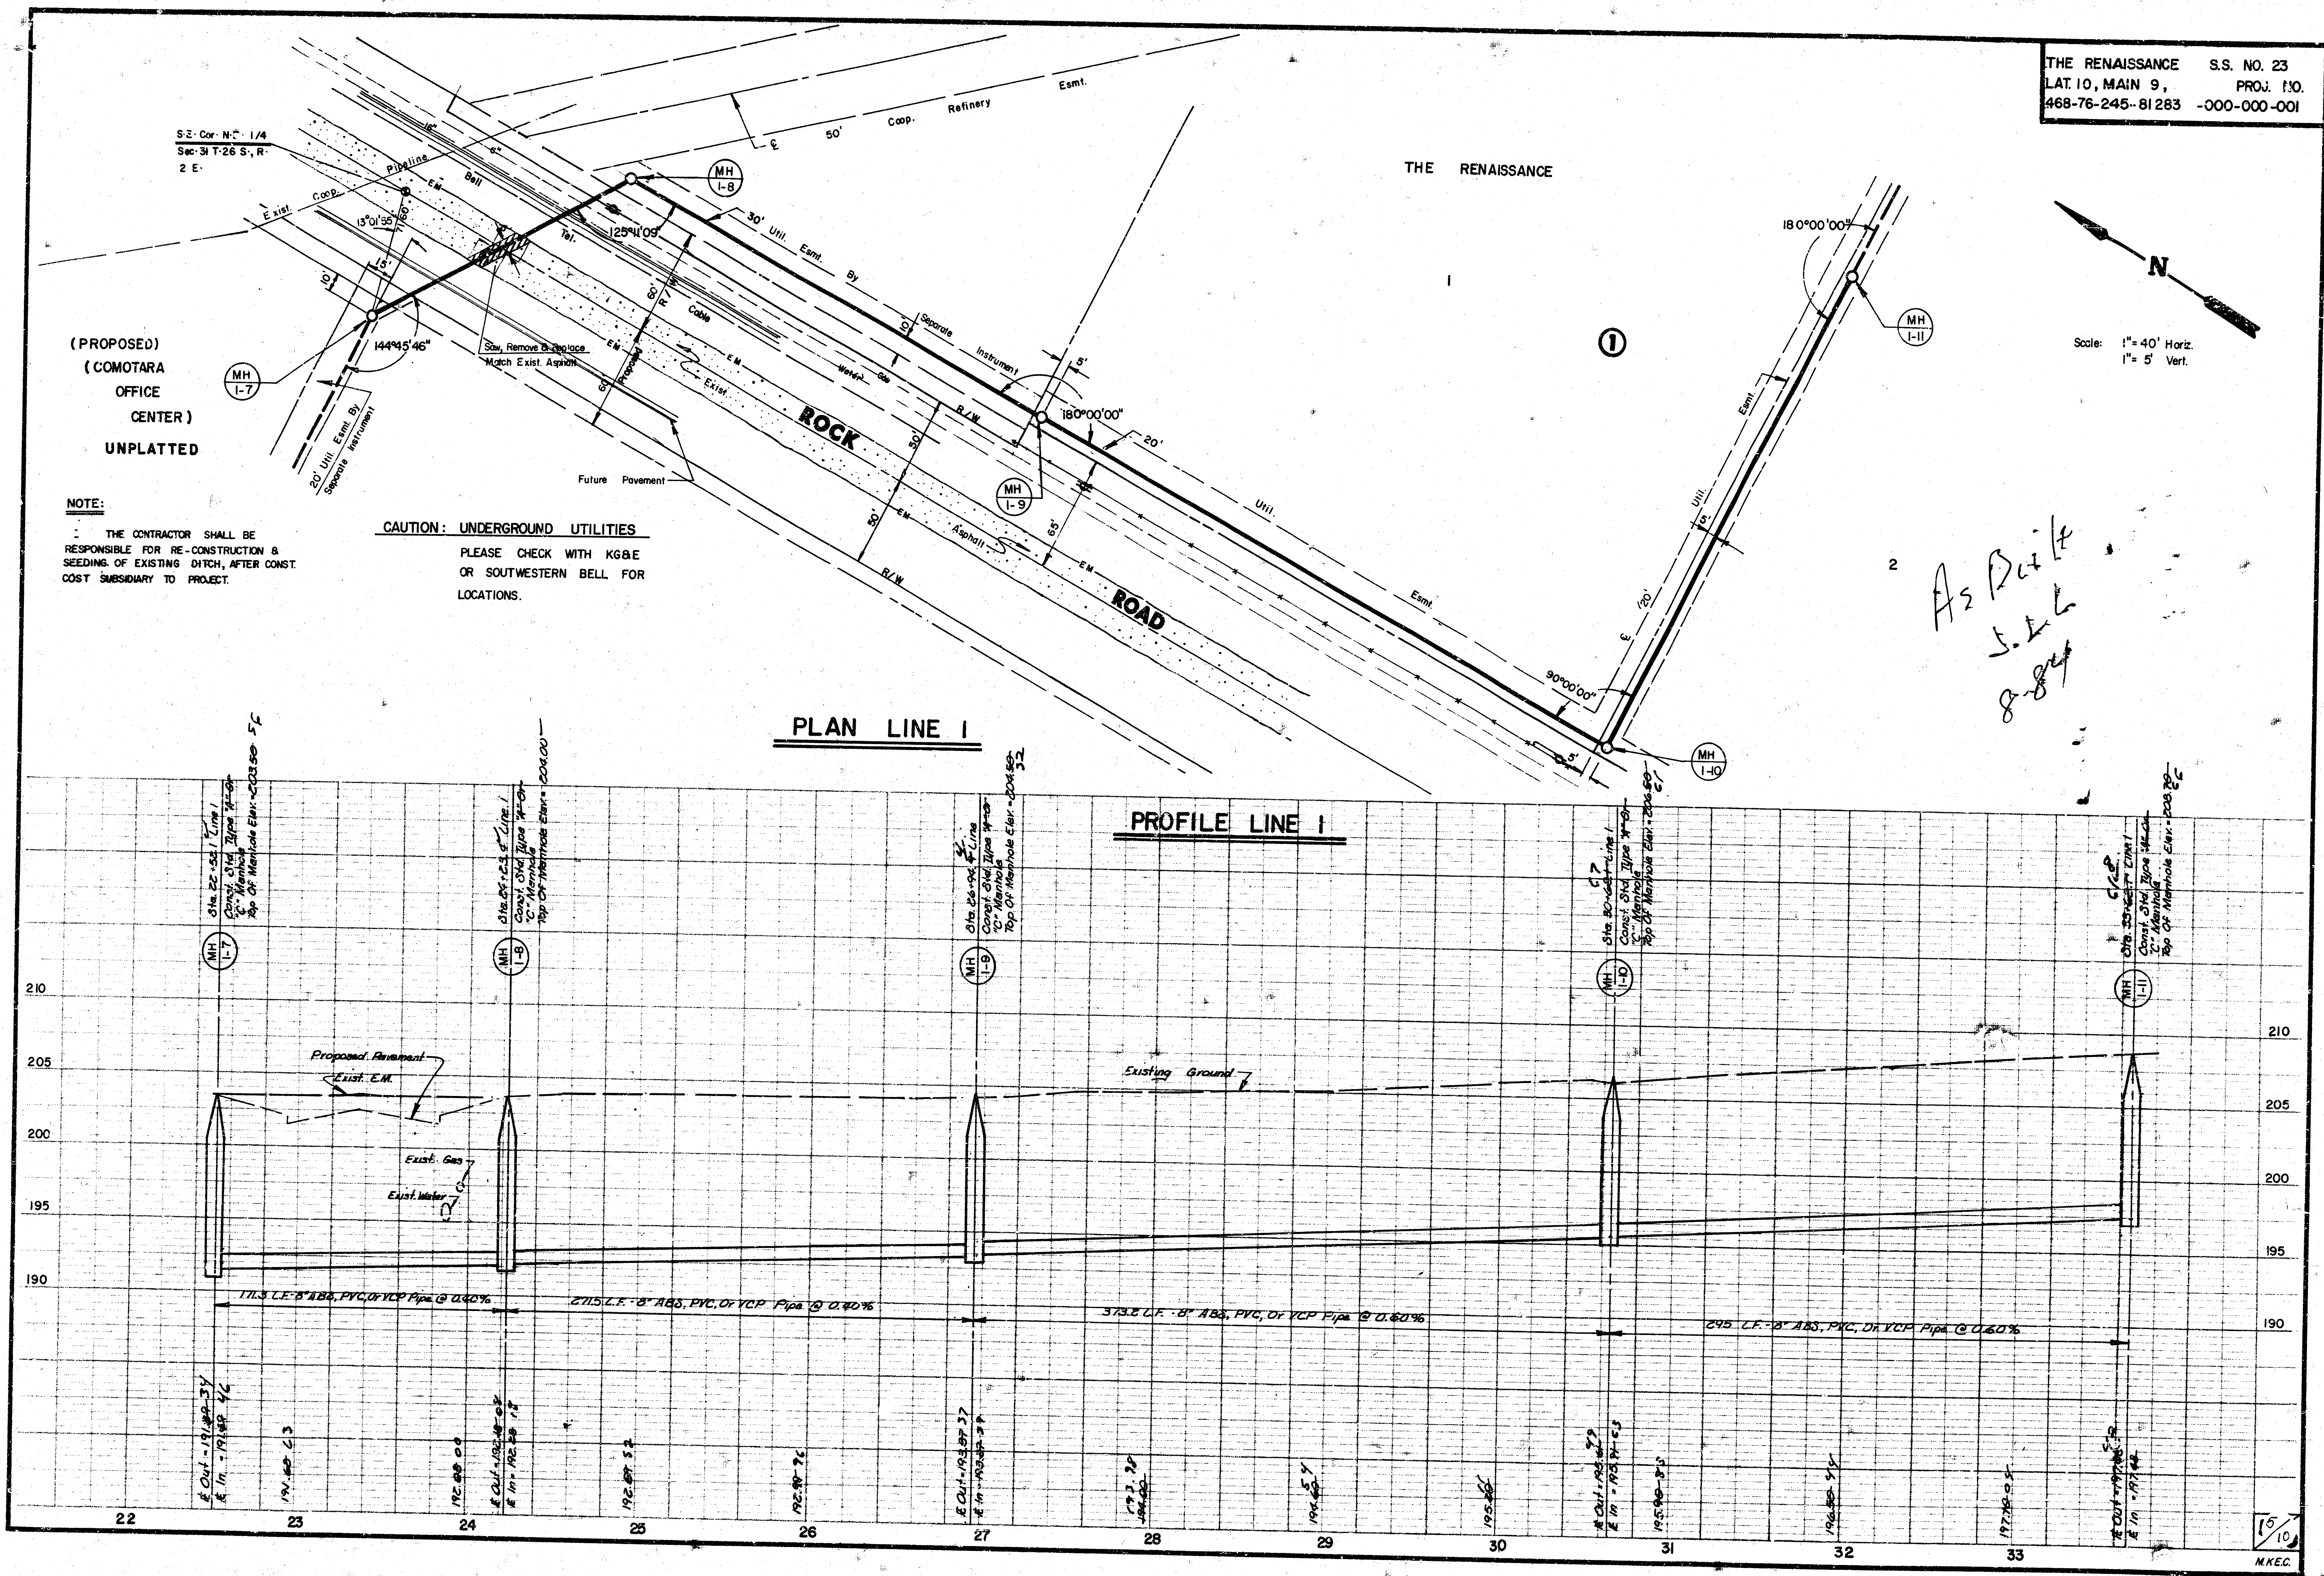

THE RENAISSANCE S.S. NO. 23
 LAT. 10, MAIN 9, PROJ. NO.
 468-76-245-81283-000-000-001

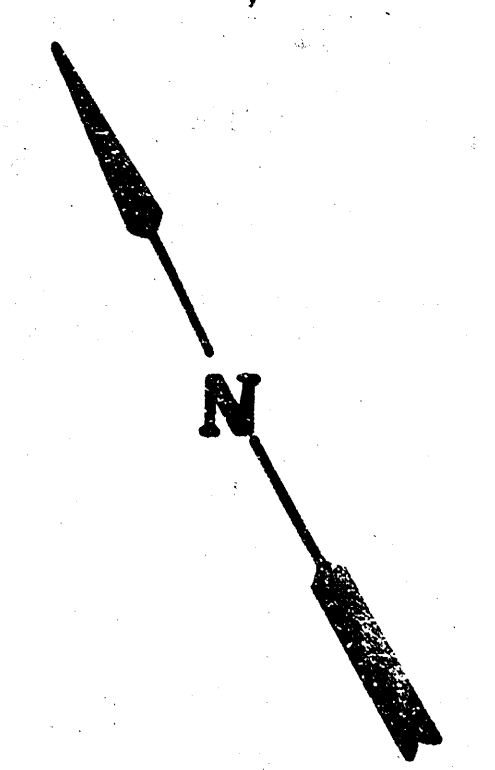


Scale: 1"=40' Horiz.
 1"=5' Vert.

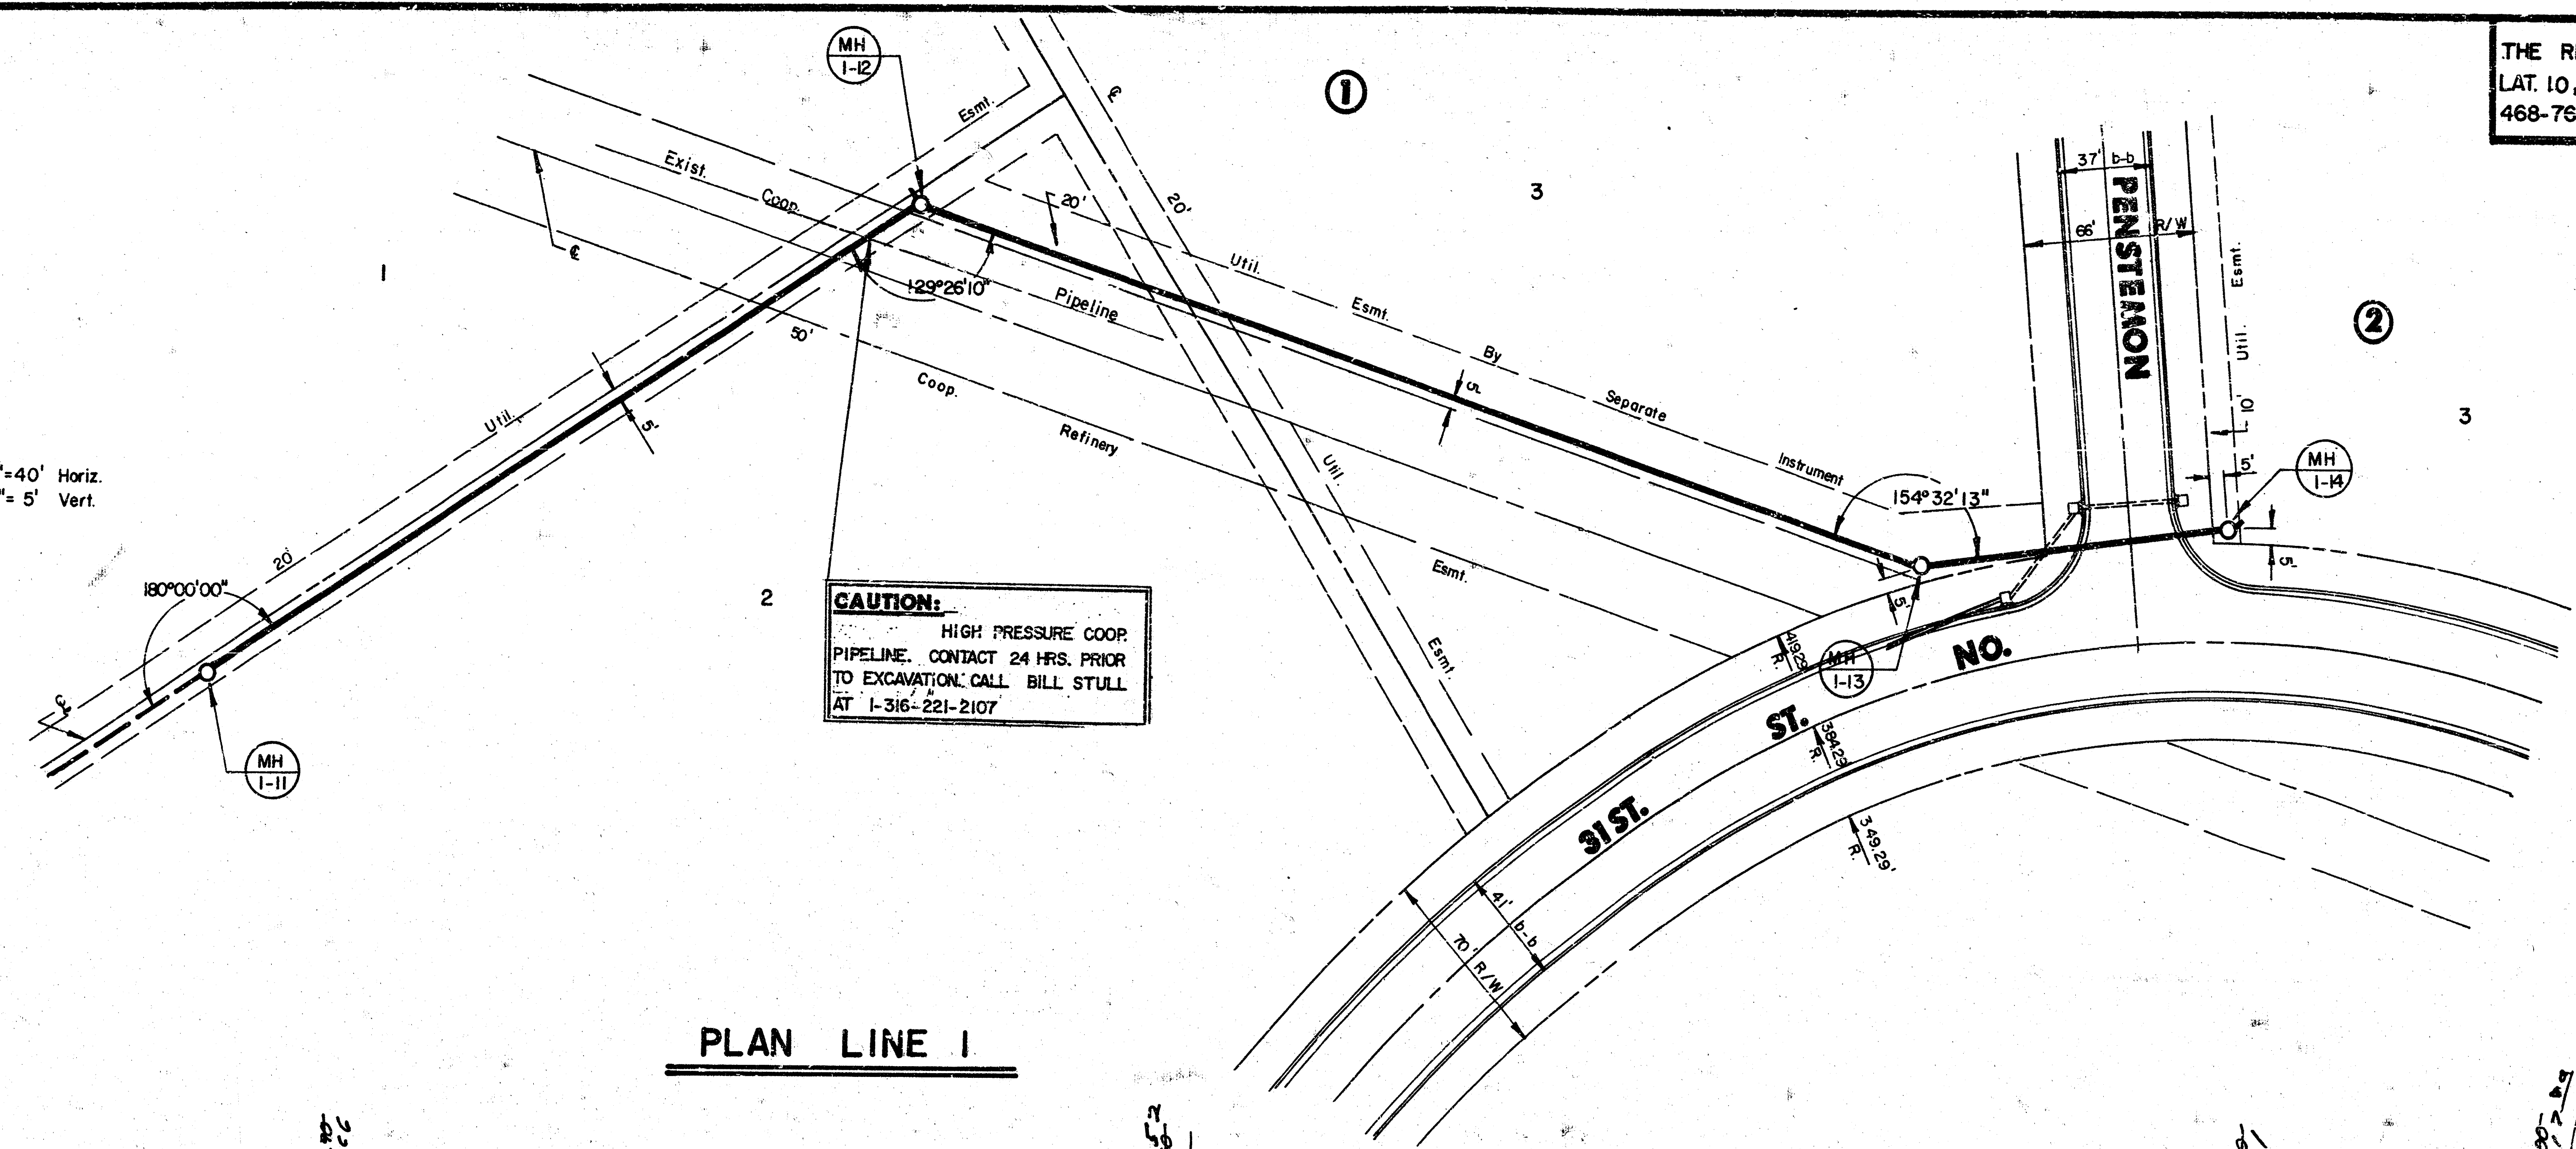

PLAN LINE 1

*As Built
 S.L.L
 8-89*

PROFILE LINE 1

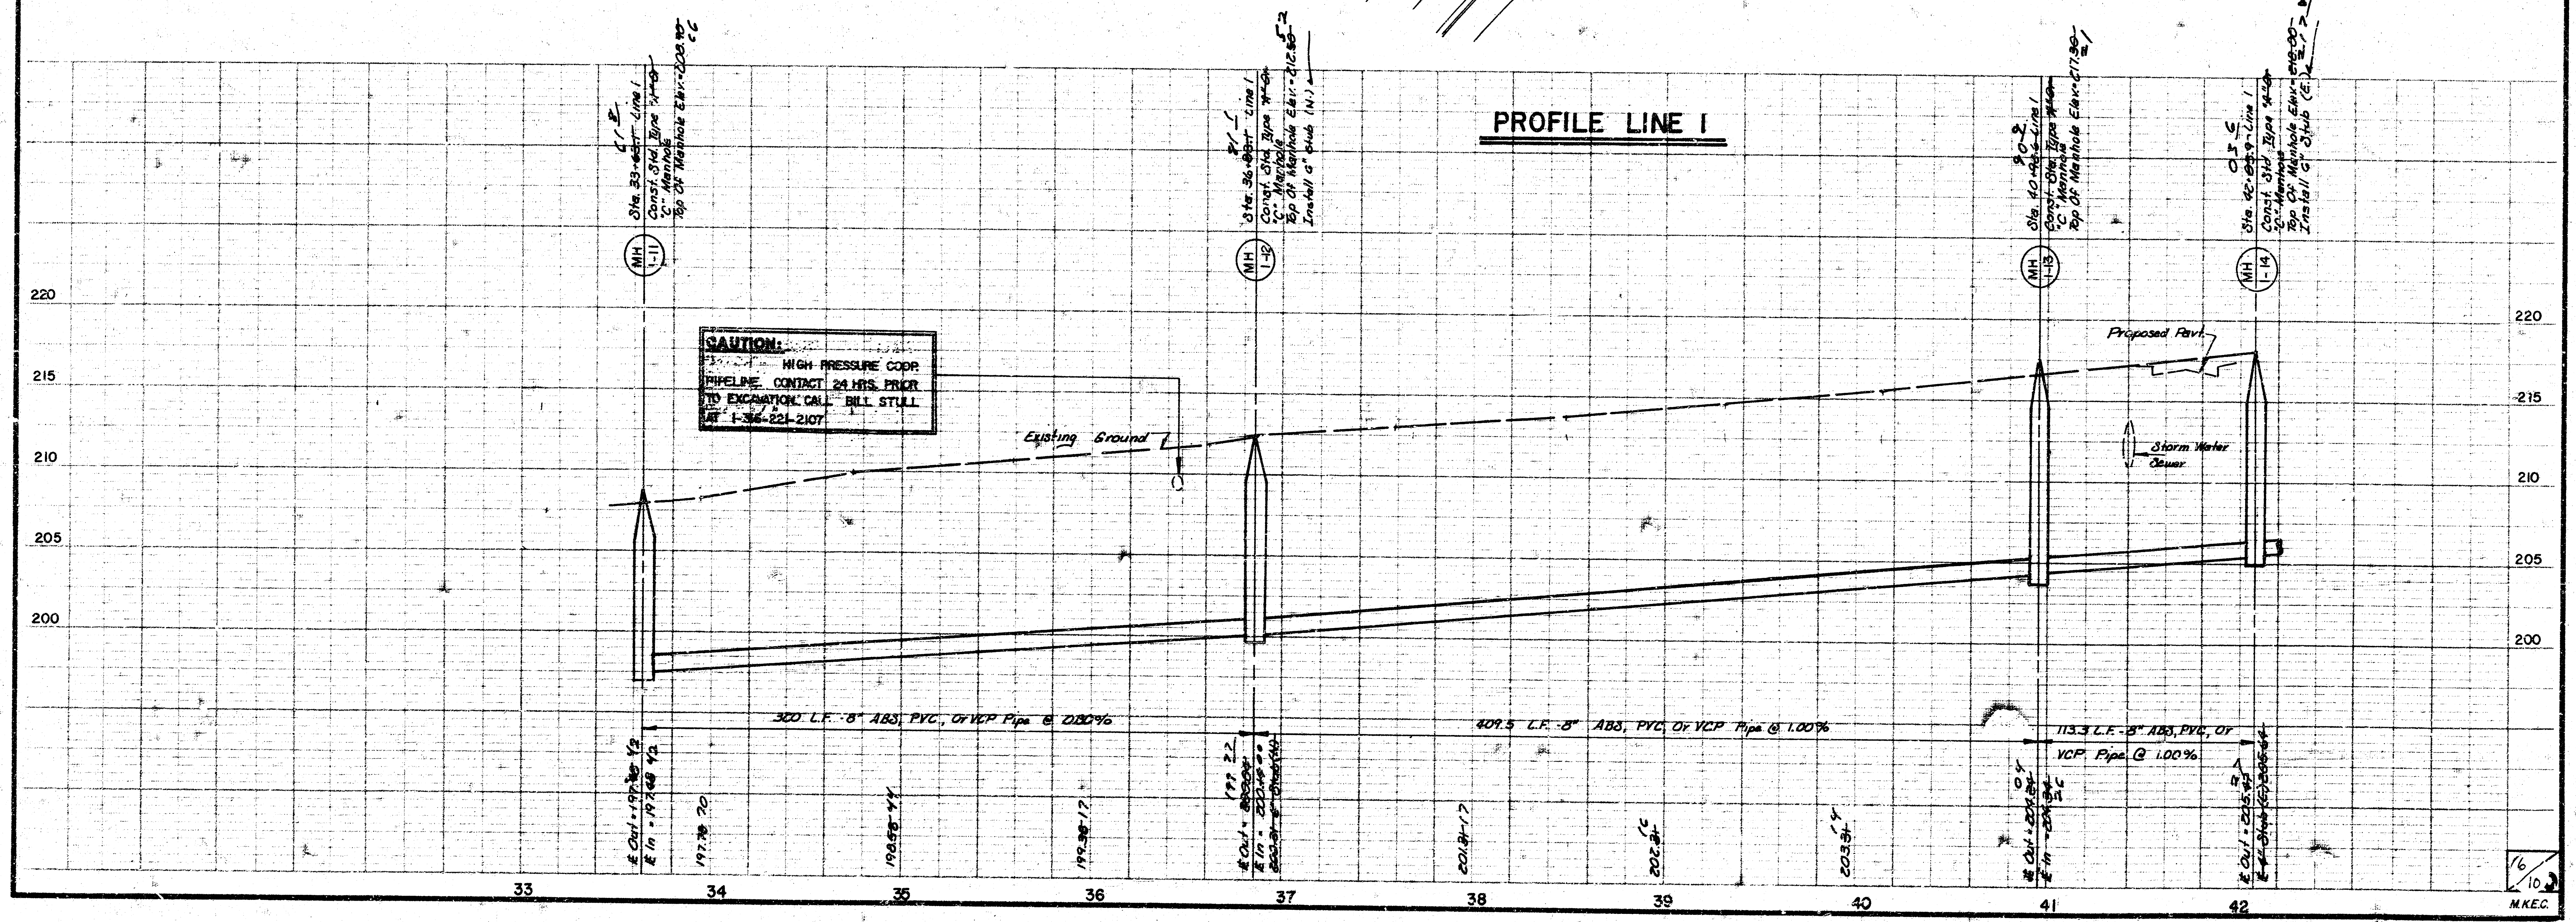


SEWER APPURTENANCES DETAILS

ADOPTED AS STANDARD DESIGN
BY


CITY of WICHITA, KANSAS

REVISED SEPTEMBER 1960
REVISED DECEMBER 1981


TYPE "A" MANHOLE

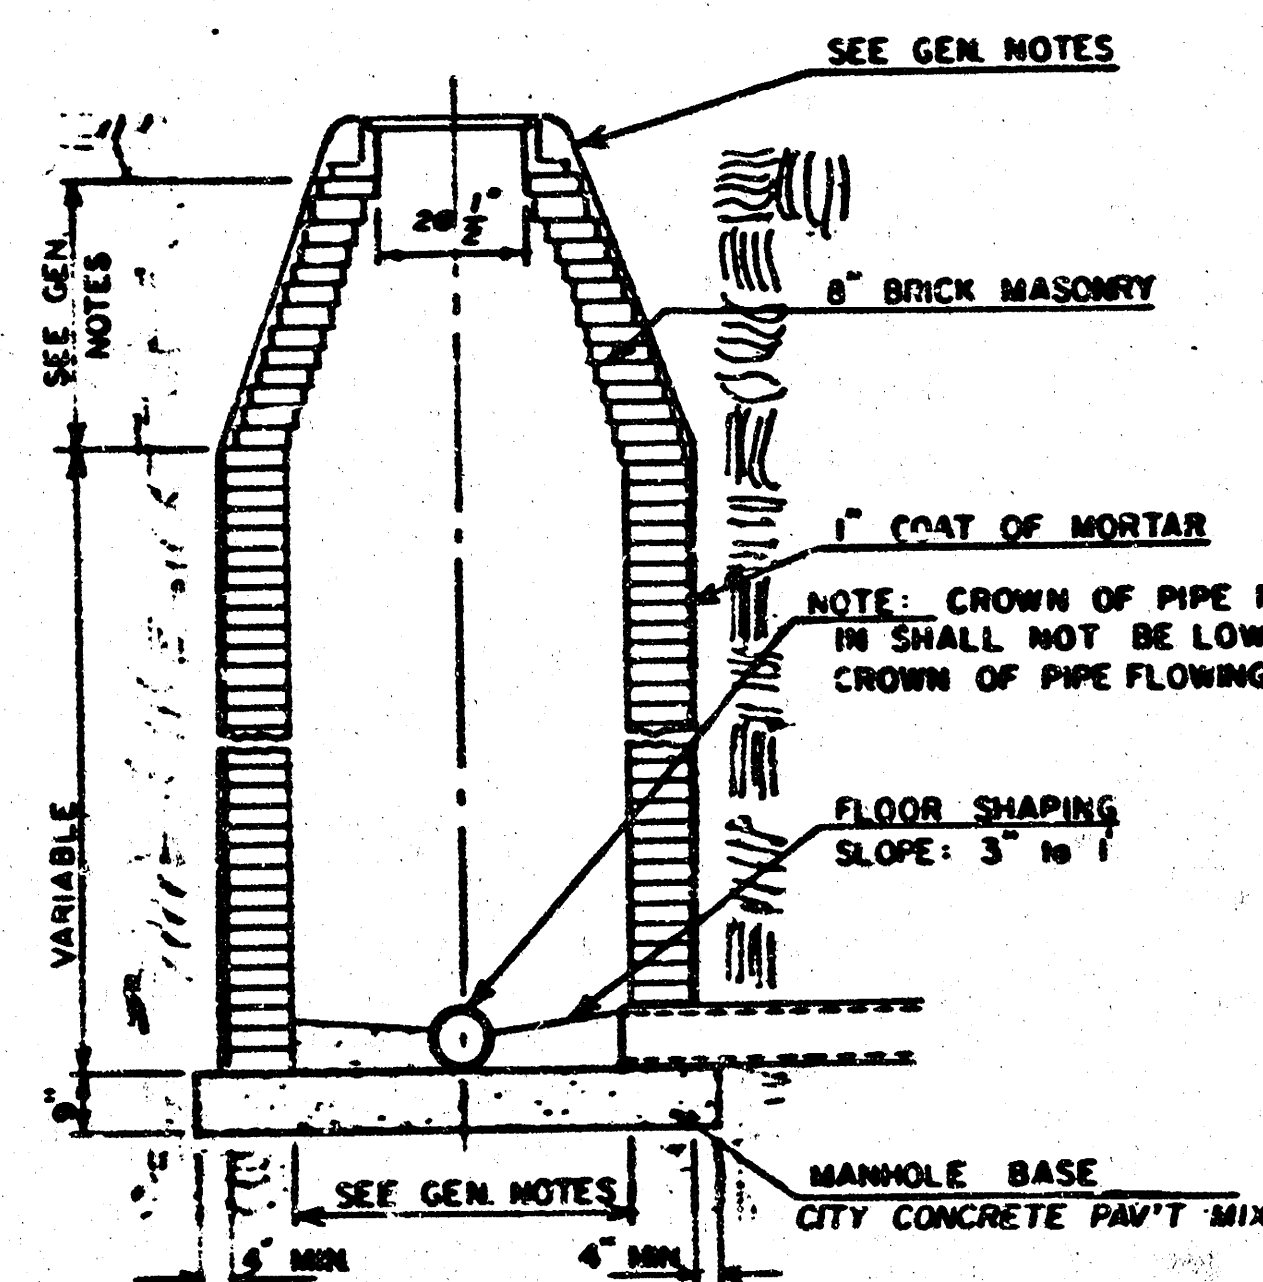


TYPE "A" INSIDE DROP MANHOLE

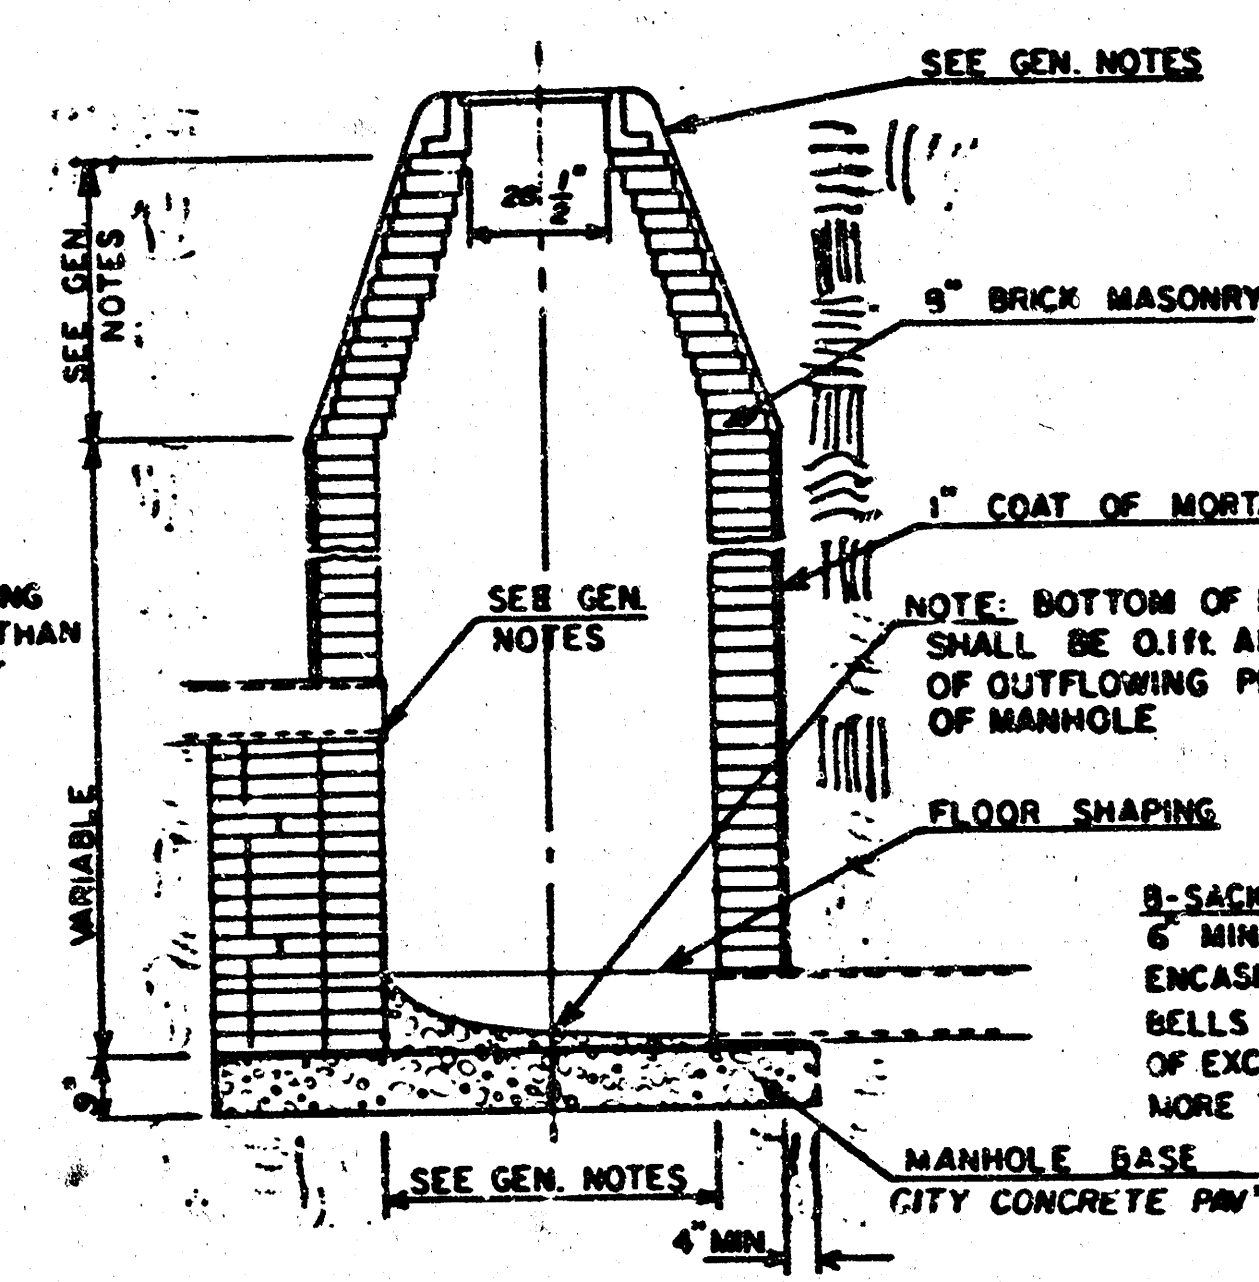

TYPE "A" OUTSIDE DROP MANHOLE

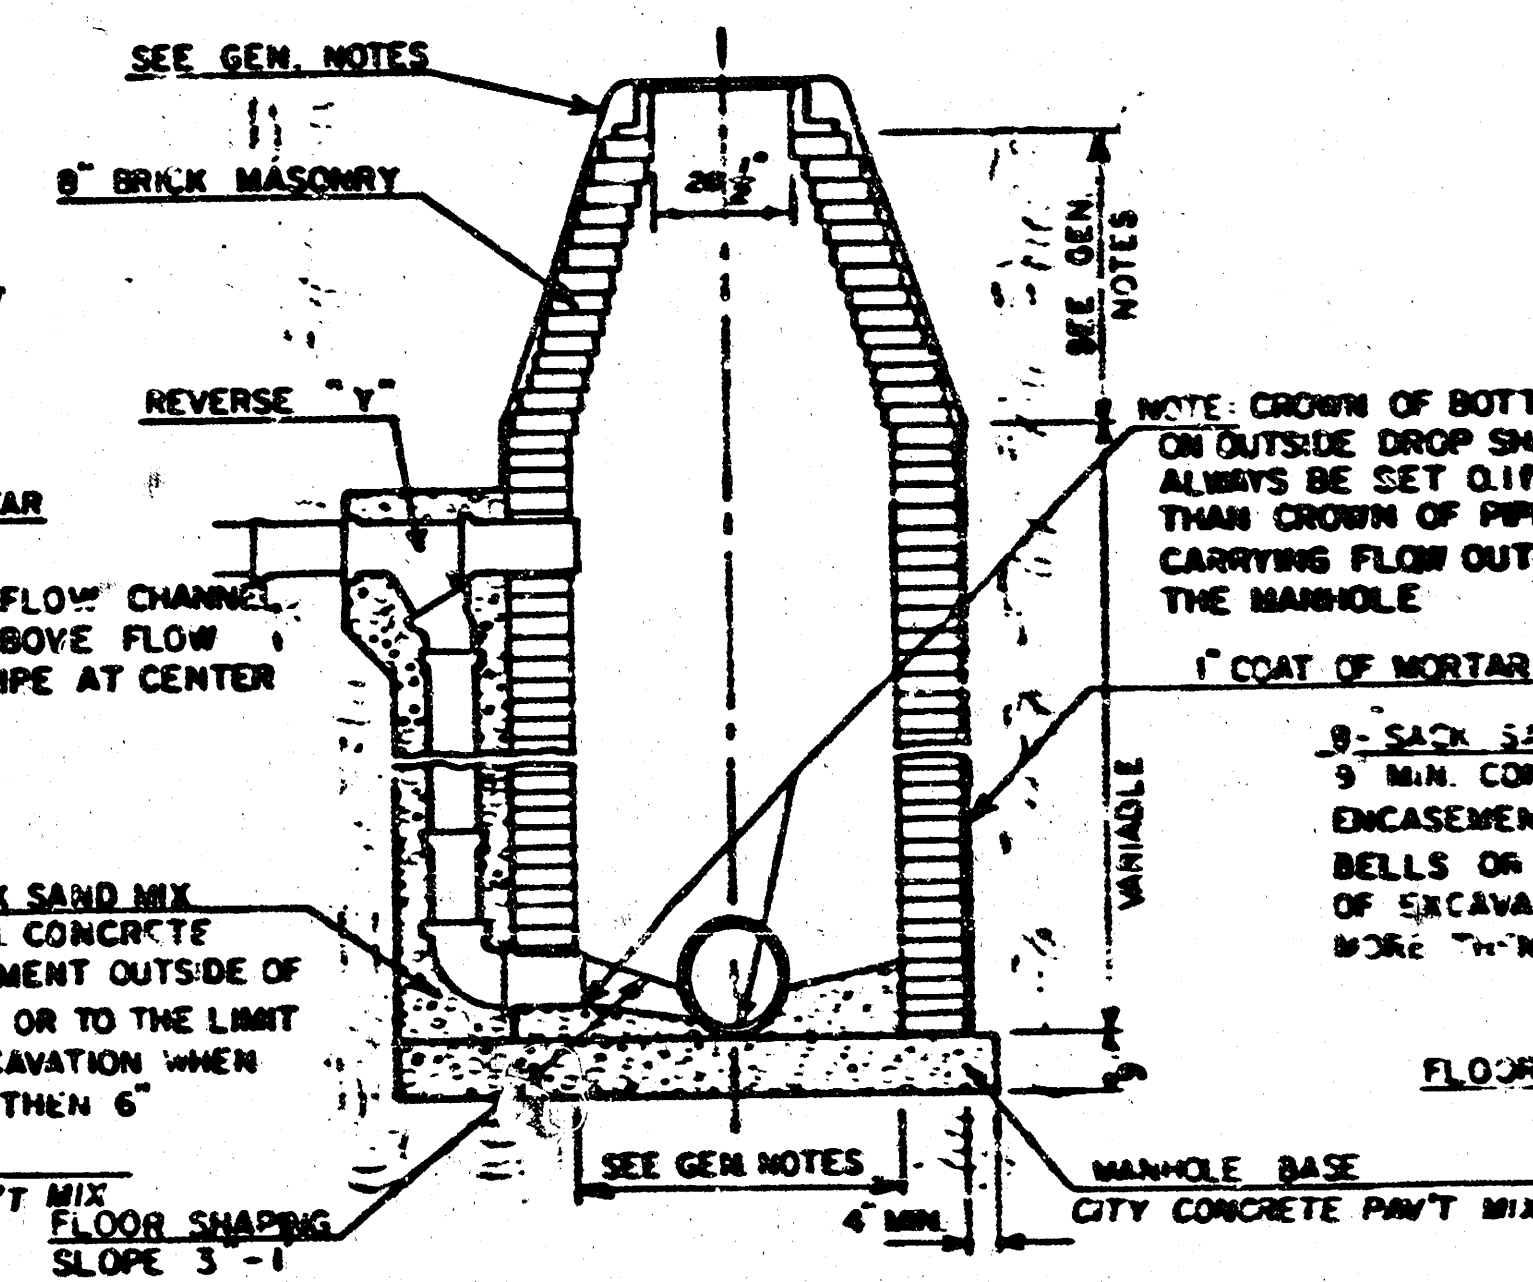

DETAIL OF OUTSIDE DROP
CONSTRUCTED ON EXISTING MANHOLE

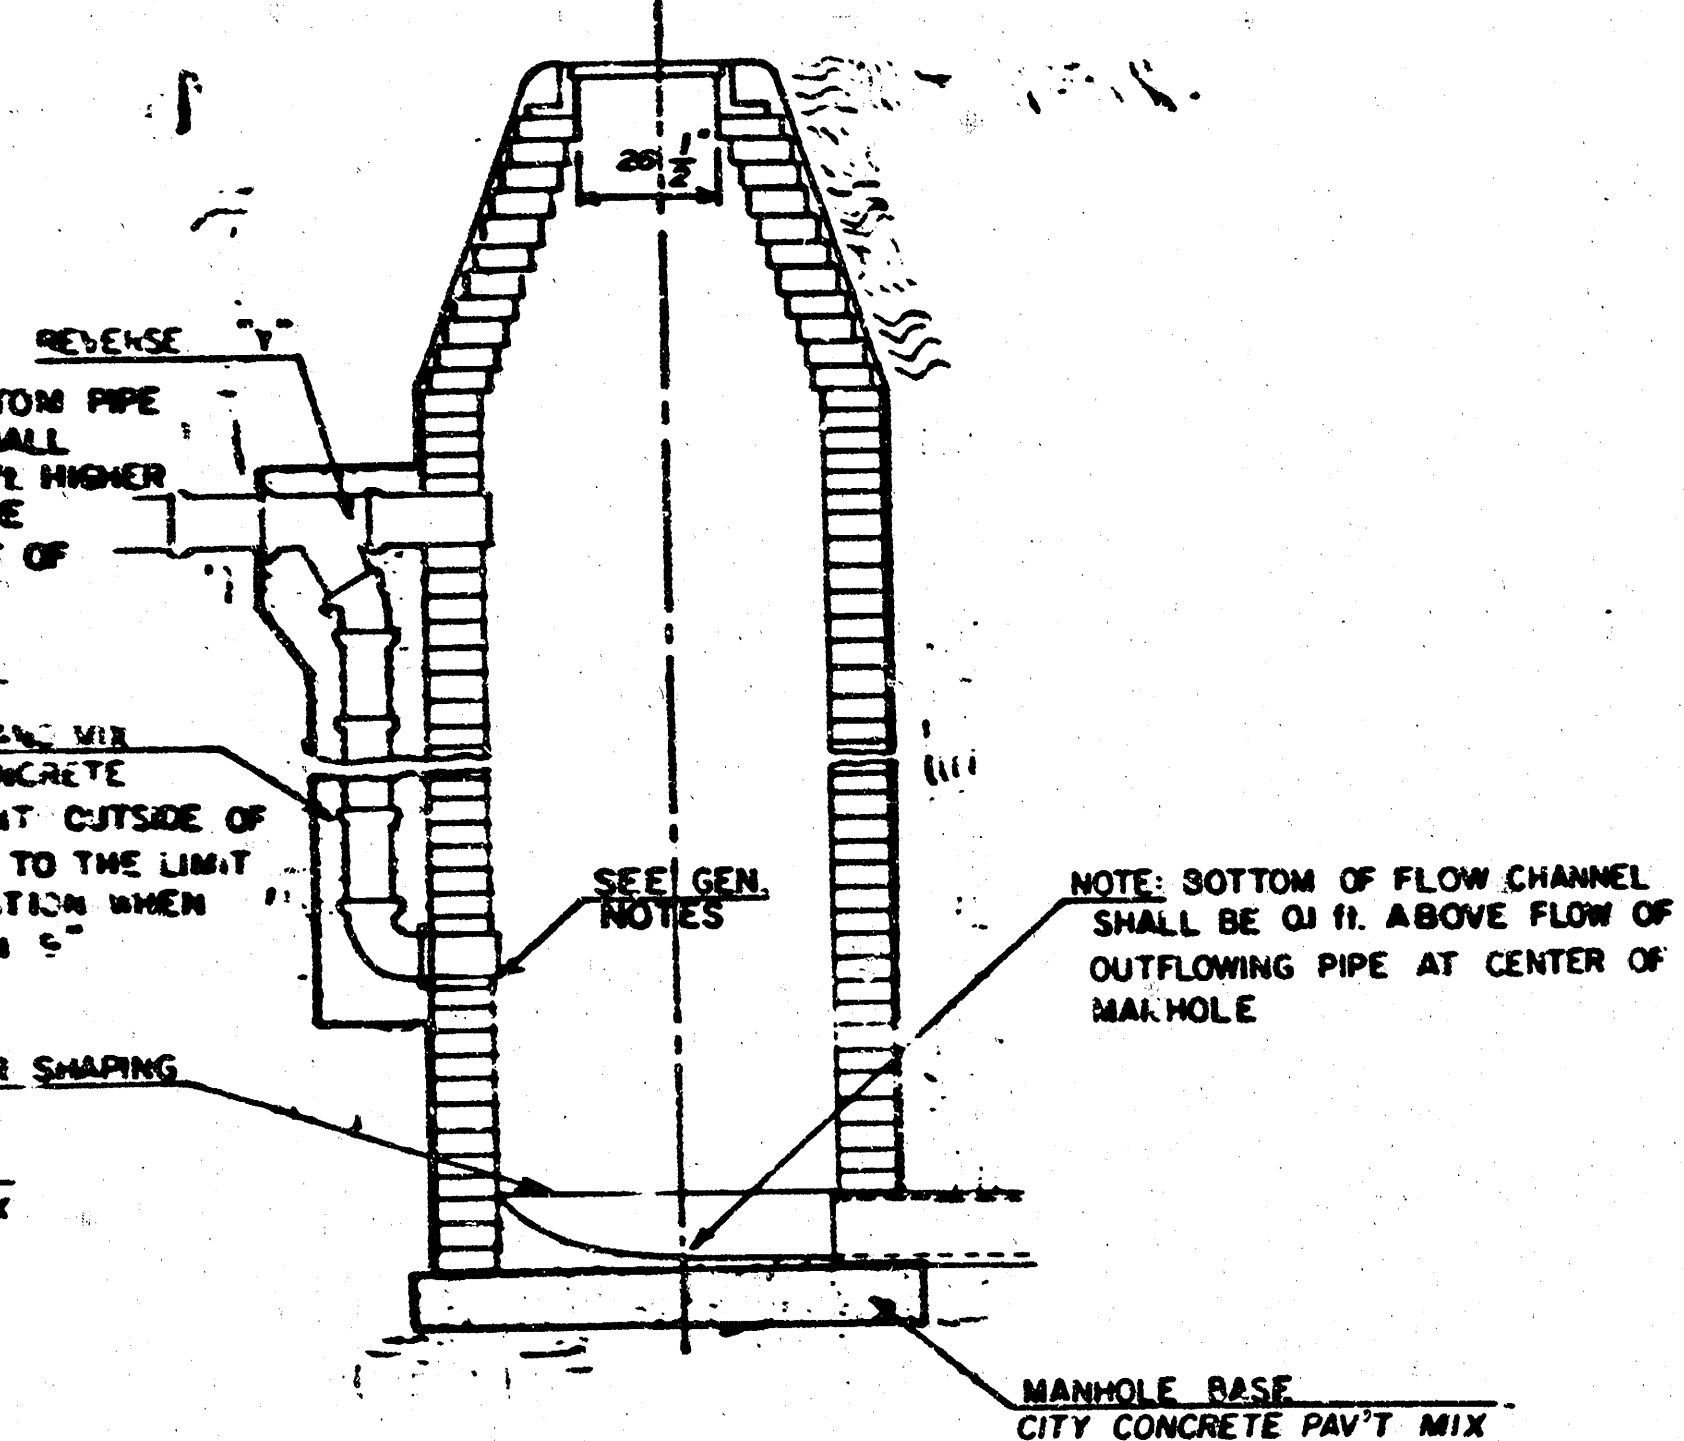


GENERAL NOTES

- MORTAR USED IN MASONRY CONSTRUCTION SHALL CONTAIN 8 SACKS OF CEMENT PER CUBIC YARD. CONCRETE USED IN MANHOLE BASES SHALL CONFORM TO THE REQUIREMENTS OF CONCRETE FOR CONCRETE PAVEMENT CONSTRUCTION AS SPECIFIED IN THE CITY STANDARD PAVING SPECIFICATIONS USING CITY CONCRETE PAVEMENT MIX WITHOUT AIR ENTRAINING AD MIXTURE. MORTAR SHALL BE PLACED AROUND THE MANHOLE RING AS SHOWN ON THE DRAWINGS WHEN MANHOLES ARE CONSTRUCTED IN UNPAVED AREAS. TYPE "A" MANHOLES CAN BE USED ON SEWERS UP TO 16' IN DEPTH WHEN THE MANHOLE IS NOT LOCATED WITHIN PUBLIC STREET PAVEMENT. MANHOLES CONSTRUCTED WHERE PIPE SIZES ARE SMALLER THAN 24" SHALL HAVE AN INSIDE DIAMETER OF 4'. MANHOLES CONSTRUCTED WHERE PIPE SIZES ARE 24" OR LARGER SHALL HAVE AN INSIDE DIAMETER OF 5'. THE HEIGHT OF THE CORBELS ON 4' DIAMETER MANHOLES SHALL BE 4'. MANHOLES HAVING A DIAMETER OF 5' SHALL HAVE CORBELS 6' IN HEIGHT. COMPLETED MANHOLE SHALL BE WITHOUT LEAKS AND WATER TIGHT.
- REINFORCING STEEL SHALL BE INSTALLED IN THE MANHOLE BASES AND SHALL CONSIST OF NO. 4 BARS PLACED 6" CENTERS IN BOTH DIRECTIONS. THE MANHOLE BASE REINFORCEMENT SHALL BE PLACED 6" ABOVE THE BOTTOM OF THE MANHOLE BASE. ALL COSTS FOR FINISHING AND INSTALLING REINFORCING STEEL SHALL BE INCLUDED IN THE UNIT PRICE BID FOR THE MANHOLE.
- OPENINGS SHALL BE CUT INTO THE MANHOLE WALL WHEN OUTSIDE DROPS ARE CONSTRUCTED ON EXISTING MANHOLES. SUCH OPENINGS CUT INTO EXISTING MANHOLES SHALL BE AS SMALL AS PRACTICAL TO FACILITATE INSTALLING AND GROUTING THE NEW PIPE IN PLACE. WATERSTOP GASKETS SHALL BE USED WITH P.V.C. AND A.B.S. COMPOSITE PIPE. THE NEW PIPE SHALL BE GROUTED INTO THE OPENING USING AN APPROVED NONSHRINK GROUT FOR THE FULL MANHOLE WALL THICKNESS. THE EXTERIOR OF THE COMPLETED CONNECTION SHALL BE SEALED WITH AN APPROVED BITUMINOUS COATING SUCH THAT THE CONNECTION WILL BE WATER TIGHT. FLOOR OF MANHOLE SHALL BE MODIFIED TO FORM NEW FLOW CHANNEL FOR THE NEW CONNECTION AS INDICATED BY THE DRAWING. THE VERTICAL DROP FROM THE LOWER PIPE ON SUCH OUTSIDE DROP CONNECTIONS SHALL NOT EXCEED 4' FOR INFLOWING PIPES SIZED 12" OR SMALLER AND 2' FOR INFLOWING PIPES SIZED LARGER THAN 12". EXCEPT THE CROWN OF THE LOWER PIPE SHALL NEVER BE SET BELOW THE CROWN OF ANY LARGER OUTFLOWING PIPE. THIS WORK, INCLUDING MODIFICATION OF MANHOLE FLOOR, SHALL BE PAID FOR AT THE UNIT PRICE BID FOR OUTSIDE DROP STACK CONSTRUCTED ON EXISTING MANHOLE.
- THE FLOORS OF ALL MANHOLES SHALL BE SHAPED WITH FLOW CHANNELS SUCH THAT THE MANHOLES WILL BE SELF CLEANING AND FREE OF AREAS WHERE SOLIDUSION COULD BE DEPOSITED AS SEWAGE FLOWS THROUGH THE MANHOLE FROM ALL INLET PIPES TO THE OUTLET PIPE. FLOW CHANNELS SHALL BE FORMED TO MATCH THE BOTTOM HALVES OF THE INFLOWING PIPES AND THE OUTFLOWING PIPE AS SHOWN BY THE DRAWINGS EXCEPT FOR INSIDE DROP MANHOLES. FLOW CHANNELS FOR INSIDE DROP MANHOLES SHALL BE CONSTRUCTED AS INDICATED BY THE DRAWING. MANHOLE FLOORS SHALL HAVE SLOPES OF 3 INCHES PER FOOT IN THE AREAS OUTSIDE OF THE FLOW CHANNELS SLOPED TOWARD THE FLOW CHANNELS. PIPES LAID THROUGH MANHOLES SHALL HAVE THE TOP HALF REMOVED TO MATCH LINES FOR THE FULL INSIDE DIAMETER OF THE MANHOLE. MANHOLE FLOORS SHALL THEN BE SHAPED AROUND THE BOTTOM HALF OF THE PIPE WHICH FORMS THE FLOW CHANNEL.
- PIPES INSTALLED WITHIN THE EXCAVATION MADE FOR THE MANHOLE SHALL BE CRADLED WITH CONCRETE TO THE LIMITS OF THE MANHOLE EXCAVATION. WHEN CLAY PIPE IS USED, THE CRADLE SHALL EXTEND TO THE FIRST JOINT OUTSIDE THE MANHOLE. THE CRADLE SHALL BE TERMINATED AT THE CLAY PIPE JOINT IN A MANNER WHICH WILL MAINTAIN THE FLEXIBILITY OF THE JOINT. COST OF THE CRADLE WITHIN MANHOLE EXCAVATION OR TO CLAY PIPE JOINTS ADJACENT TO MANHOLE SHALL BE INCLUDED IN THE UNIT PRICE BID FOR THE MANHOLE.
- MANHOLE COVER CASTINGS AND MANHOLE FRAME CASTINGS SHALL CONFORM TO THE REQUIREMENTS AS INDICATED IN THE STANDARD SPECIFICATIONS AND AS SHOWN IN THE STANDARD DETAIL DRAWING.
- THE VERTICAL DROP IN INSIDE DROP MANHOLES SHALL NOT EXCEED 4' FOR INFLOWING PIPES SIZED 12" OR SMALLER AND 2' FOR INFLOWING PIPES LARGER THAN 12". THE CROWNS OF INFLOWING PIPES SHALL NEVER BE SET LOWER THAN THE CROWN OF THE OUTFLOWING PIPE.
- STANDARD MANHOLES TYPE "A" AND STANDARD INSIDE DROP MANHOLES TYPE "A" SHALL BE BID AS STANDARD MANHOLES FOR THE TYPE AND DIAMETER INDICATED. OUTSIDE DROP MANHOLES TYPE "A" SHALL BE BID AS STANDARD OUTSIDE DROP MANHOLES FOR THE TYPE AND DIAMETER INDICATED. ALL MANHOLE DIAMETERS WILL BE 4' UNLESS INDICATED OTHERWISE.

THE RENAISSANCE

S-2 2-31 B

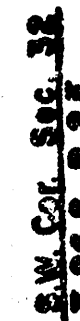

I hereby certify that the details on this plot are correct to the best of my knowledge and belief this 20 of MAY, 1983.



Donald J. Ablah


18
10

My Appointment Expires: 11-17-84

FINAL PLAT OF

THE RENAISSANCE

AN ADDITION TO WICHITA, SEDGWICK COUNTY, KANSAS

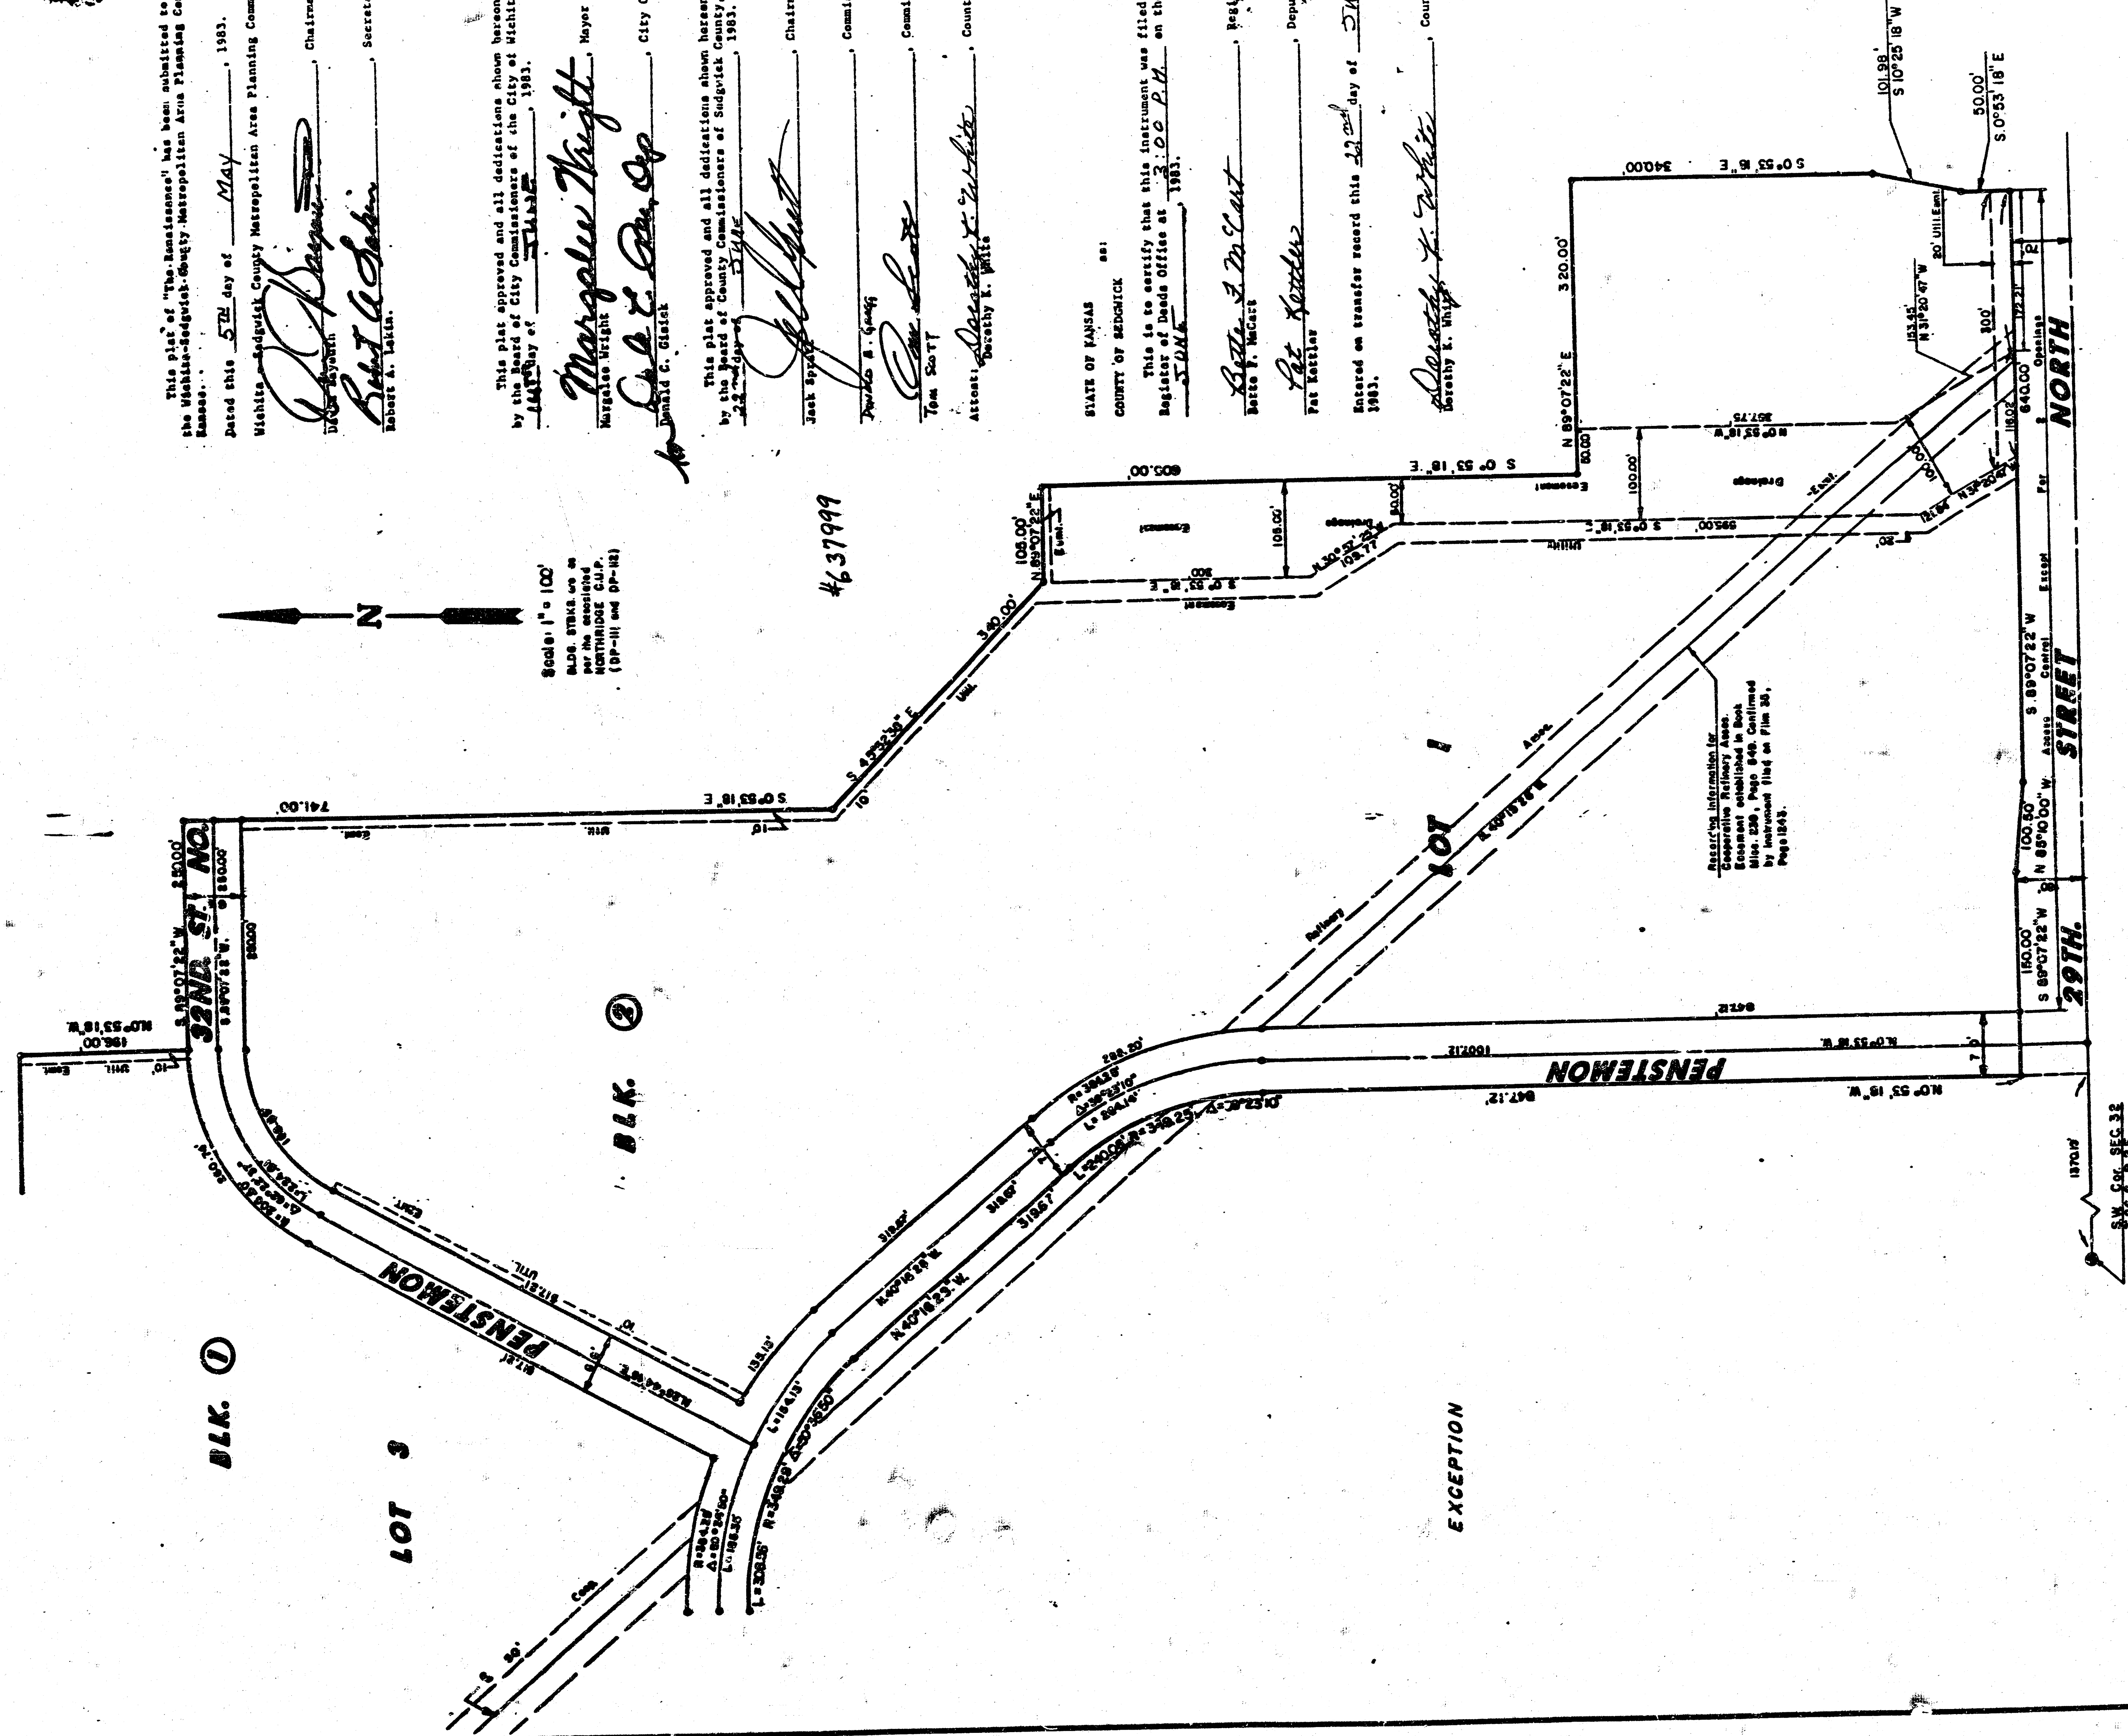

This plat of "The Renaissance" has been submitted to and approved by the Wichita-Sedgwick County Metropolitan Area Planning Commission, Wichita, Kansas.

Dated this 5th day of MAY, 1983.

Wichita-Sedgwick County Metropolitan Area Planning Commission

Chairman

Secretary

Robert A. Latta

This plat approved and all dedications shown herein, if any, accepted by the Board of Commissioners of the City of Wichita, Kansas this 14th day of MAY, 1983.

Mayor

City Clerk

Chairman

Commissioner

Commissioner

County Clerk

Attest

Notary Public

Notary Public

PROPOSED PLAT OF COMOTARA OFFICE CENTER

AN ADDITION TO WICHITA, SEDGWICK COUNTY, KANSAS

I, Michael D. Harding, a Civil Engineer in Kansas, do hereby certify that I have been in responsible charge of surveying and platting of "Comotara Office Center", an addition to Wichita, Sedgwick County, Kansas, into Lots, Blocks, Streets and a Reserve, the same being accurately set forth in the accompanying plat and described as follows:

A tract of land in the northeast quarter of Section 31, Township 26 south, Range 2 east of the 6th P.M. more particularly described as follows:

Beginning at a point on the half section line of said Section 31, 50.00 feet westerly bearing S 89° 03' 37" W from the east quarter corner, said point also being on the west line of Rock Road; thence continuing westerly bearing S 89° 03' 37" W, 620.00 feet; thence S 1° 05' 20" W, 1216.00 feet; thence N 42° 26' 12" W, 517.41 feet; thence N 1° 05' 20" W, 85.01 feet; thence N 89° 21' 15" E, 229.52 feet; thence N 1° 05' 20" W, 1045.31 feet to a point 50.00 feet south of the north line of said Section 31, said point also being on the south line of 37th Street North; thence easterly along said south line bearing N 89° 18' 12" E, 620.01 feet to a point 50.00 feet west of the east line of said Section 31; thence southerly parallel to said east line bearing S 1° 05' 20" E, 2602.72 feet to the point of beginning; containing 38.19 acres, more or less.

I hereby certify that the details on this plat are correct to the best of my knowledge and belief this _____ day of _____, 1983.

Michael D. Harding, P.E.
Mid-Kansas Engineering Consultants, P.A.
240 North Rock Road, Suite 130
Wichita, Kansas 67206

Know all men by these presents that we the undersigned property owners of the land as above set forth in the Civil Engineer's Certificate have caused the same to be surveyed and platted into lots, blocks, streets and a reserve, the same to be known as "Comotara Office Center", an addition to Wichita, Sedgwick County, Kansas. Easements for drainage and the construction and maintenance of public utilities, as indicated on the accompanying plat are hereby granted. Reserve "A" is platted for the construction and maintenance of public utilities, drainage and landscaping. The streets are hereby dedicated to and for the use of the public. All abutters' rights of access over and across the west line of Blocks 1, 2 and 3 are hereby granted to the City of Wichita, provided, however, that Lot 1, Block 2 shall have access to Rock Road at one location, Lot 2, Block 2 shall have access to Rock Road at three locations and Lot 1, Block 3 shall have access to Rock Road at one location. Building setbacks shall be in accordance with the assoc. Commercial Parcel 8, 9, 9A, 11, 11A, 11B C.U.P. (DP-12) in file in the Wichita, Sedgwick County M.A.P.D. office.

Woodlawn Development Company
a partnership

Donald J. Abiah
partner

STATE OF KANSAS
COUNTY OF SEDGWICK

Be it remembered that on this _____ day of _____, 1983, before me, a Notary Public in and for said State and County, came Donald J. Abiah, partner of Woodlawn Development Company, a partnership, to me personally known to be the same person who executed the foregoing instrument of writing and duly acknowledged the execution of the same. In testimony whereof I have hereunto set my hand and affixed my notarial seal the day and year above written.

_____, Notary Public

My Appointment Expires: _____
We, the First National Bank of St. Paul, mortgagees on the above described property do hereby consent to the plat of "Comotara Office Center".

Phillip S. Frick
Attorney in Fact for First National Bank of St. Paul
STATE OF KANSAS

COUNTY OF SEDGWICK

Be it remembered that on this _____ day of _____, 19____, before me, a Notary Public in and for said State and County, came the First National Bank of St. Paul, by Phillip S. Frick, Attorney in Fact for First National Bank of St. Paul, to me personally known to be the same person who executed the foregoing instrument of writing and duly acknowledged the execution of the same. In testimony whereof I have hereunto set my hand and affixed my notarial seal the day and year above written.

_____, Notary Public

My Appointment Expires: _____

This plat of "Comotara Office Center" has been submitted to and approved by the Wichita-Sedgwick County Metropolitan Area Planning Commission, Wichita, Kansas.

Dated this _____ day of _____, 1983.

Wichita-Sedgwick County Metropolitan Area Planning Commission

David Bayouth, Chairman

Robert A. Lakin, Secretary

This plat approved and all dedications shown hereon, if any, accepted by the Board of City Commissioners of the City of Wichita, Kansas, this day of _____, 1983.

Margalee Wright, Mayor

Donald C. Gistick, City Clerk

This plat approved and all dedications shown herein, if any, accepted by the Board of County Commissioners of Sedgwick County, Kansas, this day of _____, 1983.

Jack Spratt, Chairman

Donald E. Gragg, Commissioner

Tom Scott, Commissioner

Attest: Dorothy K. White, County Clerk

Entered on transfer record this _____ day of _____, 1983.

Dorothy K. White, County Clerk

STATE OF KANSAS

COUNTY OF SEDGWICK

This is to certify that this instrument was filed for record in the Register of Deeds Office at _____ on the _____ day of _____, 1983.

Bette F. McCart, Register of Deeds

Pat Kettler, Deputy

