
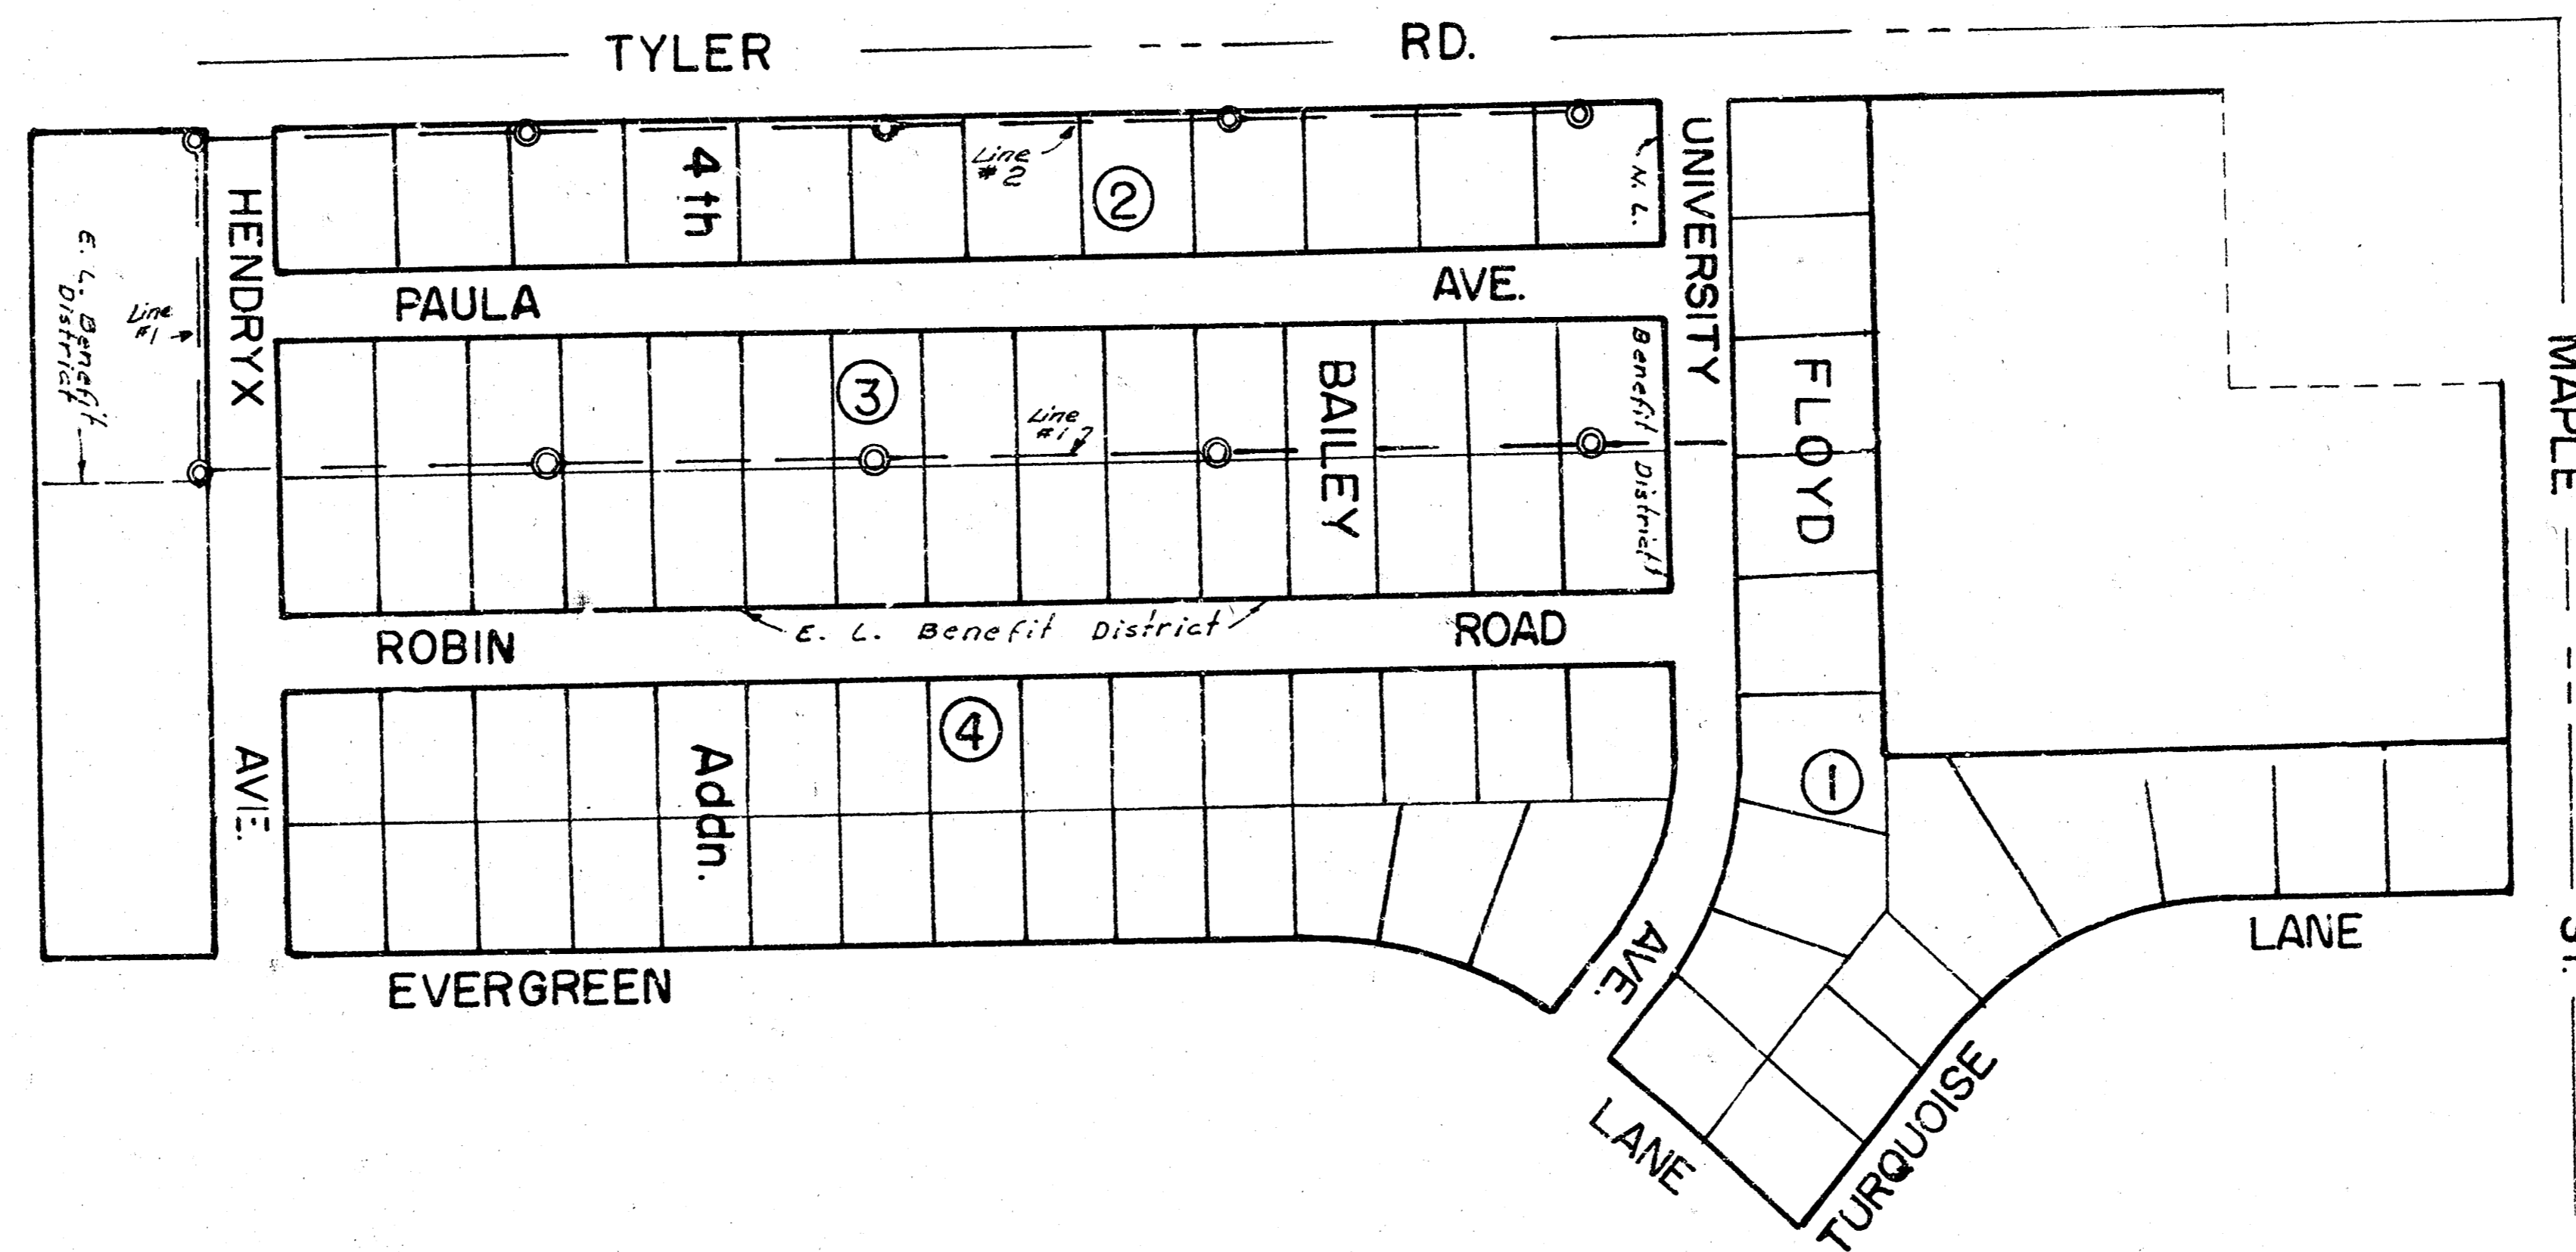


Lateral 7, Southwest Main


Project No. DBKL 568030

R. W. Linn City Engineer

City of Wichita, Kansas


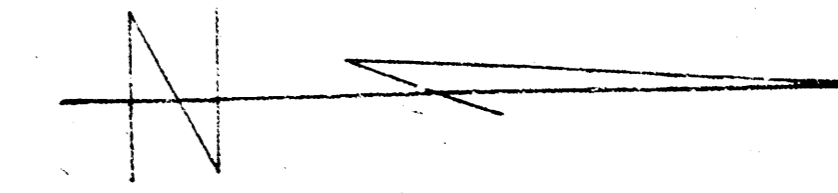


Line No.	Sheet No.
1	2 & 3
2	4

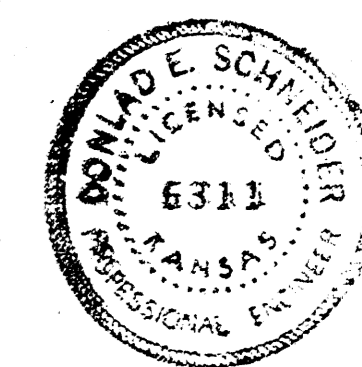


As Built Final Measurements
H-105


B.M. 143.53 Std. 342 E. of 222's & both Tyler & Maple
 B.M. 143.20 R.R. 3 mi. S.E. side P.P. NW. Cor. Tyler & Ballview
 B.M. 141.92 S.E. Cor. Conc. Patch Tyler Rd. Baptist Ch. SW. Cor. Tyler & Bryan Rd.

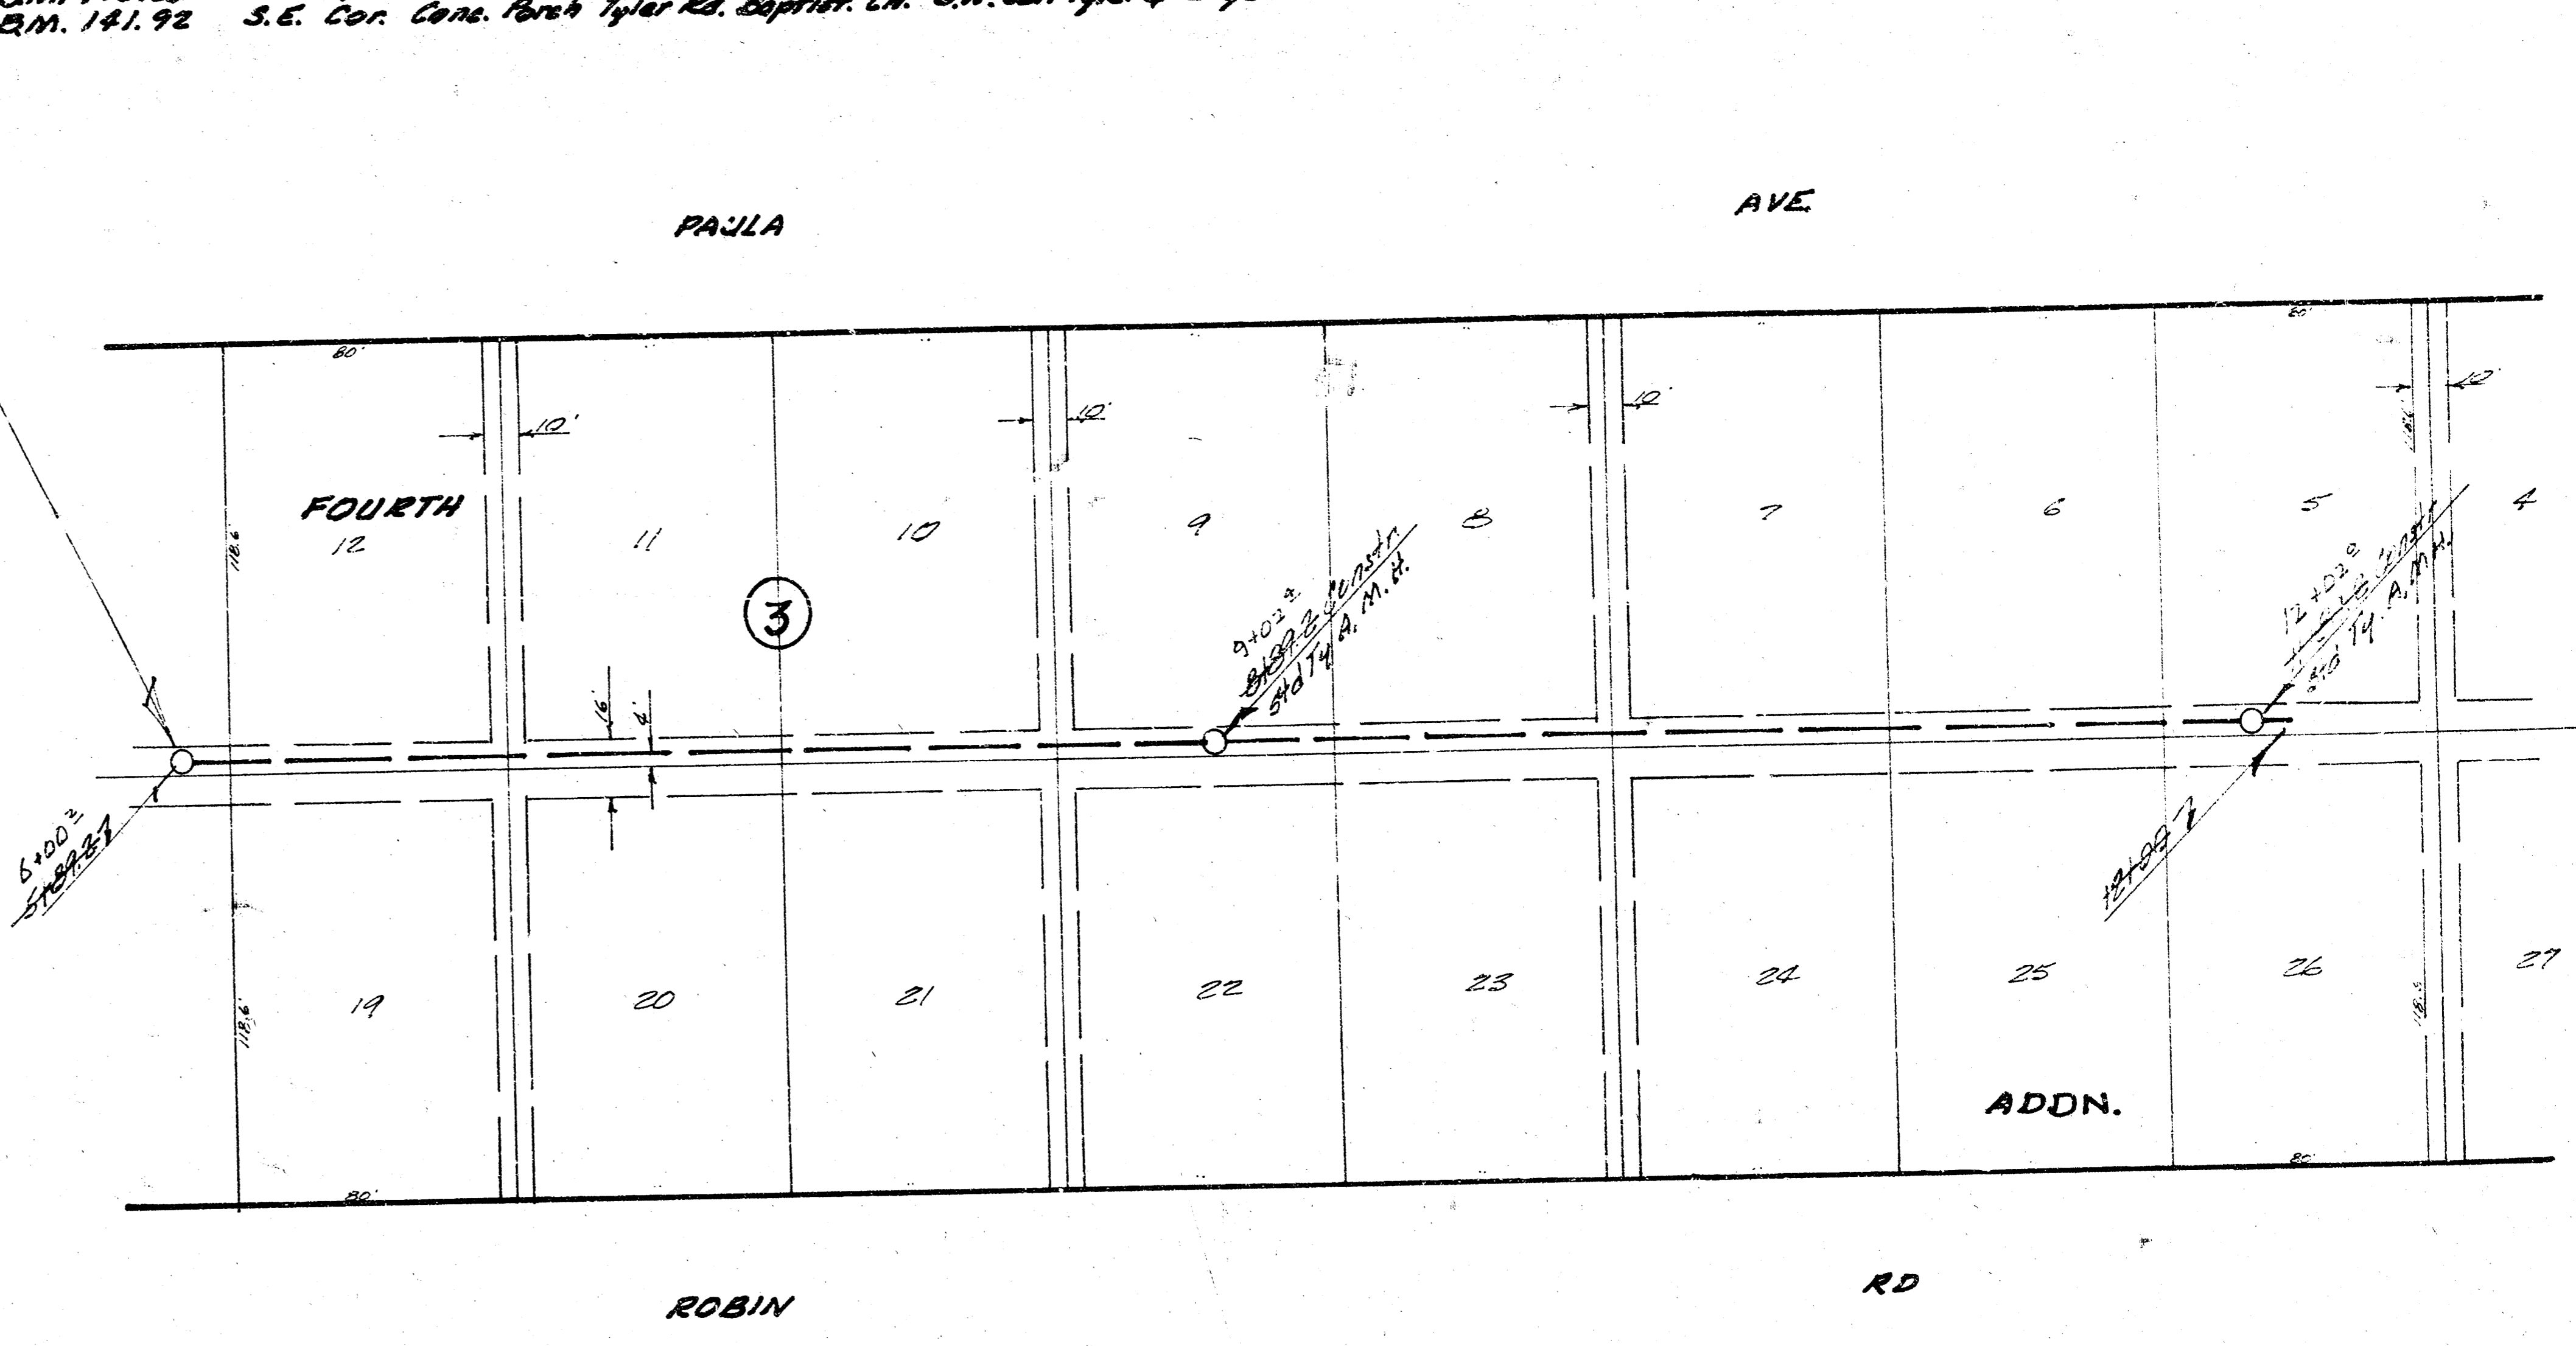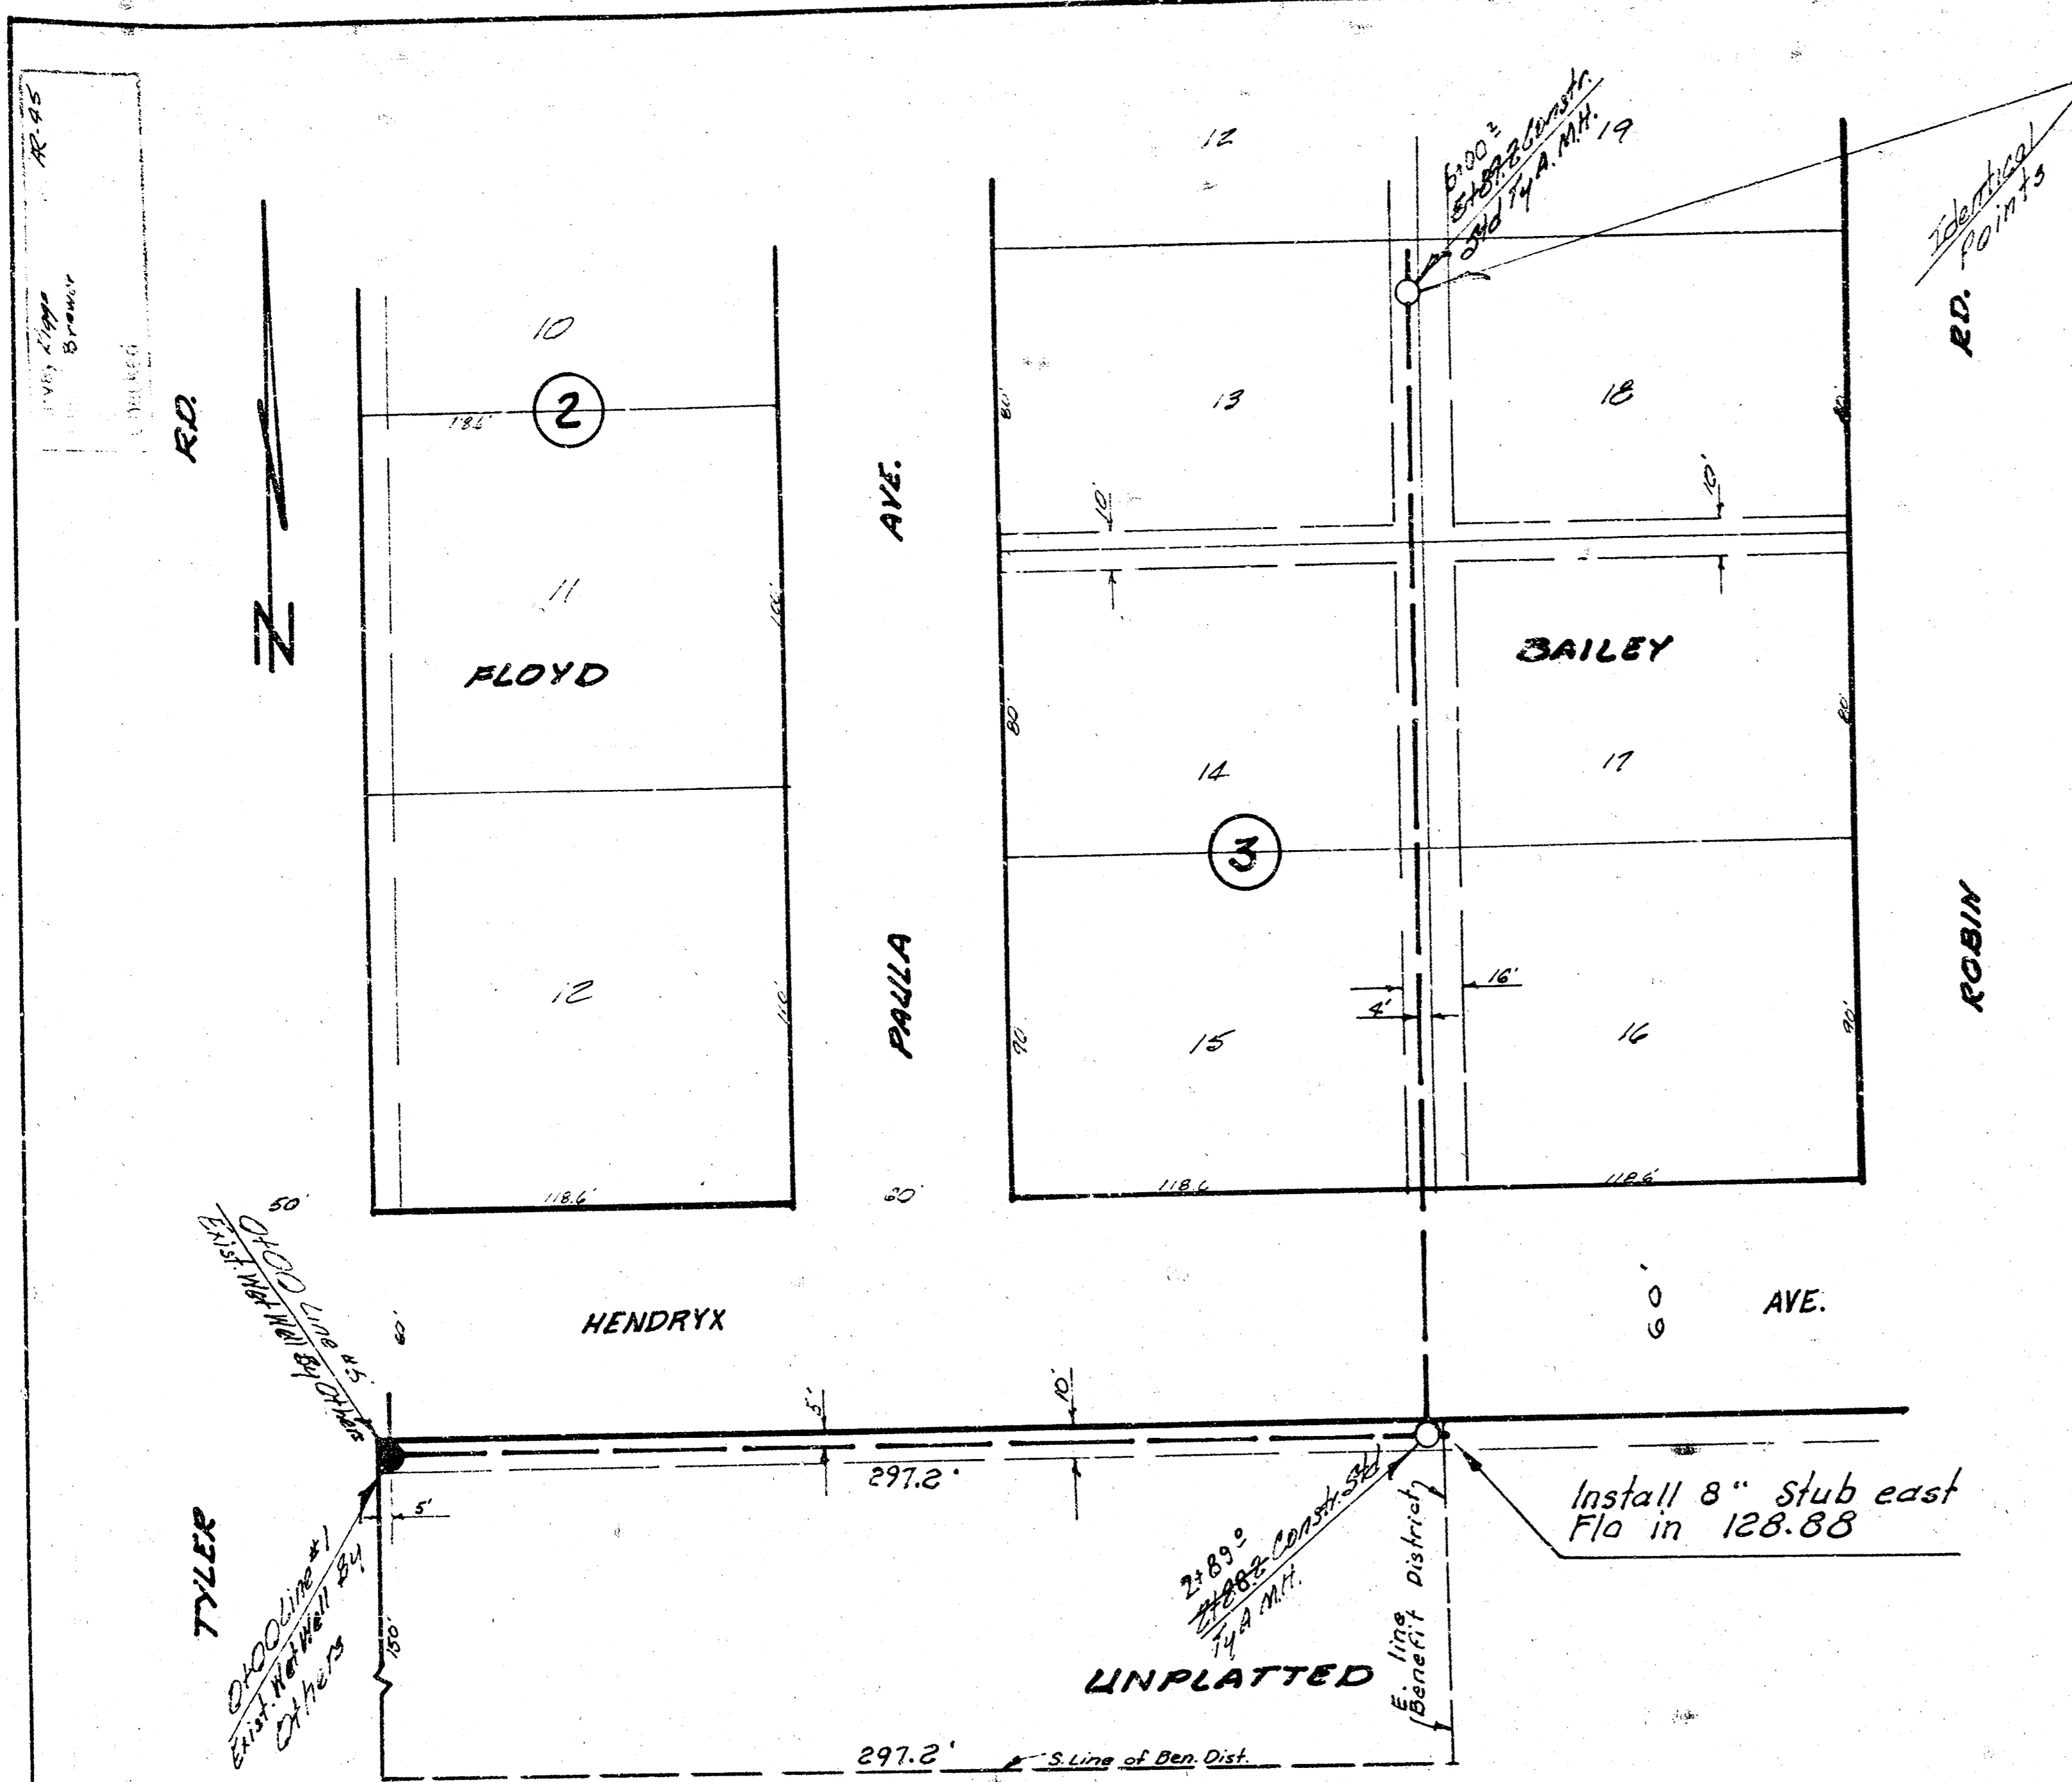


PLAN SCALE 1" = 40'
 PROFILE SCALE 1" = 4' V
 1" = 40' H

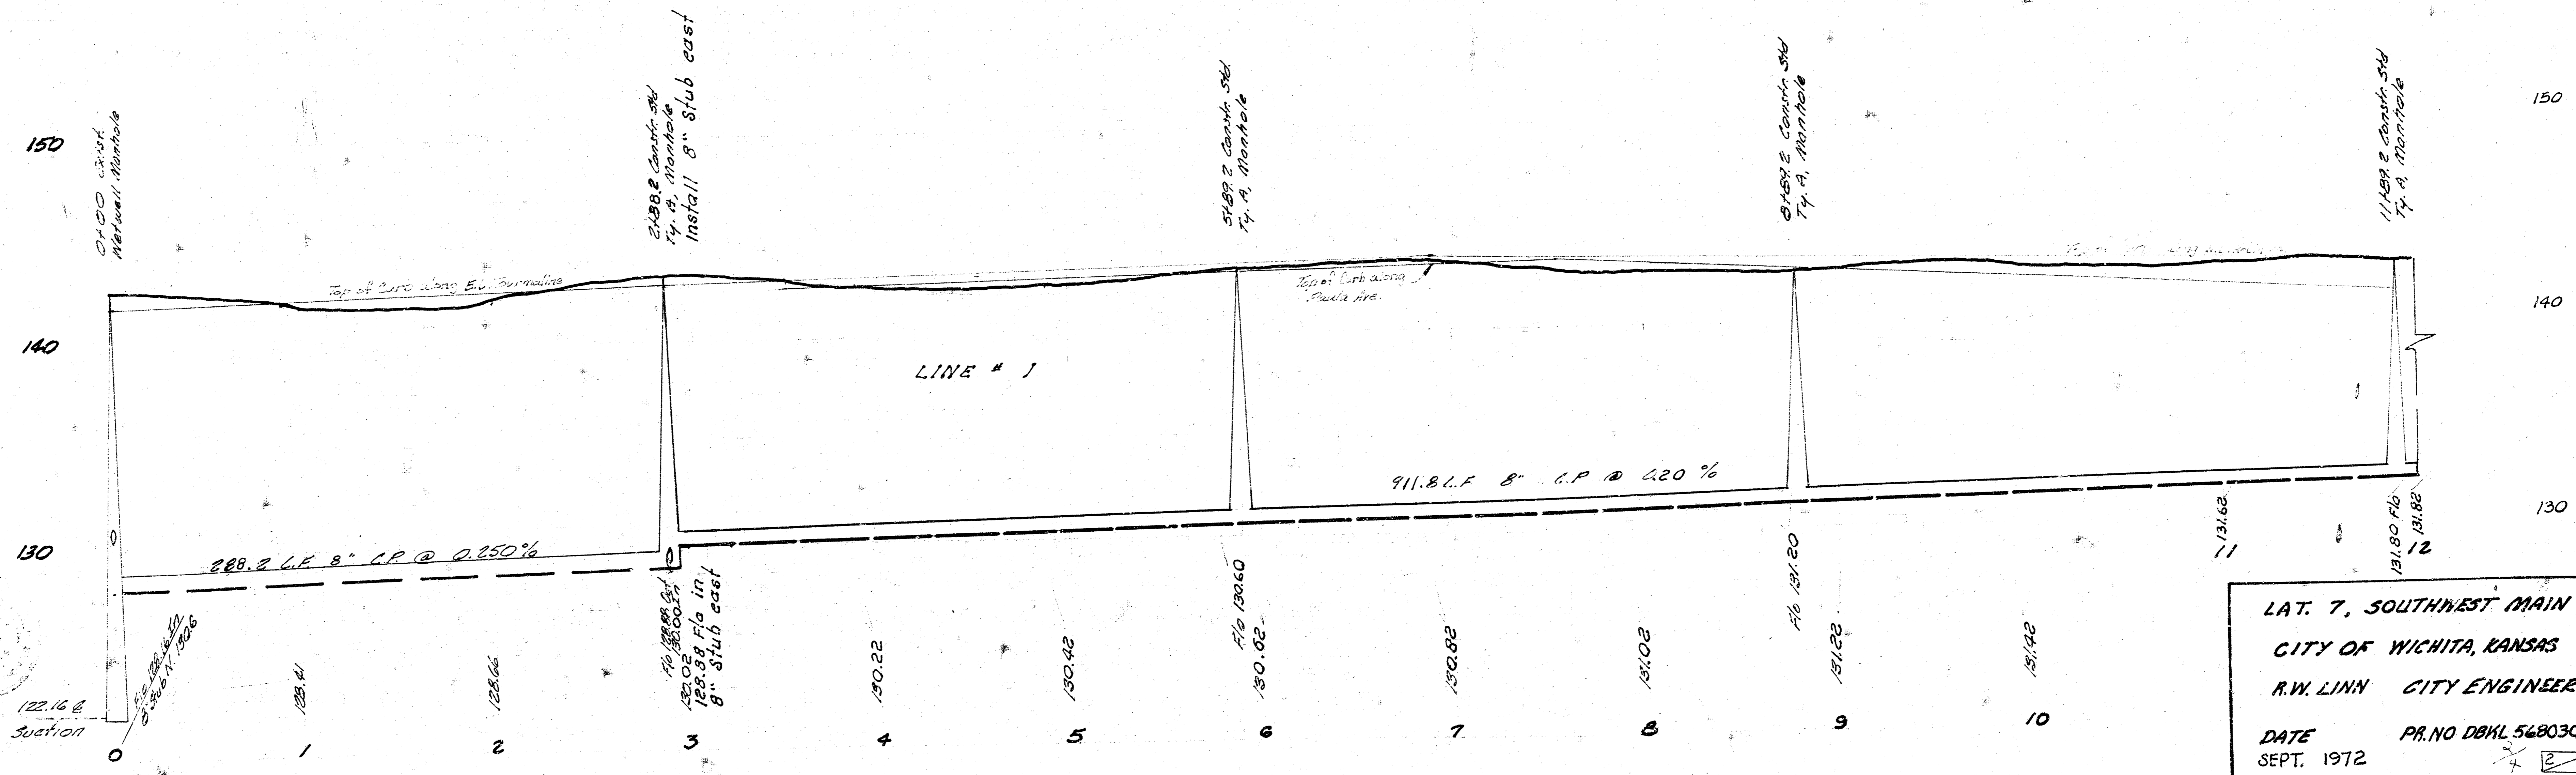



LAT. 7, SOUTHWEST MAIN
 CITY OF WICHITA, KANSAS
 R.W. LINN CITY ENGINEER
 DATE SEPT. 1972 PR. NO DBKL 568030

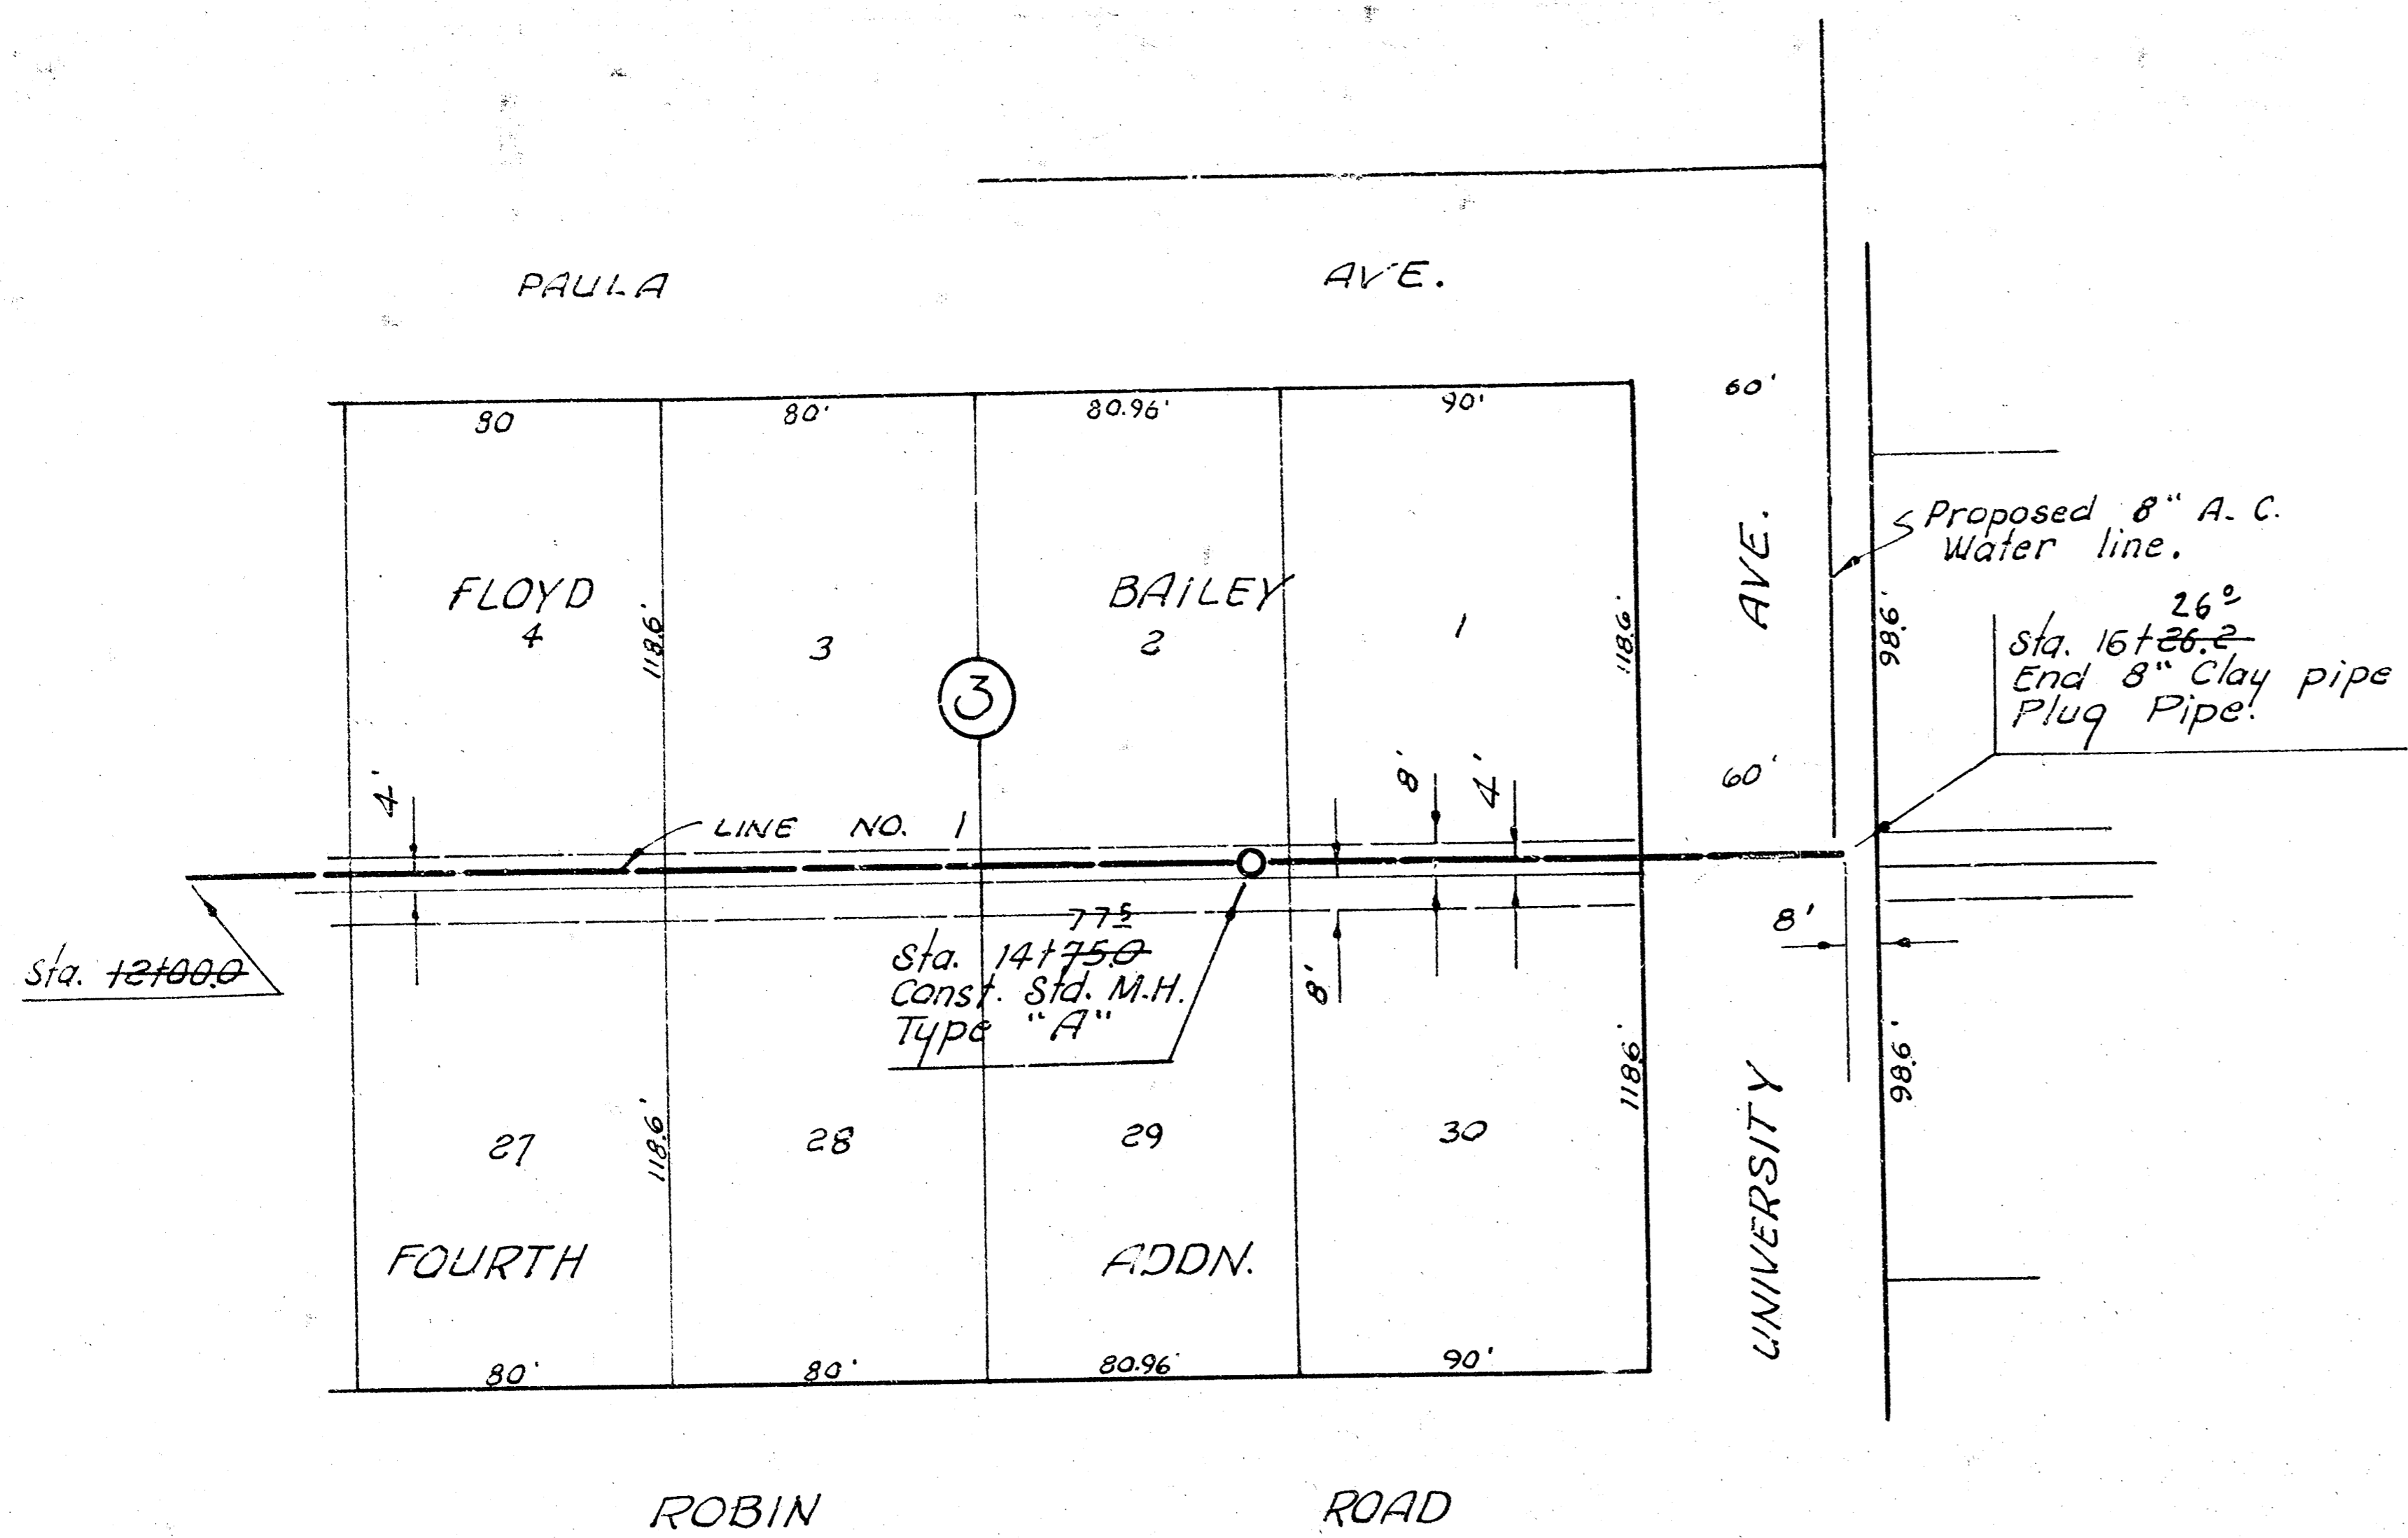

Plan Scale 1" = 40'
 Profile Scale 1" = 40' Horiz.
 1" = 5' Vert.

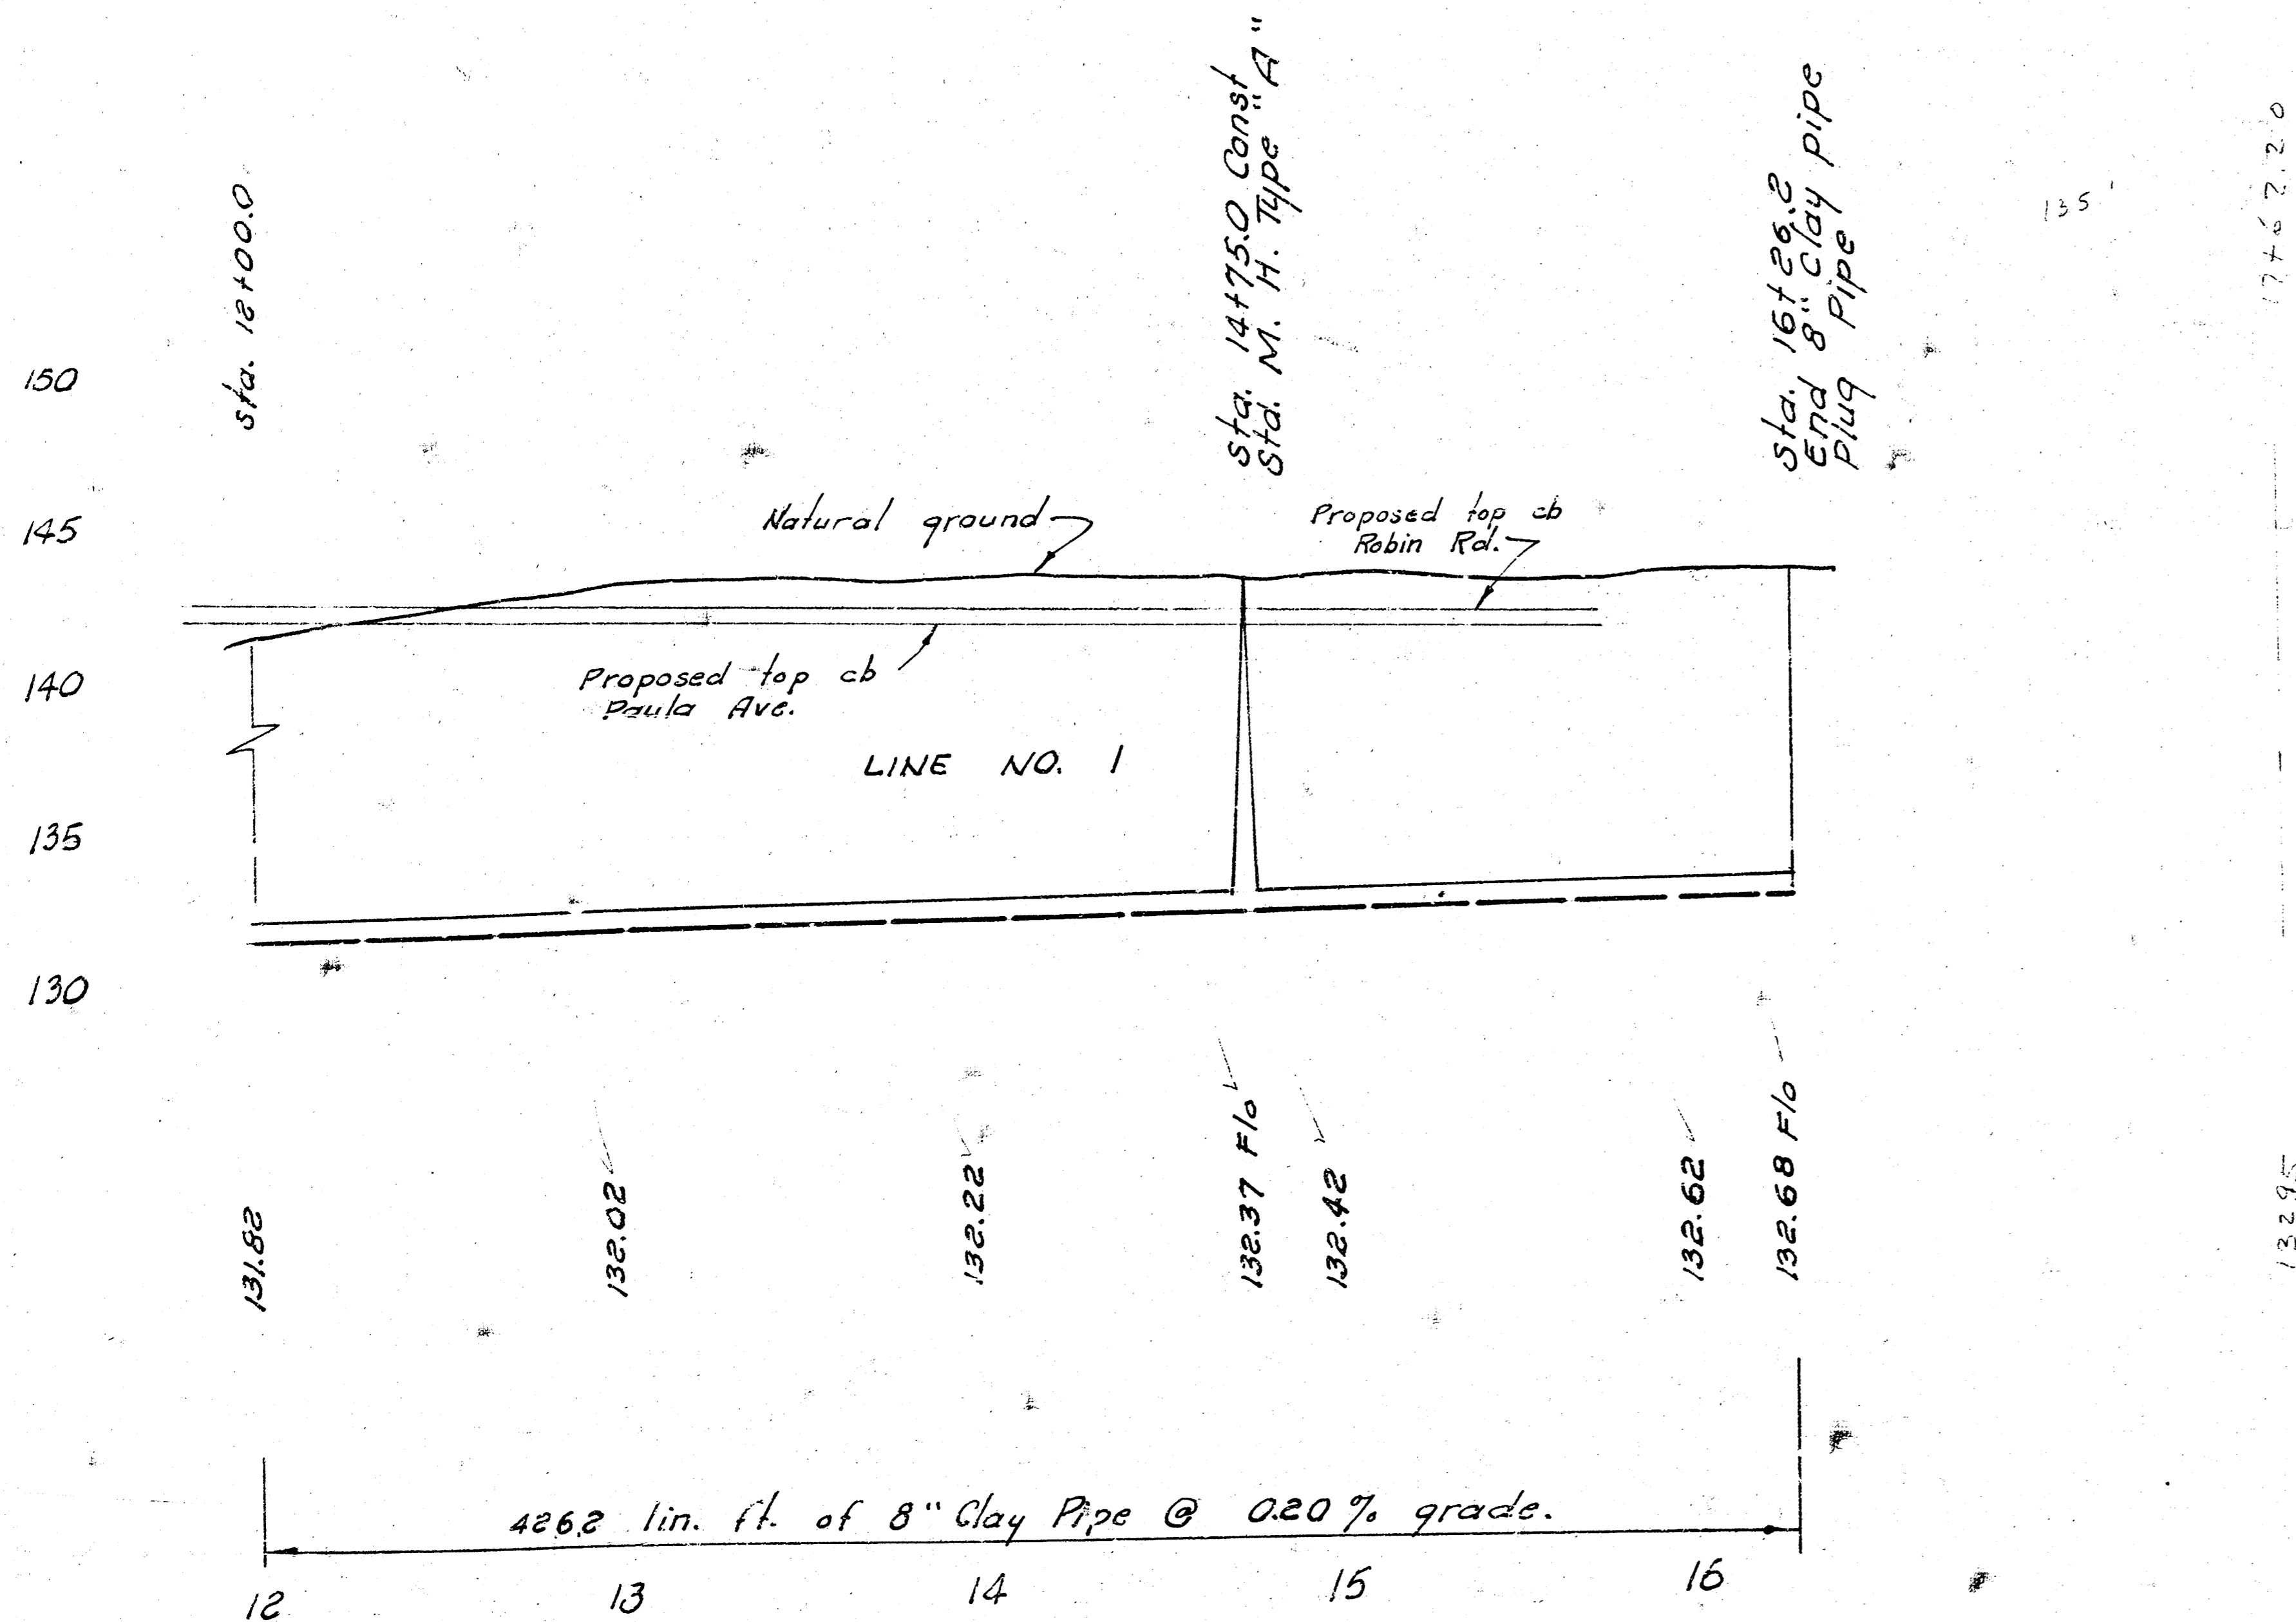

LAT. 7, S. W. MAIN
 PROJECT NO. DBK L568030 3/4

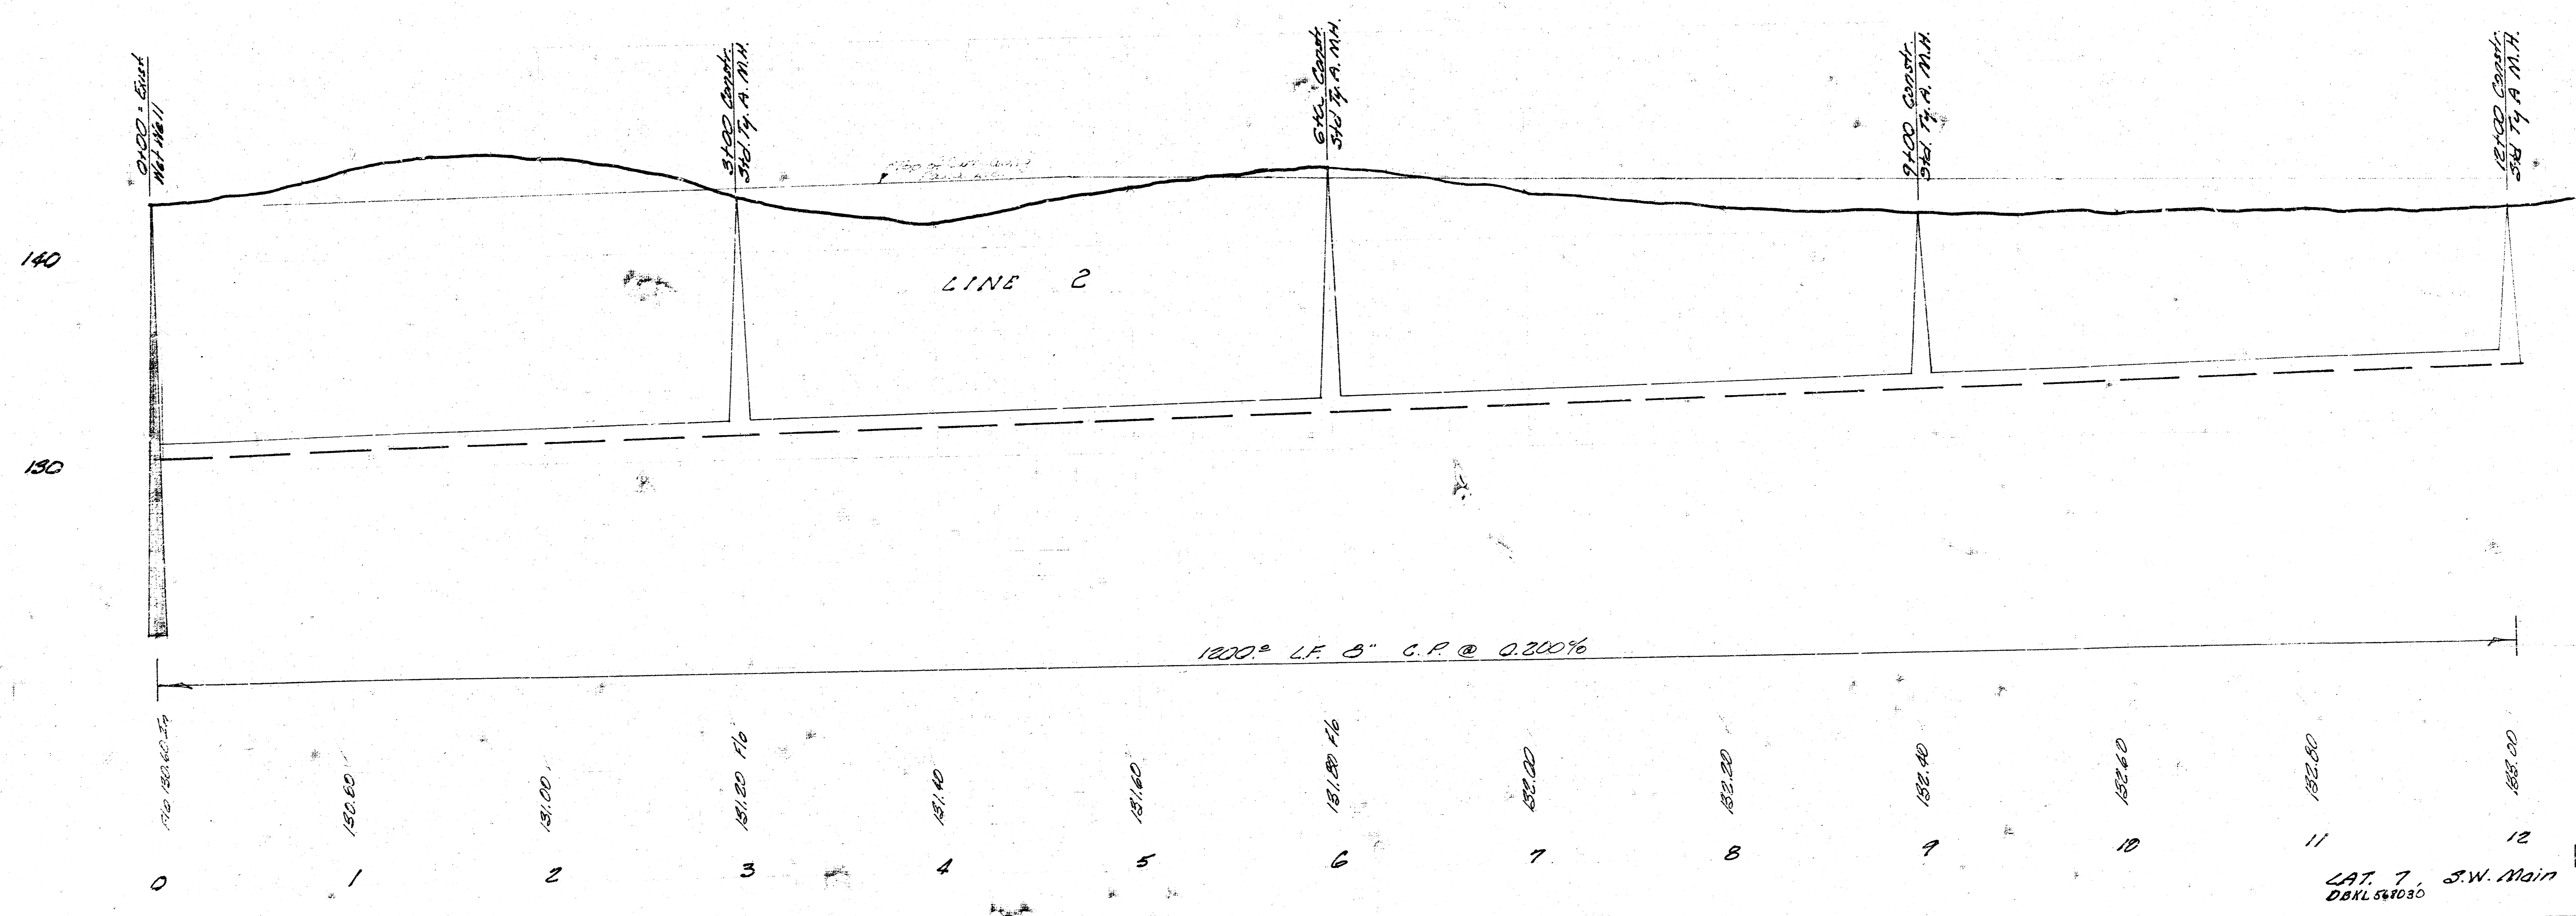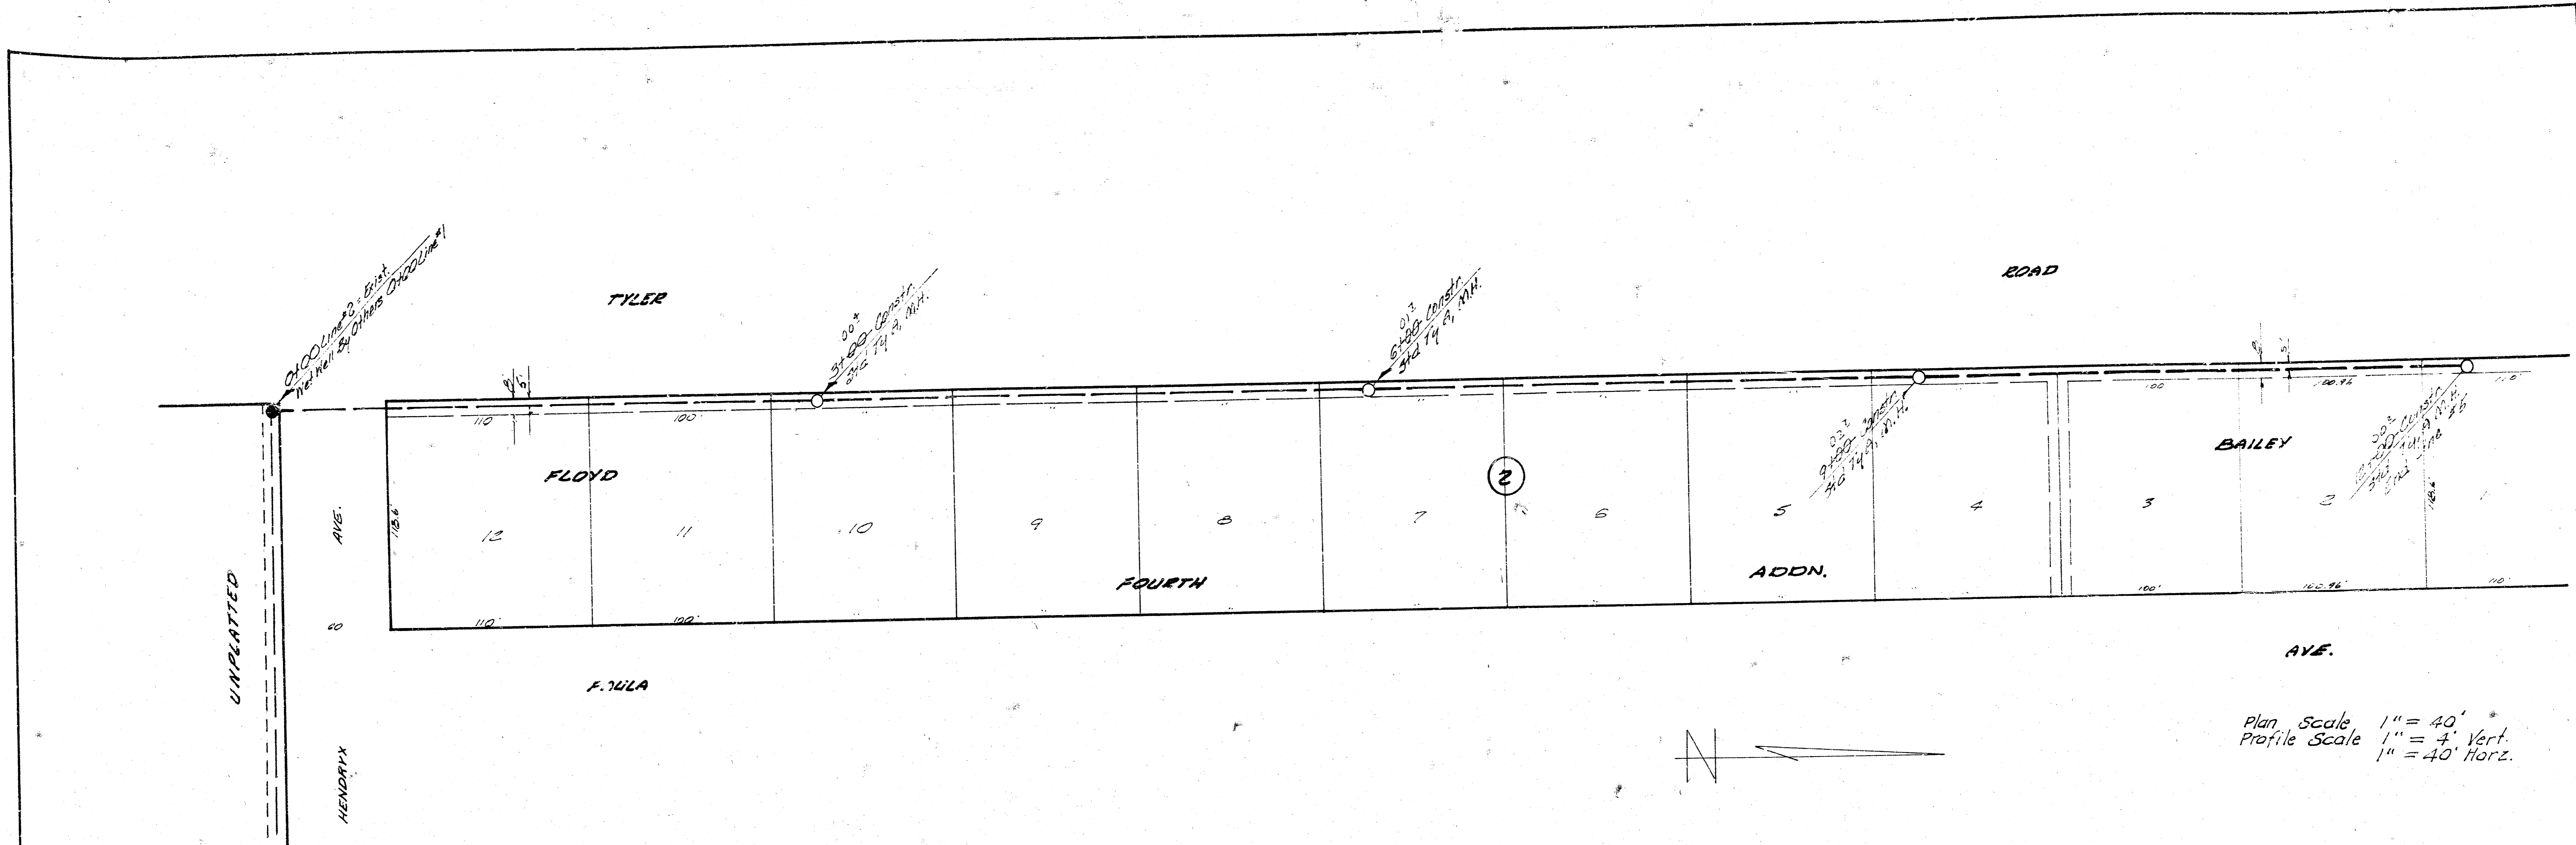

LAT. 7 S.W. Main
 DBXL 547030