
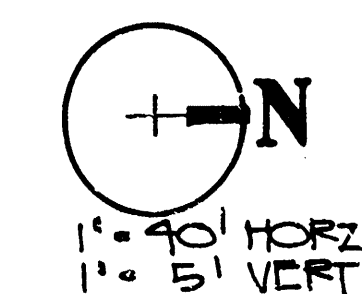




AIRPORT INDUSTRIAL PARK ADDITION (BLOCK 2)

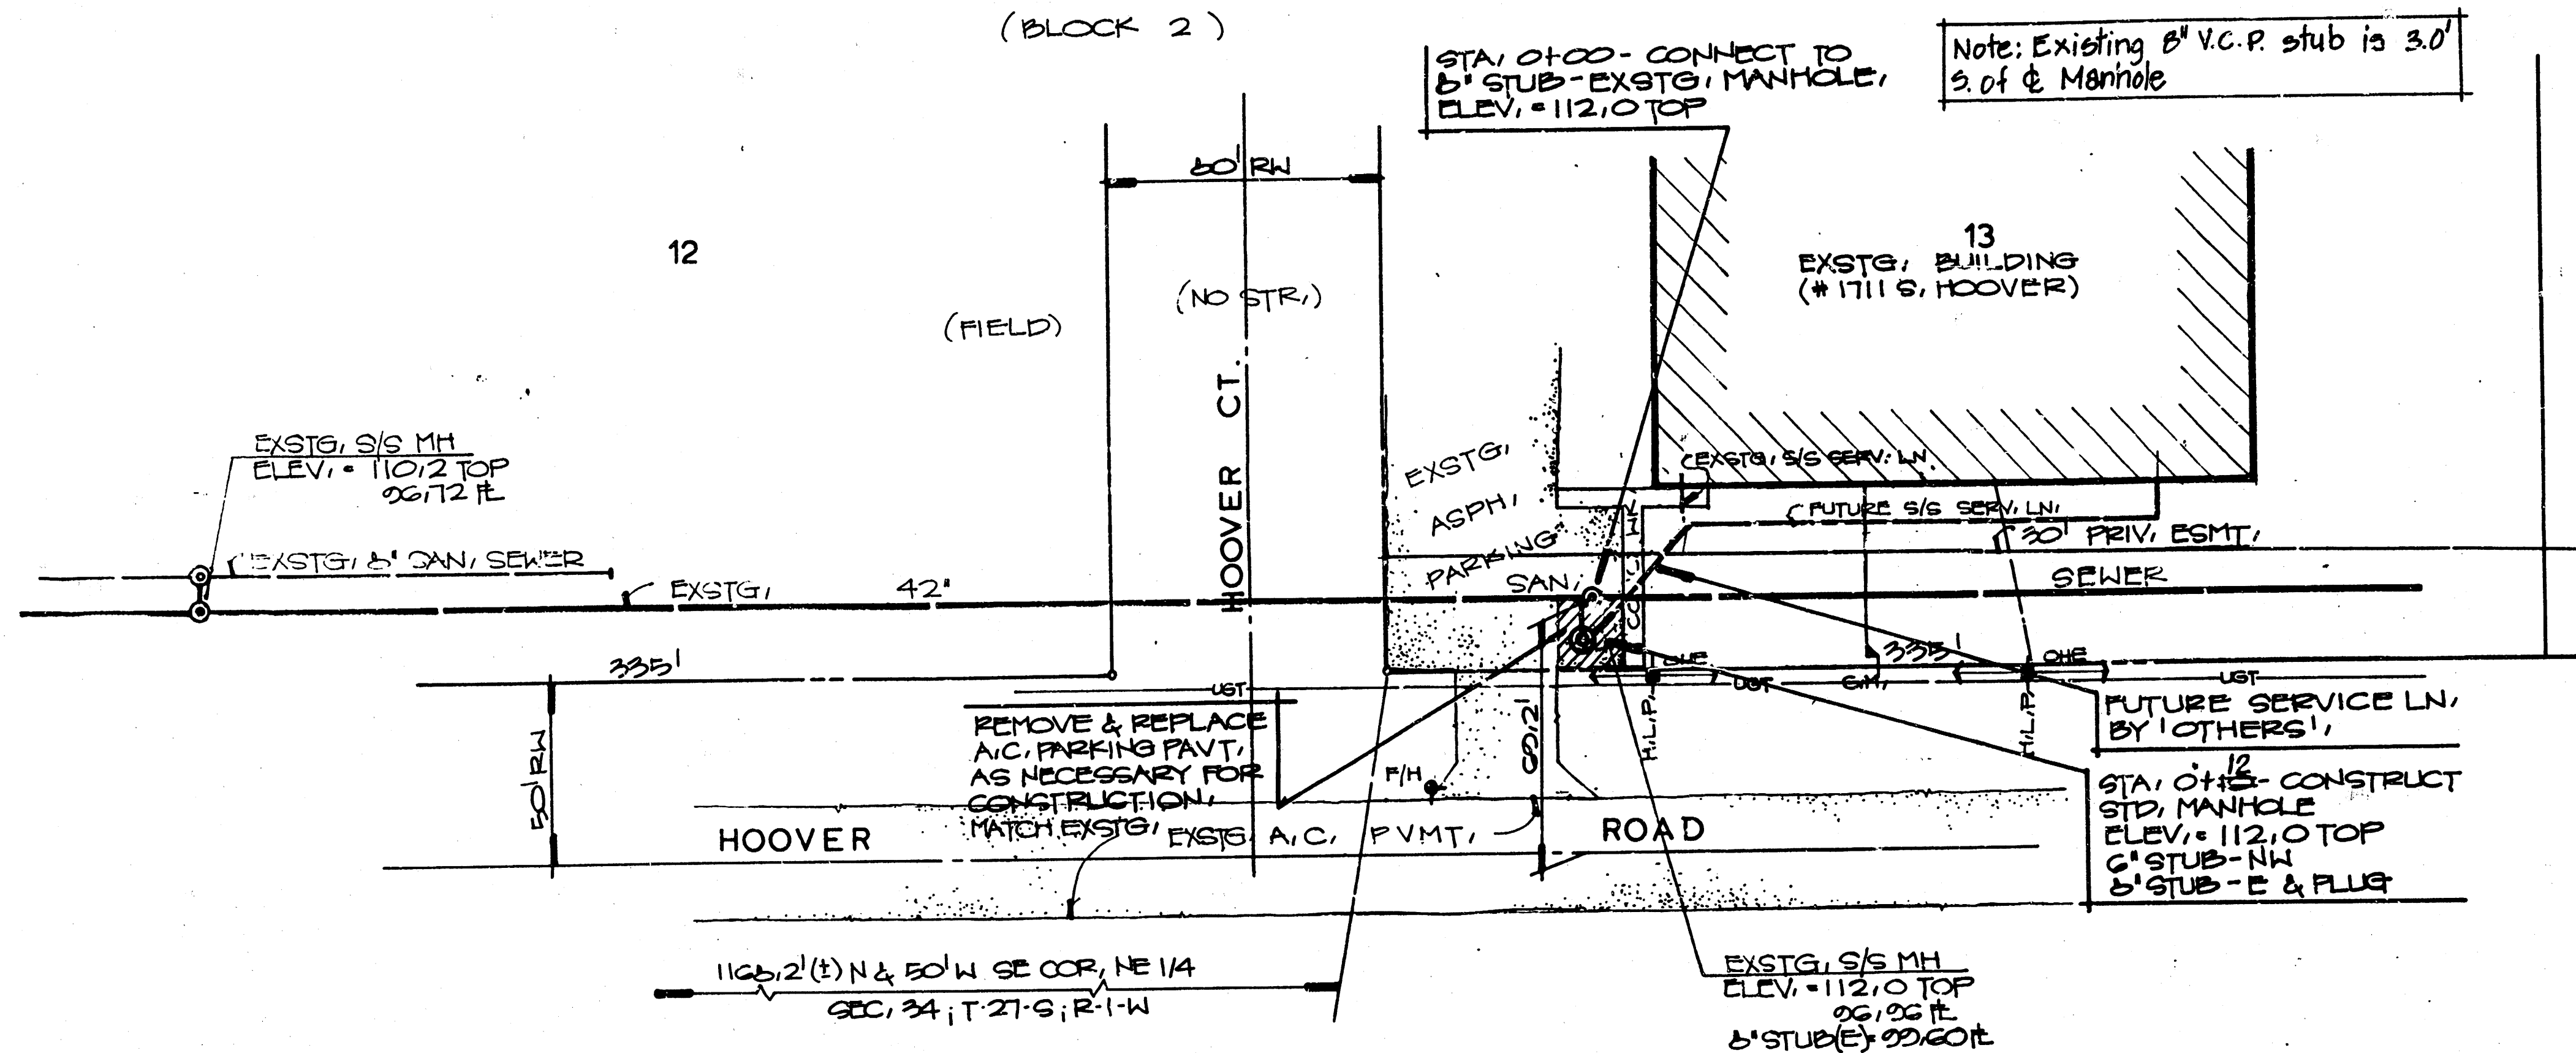

NOTE TO CONTRACTOR
INSPECTION AND TESTING FOR THIS PROJECT IS TO BE PROVIDED BY A LICENSED CONSULTING ENGINEERING FIRM UNDER CONTRACT WITH THE OWNER/DEVELOPER. SAID INSPECTION TO BE IN ACCORDANCE WITH THE CITY OF WICHITA STANDARDS CONSTRUCTION ENGINEERING PRACTICES AND CERTIFIED BY A LICENSED PROFESSIONAL ENGINEER. NO WORK SHALL BE PERFORMED IN DEDICATED EASEMENTS OR THE PUBLIC RIGHT-OF-WAY BY THE CONTRACTOR WITHOUT SUCH INSPECTION AND SHALL ANY WORK BE COMPLETED IN DEDICATED EASEMENTS OR PUBLIC RIGHT-OF-WAY WITHOUT WRITTEN AUTHORIZATION BY THE CITY ENGINEER.

APPROVED AS NOTED
By CITY ENGINEER OF WICHITA
Sanitary Sewers VRH 5/7/90
Storm Sewers _____
Driveway Approaches _____
Water Mains _____
Drains _____

- BENCHMARKS**
1. CITY DISC - 44'S. & 48'W. E. INTERSECTION HARRY ST. @ HOOVER RD. ELEV. = 111.24 C.D.
 2. CITY DISC - 46'E & 5'S SEC. 1/4 COR. (E MAY AVE @ HOOVER RD. ELEV. = 110.57 C.D.)

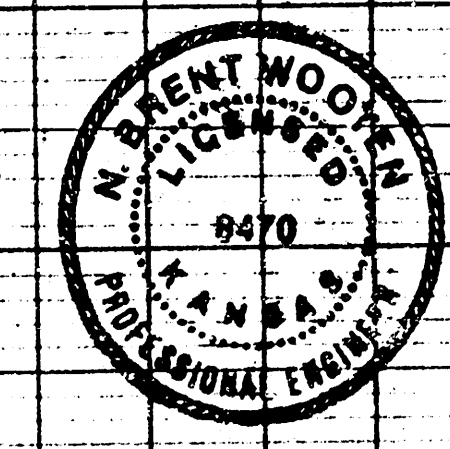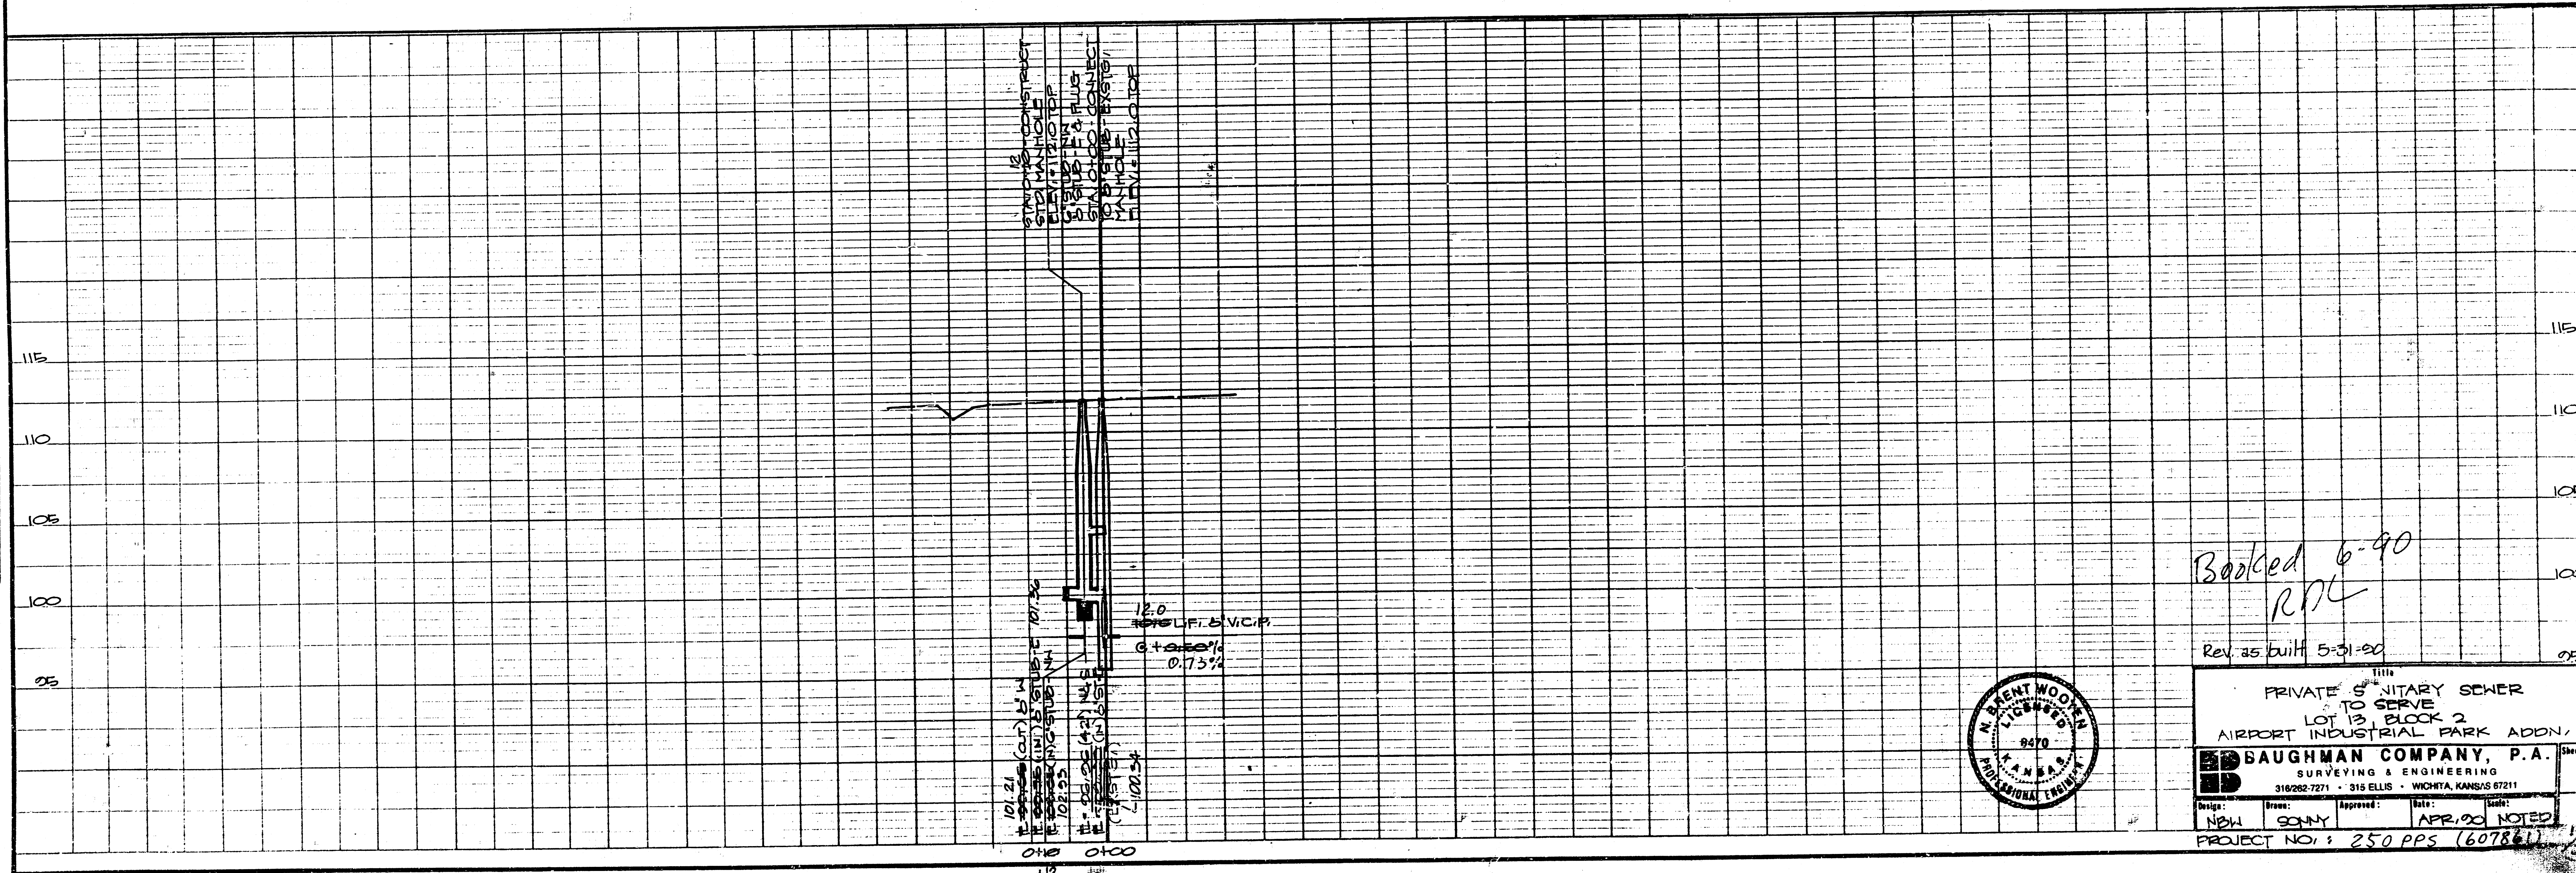


Booked 6-90
RNL
Rev. as built 5-31-90

PRIVATE SANITARY SEWER
TO SERVE 2
LOT 13 BLOCK 2
AIRPORT INDUSTRIAL PARK ADDN.

BAUGHMAN COMPANY, P.A.
SURVEYING & ENGINEERING
316/262-7271 • 315 ELLIS • WICHITA, KANSAS 67211

Design: NDW Drawn: SONNY Approved: APR 1990 Noted: NOTED
PROJECT NO.: 250 PPS (6078&1)

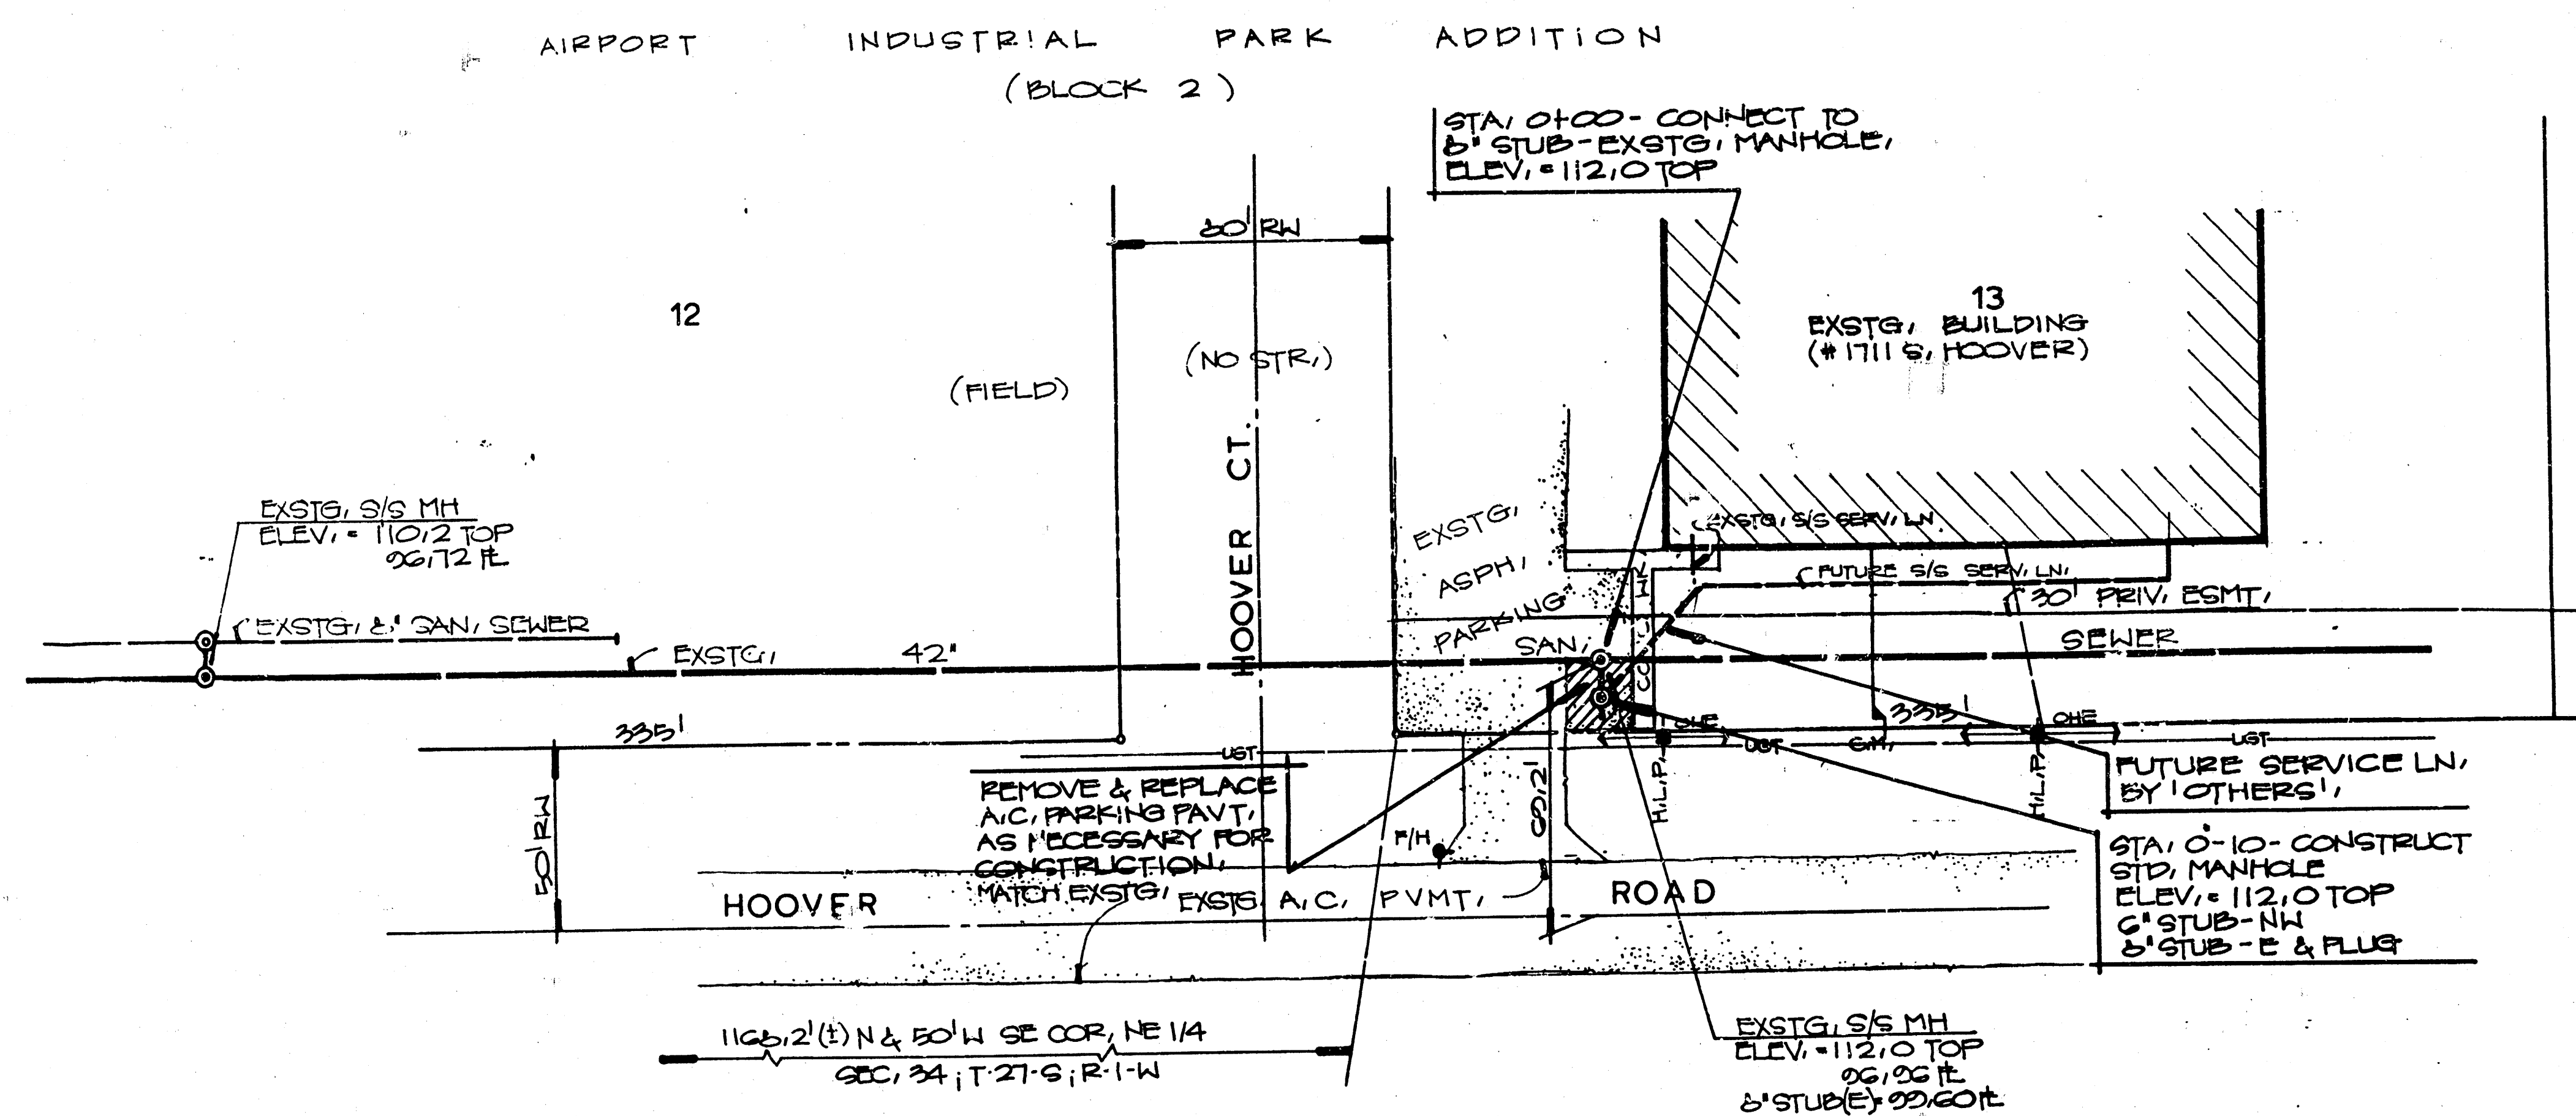

NOTE TO CONTRACTOR

INSPECTION AND TESTING FOR THIS PROJECT IS TO BE PROVIDED BY A LICENSED CONSULTING ENGINEERING FIRM UNDER CONTRACT WITH THE OWNER/DEVELOPER. SAID INSPECTION TO BE IN ACCORDANCE WITH THE CITY OF WICHITA STANDARD CONSTRUCTION ENGINEERING PRACTICES AND CERTIFIED BY A LICENSED PROFESSIONAL ENGINEER. NO WORK SHALL BE PERFORMED IN DEDICATED EASEMENTS OR THE PUBLIC RIGHT-OF-WAY BY THE CONTRACTOR WITHOUT SUCH INSPECTION. WORK SHALL ANY WORK BE COMMENCED IN DEDICATED EASEMENTS OR PUBLIC RIGHT-OF-WAY WITHOUT WRITTEN AUTHORIZATION BY THE CITY ENGINEER.

APPROVED AS NOTED

By CITY ENGINEER OF WICHITA

Sanitary Sewers VRH 5/7/90

Storm Sewers _____



Driveway Approaches _____

Water Mains _____

Beying

• BENCHMARKS •

1. CITY DISC - 44'S, & 48'W &
INTERSECTION HARRY ST. @
HOOVER RD,
ELEV. = 111.24 C.D.
2. CITY DISC - 46'E & 5'S SEC,
1/4 COR, (E MAY ME @ HOOVER RD,
ELEV. = 110.57 C.D)

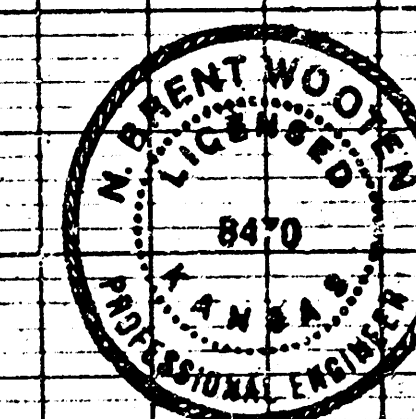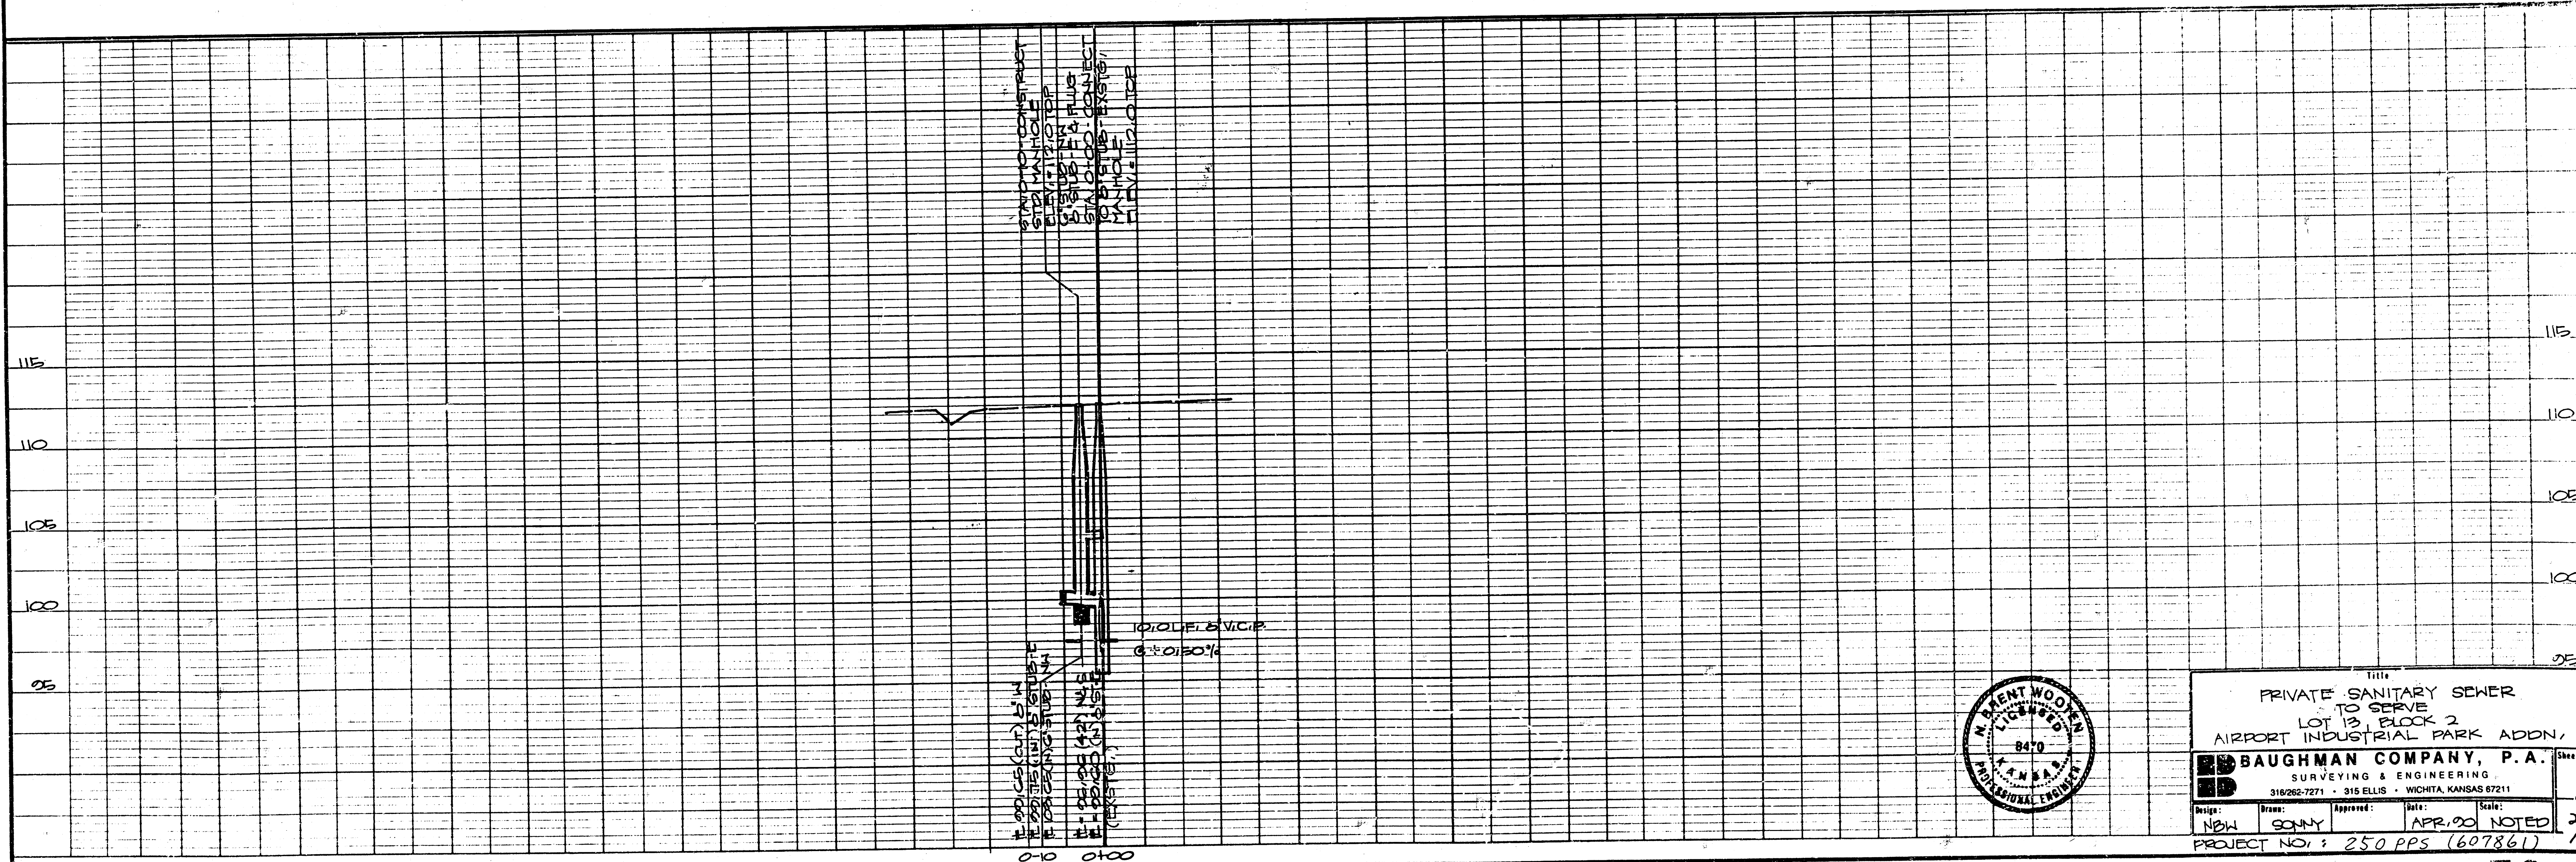

Private - SANITARY SCHER
TO SERVE
LOT 13, BLOCK 2
AIRPORT INDUSTRIAL PARK ADDN,
BAUGHMAN COMPANY, P.A.
SURVEYING & ENGINEERING
316/262-7271 - 315 ELLIS - WICHITA, KANSAS 67211

Design:	Drawn:	Approved:	Date:	Scale:
NEW	SUNNY	APR. 90	NOTED	

PROJECT NO.: 250 PPS (607861)