


PLAN
DATE: 10/1/88
BY: J. W. WOOD
CHECKED: J. W. WOOD
APPROVED: J. W. WOOD

PROFILE
DATE: 10/1/88
BY: J. W. WOOD
CHECKED: J. W. WOOD
APPROVED: J. W. WOOD

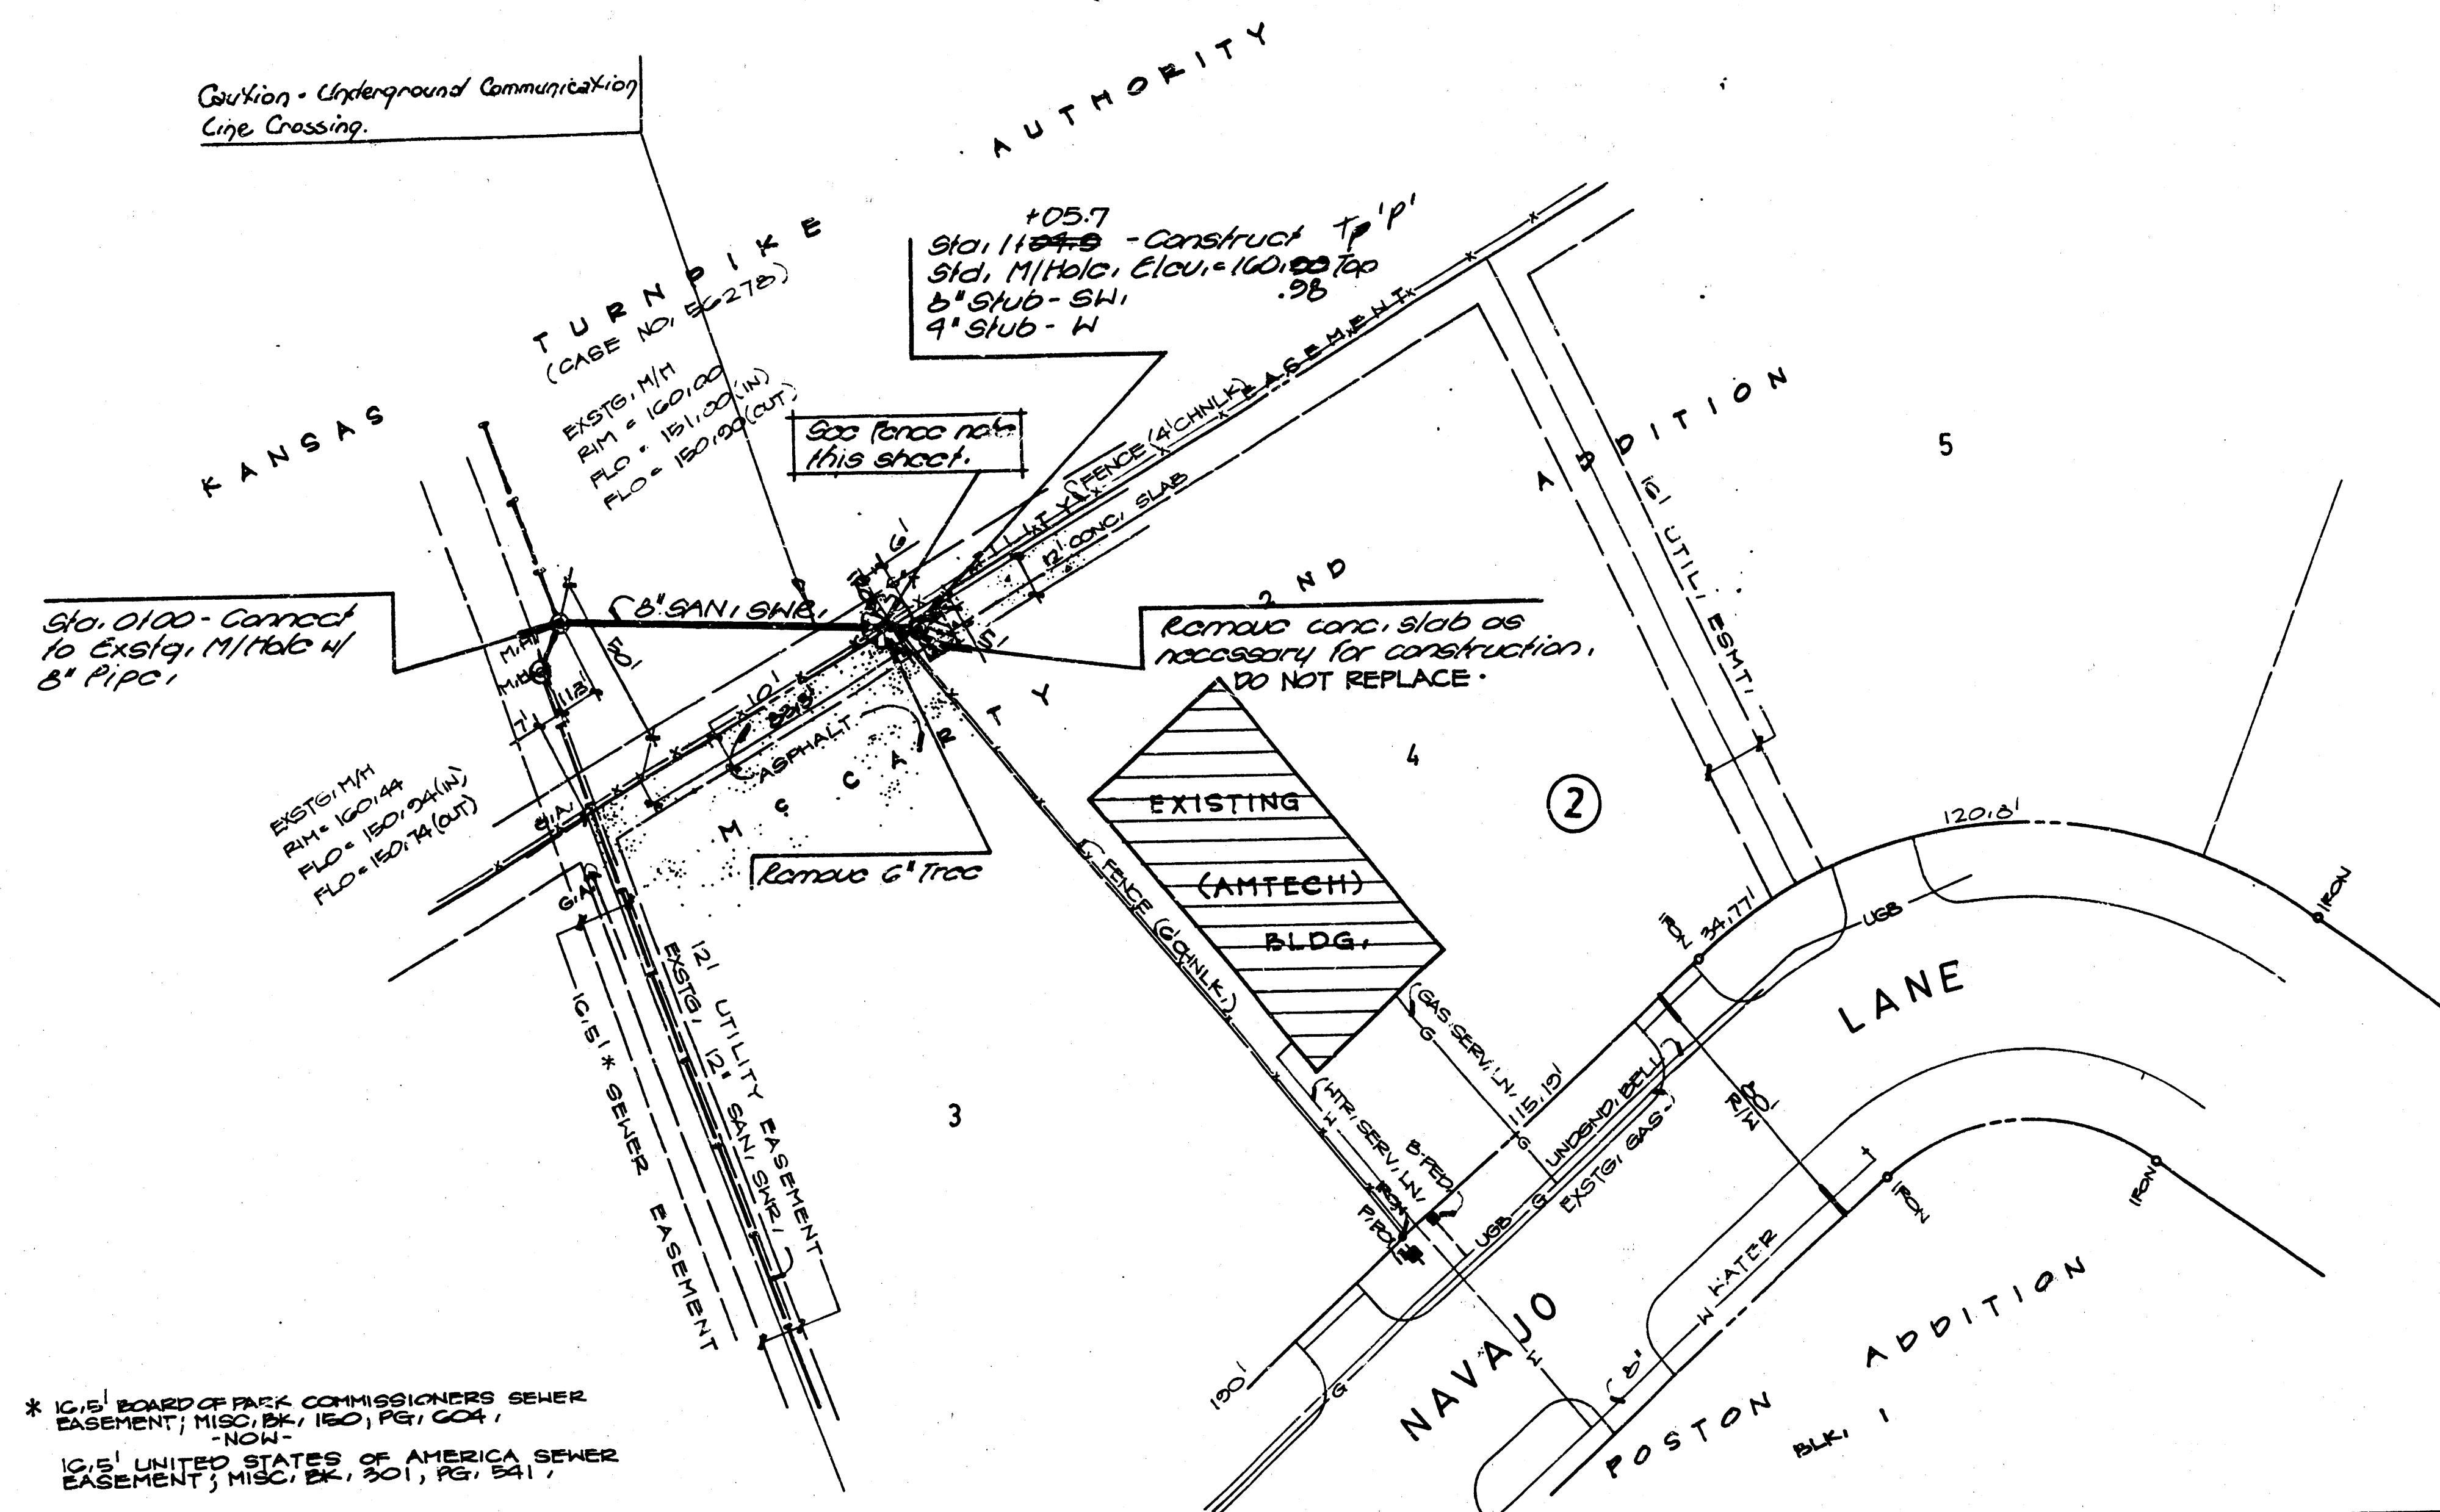

FENCE NOTE

Contractor to remove & replace K.T.A. wire fence ONLY as necessary. At no time during construction shall the K.T.A. fence be left unfenced or open for any time without temporarily closing the fence opening.

Contractor to contact K.T.A. officials and make arrangements for construction within K.T.A. property. This shall include any bonds, deposits, permits, and fees thereof which may be required by the Kansas Turnpike Authority.

NOTE TO CONTRACTOR

INSPECTION AND TESTING FOR THIS PROJECT IS TO BE PROVIDED BY A LICENSED CONSULTING ENGINEERING FIRM. THE CONTRACTOR SHALL BE RESPONSIBLE FOR OBTAINING ALL NECESSARY PERMITS AND APPROVALS FROM THE CITY OF WICHITA. THE CONTRACTOR SHALL BE RESPONSIBLE FOR OBTAINING ALL NECESSARY PERMITS AND APPROVALS FROM THE CITY OF WICHITA. THE CONTRACTOR SHALL BE RESPONSIBLE FOR OBTAINING ALL NECESSARY PERMITS AND APPROVALS FROM THE CITY OF WICHITA.

By CITY ENGINEER OF WICHITA

Sanitary Sewer: VRH 5/3/90

Storm Sewer:

Driveway, Hydrographs:

Water Mains:

BENCHMARK

10' TO EAST OF S.D. PC. 1020 AT NE COR. POSTON ADDN. ELEV. = 150.71 CITY DATUM



Revised as built 6/10/90 TR
PROJECT NO. 239 PPS



TITLE	
PRIVATE SANITARY SEWER	
AMTECH SITE	
LOT 4, BLK 2	
MCCARTY 2nd ADDITION	
BAUGHMAN COMPANY, P.A.	
SURVEYING & ENGINEERING	
316/282-7271 • 315 ELLIS • WICHITA, KANSAS 67211	
Design:	Drawn:
INBHOOTEN	SONNY
Approved:	Date:
	FEB 90
Scale:	NOTED
Sheet	1
of	1

PLAN	DATE
BY	
CHECKED	
DATE	
NO.	

PROFILE	DATE
BY	
CHECKED	
DATE	
NO.	

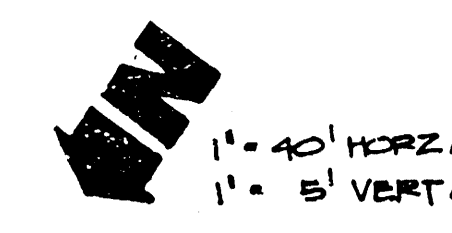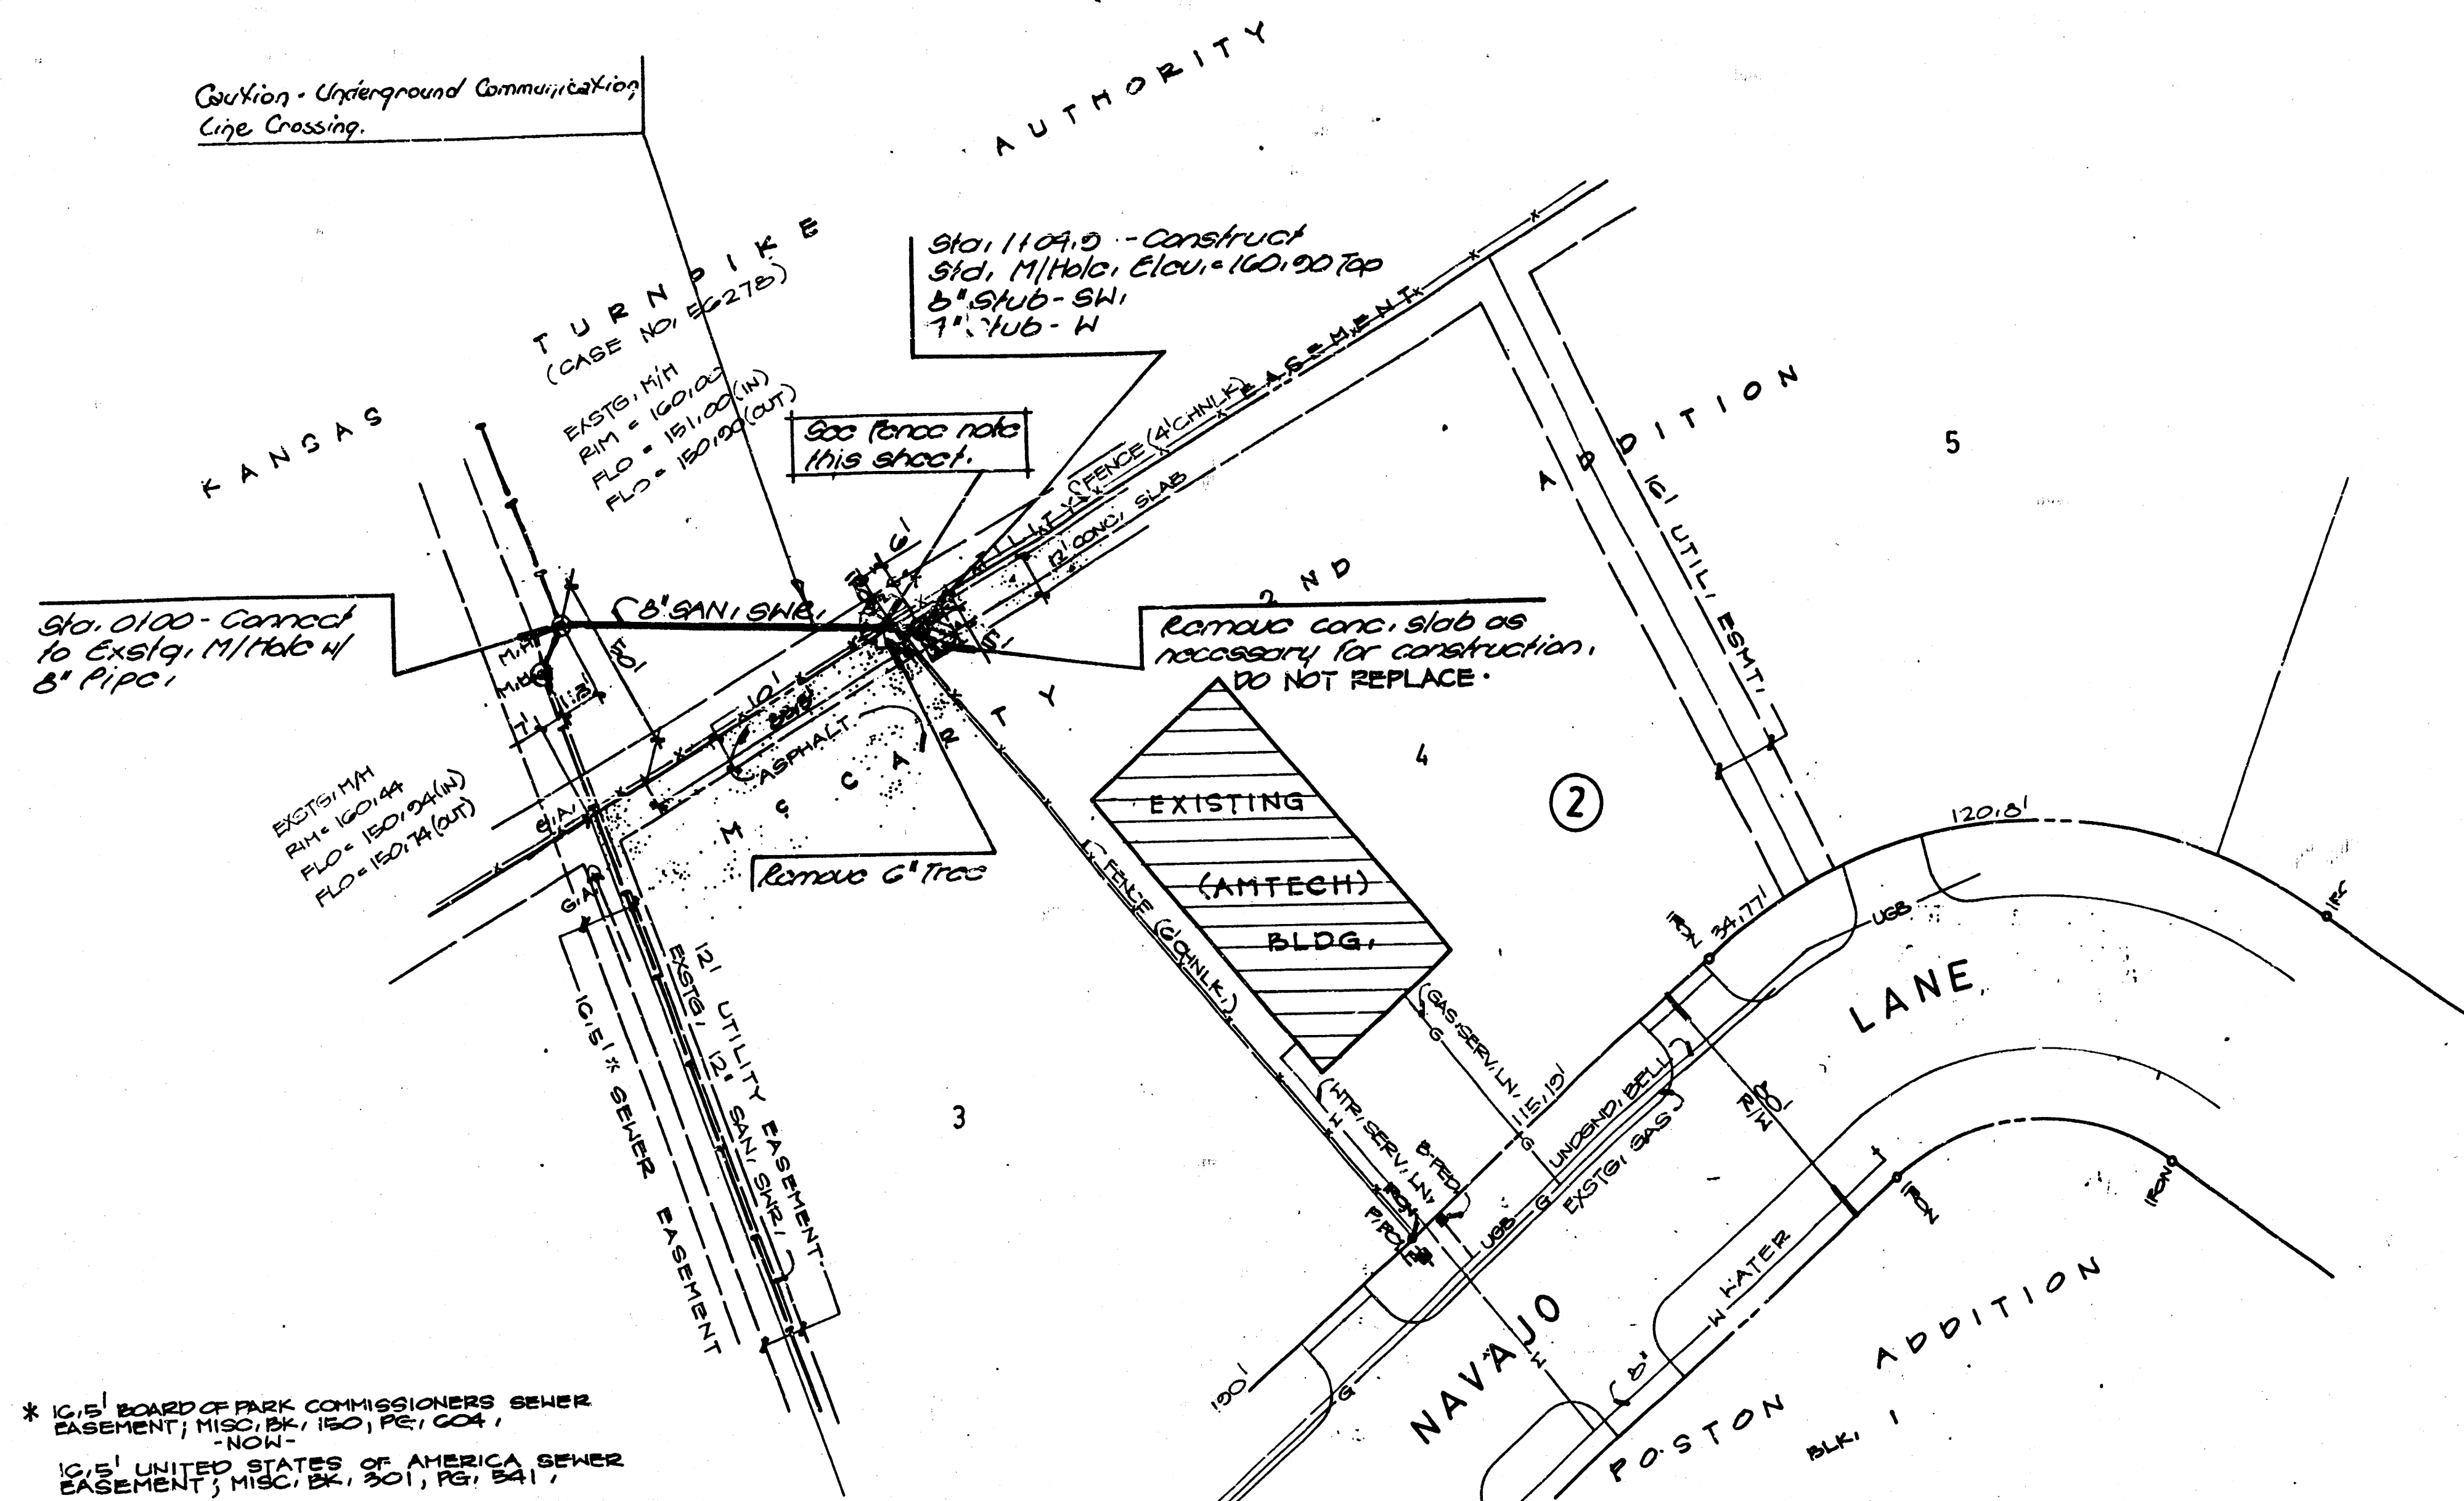

FENCE NOTE

Contractor to remove & replace K.T.A. fence ONLY as necessary. At no time during construction shall the K.T.A. fence be left unattended or open for any time without temporarily closing the fence opening.

Contractor to contact K.T.A. officials and make arrangements for construction within K.T.A. property. This shall include any bonds, deposits, permits, and fees thereof which may be required by the Kansas Turnpike Authority.

NOTE TO CONTRACTOR

INSPECTION AND TESTING FOR THIS PROJECT IS TO BE PROVIDED BY A LICENSED CONSULTING ENGINEERING FIRM UNDER CONTRACT WITH THE OWNER/DEVELOPER. SAID INSPECTION SHALL BE IN ACCORDANCE WITH THE CITY OF WICHITA'S STANDARD SPECIFICATIONS FOR CONSTRUCTION OF SEWERS AND SANITARY SEWERS. THE ENGINEER'S OFFICE SHALL BE ADVISED OF ANY DISCREPANCIES OR OMISSIONS OF THE CONTRACT DOCUMENTS OR THE FIELD CONDITIONS PRIOR TO THE START OF CONSTRUCTION. THE ENGINEER SHALL NOT BE RESPONSIBLE FOR ANY OMISSIONS OR DISCREPANCIES IN THE CONTRACT DOCUMENTS OR THE FIELD CONDITIONS.

APPROVED AS NOTED
By CITY ENGINEER OF WICHITA

Sanitary Sewers VRH 5/3/90

Storm Sewers _____


Driveway Approaches _____

Water Mains _____

Post _____

BENCHMARK

10' TO EAST OF SO. PG. 120N
AT NE COR. POSTON ADDN
ELEV. = 152.71 CITY DATUM

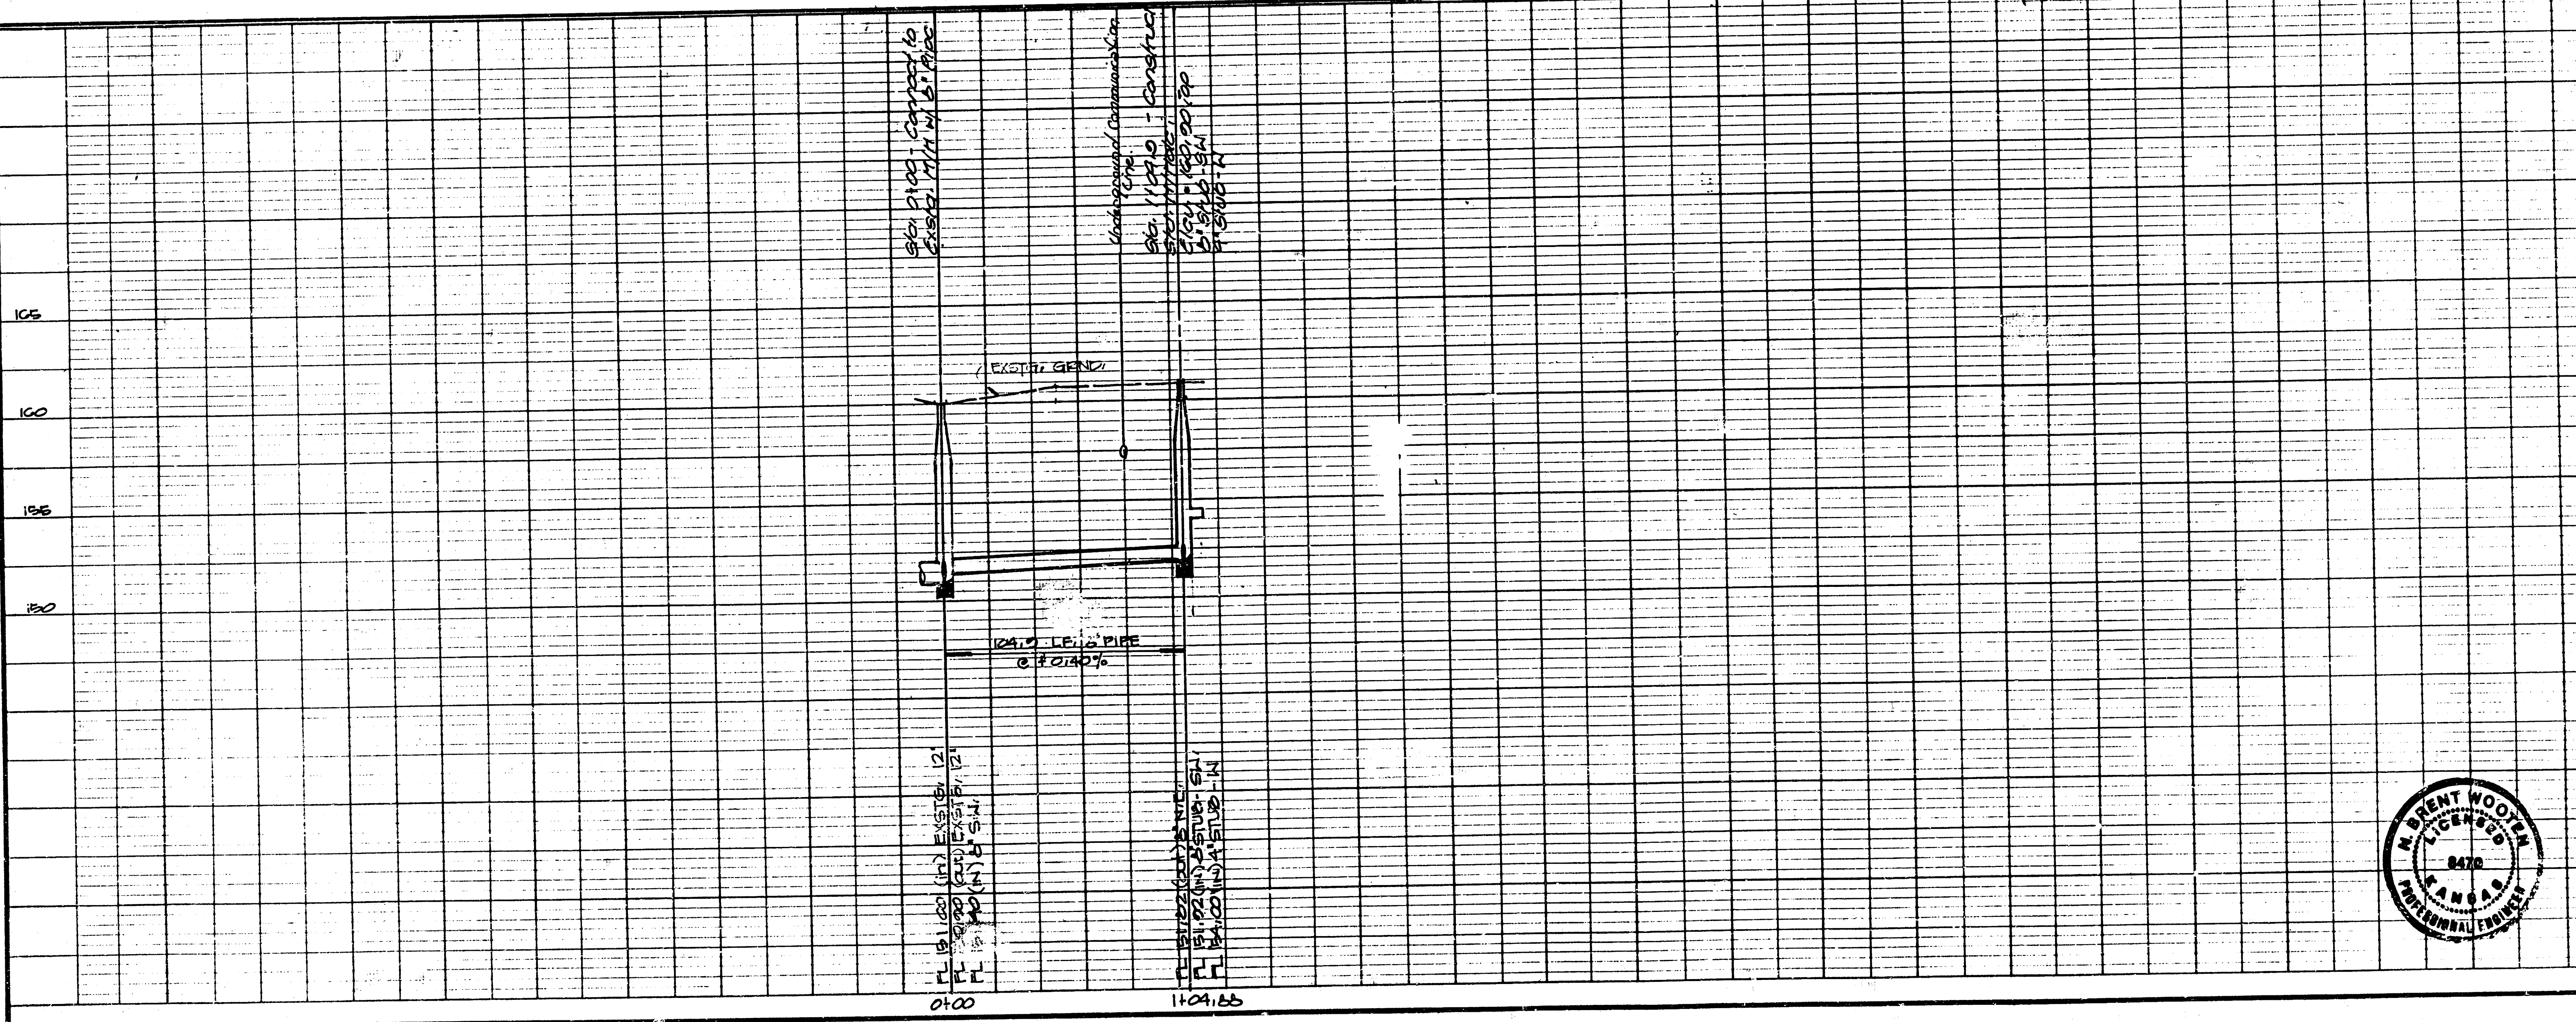

PROJECT NO. 239 PPS	
PRIVATE SANITARY SEWER	
AMTECH SITE	
LOT 4, BLK. 2	
MCCARTY 2ND ADDITION	
BAUGHMAN COMPANY, P.A.	
SURVEYING & ENGINEERING	
318/262-7271 • 315 ELLIS • WICHITA, KANSAS 67211	
Design: <u>NOH/DOH</u>	Drawn: <u>SONNY</u>
Approved: _____	Date: <u>FEB 90</u>
Scale: <u>NOTED</u>	Sheet: <u>1</u>