


Scale: 1" = 30'  
 S-26-22  
 APPROVED AS NOTED  
 By CITY ENGINEER OF WICHITA  
 Sanitary Sewers D.E.S.  
 Storm Sewers \_\_\_\_\_  
 Driveway Approaches \_\_\_\_\_

**NOTE TO CONTRACTOR:**  
 This project will be conducted under the supervision of the CITY ENGINEER and conforming to the REGULATIONS of the CITY OF WICHITA. THE CONTRACTOR will be responsible for the City of Wichita for all cost of engineering, Plans and Inspection.

B.M. "X" on E. hub guard NE Cor. Culvert 1700' N. & Central & Maize - El. 147.03

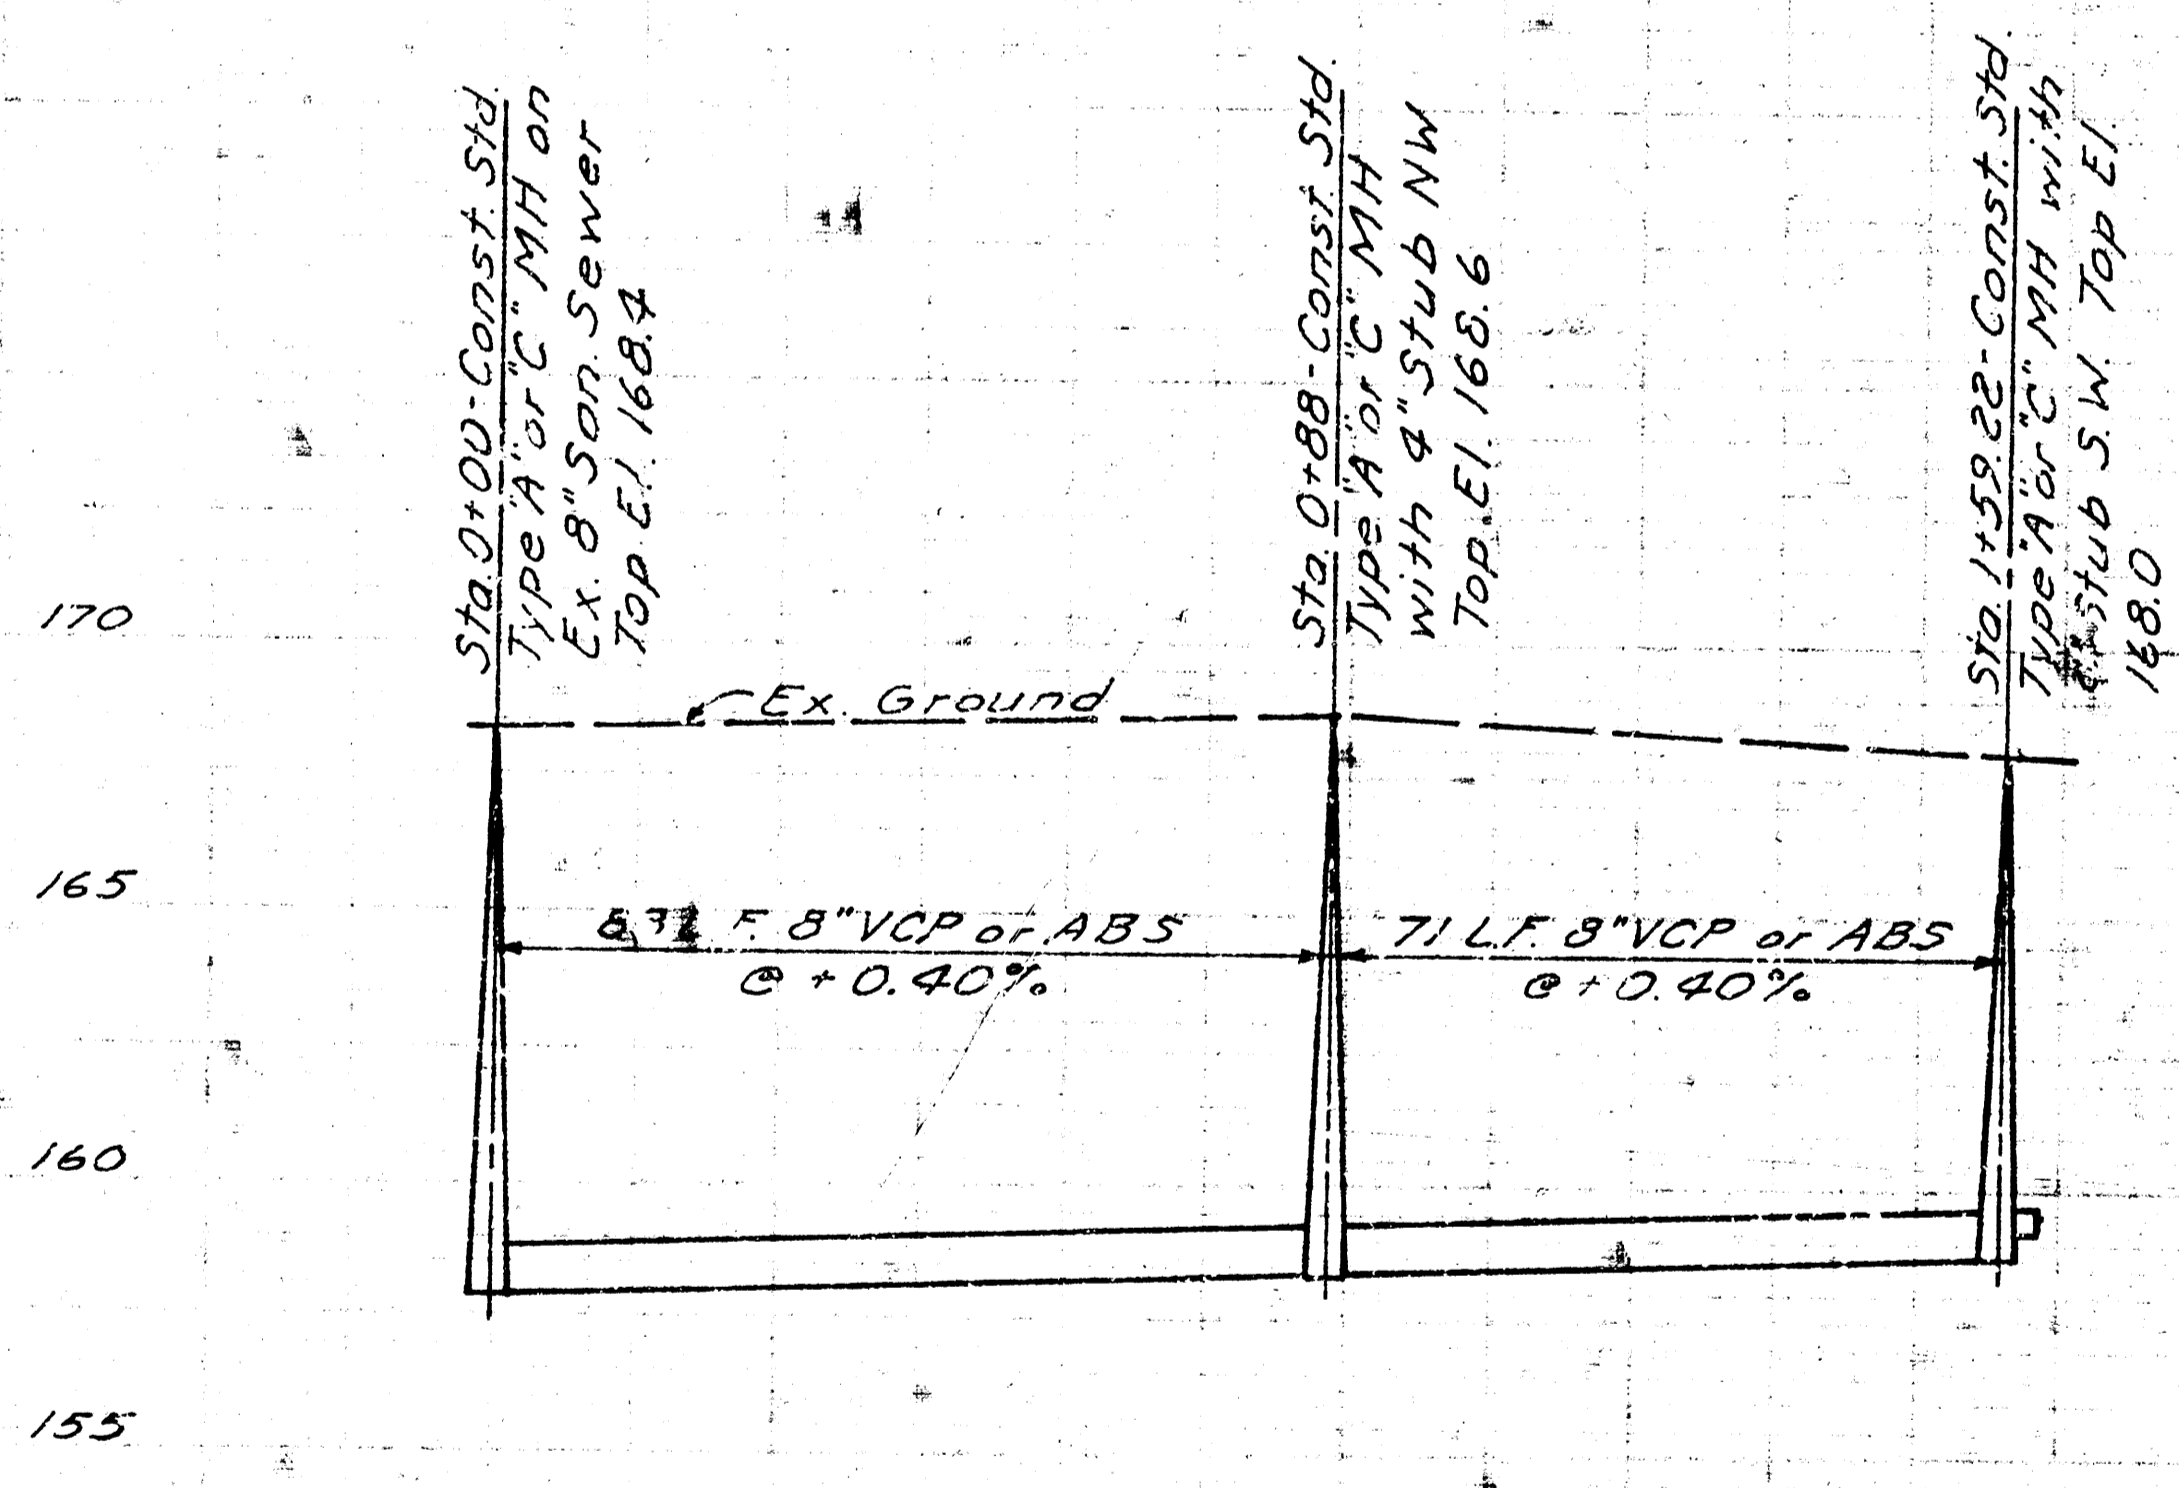

C. E. out 157.86  
 E. in (W) 157.96

+ 50' E 158.16

E. out 158.31  
 E. in (S) 158.41  
 E. in (NW) 158.64

E. out 158.69  
 E. in (SW) 159.02

CITY PROJECT NO. DBKW 707025  
 SANITARY SEWER IMPROVEMENTS  
 FOR BARTLETT ADDITION, WICHITA, KS.

14 5 1 8