



N 50 20 08 Street 31a W 50' CENTRAL

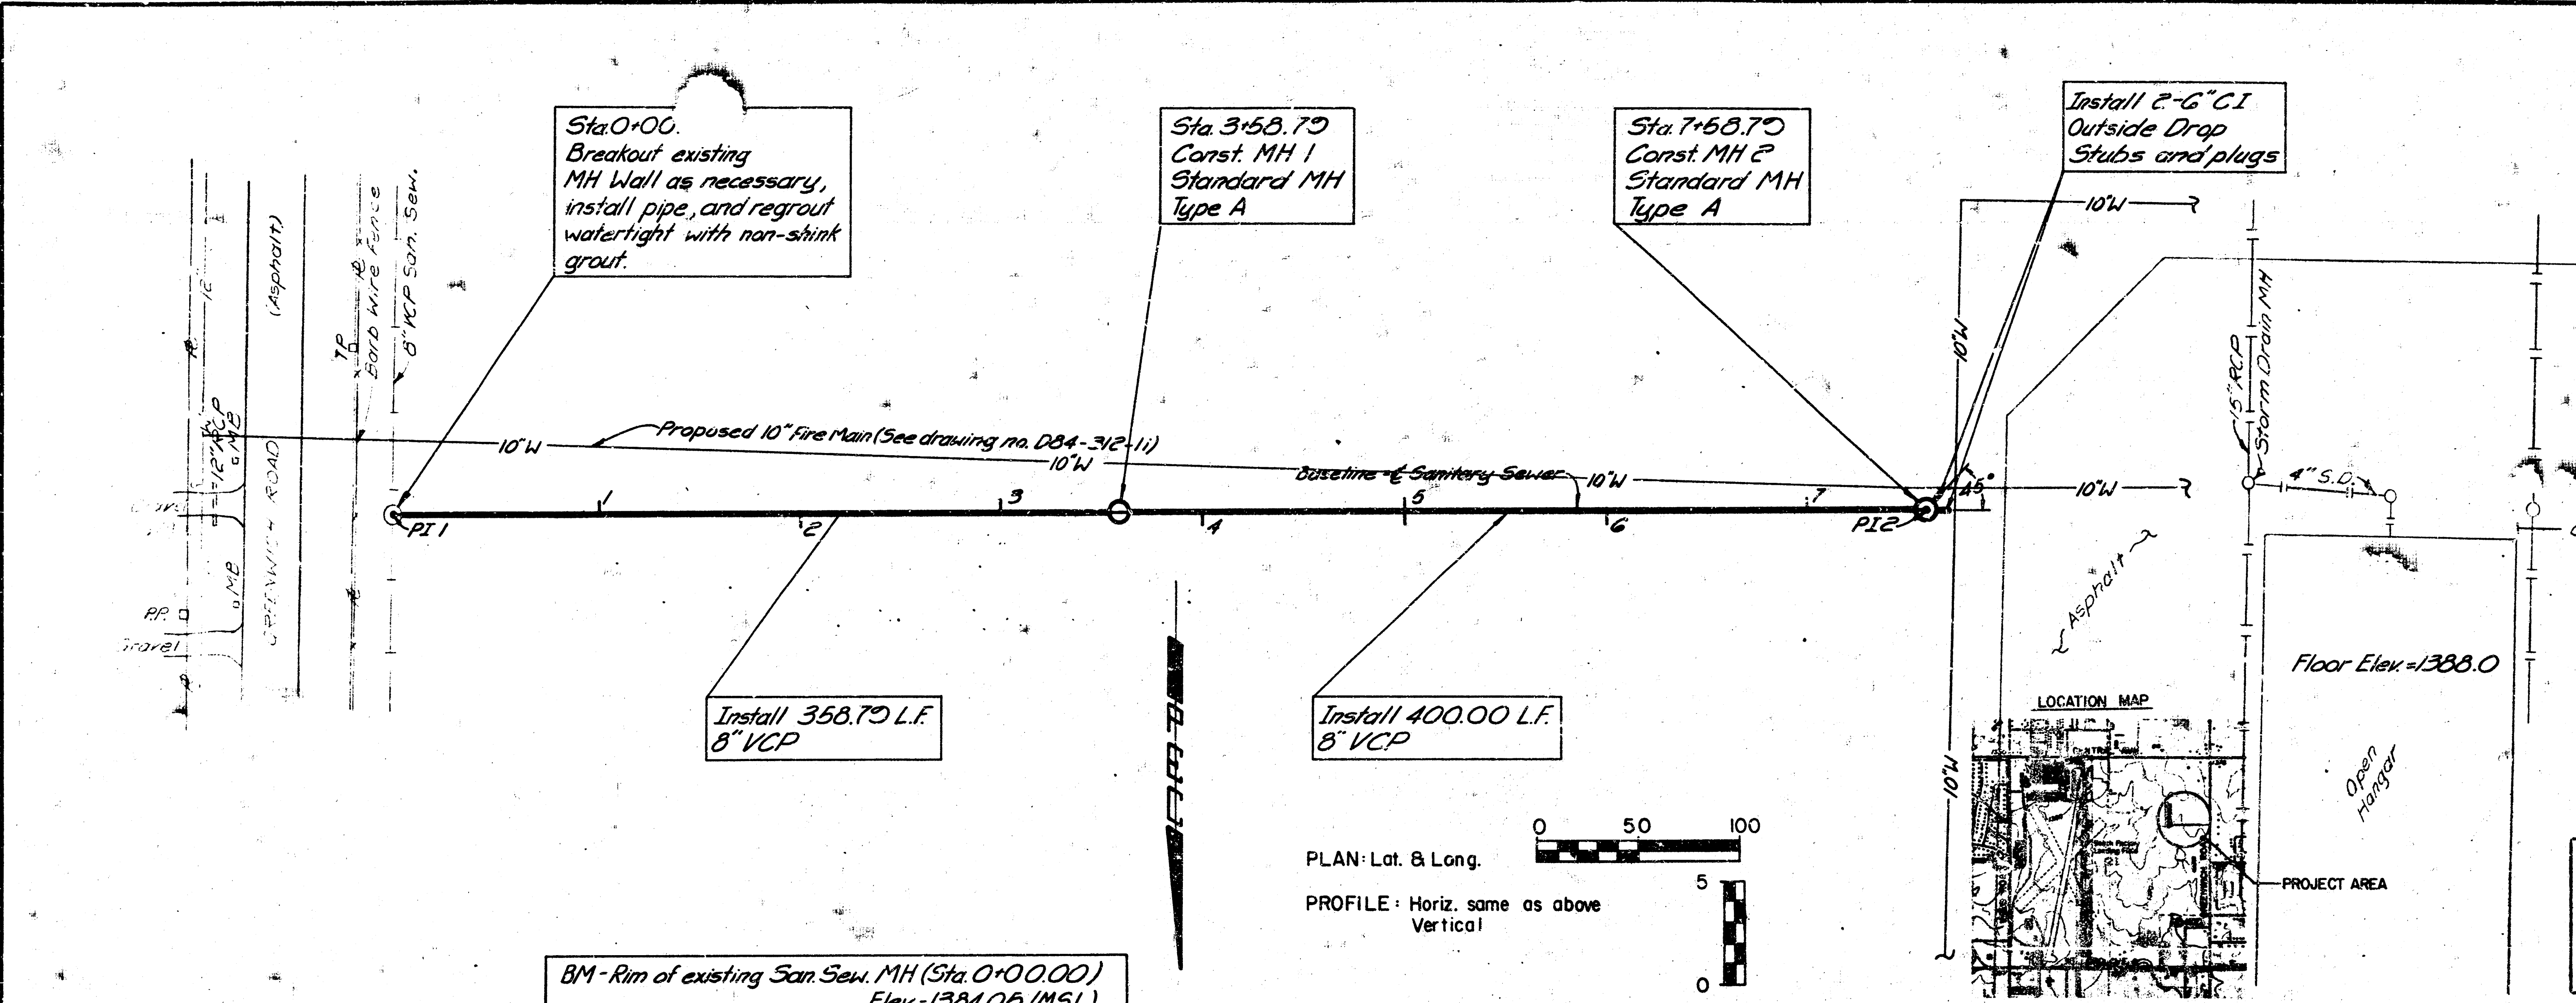

- GENERAL NOTES
1. THE CONTRACTOR SHALL CONTAIN HIS OPERATIONS TO PERMIT TRAFFIC THROUGH GREENWICH ROAD AT ALL TIMES. THE CONTRACTOR SHALL ERECT MARKING SIGNS, FLASHING LIGHTS, AND BARRICADES TO ENSURE SAFETY.
 2. THE CONTRACTOR SHALL COORDINATE CONSTRUCTION WITH BEECH AIRCRAFT CORPORATION, PLANT ENGINEERING DEPARTMENT.
 3. ALL CONSTRUCTION AND MATERIALS TO COMPLY WITH CITY OF WICHITA SPECIFICATIONS AND STANDARDS UNLESS OTHERWISE NOTED.
 4. ANY FENCE DAMAGED DURING CONSTRUCTION SHALL BE REPAIRED AND REPLACED TO EXISTING CONDITION.
 5. ALL EXCESS EXCAVATION AND DEBRIS SHALL BE REMOVED FROM THE JOB SITE BY THE CONTRACTOR AND DISPOSED OF AS DIRECTED BY THE OWNER.
 6. SAND BACKFILL SHALL COMPLY WITH CITY OF WICHITA STANDARD SPECIFICATIONS AND SHALL BE FLUSHED TO 100% OF ASTM D698.
 7. INSPECTION SHALL BE BY PROFESSIONAL ENGINEERING CONSULTANTS, P.A.
 8. ALL BACKFILL FOR MANHOLES SHALL BE EQUIVALENT TO THAT SPECIFIED FOR THE ADJACENT SEWER LINES UNLESS OTHERWISE NOTED AND SHALL BE CONSIDERED SUBSIDIARY TO THE PRICE BID FOR MANHOLES.
 9. CONCRETE SHALL HAVE A 28-DAY COMPRESSIVE STRENGTH OF 4,000 PSI, 6.5 BAGS CEMENT/CY, 5.5 GAL. WATER/BAG. CONCRETE SHALL BE AIR ENTRAINED (5 TO 6%). AGGREGATE SHALL MEET SOUNDNESS TEST WITH A TOTAL LOSS NOT GREATER THAN 10% BY WEIGHT WHEN TESTED IN ACCORDANCE WITH ASTM C88. PERCENTAGE OF WEAR BY A LA ABRASION TEST, ASTM C131 SHALL BE LESS THAN 40%. COARSE AGGREGATE TO FINE (COARSE 45-80% RETAINED ON 3/8\"/>
 10. THE CONTRACTOR SHALL ARRANGE FOR THE CITY OF WICHITA TO DO AIR TESTING AND TELEVISION INSPECTION OF THE COMPLETED SEWER LINE. TESTING AND INSPECTION SHALL BE PAID FOR BY THE CONTRACTOR IN ACCORDANCE WITH CITY OF WICHITA SPECIFICATIONS.



APPROVED AS NOTED
CITY ENGINEER OF WICHITA
Sanitary Sewers: EPB 2/27/84
Storm Sewers: _____
Disposal Approaches: _____

CITY OF WICHITA
APPROVED: _____
Approval does not relieve the contractor from any responsibility for errors or deviations from the contract requirements or for any deficiencies of equipment, work, or materials.
Date: 2/27/84
Engineering No. 408

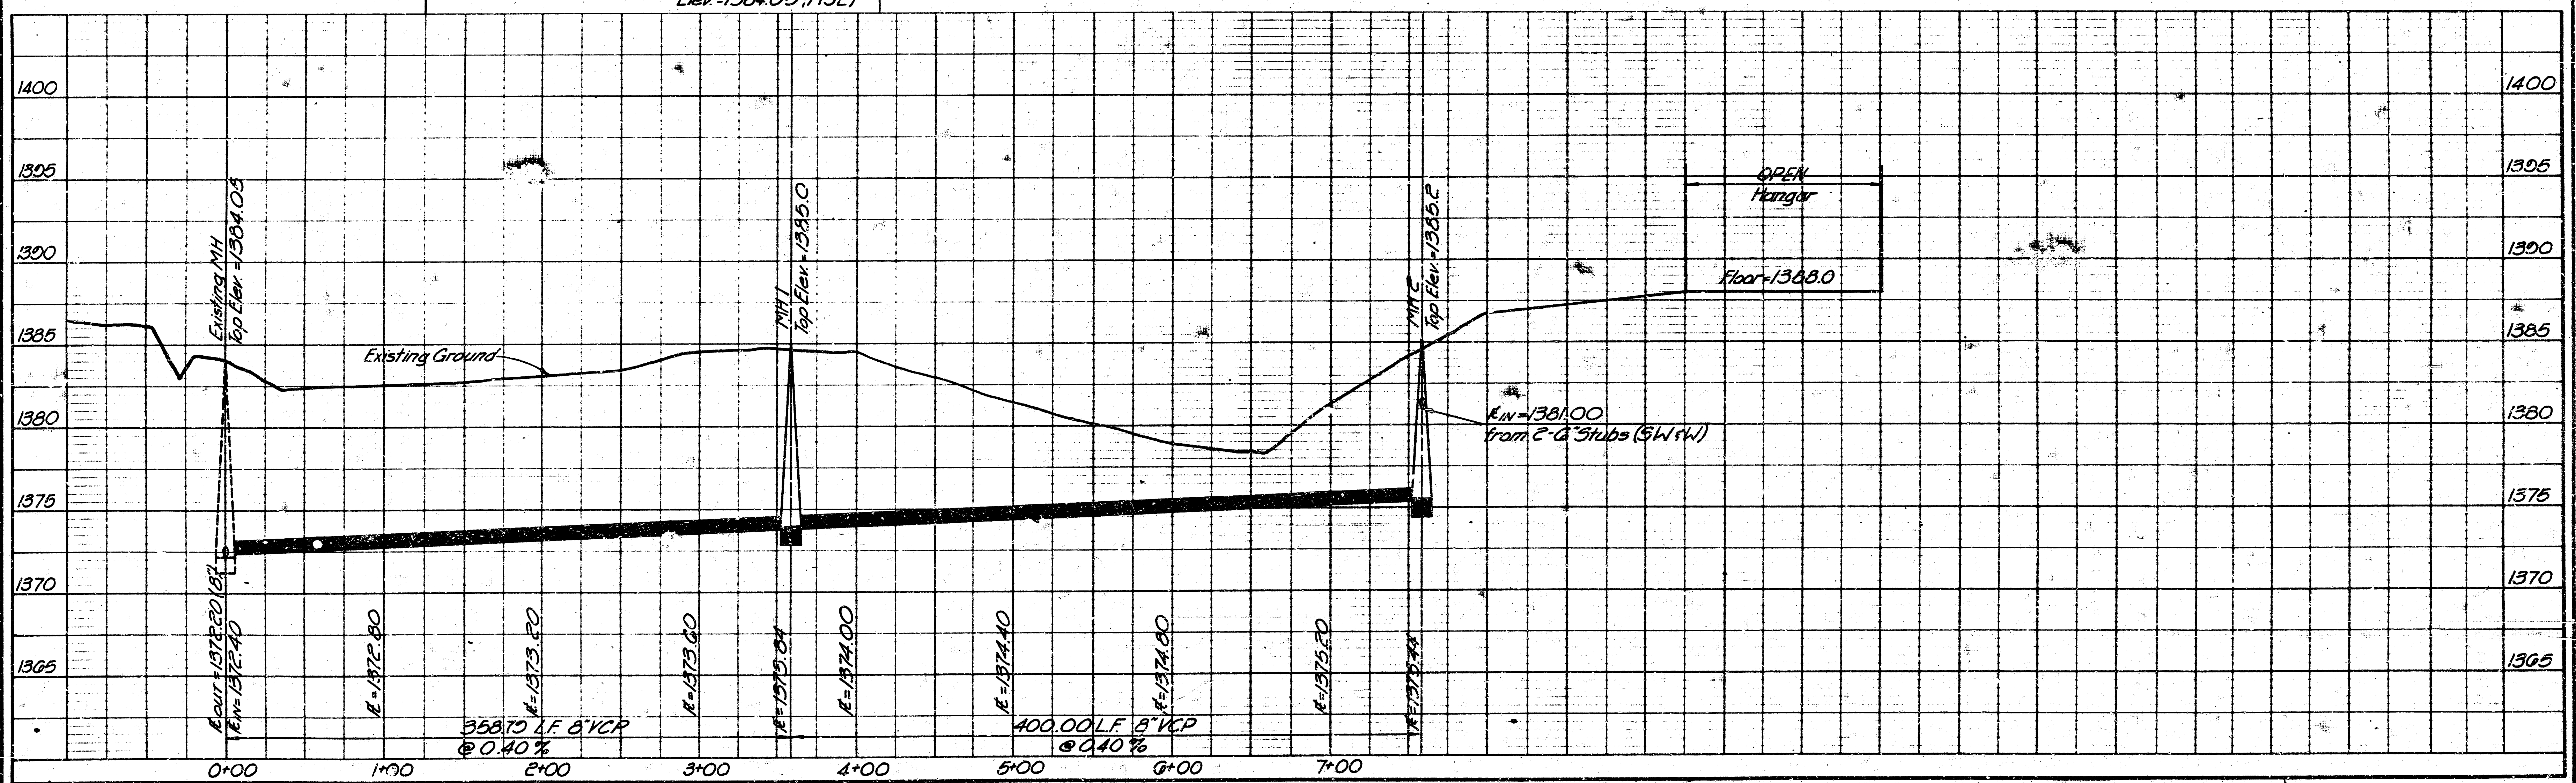

DATE	NATURE OF REVISION	BY	CHK'D	APPR.

City of Wichita Project No. 465-76-245-80000-000-000-008

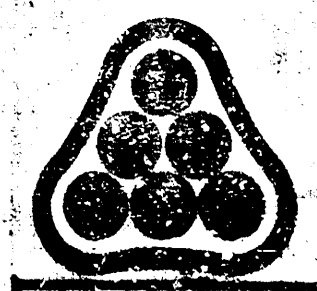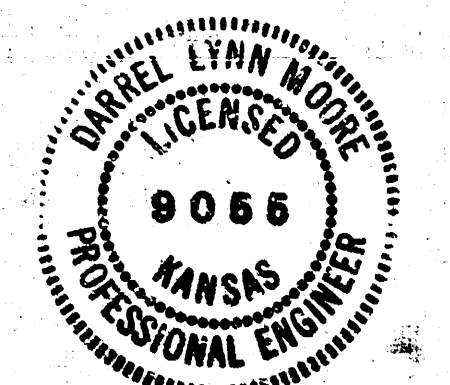

PROFESSIONAL ENGINEERING CONSULTANTS, P.A.
BIRMINGHAM
WICHITA, KANSAS

BEECH AIRCRAFT CORP.
COMPLETION CENTER

BEECH AIRCRAFT CORP.			
PLANT ENGINEERING DEPT.			
SANITARY SEWER EXTENSION			
DESIGNED BY: <u>DLM</u>	DATE: <u>Feb 1984</u>	CHECKED: _____	APPROVED: _____
DRAWN BY: <u>SM</u>	SCALE: <u>See Plan</u>	PROJECT NO. <u>No. D84-312-19</u>	

DO NOT TRIM THIS BORDER WHEN PRINTS ARE TO BE BOUND

DO NOT TRIM THIS BORDER WHEN PRINTS ARE TO BE BOUND

GENERAL NOTES


1. THE CONTRACTOR SHALL CONTAIN HIS OPERATIONS TO PERMIT TRAFFIC THROUGH GREENWICH ROAD AT ALL TIMES. THE CONTRACTOR SHALL ERECT WARNING SIGNS, FLASHING LIGHTS, AND BARRICADES TO ENSURE SAFETY.
2. THE CONTRACTOR SHALL COORDINATE CONSTRUCTION WITH BEECH AIRCRAFT CORPORATION, PLANT ENGINEERING DEPARTMENT.
3. ALL CONSTRUCTION AND MATERIALS TO COMPLY WITH CITY OF WICHITA SPECIFICATIONS AND STANDARDS UNLESS OTHERWISE NOTED.
4. ANY FENCE DAMAGED DURING CONSTRUCTION SHALL BE REPAIRED AND REPLACED TO EXISTING CONDITION.
5. ALL EXCESS EXCAVATION AND DEBRIS SHALL BE REMOVED FROM THE JOB SITE BY THE CONTRACTOR AND DISPOSED OF AS DIRECTED BY THE OWNER.
6. SAND BACKFILL SHALL COMPLY WITH CITY OF WICHITA STANDARD SPECIFICATIONS. SHALL BE FLUSHED TO 100% OF ASTM D698.
7. INSPECTION SHALL BE BY PROFESSIONAL ENGINEERING CONSULTANTS, P.A.
8. ALL BACKFILL FOR MANHOLES SHALL BE EQUIVALENT TO THAT SPECIFIED FOR THE ADJACENT SEWER LINES UNLESS OTHERWISE NOTED AND SHALL BE CONSIDERED SUBSIDIARY TO THE PRICE BID FOR MANHOLES.
9. CONCRETE SHALL HAVE A 28-DAY COMPRESSIVE STRENGTH OF 4,000 PSI, 6.5 BAGS CEMENT/CY, 5.5 GAL. WATER/BA. CONCRETE SHALL BE AIR ENTRAINED (5 TO 8%). AGGREGATE SHALL MEET SOUNDNESS TEST WITH A TOTAL LOSS NOT GREATER THAN 18% BY WEIGHT WHEN TESTED IN ACCORDANCE WITH ASTM C66. PERCENTAGE OF WEAR BY A LA ABRASION TEST, ASTM C131 SHALL BE LESS THAN 40%. COARSE AGGREGATE TO FINE (COARSE 45-80% RETAINED ON 3/8; FINE 40-75% RETAINED ON NO. 30 SIEVE) SHALL BE SUCH THAT NOT MORE THAN 70% OR LESS THAN 40% WILL PASS THE #4 SIEVE, SLUMP 1 TO 3 INCHES.
10. THE CONTRACTOR SHALL ARRANGE FOR THE CITY OF WICHITA TO DO AIR TESTING AND TELEVISION INSPECTION OF THE COMPLETED SEWER LINE. TESTING AND INSPECTION SHALL BE PAID FOR BY THE CONTRACTOR IN ACCORDANCE WITH CITY OF WICHITA SPECIFICATIONS.

CITY OF WICHITA

APPROVED: _____
DATE: 2/27/85
BY: _____



2/27/85

2/27/85

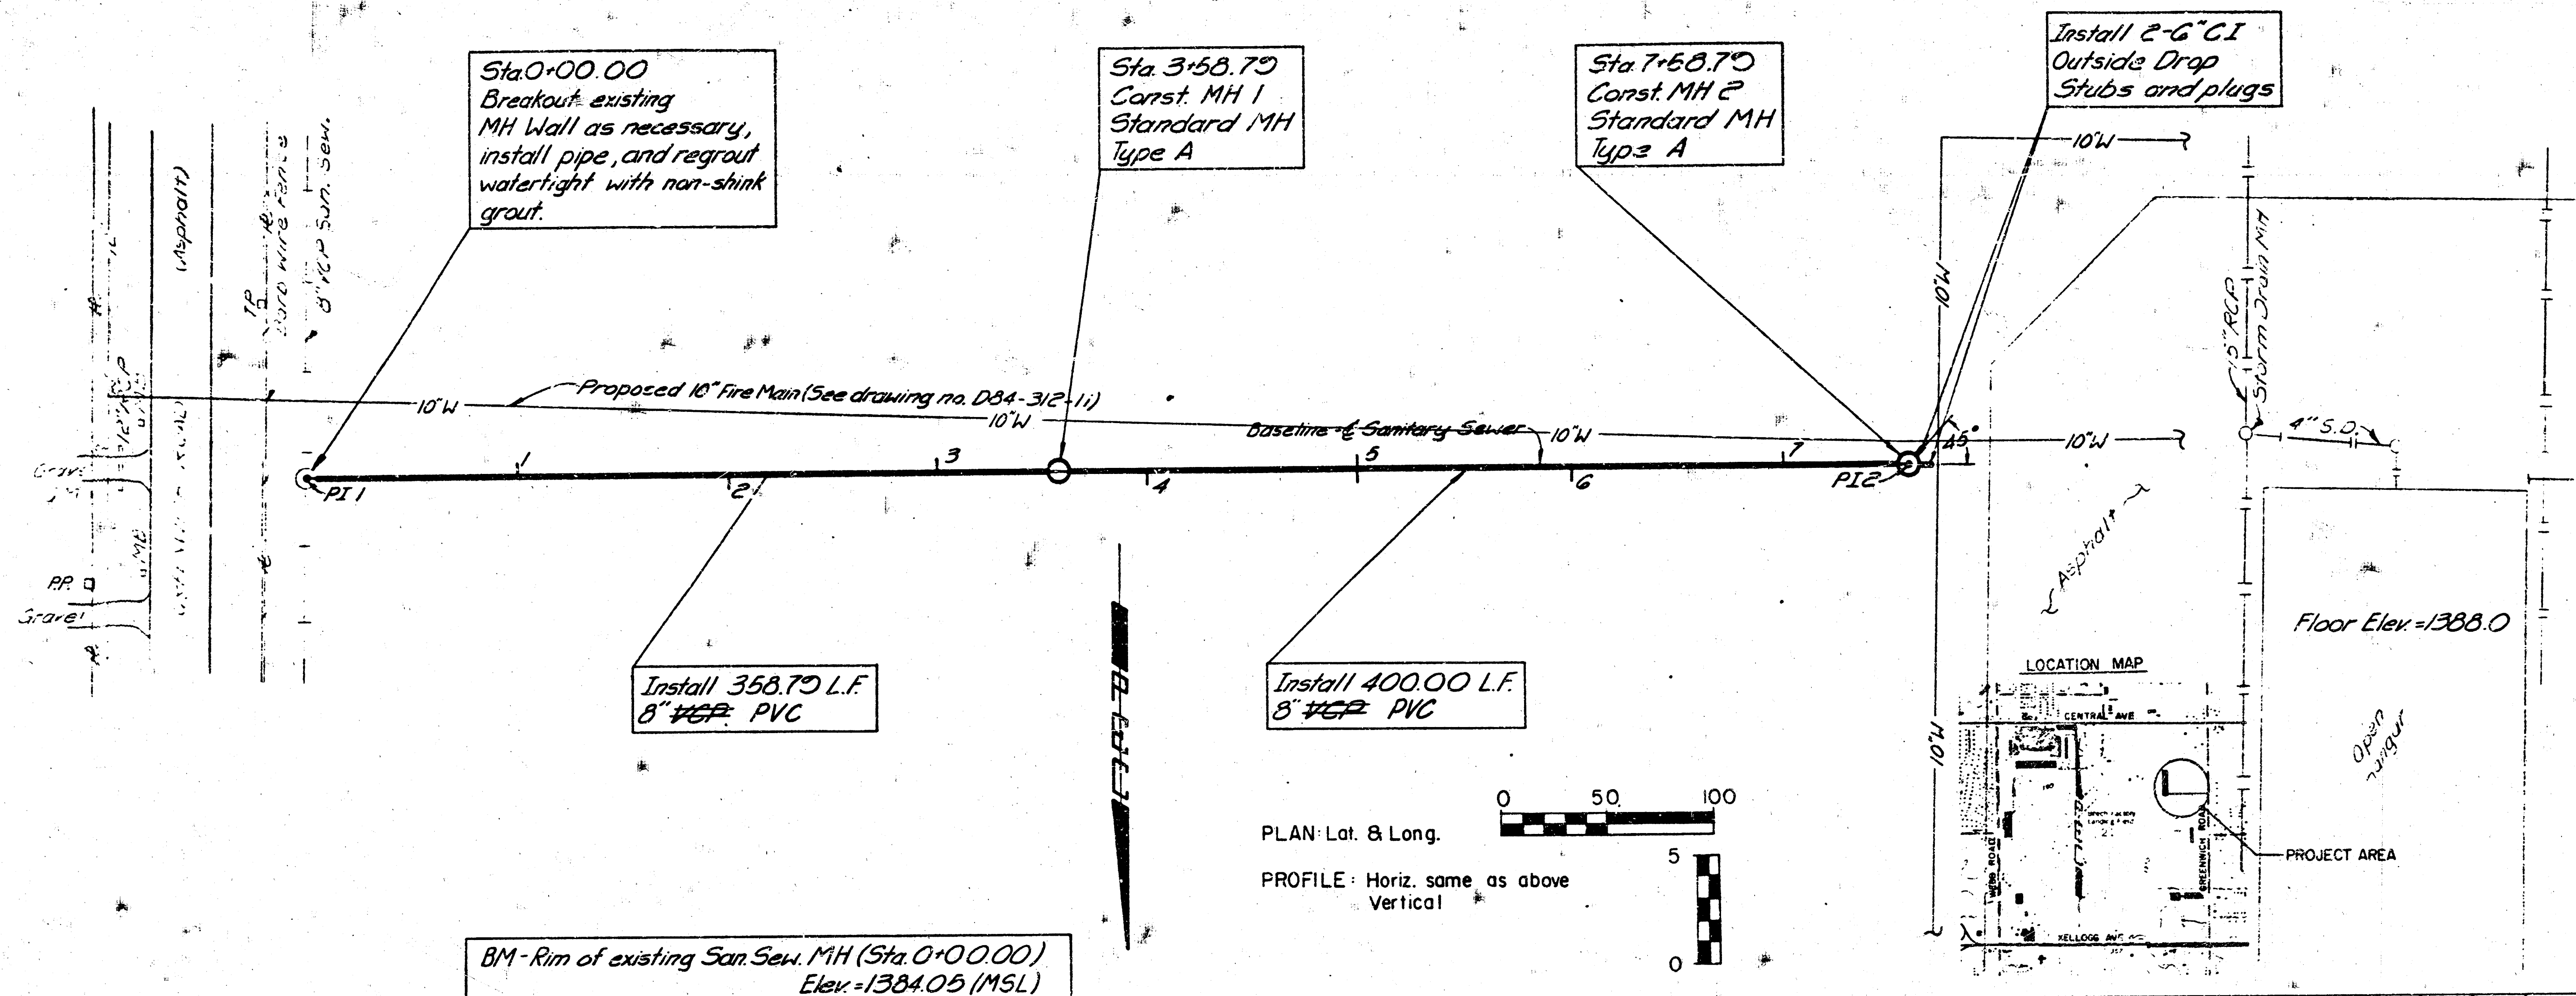

PLAN: Lat. & Long.


PROFILE: Horiz. same as above
Vertical

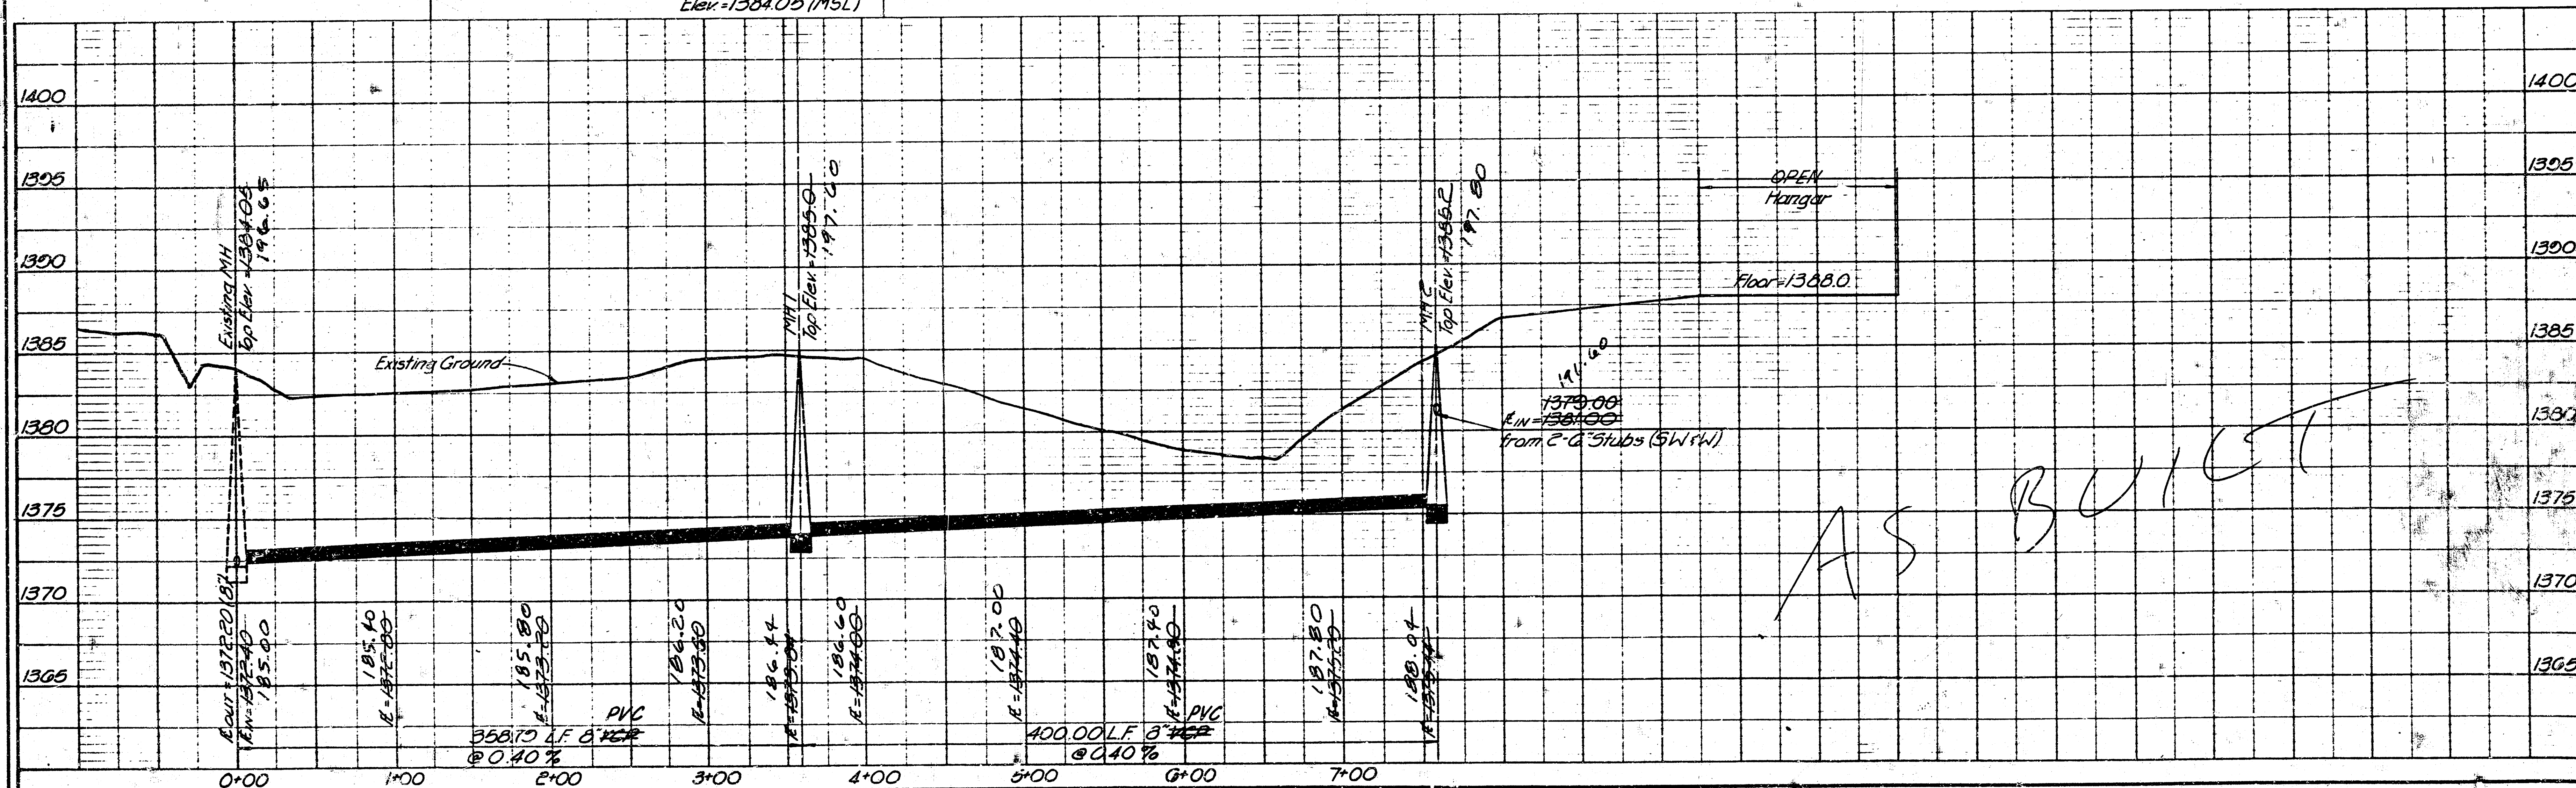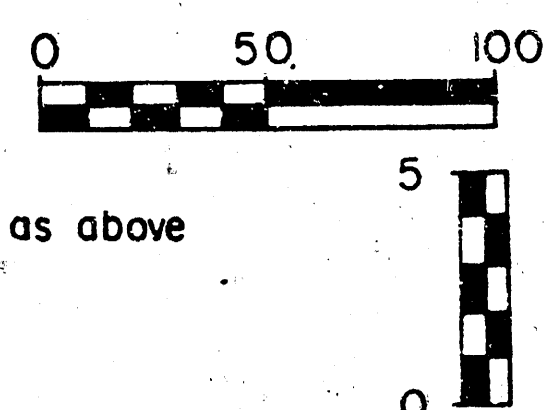

AS BUILT

DATE	NATURE OF REVISION	BY	CHKD.	APPR.

City of Wichita Project No 468-76-245-800-00-000-000-000

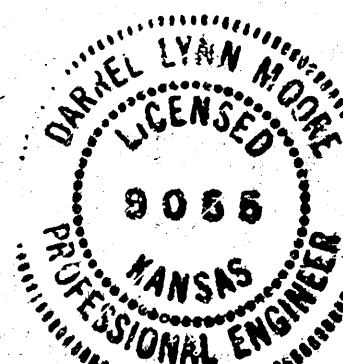

AS CONSTRUCTED
PROJ. ENG. DATE 1-21-85
RES. EN. DATE 1-18-85

PROFESSIONAL ENGINEERING CONSULTANTS, P.A.
ENGINEERS
WICHITA, KANSAS

BEECH AIRCRAFT CORP.
COMPLETION CENTER

BEECH AIRCRAFT CORP.
PLANT ENGINEERING DEPT.

SANITARY SEWER
EXTENSION

NUMBER	DATE	CHECKED	APPROVED
017	2/27/85		
SCALE			
SEE PLAN			

No. 064-19

REFERENCE DRAWINGS

APPROVED	TITLE	DATE