


PLANS FOR SANITARY SEWER SYSTEM BEL AIRE-COZY HOMES ADD.

SE0987

468-76-245-80001-000-000-153

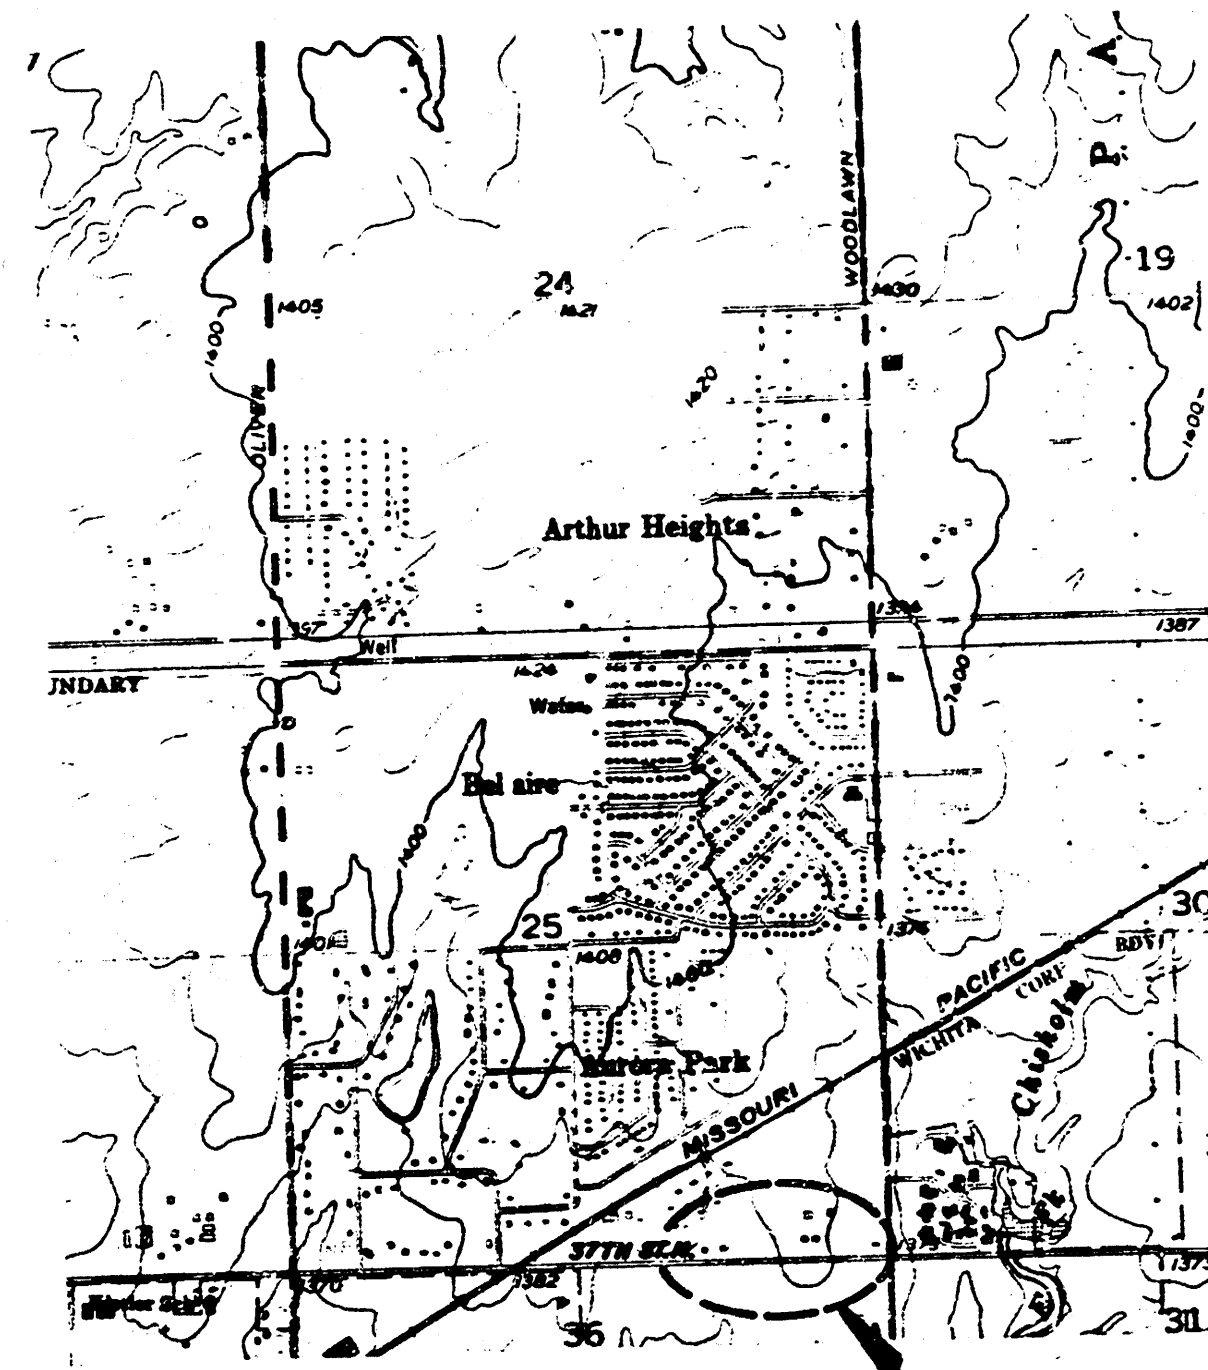

PROJECT LOCATION

APPROVED AS NOTED
By CITY ENGINEER OF WICHITA
Sanitary Sewers 4/6 3/13/88
Storm Sewers _____
Driveway Approaches _____
Water Mains _____
Paving _____

NOTE TO CONTRACTOR

This project will be constructed under the supervision of the CITY ENGINEER and conforming to the SPECIFICATIONS of the CITY OF WICHITA. The CONTRACTOR will pay the City of Wichita for all costs of plan review, inspection and booking per contract.



AS CONSTRUCTED

DEISS & GOODNESS ENGINEERS
2100 WEST 21ST STREET
WICHITA, KANSAS 67203
(913) 832-0225



REVISED 2/10/80


SCALE NONE
DATE 1-29-88
PROJECT NO. SE0987
SHEET 1 OF 8

REVISION	DRAWN BY	CHECKED BY	DESIGNED BY	PROJECT
	DEJ		C G	

CUSTOMER

FILMED FROM THE BEST
AVAILABLE COPY

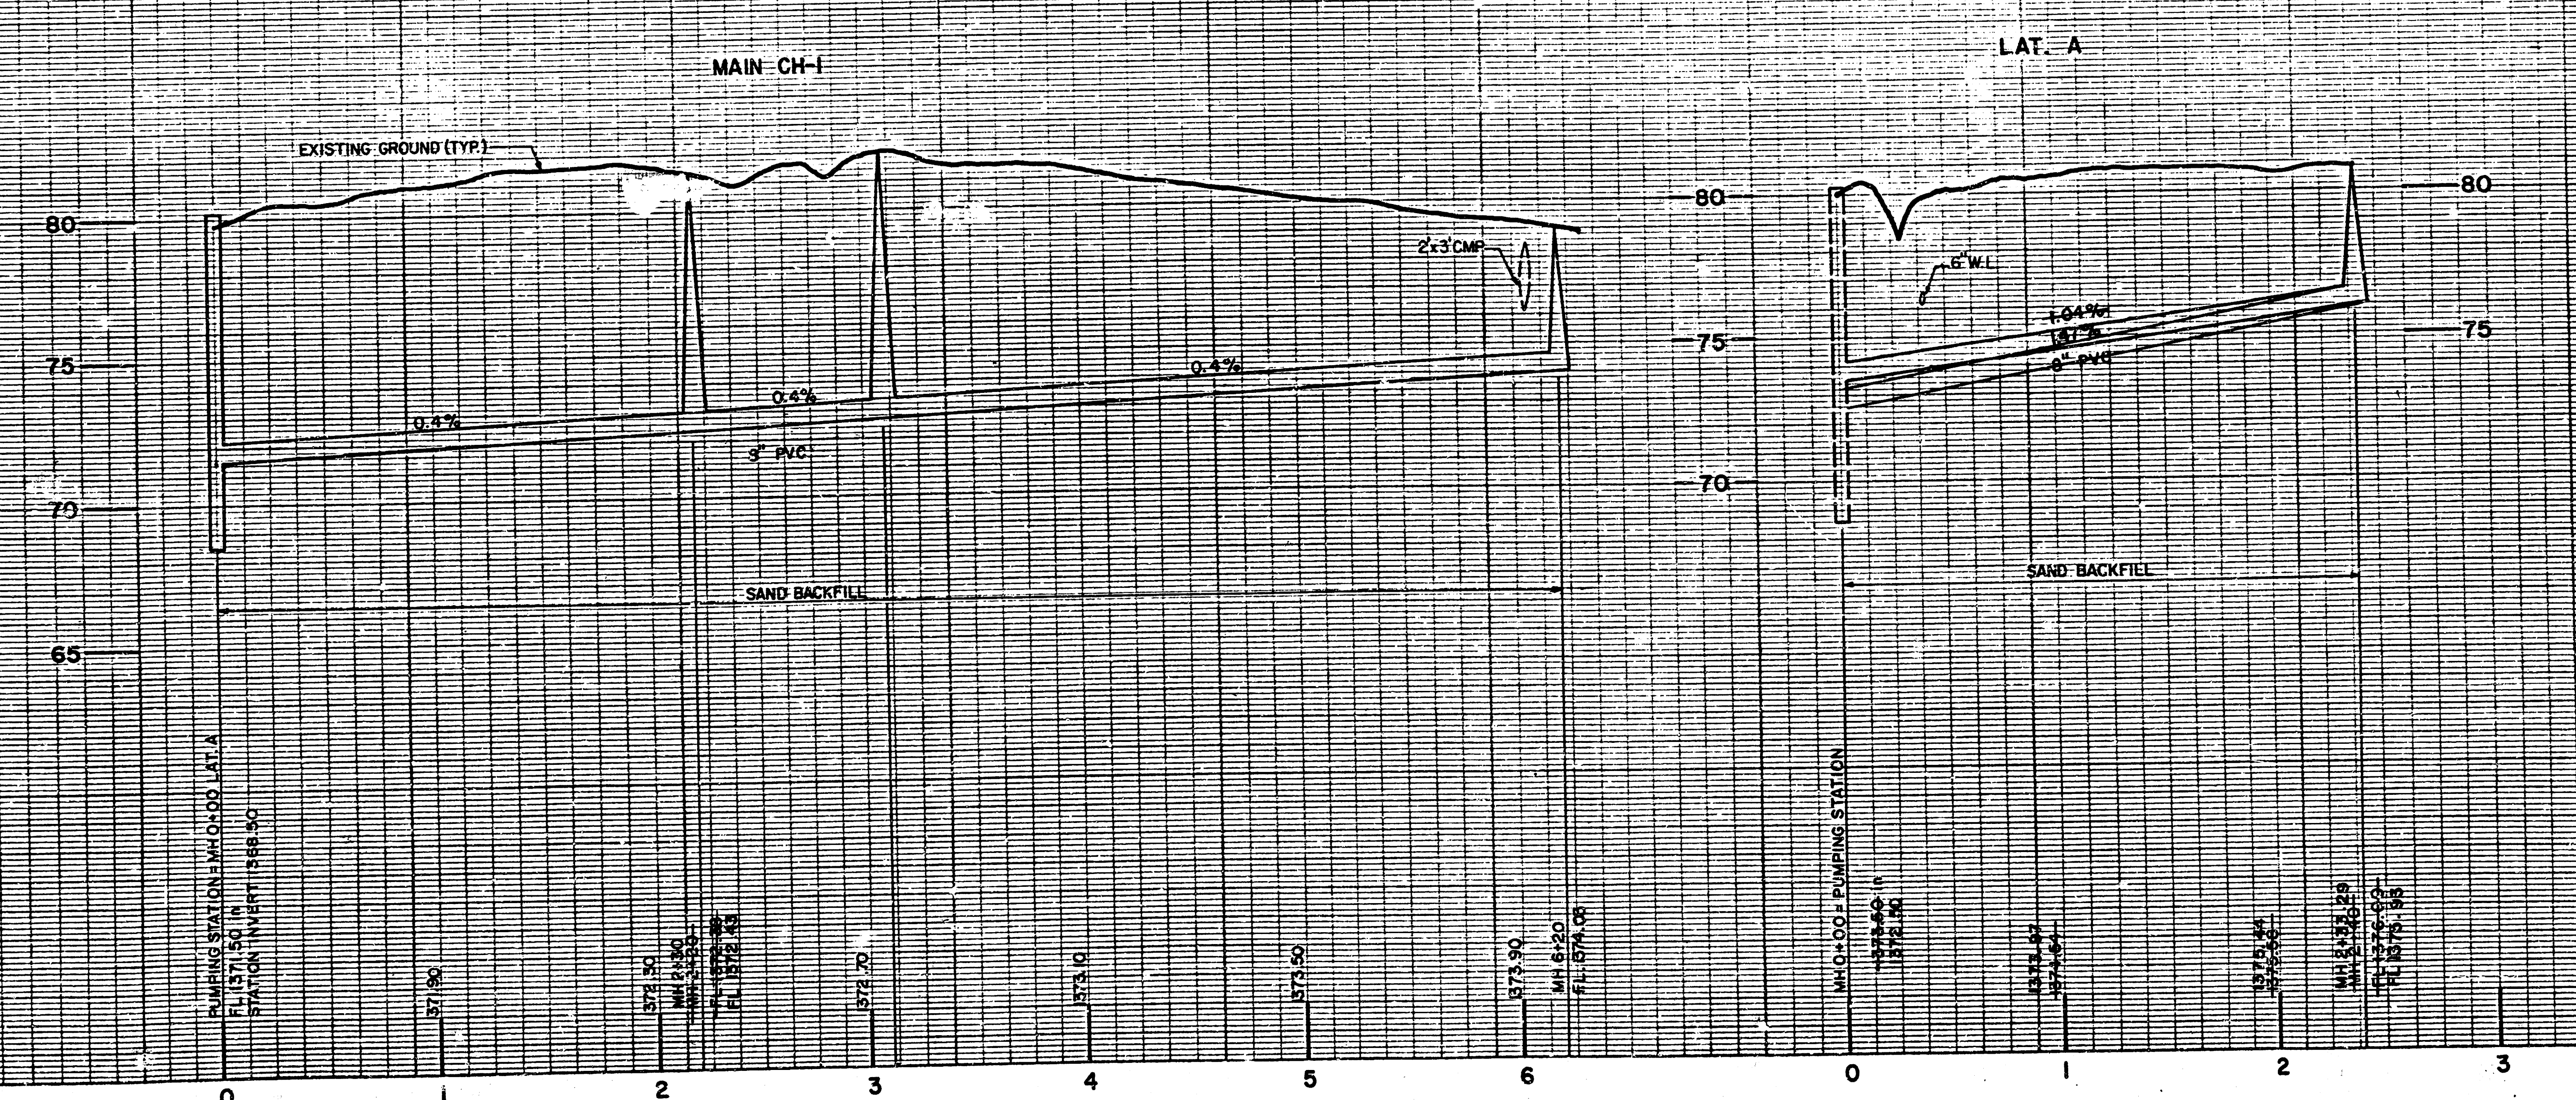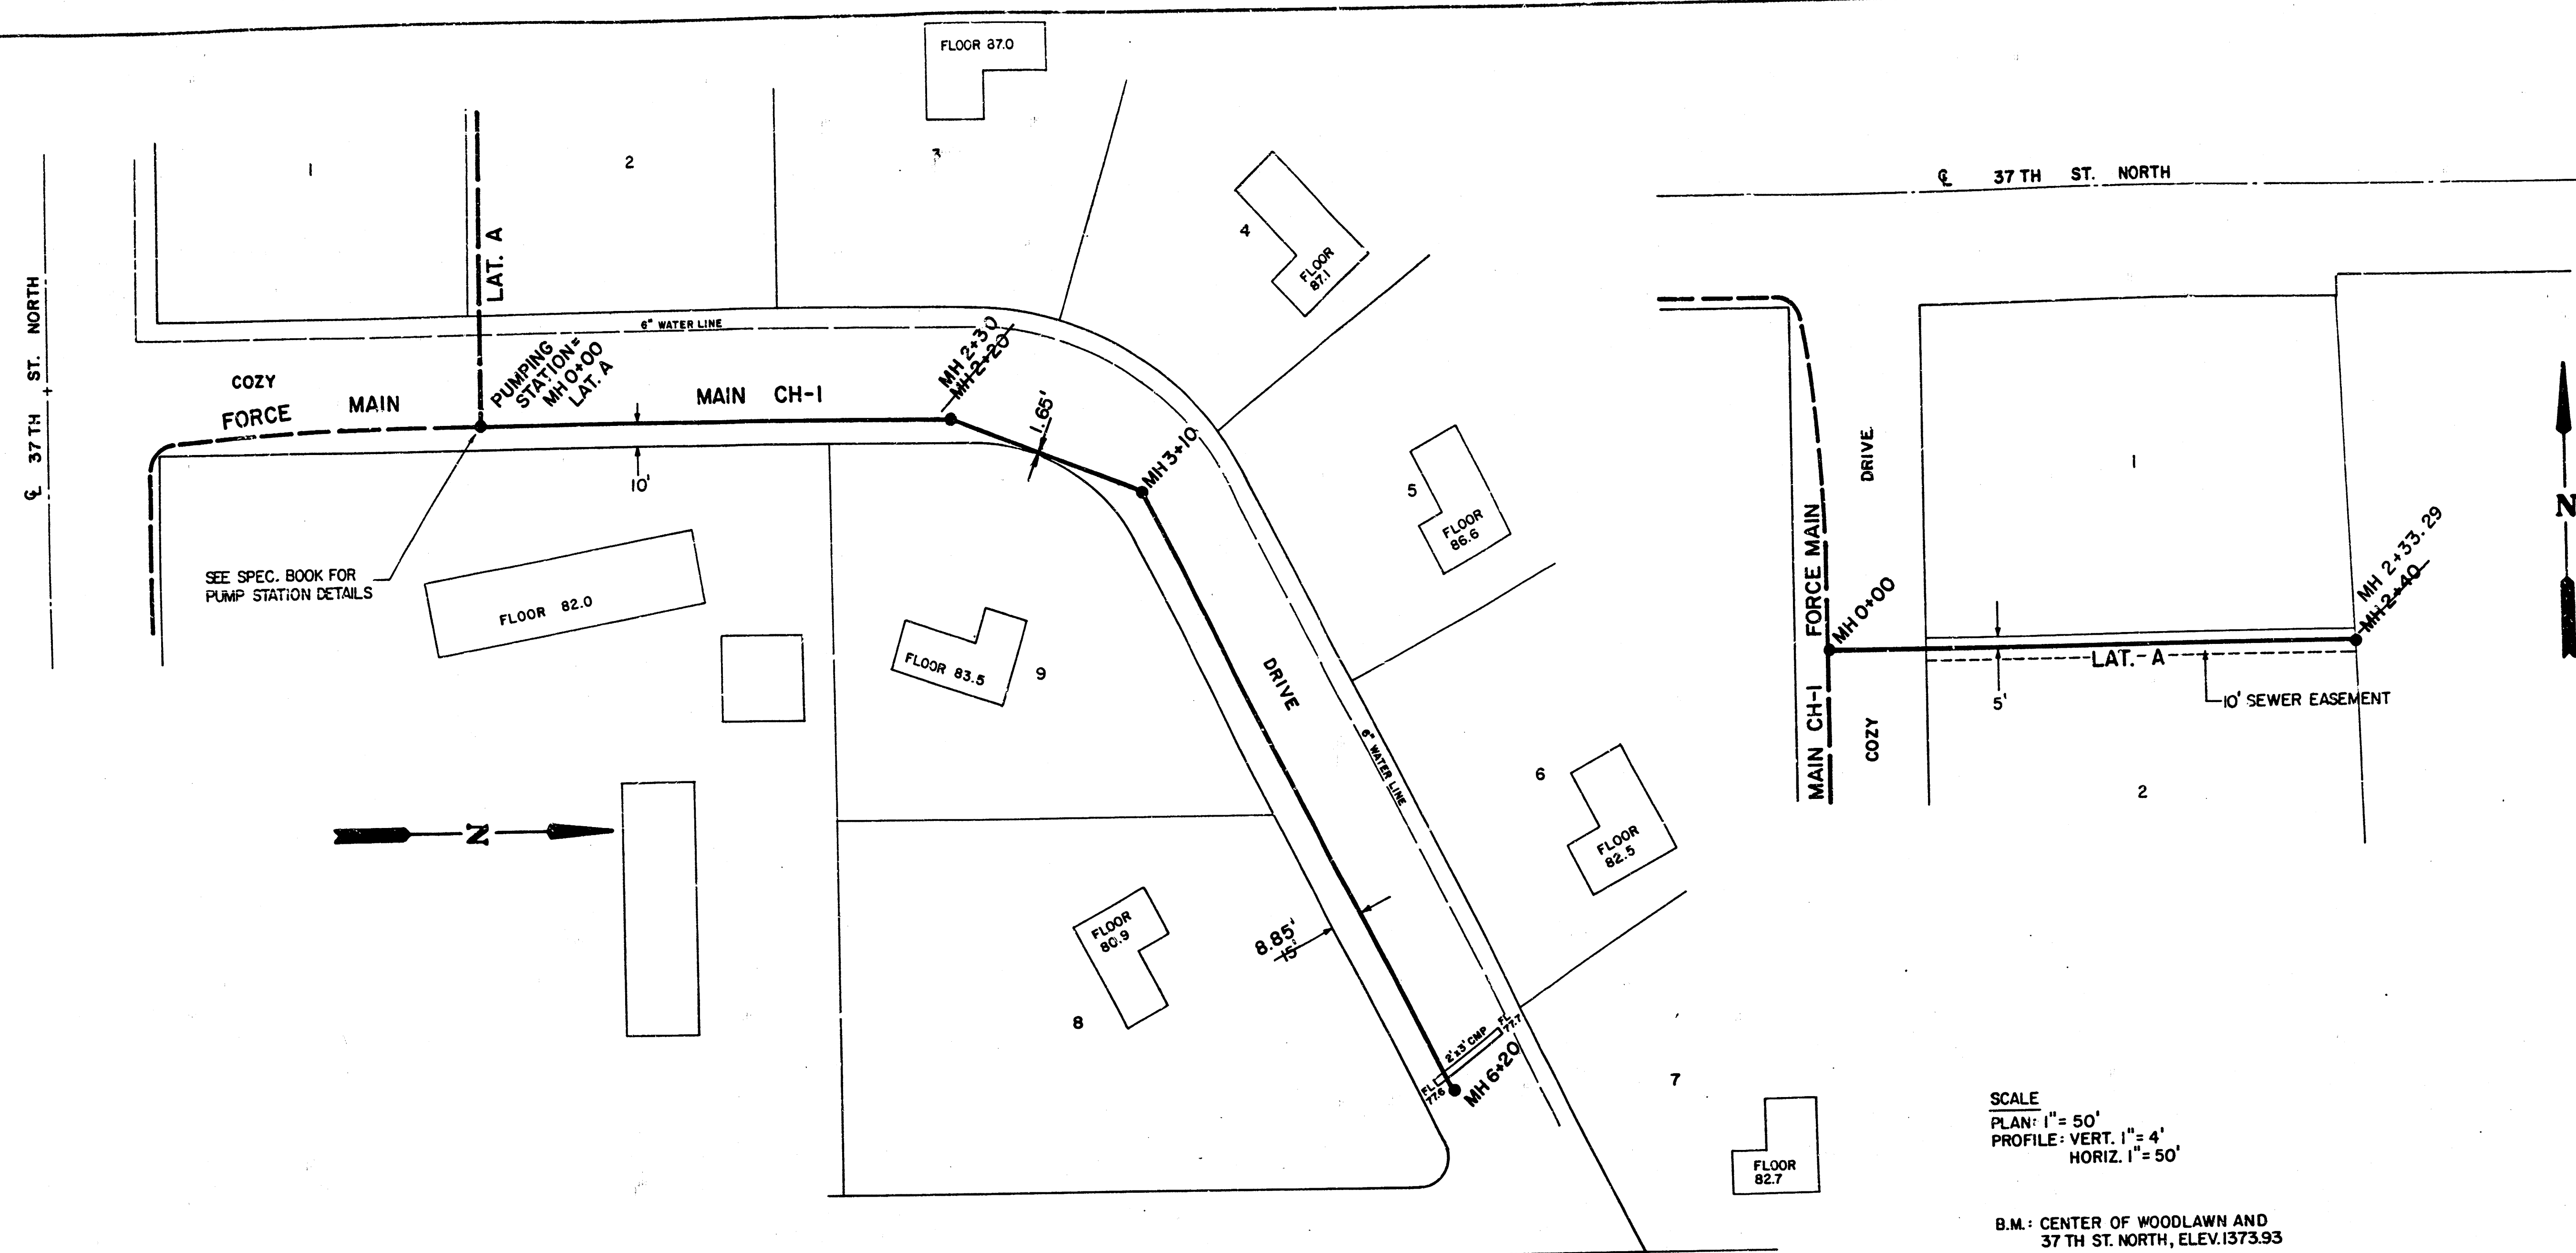

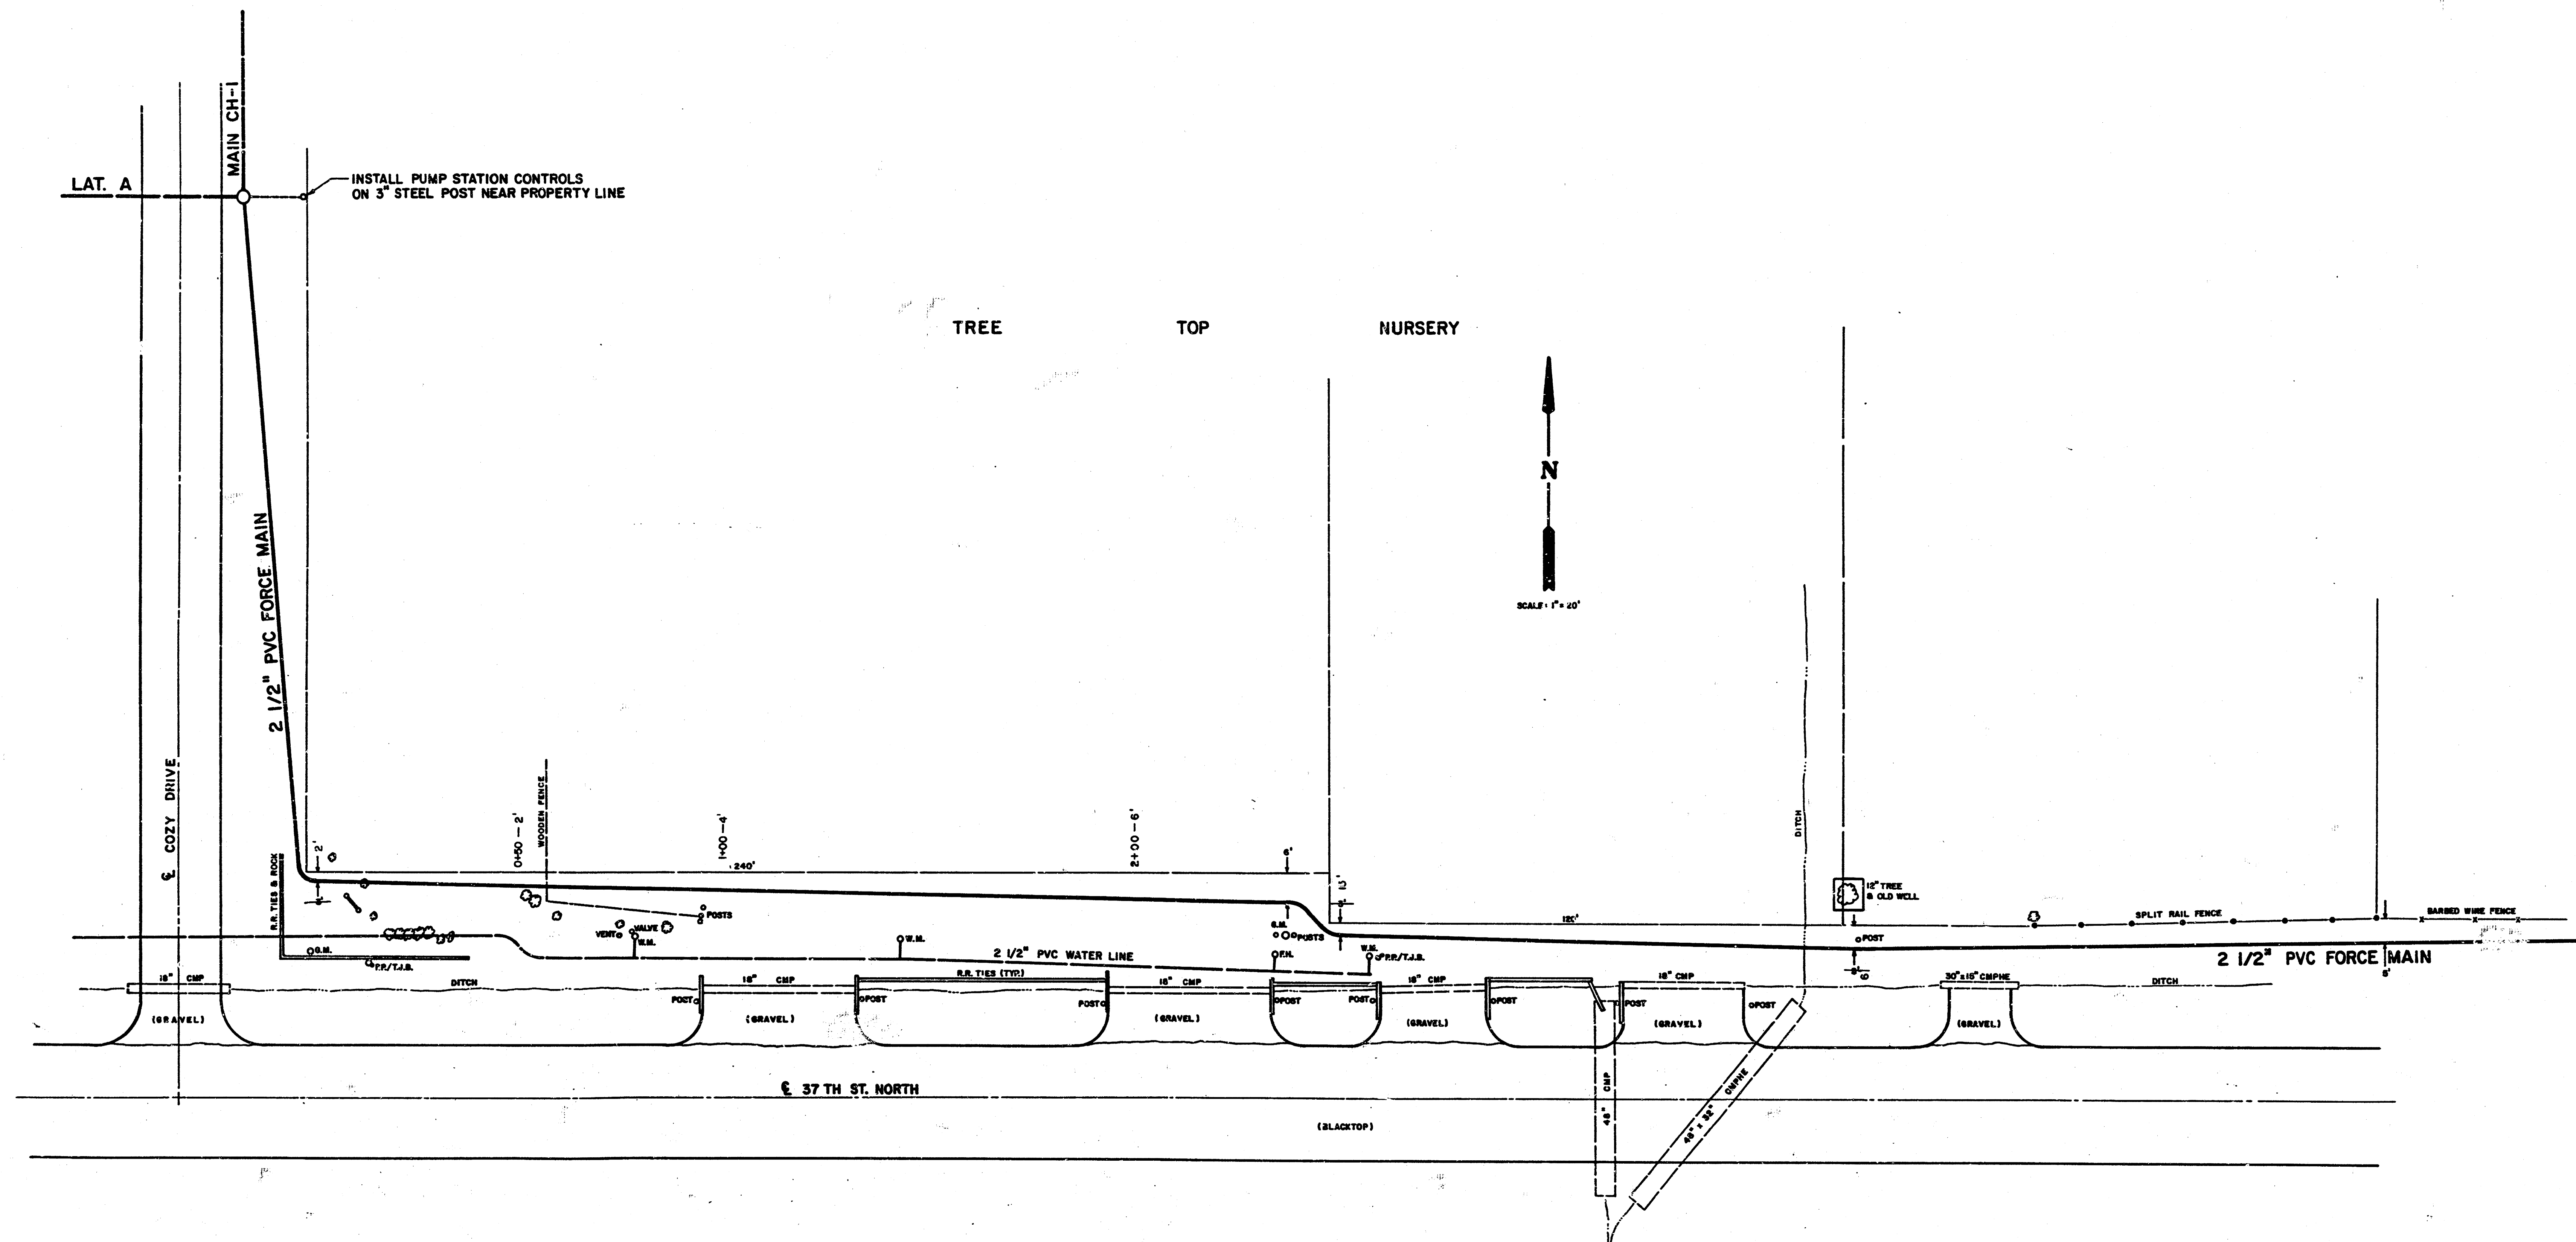

- LEGEND**
- W.M. — WATER METER
 - G.M. — GAS METER
 - P.P. — POWER POLE
 - T.J.B. — TELEPHONE JUNCTION BOX
 - F.H. — FIRE HYDRANT
 - — TREE OR BUSH

NOTE: CONTRACTOR SHALL REMOVE ALL CONSTRUCTION EQUIPMENT FROM PARKING AREA ON WEEKENDS.

DEISS & GOODNESS ENGINEERS
 2100 WEST 21ST STREET
 WICHITA, KANSAS 67203
 (316) 624-0225

REVISION 2-10-88	DRAWN BY DEJ	CHECKED BY	DESIGNED BY C G	PROJECT SANITARY SEWER SYSTEM	CUSTOMER BEL AIRE-COZY HOMES ADD.	REVISED 2/10/88	SCALE 1"=20'	PROJECT NO. 20487	SHEET 3 OF 6
---------------------	-----------------	------------	--------------------	---	---	-----------------	--------------	----------------------	--------------

FILMED FROM THE BEST AVAILABLE COPY

