


NOTE: All elevations are in feet unless otherwise noted. All elevations are to the center of the pipe.

**LEGEND**

- 36" Ø - 12' to 15' spacing
- 48" Ø - 15' to 20' spacing
- 60" Ø - 20' to 30' spacing

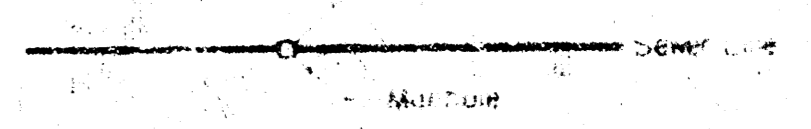

AS CONSTRUCTED  
 SANITARY SEWER SYSTEM  
**Bel Aire Village**

C. of W. PROJECT NO. DBKW 707051  
 SEDGWICK COUNTY, KANSAS

1977

L. J. COOPER & ASSOCIATES, INC.  
 2100 WEST 21ST STREET  
 WICHITA, KANSAS 67204  
 (316) 261-0533