



DATE: 9-2-70 REVISED: 10-1-70 REVISED: 10-1-70	KEISS AND GOODWIN ENGINEERS 140 E DOUGLAS APT 101 - KANSAS	SANITARY SEWER LINE EXTENSION OF LAT. 29 - WAC INDUSTRIES SEWER TO JERVE PAUL BARNETT ADDITION TO WAC - KANSAS	SHEET NO. 3
--	---	--	----------------

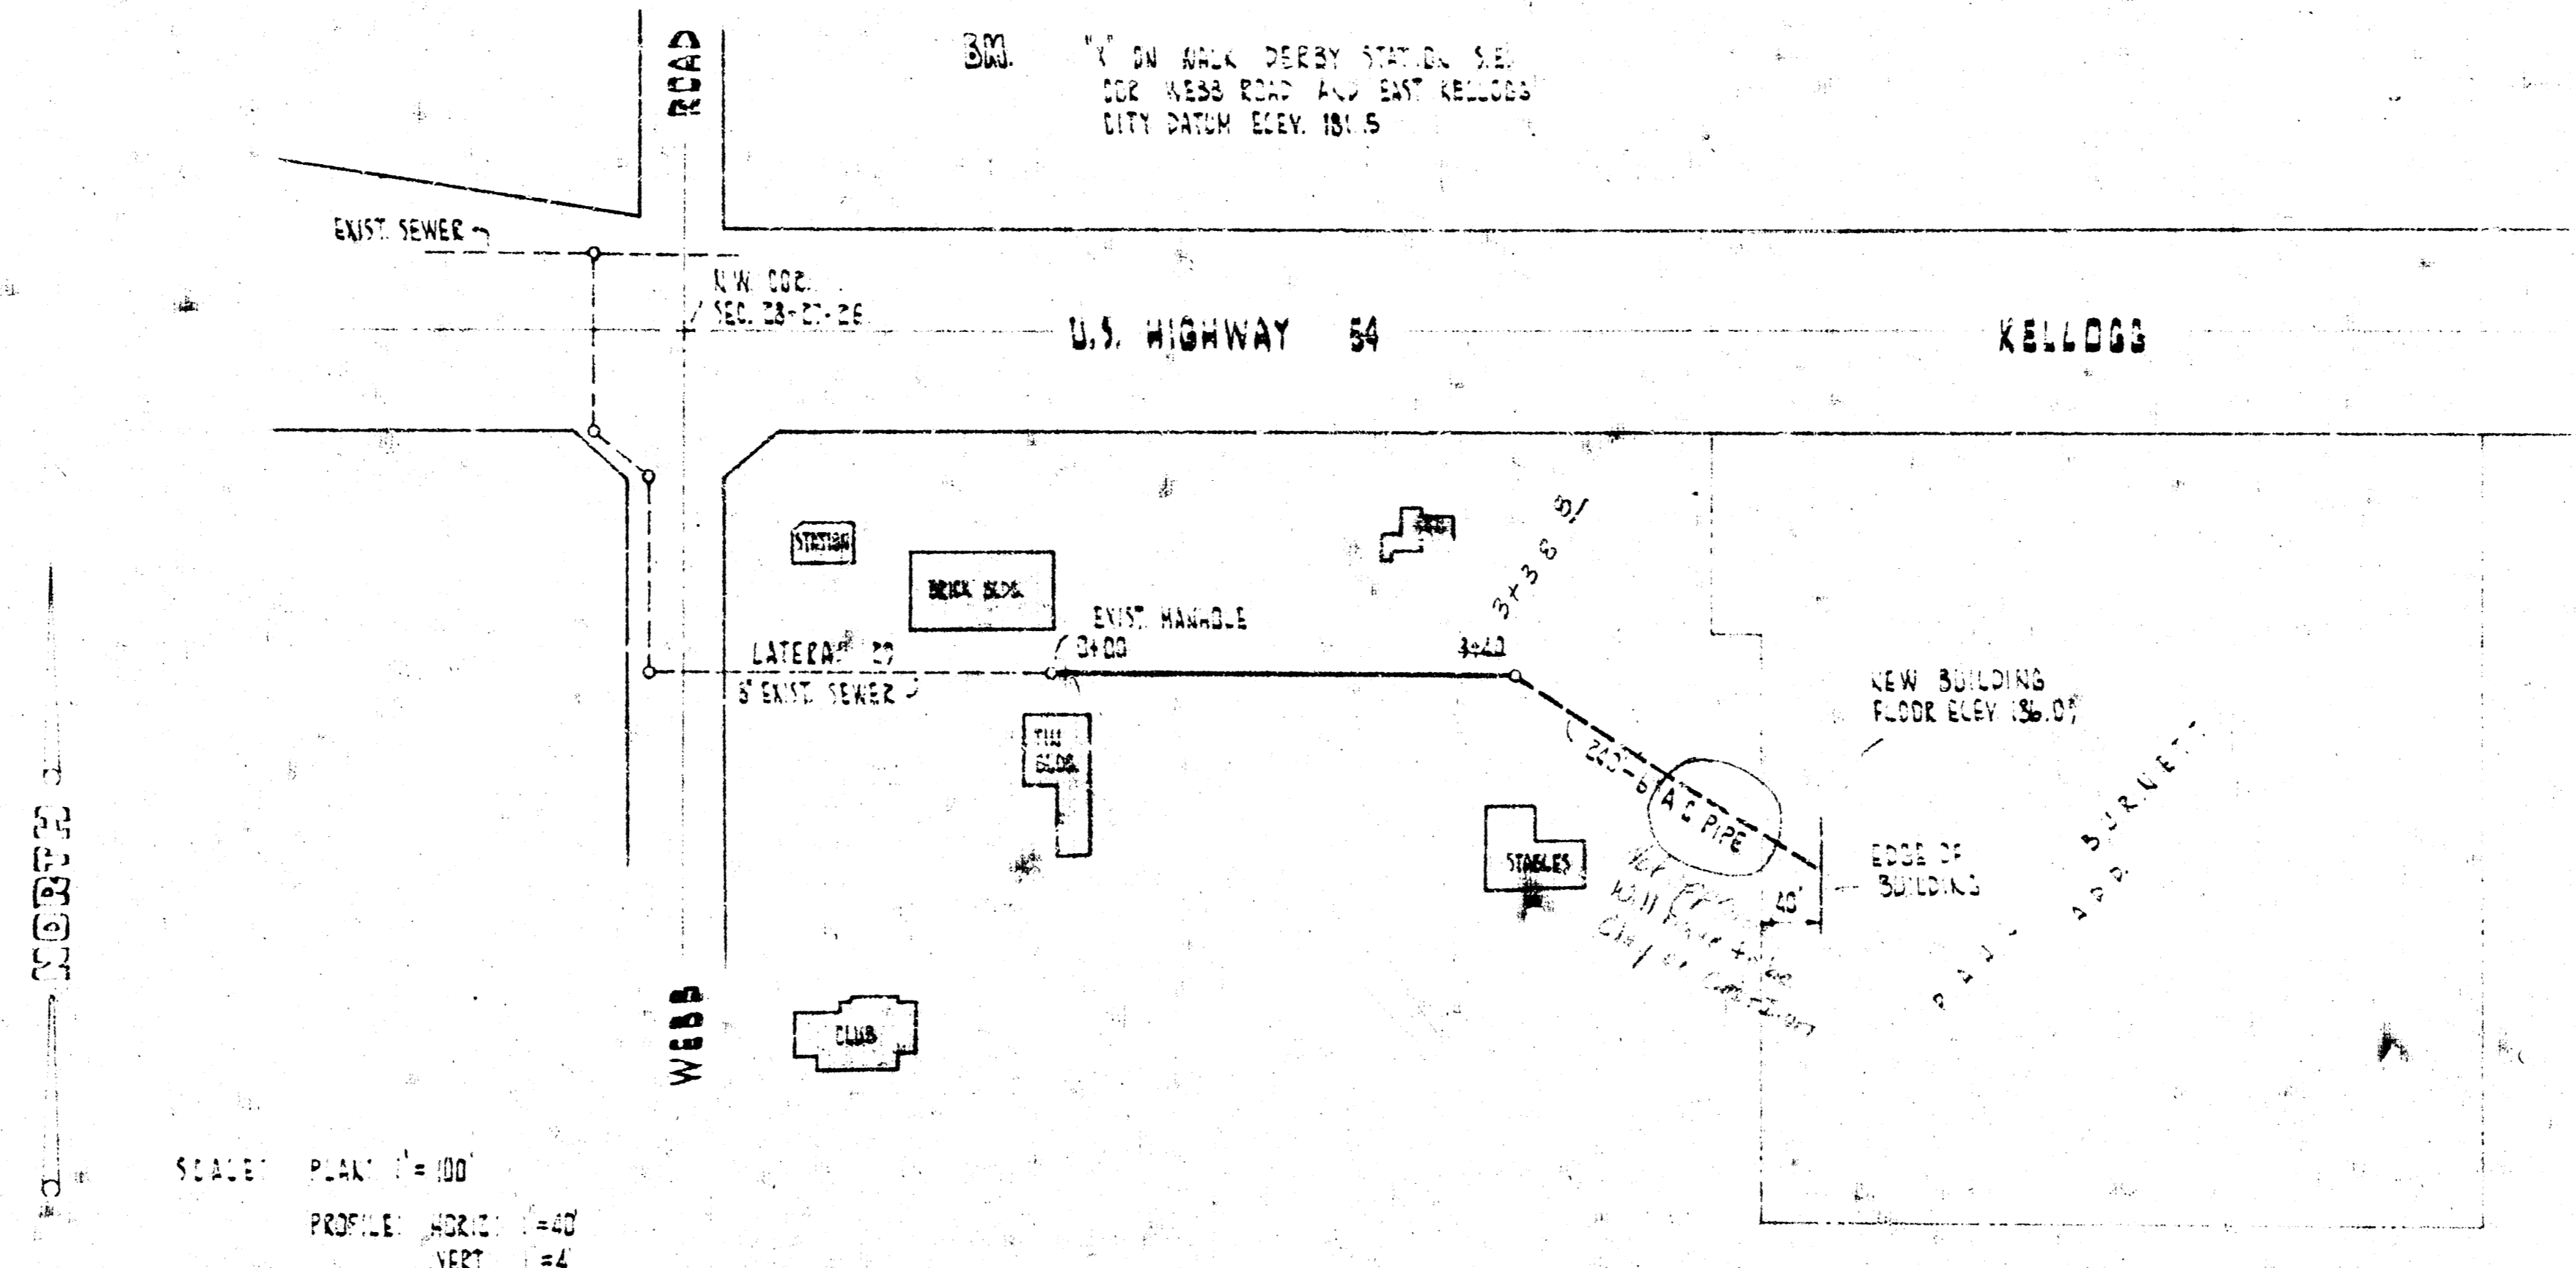

APPROVED AS NOTED
 CITY OF WICHITA
 ENGINEER
 [Signature]

NOTE TO CONTRACTOR
 This project will be constructed under the supervision of the City Engineer and conform to the specifications of the City of Wichita. The CONTRACTOR shall advise the City of Wichita of any changes in engineering and materials.

SCALE: PLAN = 1" = 100'
 PROFILE: HOR. = 1" = 40'
 VERT. = 4"

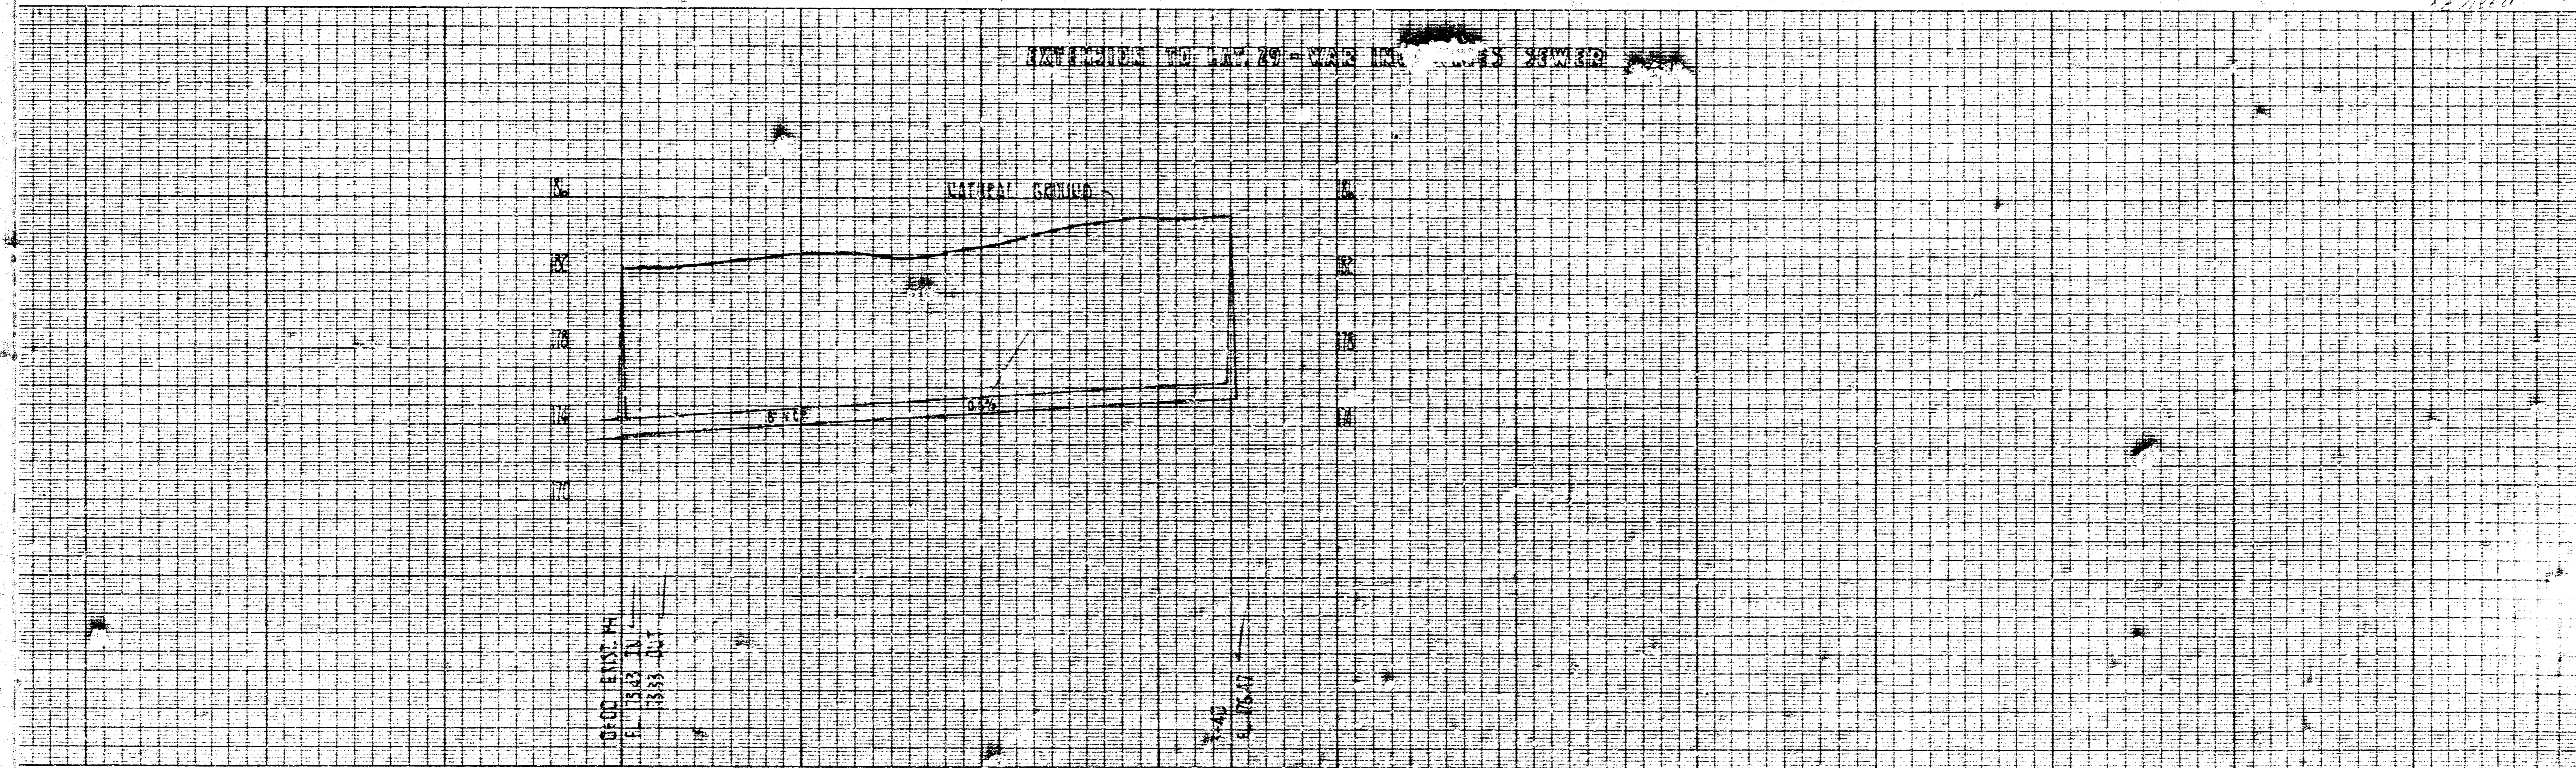

MADE IN U.S.A.
 LITHOGRAPHED BY
 LITHECO, INC.
 1115 S. W. 10th St.
 WICHITA, KANSAS 67202

MADE IN U.S.A.
 LITHOGRAPHED BY
 LITHECO, INC.
 1115 S. W. 10th St.
 WICHITA, KANSAS 67202

109
 11-17-70

Ext. Lat. 29, W. I. S.
 For Paul Barnett ADDN
 Private Job