



PLAN	DATE	BY	CHKD
NOTE BOOK	NO.	DA	59
REVISIONS	DATE	BY	CHKD
1			
2			
3			
4			
5			
6			
7			
8			
9			
10			

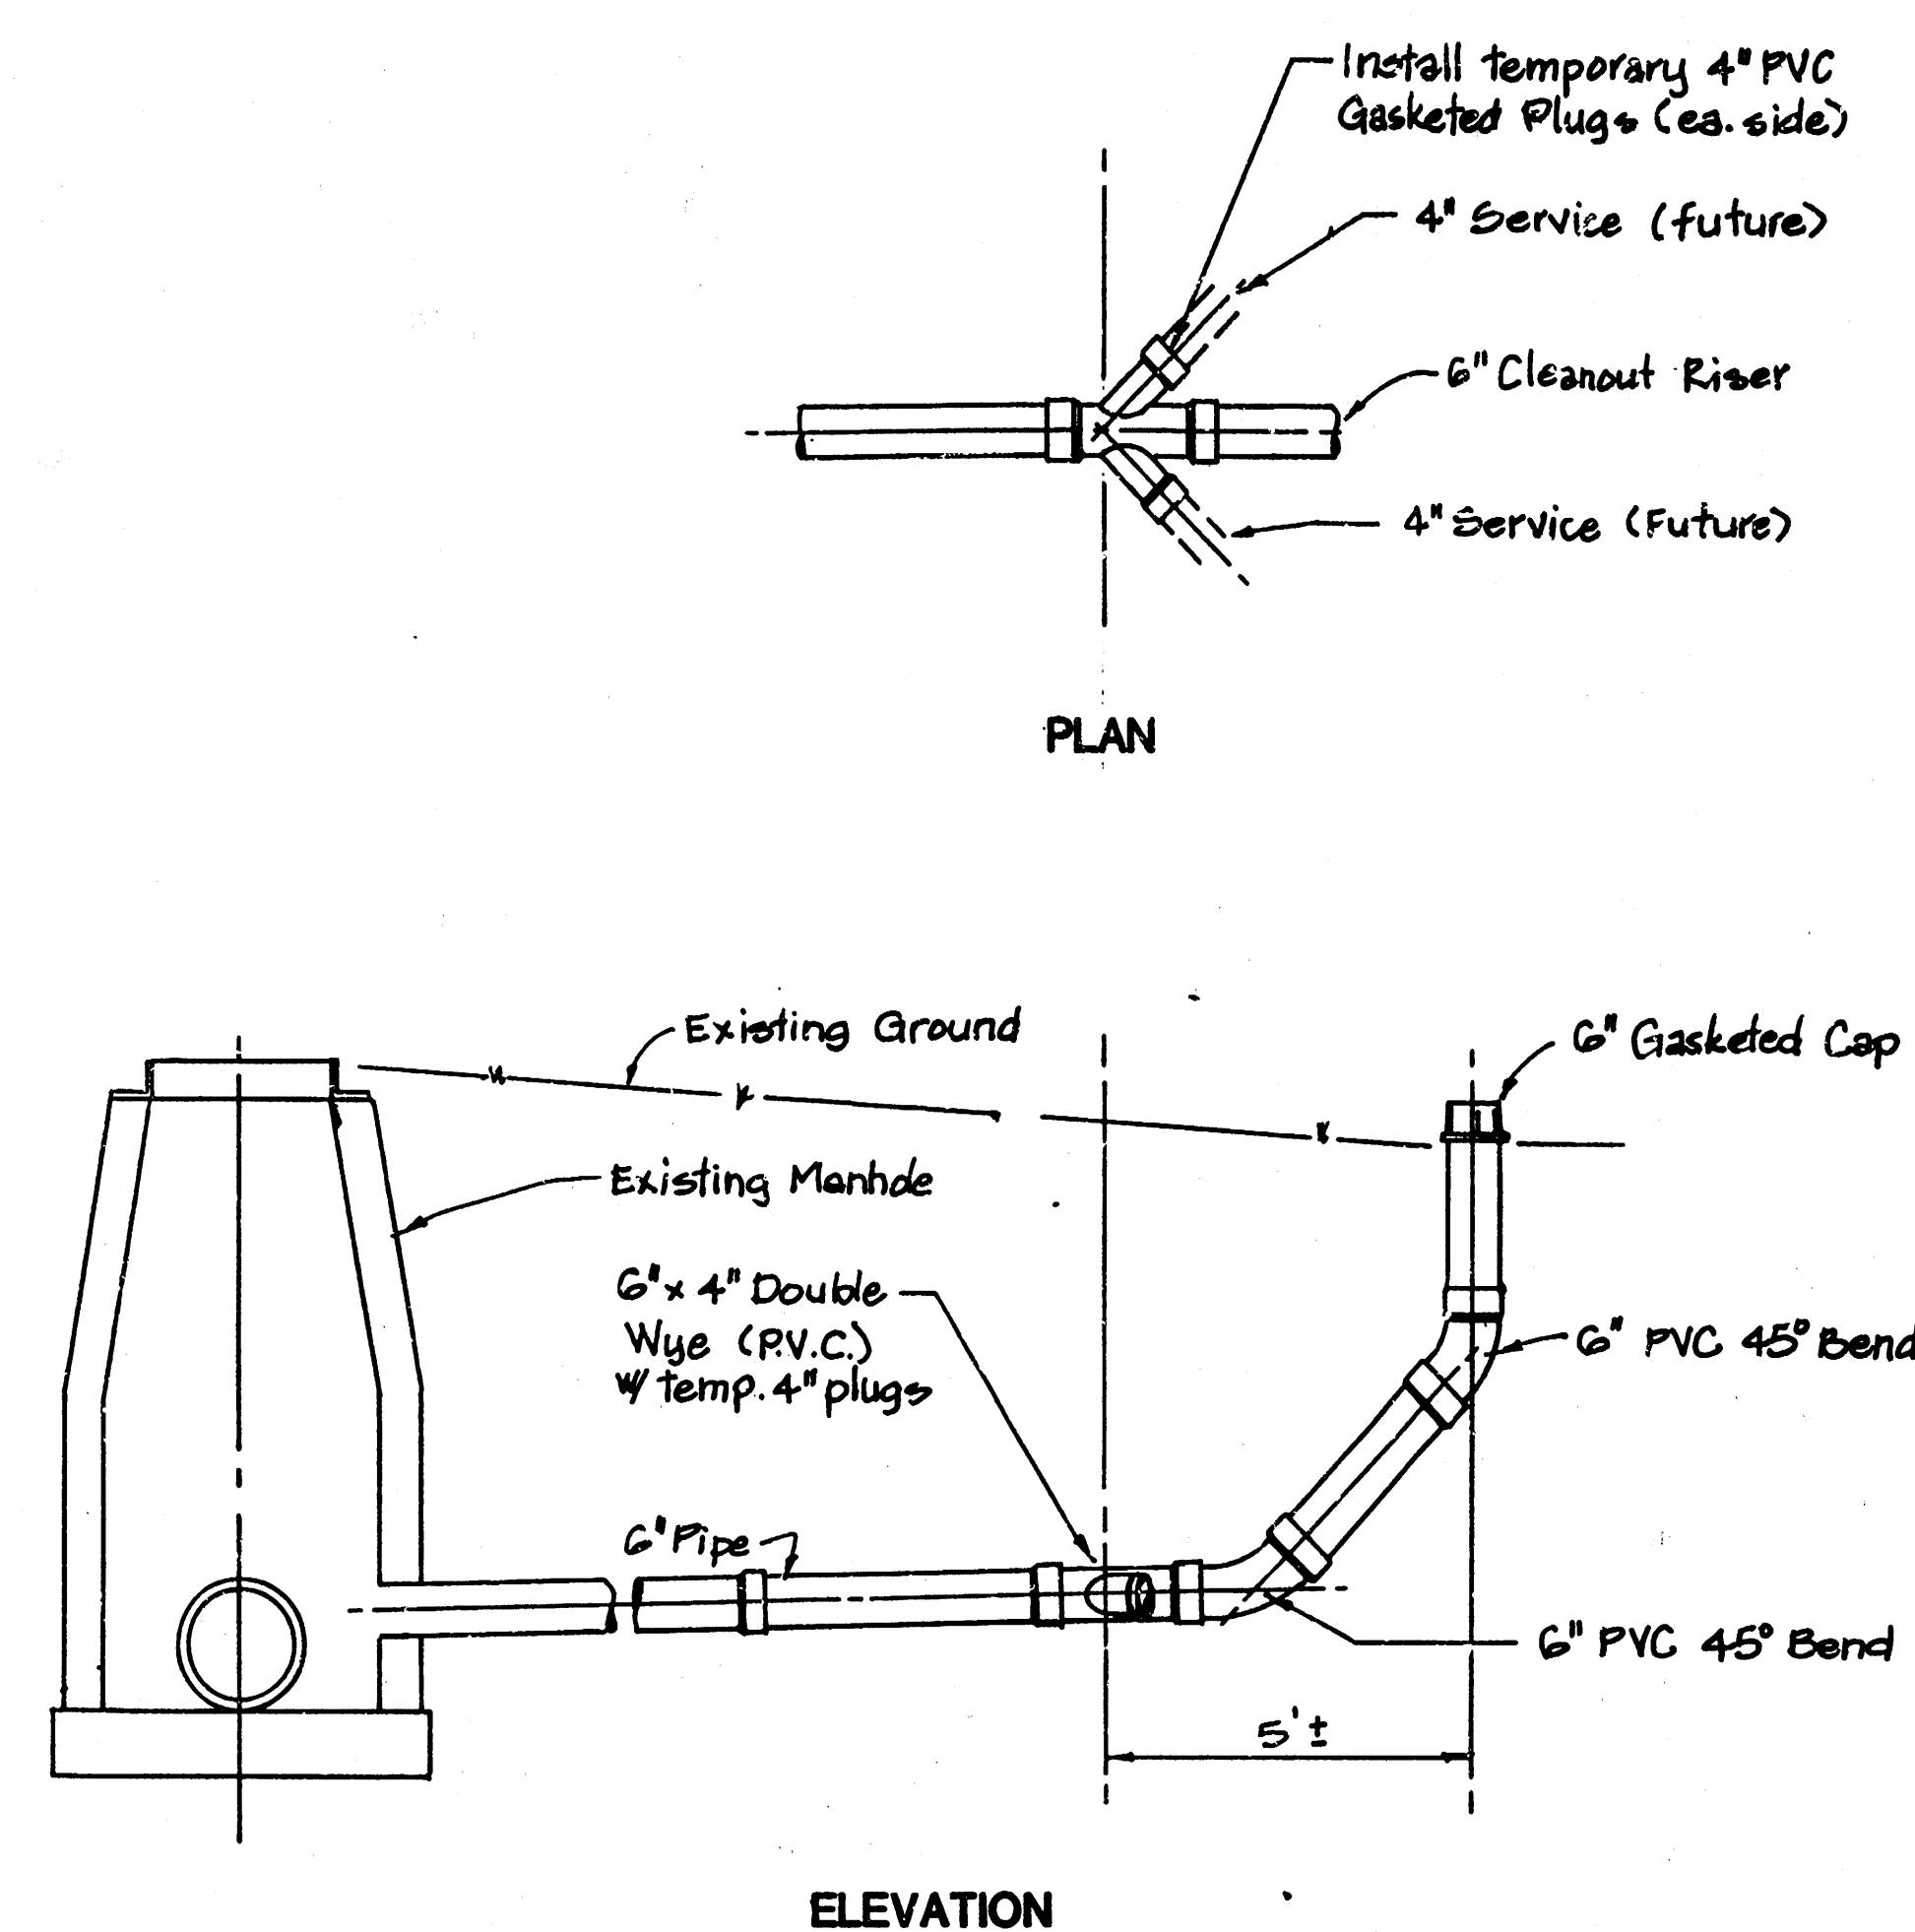

CLEANOUT RISER ASSEMBLY DETAIL

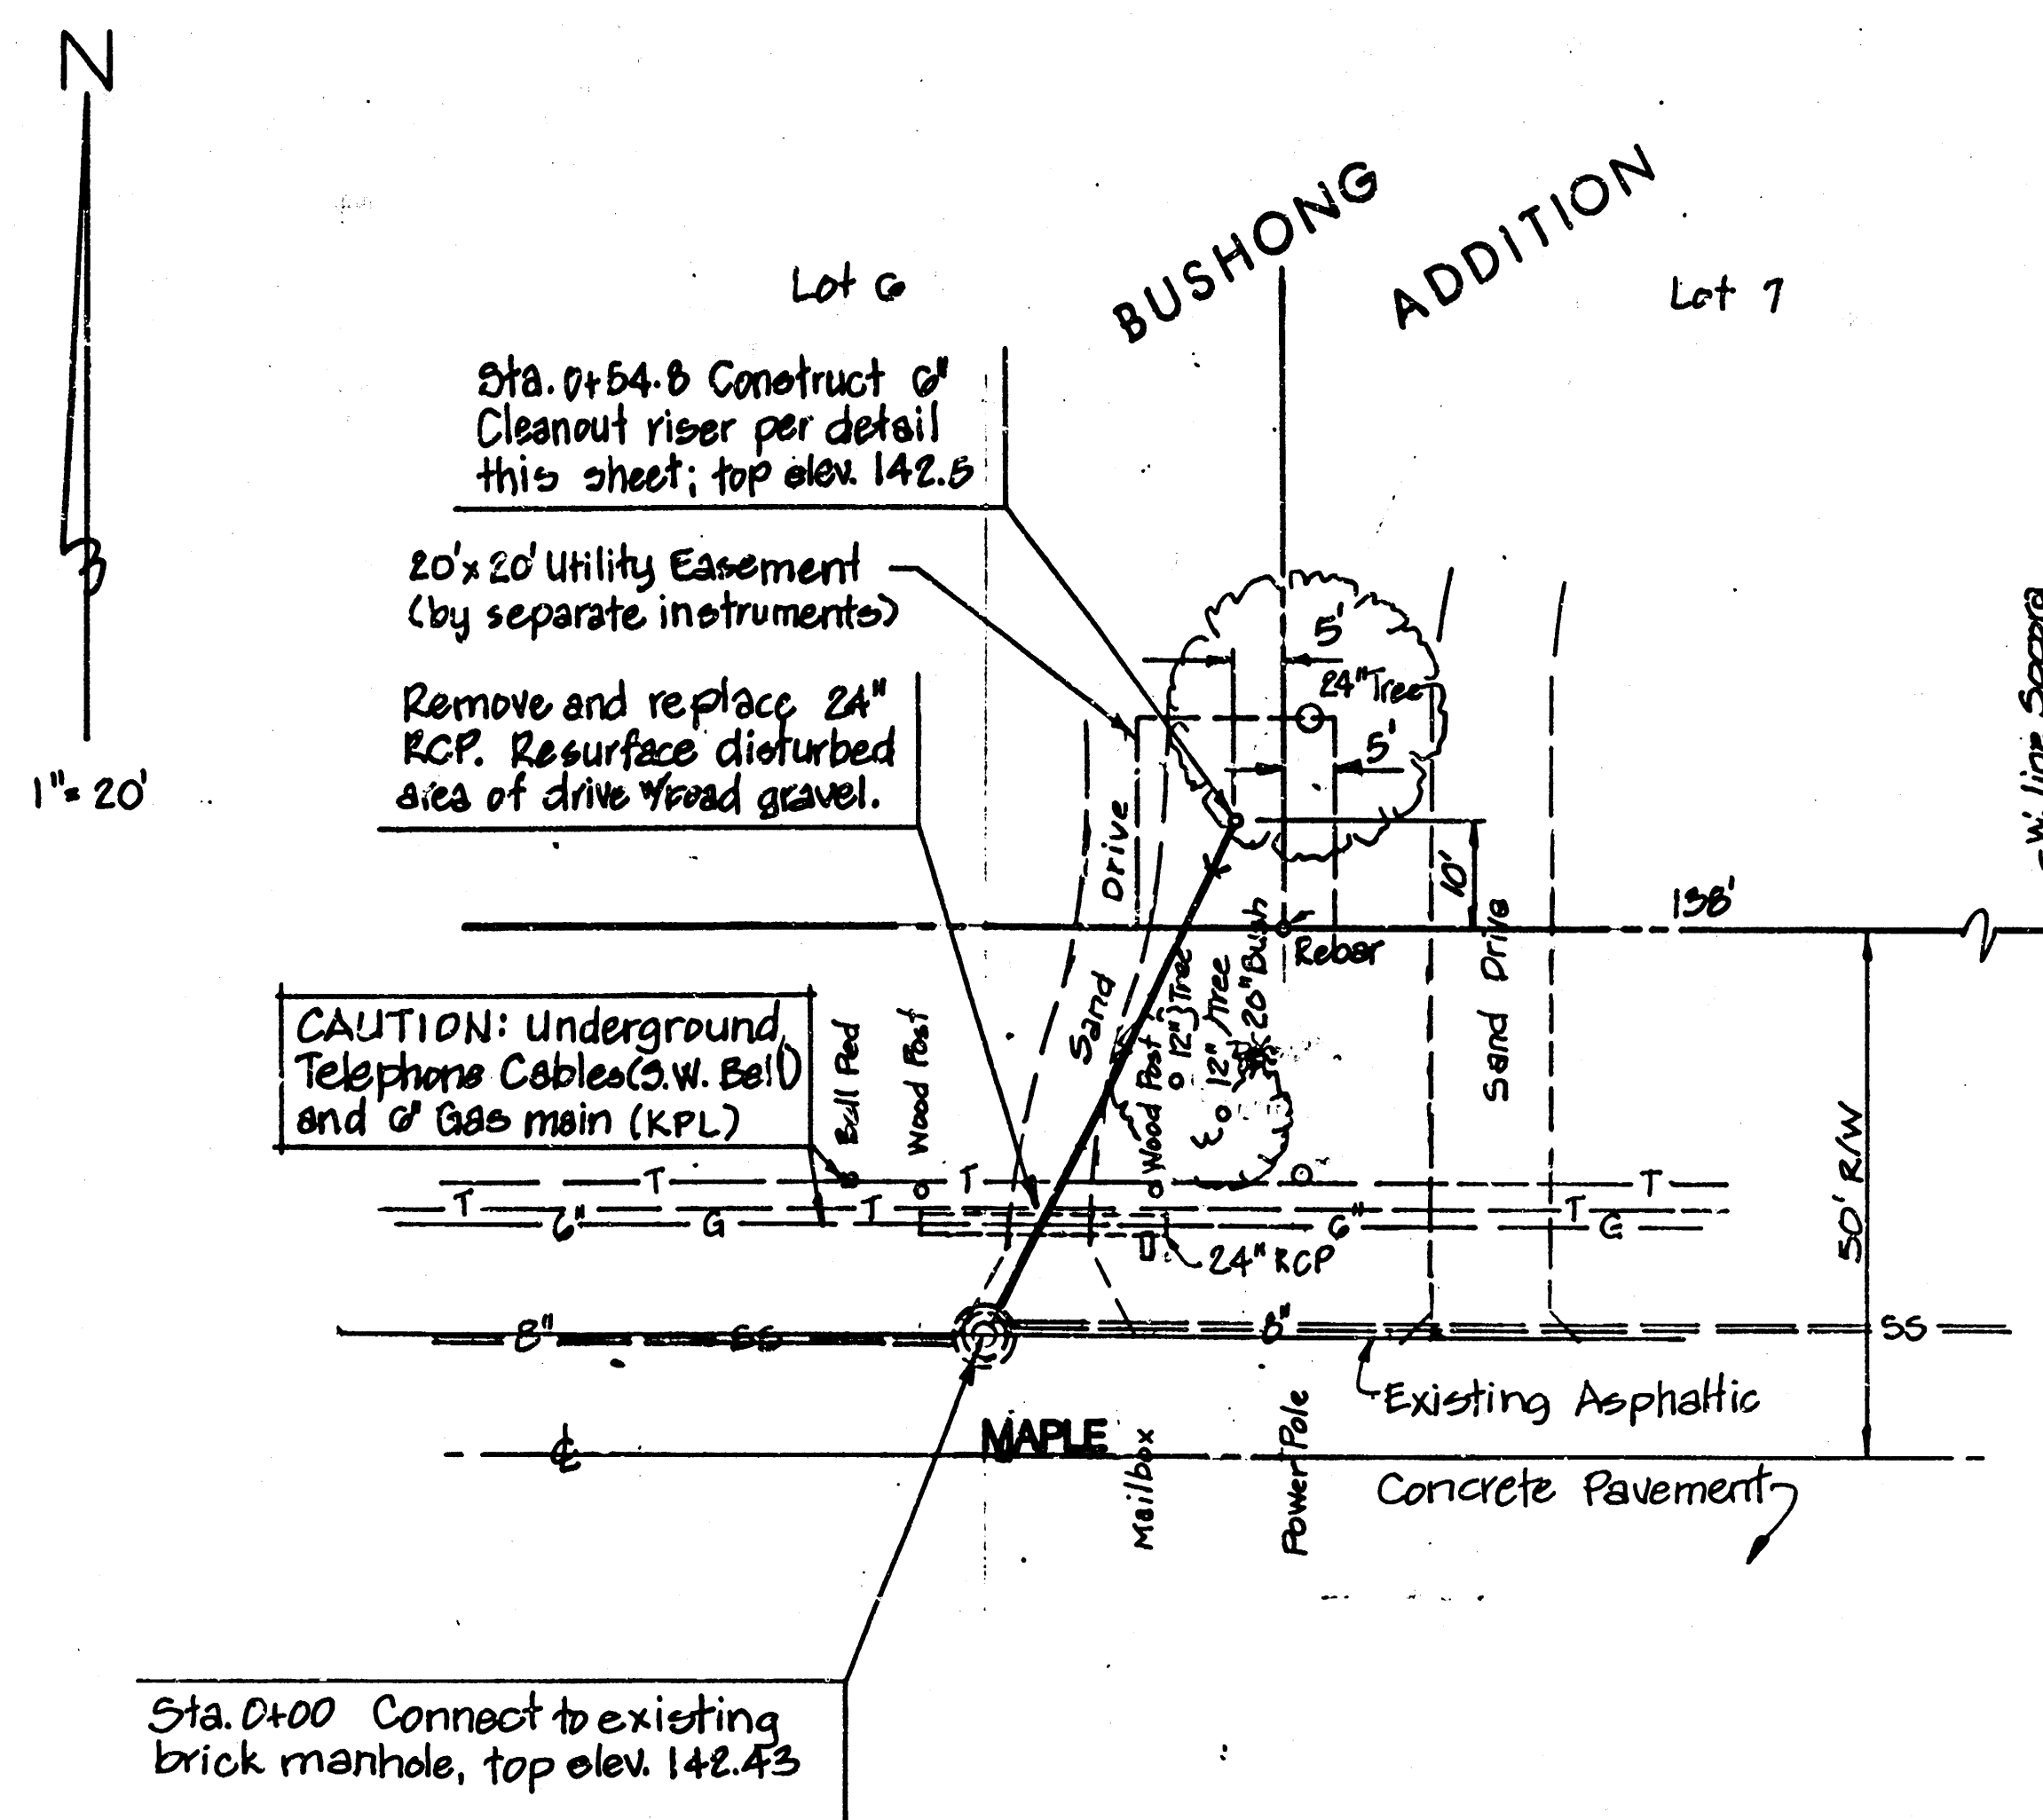


LOCATION MAP

GENERAL NOTES

- Contractor will be required to provide a minimum advance notice of twenty-four (24) hours to utility companies prior to starting any excavation as follows:

Kansas One-Call	1-800-344-7233
Cablevision	262-4270 or 263-2061
K.P. & L. Gas Service Company	263-7511
Kansas Gas & Electric	264-1141
Arkia Gas Company	942-8350 or 263-8161
Southwest Bell Telephone Company	1-571-2611
City of Wichita Water Department	268-4908
City of Wichita Sewer Maintenance	268-4071
- The Contractor shall give all property owners and/or tenants of developed property directly abutting the construction of this project a minimum of ten (10) days advance notice prior to start of construction.
- The Contractor shall be responsible for preserving property irons. The Contractor will be required to re-establish any property irons which are damaged or destroyed by his construction operations. Such irons shall be re-established by a licensed land surveyor in accordance with state law.
- Traffic will not be affected by construction on this project.

PROFILE	DATE	BY	CHKD
NOTE BOOK	NO.	DA	59
REVISIONS	DATE	BY	CHKD
1			
2			
3			
4			
5			
6			
7			
8			
9			
10			

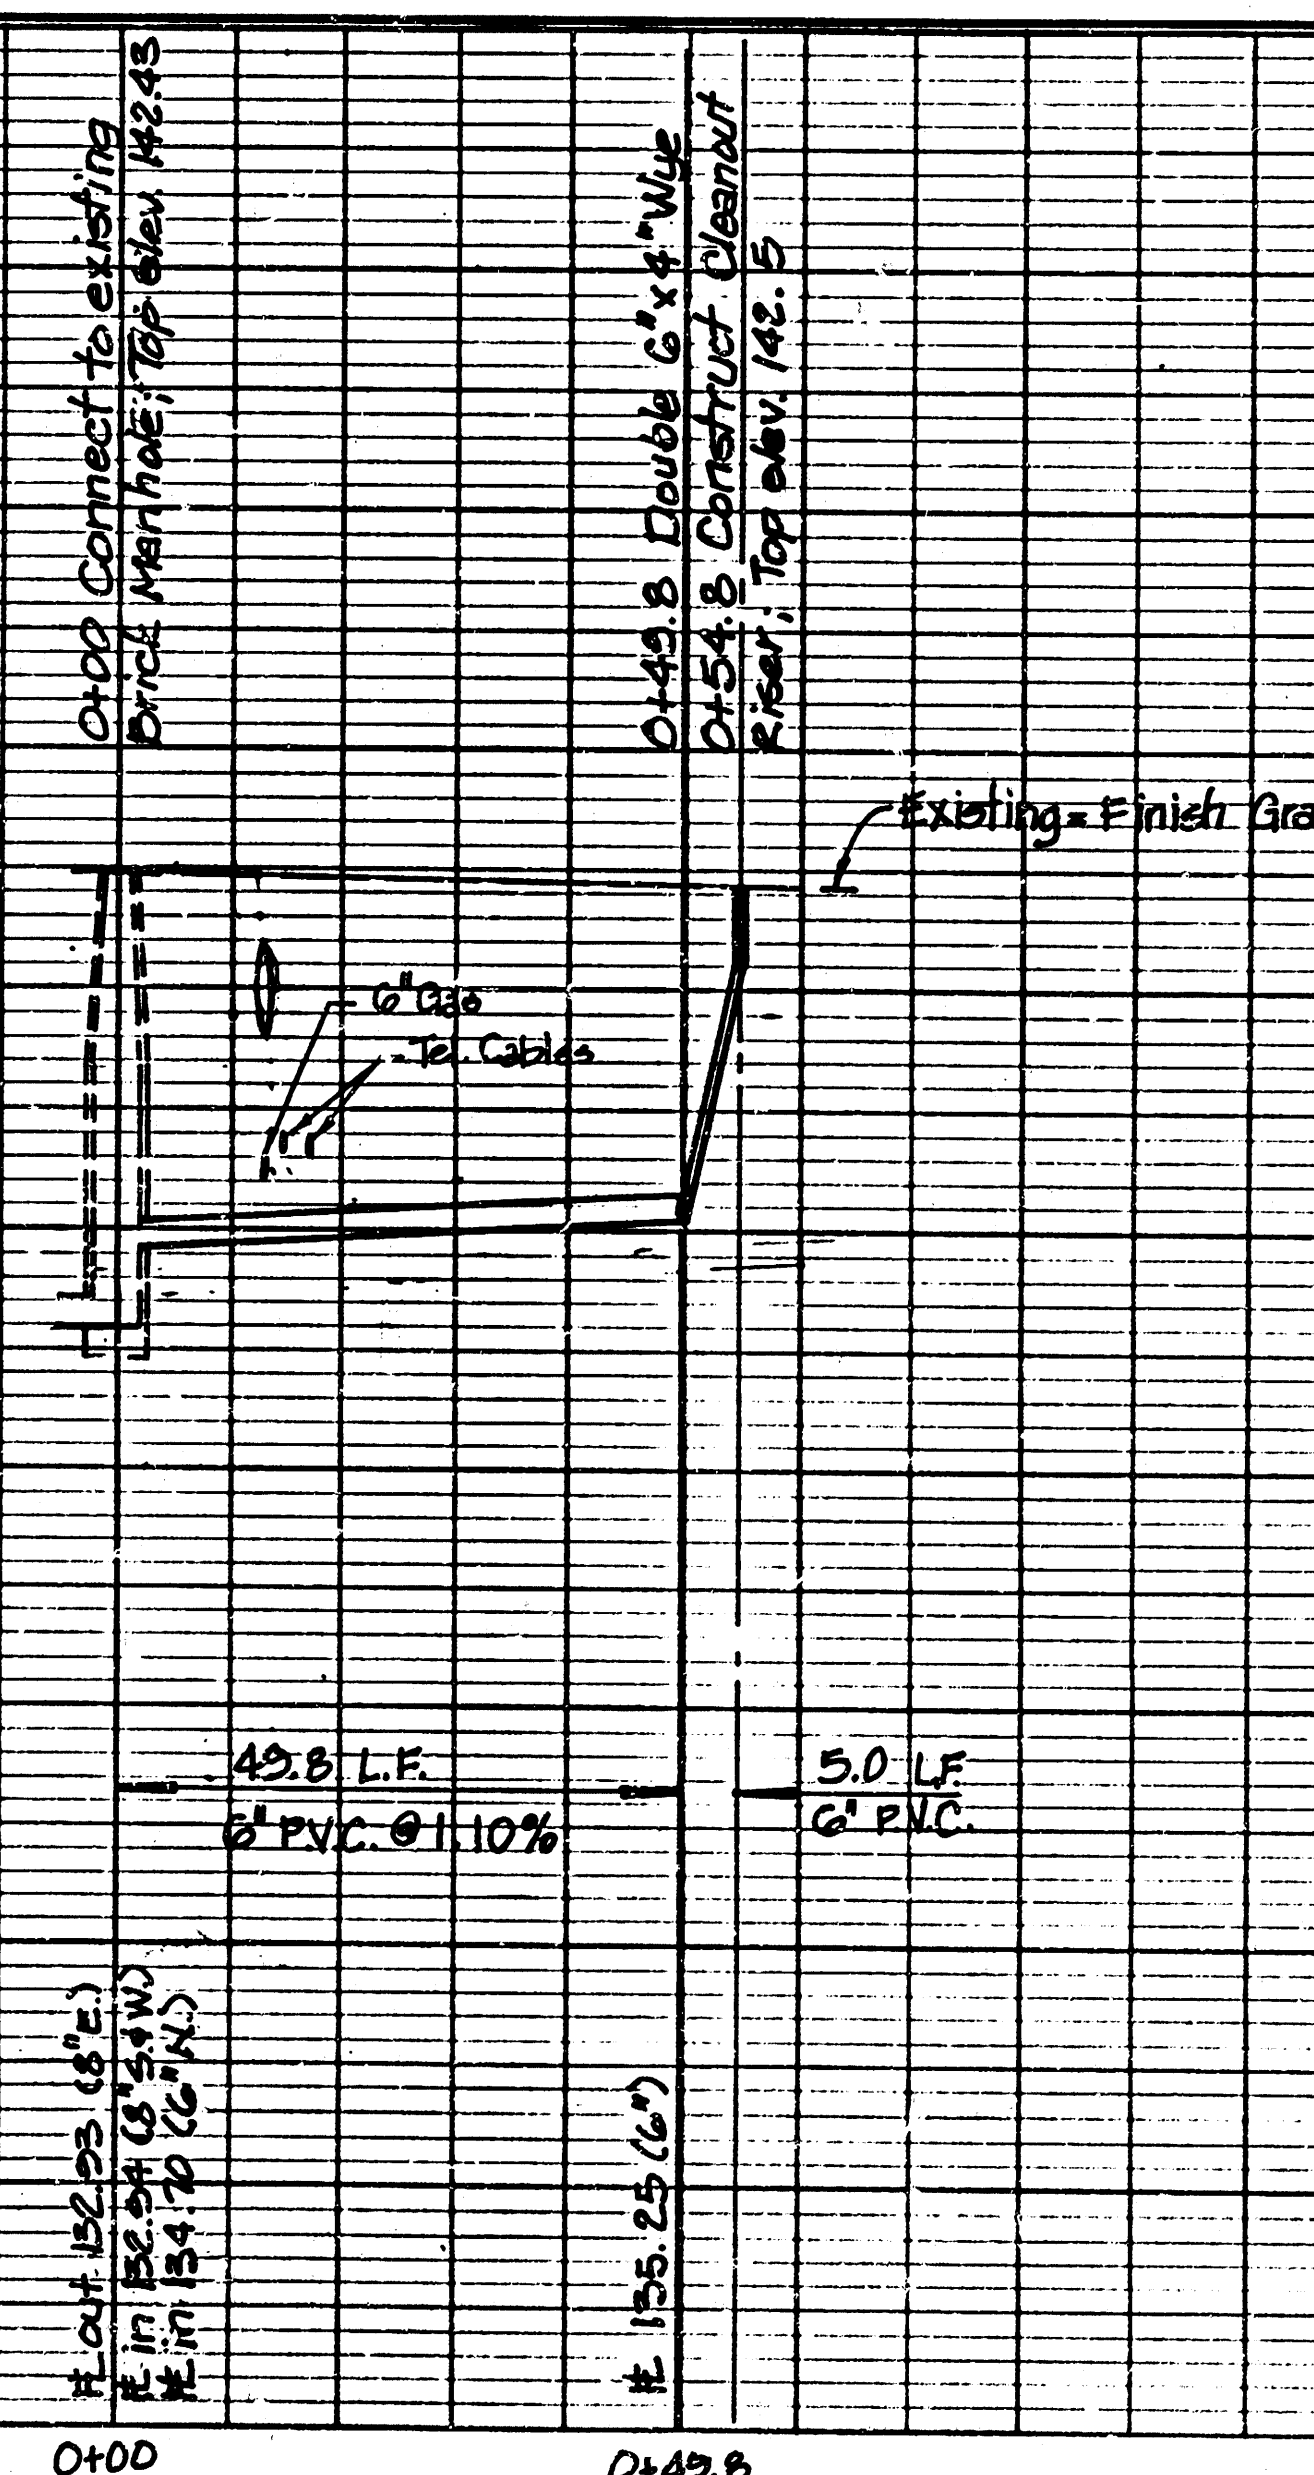

Booked
2-22-89
RDL

APPROVED AS NOTED
By CITY ENGINEER OF WICHITA

Sanitary Sewers
Storm Sewers
Driveway Approaches
Water Mains
Paving

NOTE TO CONTRACTOR

INSPECTION AND TESTING FOR THIS PROJECT IS TO BE PROVIDED BY A LICENSED CONSULTING ENGINEERING FIRM UNDER CONTRACT WITH THE OWNER/DEVELOPER. SAID INSPECTION TO BE IN ACCORDANCE WITH THE CITY OF WICHITA STANDARD CONSTRUCTION ENGINEERING PRACTICES AND CERTIFIED BY A LICENSED PROFESSIONAL ENGINEER. NO WORK SHALL BE PERFORMED IN DEDICATED BASEMENTS OR PUBLIC RIGHT-OF-WAY BY THE CONTRACTOR WITHOUT SUCH INSPECTION NOR SHALL ANY WORK BE COMMENCED WITHOUT WRITTEN AUTHORIZATION BY THE CITY ENGINEER.


As built - no revisions 11-22-89

PRIVATE SANITARY SEWER EXTENSION
TO SERVE LOTS 6 & 7, BUSHONG ADDITION
229PPS (607861)

BAUGHMAN COMPANY, P.A.
SURVEYING & ENGINEERING
310222-7271 • 315 ELLIS • WICHITA, KANSAS 67211

Design: TCR Drawn: TCR Approved: 10-26-89 Scale: 1"=20'

FILMED FROM THE BEST
AVAILABLE COPY

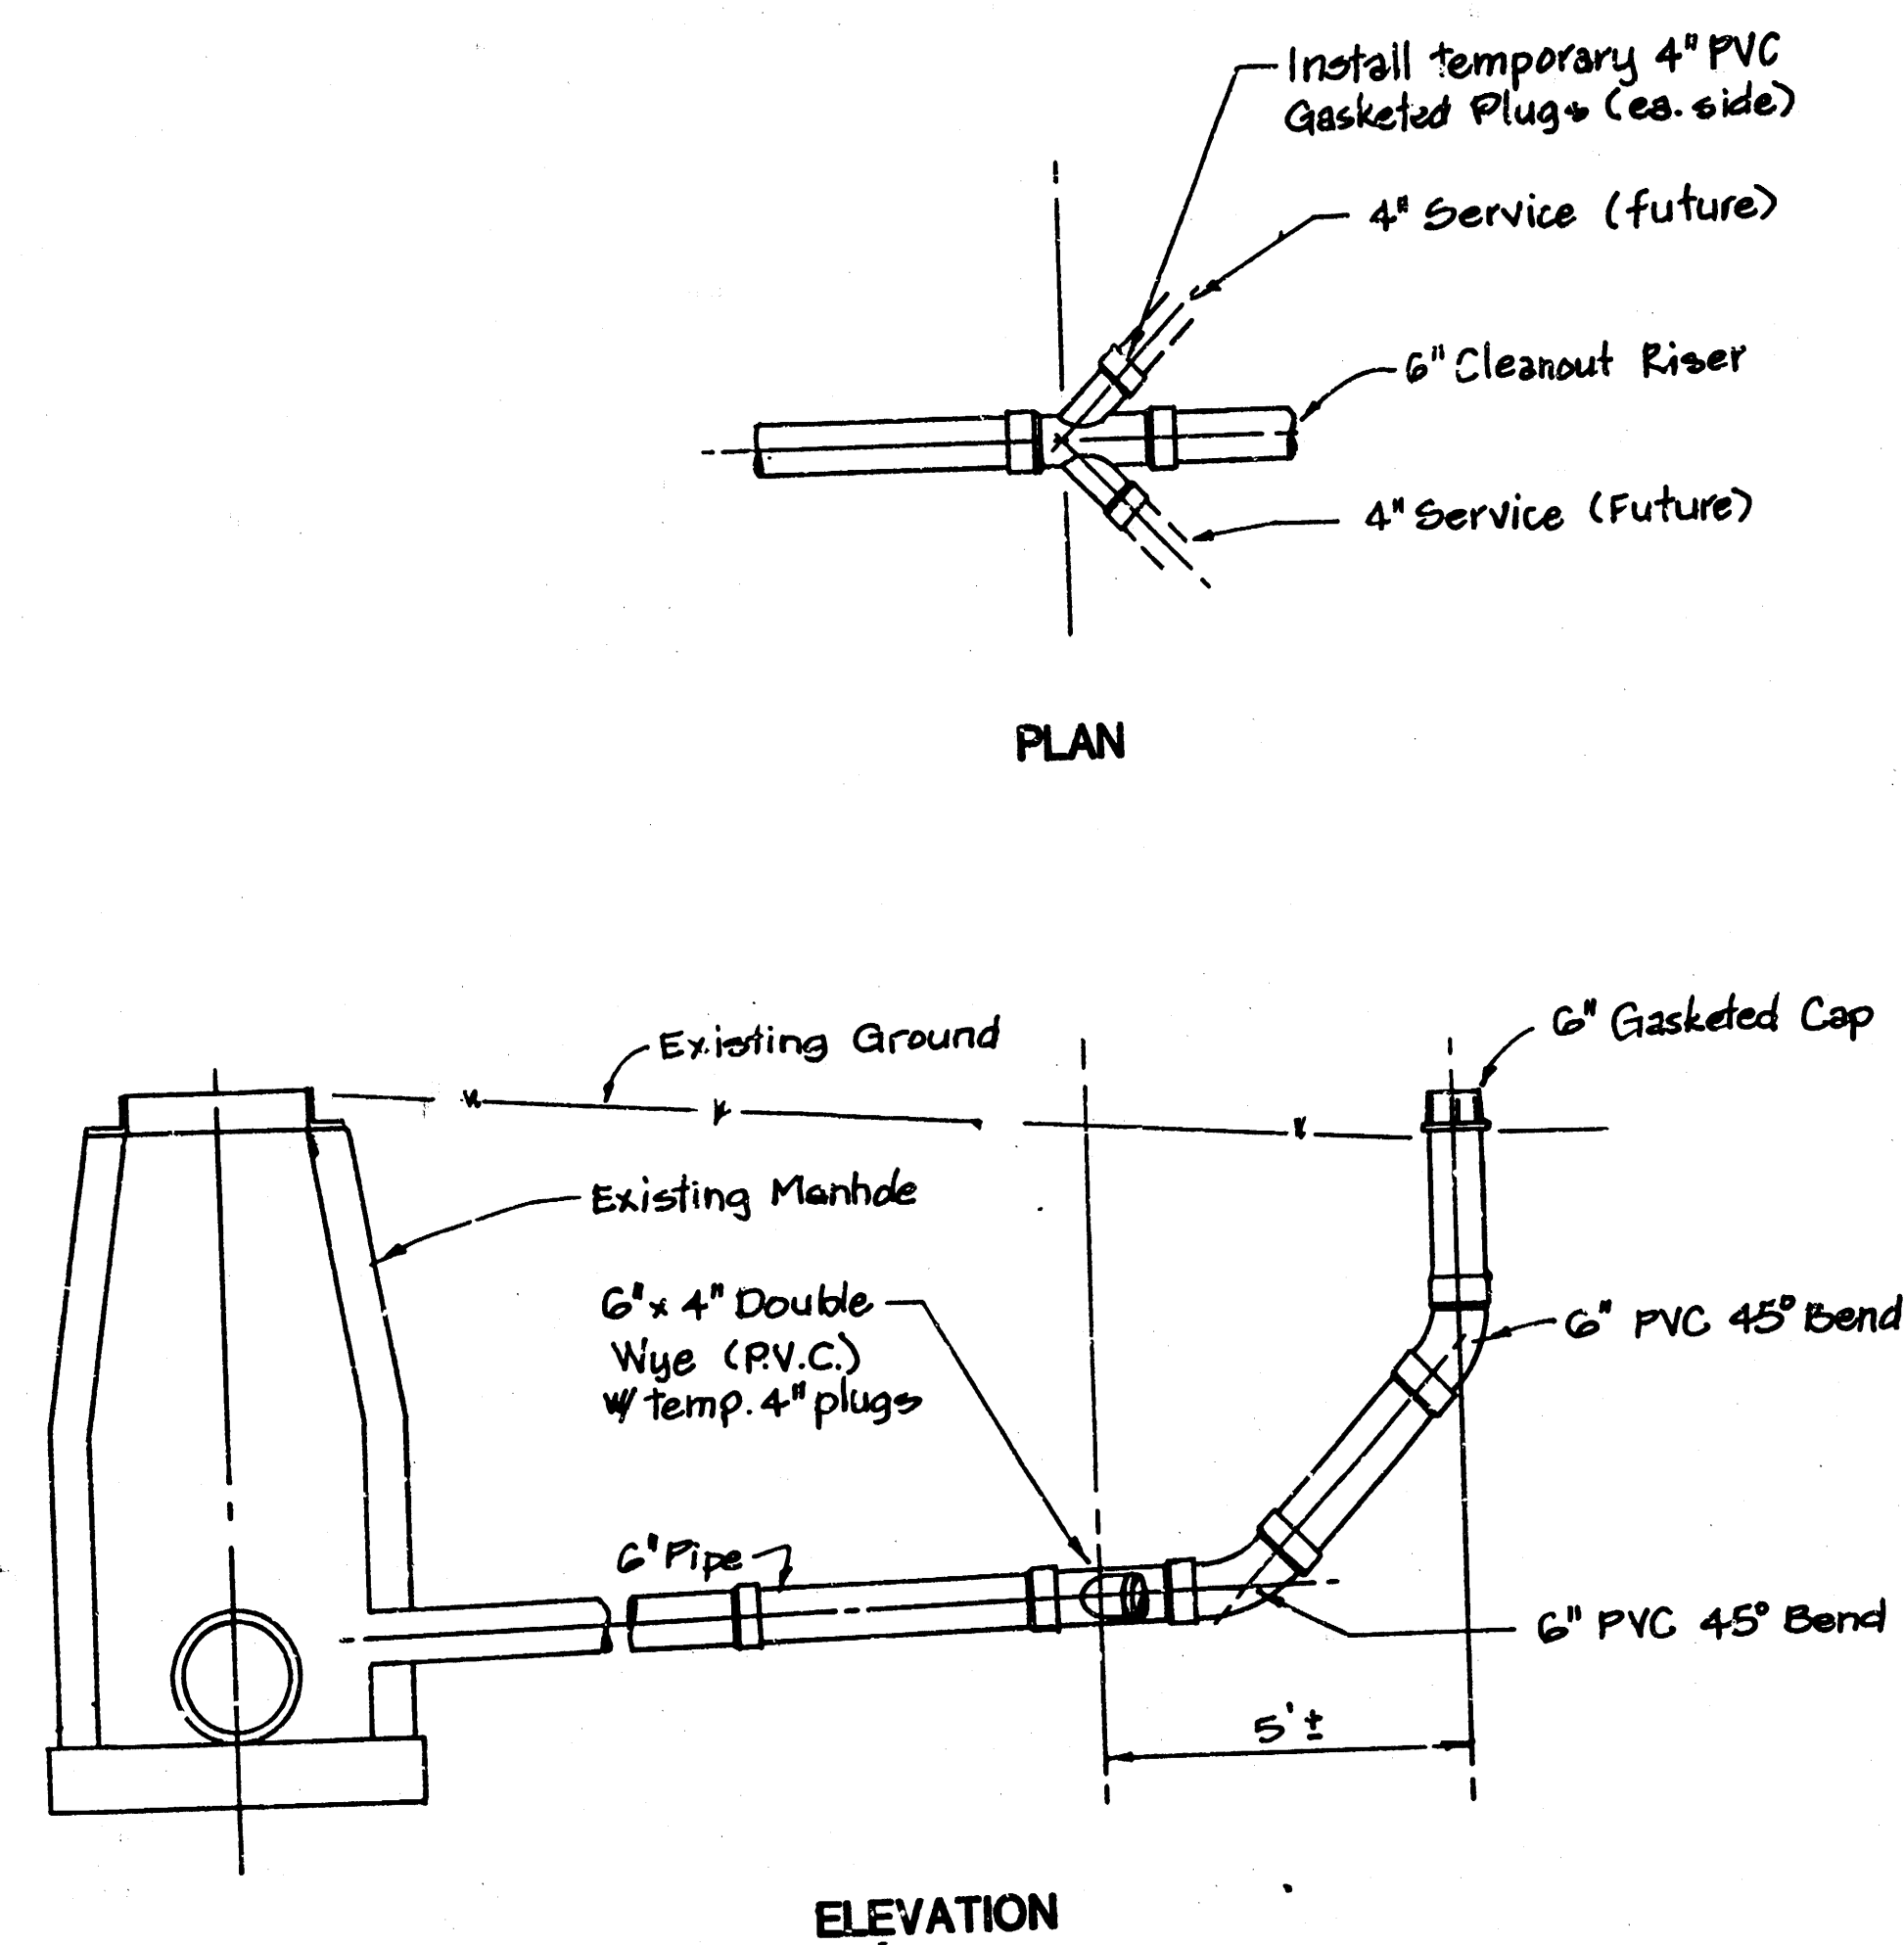

This site plan shows the layout for a proposed driveway and parking area on Lot 6, which is an addition to Lot 7. The plan includes the following details:

- Lot 6:** The main area for the new driveway and parking. It contains a 20' x 20' utility easement and a 24" RCP (Reinforced Concrete Pipe) for the driveway. The driveway is 24" RCP and is to be resurfaced with disturbed area of drive thread gravel.
- Lot 7:** The adjacent lot to the east. It contains a 24" tree and a 24" RCP.
- Proposed Construction:** A 24" RCP driveway and a 24" RCP parking area. The driveway is to be resurfaced with disturbed area of drive thread gravel.
- Easements:** A 20' x 20' utility easement is shown on Lot 6. A 24" tree is located on Lot 7.
- Existing Features:** A 24" RCP is shown on Lot 7. A 24" RCP is shown on Lot 6. A 24" RCP is shown on Lot 7.
- Other Features:** A 24" RCP is shown on Lot 7. A 24" RCP is shown on Lot 6. A 24" RCP is shown on Lot 7.

GENERAL NOTES


1. Contractor will be required to provide a minimum advance notice of twenty-four (24) hours to utility companies prior to starting any excavation as follows:

Kansas One-Call 1-800-344-7233

The Contractor must notify the following in case of an emergency:

Cablevision	262-4270 or
	263-2061
K.P. & L. Gas Service Company	263-7511
Kansas Gas & Electric	264-1141
Arkla Gas Company	942-8350 or
	263-8161
Southwest Bell Telephone Company	i-571-2611
City of Wichita Water Department	268-4908
City of Wichita Sewer Maintenance	268-4071

2. The Contractor shall give all property owners and/or tenants of developed property directly abutting the construction of this project a minimum of ten (10) days advance notice prior to start of construction.
3. The Contractor shall be responsible for preserving property irons. The Contractor will be required to re-establish any property irons which are damaged or destroyed by his construction operations. Such irons shall be re-established by a licensed land surveyor in accordance with state law.
4. Traffic will not be affected by construction on this project.

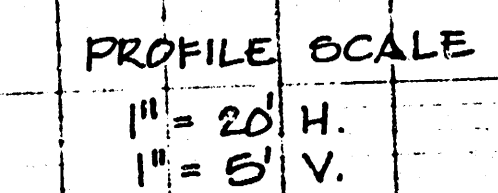

APPROVED AS NOTED

Sanitary Sewers VRH 11/7/89

Storm Sewers

Driveway Approach

Water Mains

Paving _____

NOTE TO CONTRACTOR

INSPECTION AND TESTING FOR THIS PROJECT IS TO BE PROVIDED BY A LICENSED CONSULTING ENGINEERING FIRM UNDER CONTRACT WITH THE OWNER/DEVELOPER. SAID INSPECTION TO BE IN ACCORDANCE WITH THE CITY OF CHICAGO STANDARD CONSTRUCTION ENGINEERING PRACTICES AND CERTIFIED BY A LICENSED PROFESSIONAL ENGINEER. NO WORK SHALL BE COMPLETED OR DEDICATED TO TRAFFIC WITHOUT SUCH INSPECTION NOR SHALL ANY WORK BE COMMENCED WITHOUT WRITTEN AUTHORIZATION BY THE CITY ENGINEER.

Title
PRIVATE SANITARY SEWER EXTENSION
TO SERVE LOTS 6 & 7, BUSHONG ADD.
229PPS (607861)

BAUGHMAN COMPANY, P.A. SURVEYING & ENGINEERING 310/262-7271 • 315 ELLIS • WICHITA, KANSAS 67211				Sheet 1 of 1
Design: TCR	Drawn: TCR	Approved:	Date: 10-26-89	Scale: 1" = 20'

FILMED FROM THE BEST
AVAILABLE COPY.....