


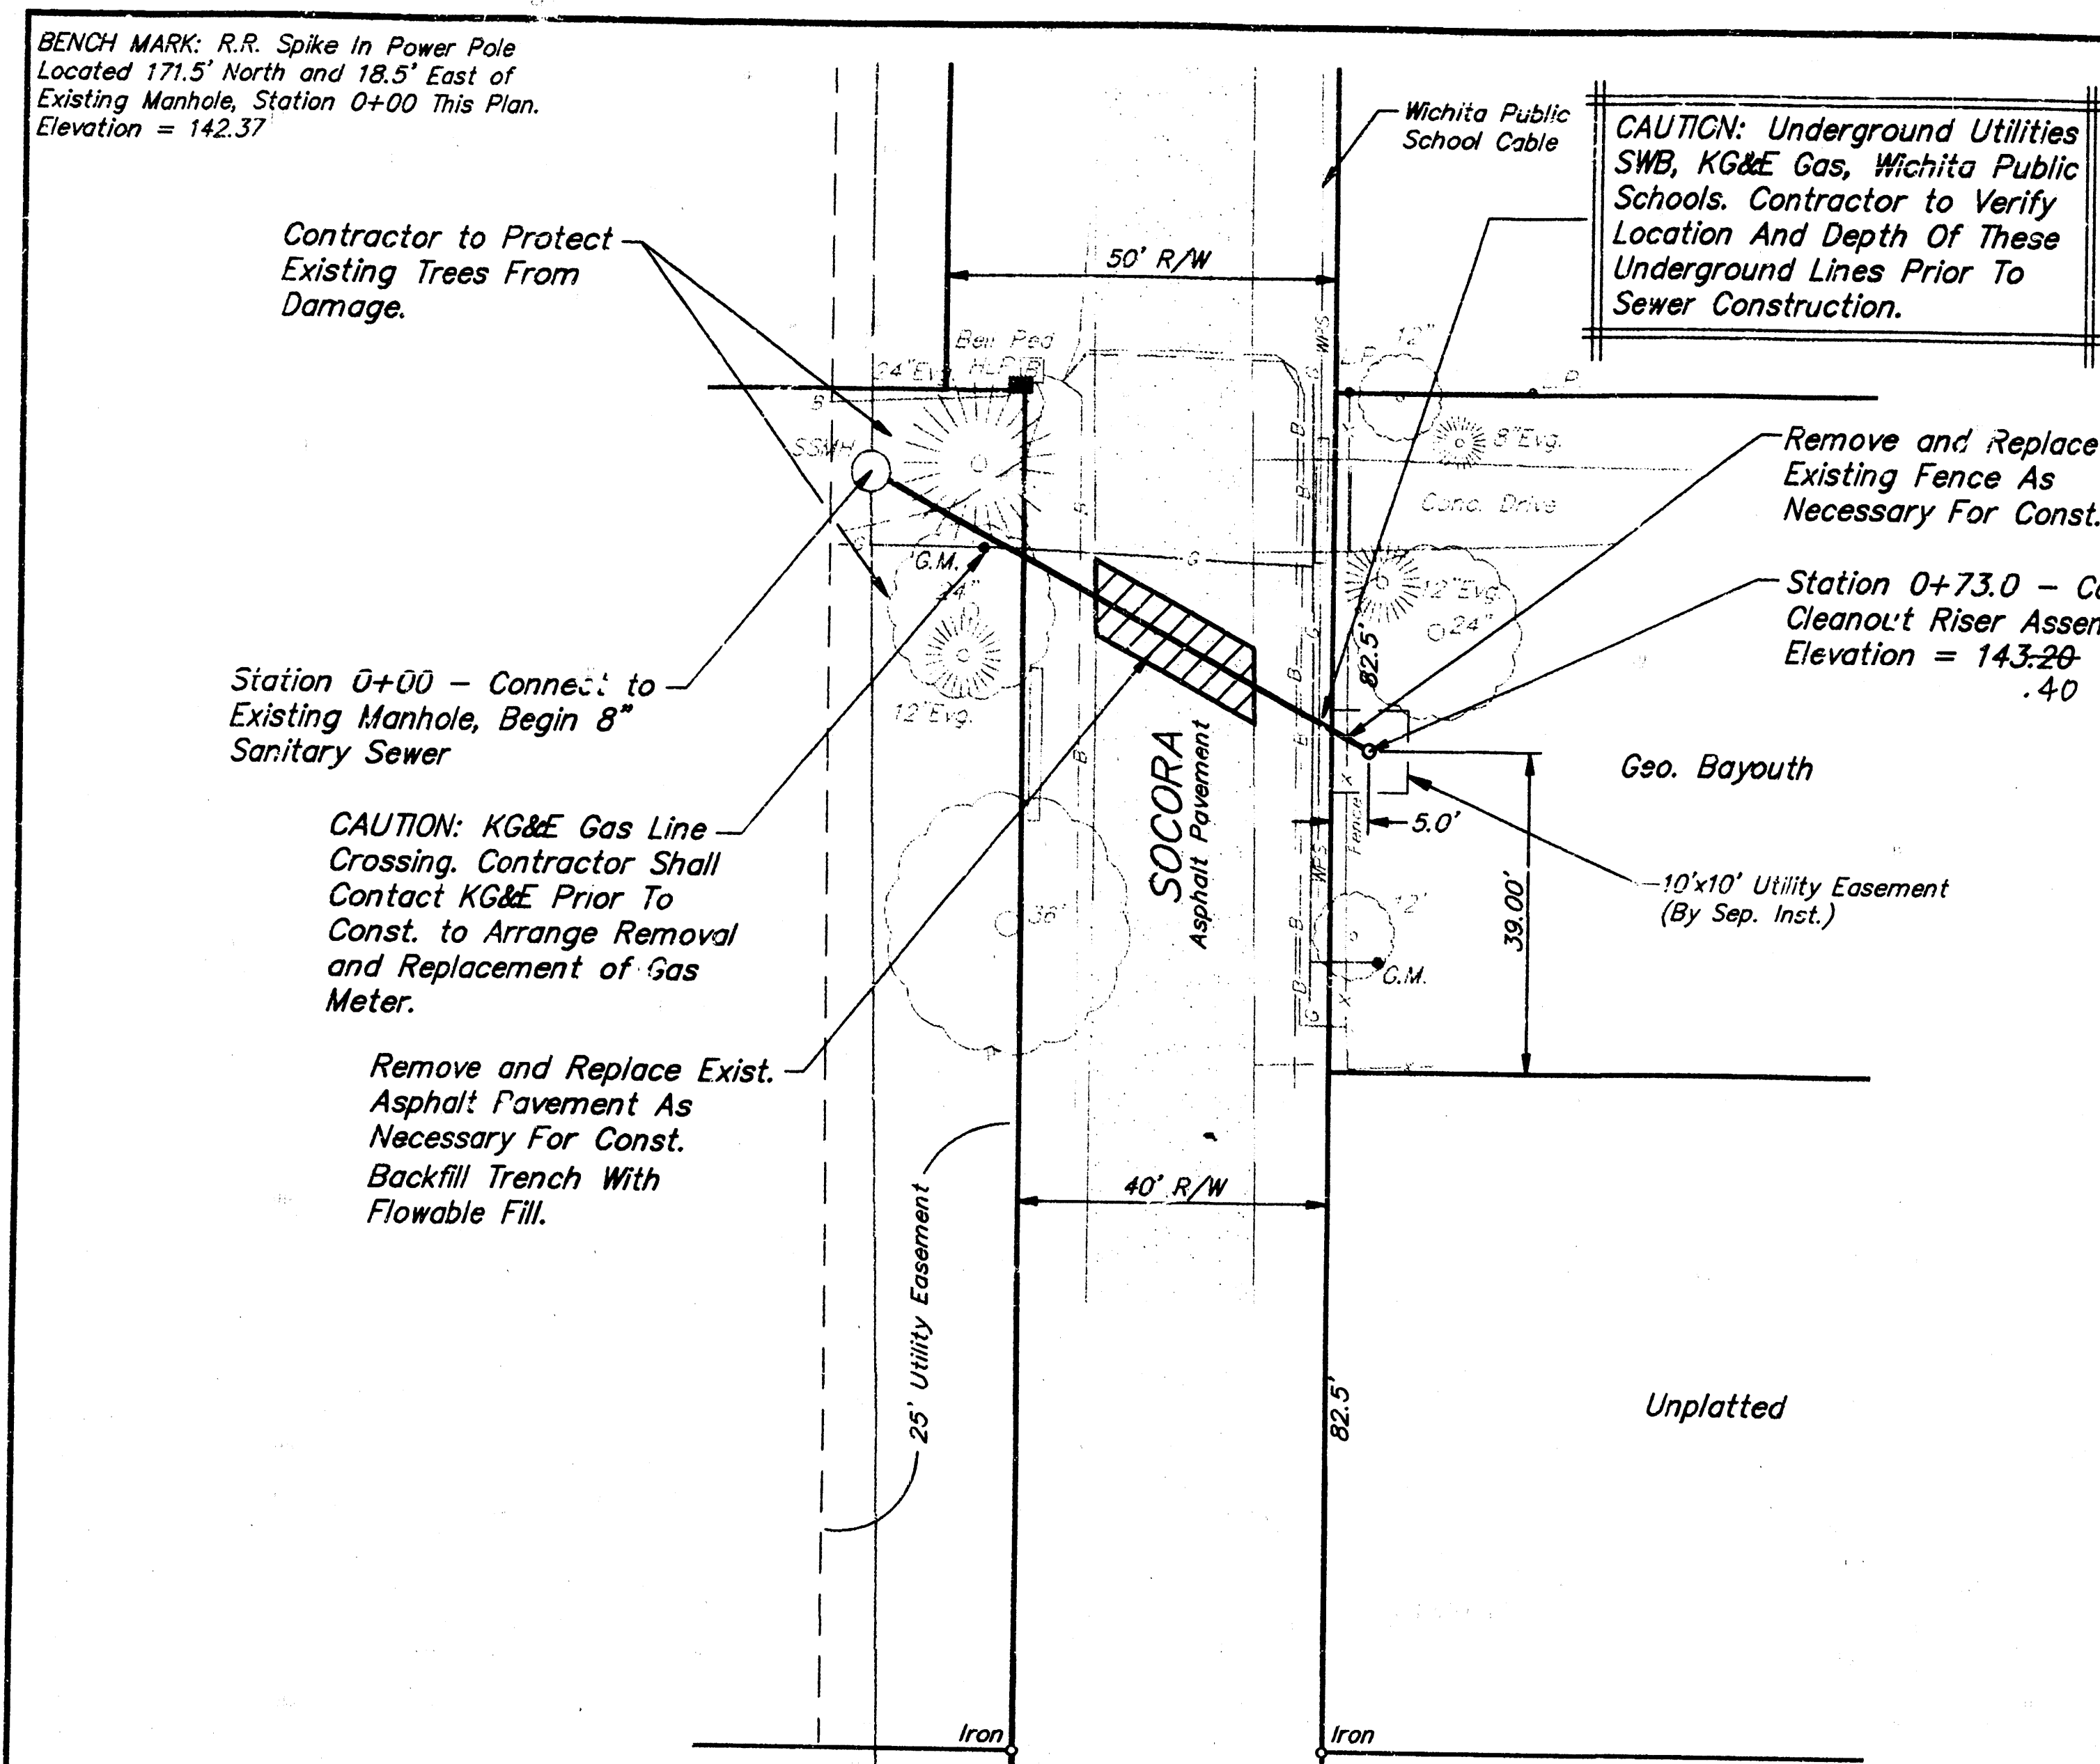


1. All Construction to be in compliance with City of Wichita Specifications.
2. The Contractor shall give all property owners and/or tenants of developed property directly abutting the construction of this project a minimum of ten (10) days advance notice prior to the start of construction.
3. The Contractor shall be responsible for preserving property irons. The Contractor will be required to re-establish any property irons which are damaged or destroyed by his construction operations. Such irons shall be re-established by a licensed land surveyor in accordance with state laws.
4. The Contractor shall maintain one open lane of traffic on Socora at all times during the construction of this project.
5. The Contractor shall be responsible for costs and arrangements for any necessary relocation of the KG&E Gas Meter.
6. Contractor will be required to provide a minimum notice of twenty-four (24) hours to utility companies prior to starting any excavation as follows:

Kansas One-Call 687-2470

The Contractor must notify the following before construction and in case of an emergency.

K.P. & L. Gas Service Company 263-7511
Kansas Gas & Electric 264-1141
Arkio Gas Company 942-8350 or 263-8161
Southwestern Bell Telephone Company 1-571-2611
Cablevision 262-4270 or 263-2061
City of Wichita Water Department 268-4908
City of Wichita Sewer Maintenance 268-4071

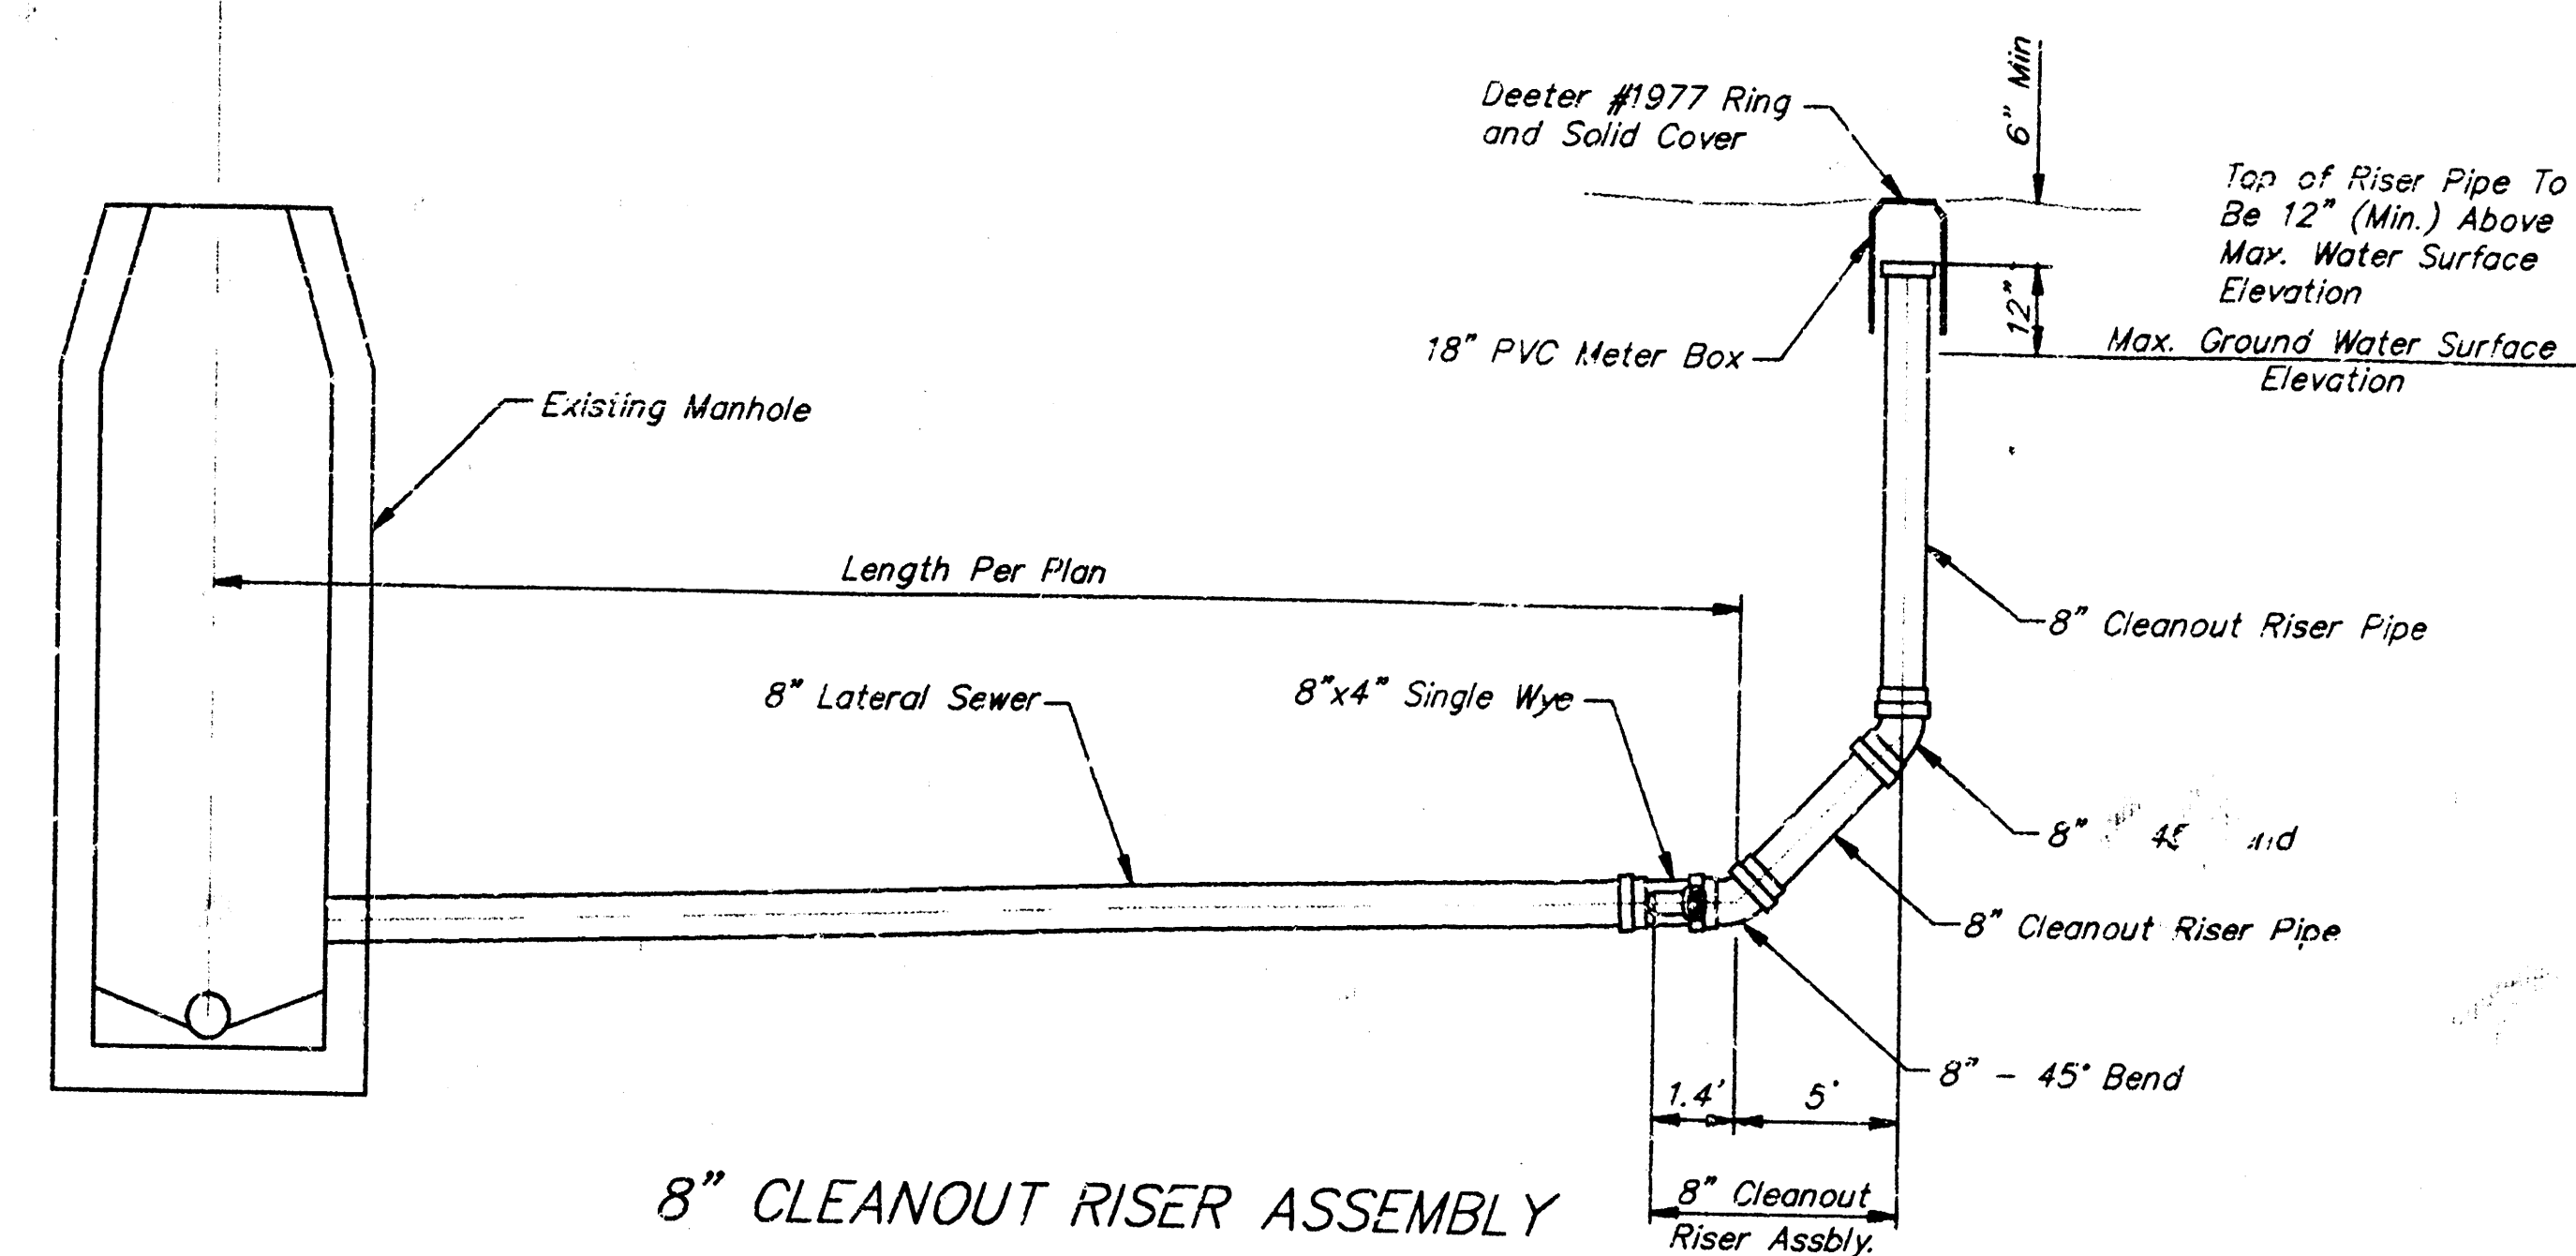

8" CLEANOUT RISER ASSEMBLY

INSPECTION AND TESTING FOR THIS PROJECT TO BE PROVIDED BY A LICENSED CONSULTING ENGINEERING FIRM UNDER CONTRACT WITH THE OWNER/DEVELOPER. SAID INSPECTION TO BE IN ACCORDANCE WITH THE CITY OF WICHITA STANDARD CONSTRUCTION ENGINEERING PRACTICES AND CERTIFIED BY A LICENSED PROFESSIONAL ENGINEER. NO WORK SHALL BE PERFORMED IN DEDICATED EASEMENTS OR PUBLIC RIGHT-OF-WAY BY THE CONTRACTOR WITHOUT SUCH INSPECTIONS. WORK SHALL BE COMMENCED IN DEDICATED EASEMENTS OR PUBLIC RIGHT-OF-WAY WITHOUT WRITTEN AUTHORIZATION BY THE CITY ENGINEER.

APPROVED AS NOTED
By CITY ENGINEER OF WICHITA



Sanitary Sewers VRH 5/20/93

Storm Sewers _____

Driveway Approaches _____

Water Mains _____

Paving _____

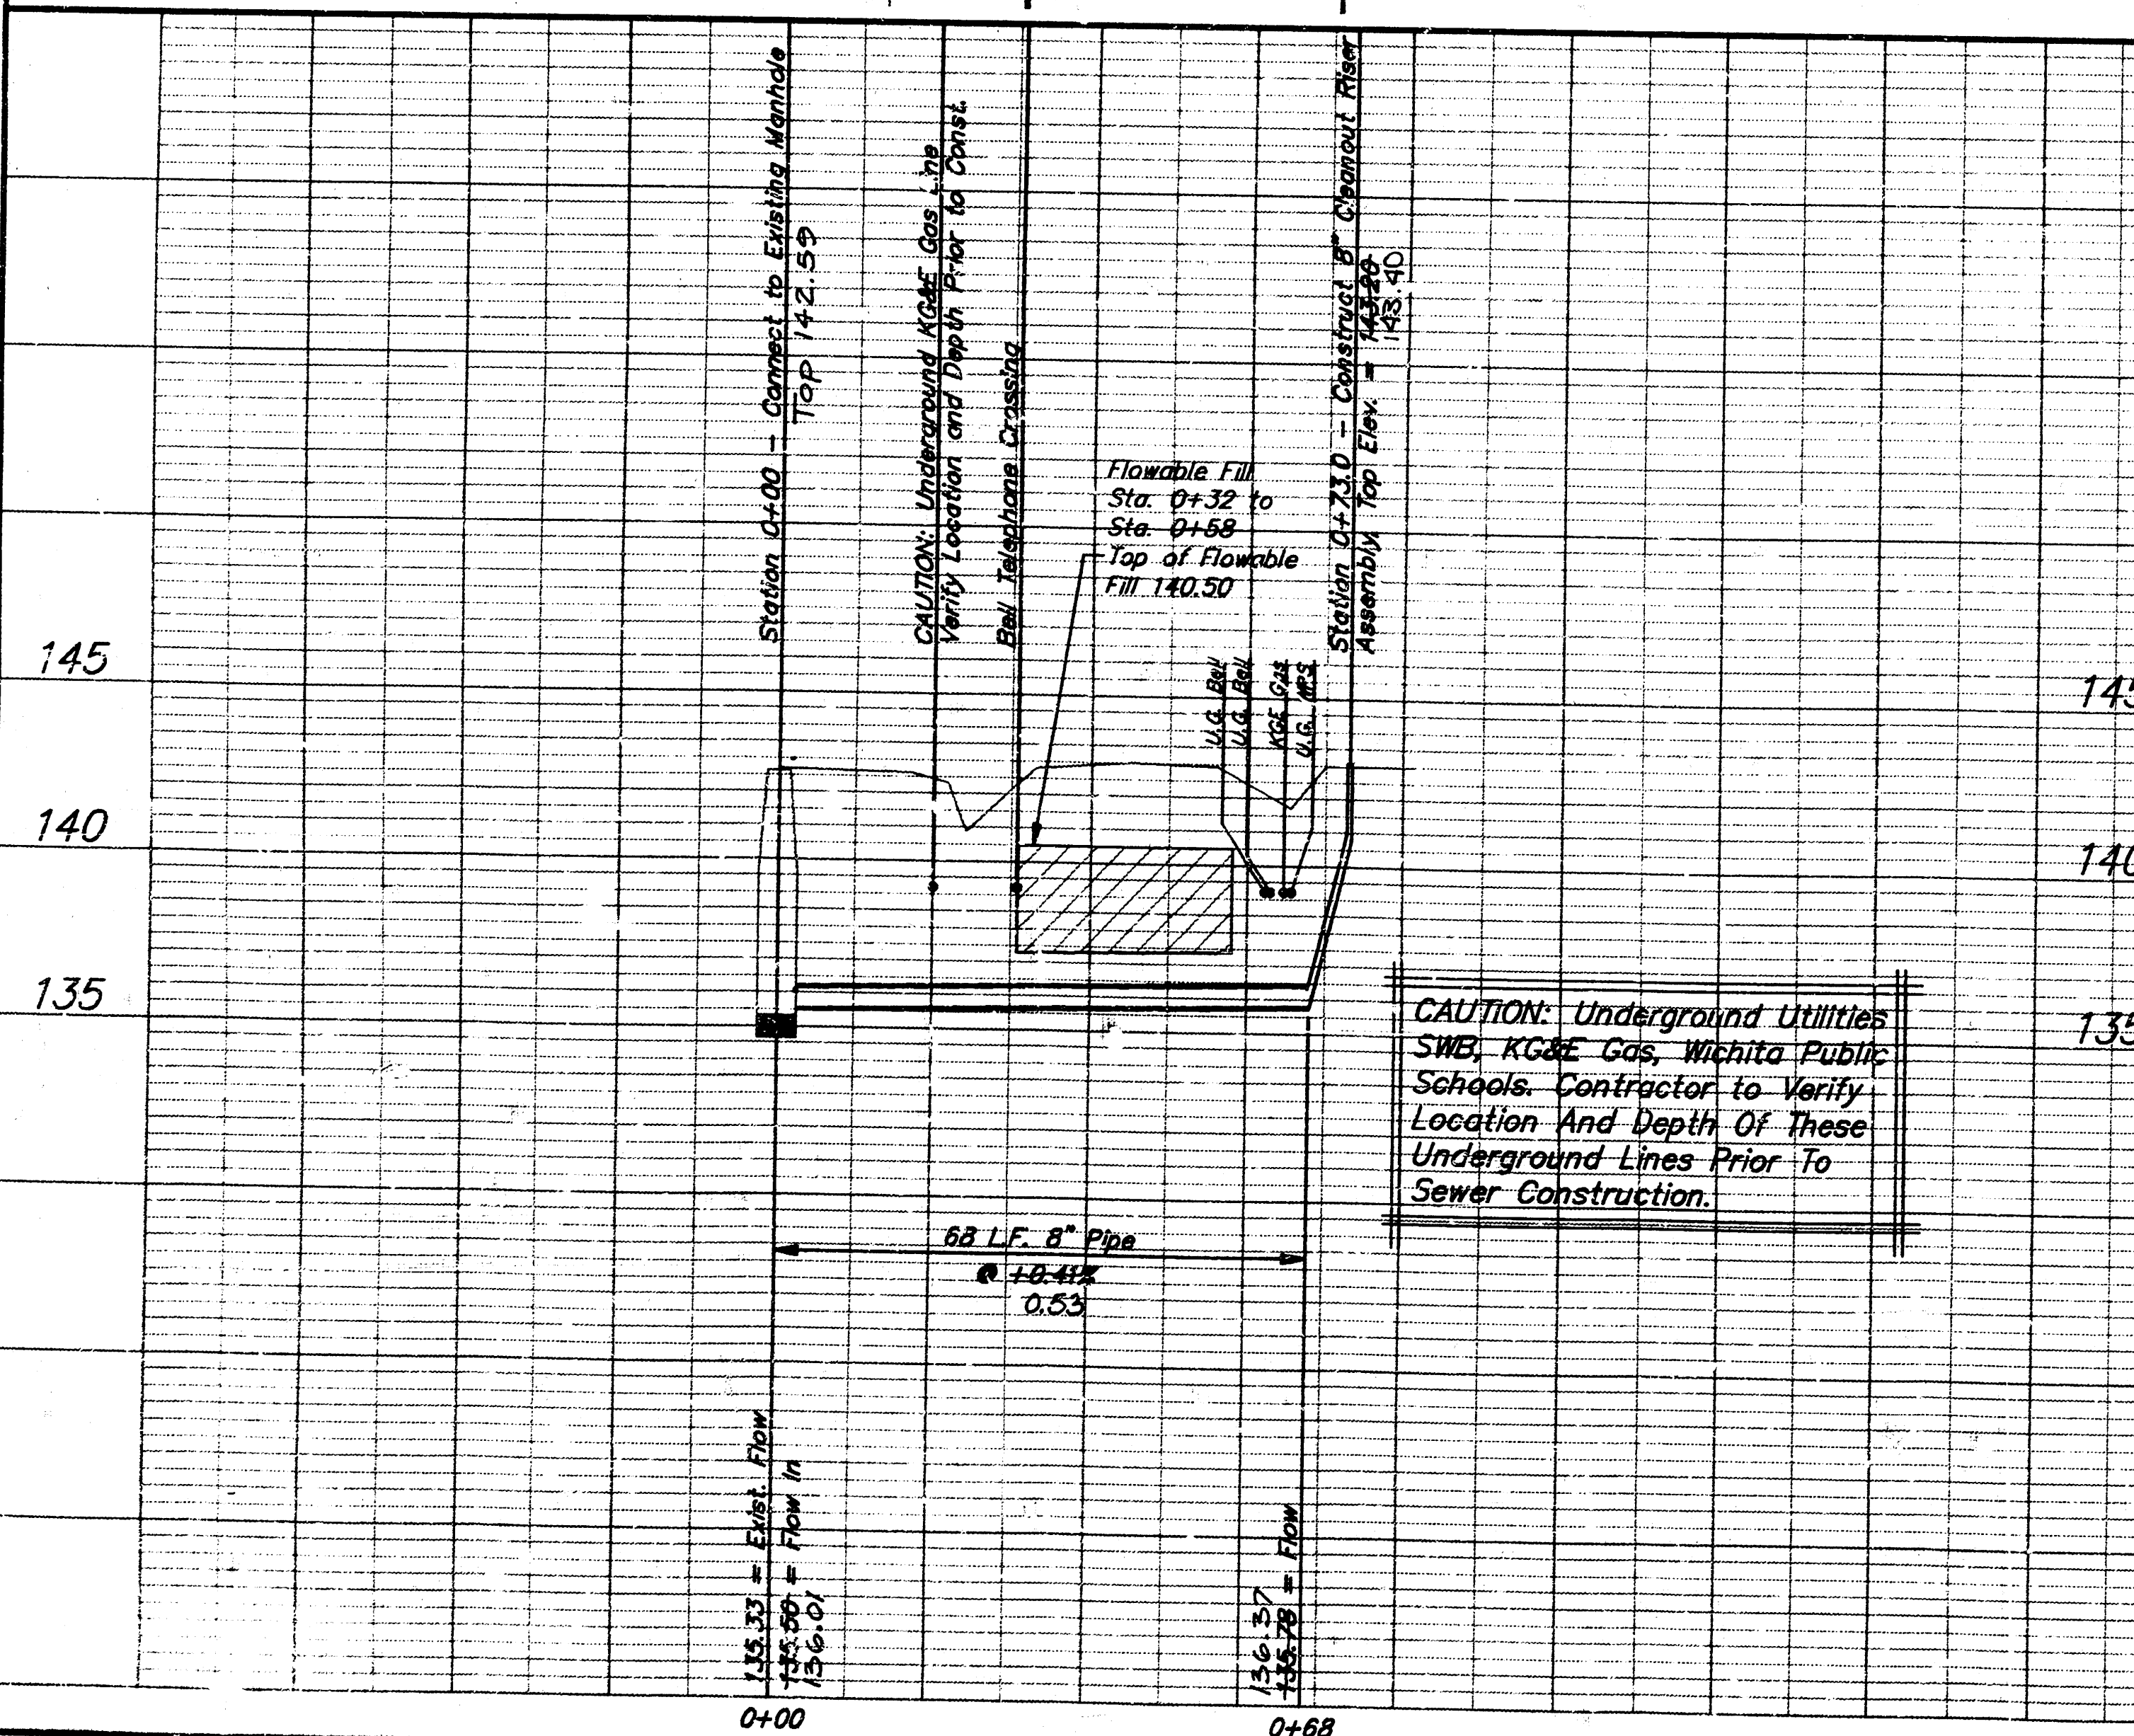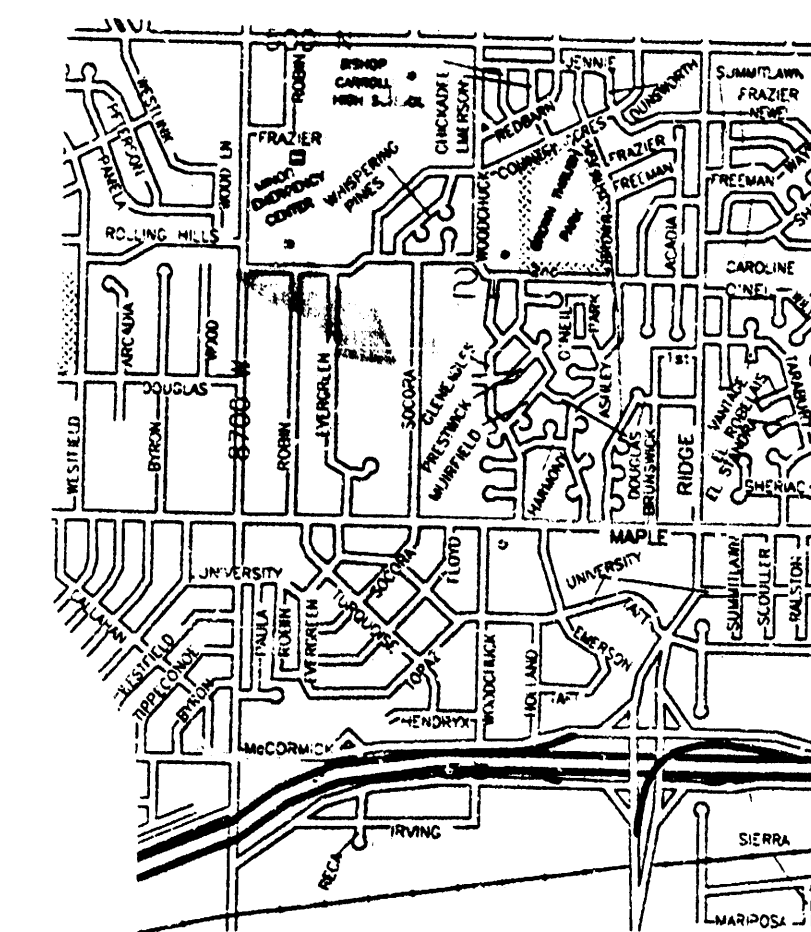

Booked 7-18-93
From SRB Buils

REVISED AS BUILT 6-4-93 JCR

PRIVATE SANITARY SEWER EXTENSION SERVING 156 SOUTH SOCORA CITY OF WICHITA, KANSAS					
SRB		841 SOUTH HILLSIDE WICHITA, KANSAS 67211		316-652-7754 FAX 652-7932	
SAVOY, RUGGLES & BOHM, P.A. ENGINEERING & SURVEYING					
PROJECT NUMBER 392 PPS					
DRAWN C. Bohm	DESIGN C. Bohm	REVIEW TCR	DATE 5/18/93	UTILITY TCR	SRB JOB ASE
					1
					1