

SANITARY SEWER SYSTEM

TO SERVE CENTRAL MAIZE MIDDLE SCHOOL

PROJECT NUMBER: 1286 PPS
OCA # 607861

GENERAL NOTES

1. Contractor will be required to notify Kansas One-Call (687-2470), a minimum of 48 hours in advance of beginning any excavation.

The Contractor must notify the following utility companies in case of an emergency:

Cox Communications	262-0661
Kansas Gas Service	383-8600
Westar Energy	383-8600
Aquila Net	1-800-303-3337
Southwestern Bell Telephone Company	1-800-286-8313
City of Wichita Water Department	262-6000
City of Wichita Sewer Maintenance	262-6000

2. The Contractor shall give all property owners and/or tenants of developed property directly abutting the construction of this project a minimum of ten (10) days advance notice prior to start of construction.


3. The Contractor shall be responsible for preserving property irons. The Contractor will be required to re-establish any property irons which are damaged or destroyed by his construction operations. Such irons shall be re-established by a licensed land surveyor in accordance with state laws.

4. It shall be the responsibility of the Contractor to maintain sewage flow during construction of this project. The Contractor's plan for maintaining sewage flow shall be approved by the Engineer prior to construction.

5. The Contractor shall seed and fertilize all disturbed turf areas upon completion of construction (incidental to bid item for site clearing and restoration).

6. Easement areas are to be final graded as shown on sheet 4.

7. The Contractor shall install Phase 1 Soil Erosion Prevention measures prior to any disturbance of the site. See sheets 7-9.

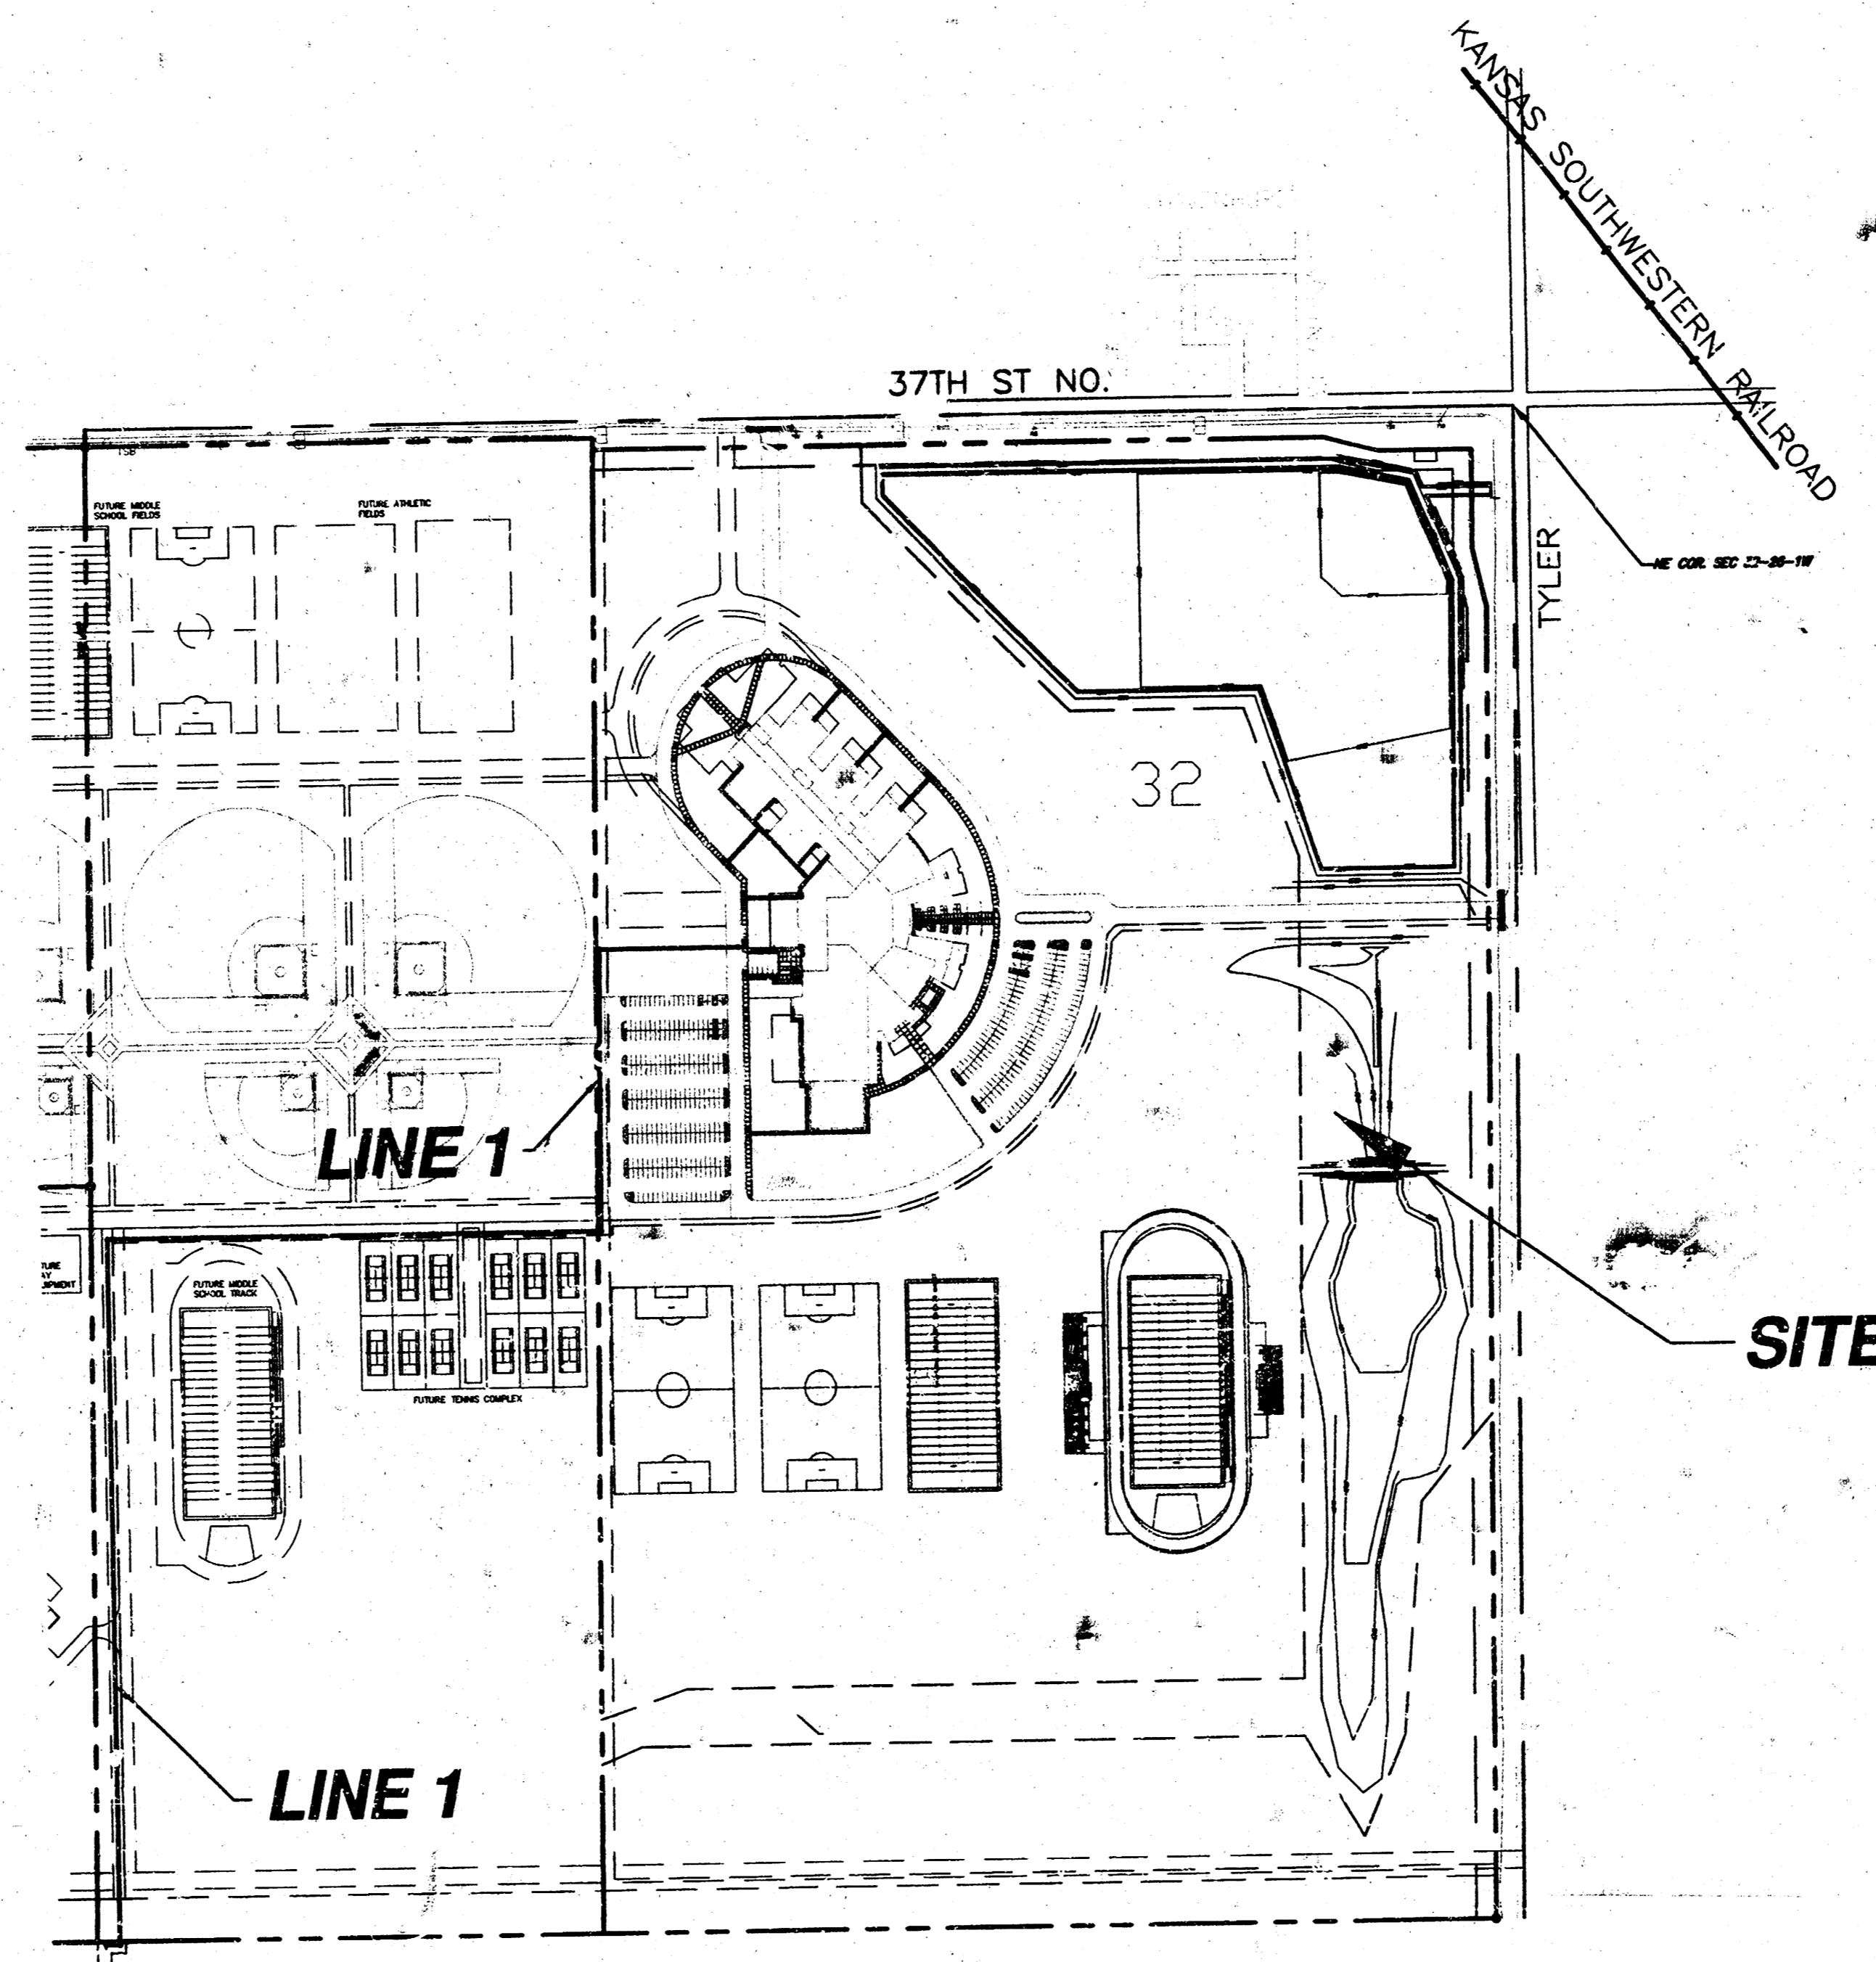

INDEX OF SHEETS

1. COVER SHEET
2. STANDARD TYPE 'P' MANHOLE DETAILS
3. MANHOLE FRAME AND COVER
- 4.-6. PLAN/PROFILES

BENCH MARKS

BM #1 60 d SPIKE IN NORTH POLE OF "H" FRAME TRANSMISSION LINE, EAST OF S.E. COR., N.E. 1/4, SEC. 32. ELEV. = 1363.49 N.G.V.D.

BM #2 TOP OF IRON, N.W. COR., N.E. 1/4, N.W. 1/4, SECTION 32. ELEV. = 1353.38 N.G.V.D.

AS-BUILTS (03/12/2003)
Inspector: Tim Kelly / Mike Shump (Ruggles & Bohm)
Contractor: Mies Construction (Albert)
Start Date: Line A 3-15-02 → 3-20-02
Line 1 1-17-03 → 2-18-03

BUILT PER PLAN


APPROVED AS NOTED BY CITY ENGINEER OF WICHITA
Sanitary Sewers <u>VRH 11/07/02</u>
Storm Sewers _____
Driveway Approaches _____
Water Mains _____
Paving _____

NOTE TO CONTRACTORS


Inspection and testing for this project are to be provided by a Licensed Consulting Engineering Firm under contract with the Owner/Developer. Said inspection to be in accordance with the City of Wichita standard construction engineering practices and certified by a Licensed Professional Engineer. No work shall be performed in dedicated easements or public right-of-way by the Contractor without such inspection, nor shall any work be commenced without written authorization by the City Engineer.

Scale 1" = 300'

8/21/03
RDL
PDE




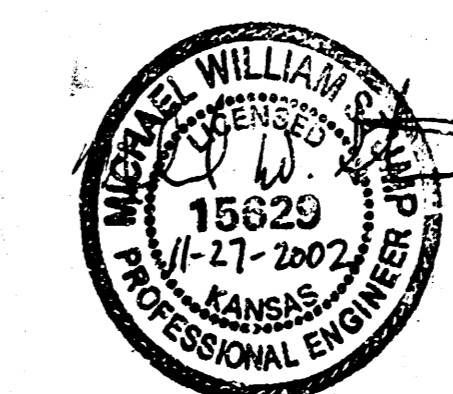


CITY OF WICHITA, KANSAS
NEIL D. CABLE, P.E. - CITY ENGINEER

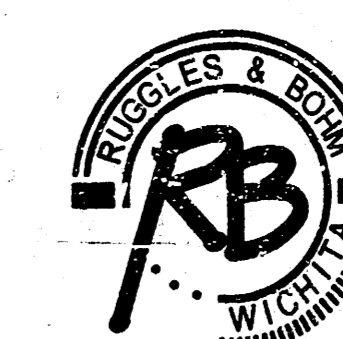

Ruggles & Bohm, P.A.
Engineering, Surveying, Land Planning
924 North Main
Wichita, Kansas 67203
www.rbkansas.com
(316) 264-8008
(316) 264-4621 fax
E-mail: info@rbkansas.com

SEWER APPURTENANCES DETAILS

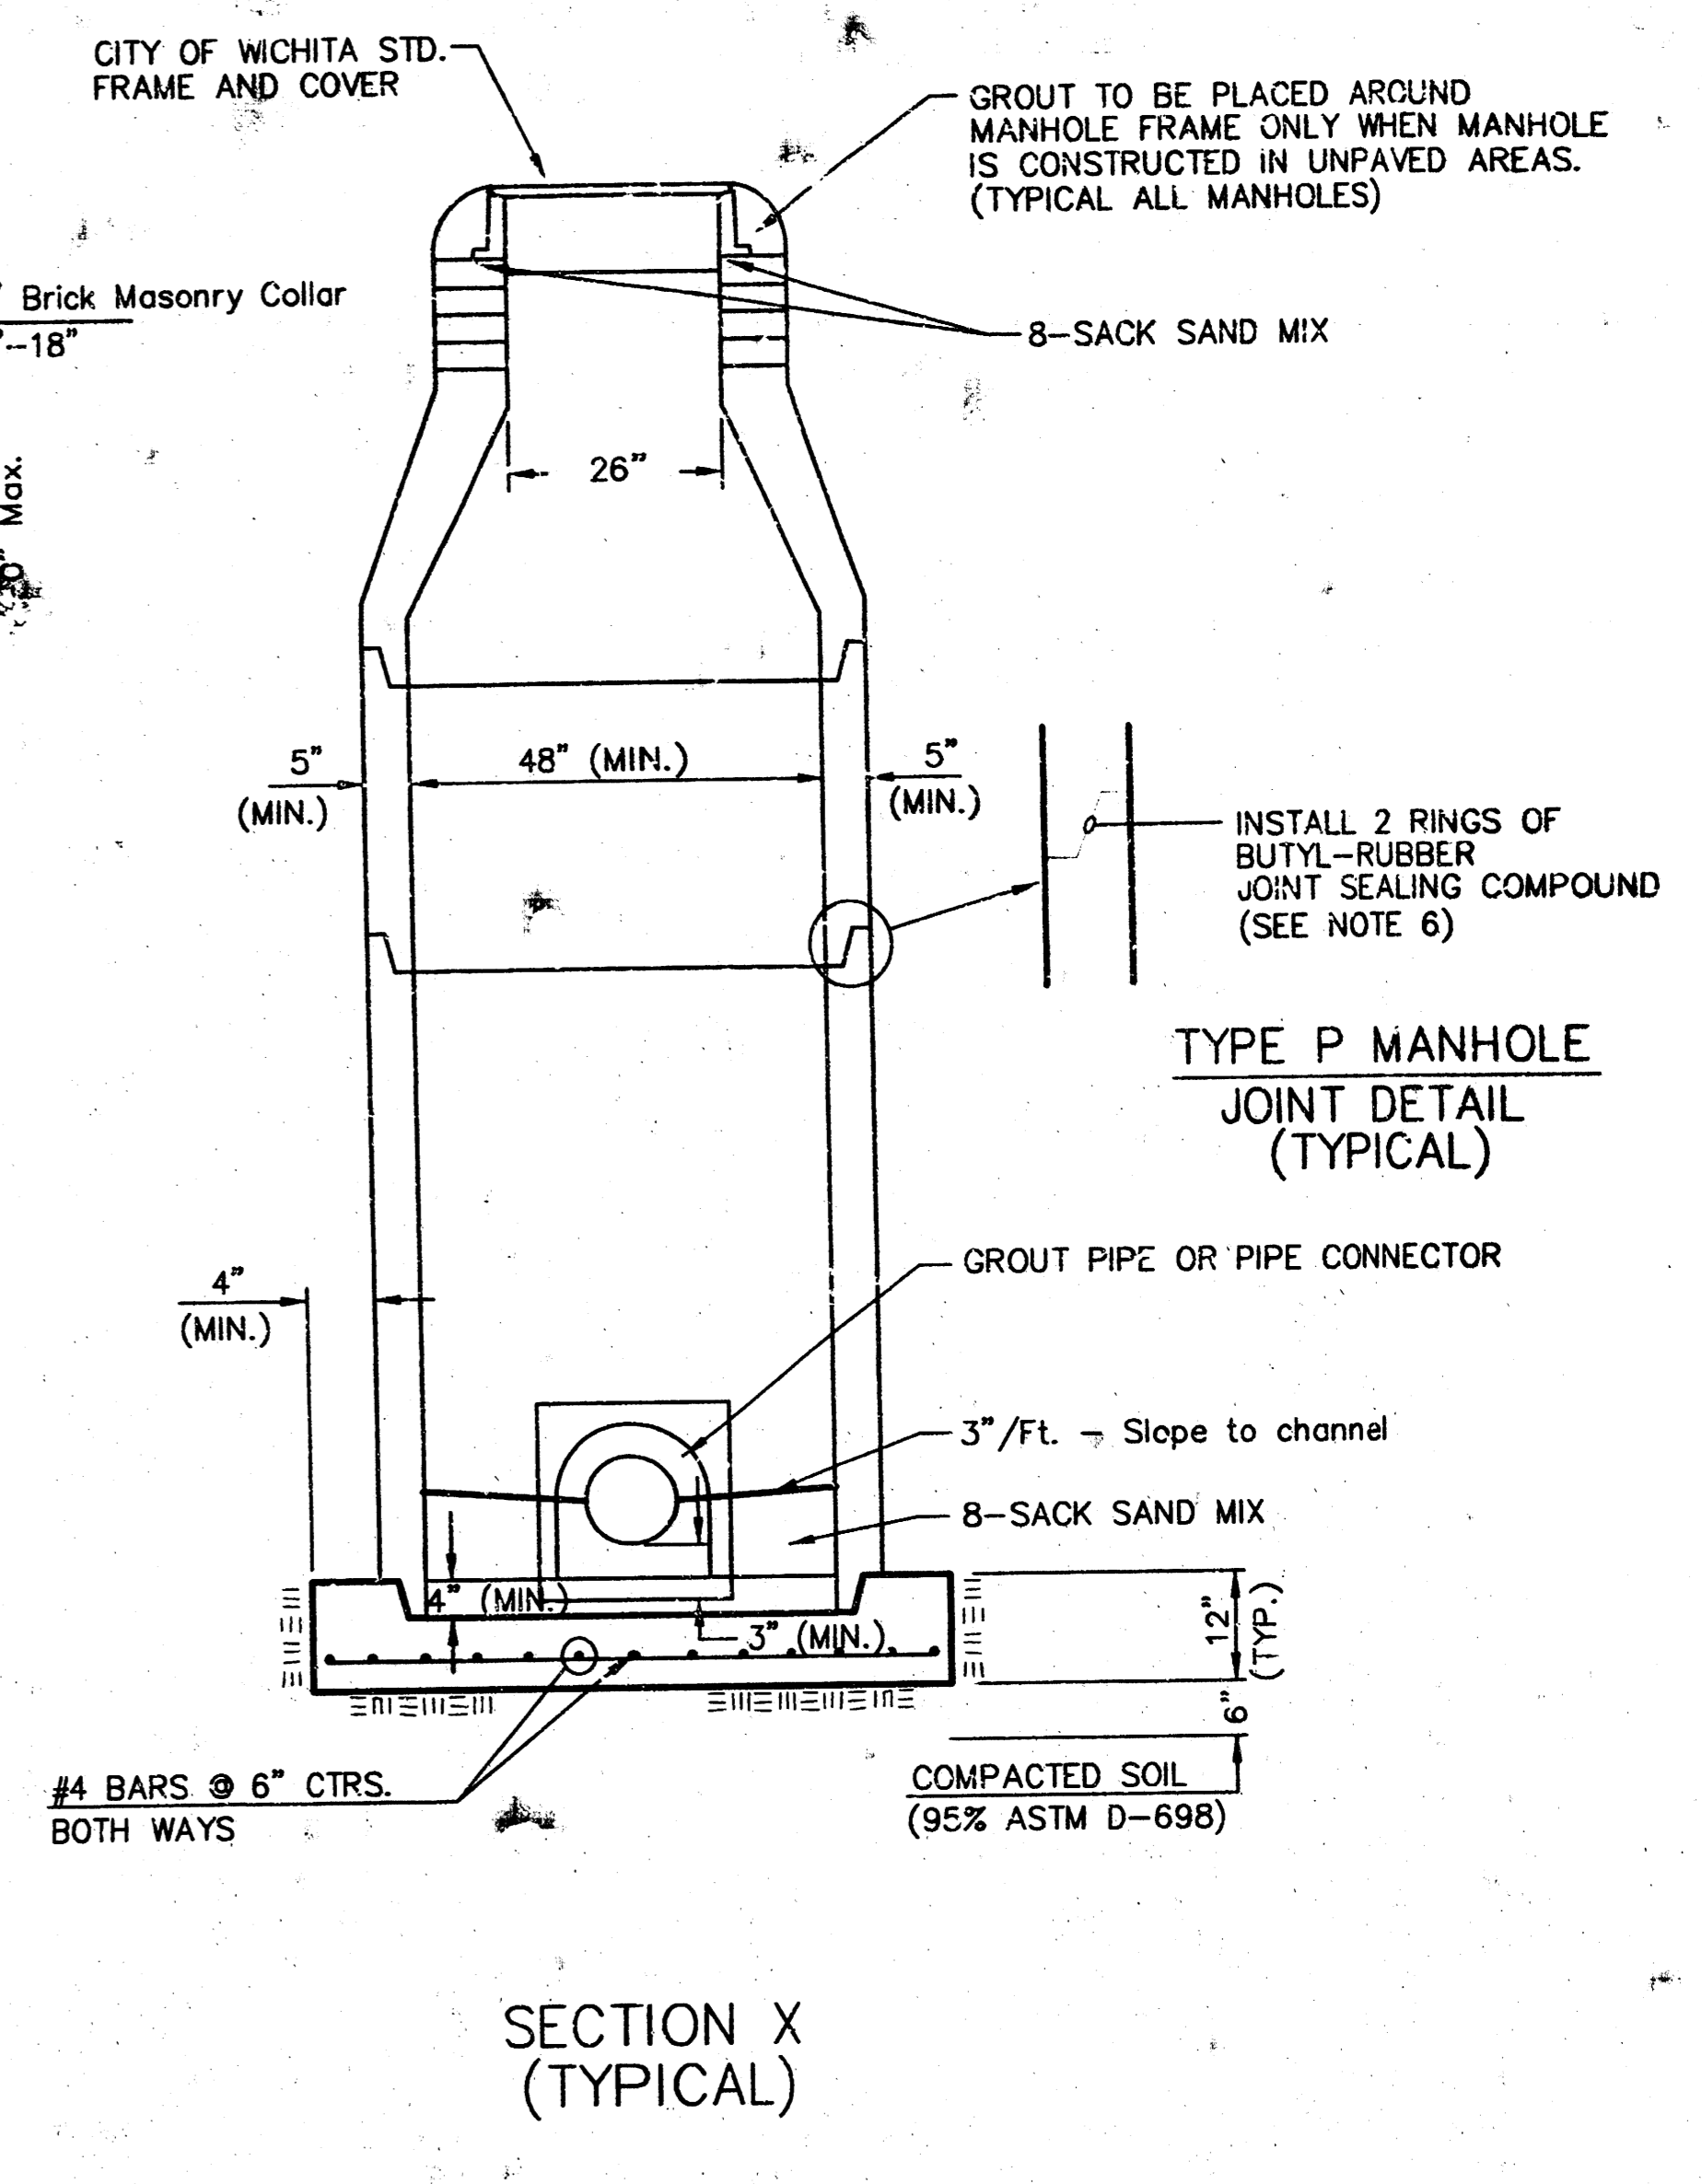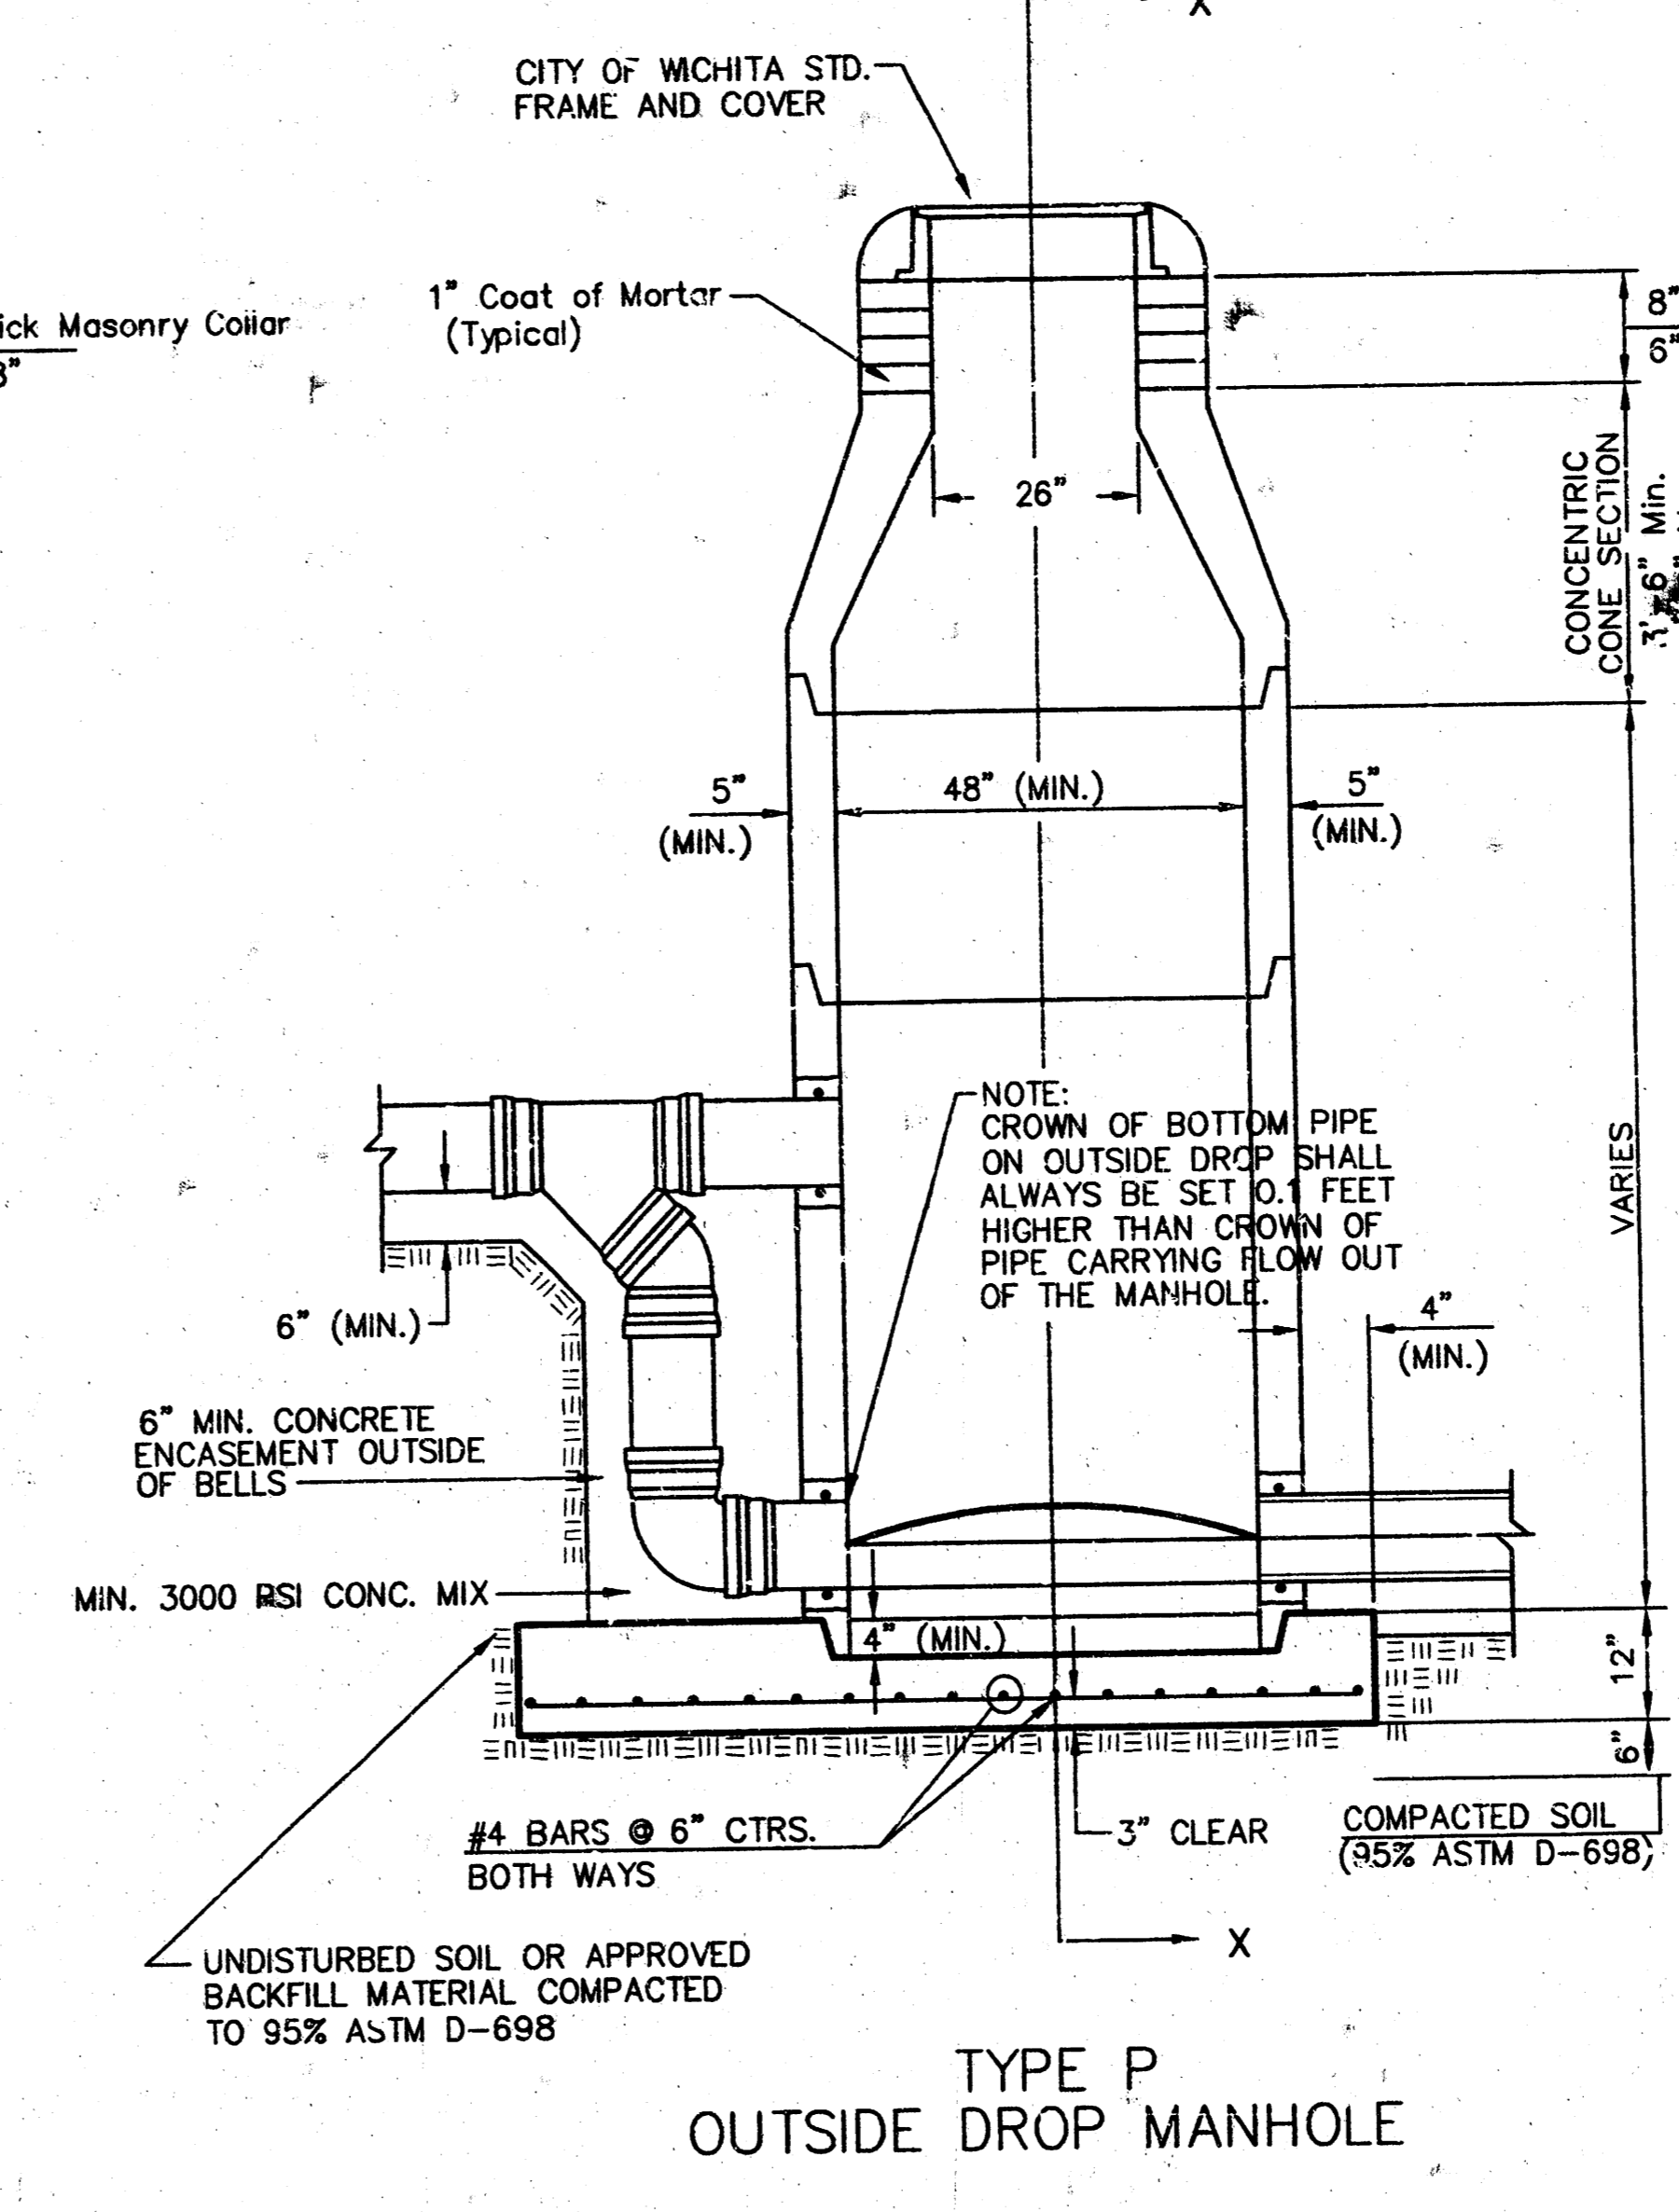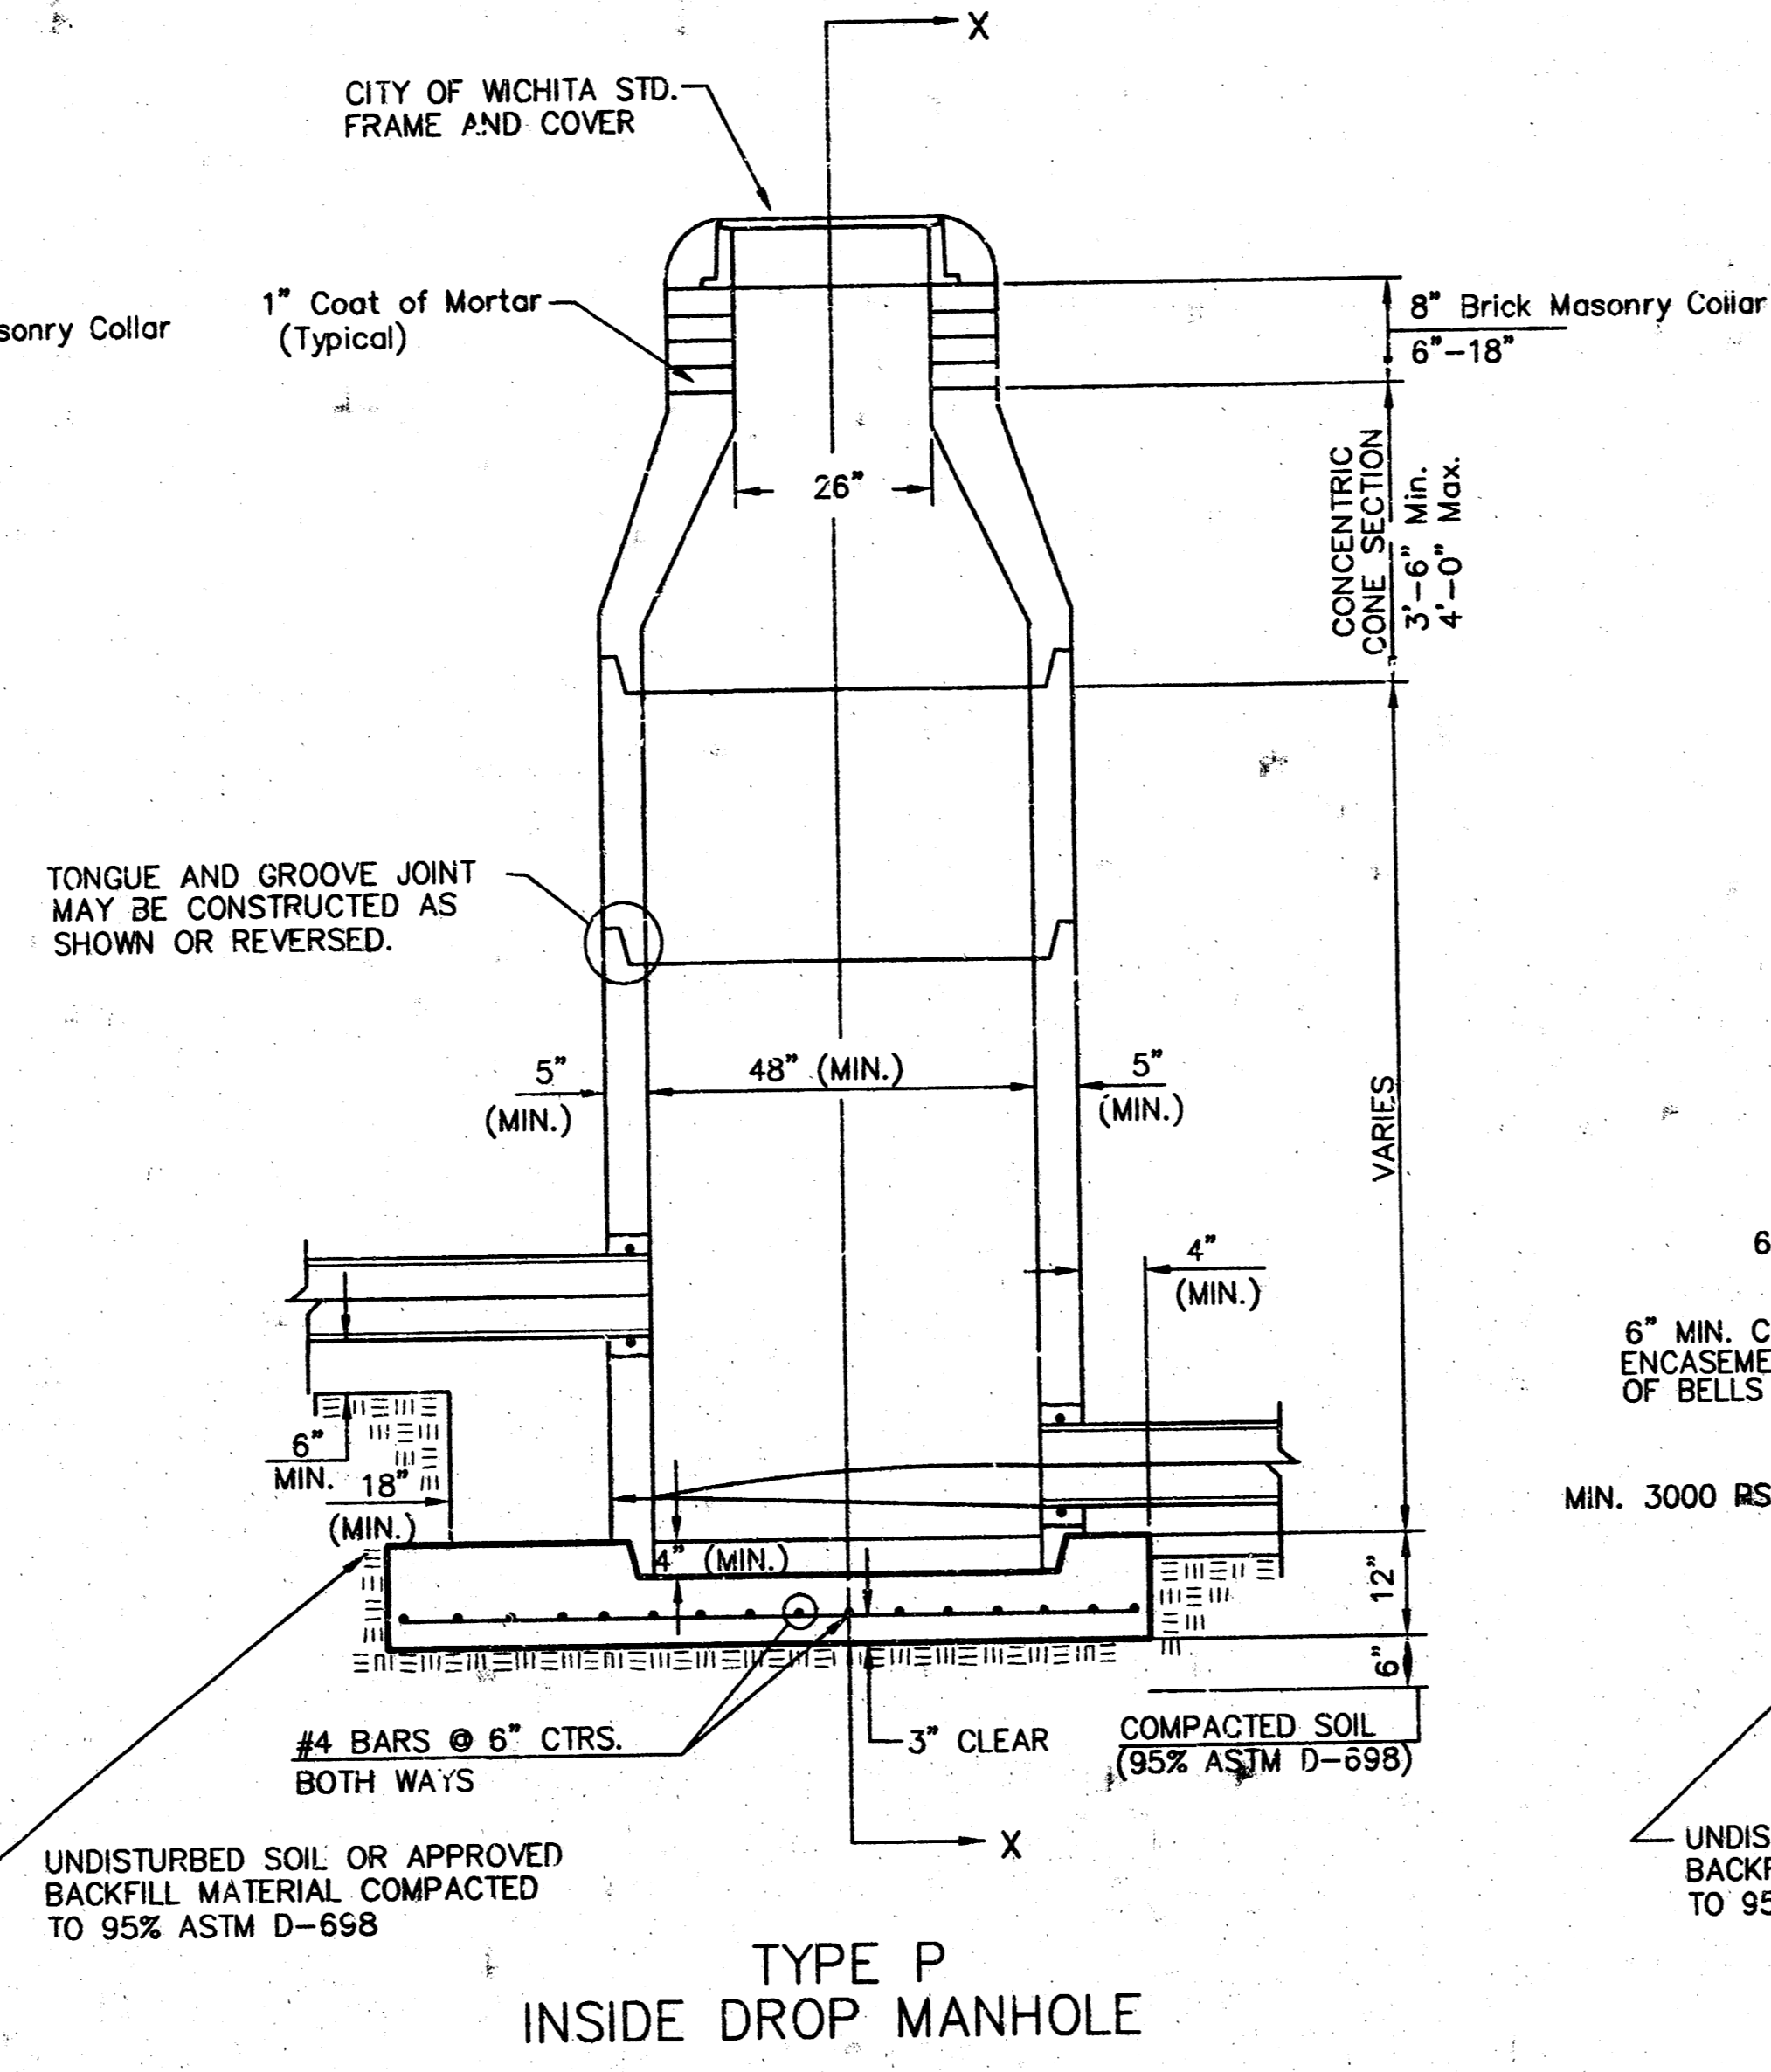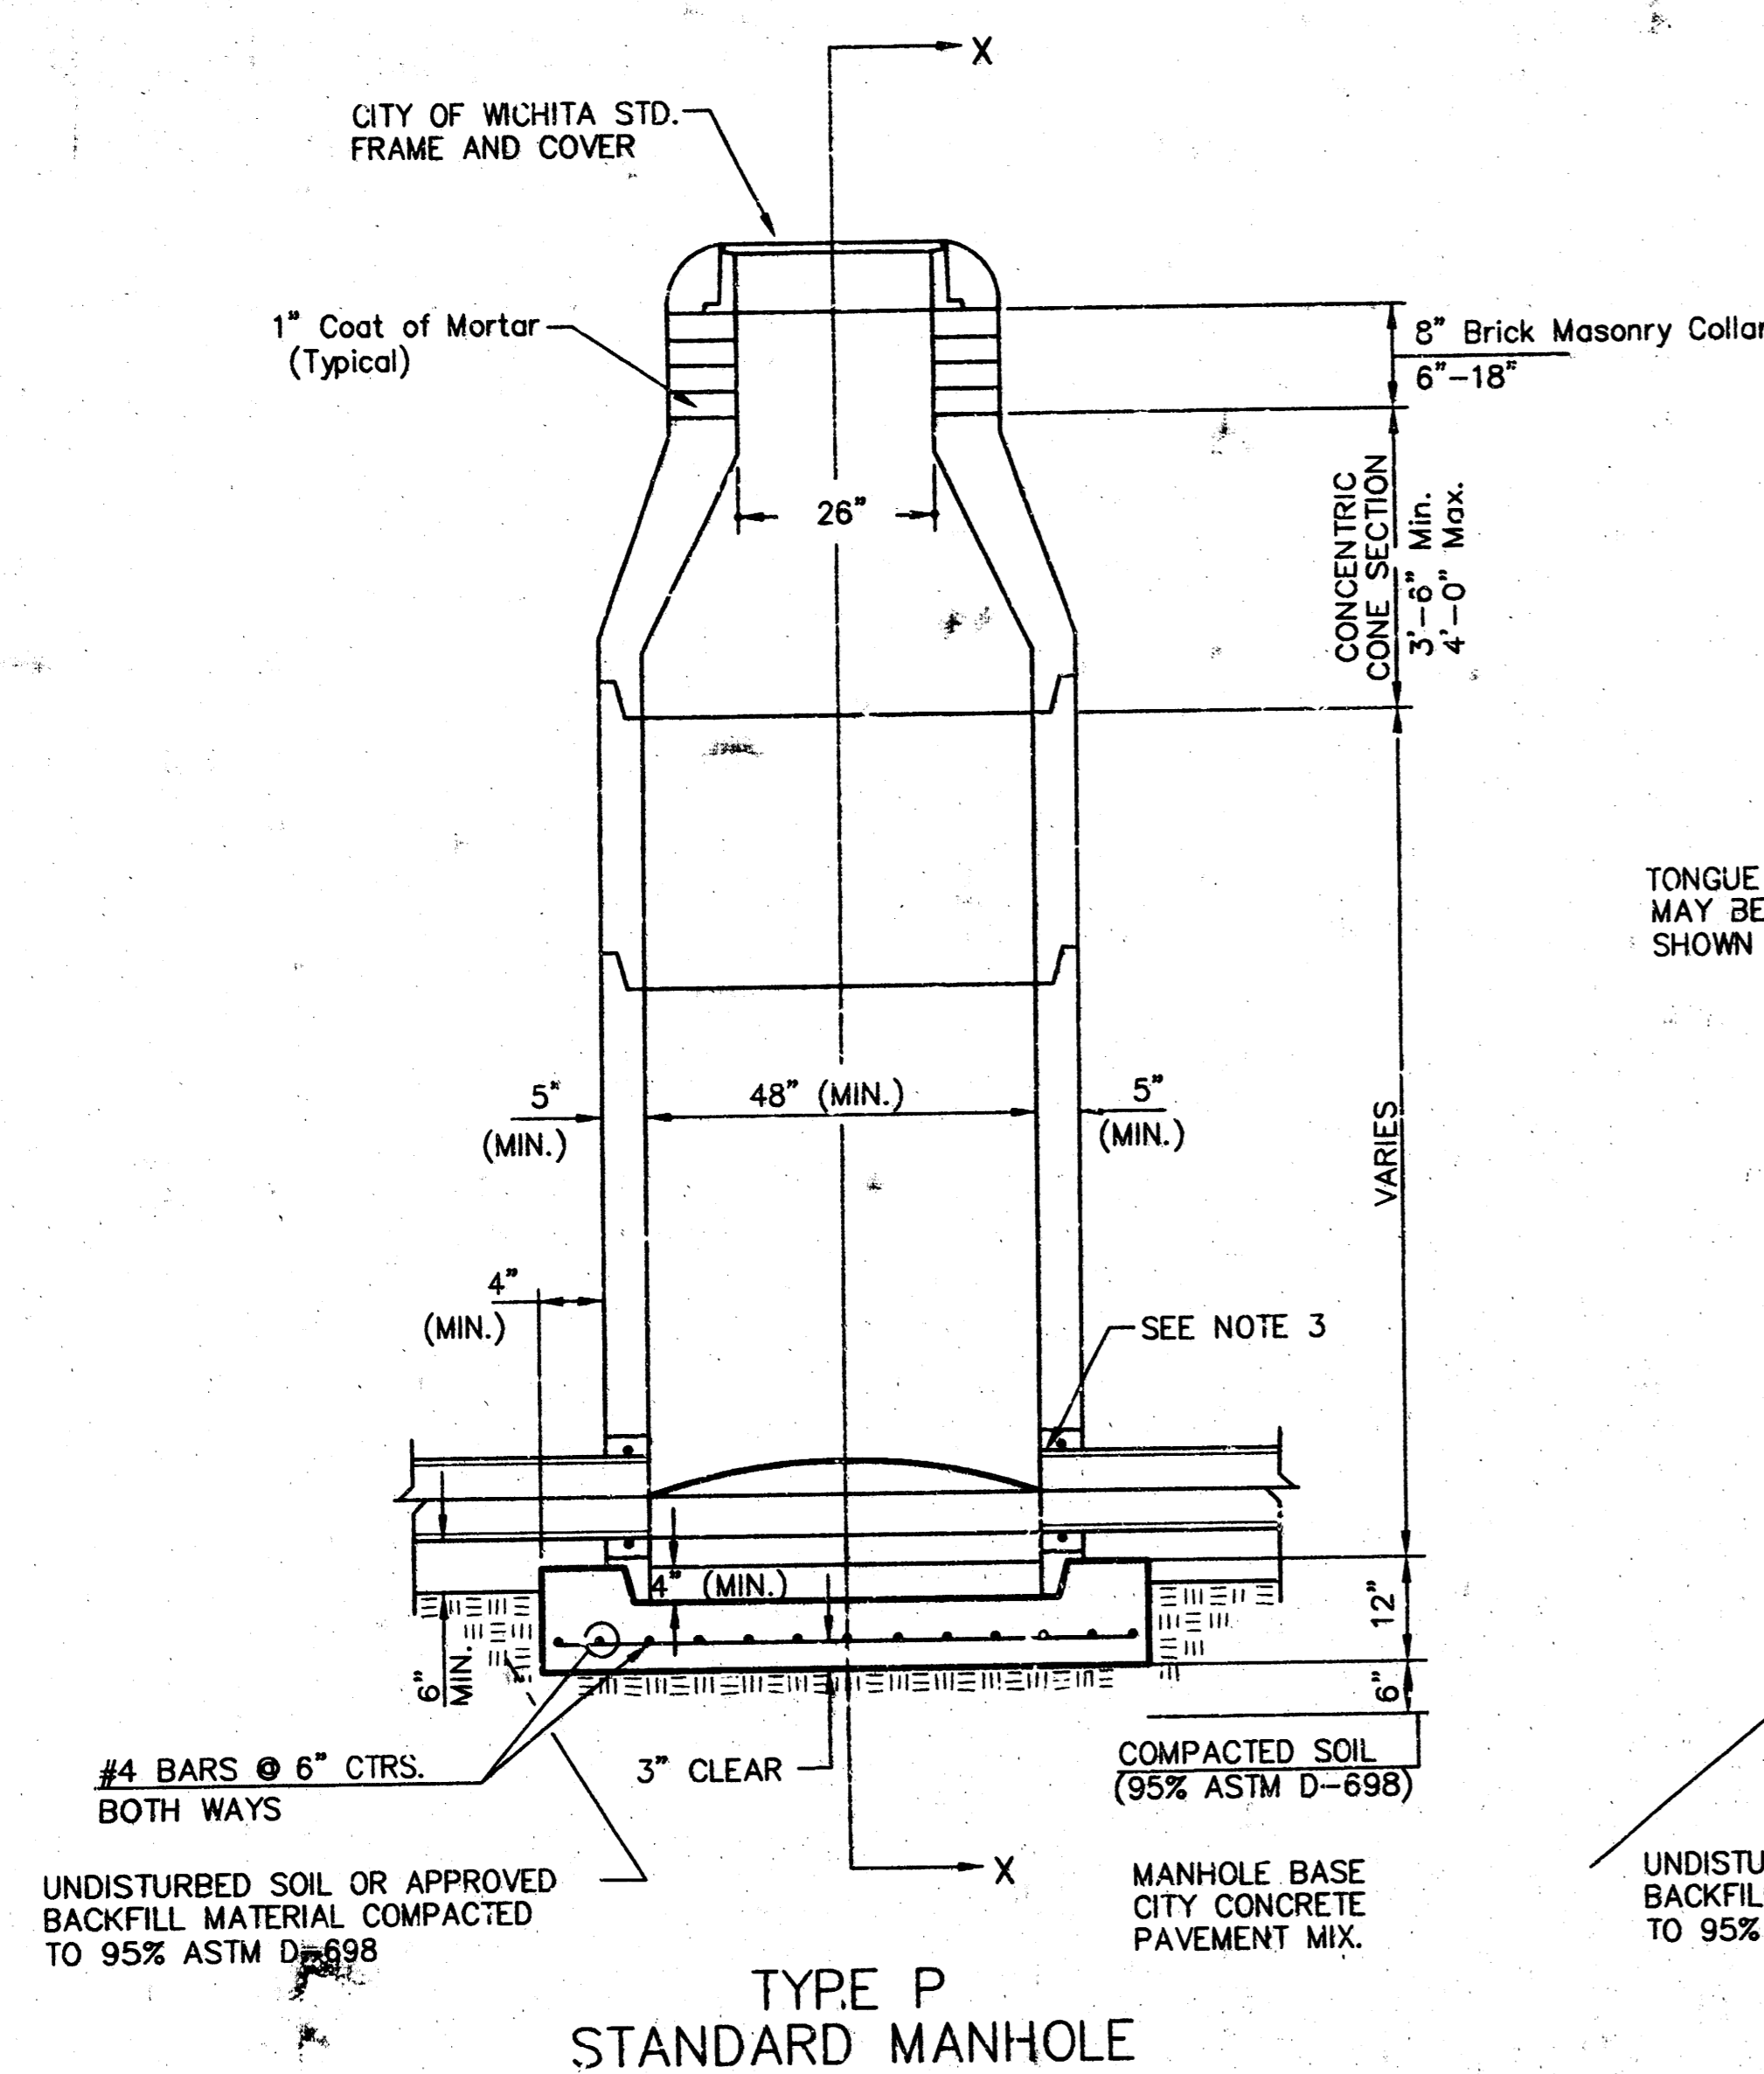

GENERAL NOTES

PRECAST MANHOLE NOTES


- ALL PRECAST CONCRETE MANHOLE SECTIONS SHALL CONFORM TO THE LATEST REVISIONS OF A.S.T.M. C478 AS MODIFIED BY THE SPECIFICATIONS.
- NON-SHRINK GROUT SHALL BE NON-METALLIC TYPE.
- APPROVED FLEXIBLE WATERSTOP GASKETS SHALL BE INSTALLED TO JOIN THE SEWER TO THE MANHOLE WALL WHEN A.B.S. COMPOSITE PIPE OR P.V.C. PIPE IS USED. FOR OTHER TYPES OF PIPE THE SEWER SHALL BE GROUTED IN PLACE WITH NON-SHRINK GROUT. THE SEWER PIPE SHALL BE SUPPORTED WITH CONCRETE ENCASUREMENT A MINIMUM OF 3 FEET FROM THE MANHOLE WALL AND TO THE FIRST JOINT FOR V.C.P. SUCH THAT THE JOINT REMAINS FLEXIBLE.
- ALL INSIDE SURFACES OF THE CONCRETE MANHOLE WHICH WOULD BE EXPOSED TO SEWER GAS SHALL BE COATED WITH 2 COATS TNEC SERIES 66 HI-BUILD EPOXIDINE, DRY THICKNESS OF 8 MILS (MIN.).
- EXTERIOR MANHOLE WALLS SHALL BE COATED WITH 1 COAT MOBILARMA 633 BITUMINOUS COATING.
- JOINT SEALING COMPOUND SHALL BE KENT SEAL NO. 2 OR APPROVED EQUAL.
- PRECAST MANHOLES SHALL BE SET AT LEAST 4 INCHES INTO THE MANHOLE BASE.
- TOP OF MANHOLE FLOOR SLAB SHALL BE AT LEAST 3 INCHES BELOW THE FLOW LINE OF THE OUTLET PIPE TO INSURE SUFFICIENT MINIMUM THICKNESS OF SHAPED INVERT.
- LIFTING HOLES SHALL BE FILLED WITH NON-SHRINK GROUT AND THE INTERIOR SURFACE COATED AS SPECIFIED.
- MORTAR USED IN MASONRY CONSTRUCTION SHALL CONTAIN 8 SACKS OF CEMENT PER CUBIC YARD. CONCRETE USED IN MANHOLE BASES SHALL CONFORM TO THE REQUIREMENTS OF CONCRETE FOR CONCRETE PAVEMENT CONSTRUCTION AS SPECIFIED IN THE CITY STANDARD PAVING SPECIFICATIONS USING CITY CONCRETE PAVEMENT MIX WITHOUT AIR ENTRAINING ADMIXTURE. MORTAR SHALL BE PLACED AROUND THE MANHOLE RING AS SHOWN ON THE DRAWINGS WHEN MANHOLES ARE CONSTRUCTED IN UNPAVED AREAS. MANHOLES CONSTRUCTED WHERE PIPE SIZES ARE SMALLER THAN 24" SHALL HAVE AN INSIDE DIAMETER OF 4". MANHOLES CONSTRUCTED WHERE PIPE SIZES ARE 24" OR LARGER SHALL HAVE AN INSIDE DIAMETER OF 5". COMPLETED MANHOLE SHALL BE WITHOUT LEAKS AND WATER TIGHT.

- REINFORCING STEEL SHALL BE INSTALLED IN THE MANHOLE BASES AND SHALL CONSIST OF NO. 4 BARS PLACED ON 6" CENTERS IN BOTH DIRECTIONS. THE MANHOLE BASE REINFORCEMENT SHALL BE PLACED AT LEAST 3" ABOVE THE BOTTOM OF THE MANHOLE BASE. ALL COSTS FOR FURNISHING AND INSTALLING REINFORCING STEEL SHALL BE INCLUDED IN THE UNIT PRICE BID FOR THE MANHOLE.
- OPENINGS SHALL BE CUT INTO THE MANHOLE WALL WHEN OUTSIDE DROPS ARE CONSTRUCTED ON EXISTING MANHOLES. SUCH OPENINGS CUT INTO EXISTING MANHOLES SHALL BE AS SMALL AS PRACTICAL TO FACILITATE INSTALLING AND GROUTING THE NEW PIPE IN PLACE. WATERSTOP GASKETS SHALL BE USED WITH P.V.C. AND A.B.S. COMPOSITE PIPE. THE 7" PIPE SHALL BE GROUTED INTO THE OPENING USING AN APPROVED NON-SHRINK GROUT FOR THE FULL MANHOLE WALL THICKNESS. THE EXTERIOR OF THE COMPLETED CONNECTION SHALL BE SEALED WITH AN APPROVED BITUMINOUS COATING SUCH THAT THE CONNECTION WILL BE WATER TIGHT. FLOOR OF MANHOLE SHALL BE MODIFIED TO FORM NEW FLOW CHANNEL FOR THE NEW CONNECTION AS INDICATED BY THE DRAWING. THIS WORK, INCLUDING MODIFICATION OF MANHOLE FLOOR, SHALL BE PAID FOR AT THE UNIT PRICE BID FOR OUTSIDE DROP STACK CONSTRUCTED ON EXISTING MANHOLE.
- THE FLOORS OF ALL MANHOLES SHALL BE SHAPED WITH FLOW CHANNELS SUCH THAT THE MANHOLES WILL BE SELF-CLEANING AND FREE OF AREAS WHERE SOLIDS COULD BE DEPOSITED AS SEWAGE FLOWS THROUGH THE MANHOLE FROM ALL INLET PIPES TO THE OUTLET PIPE. FLOW CHANNELS SHALL BE FORMED TO MATCH THE BOTTOM HALVES OF THE INFLOWING PIPES AND THE OUTFLOWING PIPE AS SHOWN BY THE DRAWINGS EXCEPT FOR INSIDE DROP MANHOLES. FLOW CHANNELS FOR INSIDE DROP MANHOLES SHALL BE CONSTRUCTED AS INDICATED BY THE DRAWING. MANHOLE FLOORS SHALL HAVE SLOPES OF 3 INCHES PER FOOT IN THE AREAS OUTSIDE OF THE FLOW CHANNELS SLOPED TOWARD THE FLOW CHANNELS. PIPES LAID THROUGH MANHOLES SHALL HAVE THE TOP HALF REMOVED TO NEAT LINES FOR THE FULL INSIDE DIAMETER OF THE MANHOLE. MANHOLE FLOORS SHALL THEN BE SHAPED AROUND THE BOTTOM HALF OF THE PIPE WHICH FORMS THE FLOW CHANNEL.
- PIPES INSTALLED WITHIN THE EXCAVATION MADE FOR THE MANHOLE SHALL BE CRADLED WITH CONCRETE TO THE LIMITS OF THE MANHOLE EXCAVATION. WHEN CLAY PIPE IS USED, THE CRADLE SHALL EXTEND TO THE FIRST JOINT OUTSIDE THE MANHOLE. THE CRADLE SHALL BE TERMINATED AT THE CLAY PIPE JOINT IN A MANNER WHICH WILL MAINTAIN THE FLEXIBILITY OF THE JOINT. COST OF CRADLE WITHIN MANHOLE EXCAVATION OR TO CLAY PIPE JOINTS ADJACENT TO MANHOLE SHALL BE INCLUDED IN THE UNIT PRICE BID FOR THE MANHOLE.


- MANHOLE COVER CASTINGS AND MANHOLE FRAME CASTINGS SHALL CONFORM TO THE REQUIREMENTS AS INDICATED IN THE STANDARD SPECIFICATIONS AND AS SHOWN IN THE STANDARD DETAIL DRAWING.
- THE VERTICAL DROP IN INSIDE DROP MANHOLES SHALL NOT EXCEED 2' FOR INFLOWING PIPES SIZED 12" OR SMALLER AND 2' FOR INFLOWING PIPES LARGER THAN 12". THE CROWNS OF INFLOWING PIPES SHALL NEVER BE SET LOWER THAN THE CROWN OF THE OUTFLOWING PIPE.
- STANDARD MANHOLES AND STANDARD INSIDE DROP MANHOLES SHALL BE BID AS STANDARD MANHOLES FOR THE TYPE AND DIAMETER INDICATED. OUTSIDE DROP MANHOLES SHALL BE BID AS STANDARD OUTSIDE DROP MANHOLES FOR THE TYPE AND DIAMETER INDICATED. ALL MANHOLE DIAMETERS WILL BE 4' UNLESS INDICATED OTHERWISE.
- A BRICK MASONRY COLLAR SHALL BE INSTALLED BETWEEN THE CAST IRON FRAME AND THE CONCENTRIC CONE. THE COLLAR WILL HAVE 8" WALLS AND A VERTICAL HEIGHT OF 6" MINIMUM AND 18" MAXIMUM. A 1" COAT OF MORTAR WILL BE PLASTERED ON THE OUTSIDE OF THE COLLAR. THE USE OF PRE-CAST CONCRETE SPACERS FOR MANHOLE TOP ADJUSTMENT IS ALSO ALLOWED.

As-BUILTS (3/12/03) Built per Plan

<p>THE CITY OF WICHITA</p> <p>CITY ENGINEER'S OFFICE CITY HALL - 5TH FLOOR 455 NORTH MAIN STREET WICHITA, KANSAS 67202 (316) 268-4201 (316) 268-4114 FAX</p>	STANDARD TYPE 'P' MANHOLES	
	M. E. LINDEBAK P.E. - CITY ENGINEER	
	PROJECT NUMBER 1286 PPS	CCA # 607861
	DATE MAR 96	SHEET 2 OF 6

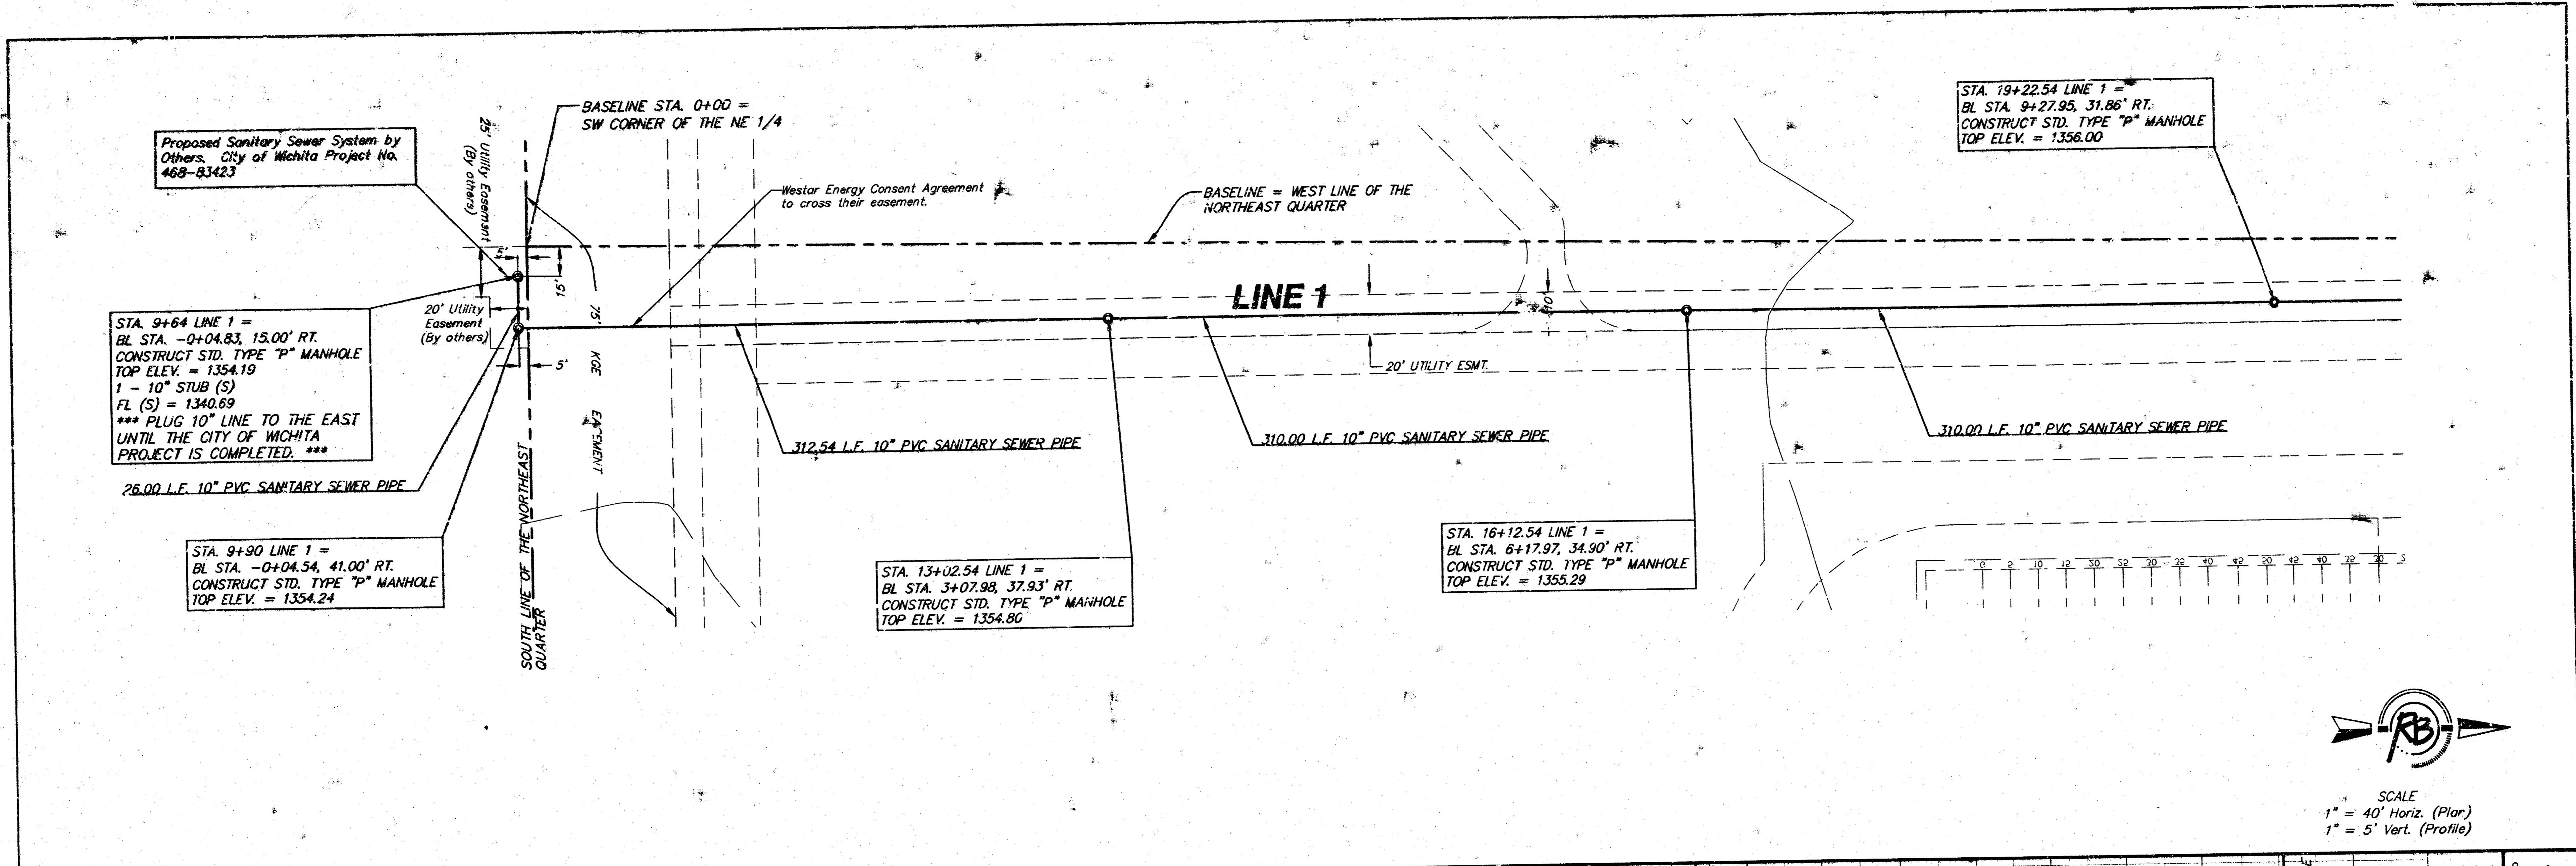

SCALE
1" = 40' Horiz. (Plan)
1" = 5' Vert. (Profile)

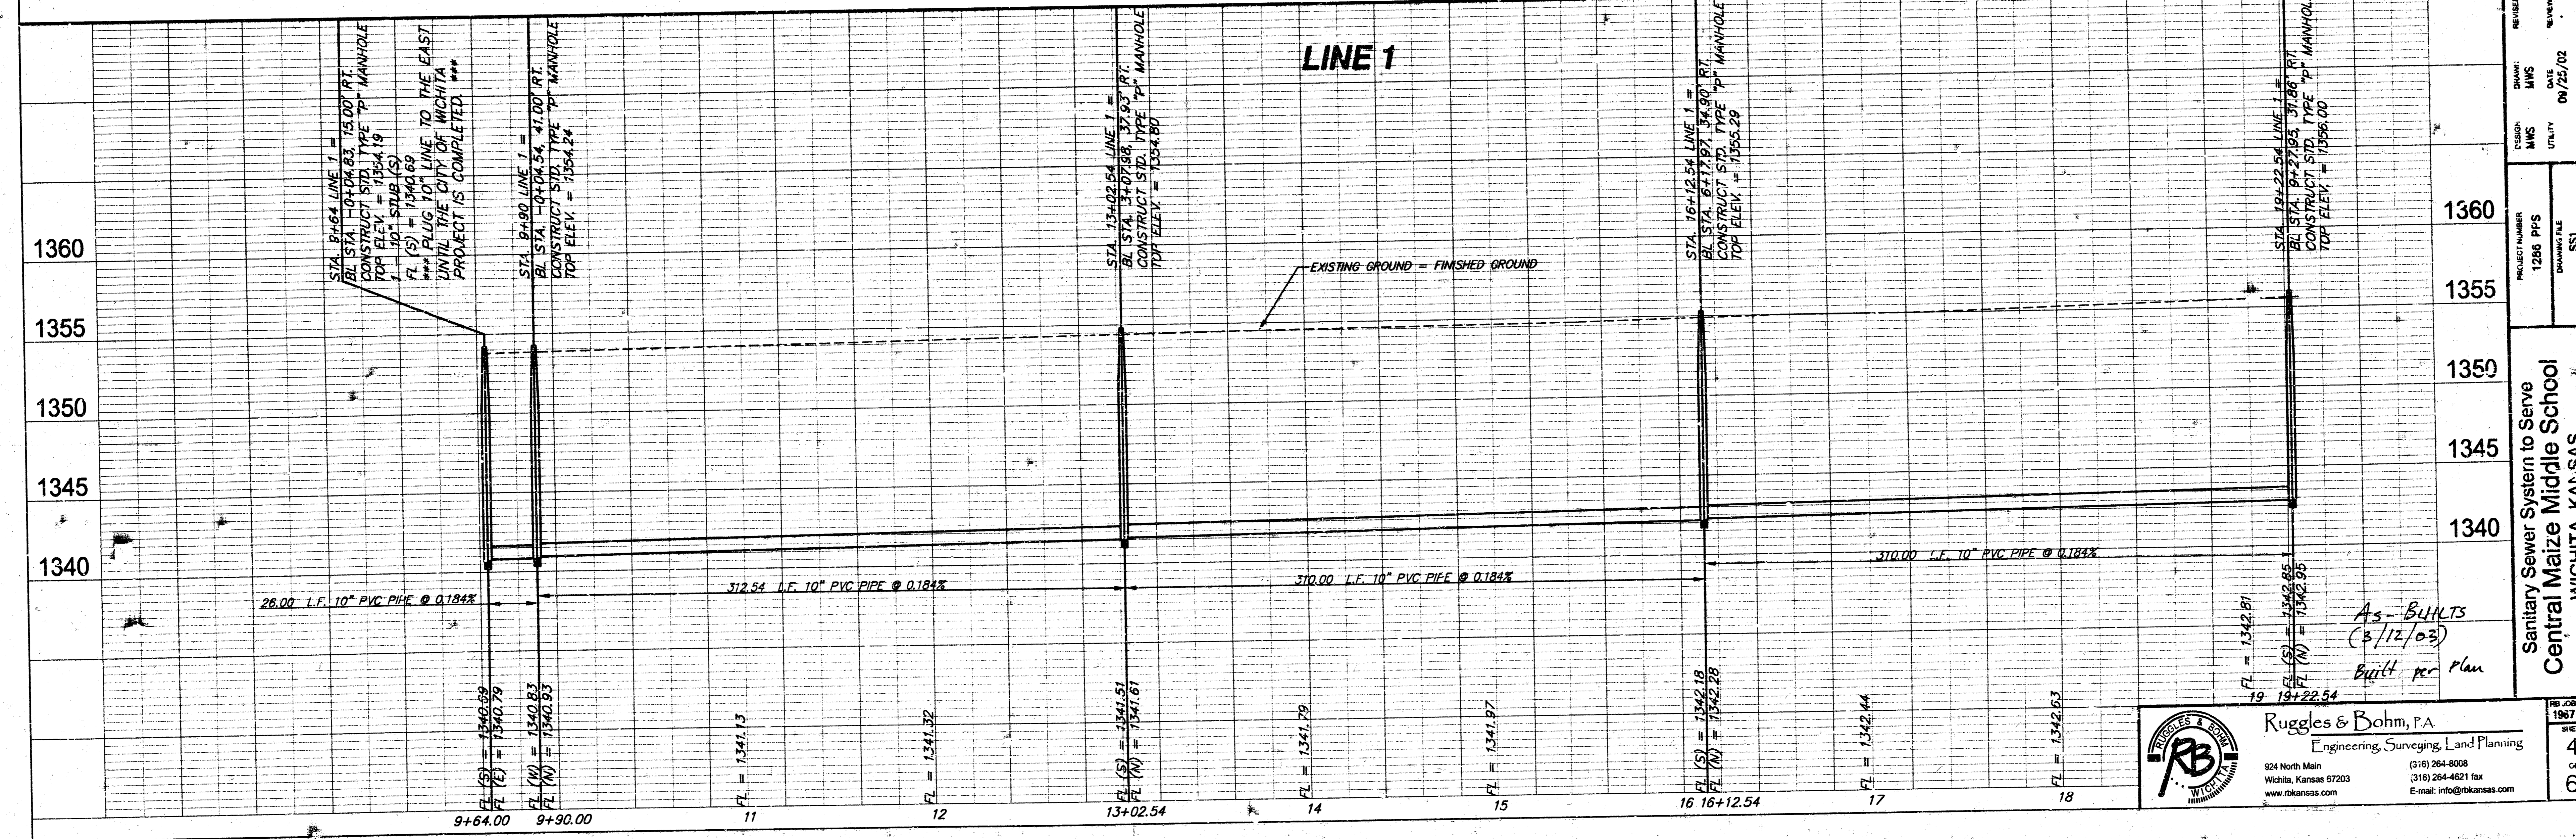



DESIGN	MWS	DATE	09/25/02
PROJECT NUMBER	1288 PFS	DRAWN BY	SS1
Sanitary Sewer System to Serve Central Maize Middle School WICHITA, KAN-SAS			

Ruggles & Bohm, P.A.
Engineering, Surveying, Land Planning

524 North Main
Wichita, Kansas 67203
www.rbkansas.com

(316) 264-8008
(316) 264-4621 fax
E-mail: info@rbkansas.com

1927 E
SHEET
4
0

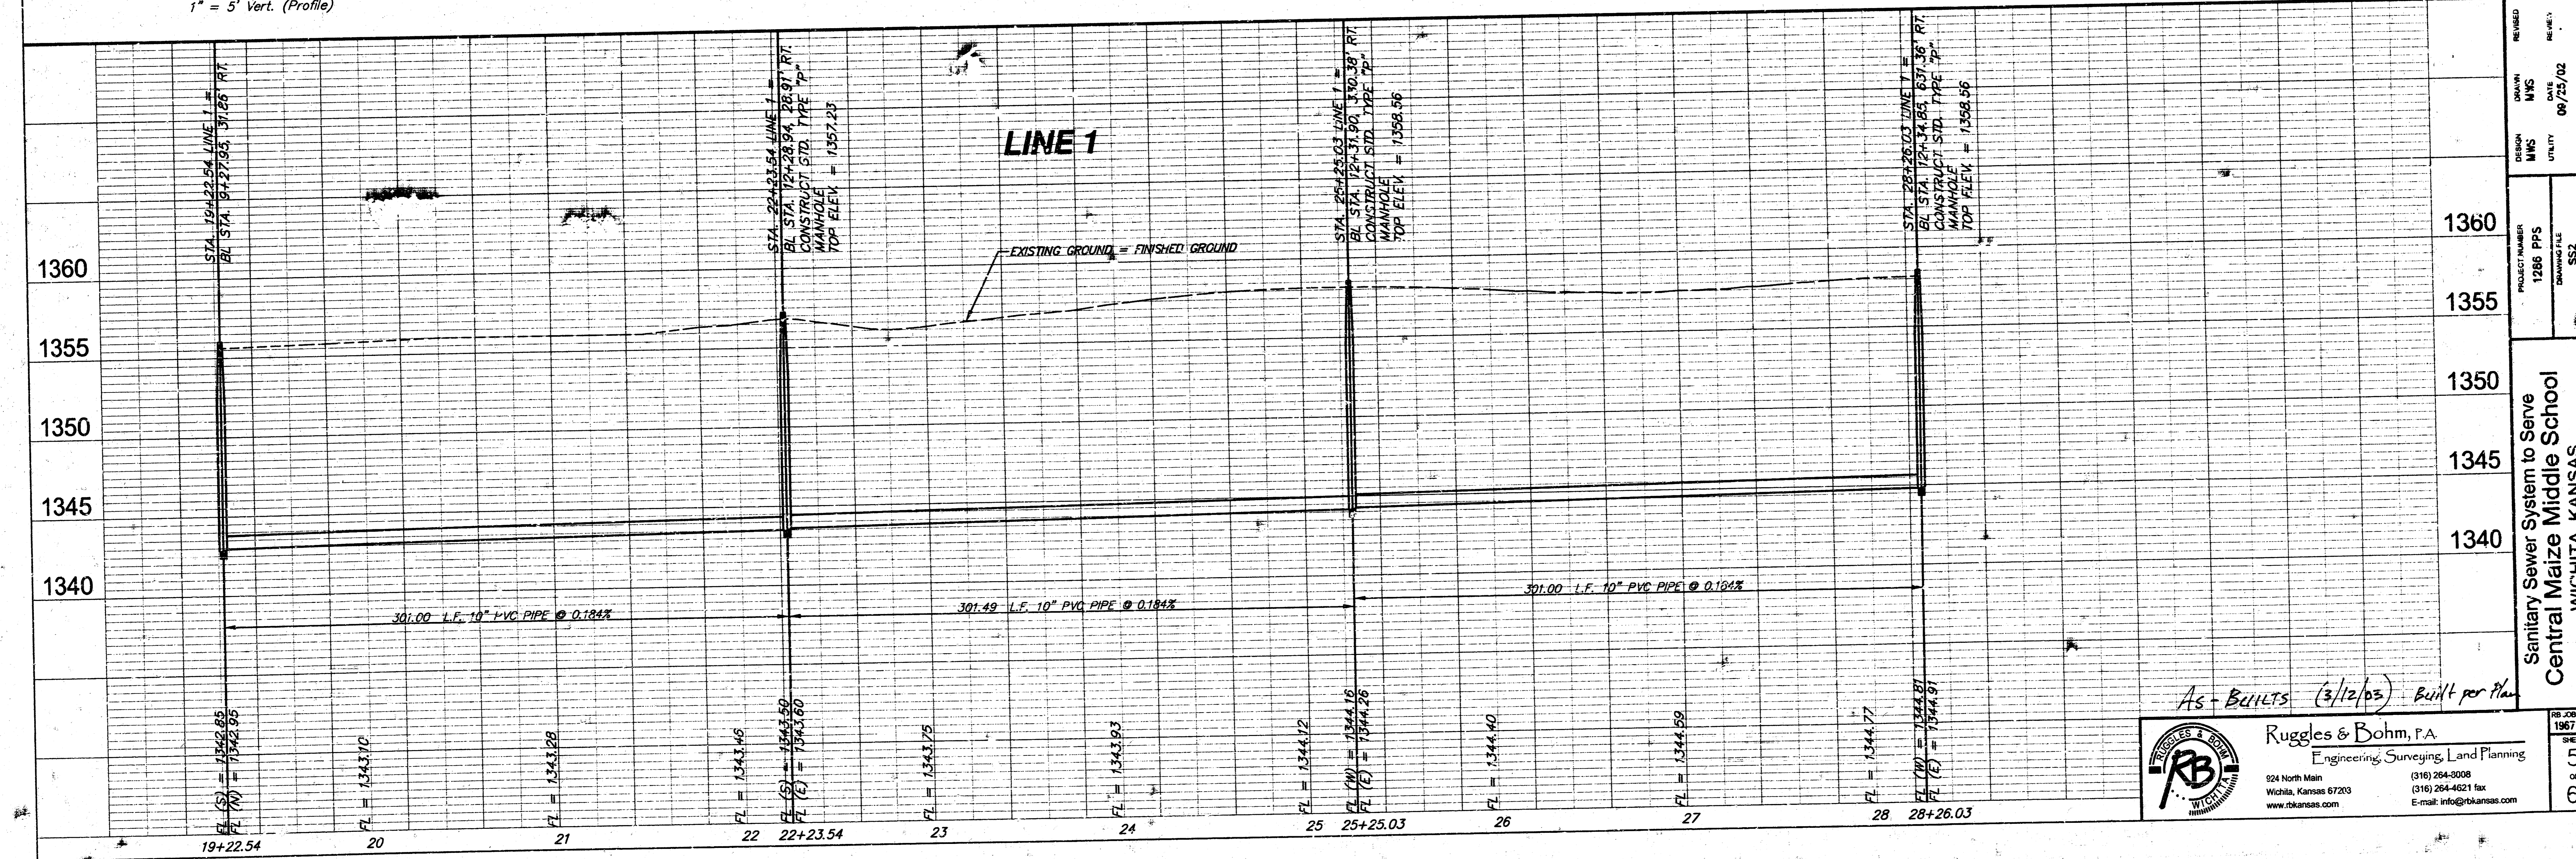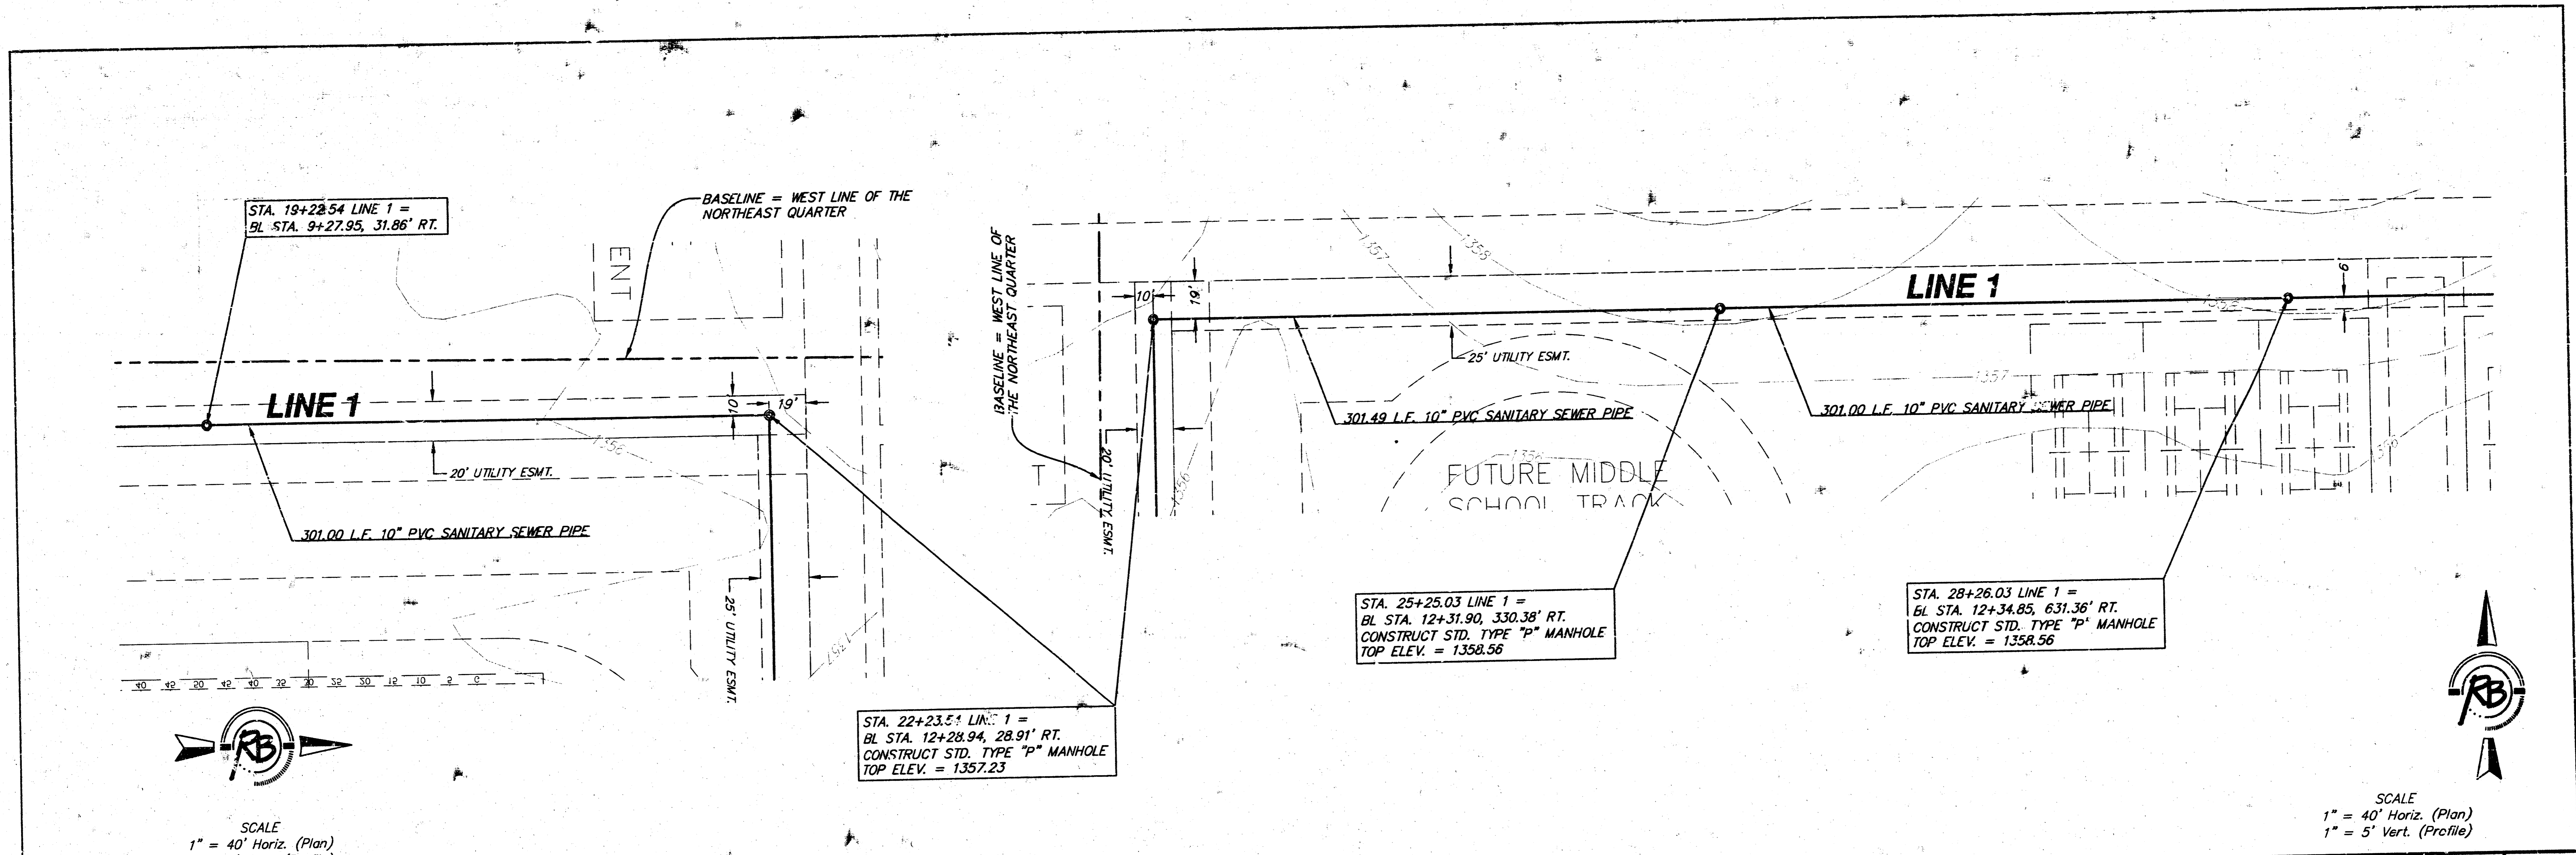

PROJECT NUMBER 1288 PPS	DATE 09/25/02
DESIGN MWS	UTILITY
DRAWN MWS	REVIEW
REVISION	


Sanitary Sewer System to Serve
Central Maize Middle School
WICHITA, KANSAS

AS-BUILTS (3/12/03) Built per Plan

Ruggles & Bohm, P.A.
Engineering, Surveying, Land Planning
924 North Main
Wichita, Kansas 67203
www.rbkansas.com
(316) 264-8008
(316) 264-4621 fax
E-mail: info@rbkansas.com

1967 E
SHEET
CD & U

BASELINE = WEST LINE OF THE
NORTHEAST QUARTER

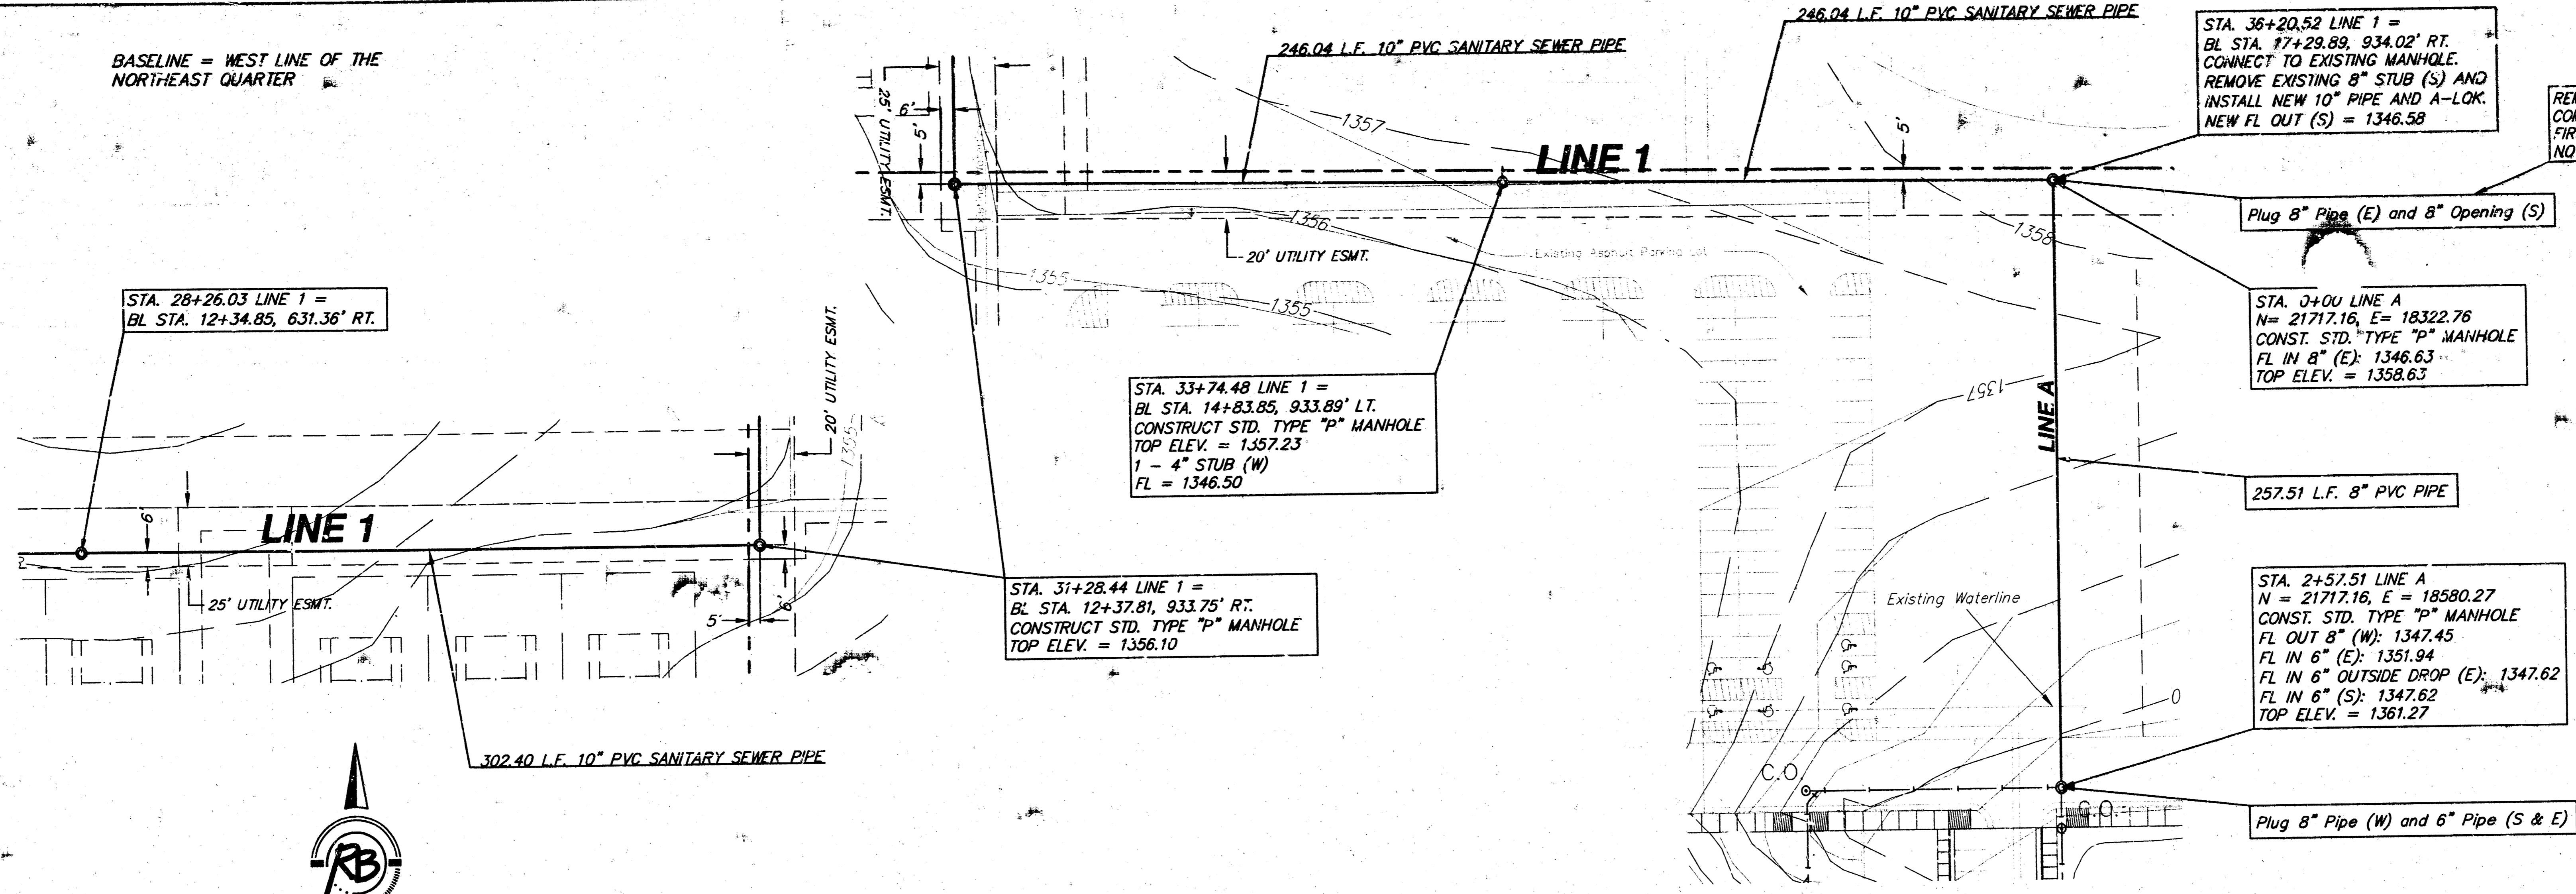

STA. 28+26.03 LINE 1 =
BL STA. 12+34.85, 631.36' RT.

STA. 33+74.48 LINE 1 =
BL STA. 14+83.85, 933.89' LT.
CONSTRUCT STD. TYPE "P" MANHOLE
TOP ELEV. = 1357.23
1 - 4" STUB (W)
FL = 1346.50

STA. 31+28.44 LINE 1 =
BL STA. 12+37.81, 933.75' RT.
CONSTRUCT STD. TYPE "P" MANHOLE
TOP ELEV. = 1356.10

STA. 36+20.52 LINE 1 =
BL STA. 17+29.89, 934.02' RT.
CONNECT TO EXISTING MANHOLE.
REMOVE EXISTING 8" STUB (S) AND
INSTALL NEW 10" PIPE AND A-LOK.
NEW FL OUT (S) = 1346.58

REMOVE PLUGS AFTER LINE IS
COMPLETED. MOVE PLUGS TO
FIRST MANHOLE AND INSTALL PER
NOTE.

Plug 8" Pipe (E) and 8" Opening (S)

STA. 0+00 LINE A
N = 2171.16, E = 18322.76
CONST. STD. TYPE "P" MANHOLE
FL IN 8" (E) = 1346.63
TOP ELEV. = 1358.63

257.51 L.F. 8" PVC PIPE

STA. 2+57.51 LINE A
N = 2171.16, E = 18580.27
CONST. STD. TYPE "P" MANHOLE
FL OUT 8" (W) = 1347.45
FL IN 6" (E) = 1351.94
FL IN 6" OUTSIDE DROP (E) = 1347.62
FL IN 6" (S) = 1347.62
TOP ELEV. = 1361.27


Plug 8" Pipe (W) and 6" Pipe (S & E)

Note:
Line A was completed first.
This portion of sewer was
inst. before the asphalt
pavement was installed.
Contractor then completed
rest of line. This is why the
manhole at Sta. 36+20.52,
Line 1 = Sta. 0+00, Line A



SCALE
1" = 40' Horiz. (Plan)
1" = 5' Vert. (Profile)

SCALE
1" = 40' Horiz. (Plan)
1" = 5' Vert. (Profile)

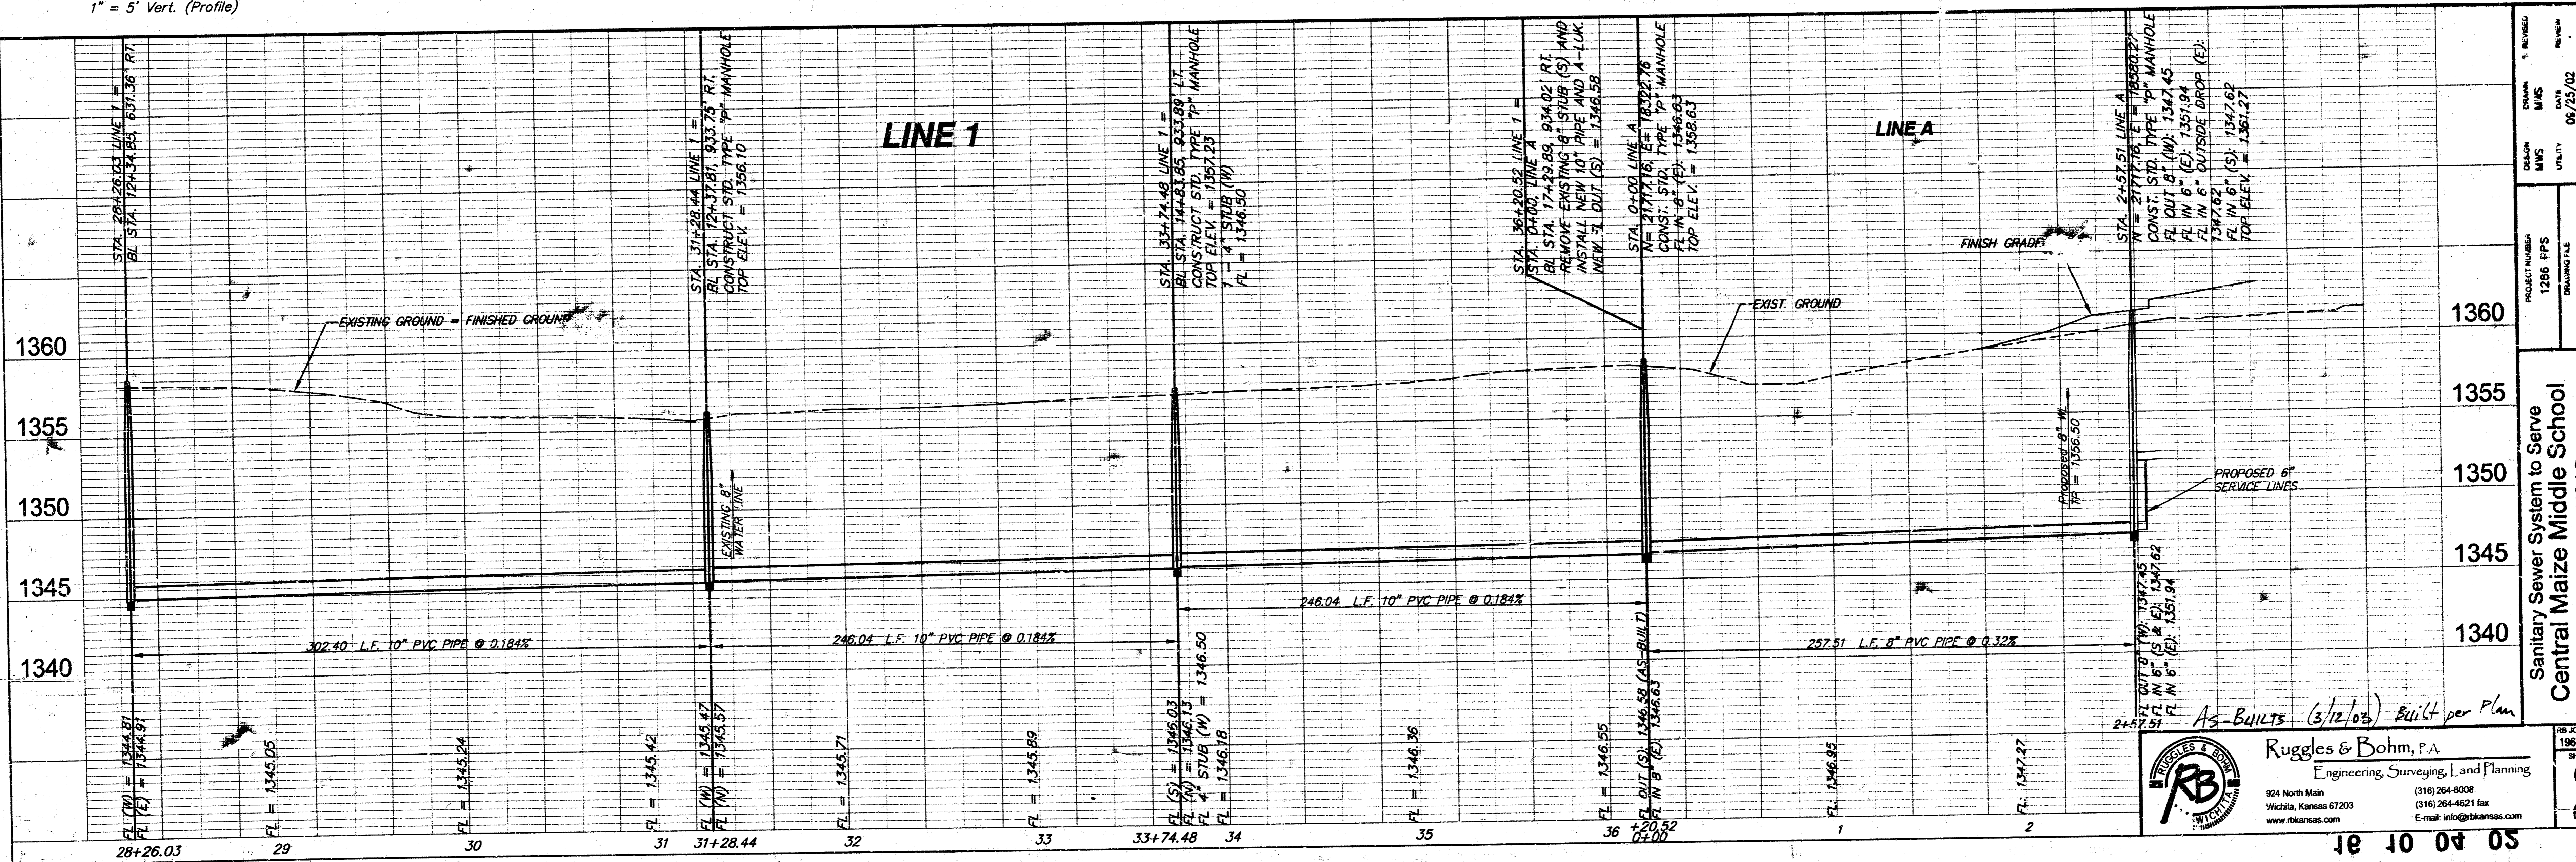

PROJECT NUMBER	1286 EPS
DATE	06/25/02
DESIGNER	M/S
CHECKER	M/S
DATE	06/25/02
PROJECT	UTILITY
SCALE	SS3

Sanitary Sewer System to Serve
Central Maize Middle School
WICHITA, KANSAS

AS-BUILTS (3/12/03) Built per Plan

Ruggles & Bohm, P.A.
Engineering, Surveying, L and Planning
924 North Main
Wichita, Kansas 67203
www.rkansas.com
(316) 264-8008
(316) 264-4621 fax
E-mail: info@rkansas.com