


Note: Dimensions and locations to be field checked.



• Bench mark "M" in Mueller on Fire Hydrant at NW corner Gilbert & Eastern 150.87

SANITARY SEWER TO SERVE CHARTER MEDICAL CENTER SANITARY SEWER INSTALLATION PRIVATE PROJECT NO. 448-76-245-80001-000-000-127

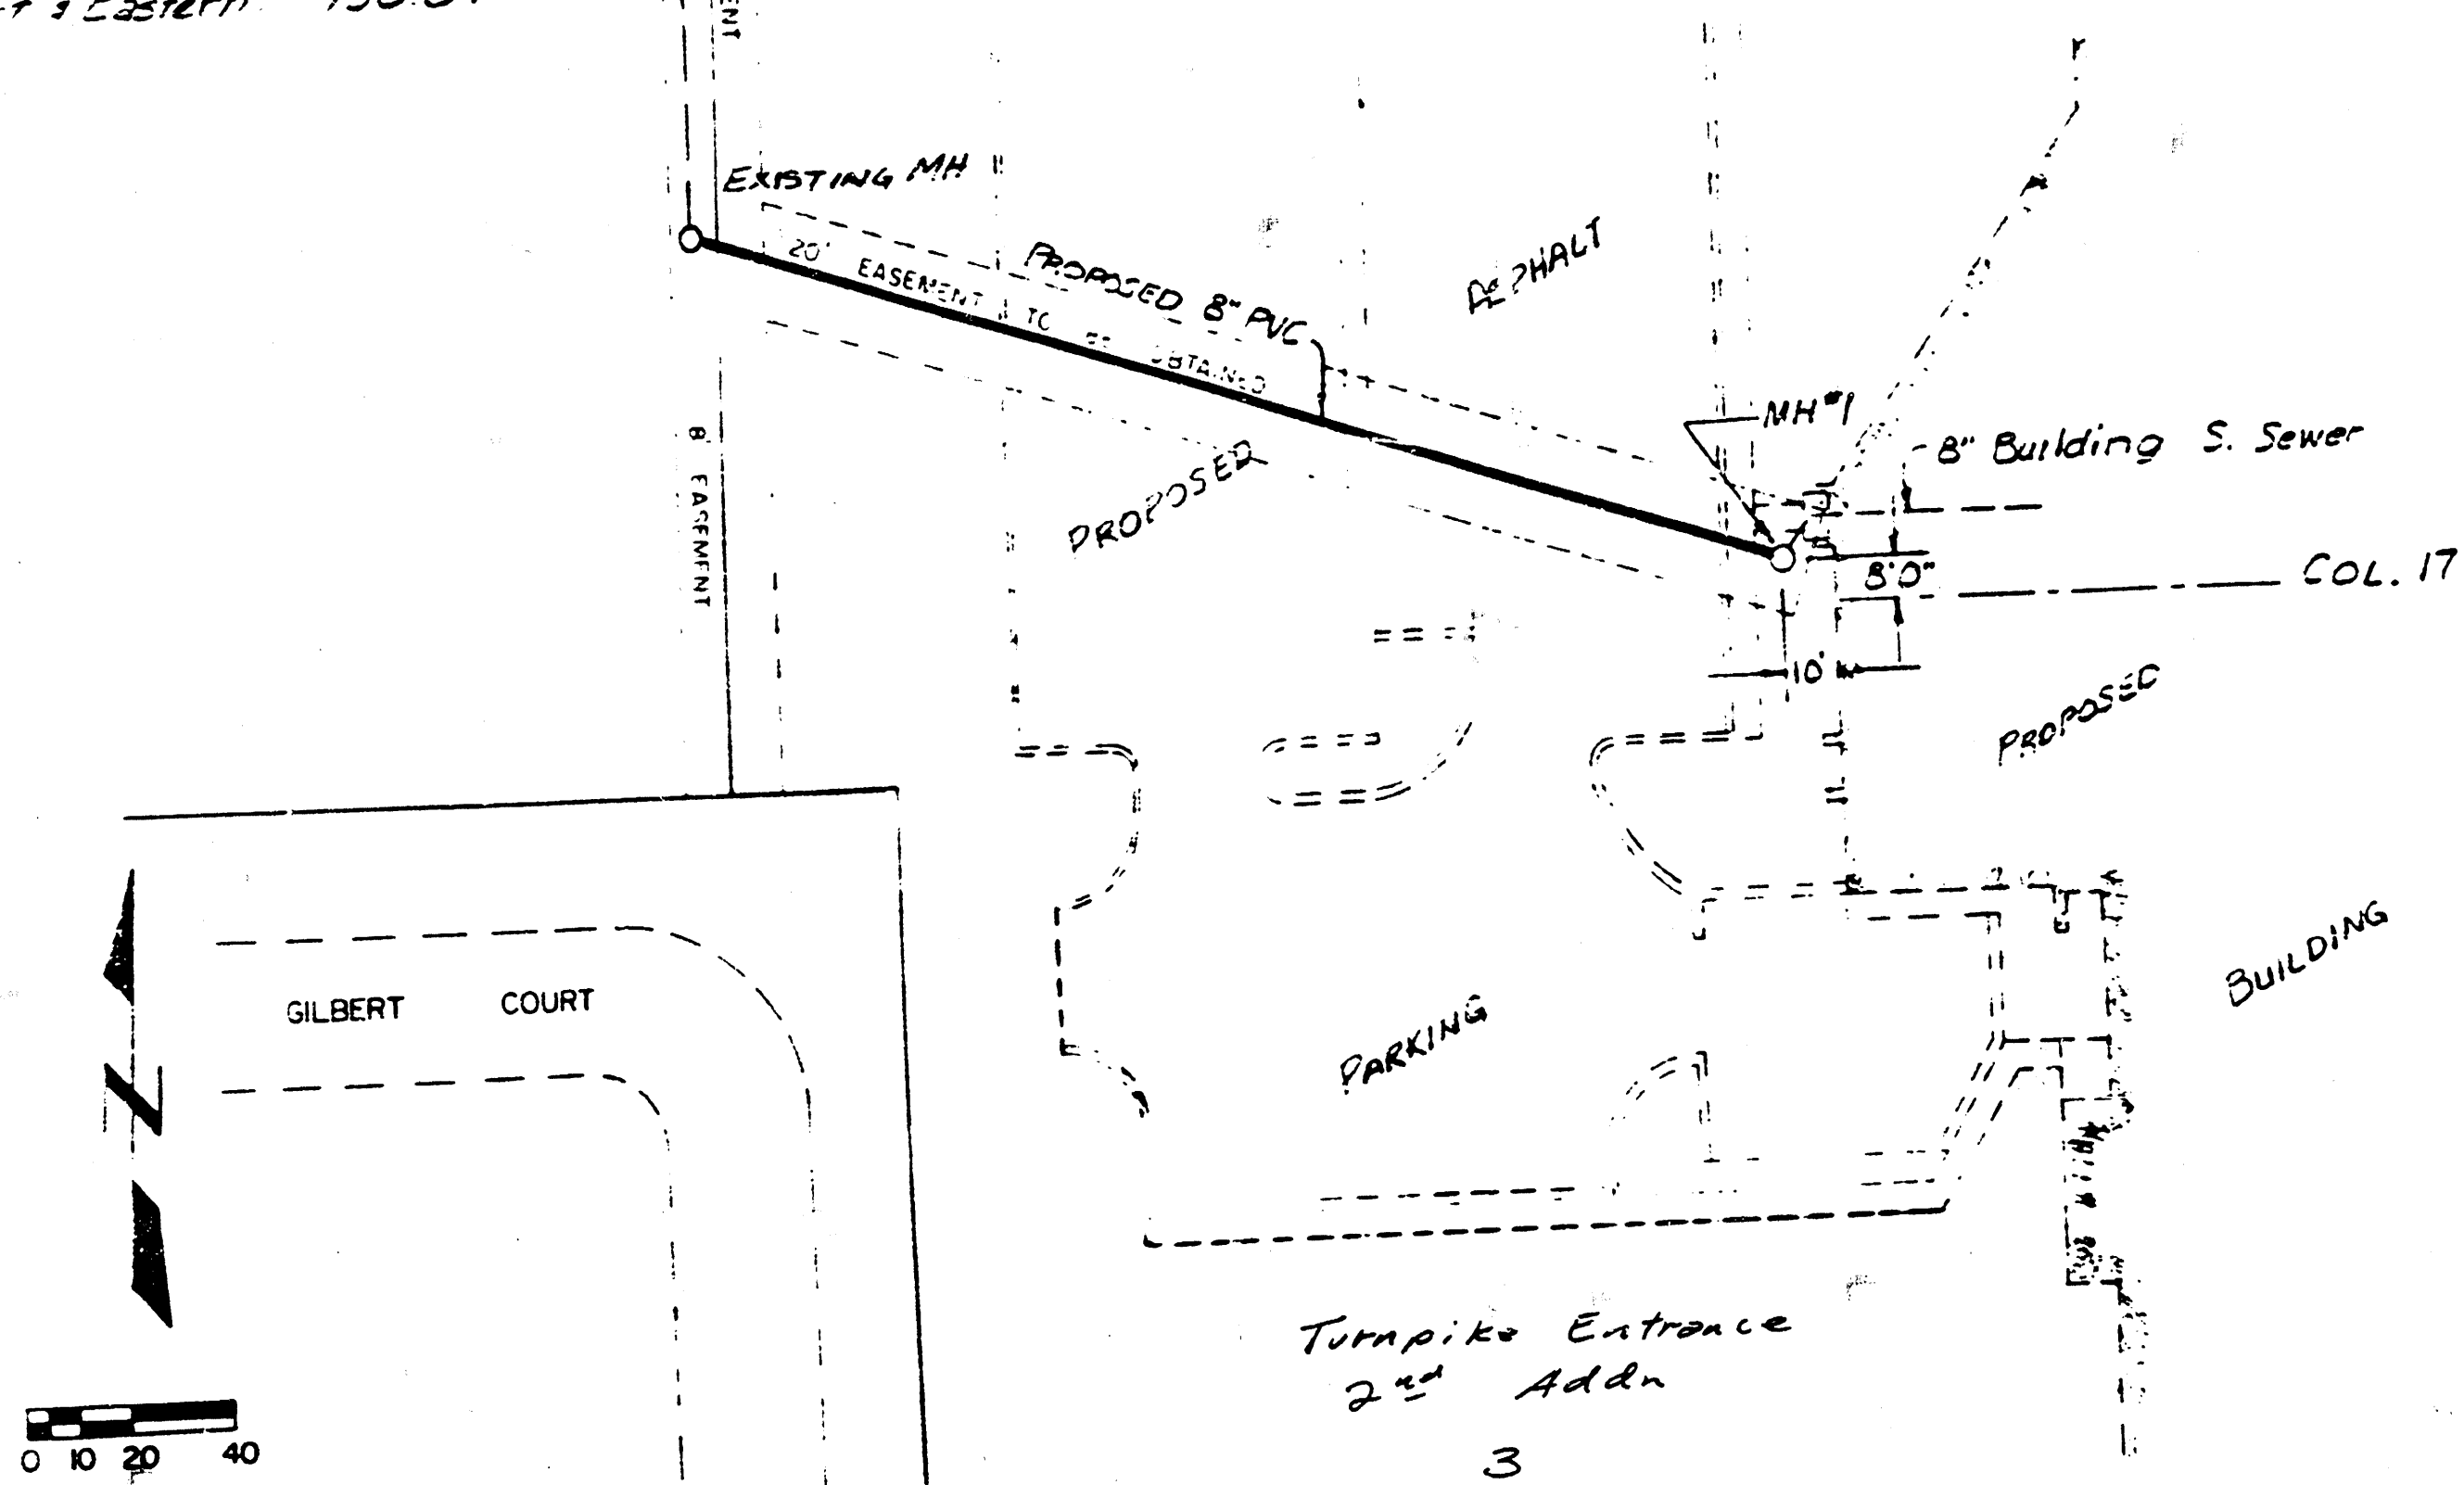

NOTE: See City of Wichita Sewer Specifications

8" WATER MAIN CROSSING ORME STREET FOR CHARTER MEDICAL CENTER AND SANITARY SEWER WATER MAIN INSTALLATION AND SANITARY SEWER INSTALLATION PRIVATE PROJECT NO. 448-76-245-80001-000-000-127

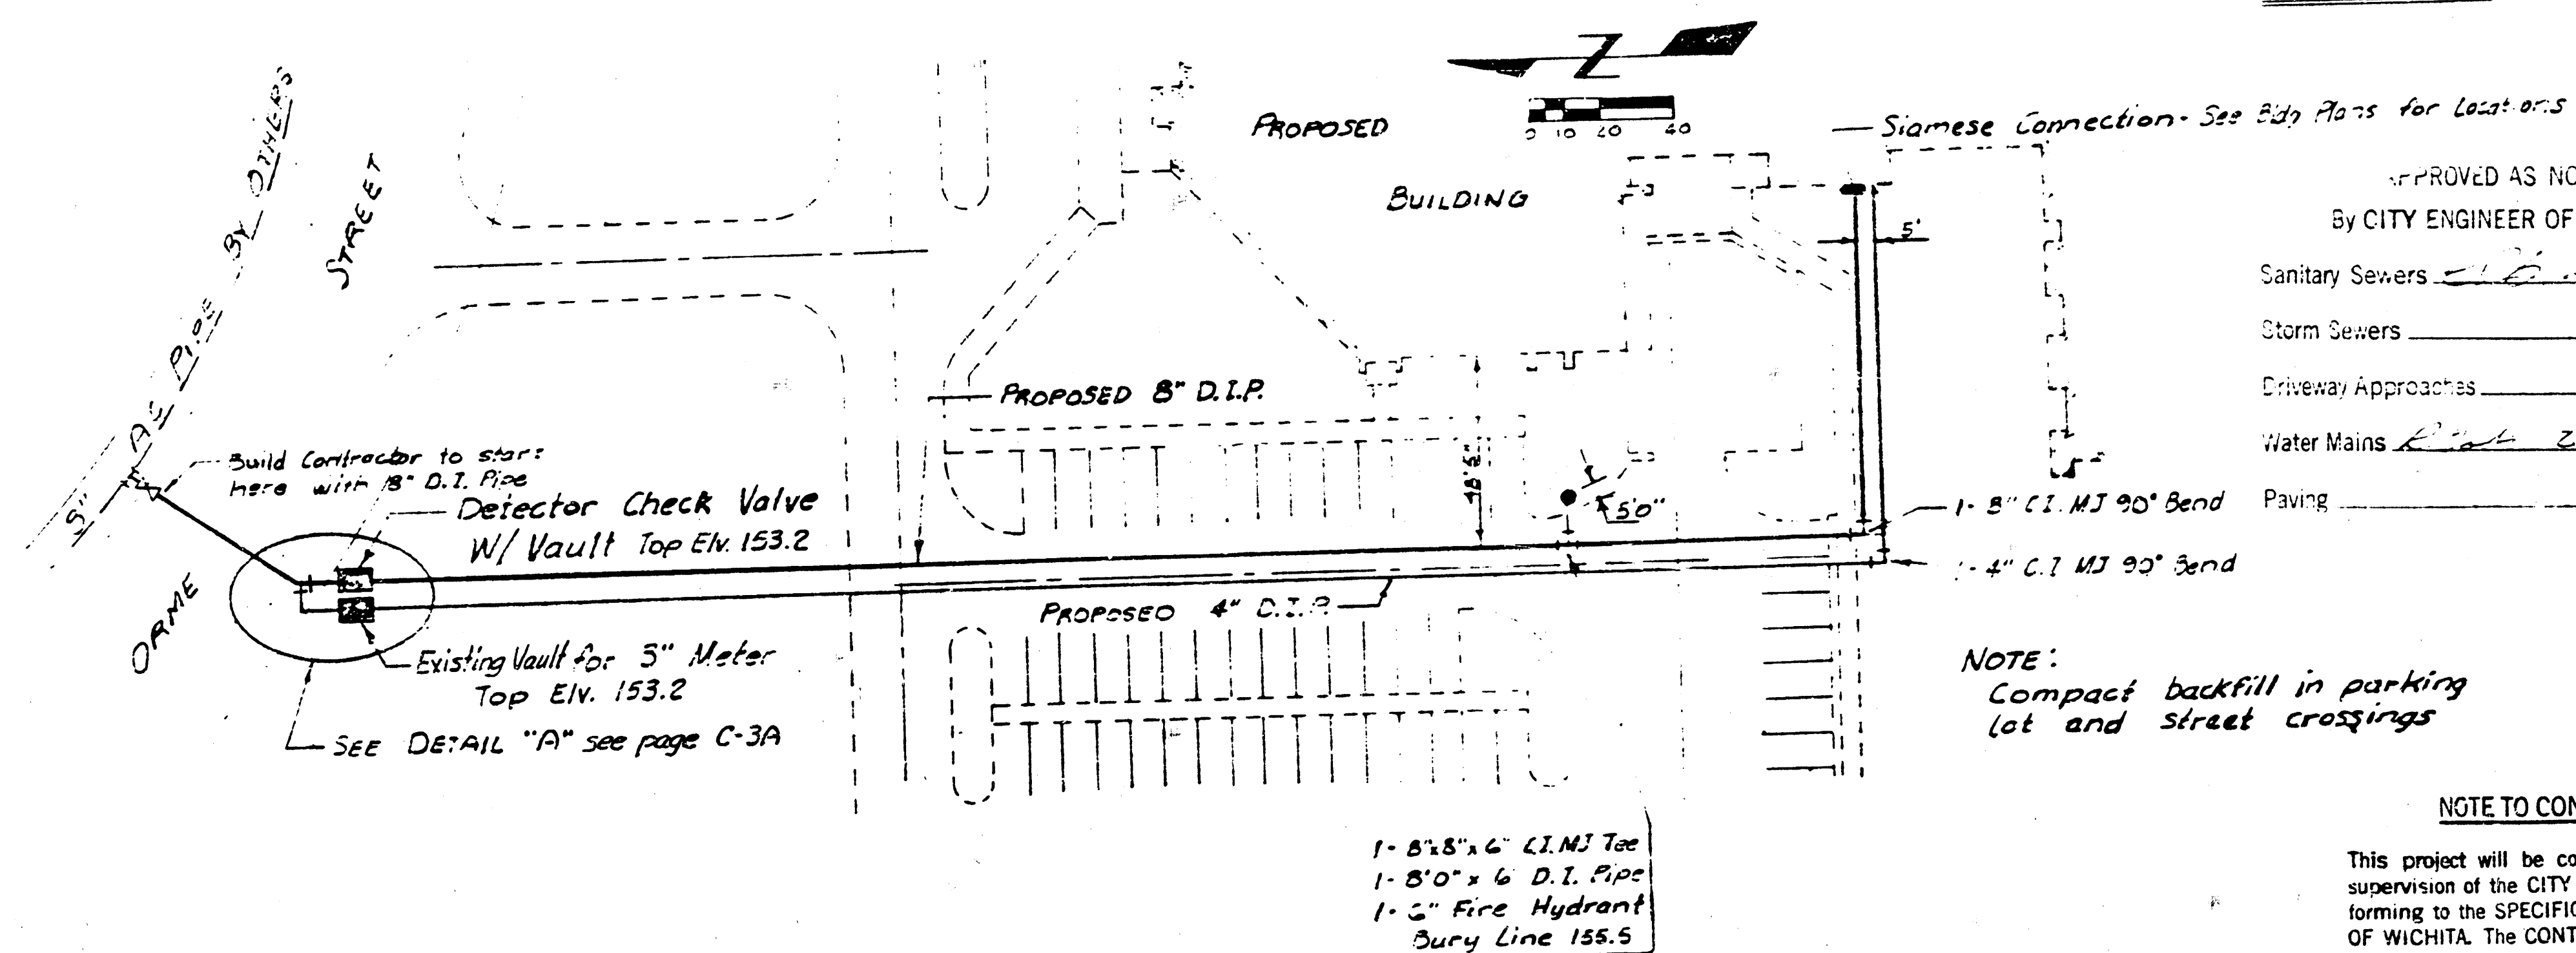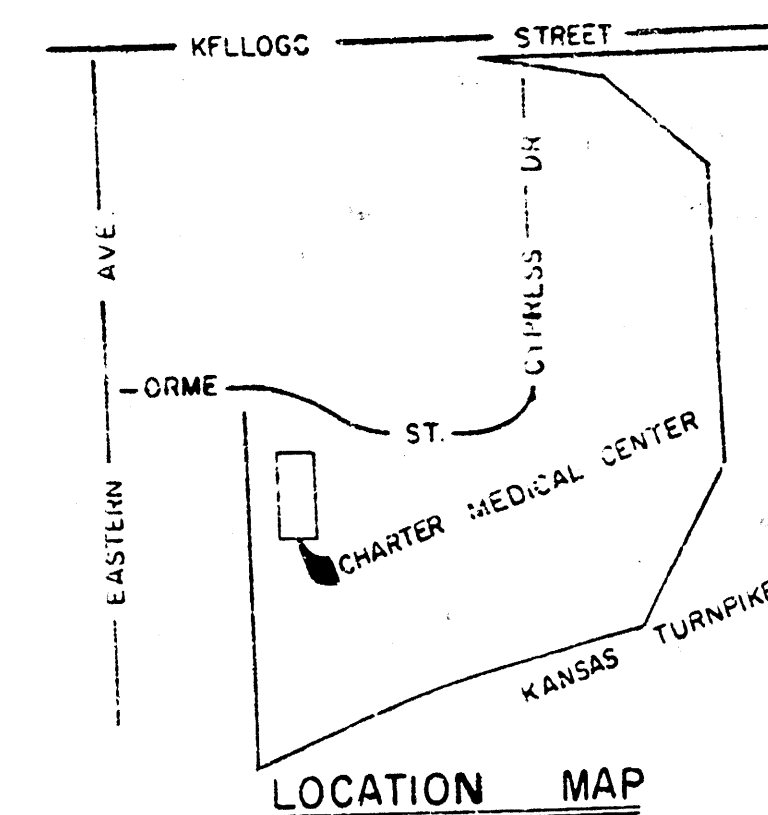


NOTE: Compact backfill in parking lot and street crossings

NOTE TO CONTRACTOR

This project will be constructed under the supervision of the CITY ENGINEER and conforming to the SPECIFICATIONS of the CITY OF WICHITA. The CONTRACTOR will pay the City of Wichita for all costs of plan review, inspection and looking per contract.


- △ Redesigned 8" PVC Sanitary Sewer - Feb. 12, 1986
- △ Redesigned 8" Water Service and locations of concrete Vaults

NOTE: Fill must be in place from Sta 3+00 to Sta 5+71 before water line is placed.

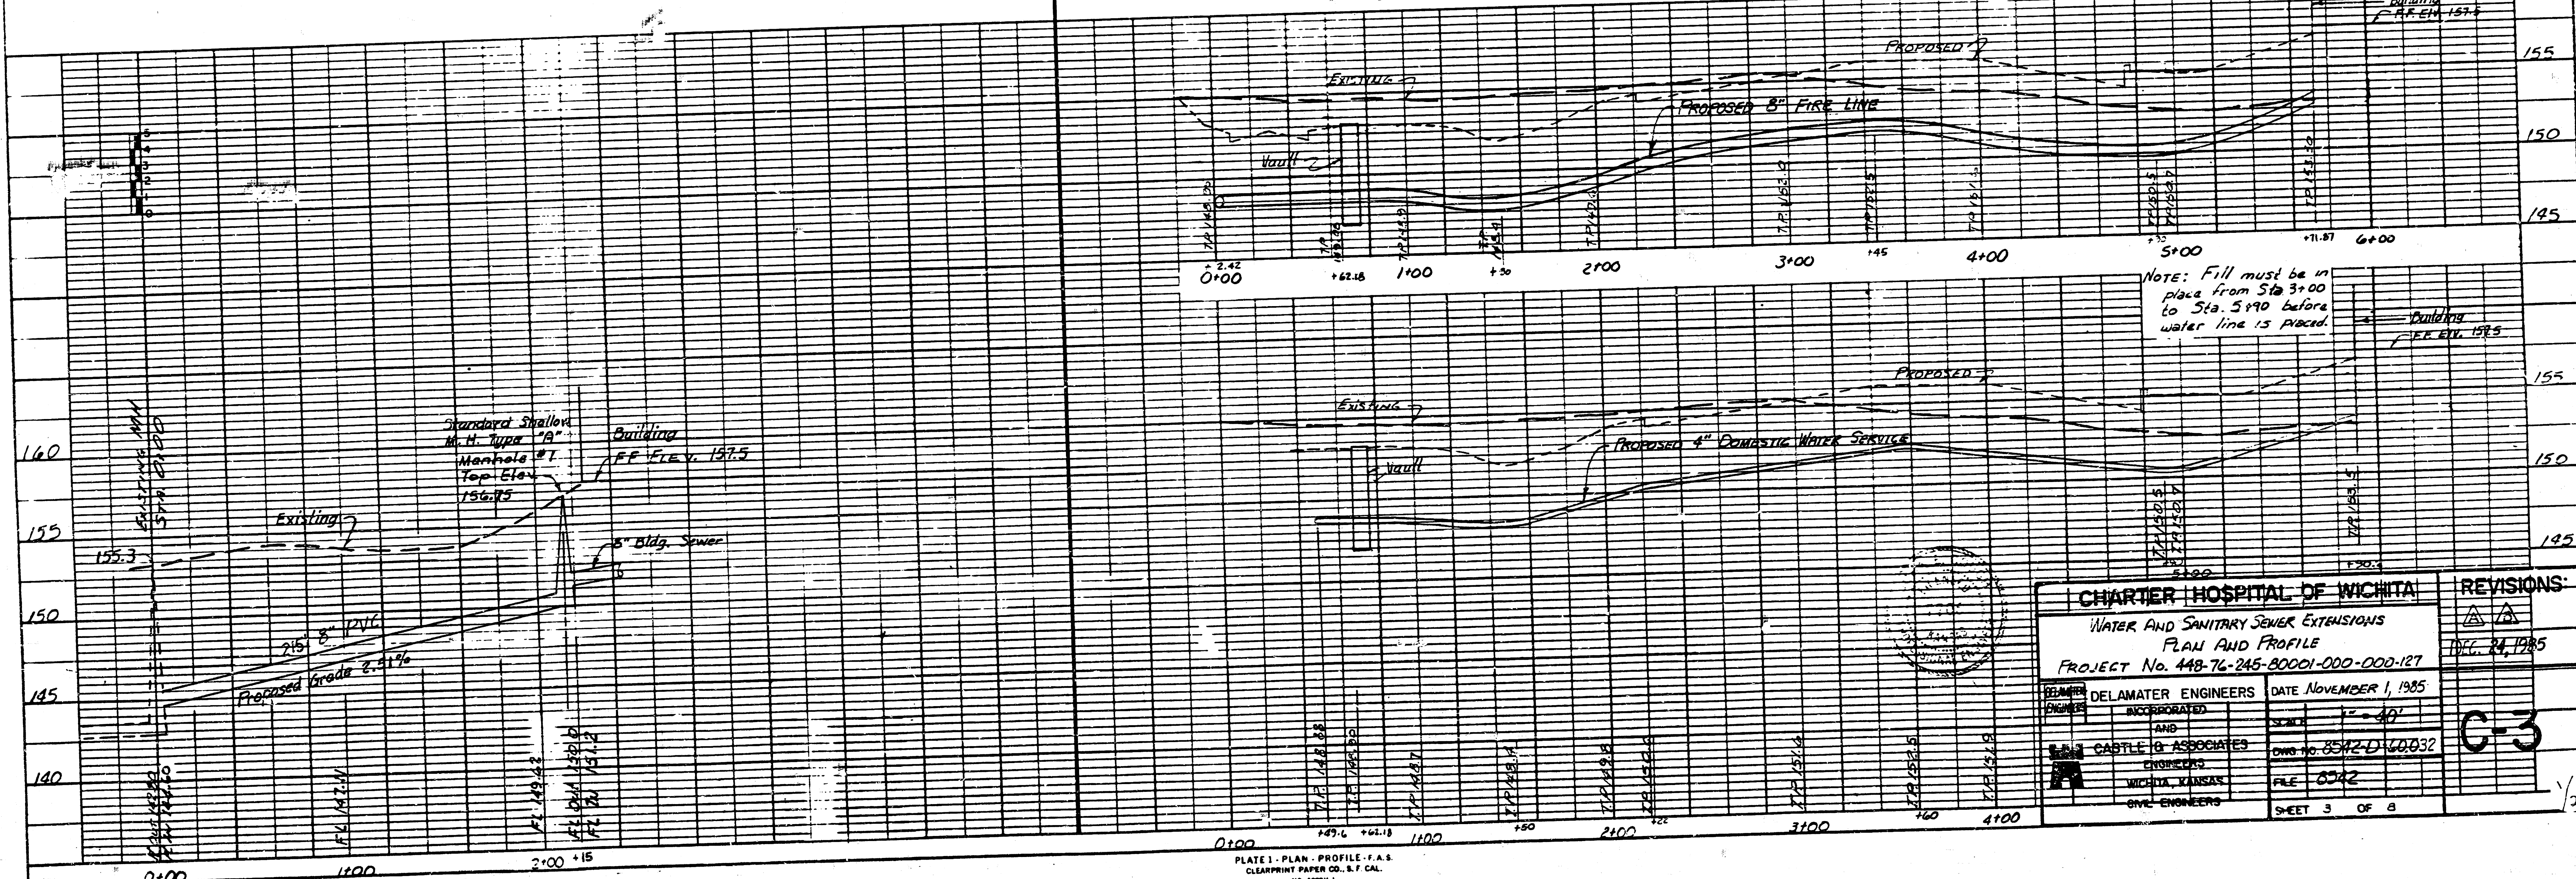

CHARTER HOSPITAL OF WICHITA		REVISIONS	
WATER AND SANITARY SEWER EXTENSIONS		DATE NOVEMBER 1, 1985	
PLAN AND PROFILE		NOV. 24, 1985	
PROJECT NO. 448-76-245-80001-000-000-127		C-3	
DESIGNED BY	DELMATER ENGINEERS	DATE	NOVEMBER 1, 1985
CHECKED BY	INCORPORATED	SCALE	1" = 40'
APPROVED BY	CITY ENGINEER	FILE NO.	8542-D-40052
WICHITA, KANSAS		FILE	8542
SHEET 3 OF 8			

FILED FROM THE BEST AVAILABLE COPY

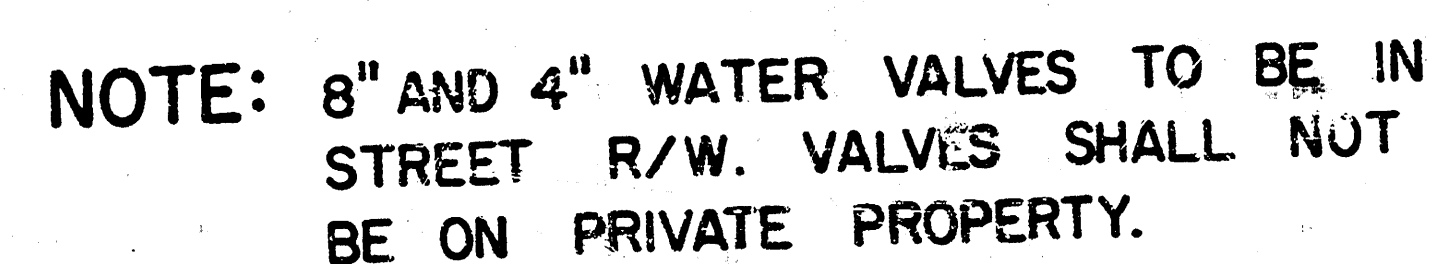

CHARTER HOSPITAL OF WICHITA		REVISIONS:	
WATER AND SANITARY SEWER EXTENSIONS DETAIL AND SPECIFICATIONS PROJECT NO. 448-76-245-80001-000-000-127		 DEC. 24, 1985	
DESIGNED BY ENGINEER	DELAWARE ENGINEERS INCORPORATED AND B. J. CASTLE & ASSOCIATES ENGINEERS WICHITA, KANSAS CIVIL ENGINEERS	DATE	NOVEMBER 1, 1983
		SCALE	1" = 40'
		DWG. NO.	35K-22 C-3033
		FILE	6742
		SHEET	5A OF 8