


PLANS FOR SANITARY SEWER SYSTEM CHELSEA INDUSTRIAL 2ND LOTS 1 & 2, BLOCK A

SEDGWICK COUNTY, KANSAS

CITY OF WICHITA PRIVATE PROJECT NO. 468-76-245-80001-000-000-184

1988

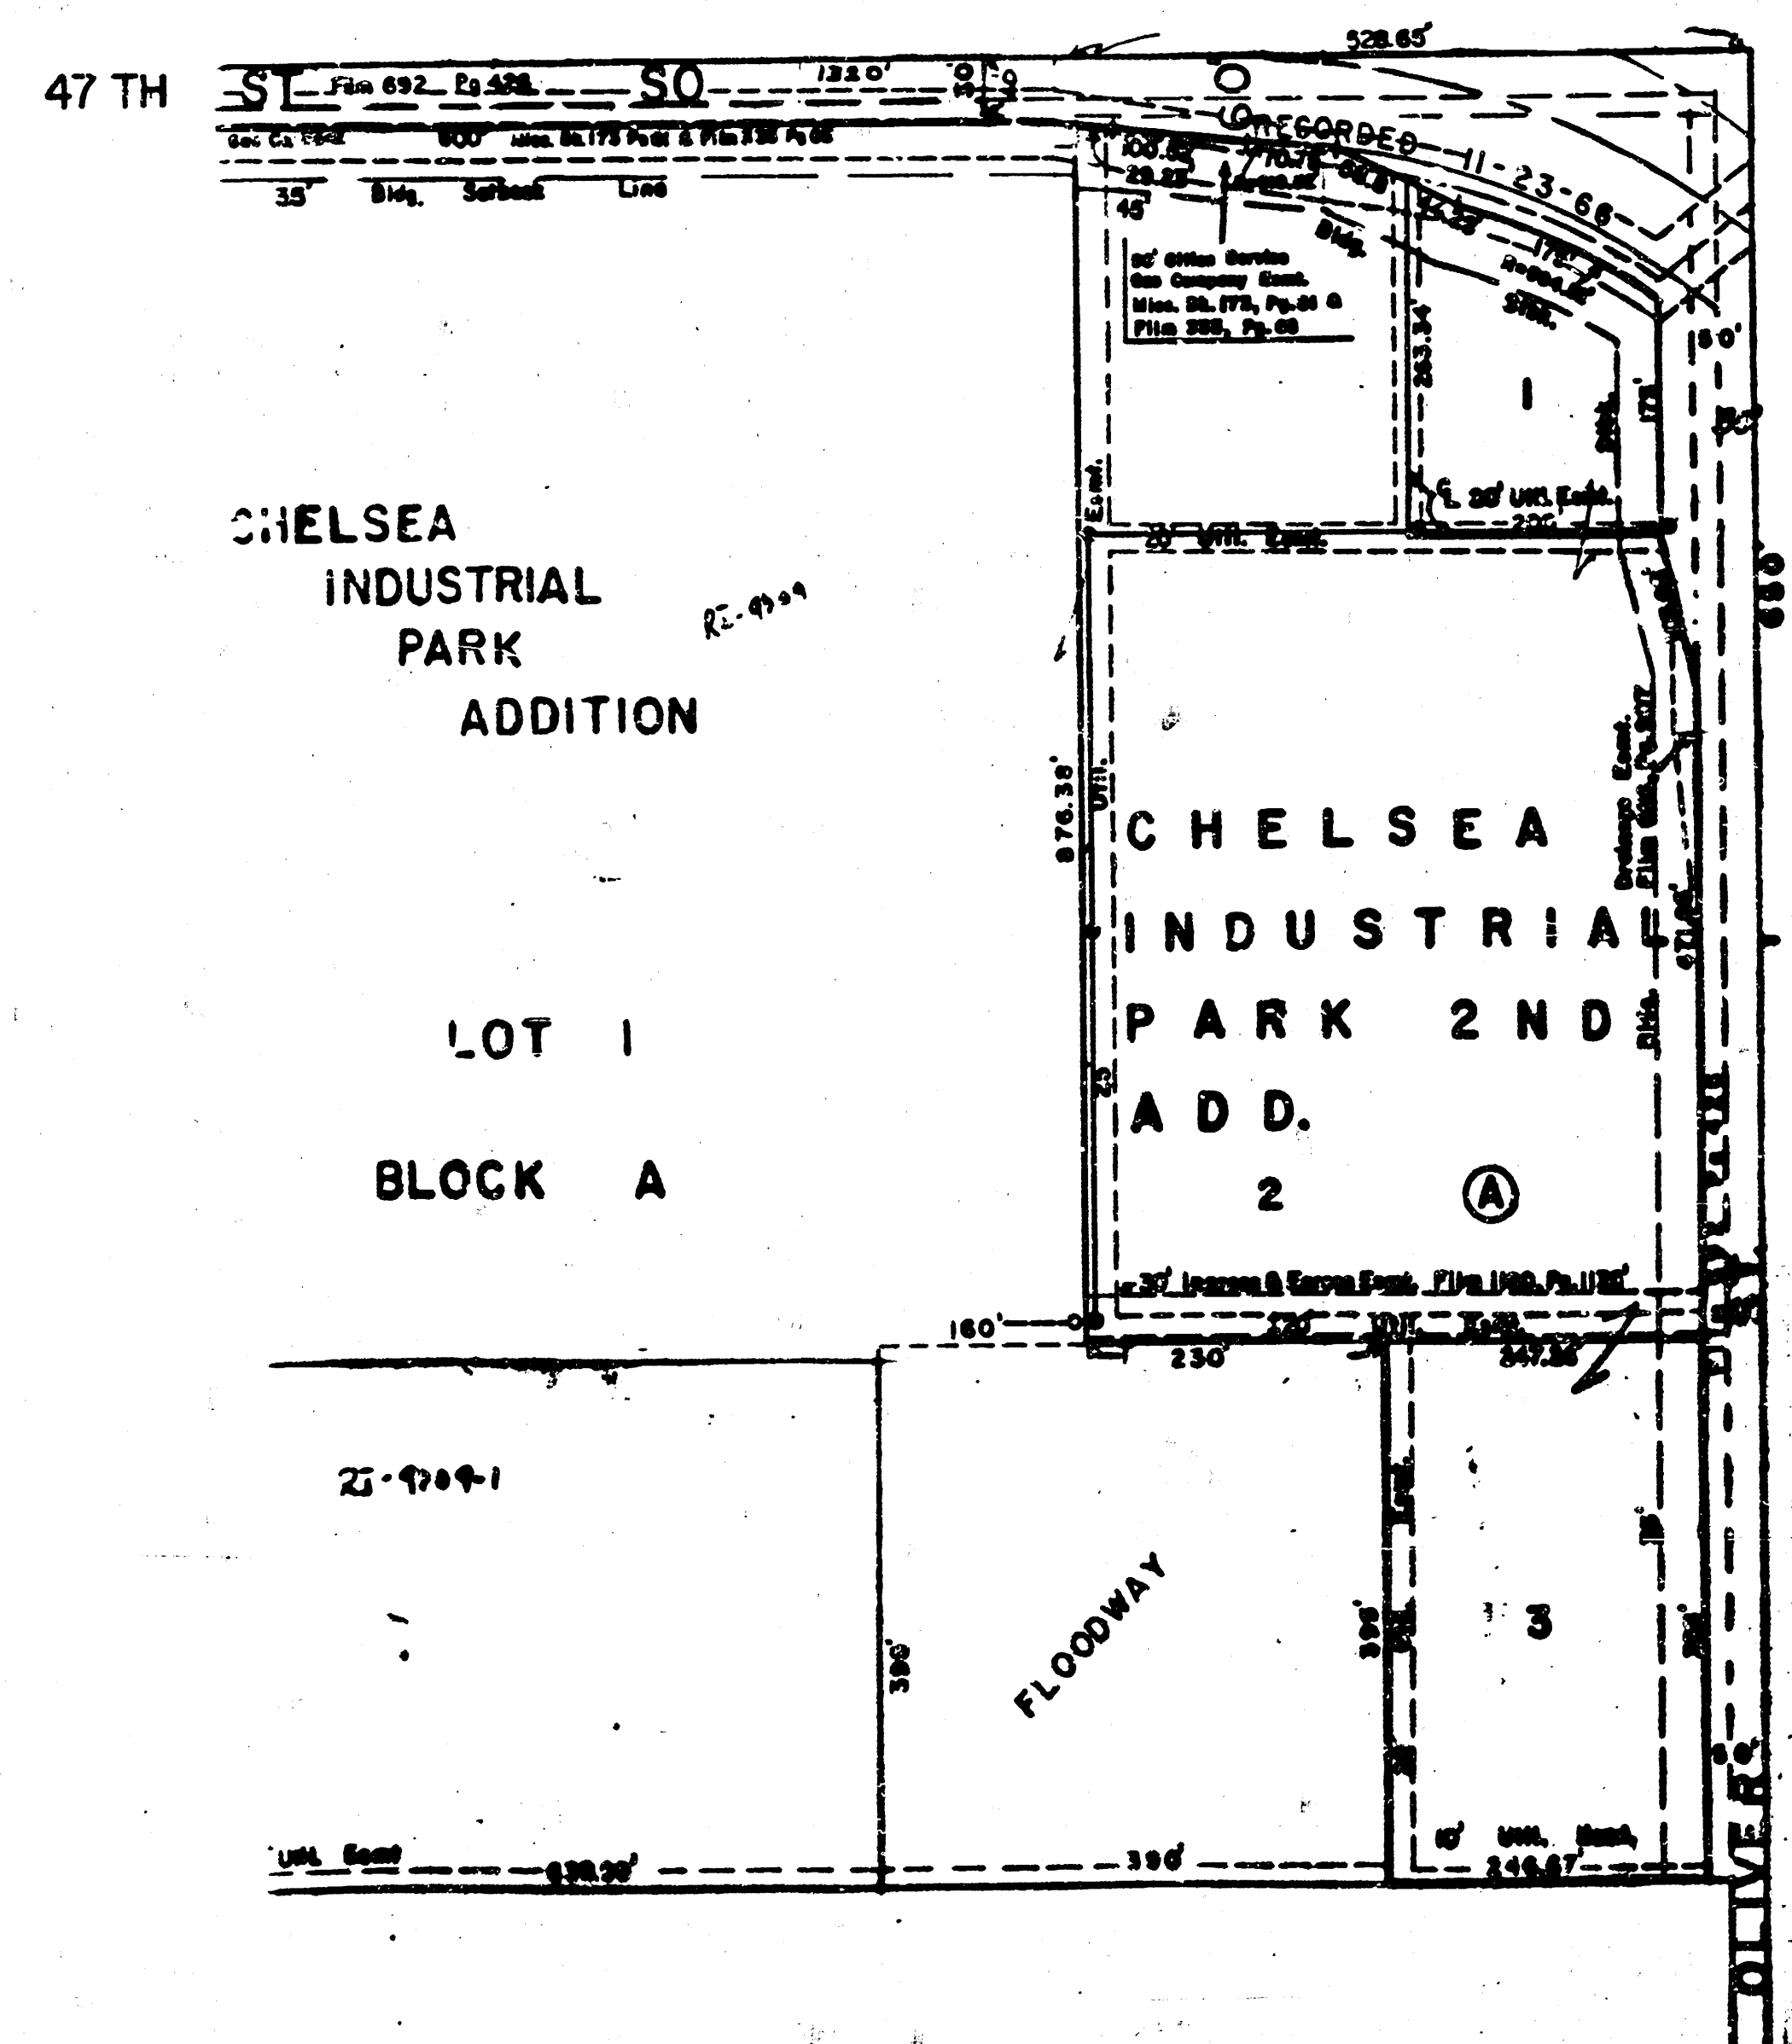

VICINITY MAP

"AS CONSTRUCTED"

APPROVED AS NOTED
By CITY ENGINEER OF WICHITA
Sanitary Sewers *2/10/25/88*
Storm Sewers _____
Driveway Approaches _____
Water Mains _____
Paving _____



NOTE TO CONTRACTOR
INSPECTION AND TESTING FOR THIS PROJECT IS TO BE PROVIDED BY A LICENSED CONSULTING ENGINEERING FIRM UNDER CONTRACT WITH THE OWNER/DEVELOPER. SAID INSPECTION SHALL BE IN ACCORDANCE WITH THE CITY OF WICHITA STANDARD CONSTRUCTION SPECIFICATIONS, LATEST EDITION, AND CERTIFIED BY A LICENSED CONSULTING ENGINEER. NO WORK SHALL BE COVERED OR BACKFILLED UNTIL INSPECTION HAS BEEN COMPLETED. THE CITY ENGINEER SHALL NOT BE RESPONSIBLE FOR ANY DELAY WITHOUT WRITTEN AUTHORIZATION BY THE CITY ENGINEER.



REISS & GOODNESS ENGINEERS
2100 WEST 21ST STREET
WICHITA, KANSAS 67203
(316) 838-0225

REVISION	DRAWN BY	CHECKED BY	DESIGNED BY	PROJECT	CUSTOMER	SCALE	PROJECT NO.
	DEJ	RP	RP			1/2"	DATE 10-28-88 SHEET 1 OF 5

FILMED FROM THE BEST
AVAILABLE COPY....

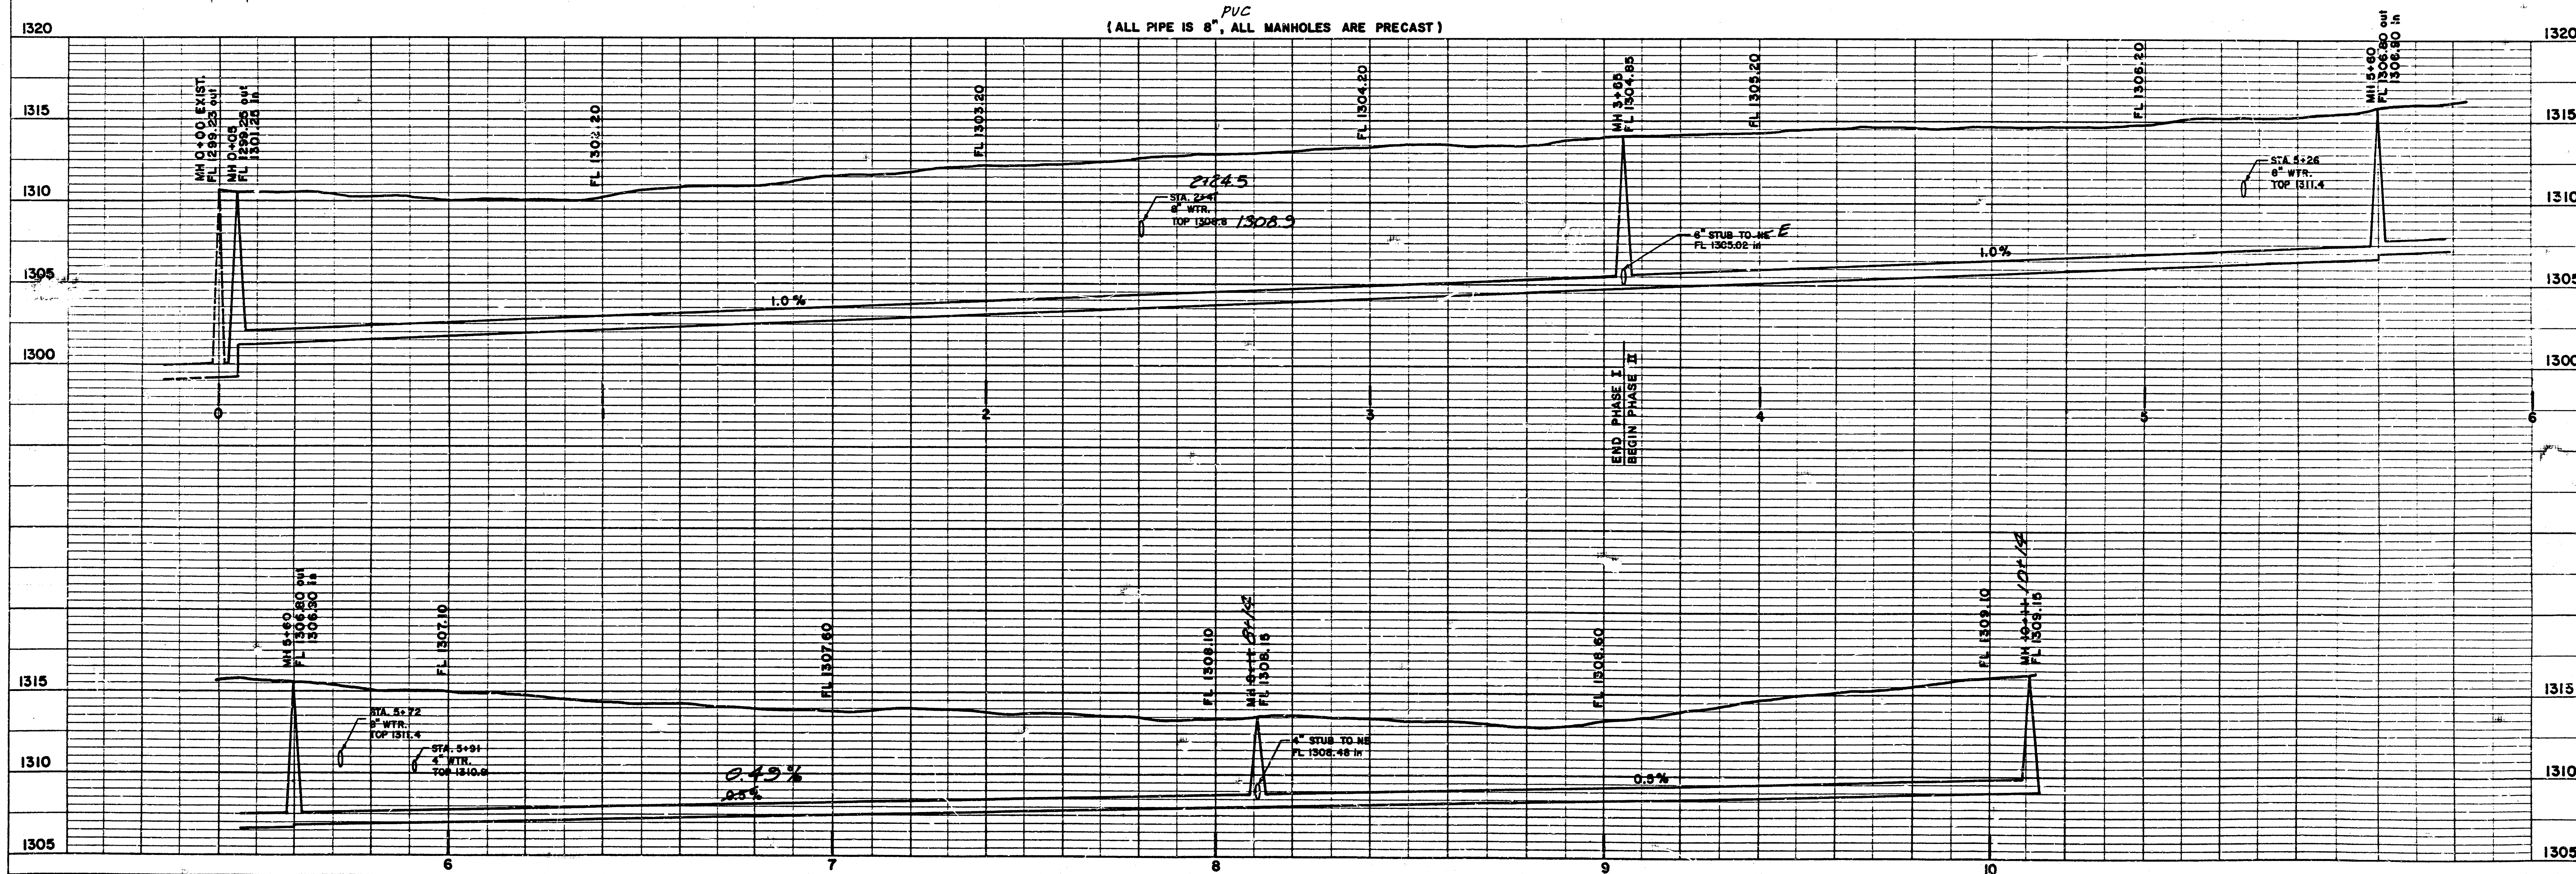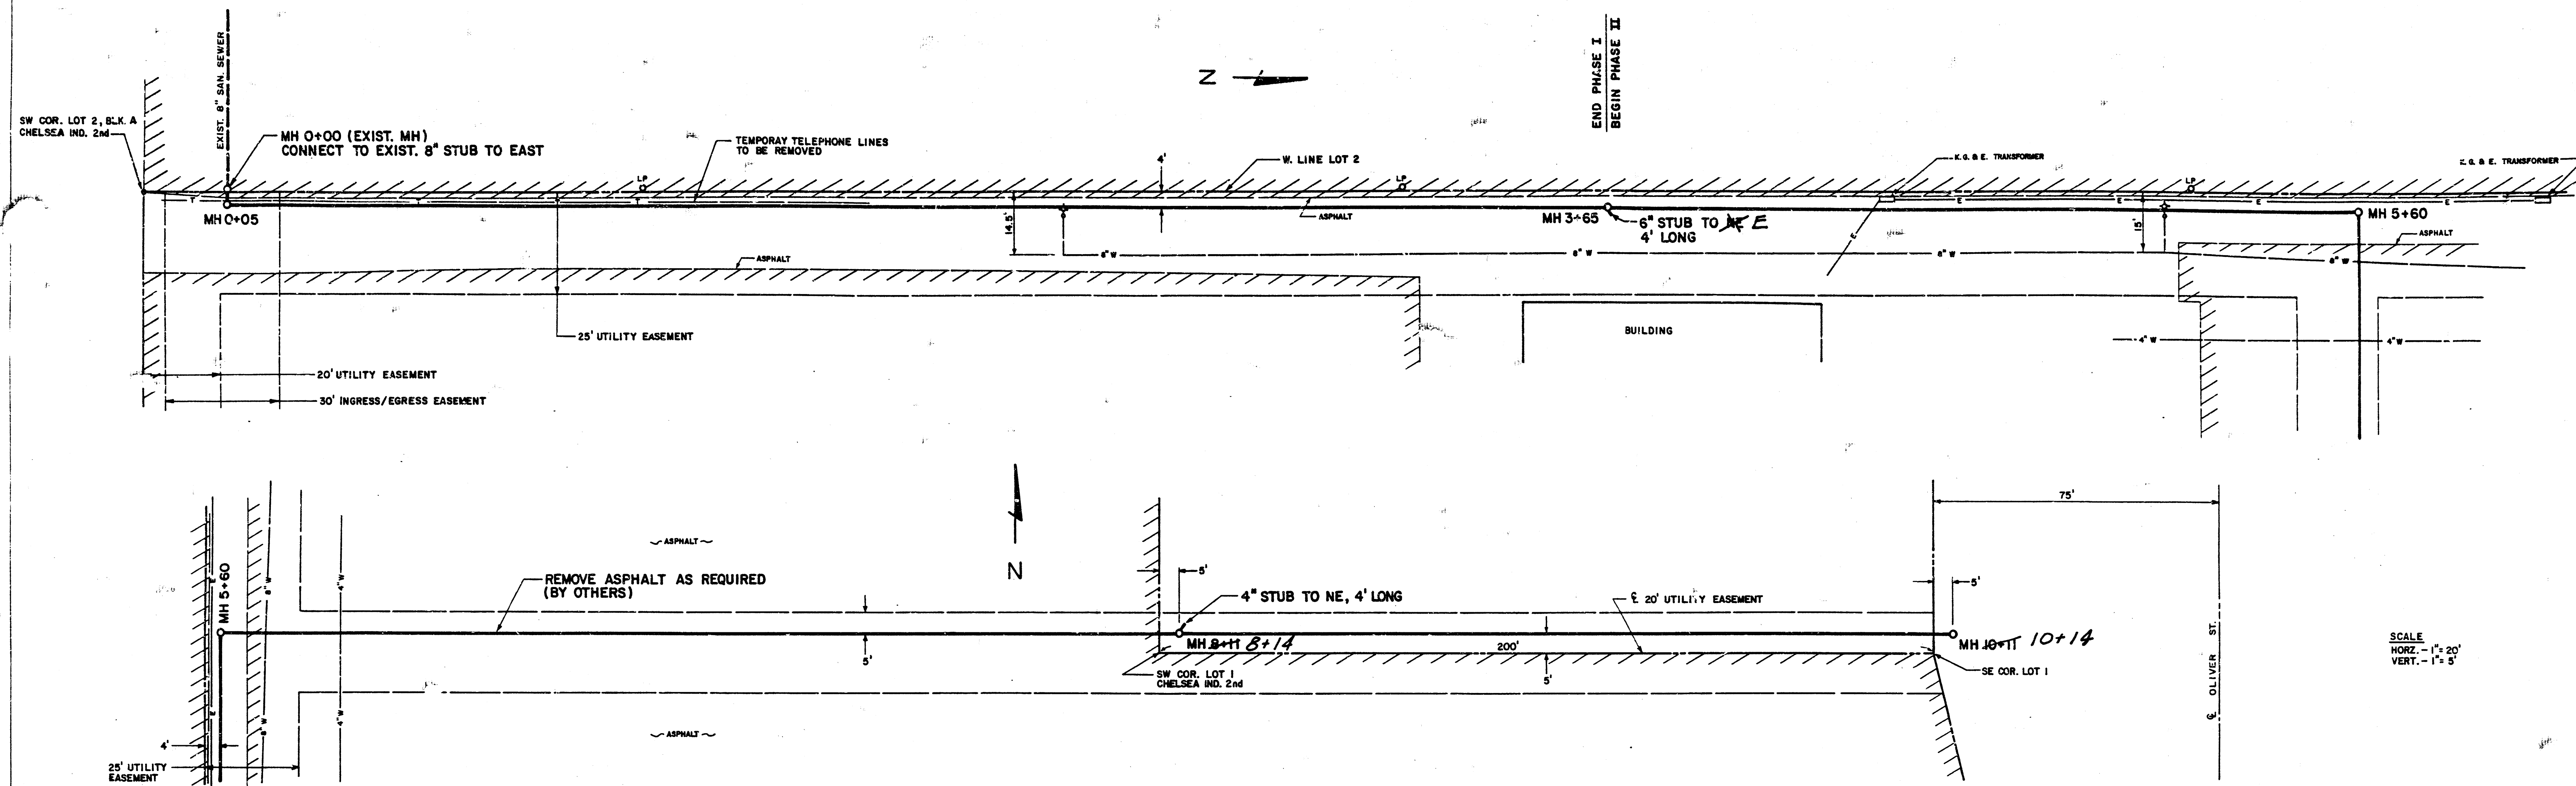

DEISS & GOODNESS ENGINEERS
 2100 WEST 21ST STREET
 WICHITA, KANSAS 67203
 (316) 832-0225

REVISION	DRAWN BY	CHECKED BY	DESIGNED BY	PROJECT	CUSTOMER	DATE	SCALE	NOTED	PROJECT NO.
	DEJ	RP	RP	SANITARY SEWER EXTENSIONS	LOTS 1 & 2, BLK. A, CHELSEA INDUSTRIAL 2nd	10-26-88	2"	10-26-88	2 OF 5

FILMED FROM THE BEST AVAILABLE COPY