

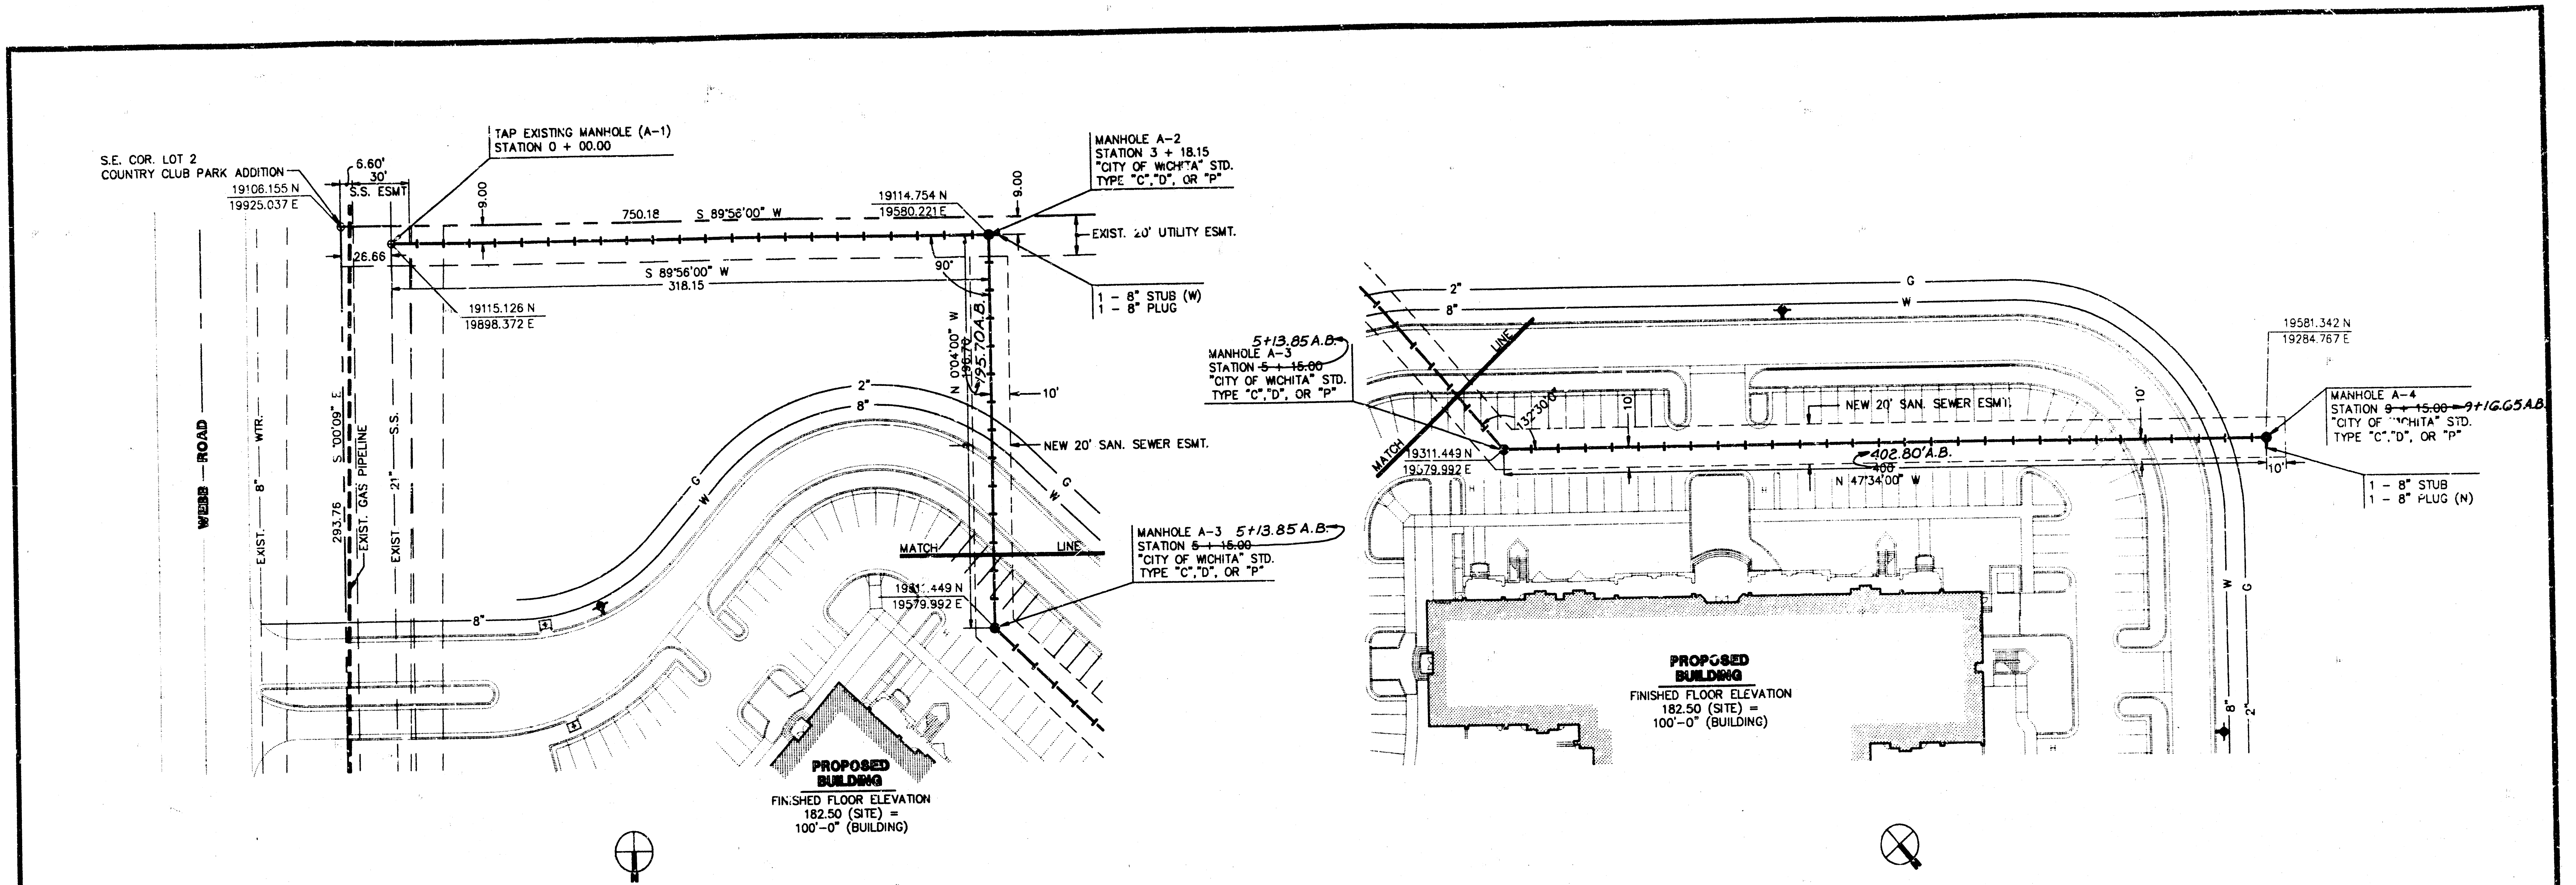


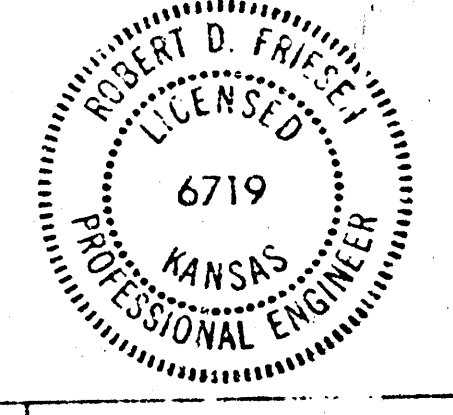

A SANITARY SEWER PLAN AND PROFILE

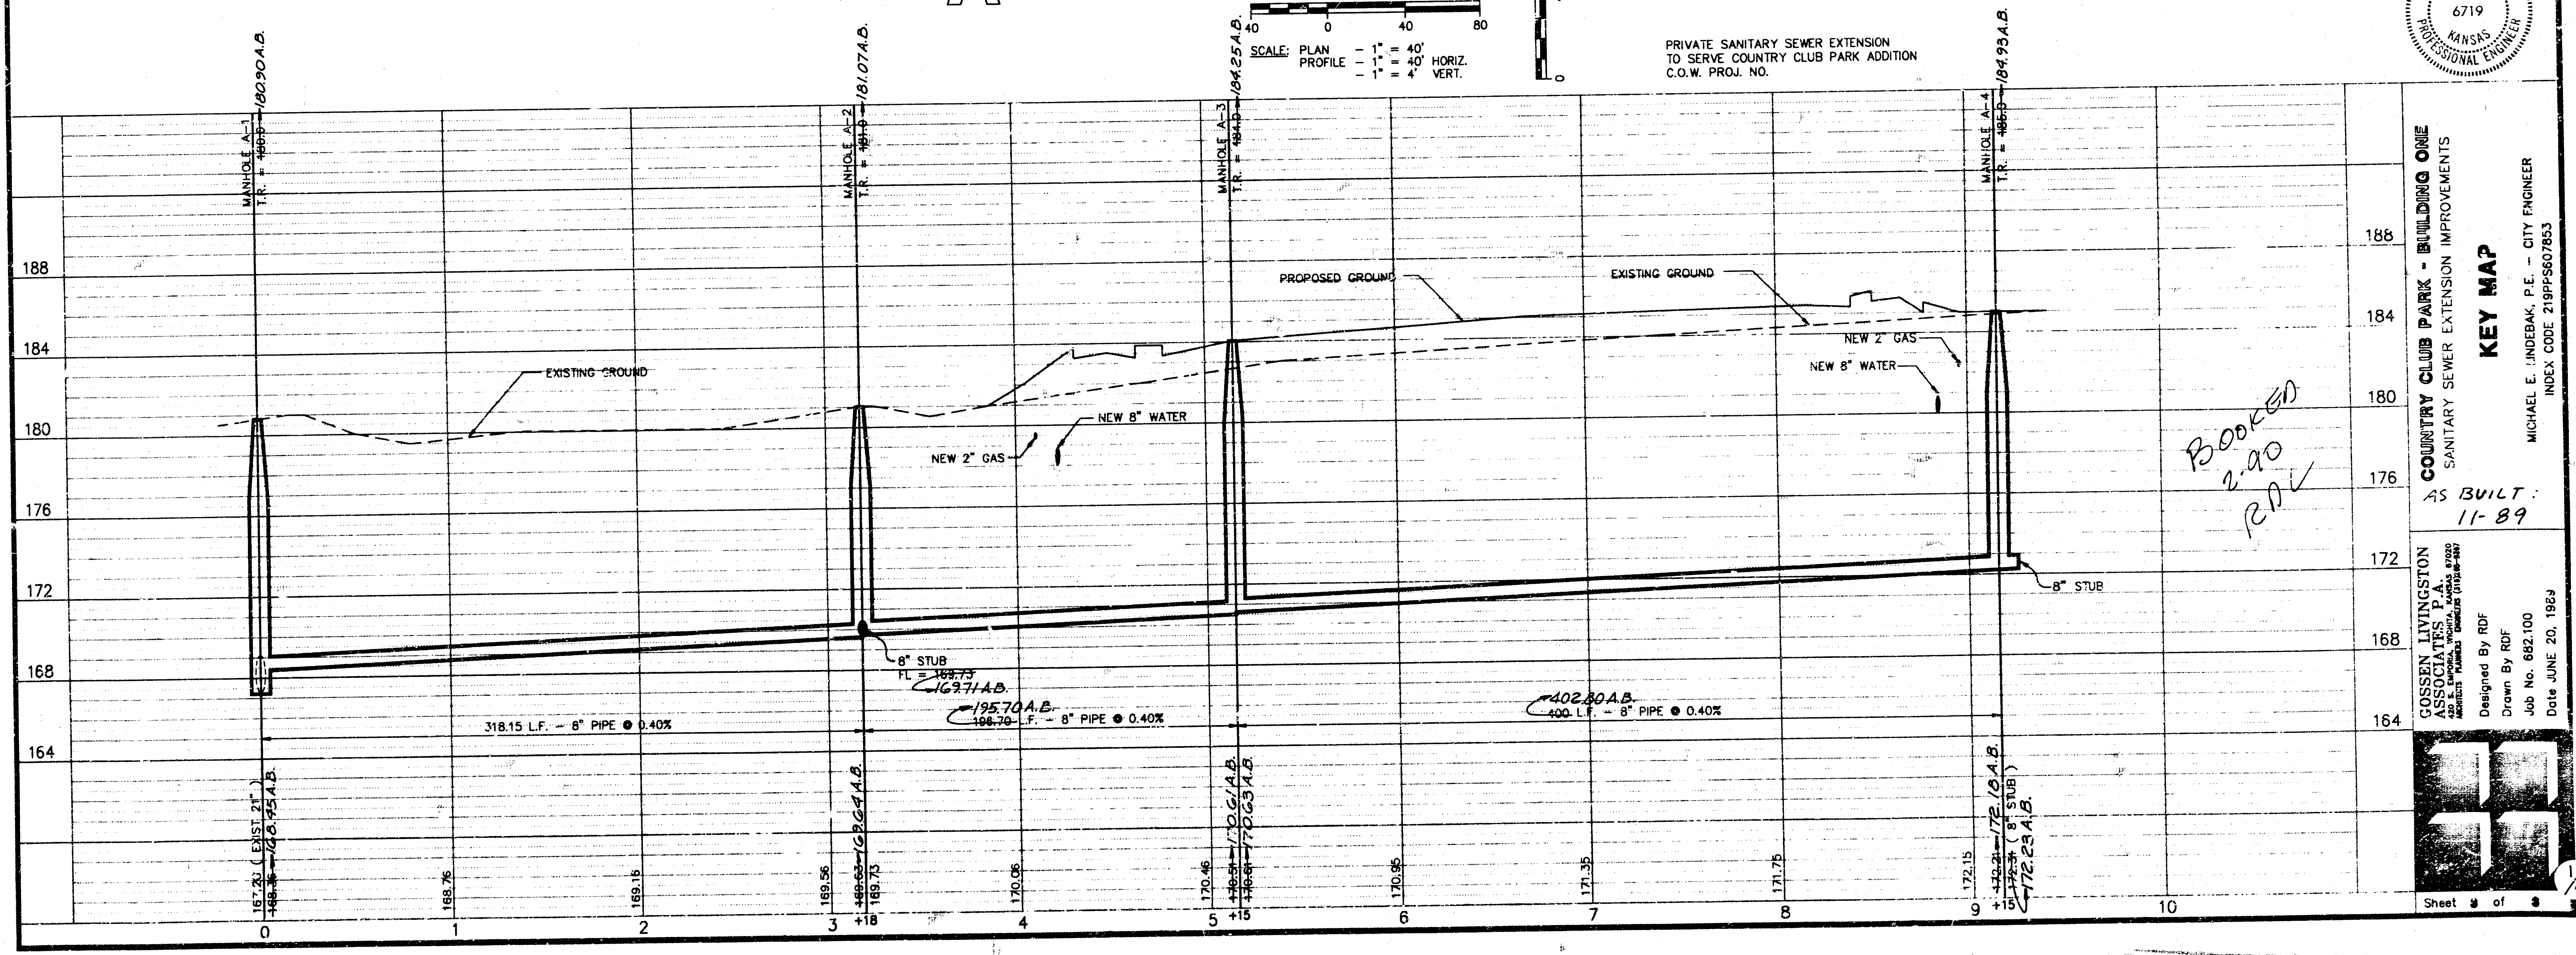

KEY MAP

COUNTRY CLUB PARK - BUILDING ONE
SANITARY SEWER EXTENSION IMPROVEMENTS
AS BUILT:
11-89


COSSEN, LIVINGSTON
COSSEN, LIVINGSTON & ASSOCIATES, P.A.
240 E. WILSON, SUITE 200, LAWRENCE, KANSAS 66044
ARCHITECT: MICHAEL E. INDEBAK, P.E.
DESIGNED BY: R.D.F.
DRAWN BY: R.D.F.
JOB NO. 682.100
DATE: JUNE 20, 1983

Sheet 3 of 3

CONSTRUCTION PLANS FOR SANITARY SEWER EXTENSION IMPROVEMENTS TO SERVE COUNTRY CLUB PARK ADDITION TO

THE CITY OF WICHITA,
SEDGWICK COUNTY, KANSAS
MICHAEL E. LINDEBAK, P.E. - CITY ENGINEER

APPROVED AS NOTED
By CITY ENGINEER OF WICHITA
Sanitary Sewers 2-10-89
Storm Sewers _____
Driveway Approaches _____
Water Mains _____
Paving _____

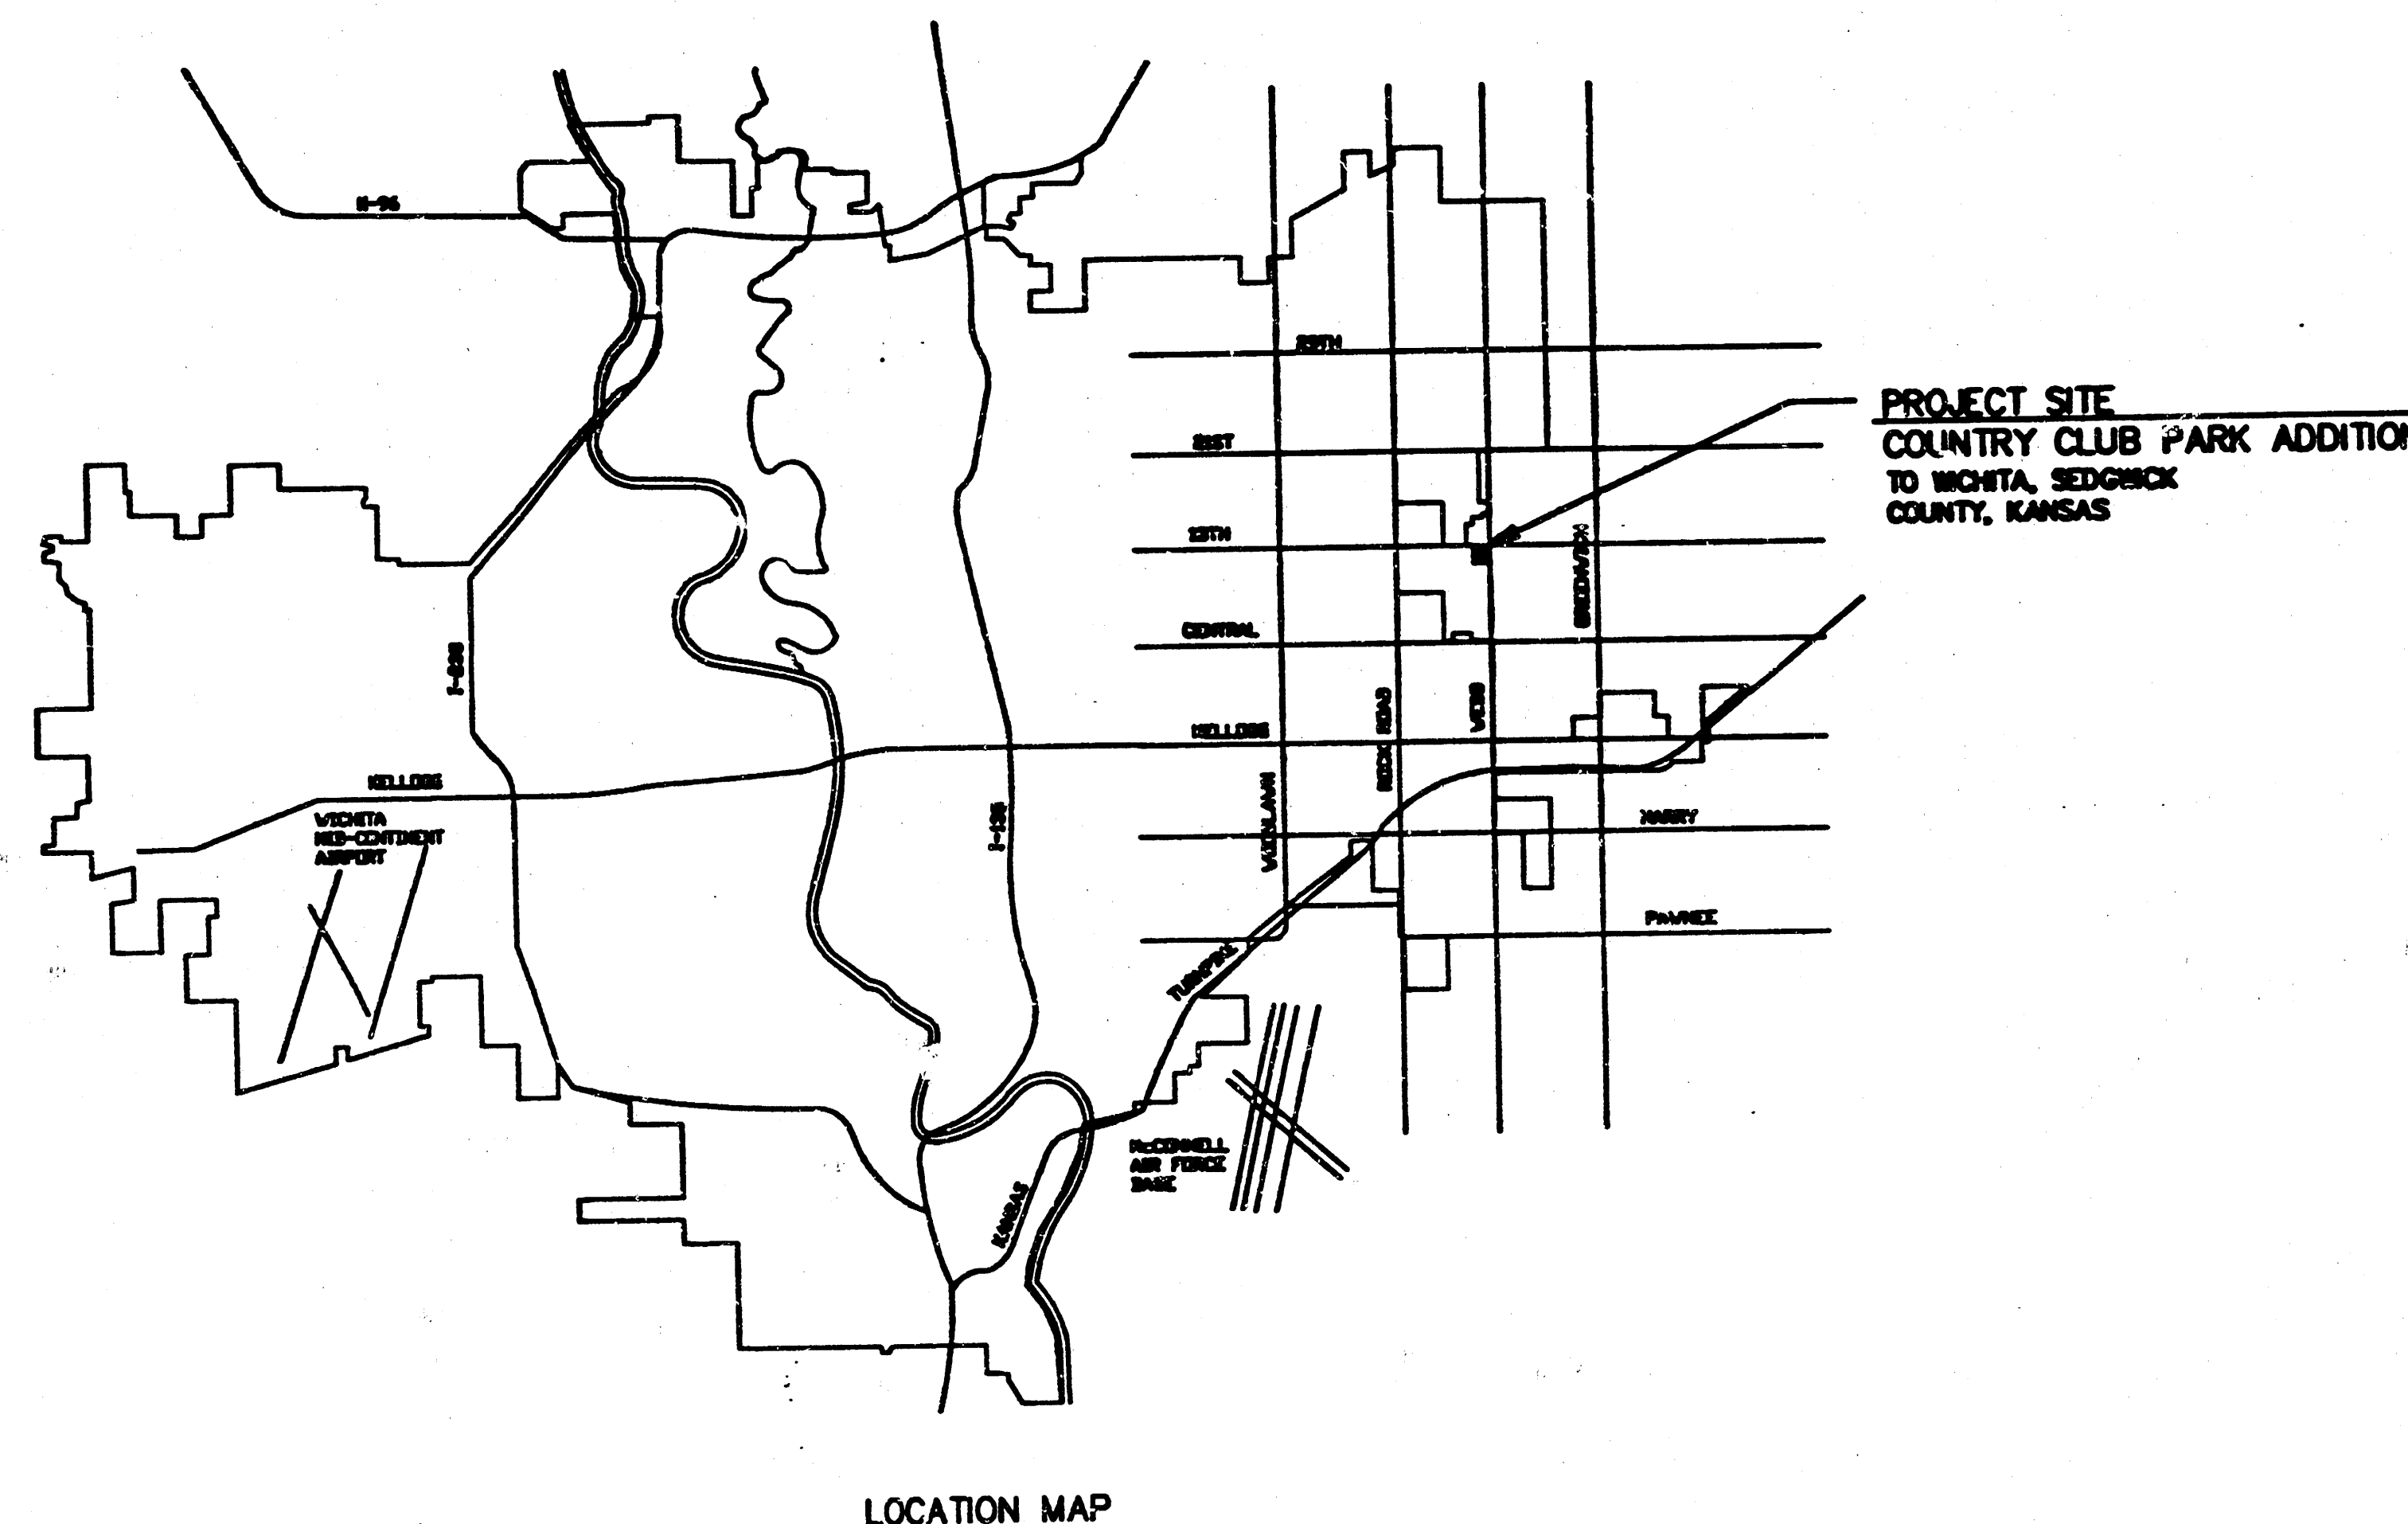

WICHITA, SEDGWICK COUNTY, KANSAS



COUNTRY CLUB PARK - BUILDING ONE
SANITARY SEWER EXTENSION IMPROVEMENTS

KEY MAP

INDEX CODE 219PPS607653

**GOSSEN LIVINGSTON
ASSOCIATES P.A.**
430 S. EMPORIA, WICHITA, KANSAS 67202
ADVERTISING PLANNING SERVICES (913) 686-6897

Designed By: RDB
Drawn By: RDB

Date JUNE 20, 1989

1

Sheet 2 of 3 ³/₄

FILMED FROM THE BEST
AVAILABLE COPY

