

AS BUILT

SANITARY SEWER SYSTEM


CRESTVIEW COUNTRY CLUB ESTATES


SOUTHERN VILLAGE ADDITION

REISS AND GOODNESS ENGINEERS



2100 E DOUGLAS WICHITA KANSAS

1973

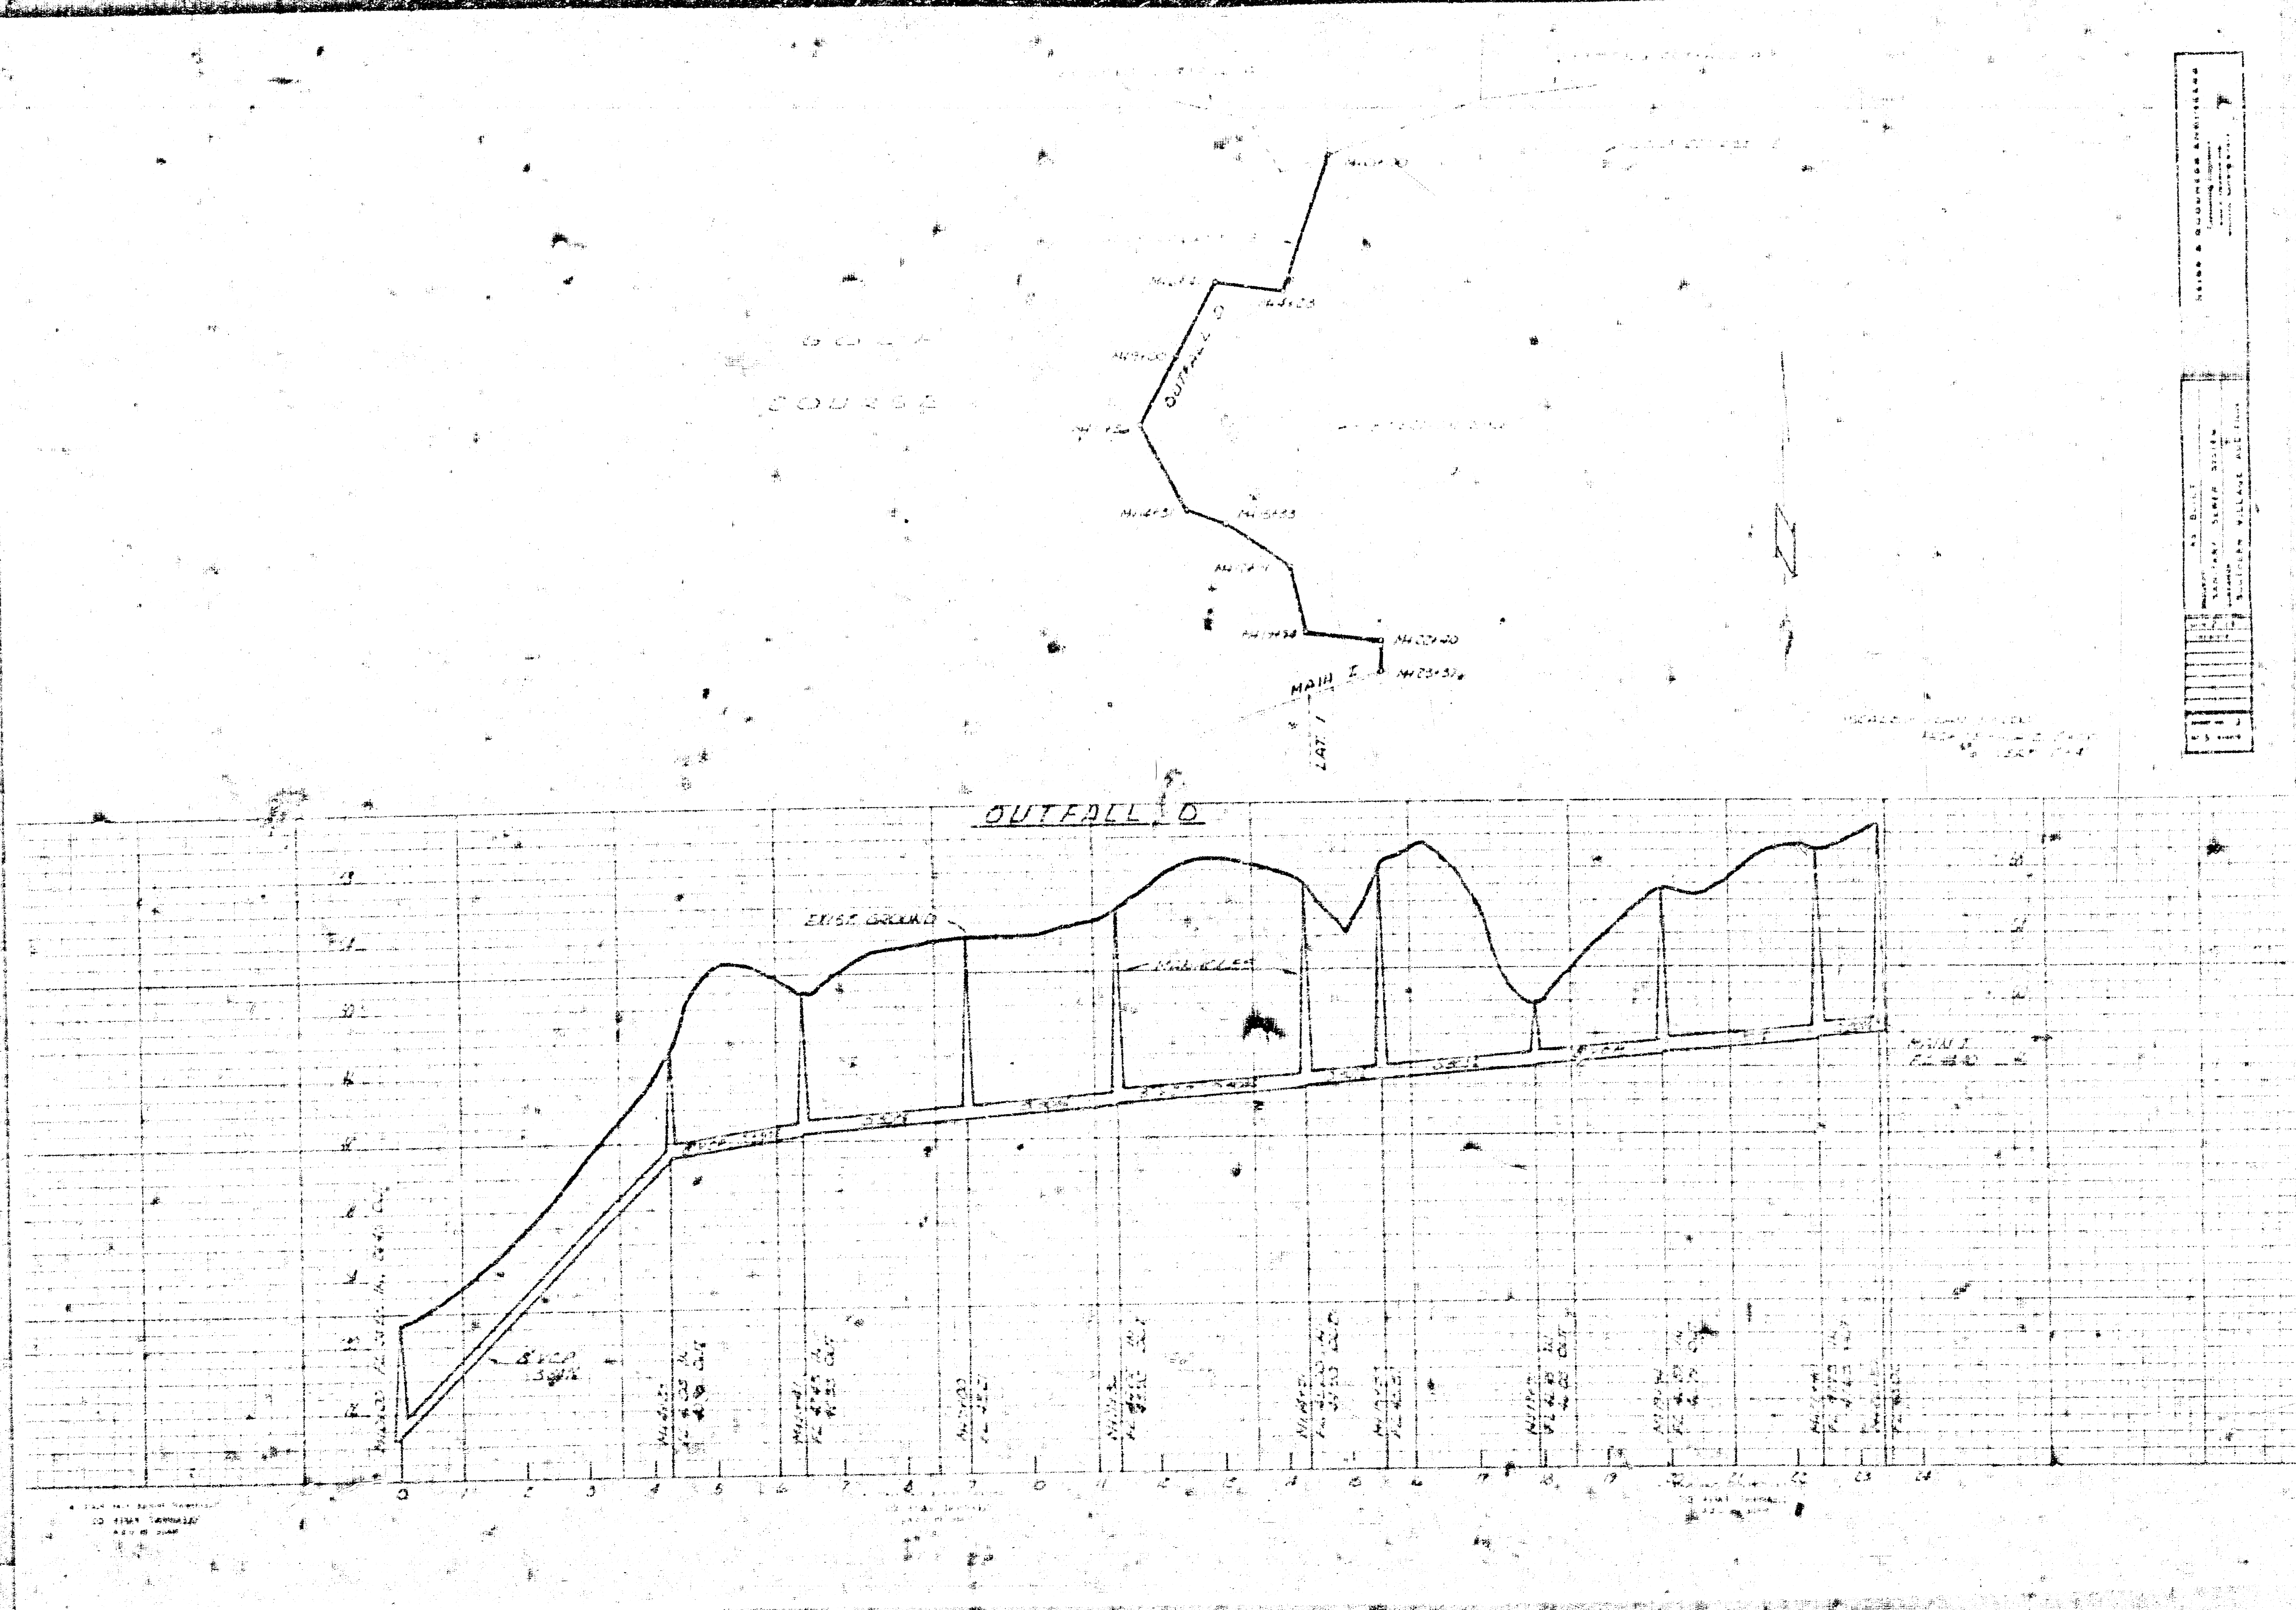

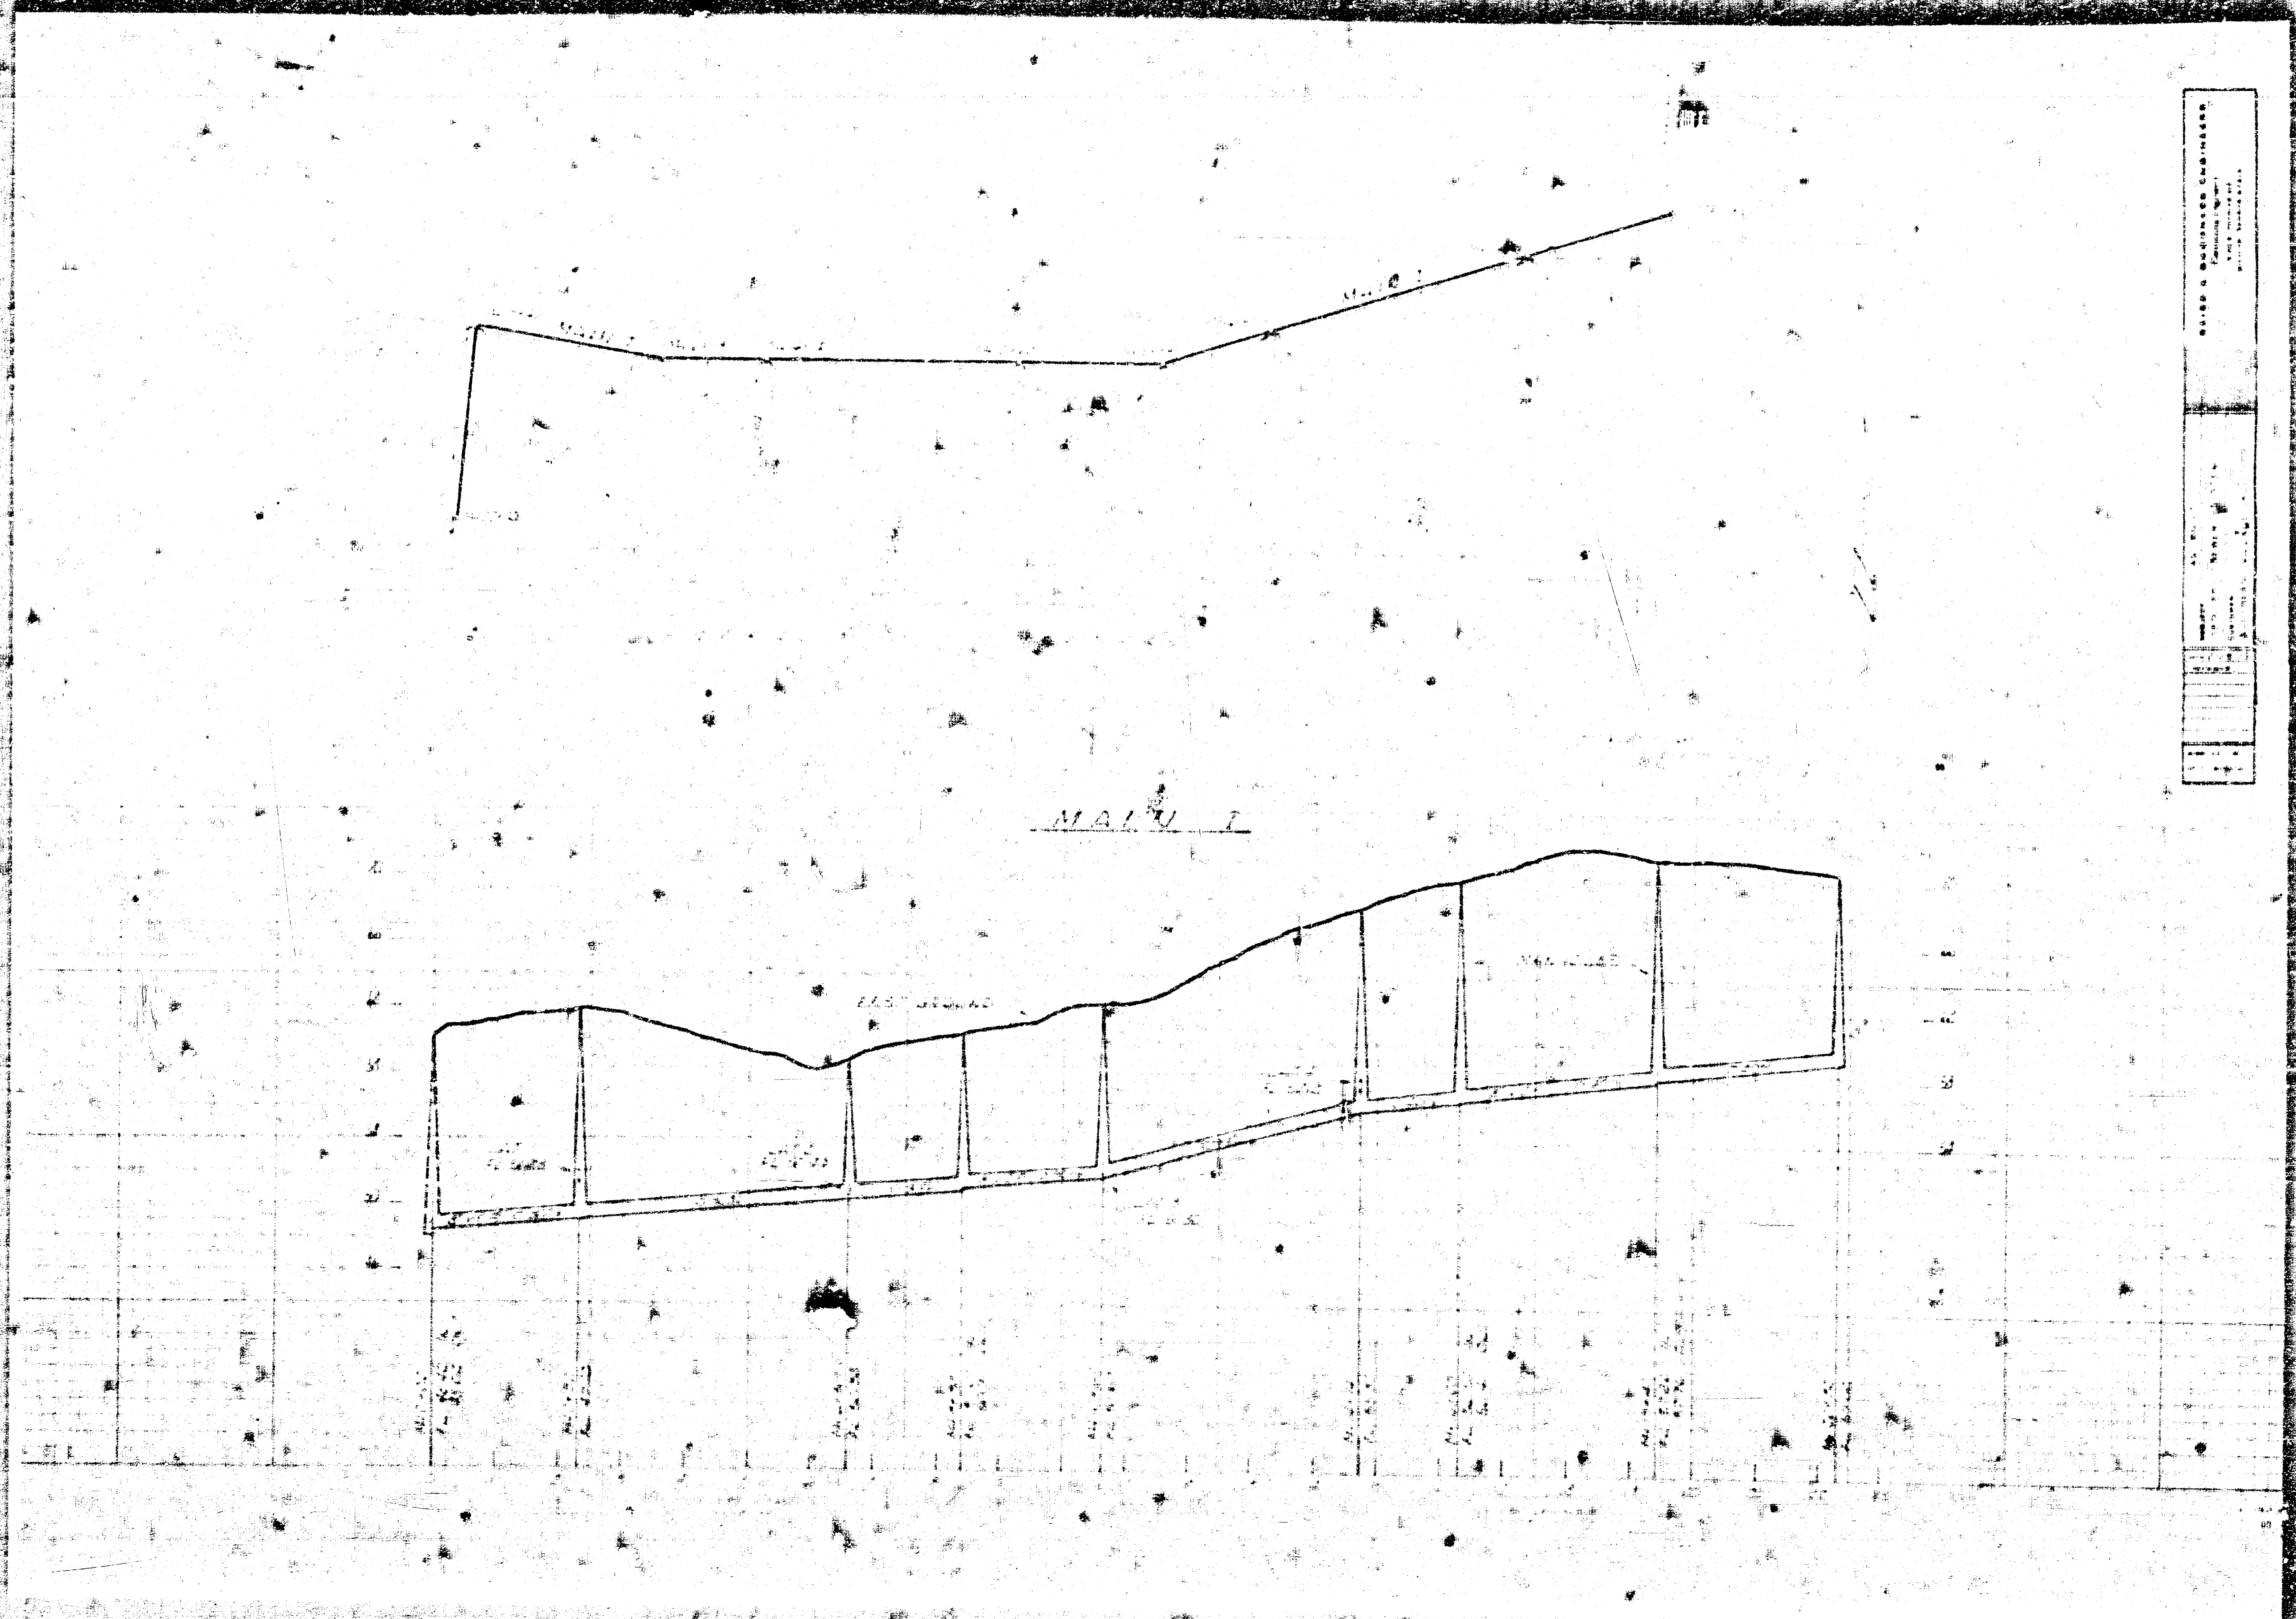

UNITED STATES ENGINEERING	
DRAWING NO.	
DATE	
BY	
CHECKED BY	
APPROVED BY	
TITLE	
SCALE	
SHEET NO.	
TOTAL SHEETS	

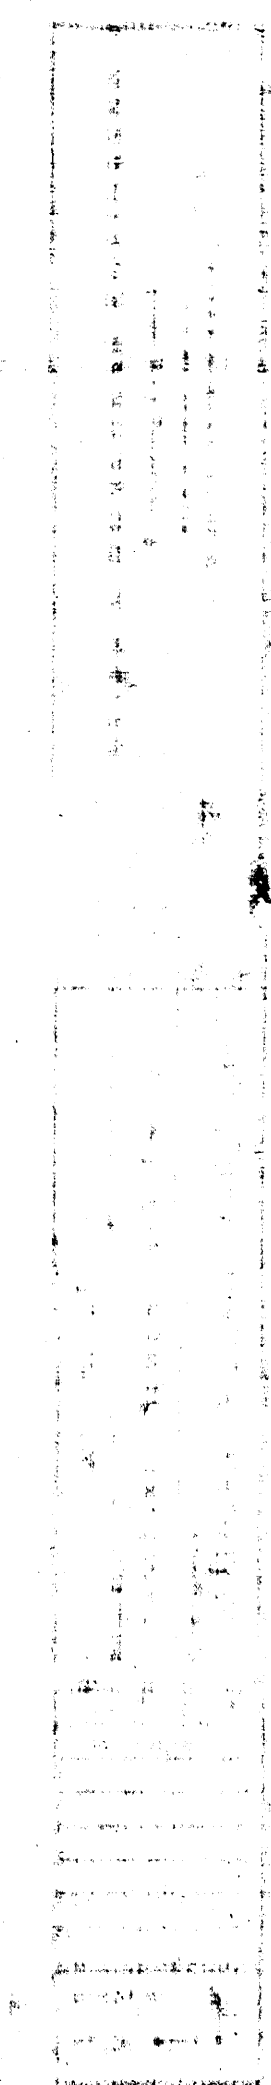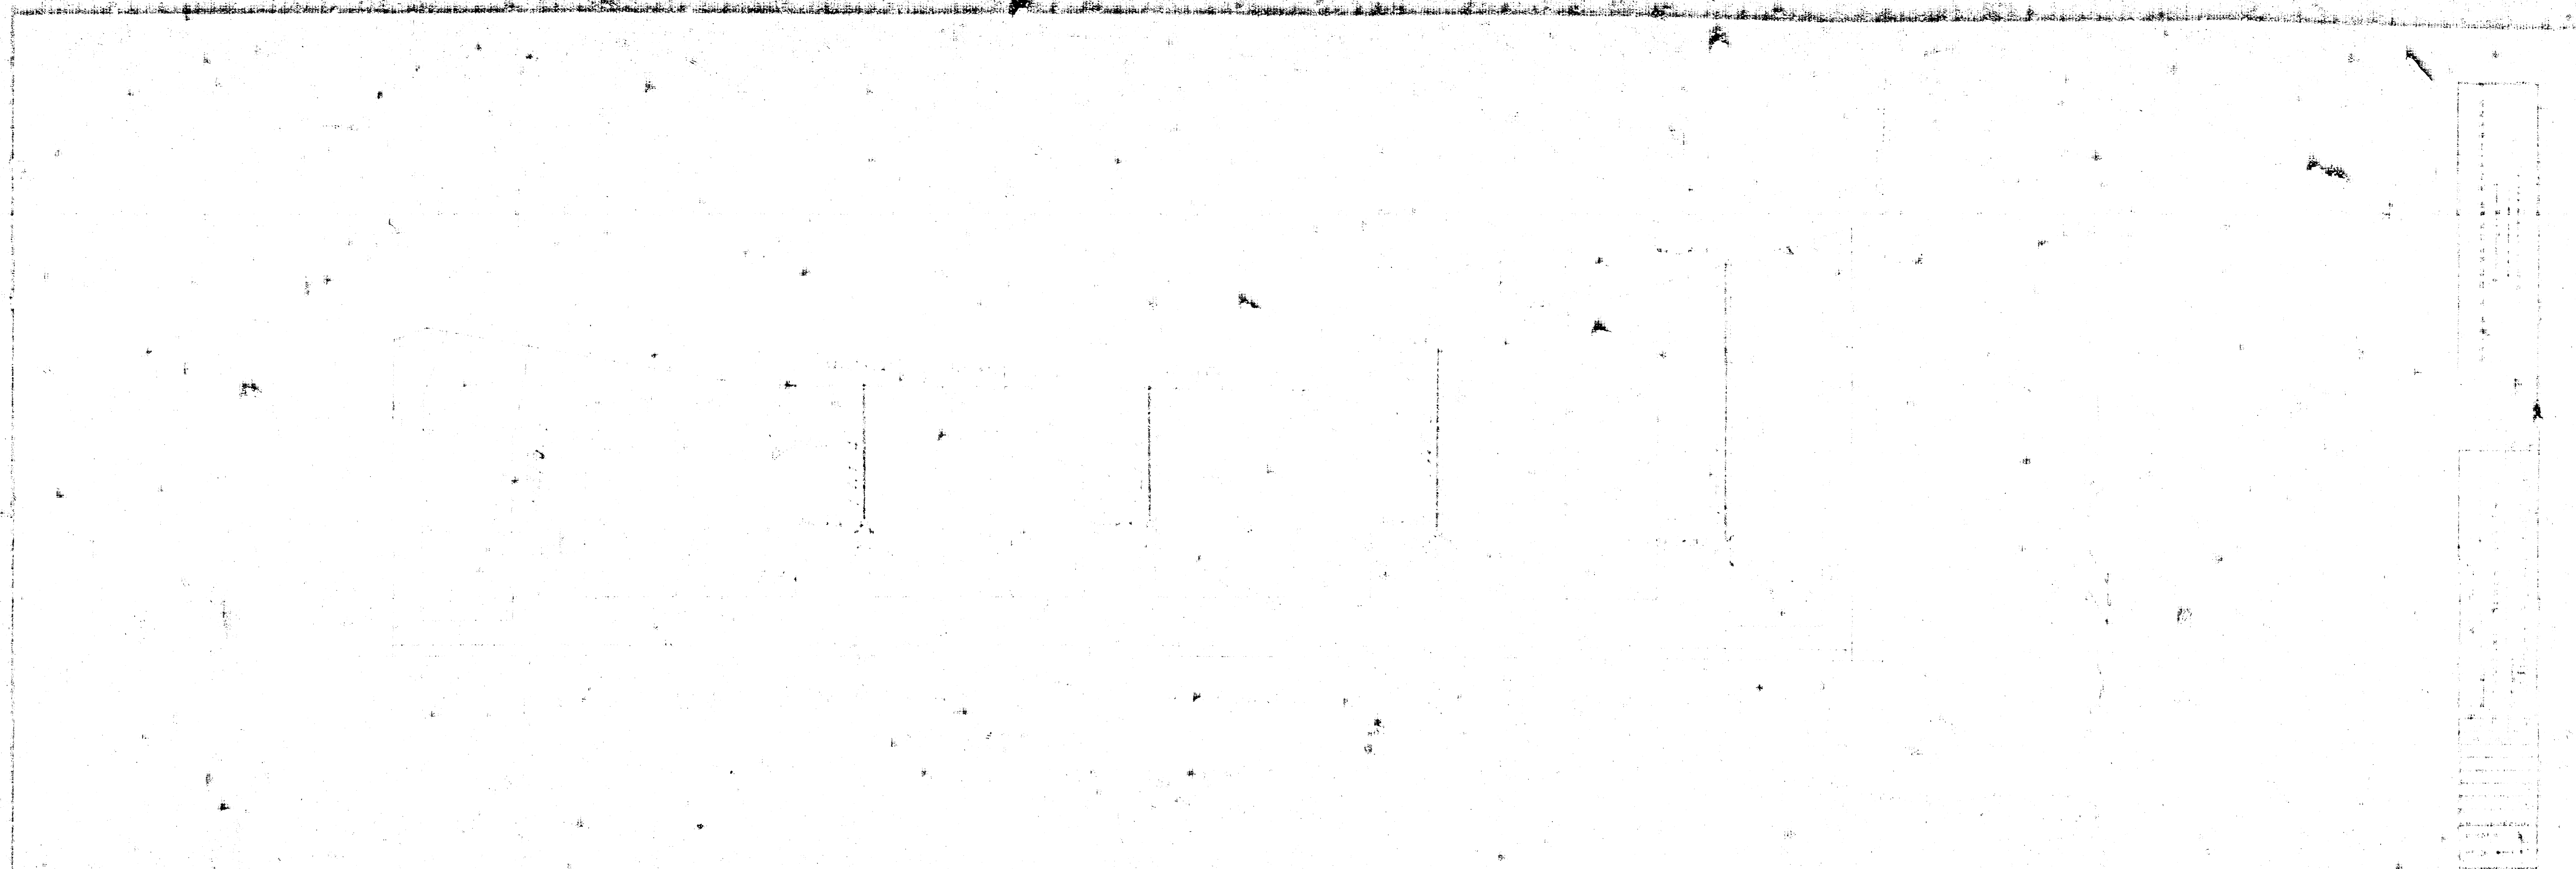

LATERAL 1

LATERAL 2

LATERAL 3

LATERAL 4

