


PLAN
 NOTES:
 1. ALL WORK SHALL BE IN ACCORDANCE WITH THE LATEST EDITIONS OF THE KANSAS STANDARD SPECIFICATIONS FOR HIGHWAYS AND BRIDGES.
 2. THE CONTRACTOR SHALL BE RESPONSIBLE FOR OBTAINING ALL NECESSARY PERMITS AND RIGHTS-OF-WAY.
 3. THE CONTRACTOR SHALL MAINTAIN ACCESS TO ALL ADJACENT PROPERTIES AT ALL TIMES.
 4. THE CONTRACTOR SHALL BE RESPONSIBLE FOR PROTECTING ALL EXISTING UTILITIES.
 5. THE CONTRACTOR SHALL MAINTAIN ADEQUATE TRAFFIC CONTROL DURING CONSTRUCTION.
 6. THE CONTRACTOR SHALL BE RESPONSIBLE FOR THE REMOVAL AND DISPOSAL OF ALL DEBRIS AND EXCESS MATERIAL.
 7. THE CONTRACTOR SHALL MAINTAIN THE PROPOSED SEWER LINE CLEAR OF ALL OBSTRUCTIONS.
 8. THE CONTRACTOR SHALL BE RESPONSIBLE FOR THE PROTECTION OF ALL EXISTING STRUCTURES AND UTILITIES.
 9. THE CONTRACTOR SHALL MAINTAIN THE PROPOSED SEWER LINE CLEAR OF ALL OBSTRUCTIONS.
 10. THE CONTRACTOR SHALL BE RESPONSIBLE FOR THE PROTECTION OF ALL EXISTING STRUCTURES AND UTILITIES.

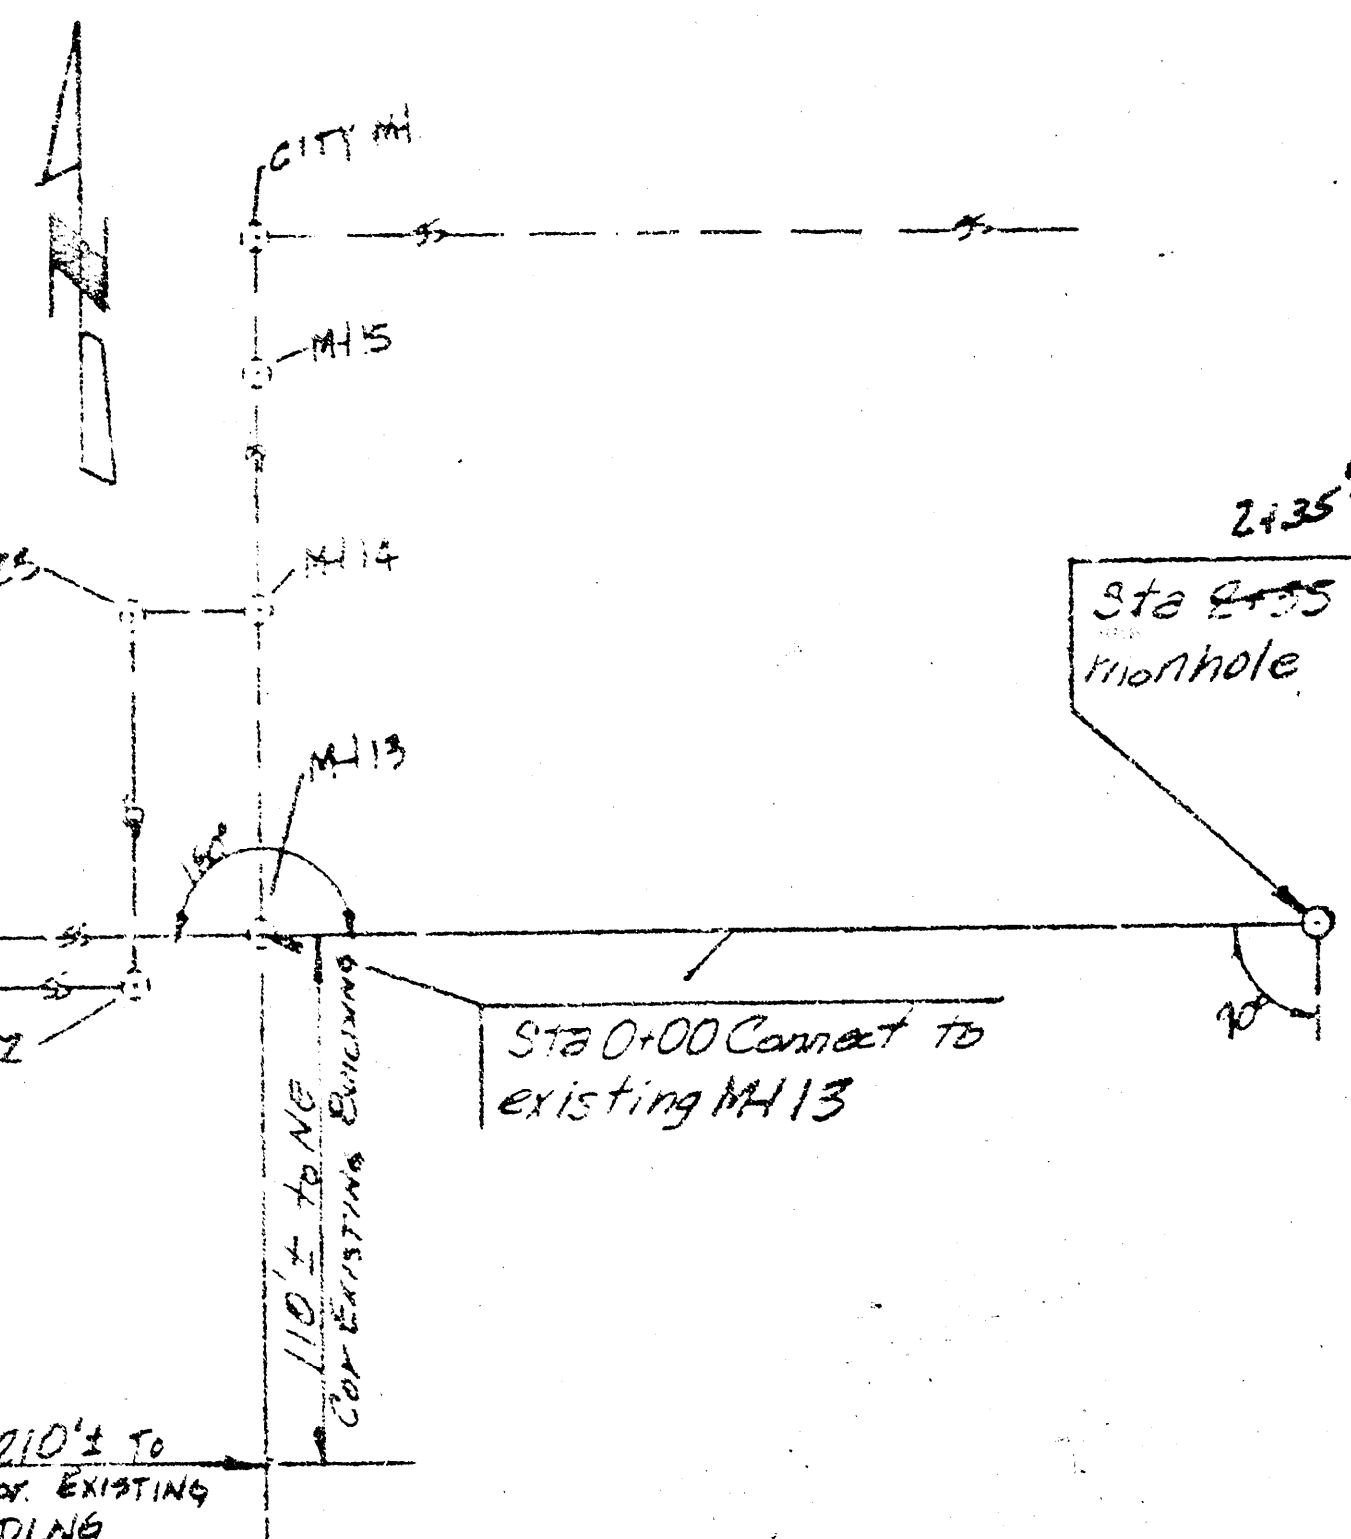


Sta 2+35 Construct Type A manhole

Notes:
 Contact Carl May Maintenance Foreman Davis Mfg. Co. for assistance in locating buried utilities. Also contact S.W. Bell and K&E.
 Contractor shall protect existing utilities. Contractor shall only close one lane of concrete drive at any time. The trench shall be backfilled, compacted and rocked at the end of the day.

Sta 6+55 Construct Type A manhole. Install 10' x 12' V.P. East @ 0.20% Grade E 88.97.

Sta 7+55 Construct Type A manhole

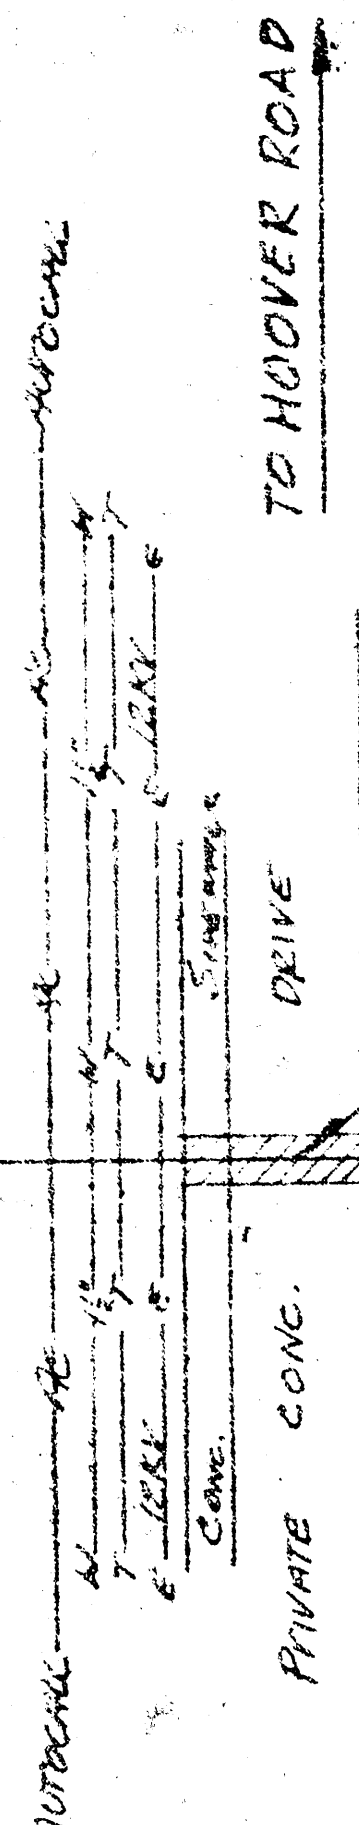

Remove and Replace Concrete Pavement. Contractor may close one side of drive.


NEW 14' x 24' BLDG
 Verify location of existing 4' stub out in new building

As B.R. 8/28/79
 D.B.S. W.S.J. OR

SANITARY SEWER FOR DAVIS MANUFACTURING
 3301 S. HOOVER ROAD
 468-76-245 80606-000-000-008


SCALE
 PLAN: 1" = 50'
 PROFILE: HORIZ. 1" = 50'
 VERT. 1" = 5'

BM: Top of Ring Existing M13 ELEV. 97.92

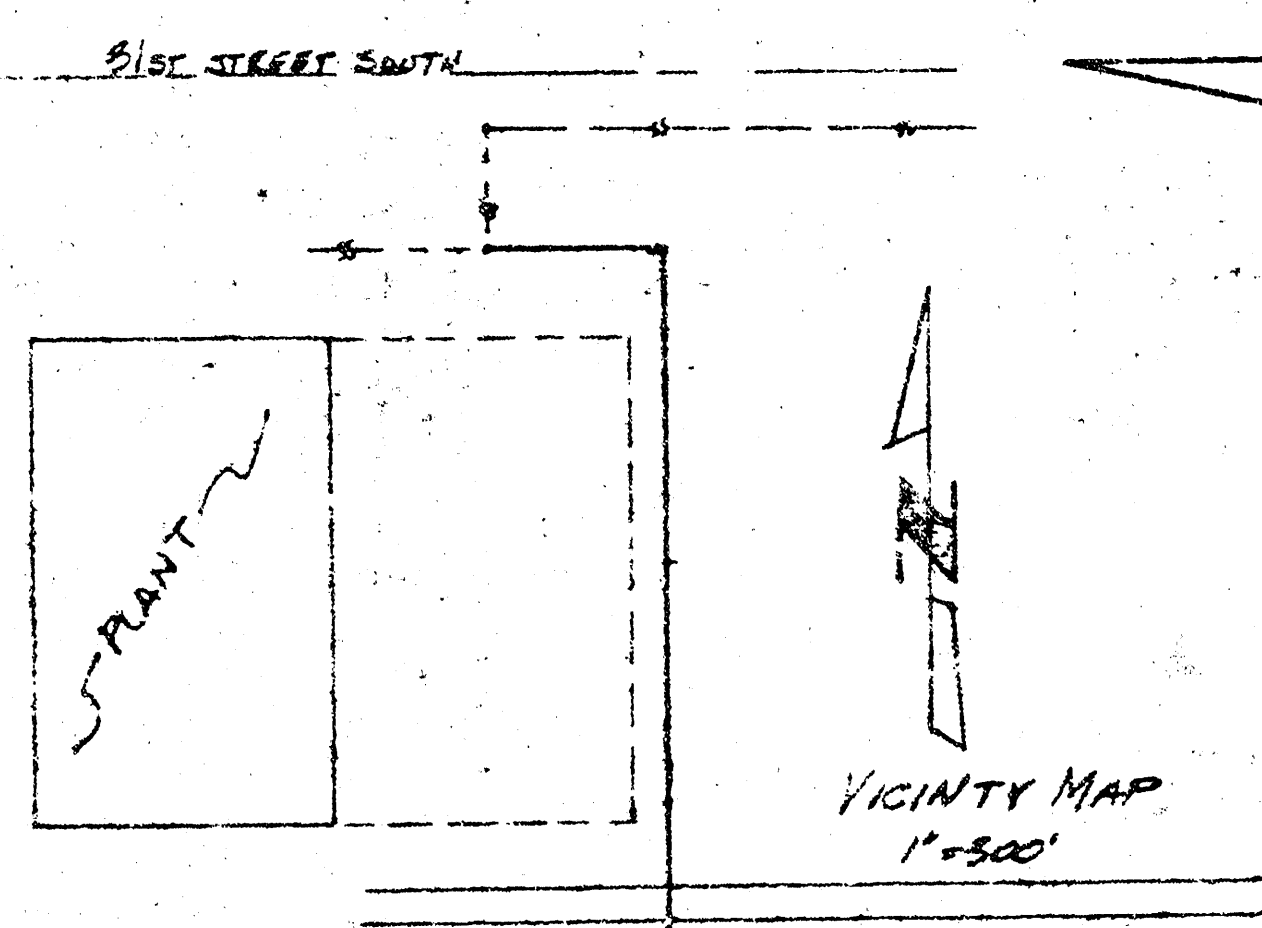

8-7-79
 APPROVED AS NOTED
 By CITY ENGINEER OF WICHITA
 Sanitary Sewers
 Storm Sewers
 Driveway Approaches

NOTE TO CONTRACTOR
 This project will be constructed under the supervision of the CITY ENGINEER and conforming to the SPECIFICATIONS of the CITY OF WICHITA. The CONTRACTOR will reimburse the City of Wichita for all cost of inspection.

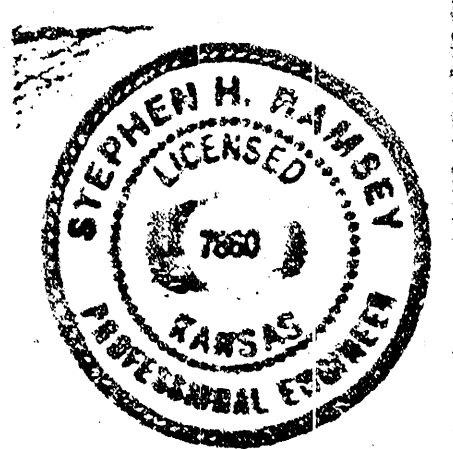

UTILITY CONTRACTORS, INC.
 100 WEST 10TH STREET - P.O. BOX 2009
 WICHITA, KANSAS 67202 - (316) 265-9128
 STEEL STRUCTURES OF KANSAS
 SANITARY SEWER EXTENSION AT
 DAVIS MANUFACTURING, DILL LILACE
 3301 S. HOOVER ROAD, WICHITA
 JOB # D-1784
 DATE: JUNE 1979 SHEET 1 of 1

