



HWY. K-15

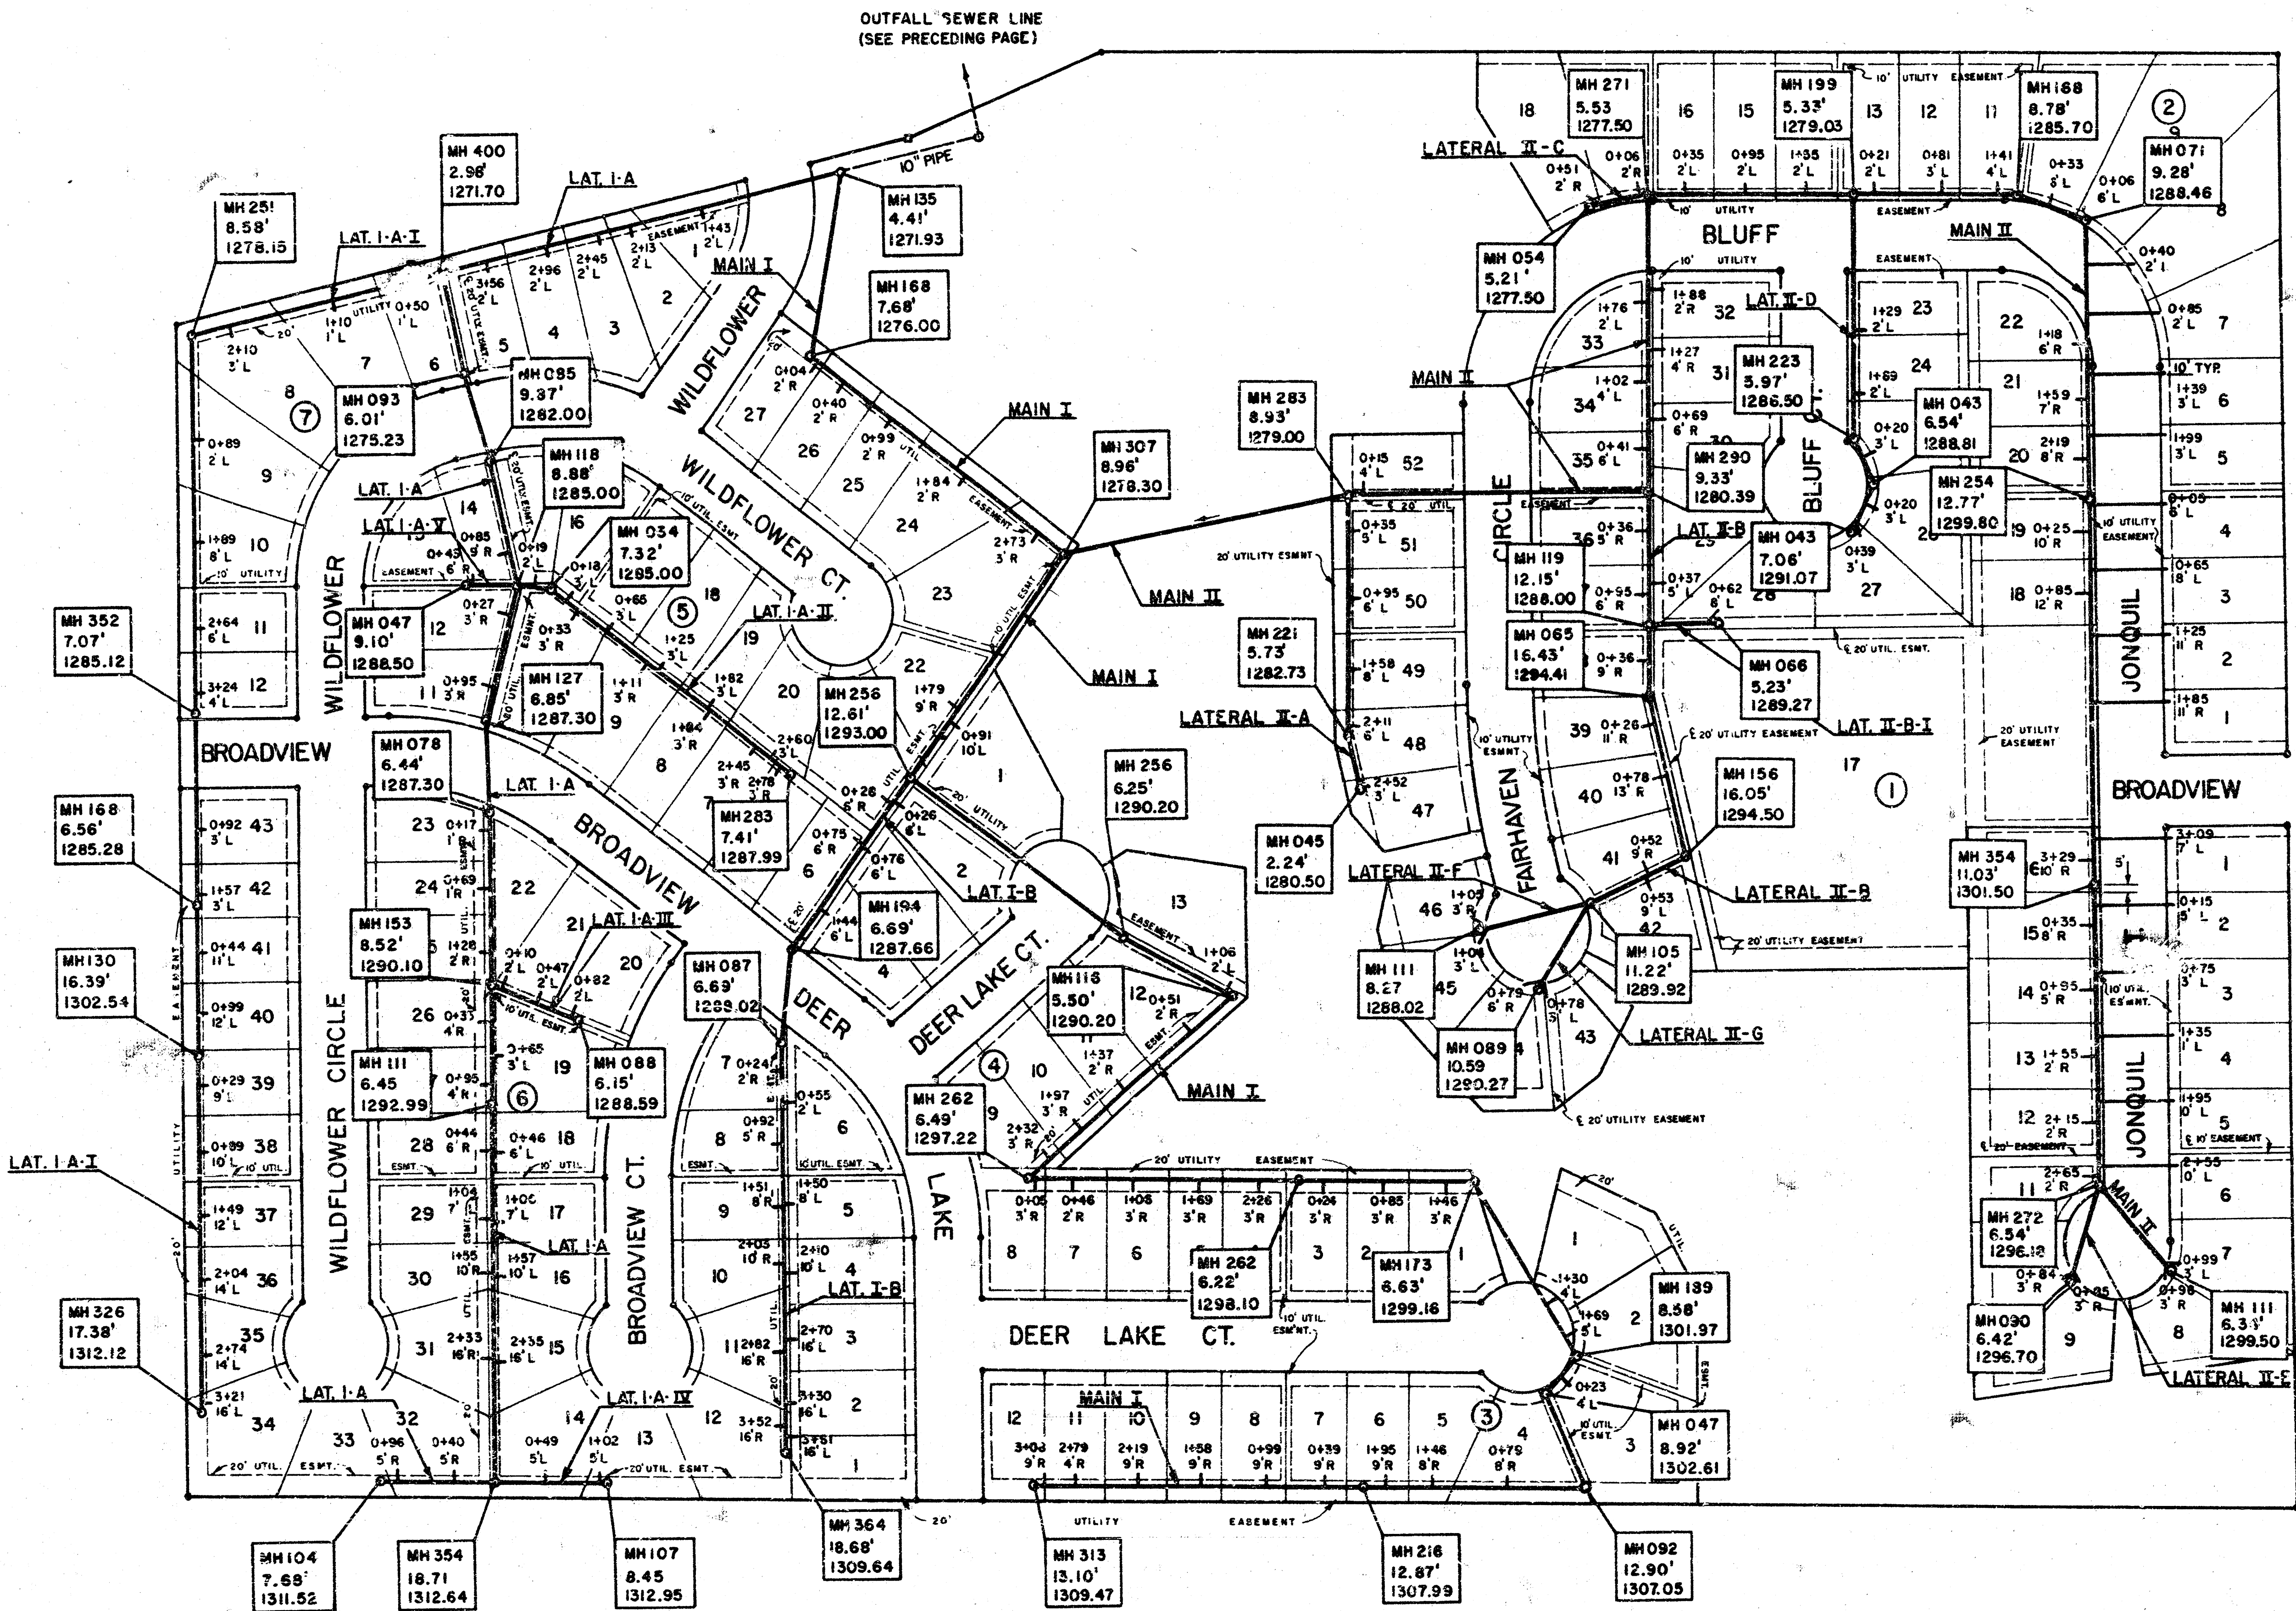

N.W. COR., W. 1/2, N.E. 1/4,
SEC. 23

47TH STREET S.O.

LEGEND

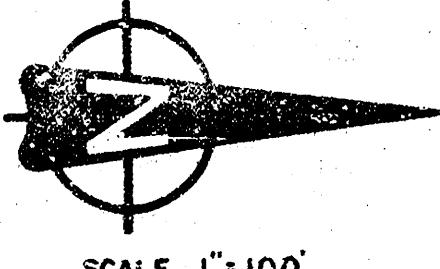

DISTANCE TO PRECEDING DOWNSTREAM MANHOLE	MM 123
DEPTH- RING TO FLOW LINE OUT	4.56
MANHOLE RING ELEVATION	1234.56

ALL PIPE SHOWN IS 8" UNLESS OTHERWISE NOTED.



REISS & GOODNESS ENGINEERS
2160 WEST 21ST STREET
WICHITA, KANSAS 67203
(316) 832-0213

"AS CONSTRUCTED" SANITARY SEWER SYSTEM

DEER LAKES ESTATES, SEDGWICK COUNTY, KANSAS

SCALE	PROJECT NO.
DATE 4/29/83	SHEET 2 OF 2

**OAKLAWN
SUBDIVISION**

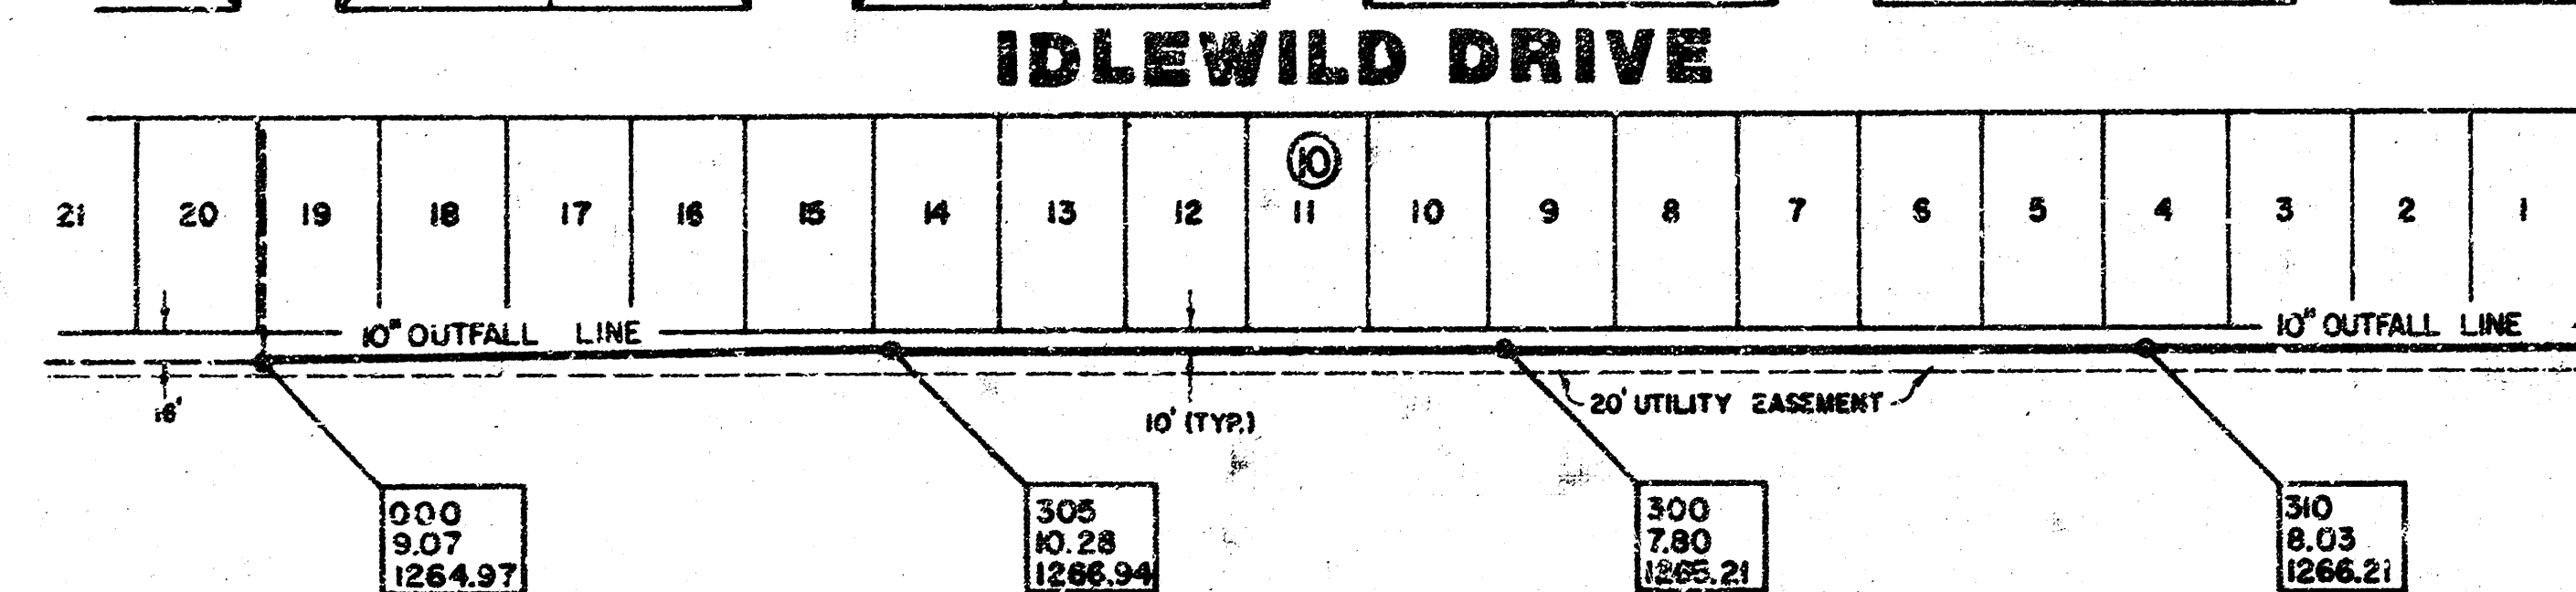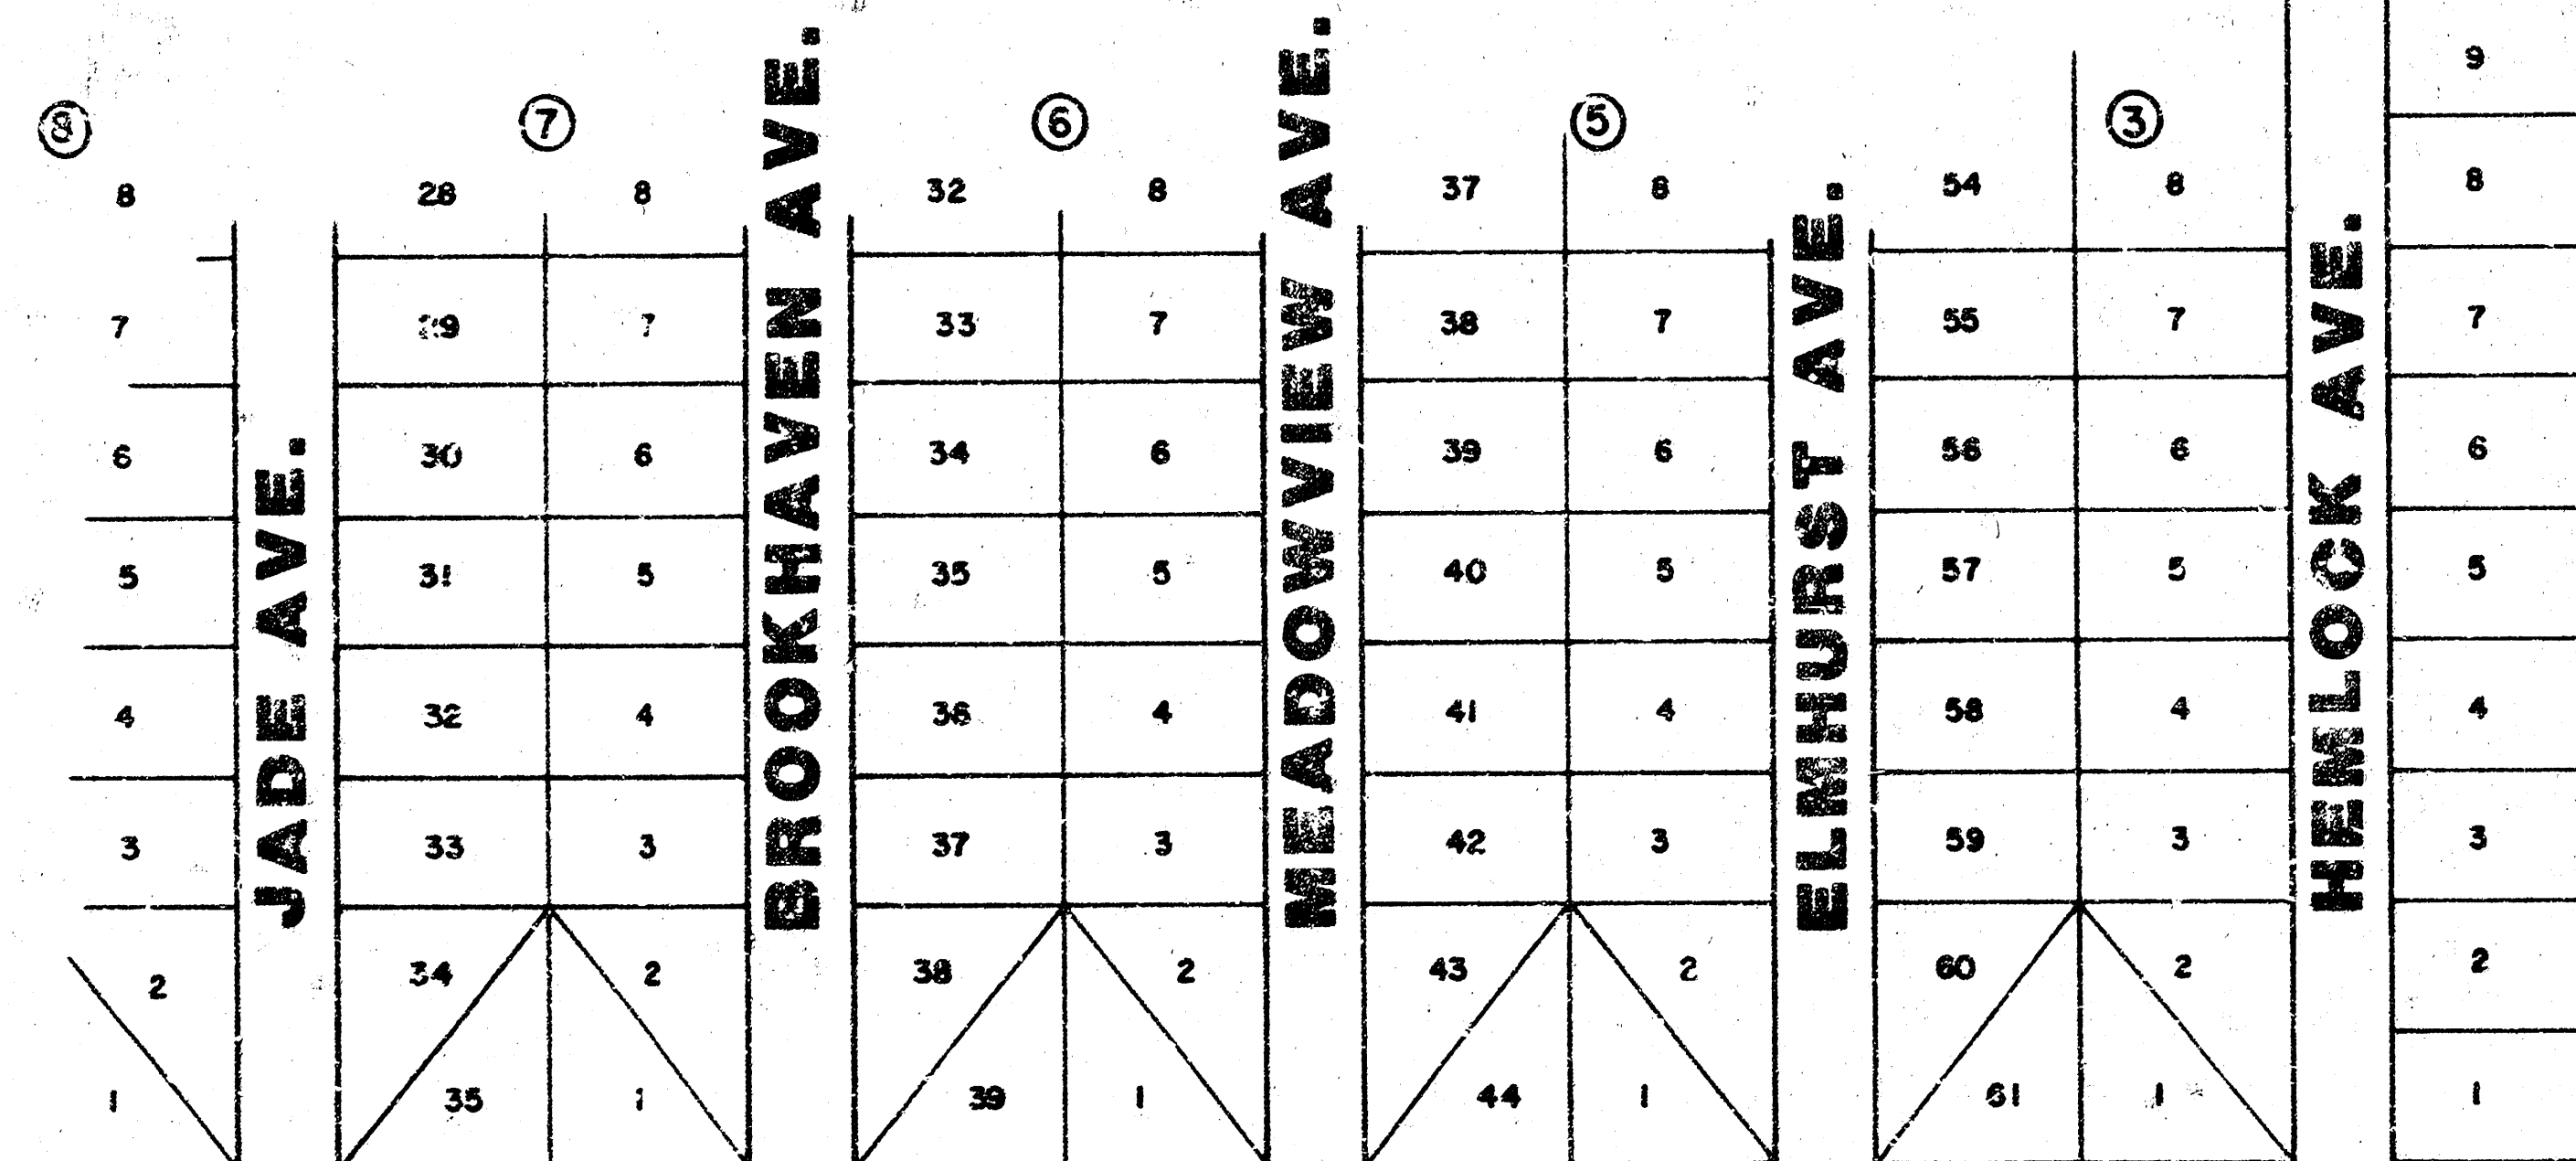

PINAIRE MOBILE HOME PARK

TIERRA AVE.

③

②

SO. CLIFTON AVE.

**MATHEWSON AVENUE
CHURCH OF CHRIST**

U. S. D. 260

DEER LAKE ESTATES

K-15 STATE HIGHWAY

A.T. & S.F. R.R.

FAIRHAVEN CIR.


RESERVE 'A'

**WILDFLOWER
WILDFLOWER CT.**

123 4.56 1234.56
DISTANCE TO DOWNSTREAM MANHOLE
MEASUREMENT (RING TO FL. OUT)
TOP OF MANHOLE RING (U.S.G.S. DATUM)

SEWER LINE MANHOLE

NOTE:
- ALL PIPE ON THIS SHEET IS 10"
- THERE ARE NO STUBS INSTALLED

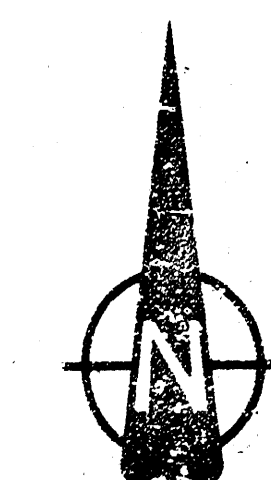

SCALE: 1"=100'

DEISS & GOODNESS ENGINEERS
2100 WEST 21ST STREET
WICHITA, KANSAS 67203
(316) 644-0213