



6" x 6" CHISELED SQUARE ON CENTERLINE CONCRETE
PAVEMENT SURFACE SLAB K-12 AND WEST LINE WEST STREET.

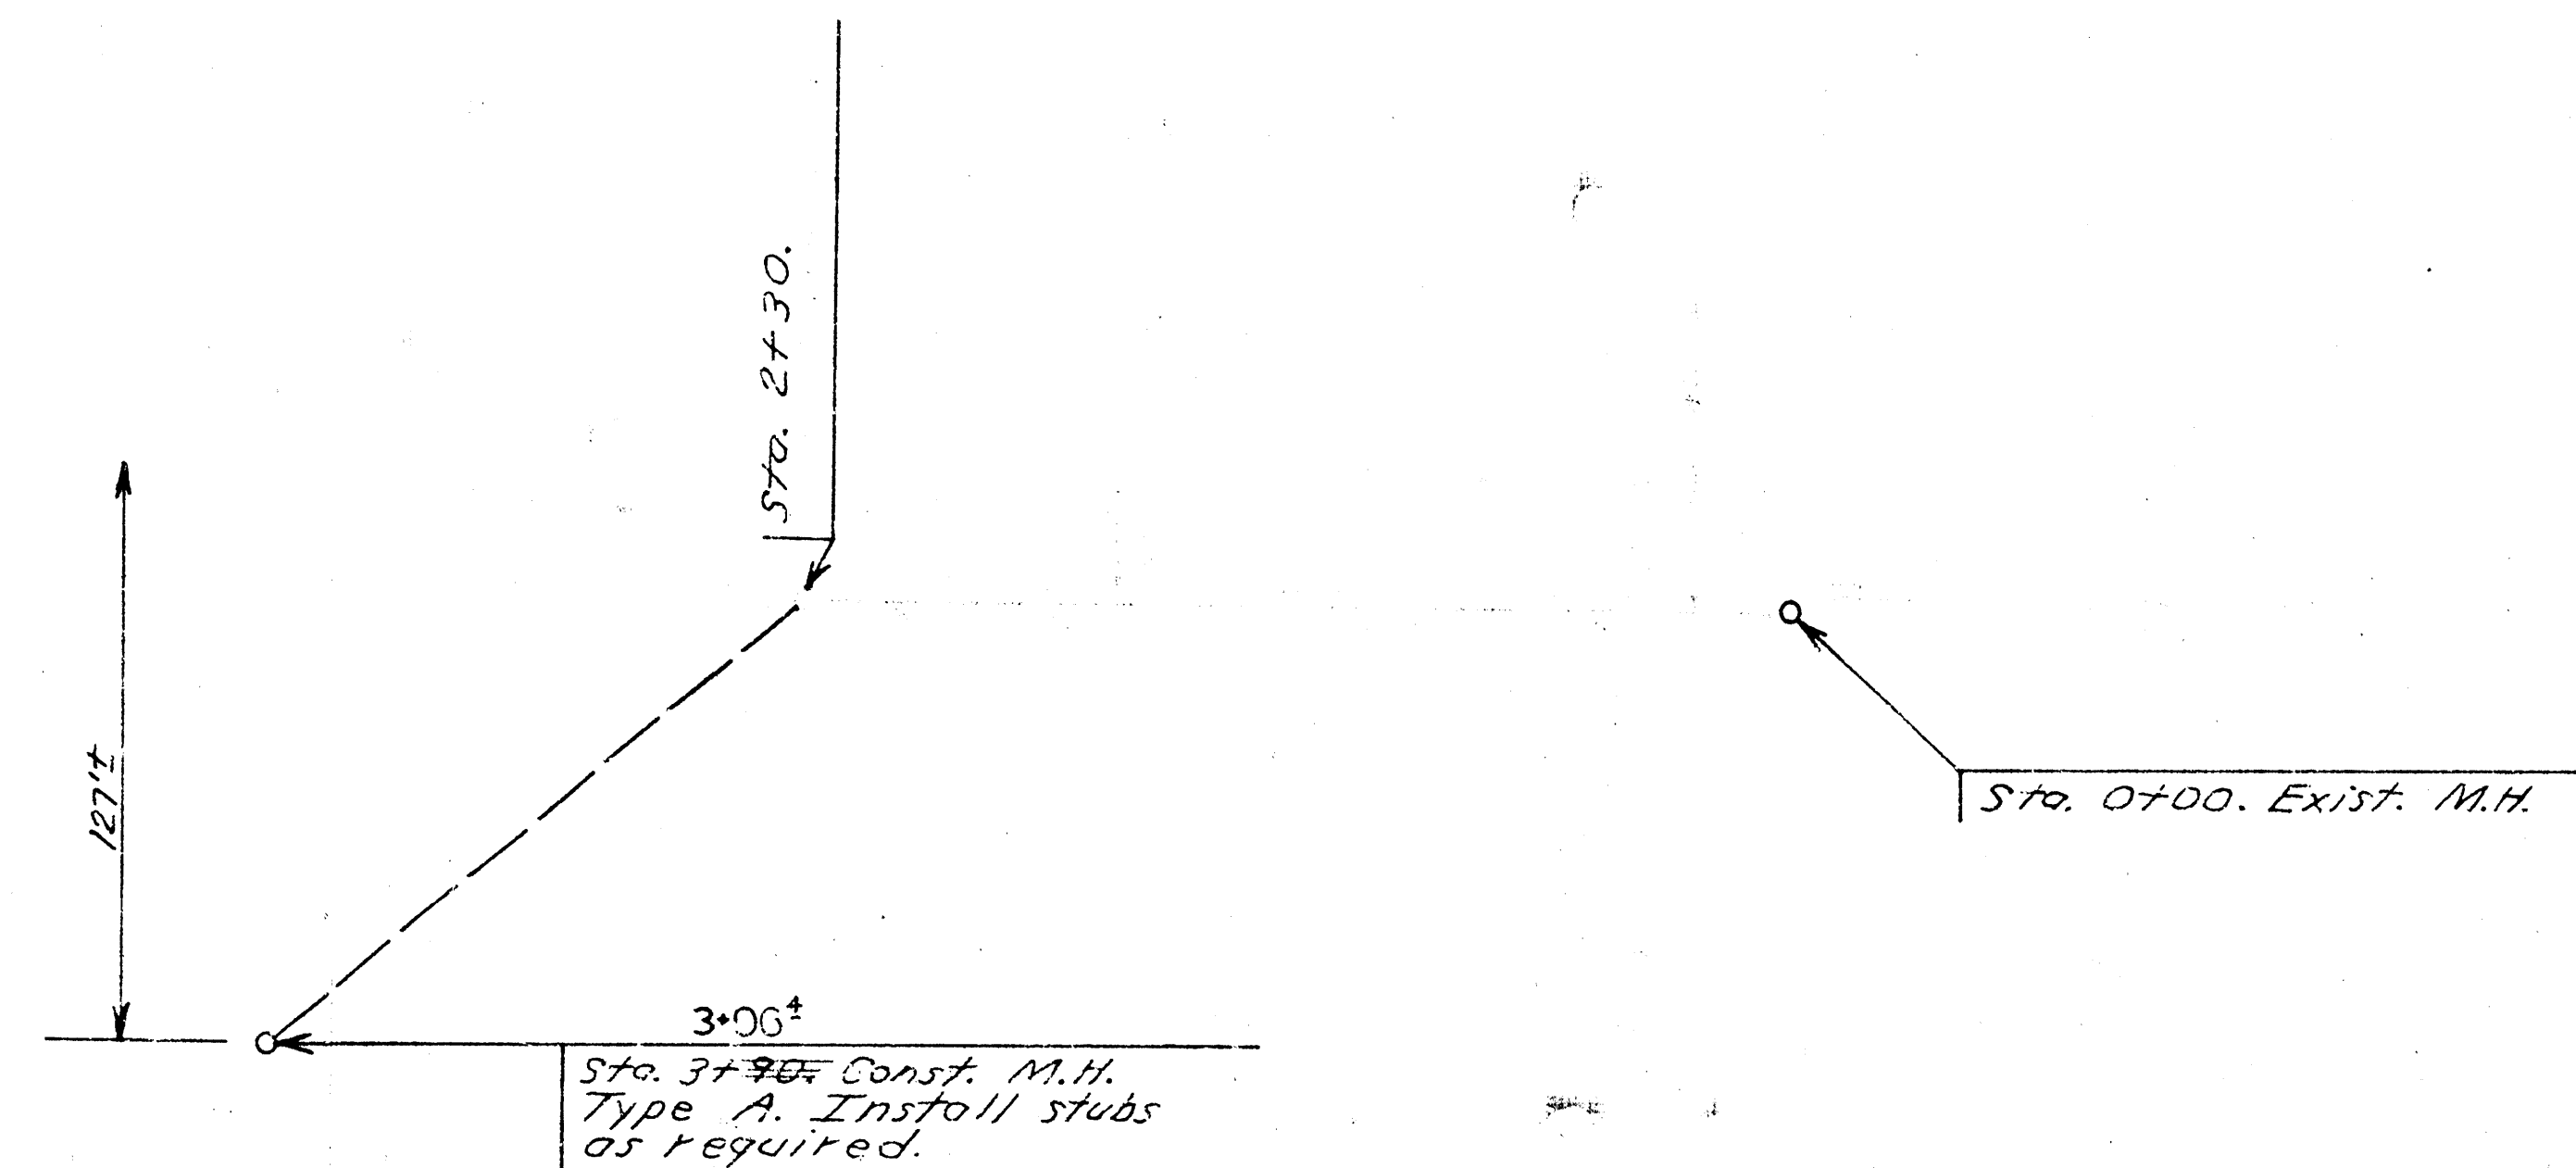

NOTE: EXACT LOCATION OF MANHOLE AT STA. 3+90 IS TO
BE DETERMINED BY OWNER. CONCRETE ENCASEMENT
WILL BE REQUIRED UNDER THE DRAINAGE DITCH
BEGINNING FROM MANHOLE AT STA. 2+30 IF COVER
OVER DITCH IS LESS THAN 10".

Rev. 10-26-73

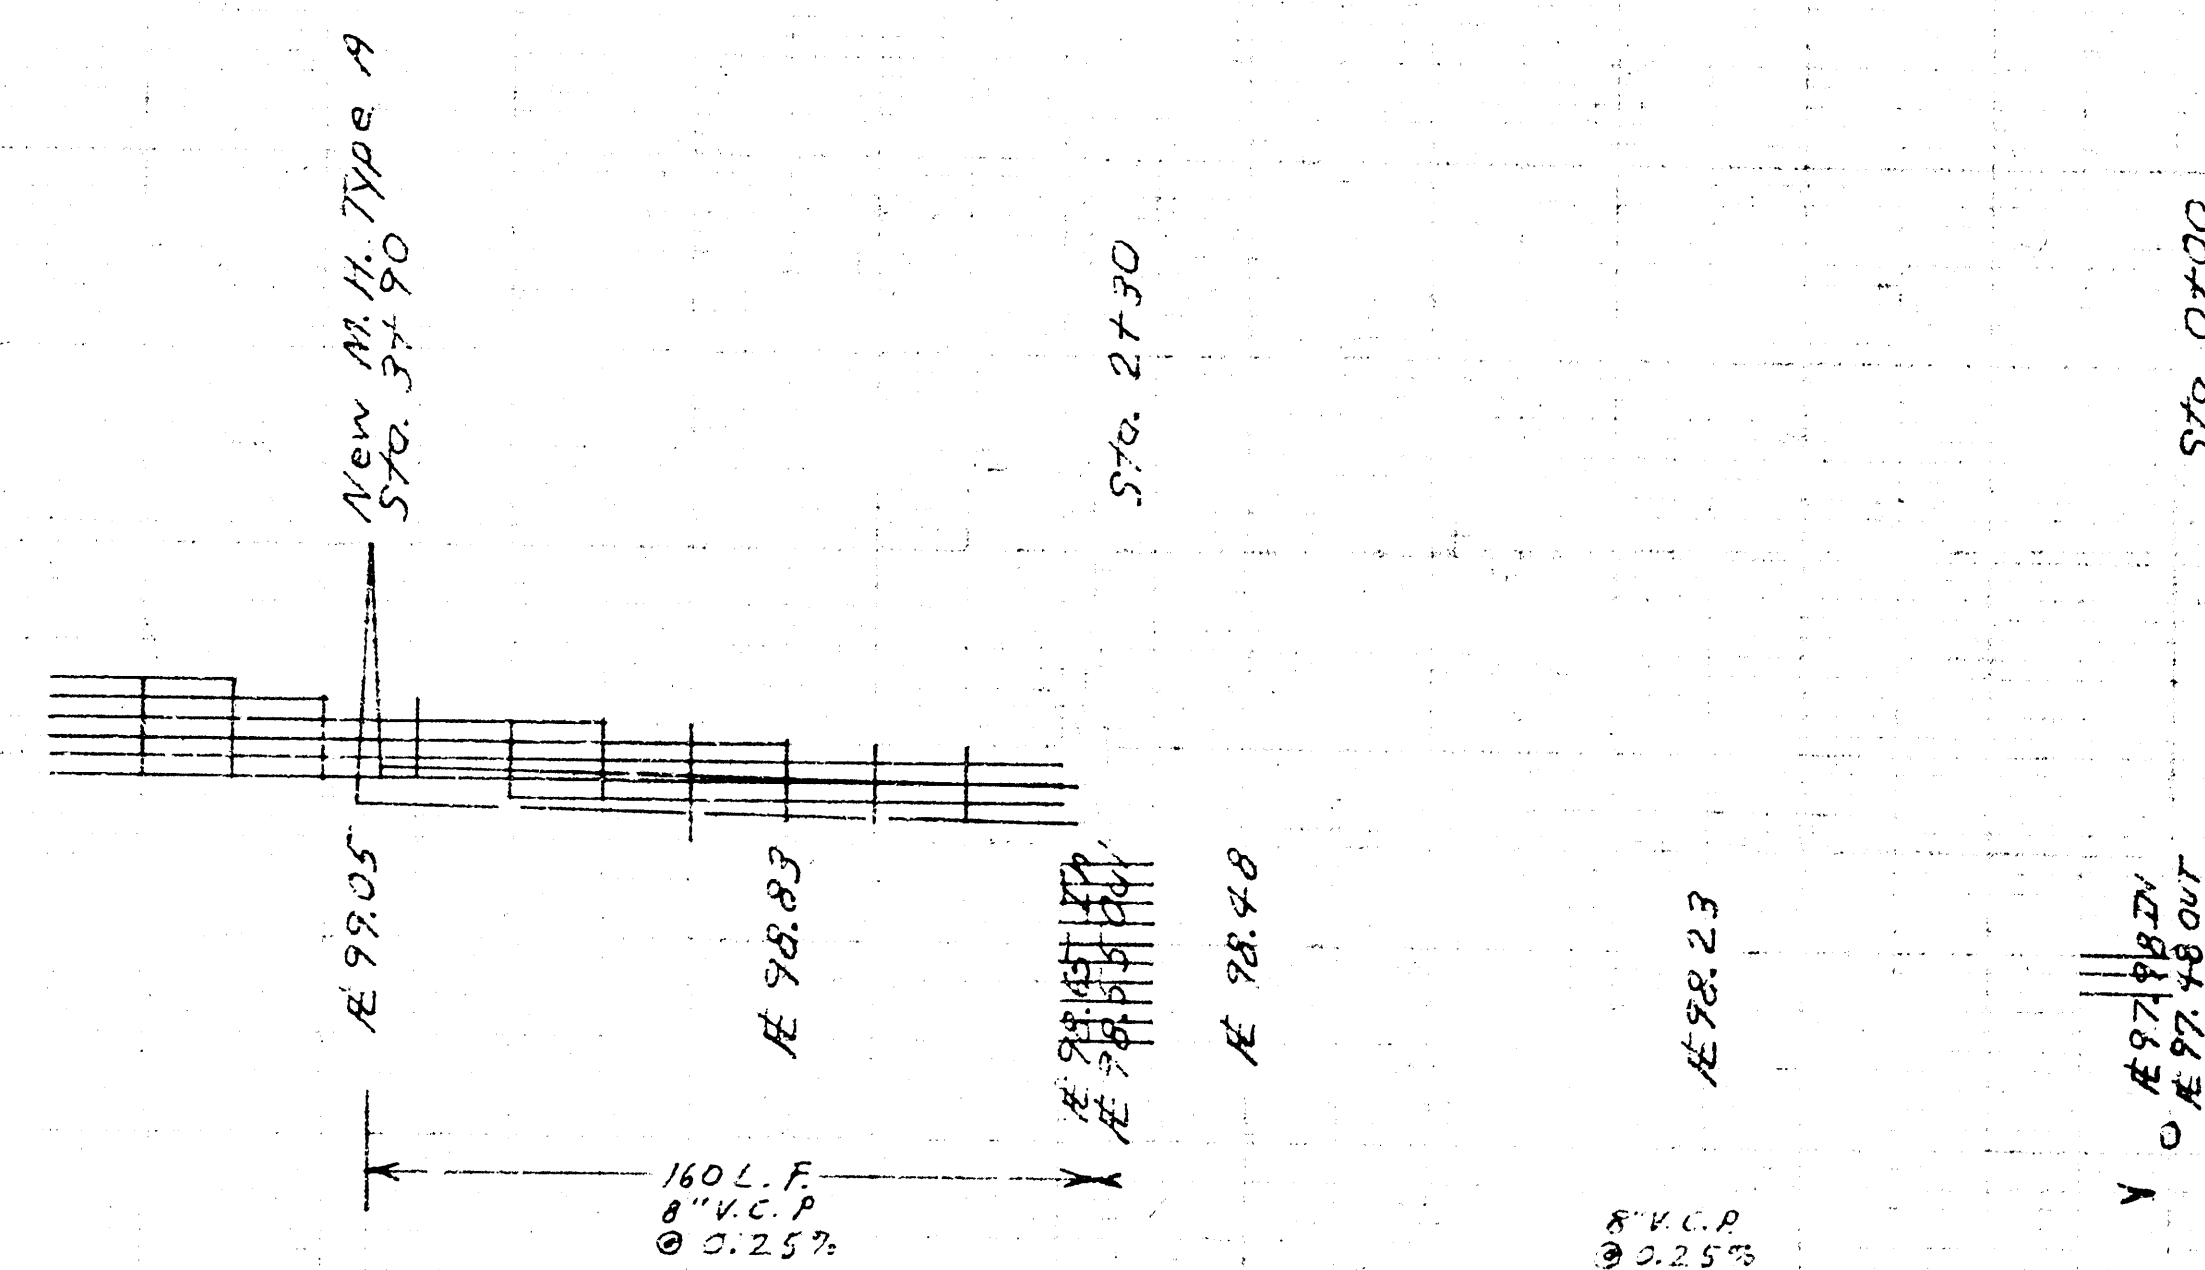

AS BUILT FIELD MEASUREMENTS
10/26/73