

PLANS FOR SANITARY SEWER EXTENSIONS TO EAGLE LAKE ADDITION PHASE II BEL AIRE, SEDGWICK COUNTY

SE1485
1986

CITY OF WICHITA PROJECT NO. 468 76 245 80001 000 000 051

INDEX OF SHEETS

- 1 - TITLE SHEET
- 2 - LAT. D AND LAT. E
- 3 - LAT. F AND MAIN I
- 4-8 DETAILS

APPROVED AS NOTED

By CITY ENGINEER OF WICHITA

Sanitary Sewers *2/13/86*

Storm Sewers _____

Driveway Approaches _____

Water Mains _____

Paving _____

NOTE TO CONTRACTOR


This project will be constructed under the supervision of the CITY ENGINEER and conforming to the SPECIFICATIONS of the CITY OF WICHITA. The CONTRACTOR will pay the City of Wichita for all costs of plan review, inspection and bookkeeping per contract.




REVISED 2/10/86

RESS & GOODNESS ENGINEERS
2100 WEST 21ST STREET
WICHITA, KANSAS 67203
(913) 52-0225

SCALE GIVEN DATE 1/23/86 PROJECT NO. SE 1485 SHEET 1 OF 8

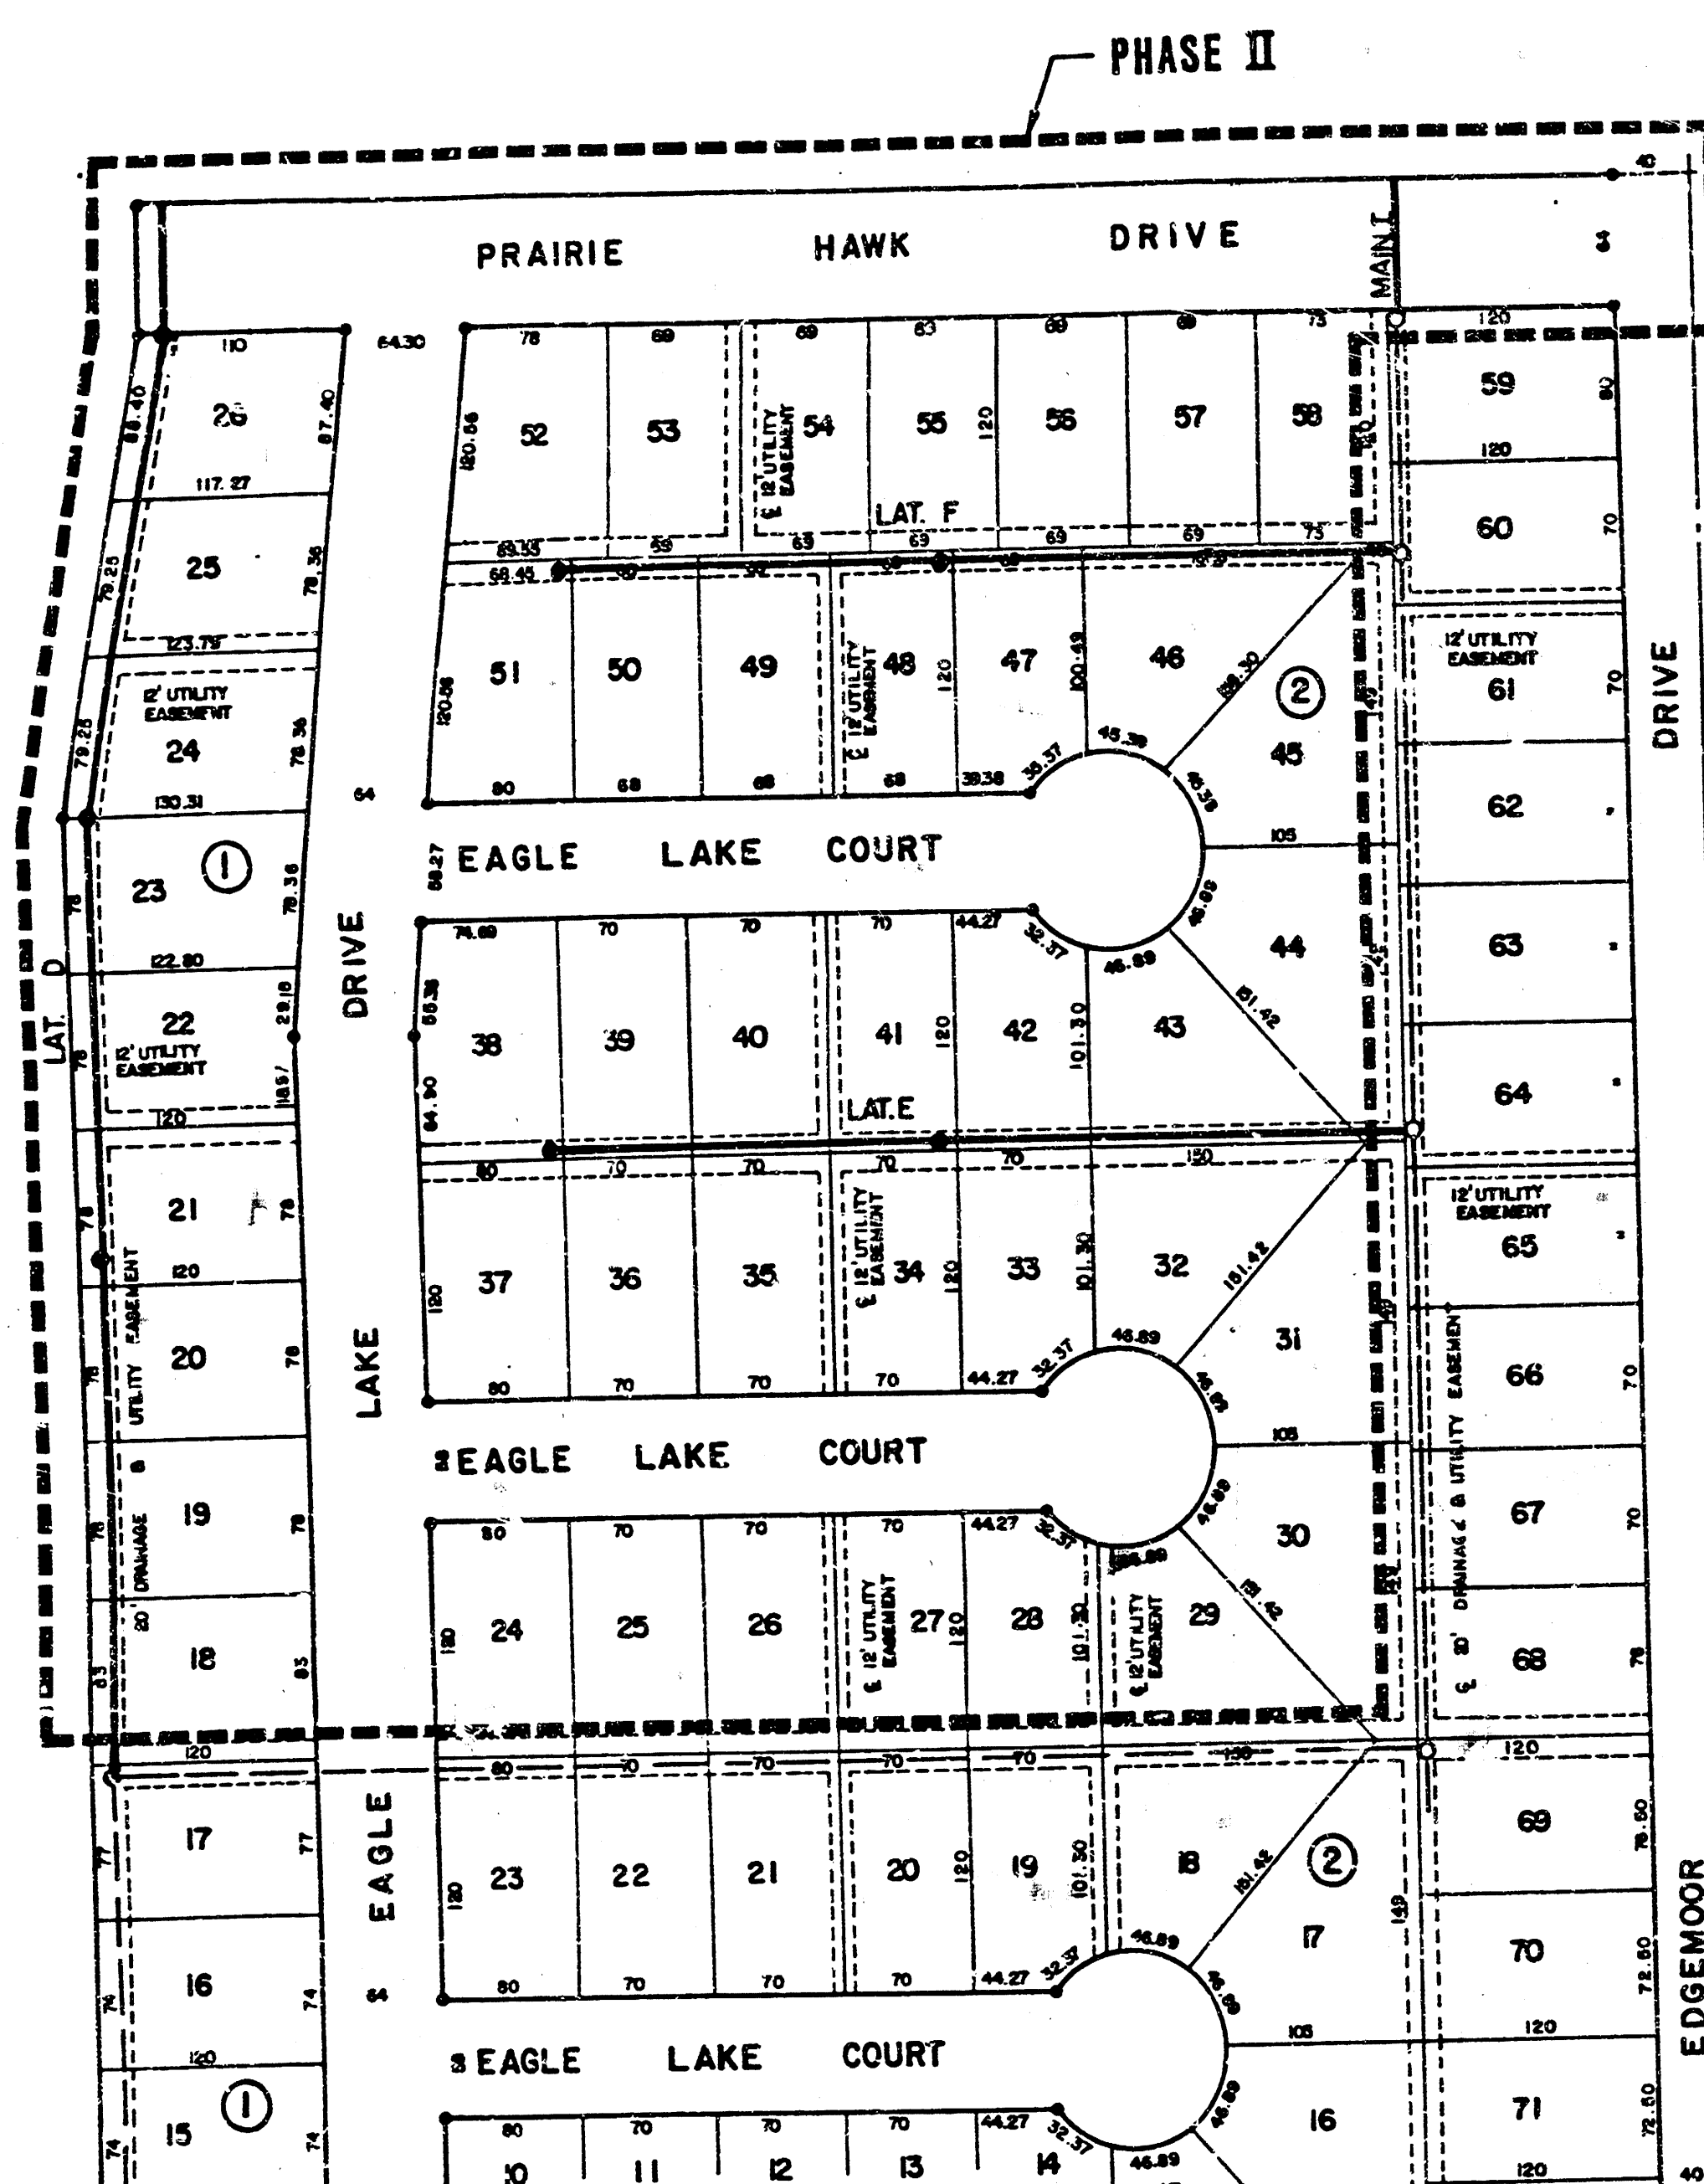

BM
"D" CUT IN SW COR. INLET BOX,
150' ± NO. OF EAGLE LAKE COURT
EL. 1396.61 USGS


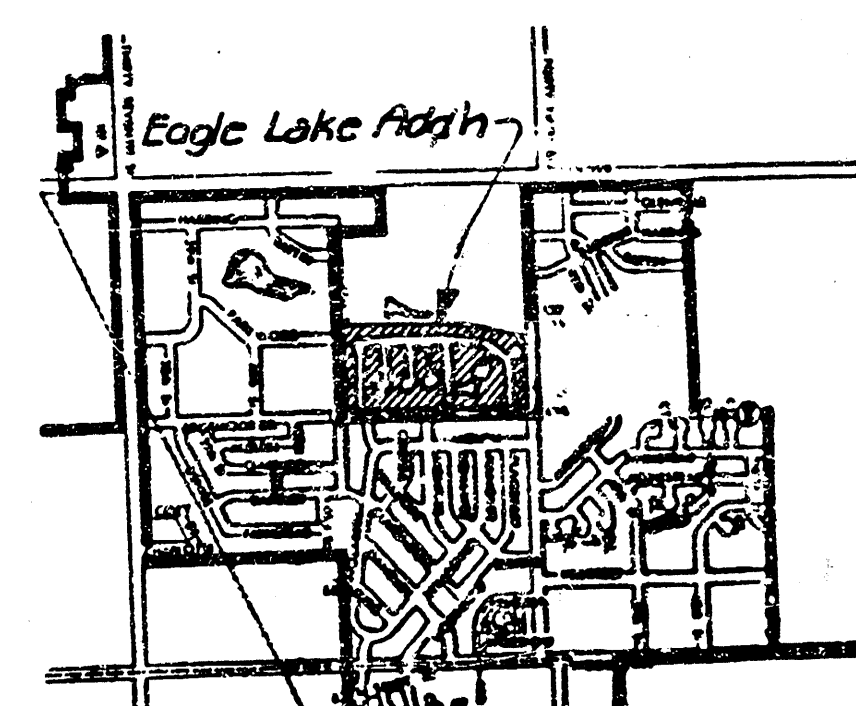


VICINITY MAP
N-3

REVISION	DRAWN BY	CHECKED BY	DESIGNED BY	PROJECT

CUSTOMER


FILMED FROM THE BEST
AVAILABLE COPY.....

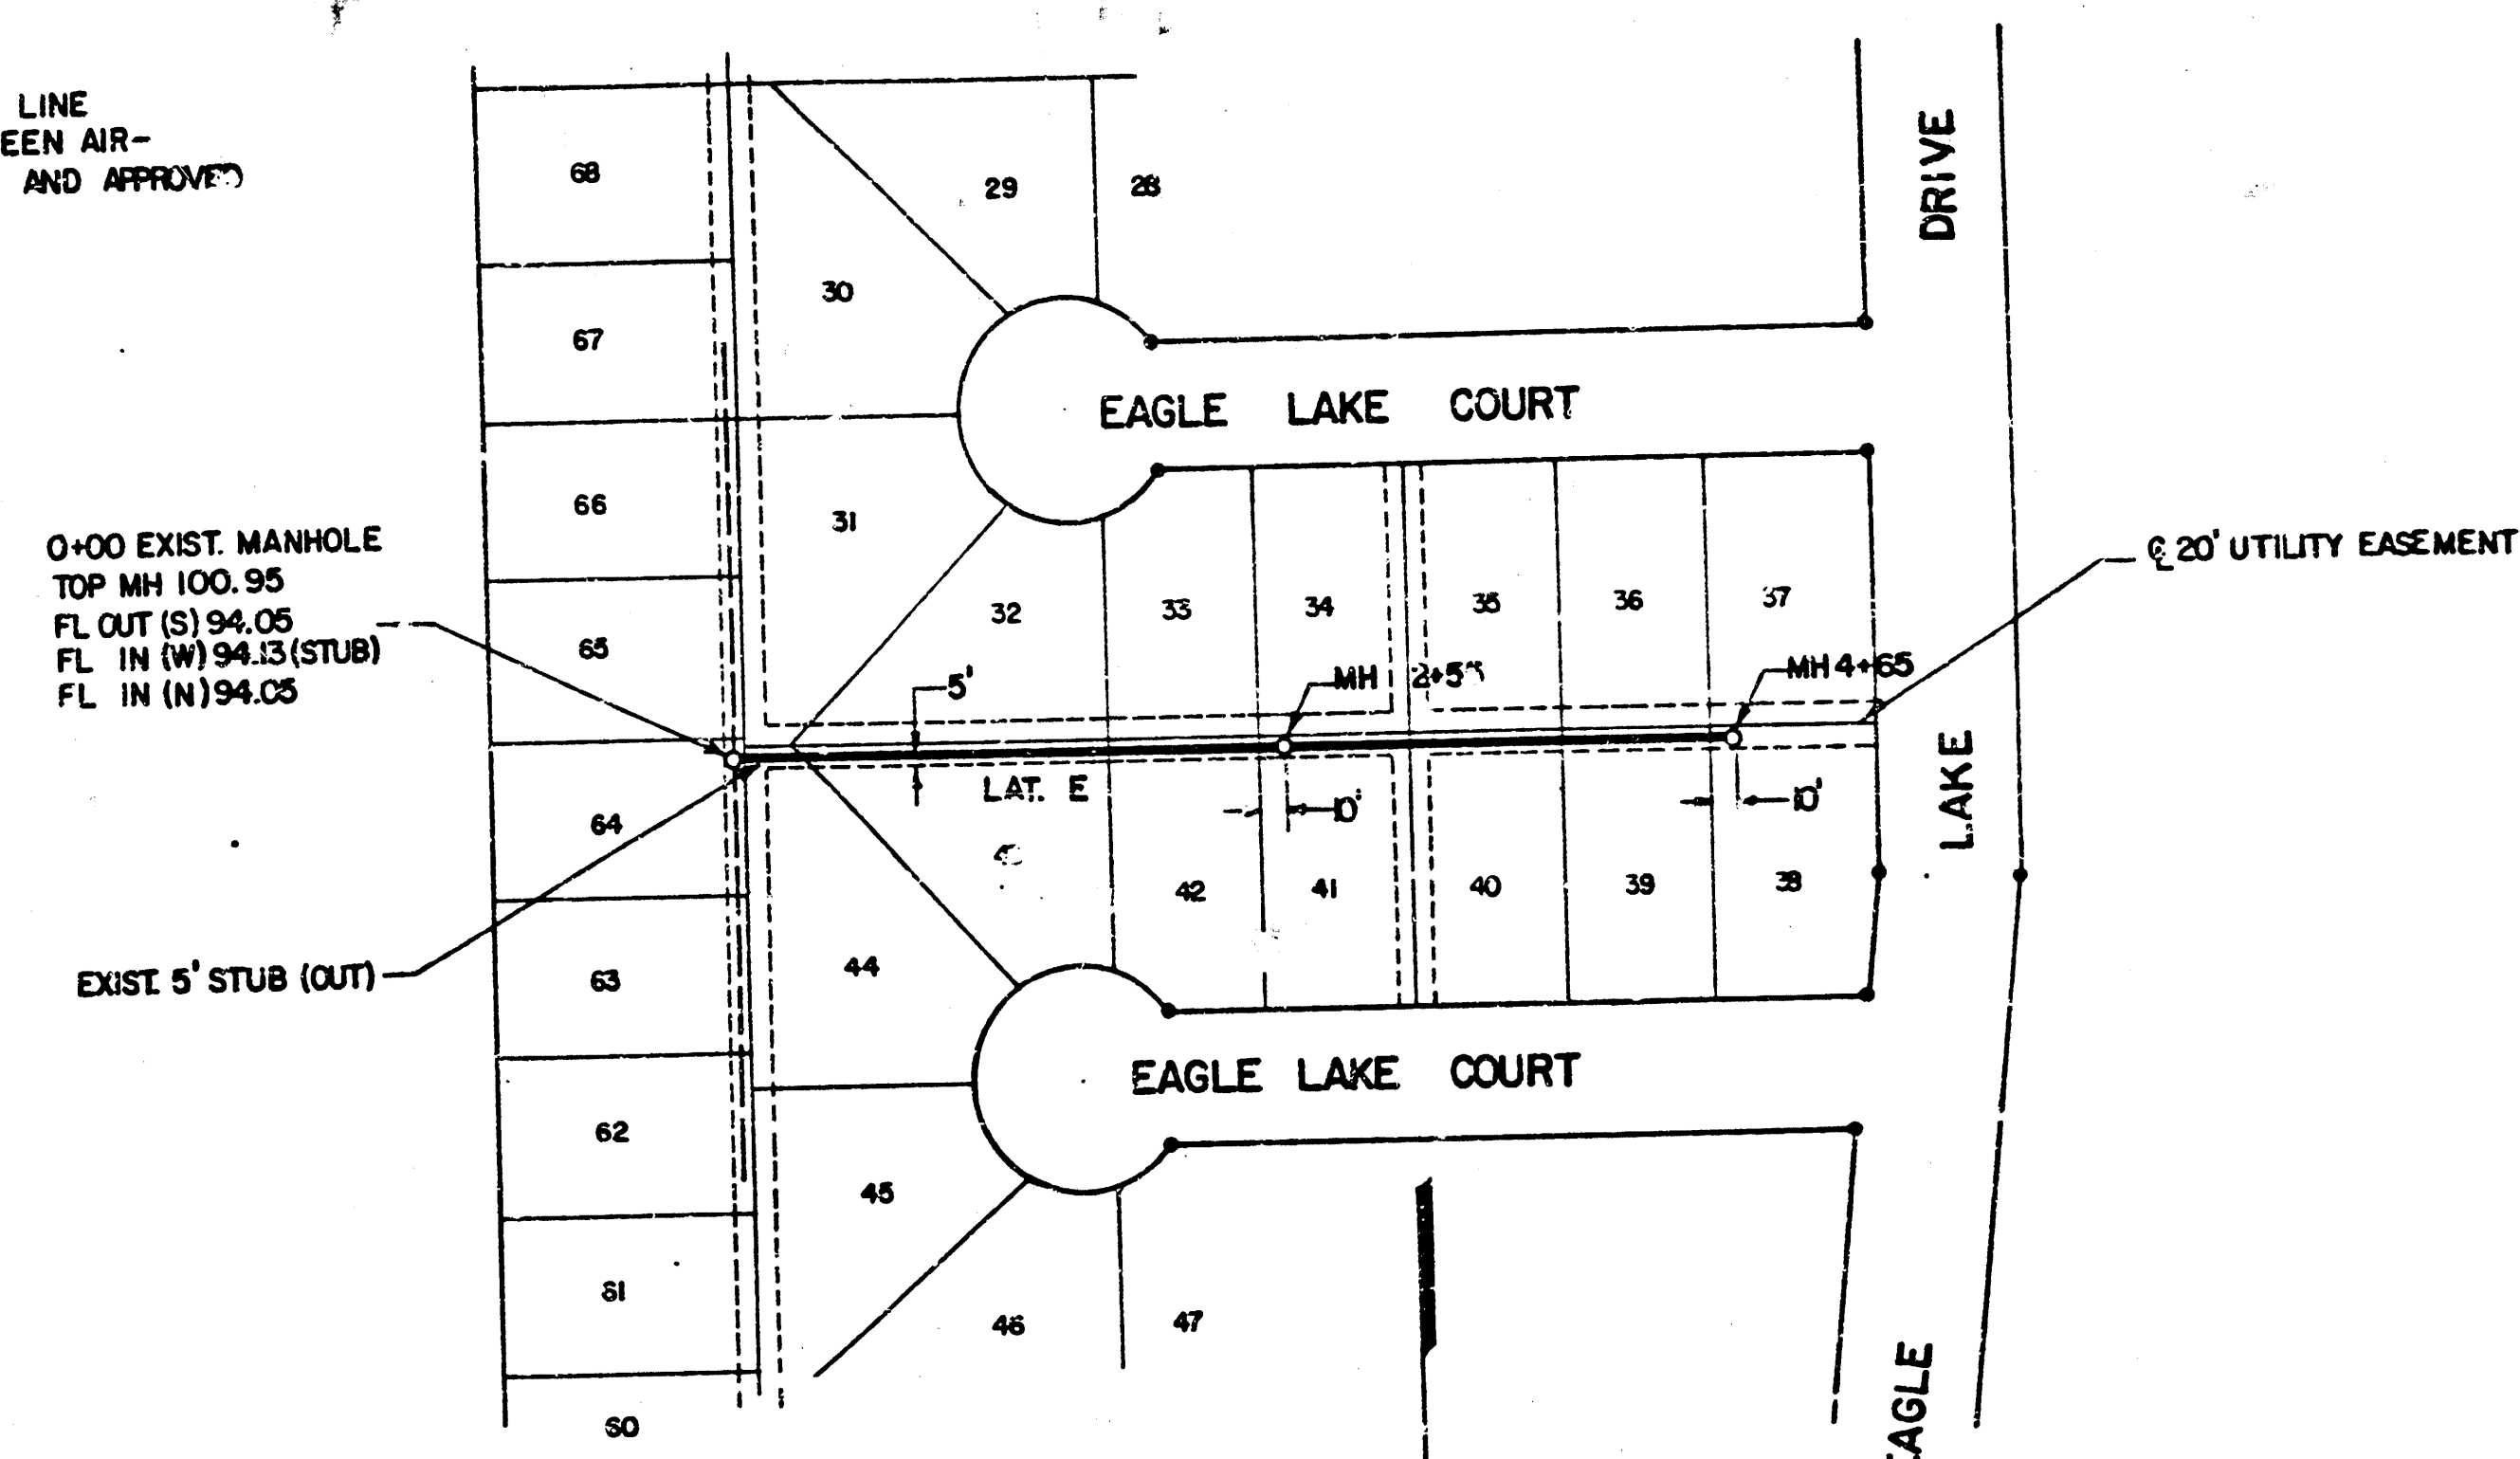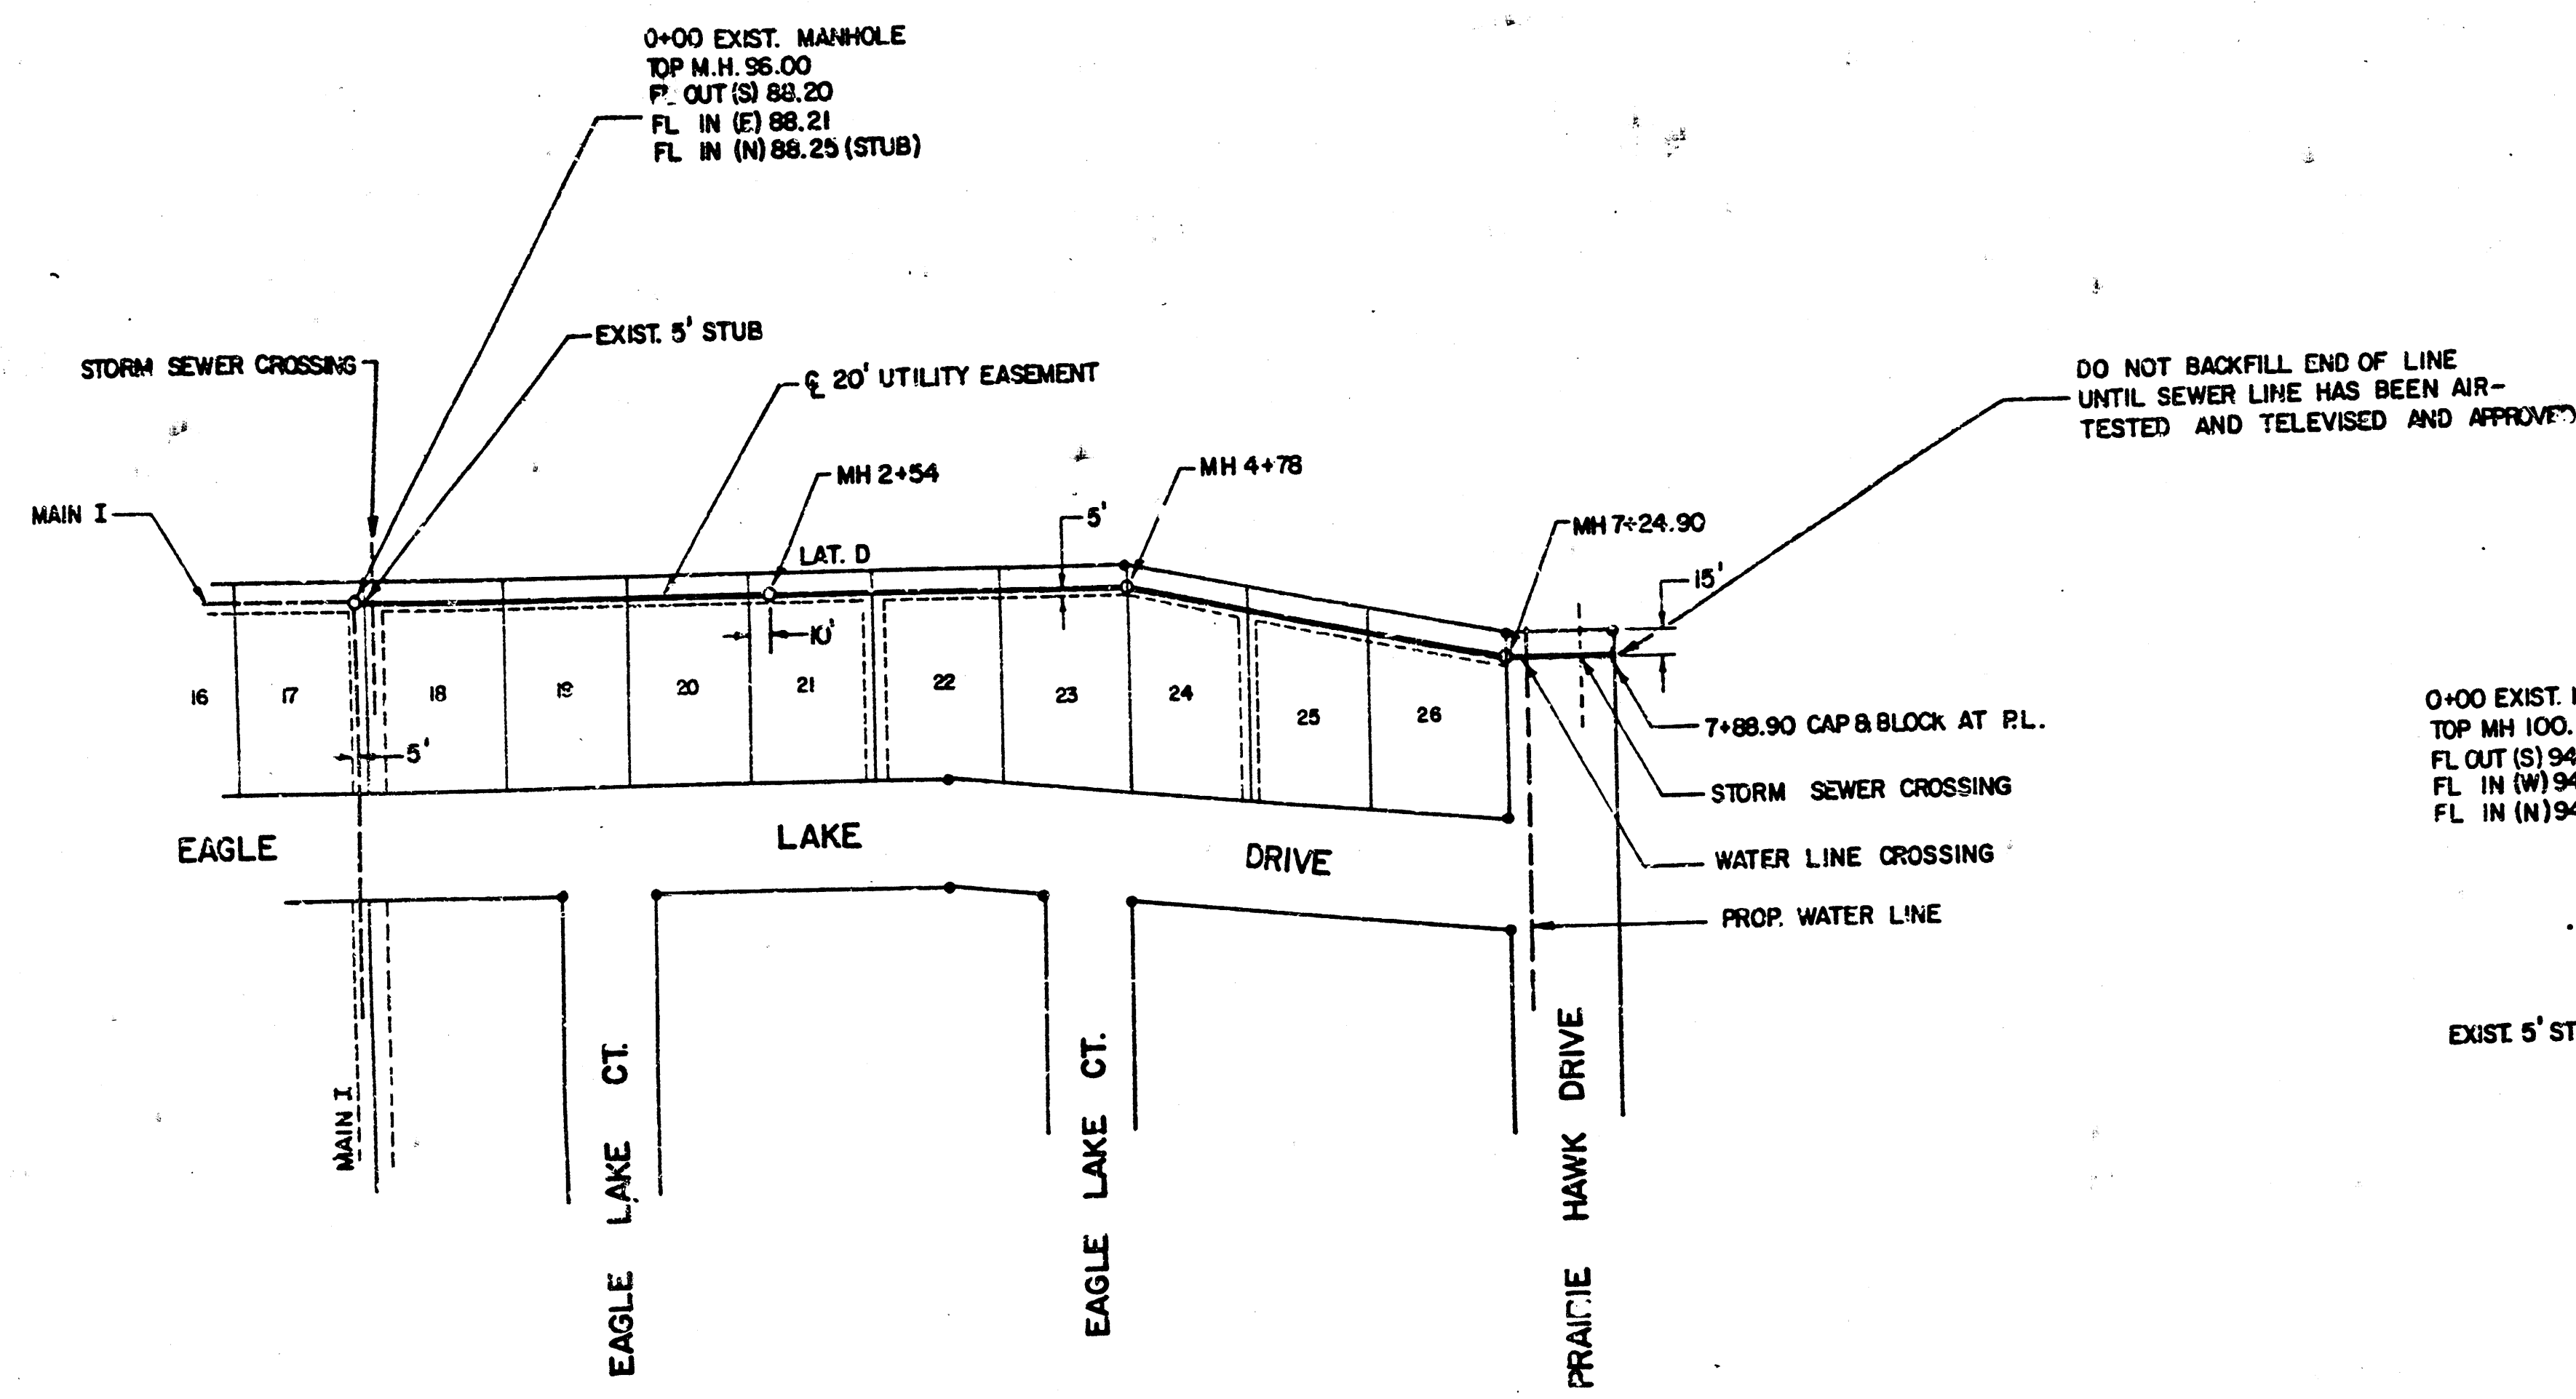

SCALE
PLAN 1" = 100'
PROFILE 1" = 50'
HORIZ 1" = 50'
VERT 1" = 5'

ALL PIPE IS 8" PVC

ALL MANHOLES ARE TYPE "A" OR "C"

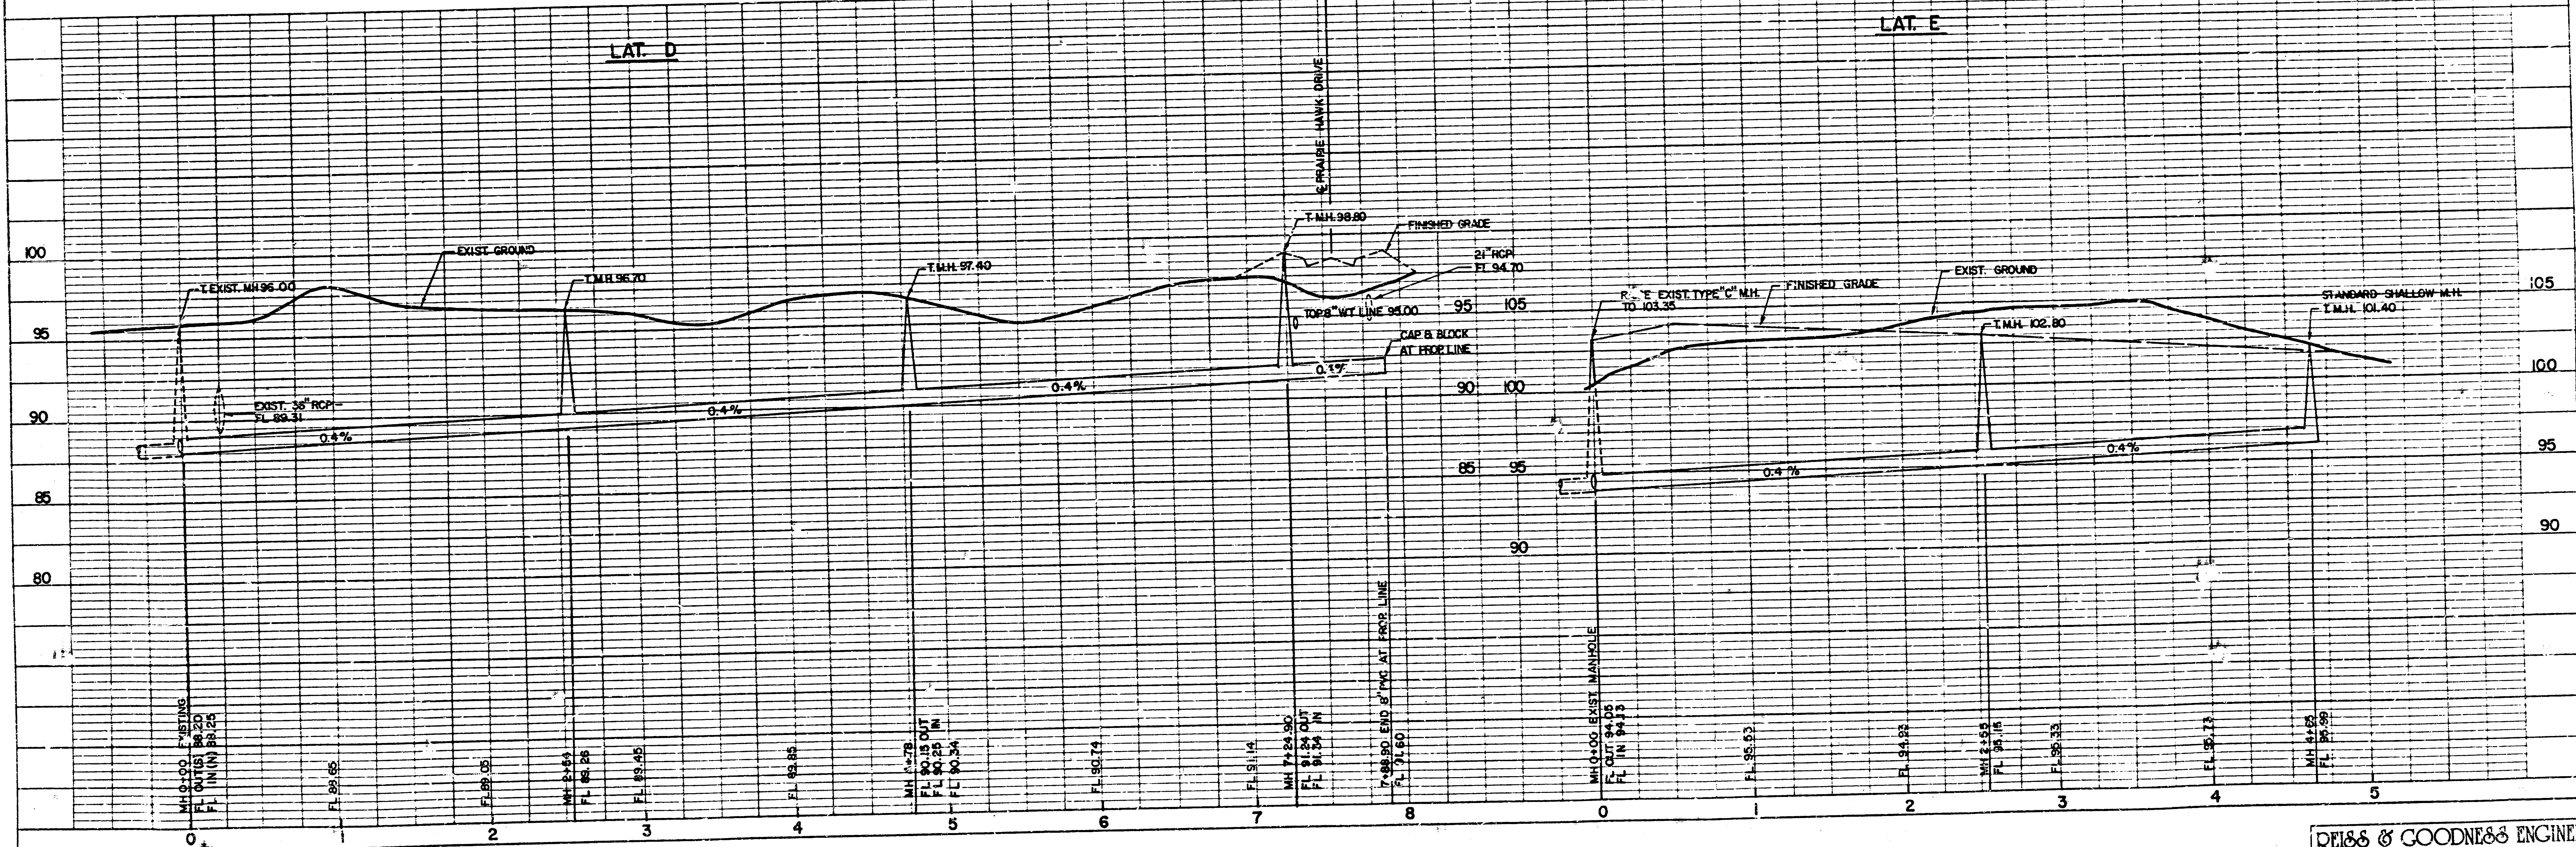

DEISS & GOODNESS ENGINEERS
2100 WEST 91ST STREET
WICHITA, KANSAS 67203
(316) 332-0255

REVISION	DRAWN BY	CHECKED BY	DESIGNED BY	PROJECT

SANITARY SEWER EXTENSIONS LAT D & LAT E

CUSTOMER

EAGLE LAKE ADDITION PHASE II BEL AIRE, KANSAS



SCALE NOTED
DATE 1/23/86

PROJECT NO.
SHEET 2

FILMED FROM THE BEST
AVAILABLE COPY.....

NOTE:
CONTRACTOR WILL CHECK F.L. GRADE(OUT)
OF EXIST. PIPE BEFORE LAYING NEW PIPE
AND MAKE ANY NECESSARY CHANGES IN GRADE


EXIST. 8" PVC SEWER LINE
MAIN I
MH 0+00 CONSTRUCT NEW M.H.
OVER EXIST. 8" PVC SEWER LINE.
FL OUT(S) 95.34
FL IN(N) 95.34
FL IN(W) 95.44

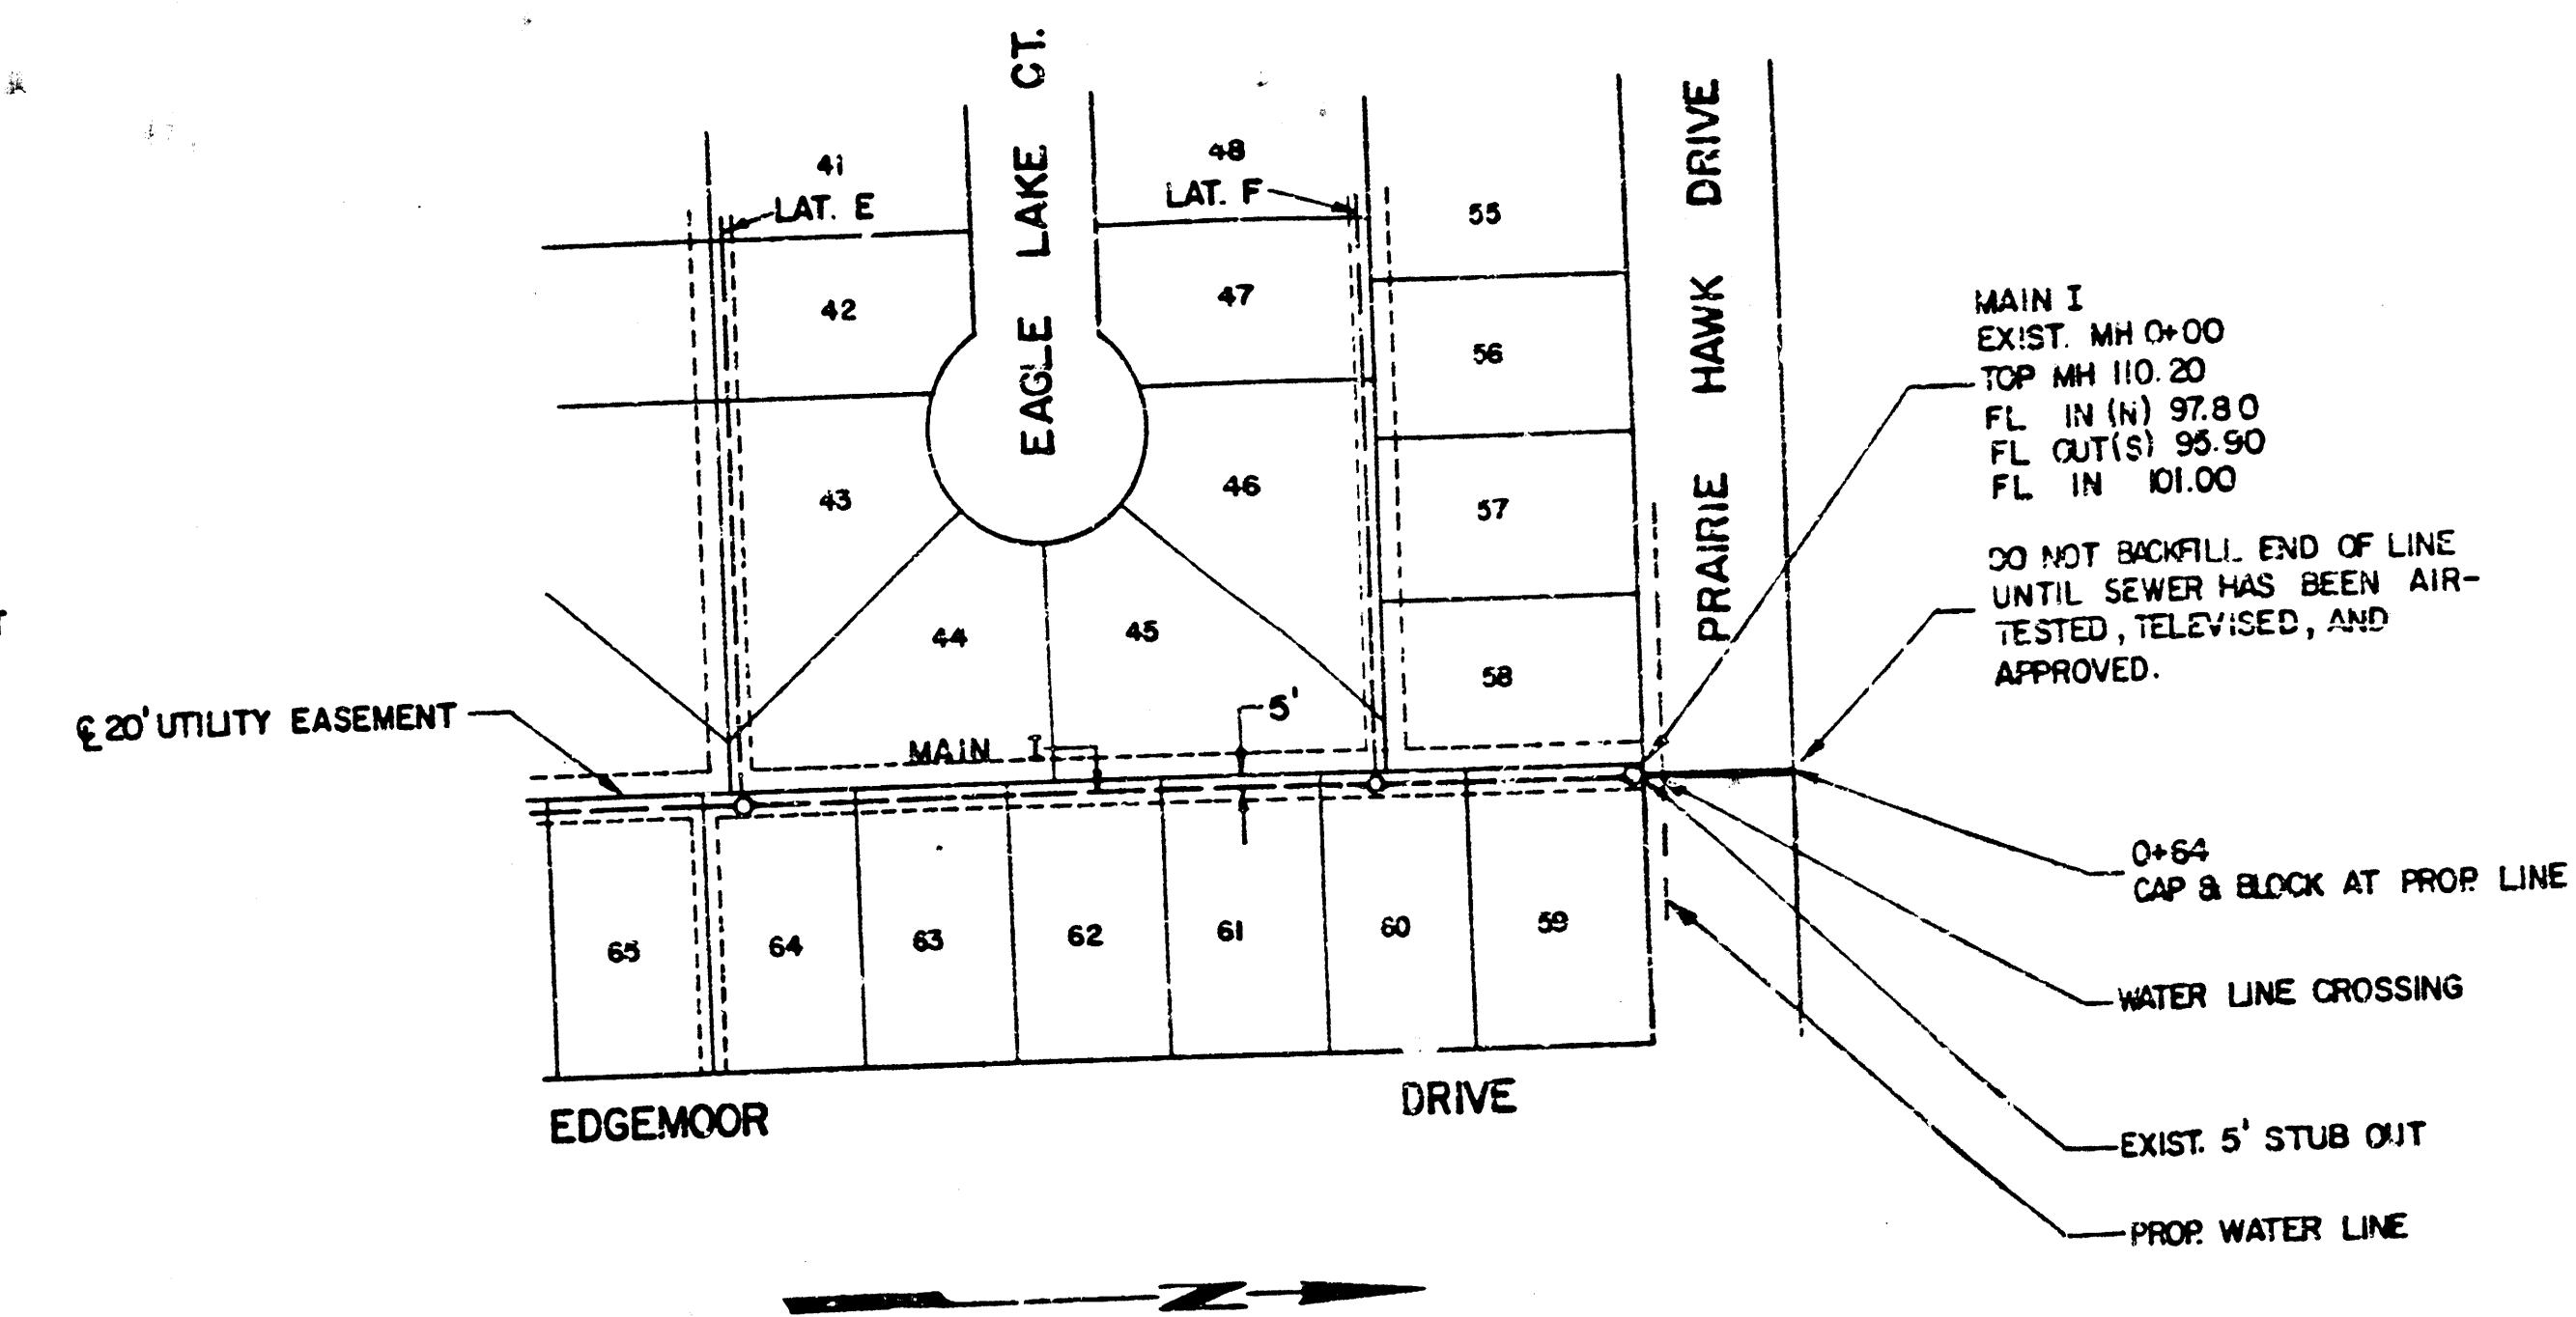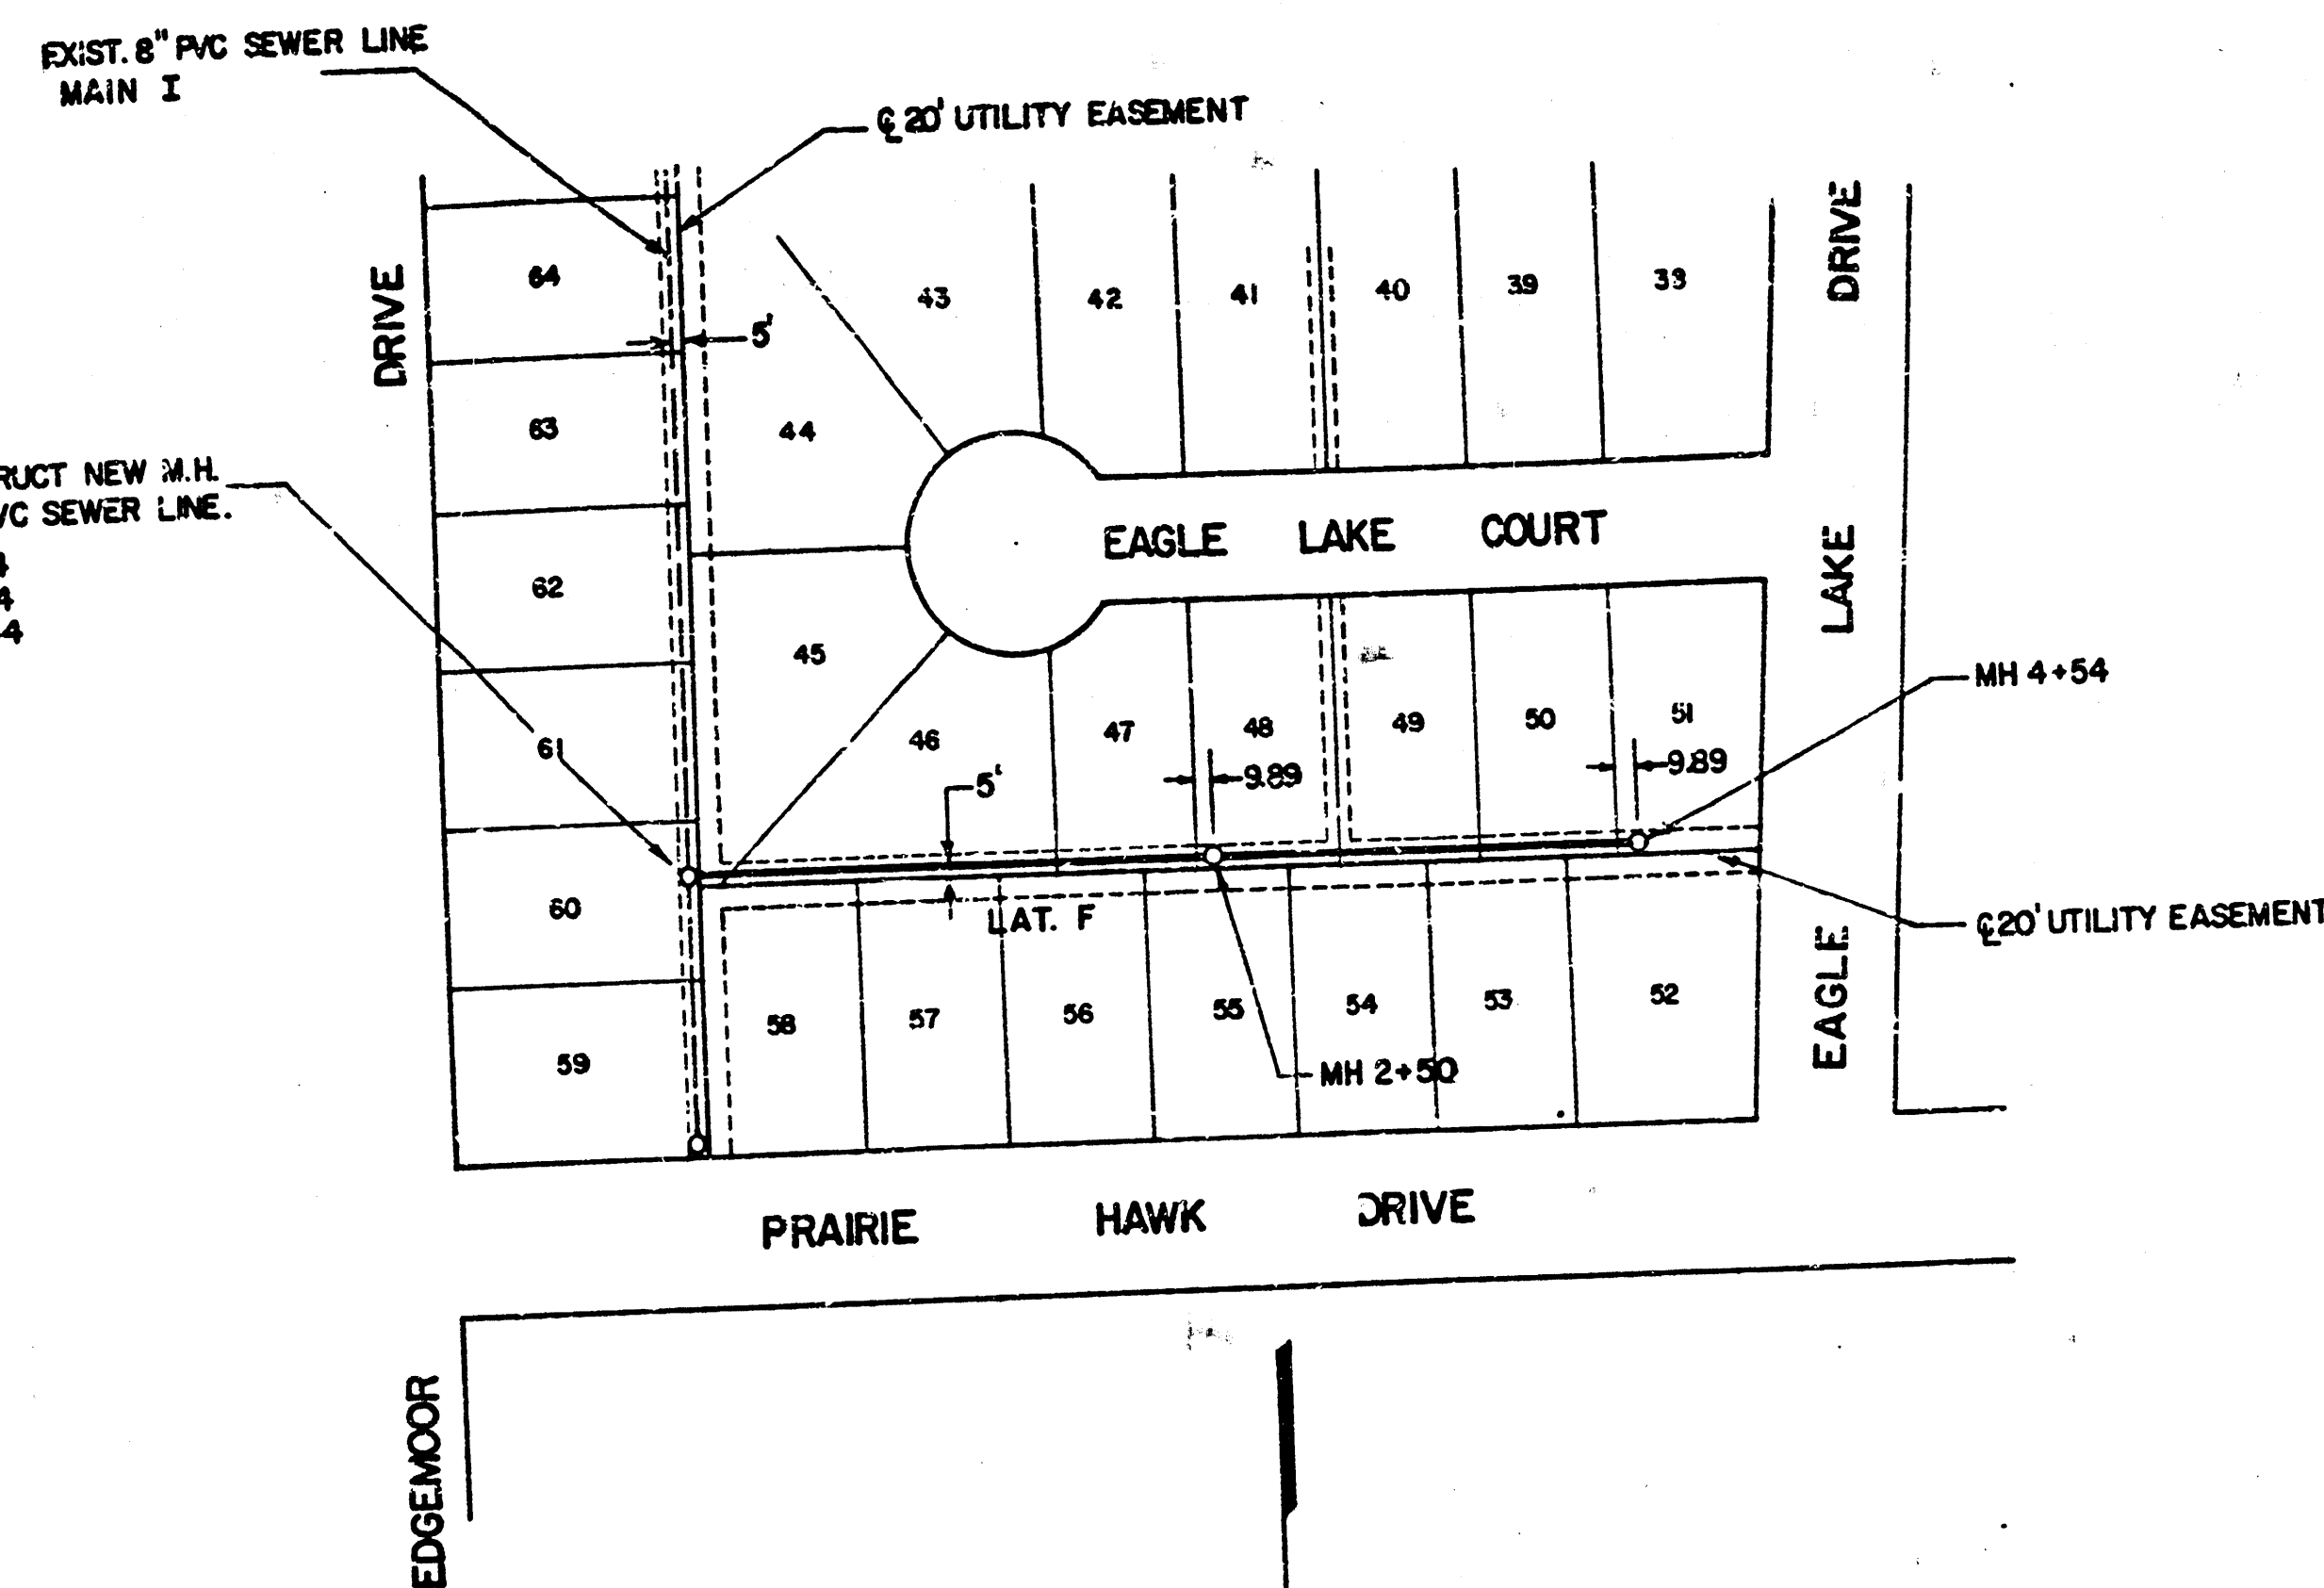

SCALE
PLAN 1"=100'
PROFILE
HORIZ 1"=50'
VERT 1"=5'

ALL PIPE IS 8" PVC

ALL MANHOLES ARE TYPE "A" OR "C"

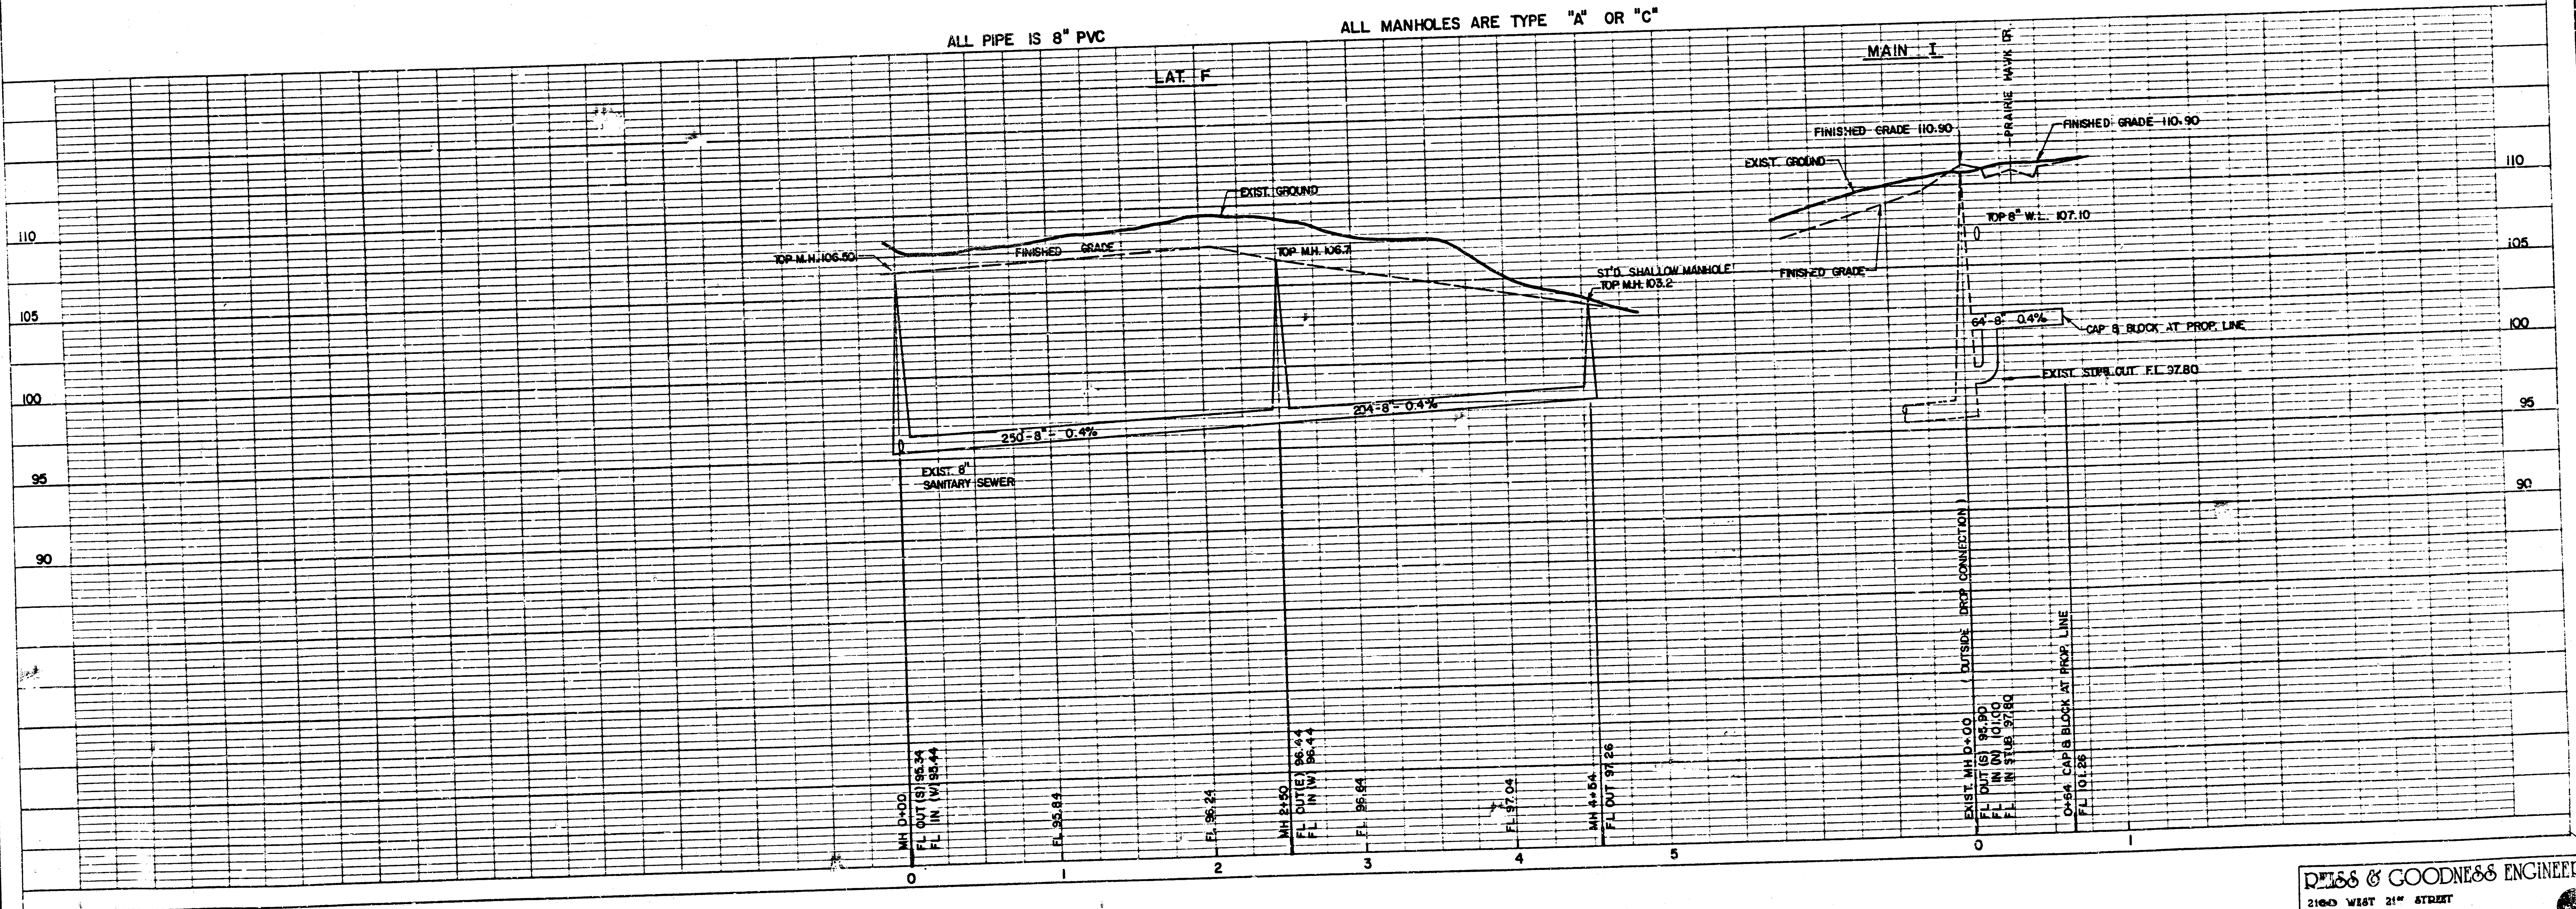

D. J. & GOODNESS ENGINEERS
2100 WEST 21ST STREET
WICHITA, KANSAS 67203
(316) 532-0233

REVISION	DRAWN BY	CHECKED BY	DESIGNED BY	PROJECT
				SANITARY SEWER EXTENSIONS LAT F & MAIN I

CUSTOMER EAGLE LAKE ADDITION-PHASE II-BEL AIRE, KANSAS

SCALE GIVEN PROJECT NO.
DATE 1/24/86 SHEET 3 OF 3

FILMED FROM THE BEST
AVAILABLE COPY.....

PLANS FOR SANITARY SEWER EXTENSIONS TO EAGLE LAKE ADDITION PHASE II BEL AIRE, SEDGWICK COUNTY

SEI485
1986

CITY OF WICHITA PROJECT NO. 468 76 245 80001 000 000 051

INDEX OF SHEETS


- 1 - TITLE SHEET
- 2 - LAT. D AND LAT. E
- 3 - LAT. F AND MAIN I
- 4-3 DETAILS

APPROVED FOR THE CITY OF WICHITA
By CITY ENGINEER OF WICHITA


Sanitary Sewer *1/23/86*
Storm Sewer _____
Drains _____
Water Line _____
Paving _____

NOTE TO CONTRACTOR


This project will be constructed under the supervision of the CITY ENGINEER and conforming to the CITY ENGINEER'S plan and specifications. The CITY OF WICHITA will pay the City Engineer's fee and the City Engineer's fee will be paid by the City of Wichita.

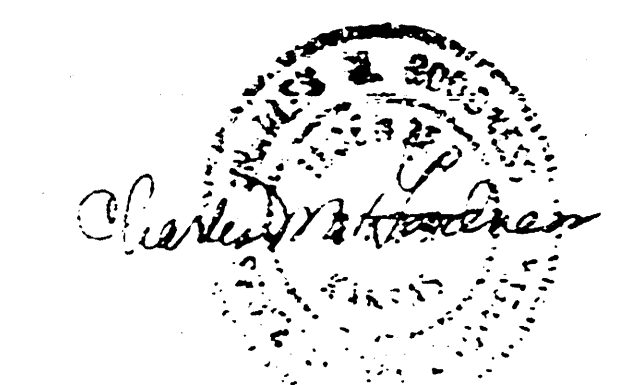

REVISED 2/10/86
REISS & GOODNESS ENGINEERS
2160 WEST 21ST STREET
WICHITA, KANSAS 67203
(316) 832-0213

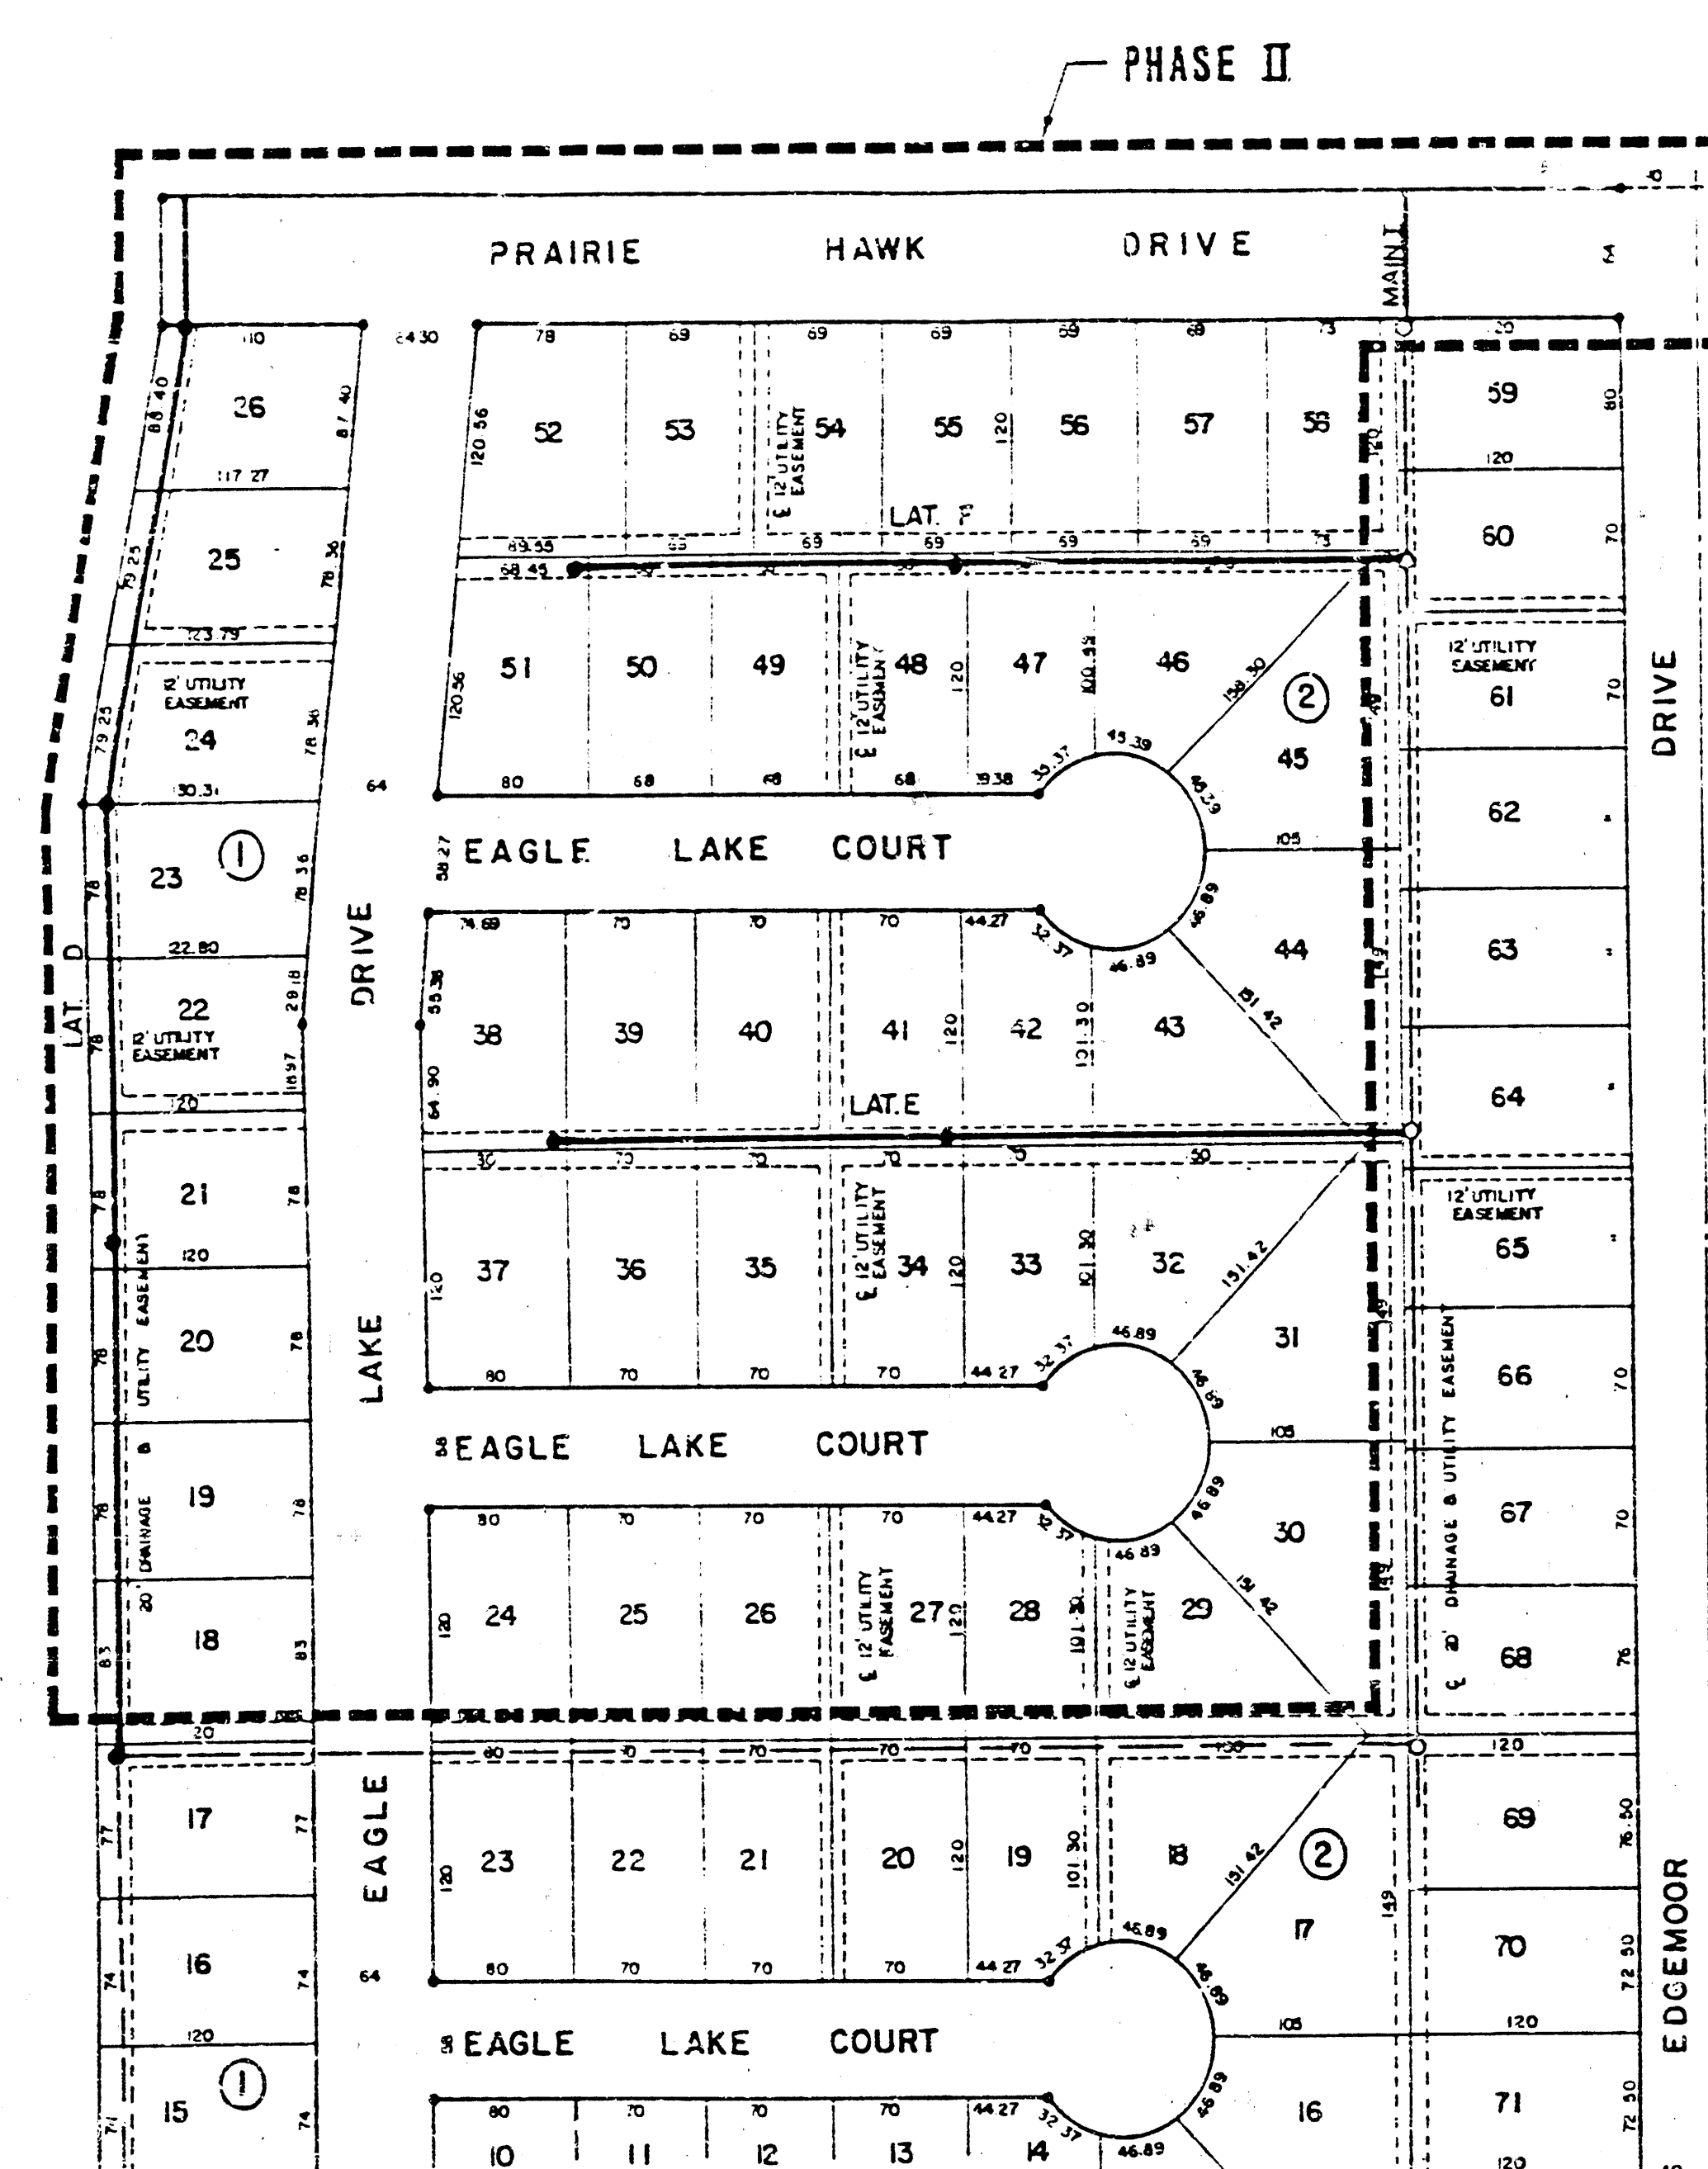

BM
"C" CUT IN SW COR. INLET BOX,
150' E. NO. OF EAGLE LAKE COURT
EL. 1398.61 USGS

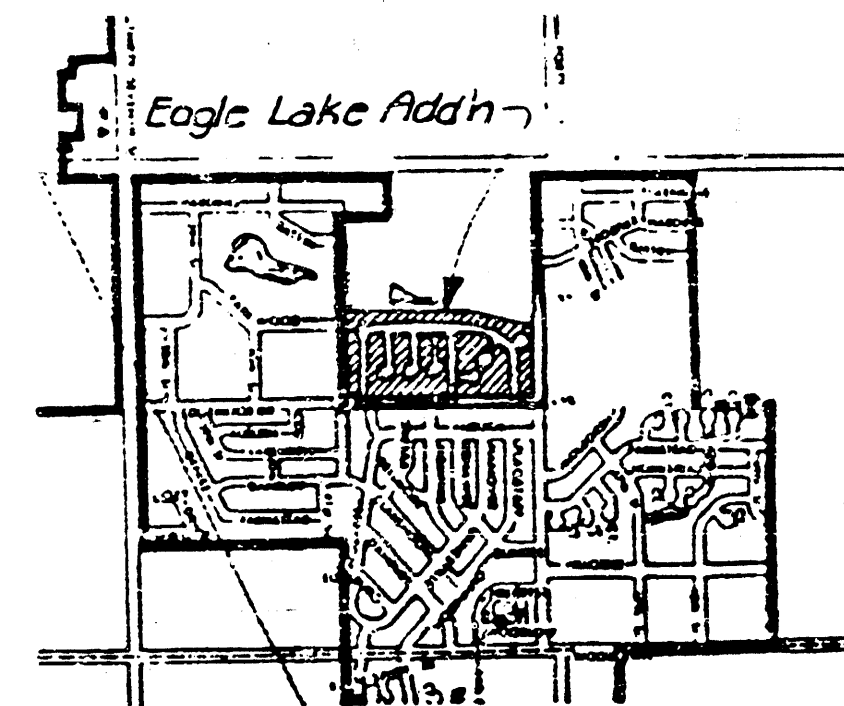




VICINITY MAP
N.S.

"AS BUILT"

REVISION	DRAWN BY	CHECKED BY	DESIGNED BY	PROJECT	CUSTOMER


SCALE GIVEN	PROJECT NO.
DATE 1/23/86	SEI485
SHEET 1 OF 4	

FILMED FROM THE BEST
AVAILABLE COPY.....

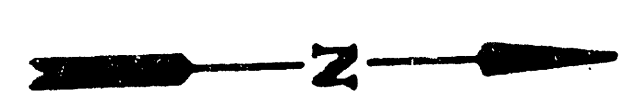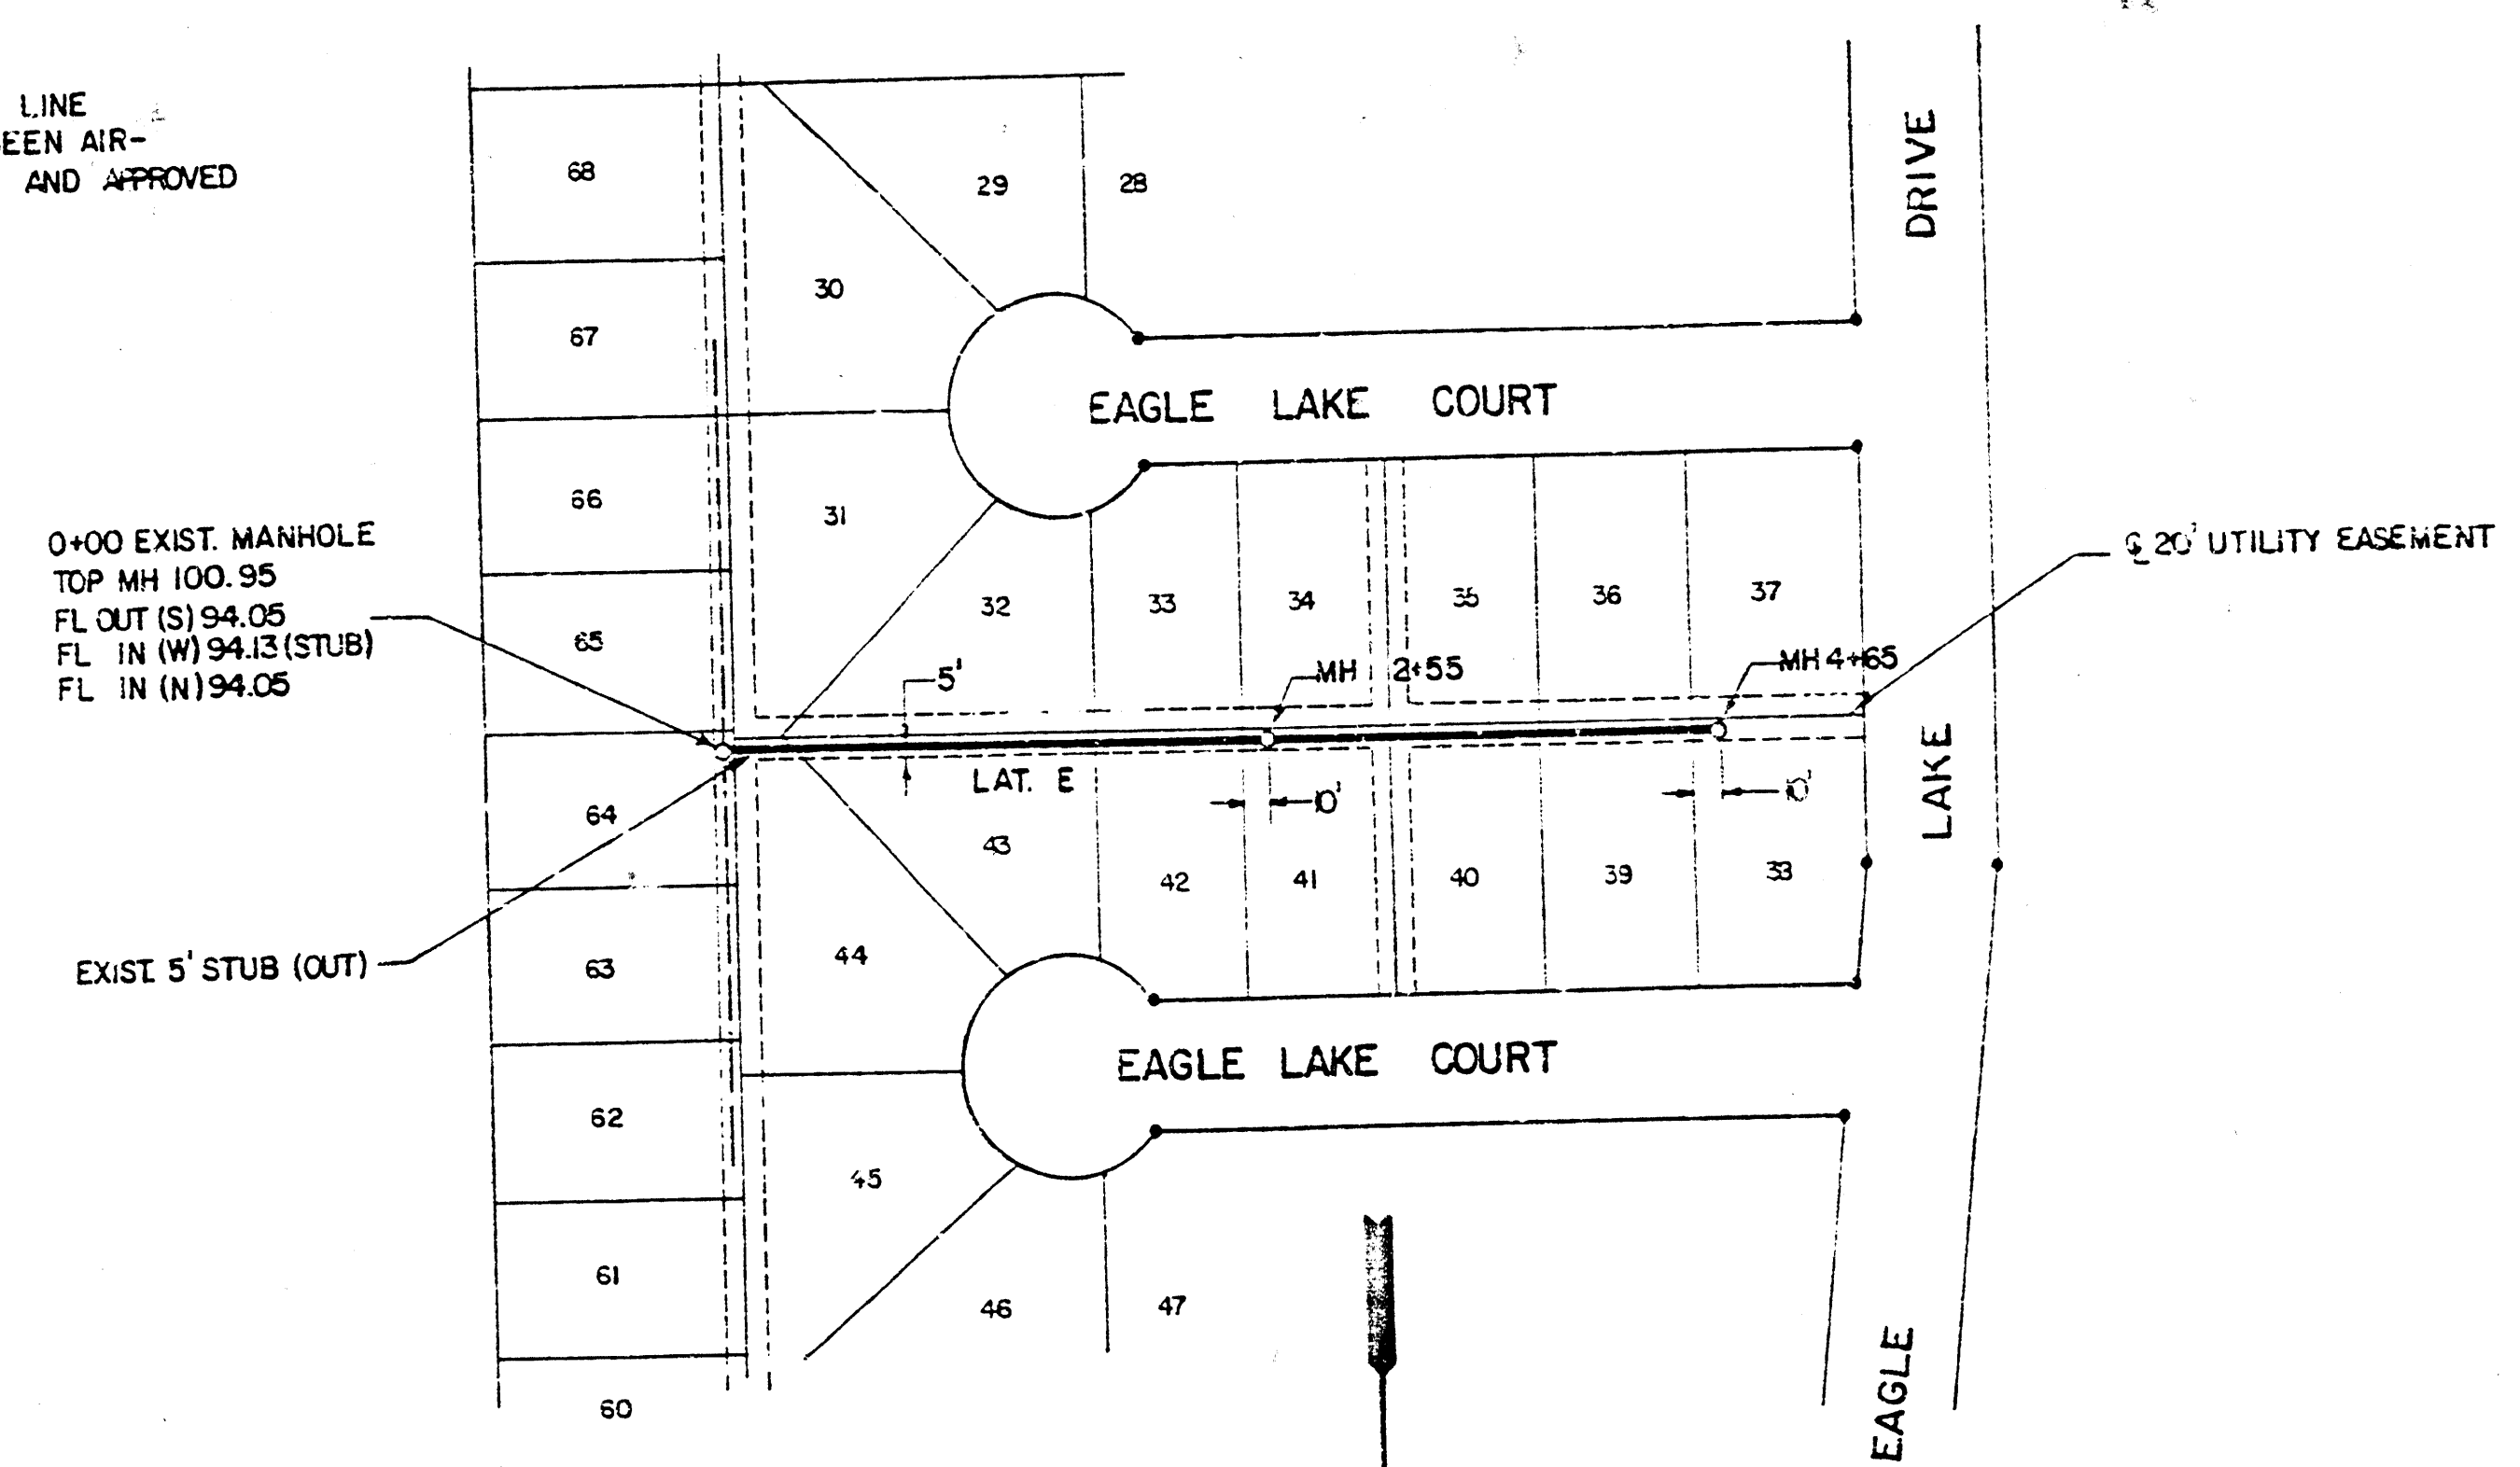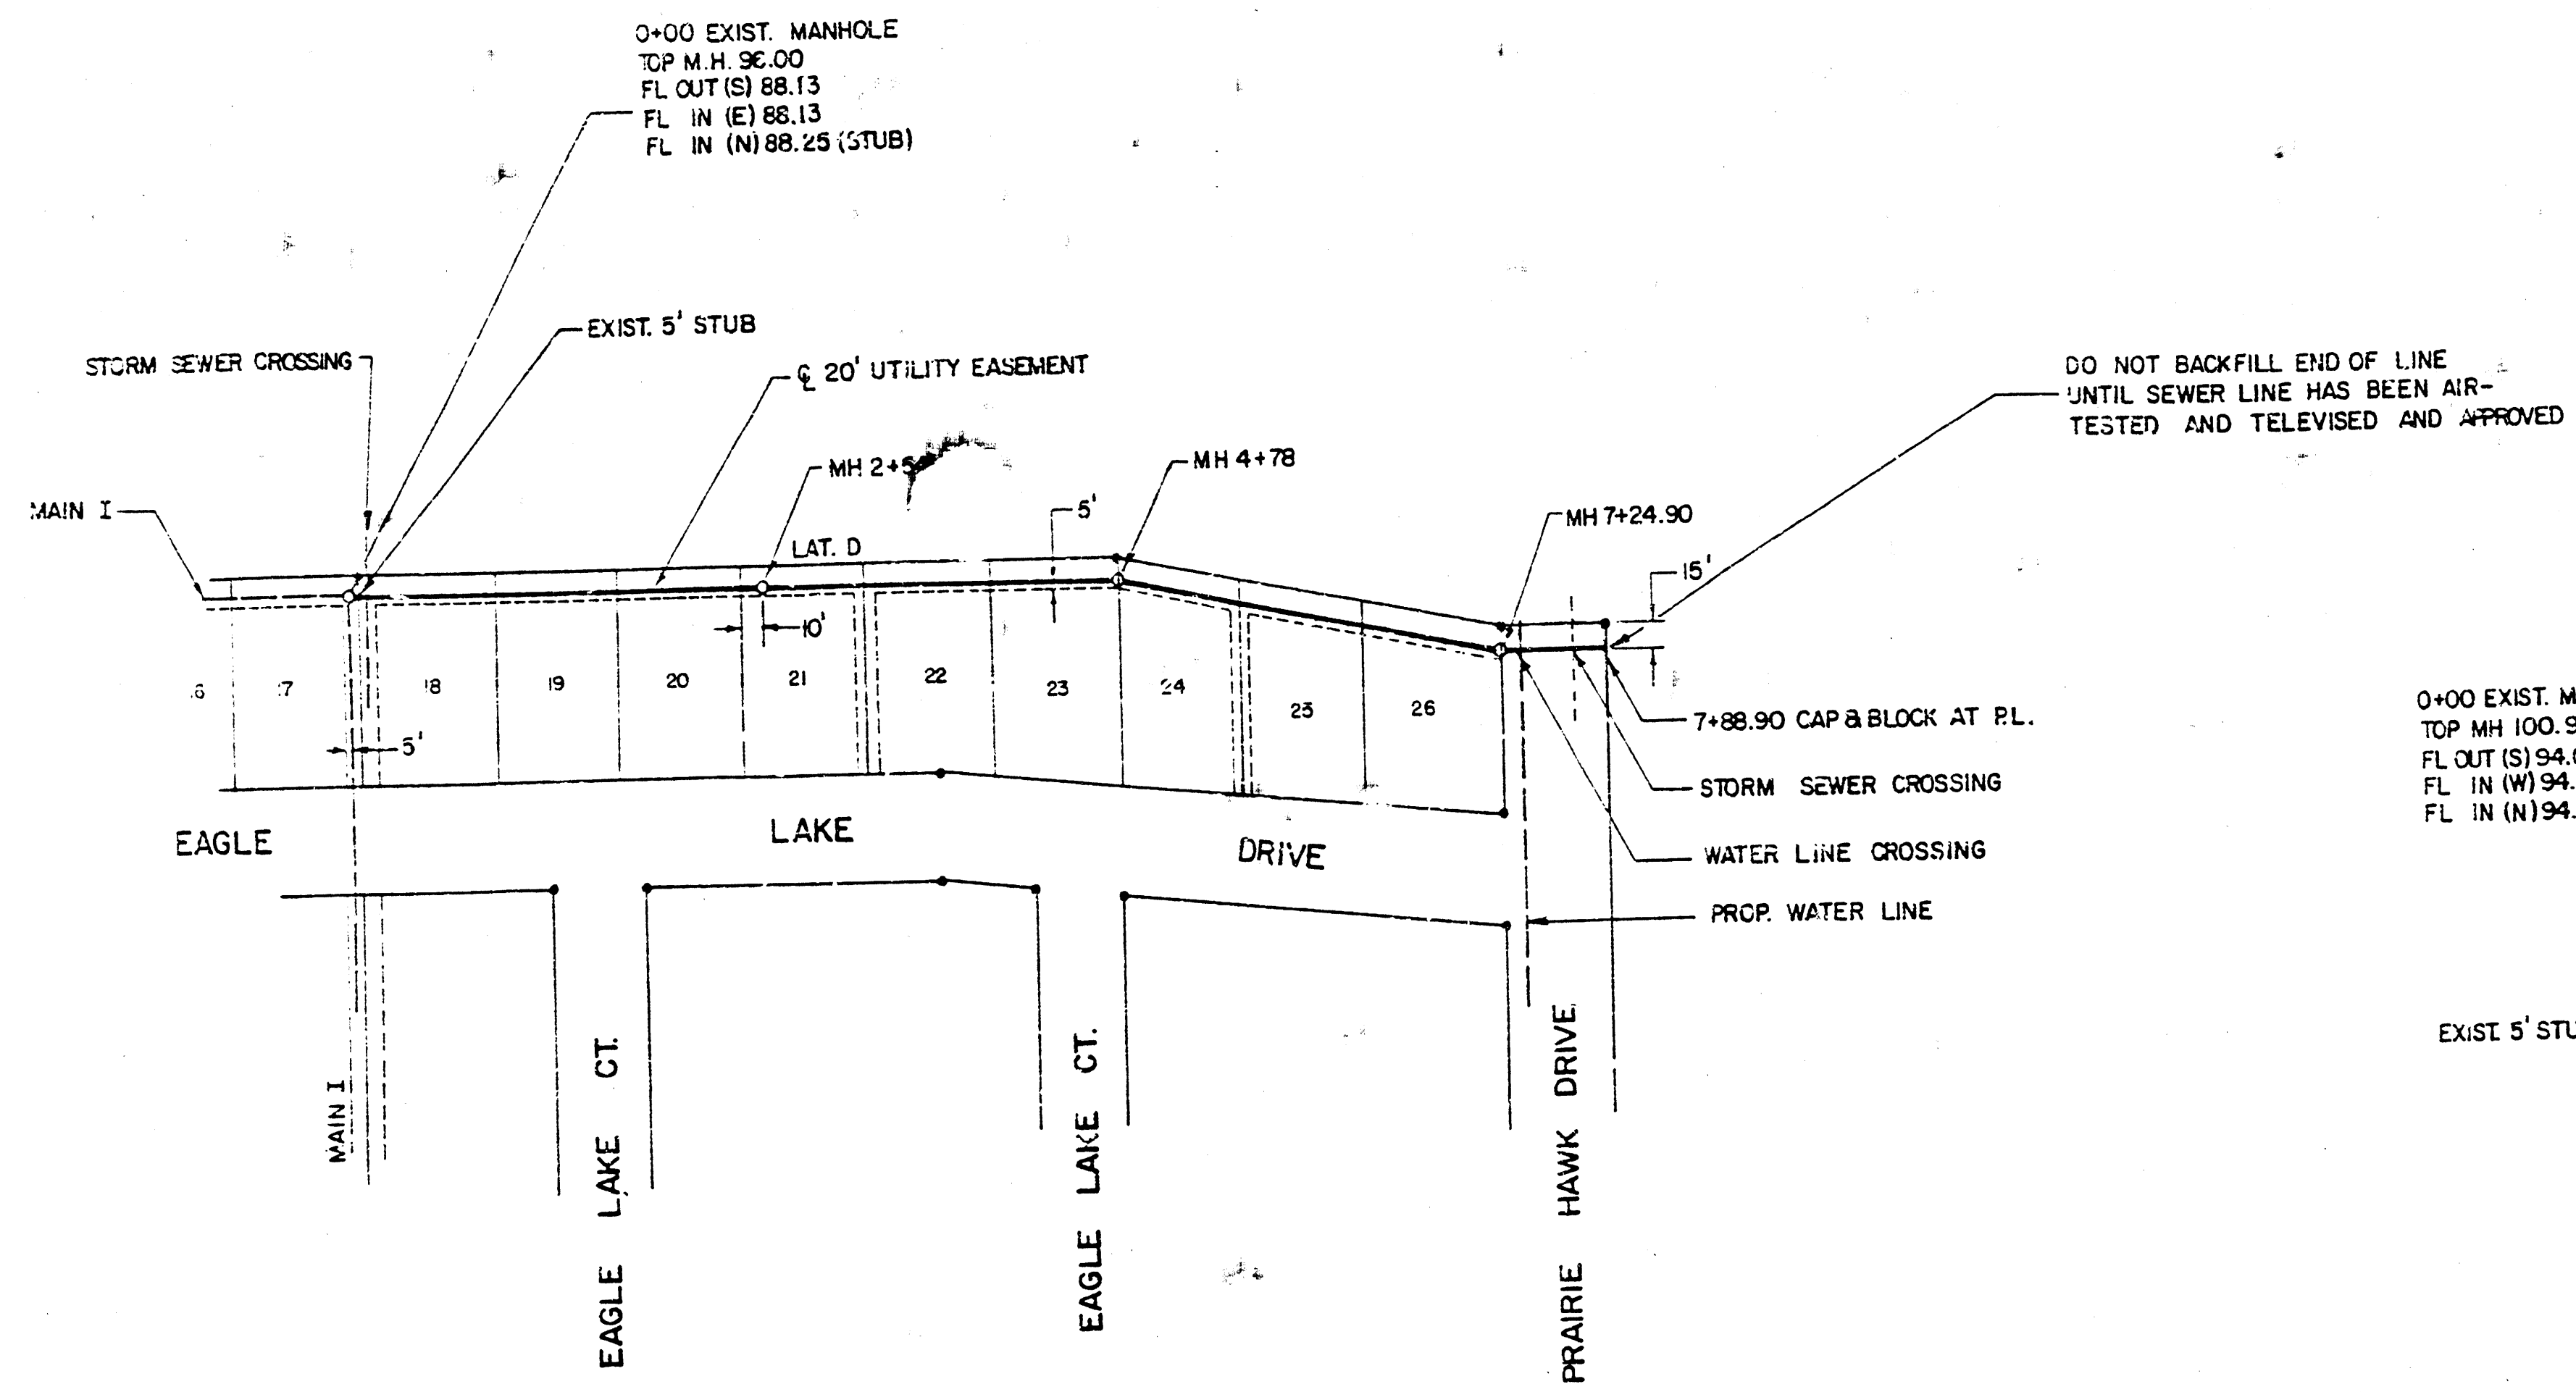

SCALE
 PLAN 1" = 100'
 PROFILE 1" = 50'
 HORIZ 1" = 50'
 VERT 1" = 5'

NOTE:
 ADD 1300 TO ELEVATIONS SHOWN
 TO OBTAIN USGS ELEVATION

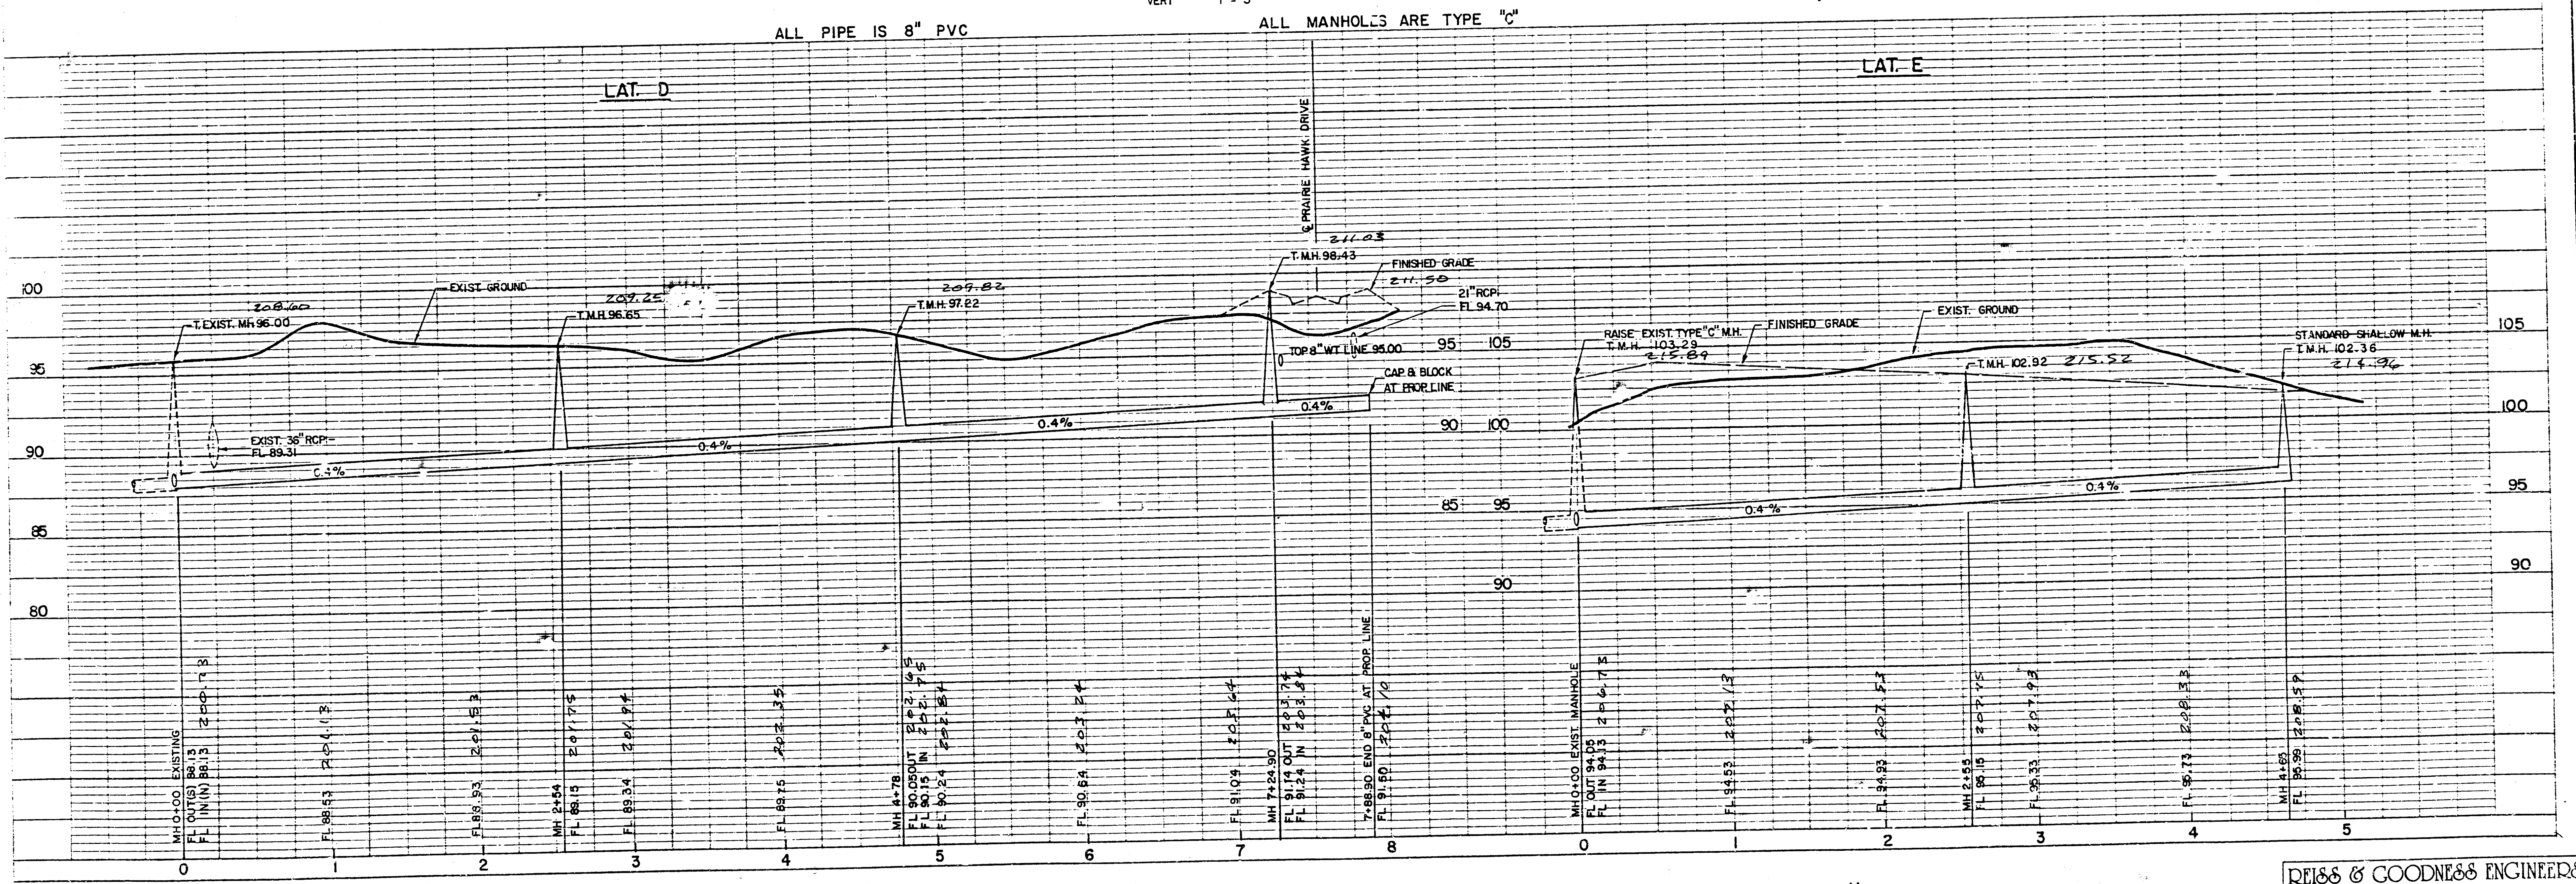

"AS BUILT"

DEISS & GOODNESS ENGINEERS
 2150 WEST 21ST STREET
 WICHITA, KANSAS 67203
 (316) 832-0213

REVISION	DRAWN BY	CHECKED BY	DESIGNED BY	PROJECT

SANITARY SEWER EXTENSIONS LAT D & LAT E



CUSTOMER EAGLE LAKE ADDITION PHASE II BEL AIRE, KANSAS

SCALE	NOTED	PROJECT NO.
DATE	1/23/86	SE 1485
		SHEET 5 8

FILMED FROM THE BEST
 AVAILABLE COPY.....

NOTE:
CONTRACTOR WILL CHECK F.L. GRADE(OUT)
OF EXIST. PIPE BEFORE LAYING NEW PIPE
AND MAKE ANY NECESSARY CHANGES IN GRADE


NOTE:
ADD 1300 TO ELEVATIONS SHOWN
TO OBTAIN USGS ELEVATION

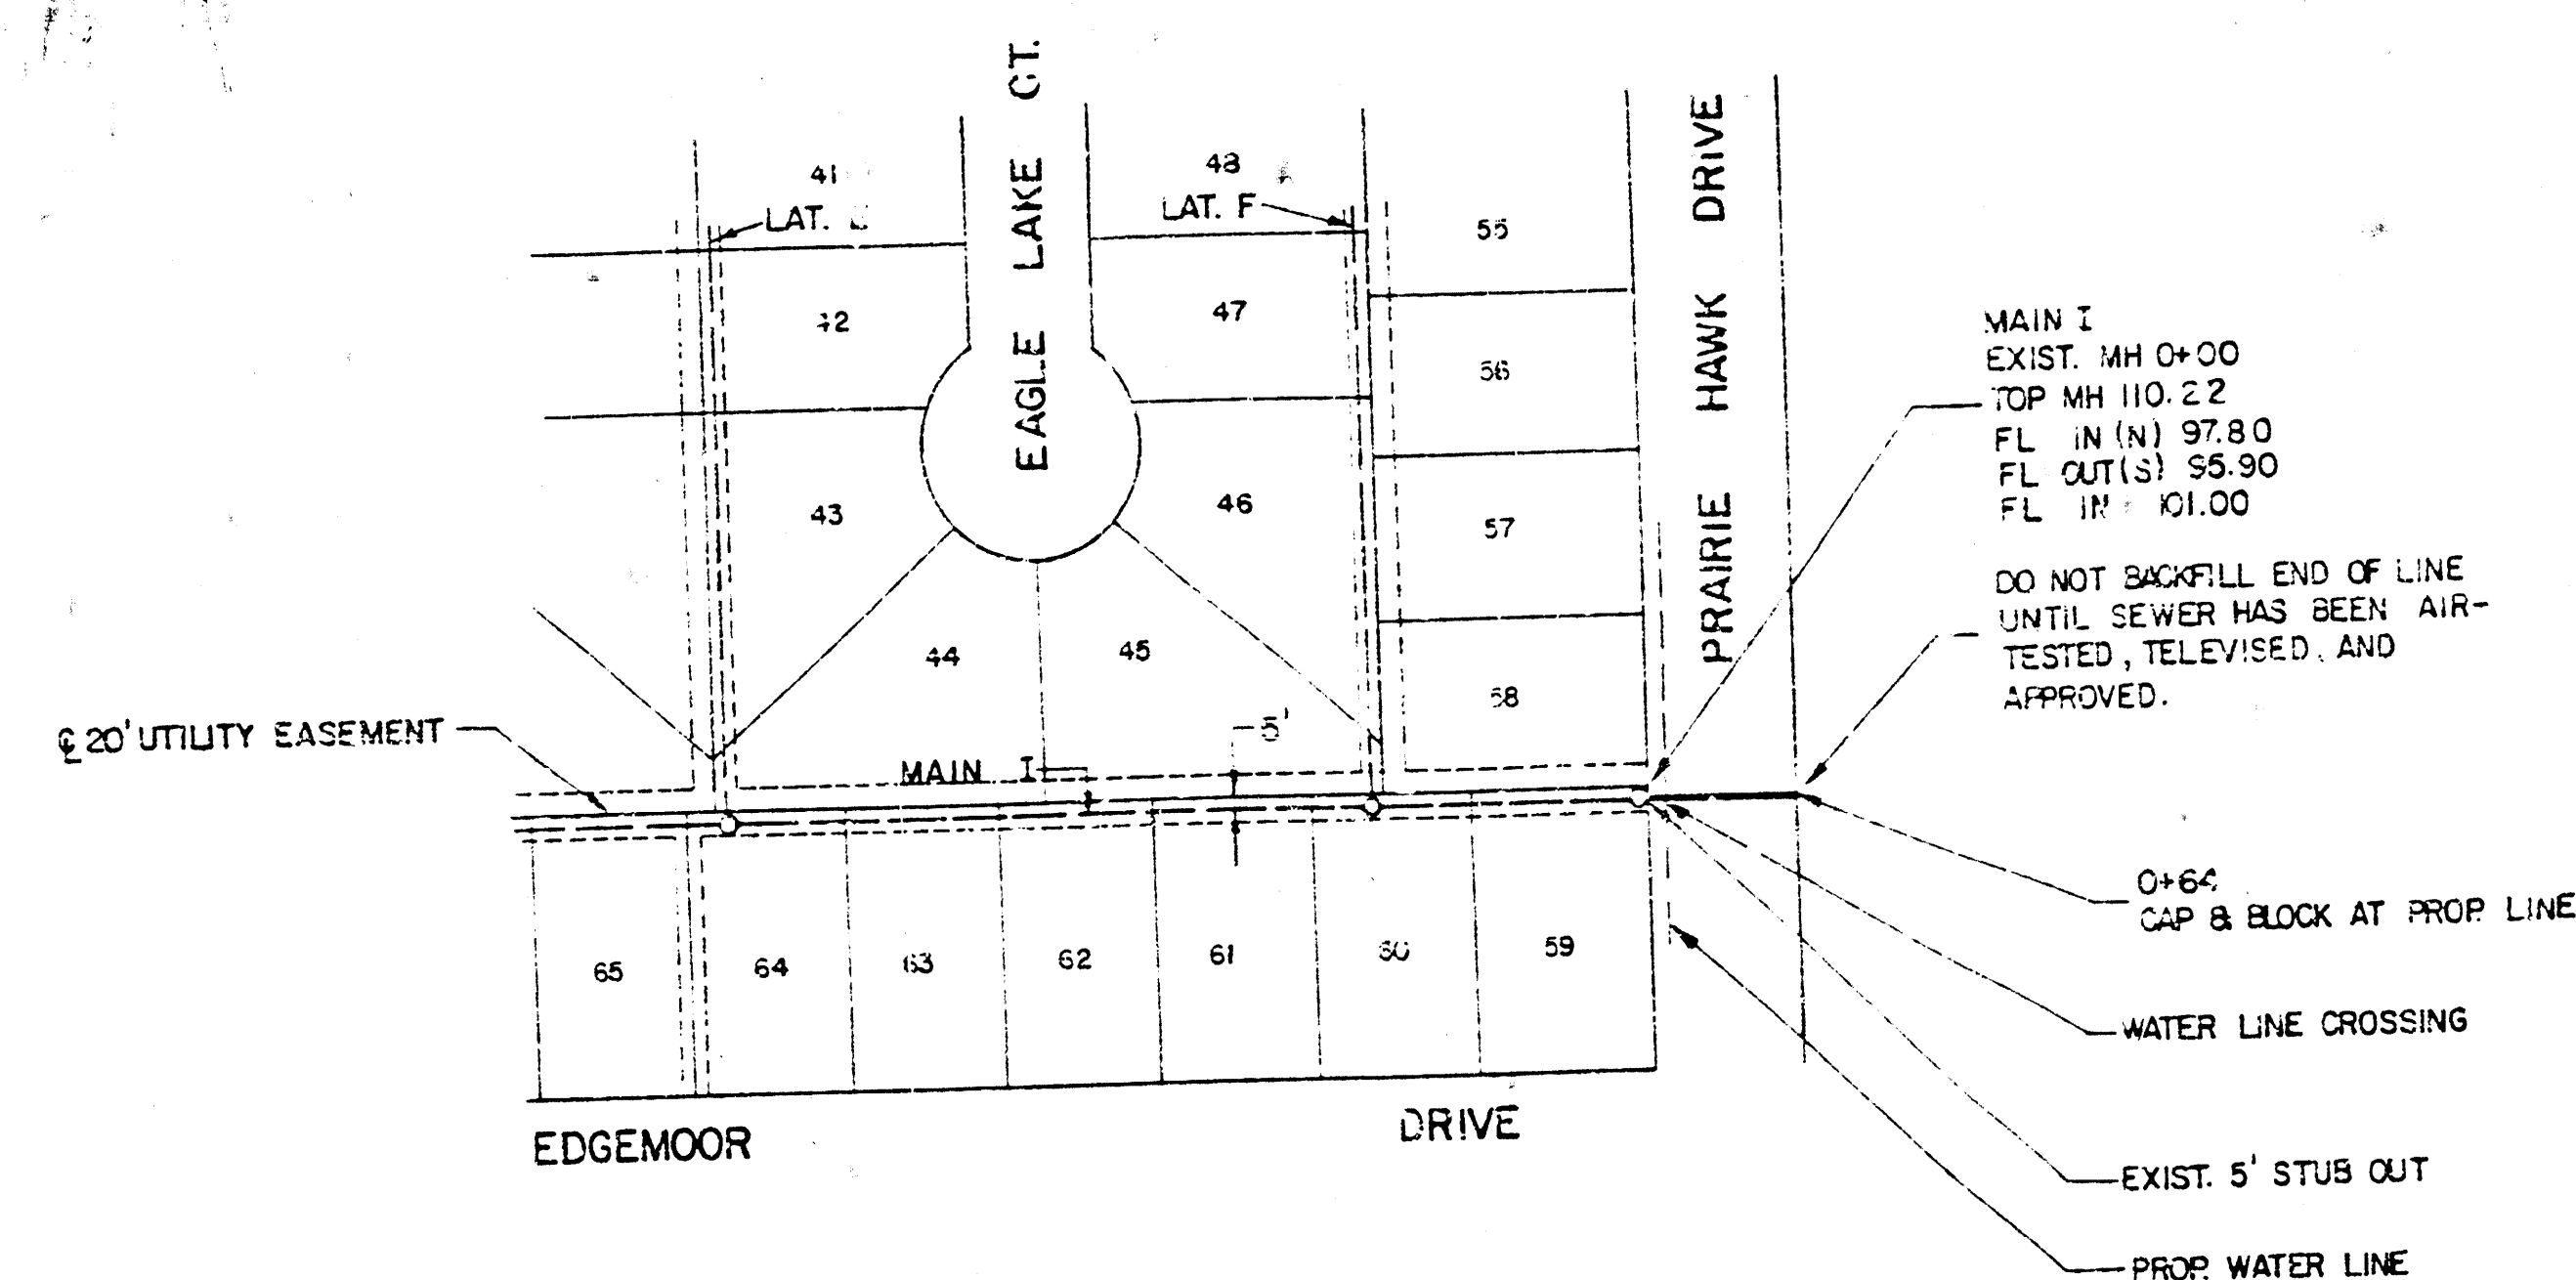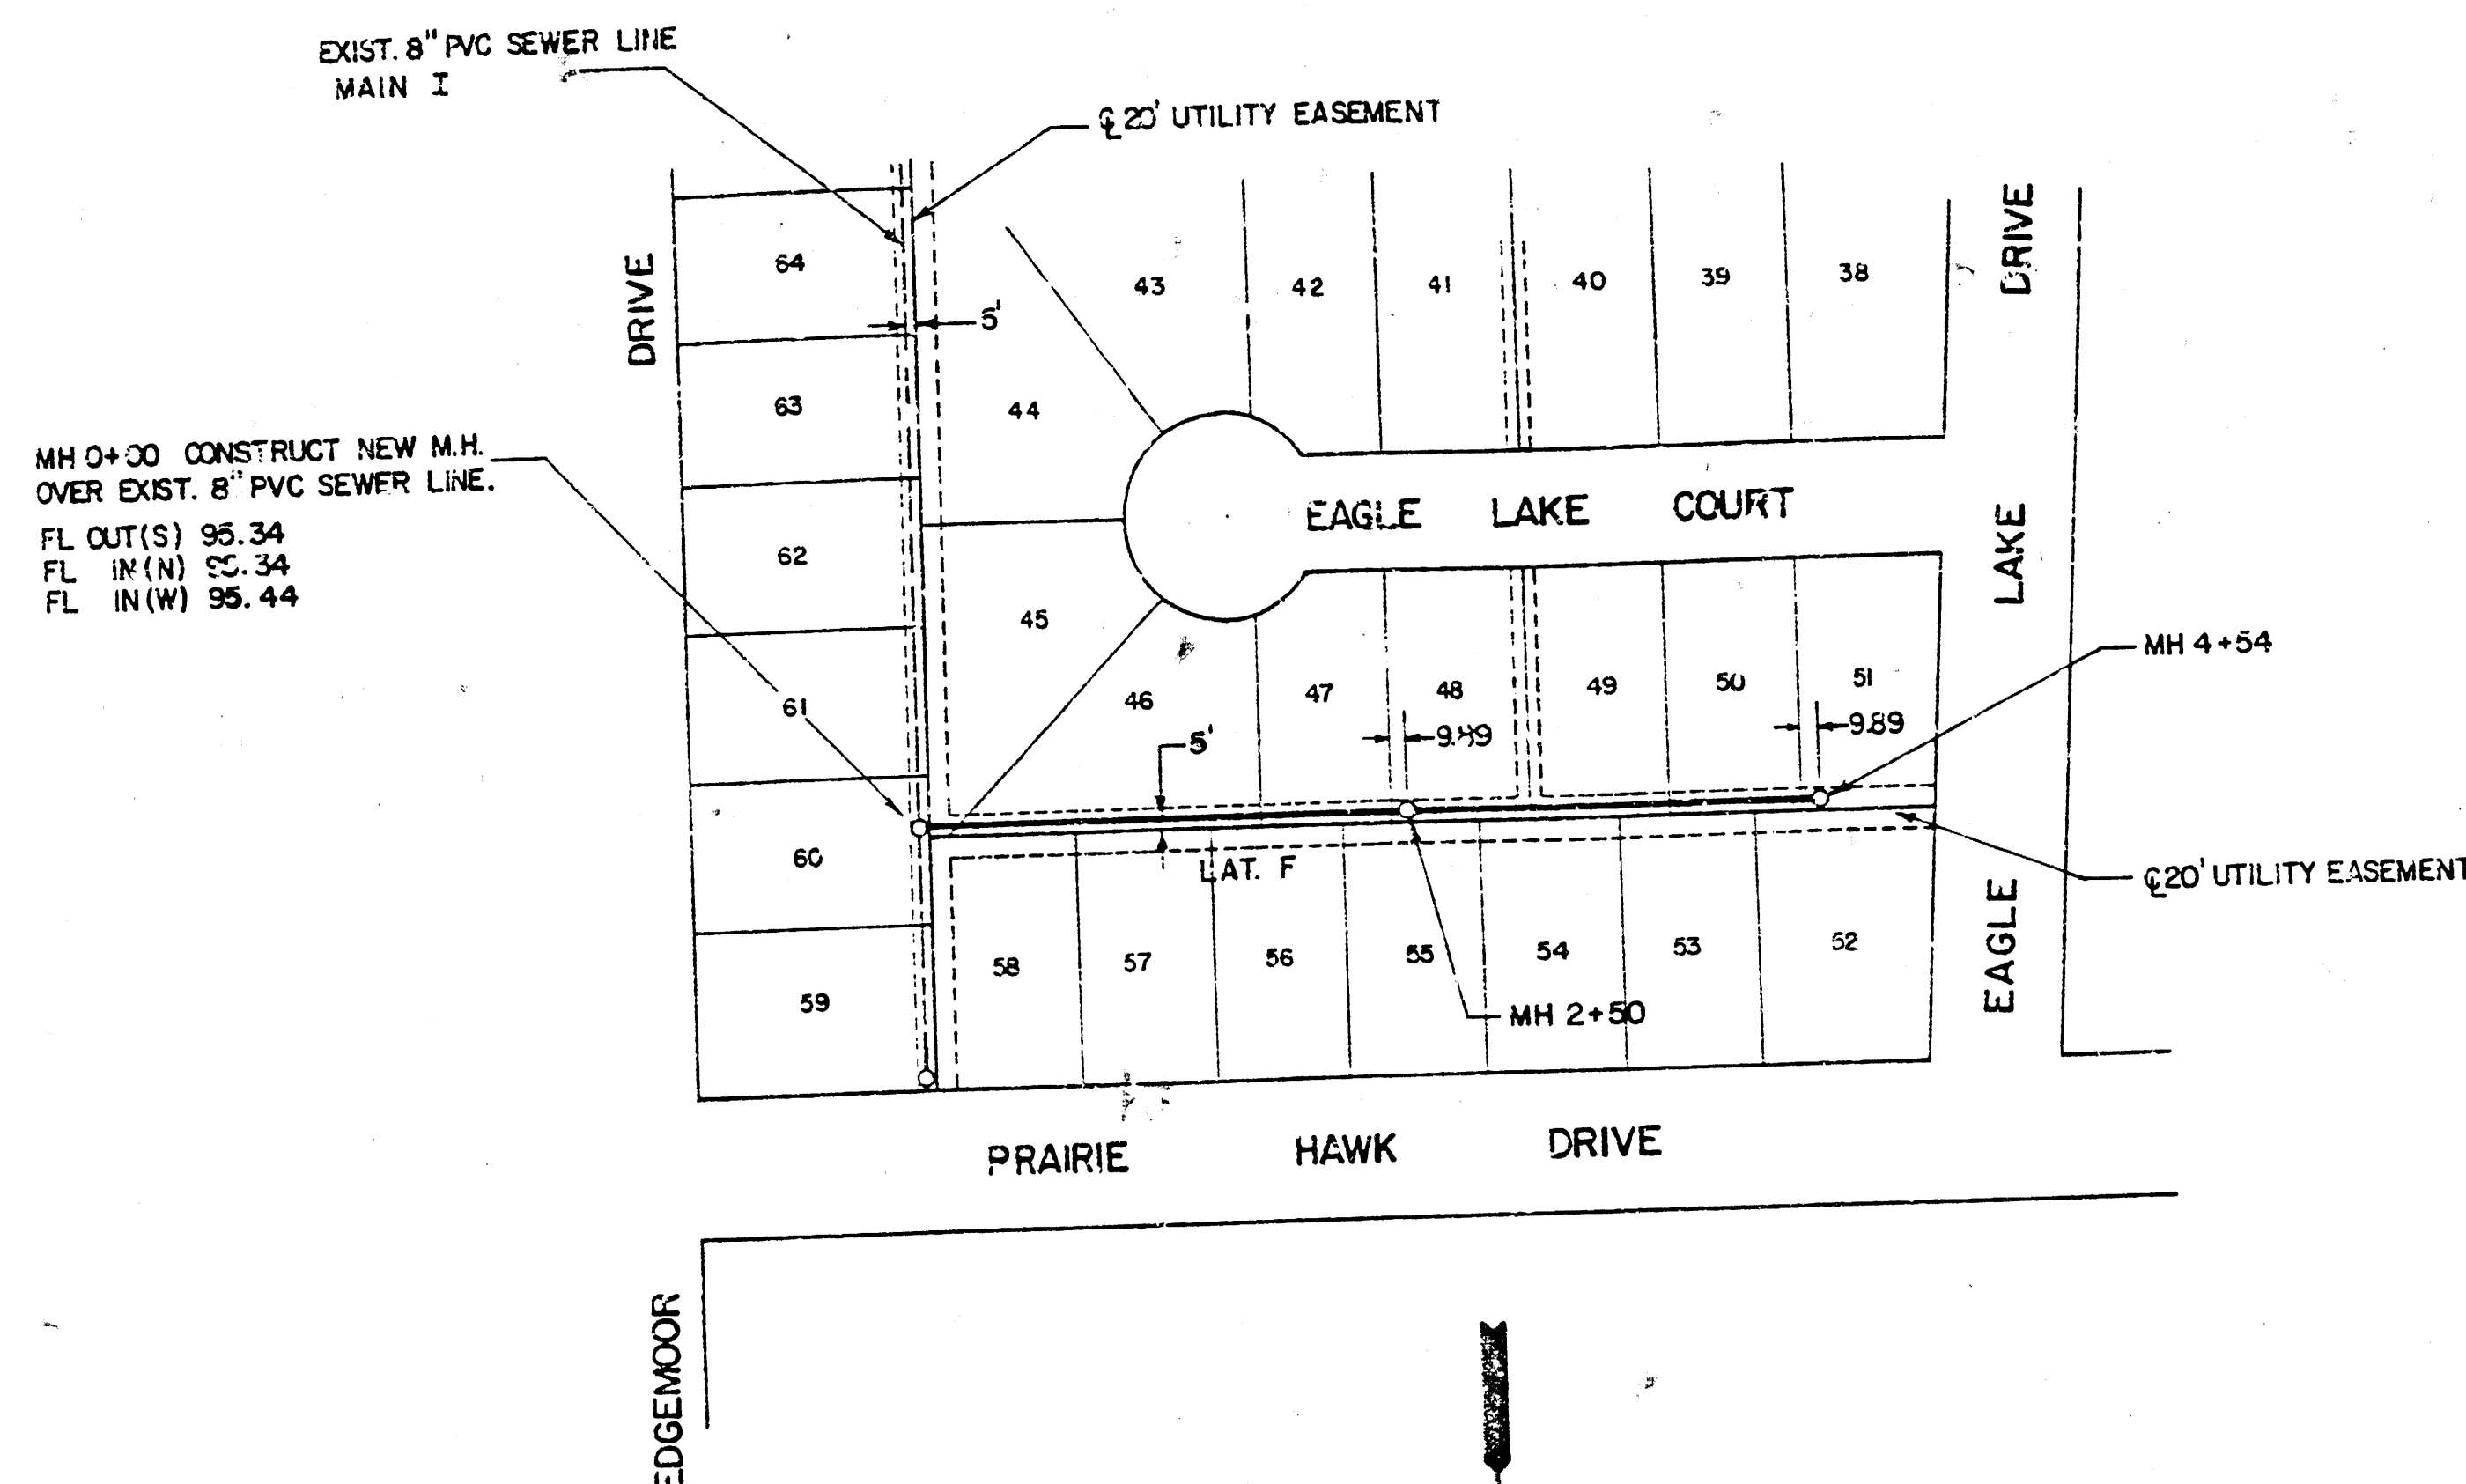

SCALE
PLAN 1"=100'
PROFILE 1"=50'
HORIZ 1"=50'
VERT. 1"=5'

ALL PIPE IS 8" PVC

ALL MANHOLES ARE TYPE "C"

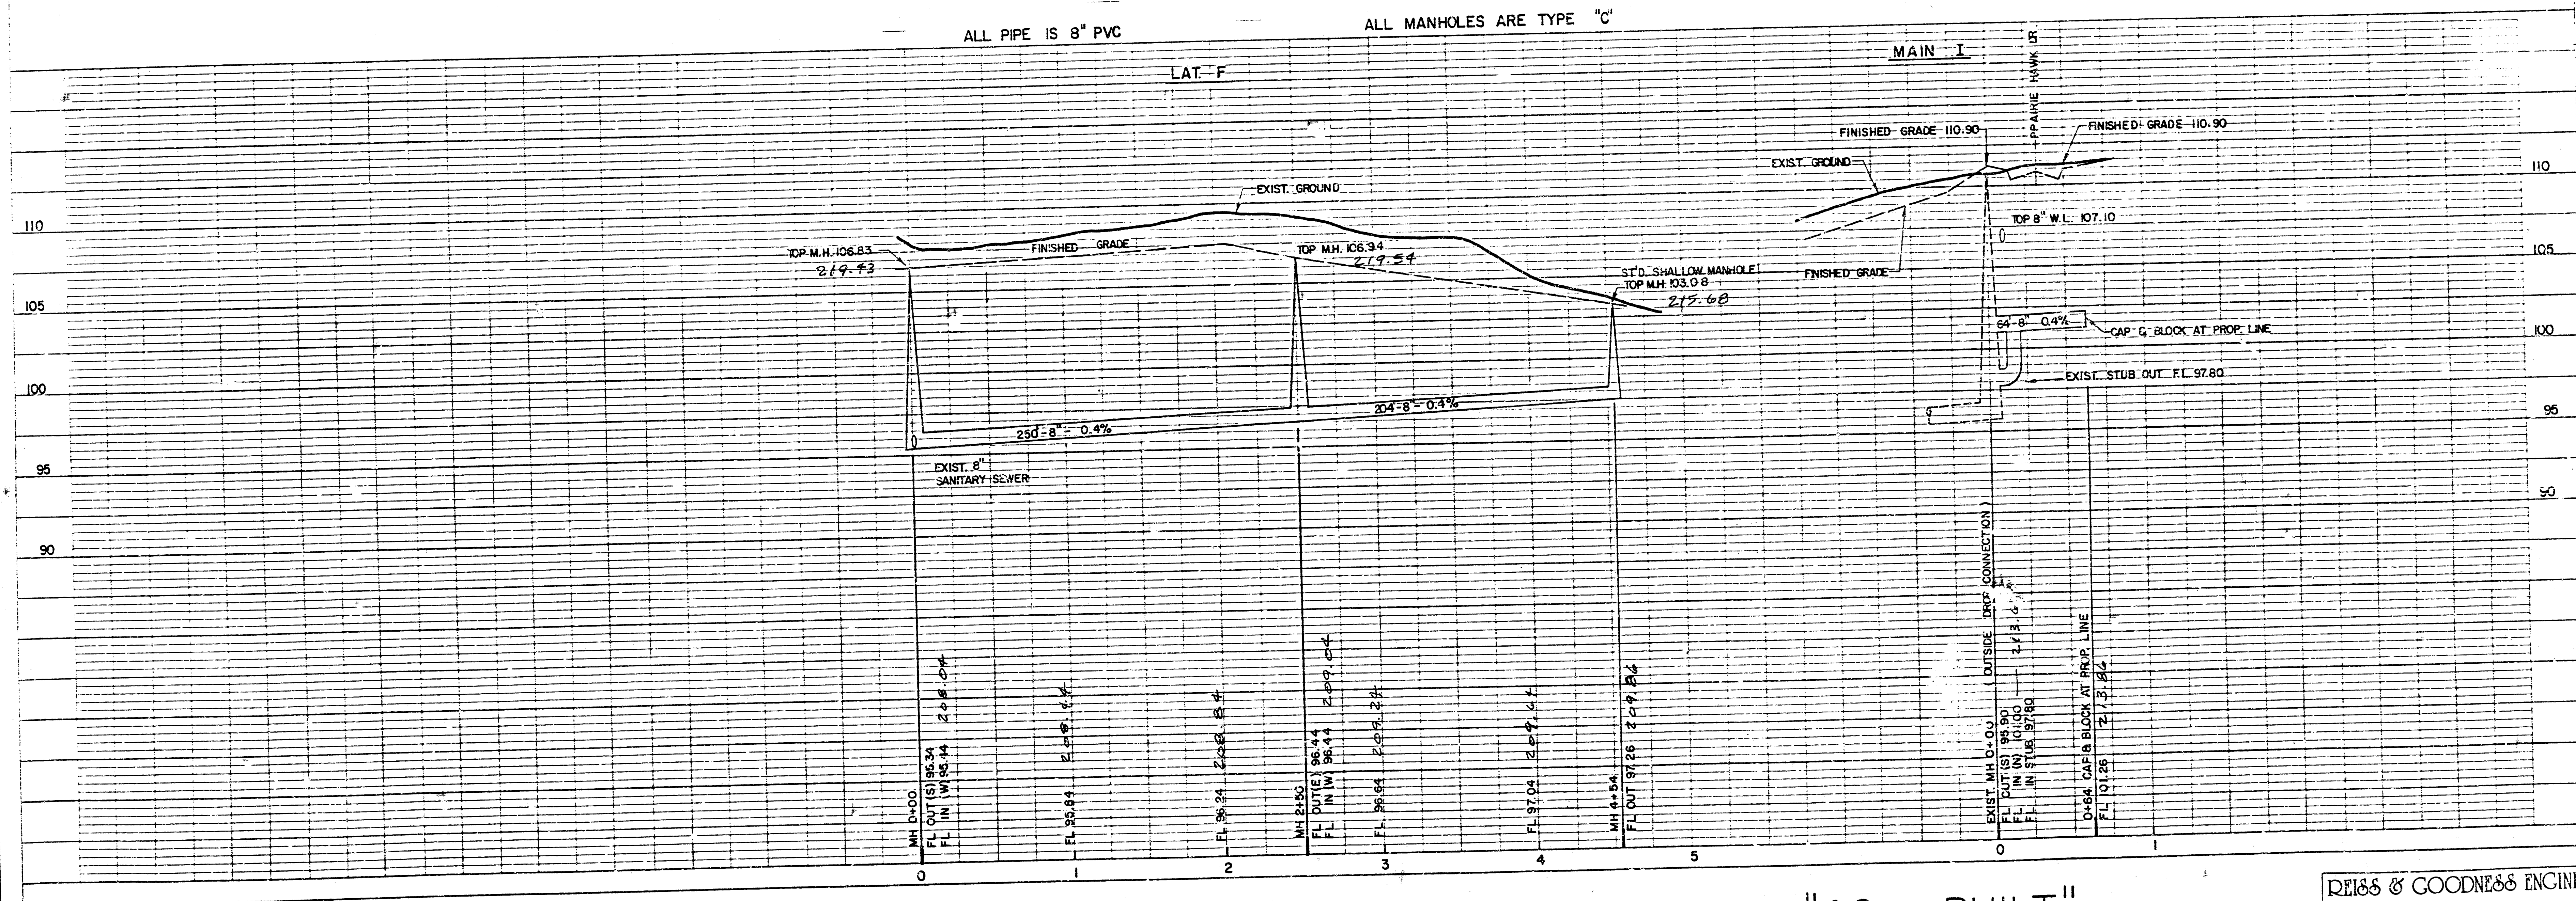

"AS BUILT"

REISS & GOODNESS ENGINEERS
2160 WEST 21ST STREET
WICHITA, KANSAS 67203
(316) 832-0253

REVISION	DRAWN BY	CHECKED BY	DESIGNED BY	PROJECT	CUSTOMER	SCALE GIVEN	PROJECT NO.
				SANITARY SEWER EXTENSIONS LAT F & MAIN I	EAGLE LAKE ADDITION-PHASE II-BEL AIRE, KANSAS	DATE 1/24/86	ST 1485

FILMED FROM THE BEST
AVAILABLE COPY