


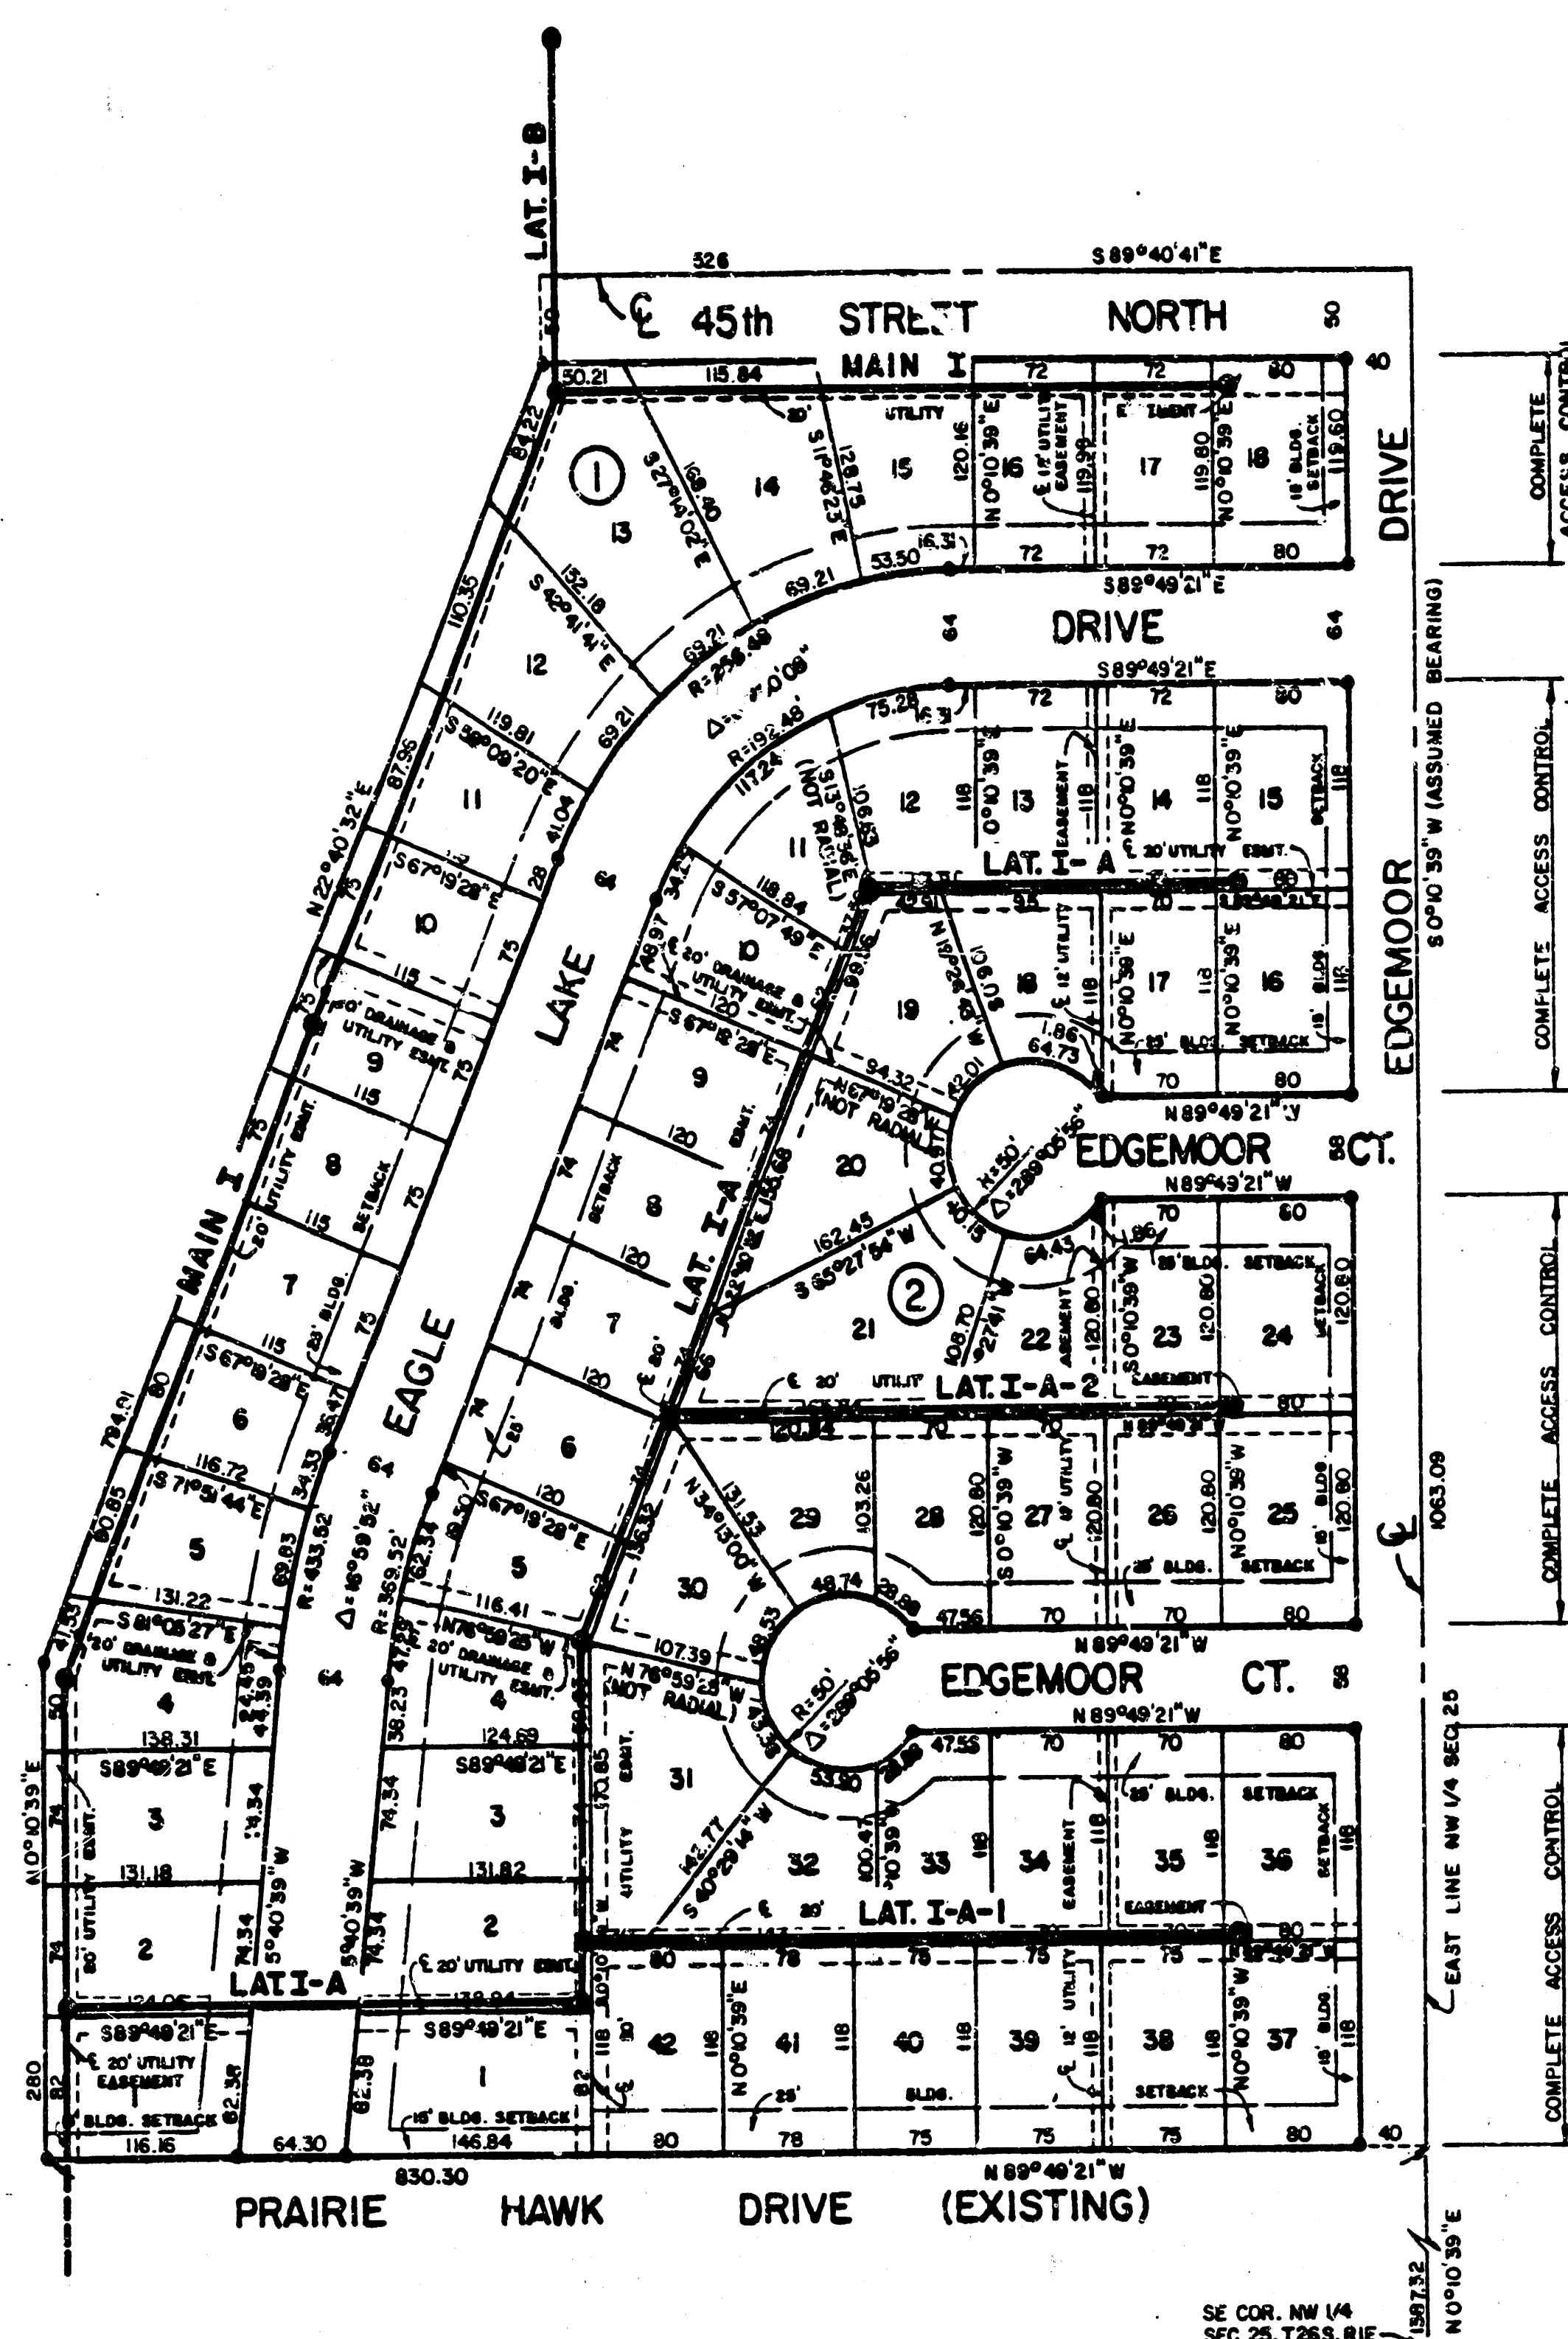

PLANS FOR
SANITARY SEWER EXTENSIONS
 TO
EAGLE LAKE 2ND ADDITION
 BEL AIRE, SEDGWICK COUNTY
 1987
 SE 0787

CITY OF WICHITA PROJECT NO. 468-76-245-80001-000-000-134

APPROVED AS NOTED
 By CITY ENGINEER OF WICHITA
 Sanitary Sewers 9/13/87
 Storm Sewers _____
 Driveway Approaches _____
 Water Mains _____
 Paving _____

NOTE TO CONTRACTOR

This project will be constructed under the supervision of the CITY ENGINEER and conforming to the SPECIFICATIONS of the CITY OF WICHITA. The CONTRACTOR will pay the City of Wichita for all costs of plan review, inspection and booking per contract.

BENCHMARK:
 CITY DISK ON WEST END SOUTH
 HUBBARD BRIDGE APPROX. 200'
 E. OF OLIVER ON 45th ST. NORTH
 ELEV. 1398.88 U.S.G.S.
 FOR CITY DATUM - SUBTRACT 1187.4
 FEET FROM GIVEN BENCHMARK ELEV.

INDEX OF SHEETS

SHEET NO.	DESCRIPTION
1	TITLE SHEET
2	PLAN & PROFILE MAIN I & LAT. I-B
3	PLAN & PROFILE LAT. I-A
4	PLAN & PROFILE LAT. I-A-1 & LAT. I-A-2
5	MANHOLE DETAILS TYPE "C"
6	MANHOLE DETAILS TYPE "D"
7	MANHOLE DETAILS TYPE "P"
8	MANHOLE DETAILS RING & COVER




Booked


AS CONSTRUCTED

REISS & GOODNESS ENGINEERS
 2160 WEST 21ST STREET
 WICHITA, KANSAS 67203
 (316) 832-0203

REVISION	DRAWN BY	CHECKED BY	DESIGNED BY	PROJECT	CUSTOMER	SCALE	PROJECT NO.
3/29/87						DATE 9/9/87	SHEET 1 OF 2


FILMED FROM THE BEST AVAILABLE COPY

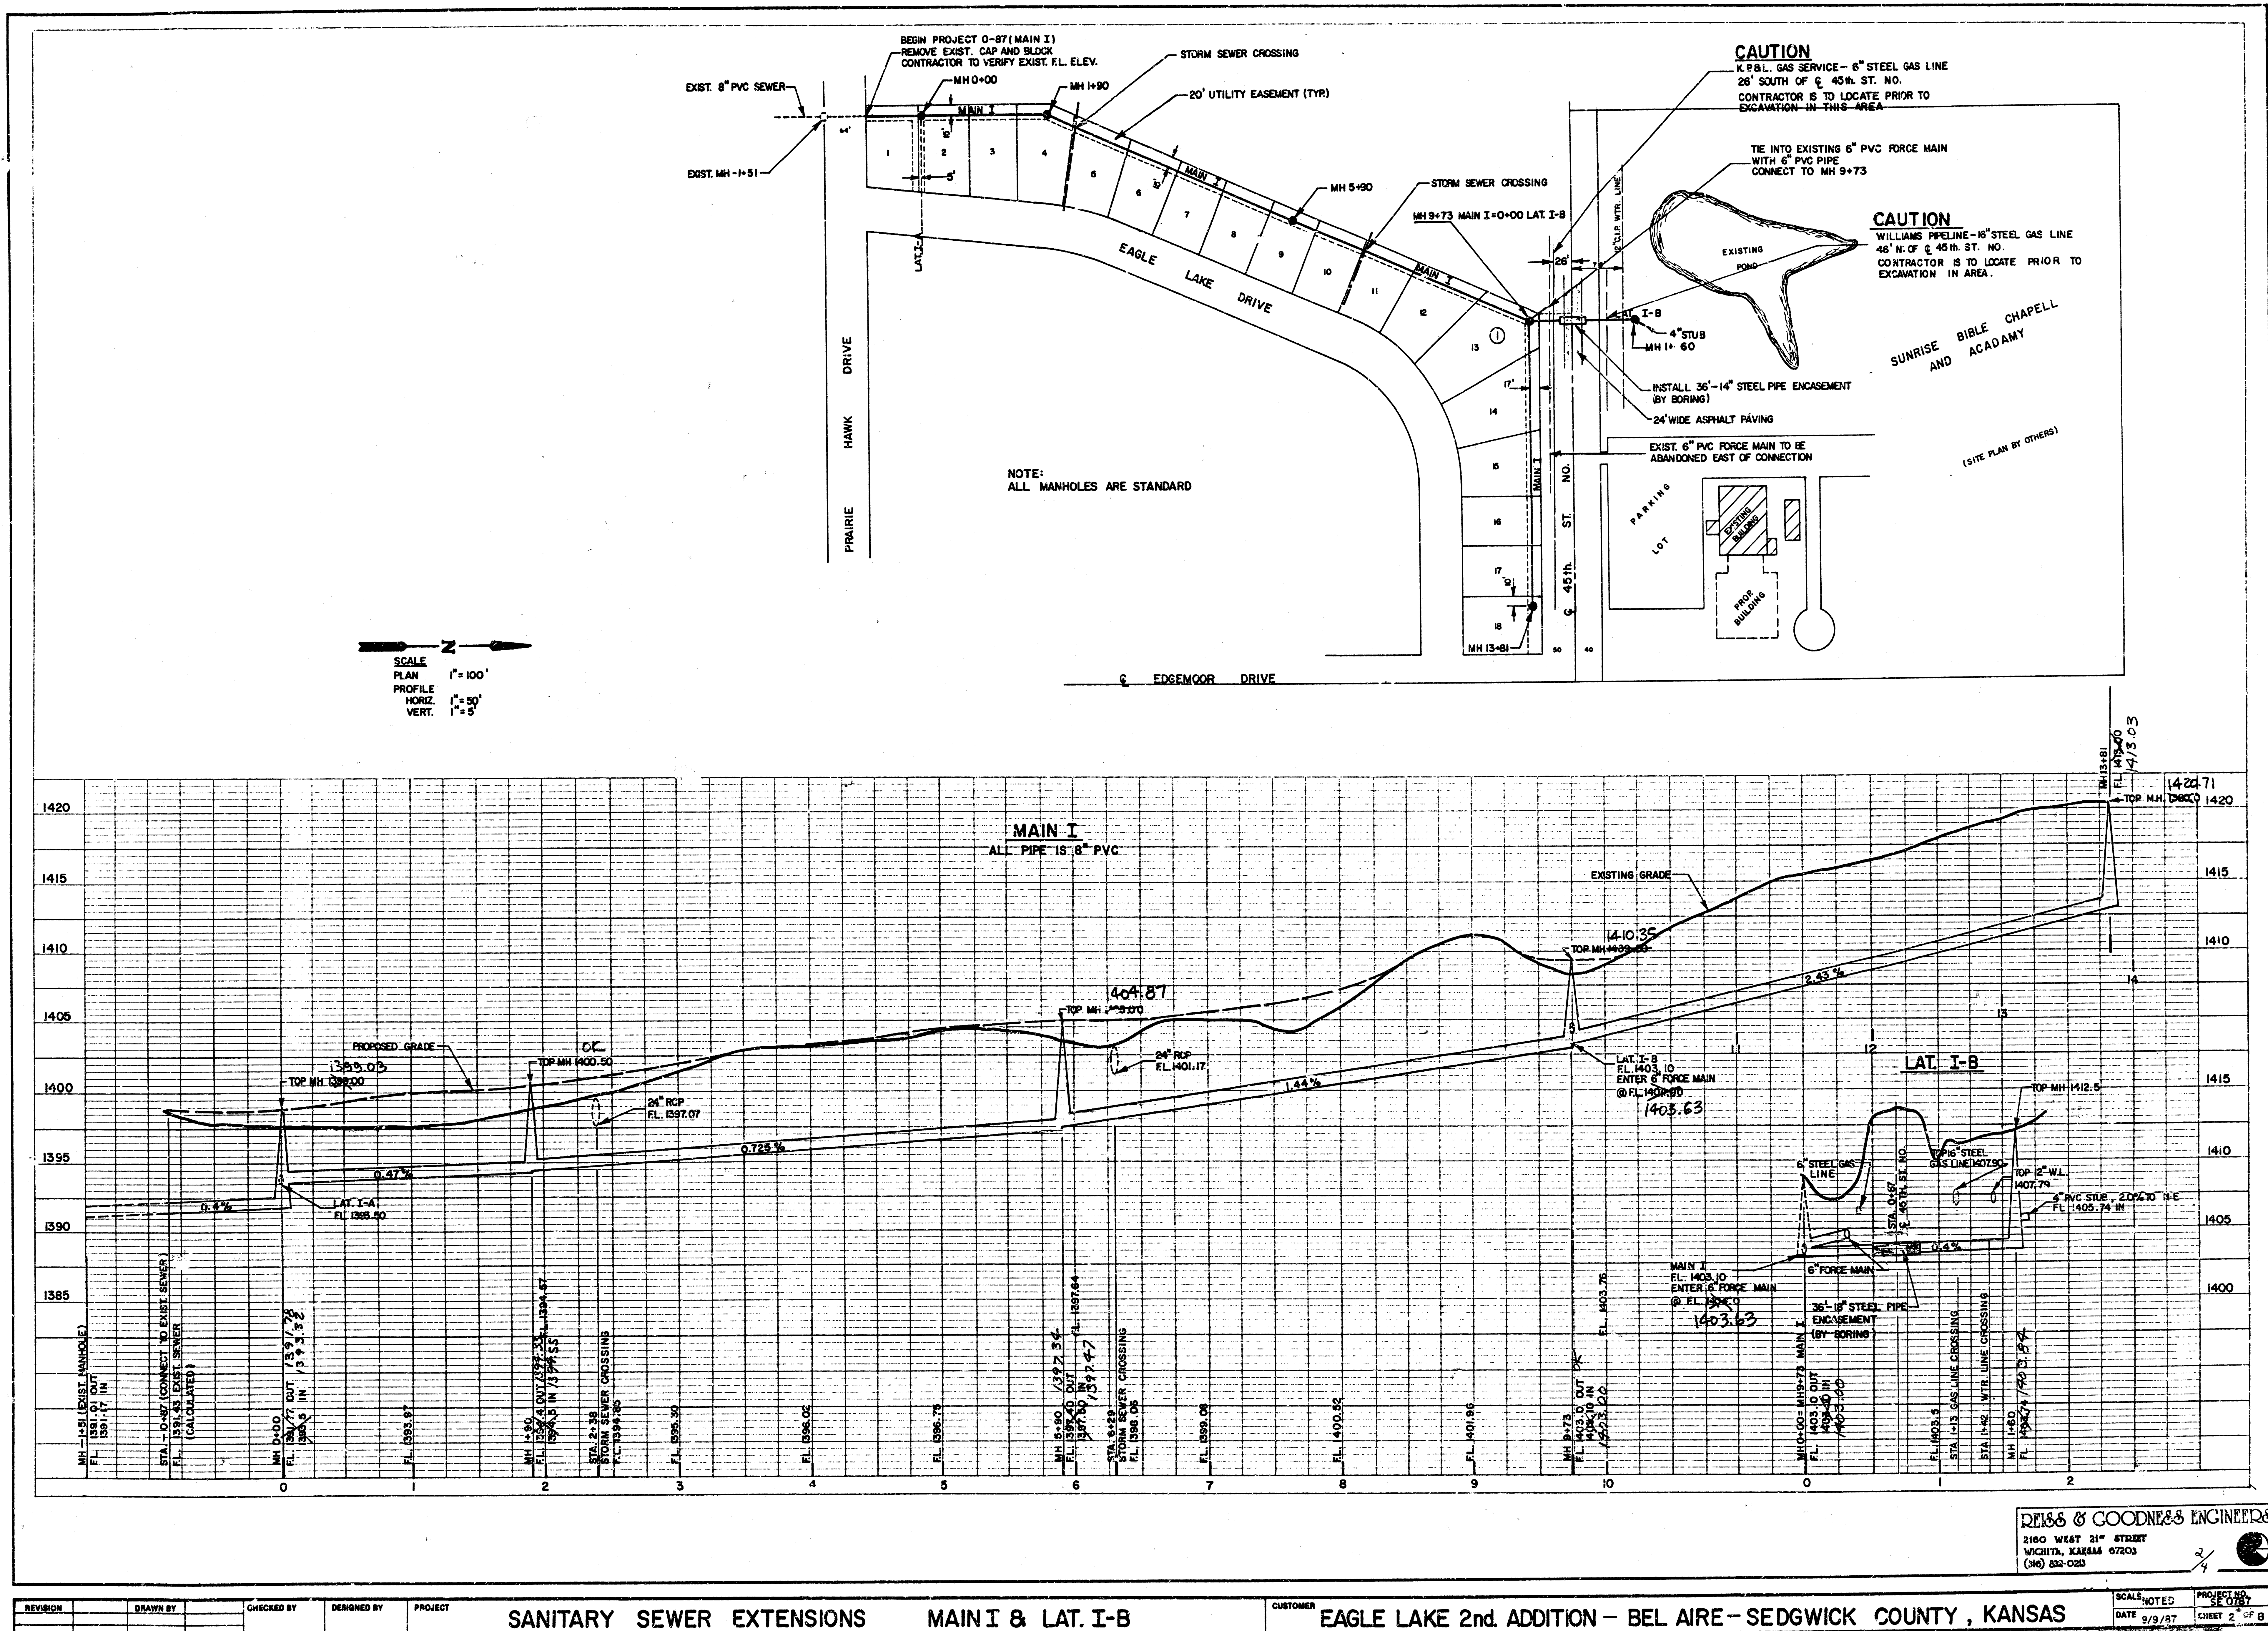

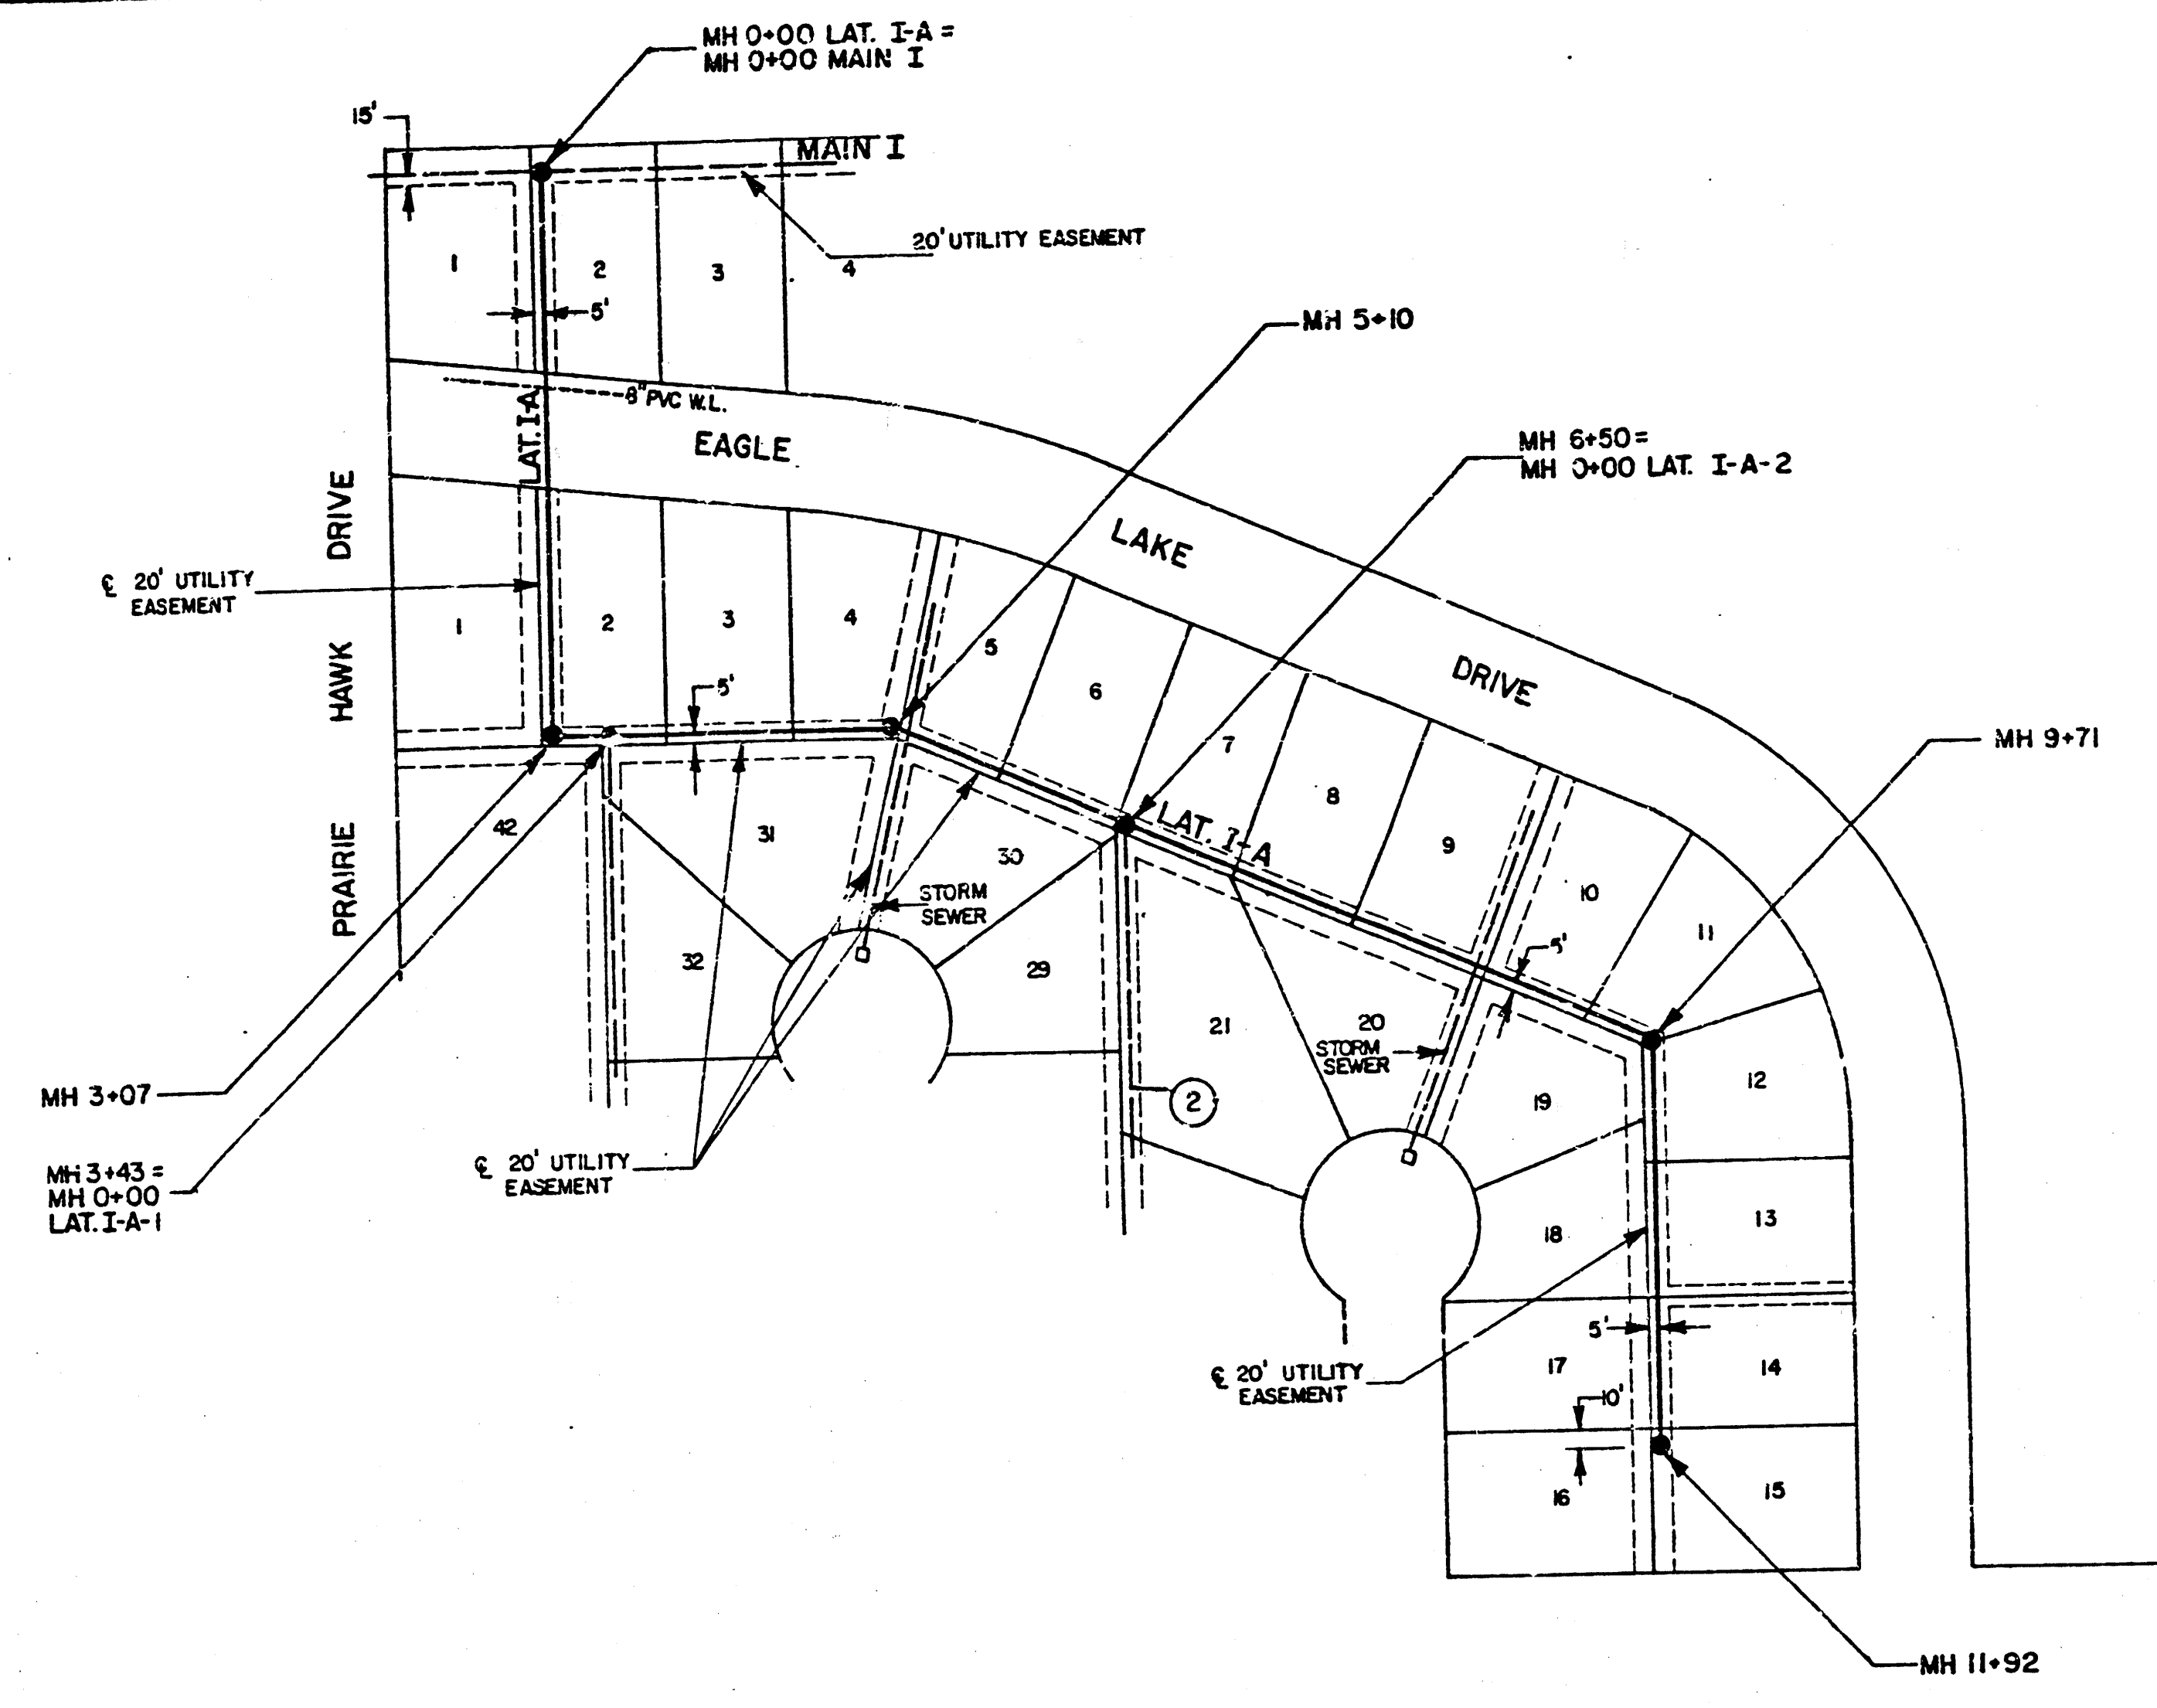

NOTE:
ALL MANHOLES ARE STANDARD


SCALE
PLAN 1" = 100'
PROFILE 1" = 50'
HORIZ. 1" = 50'
VERT. 1" = 5'

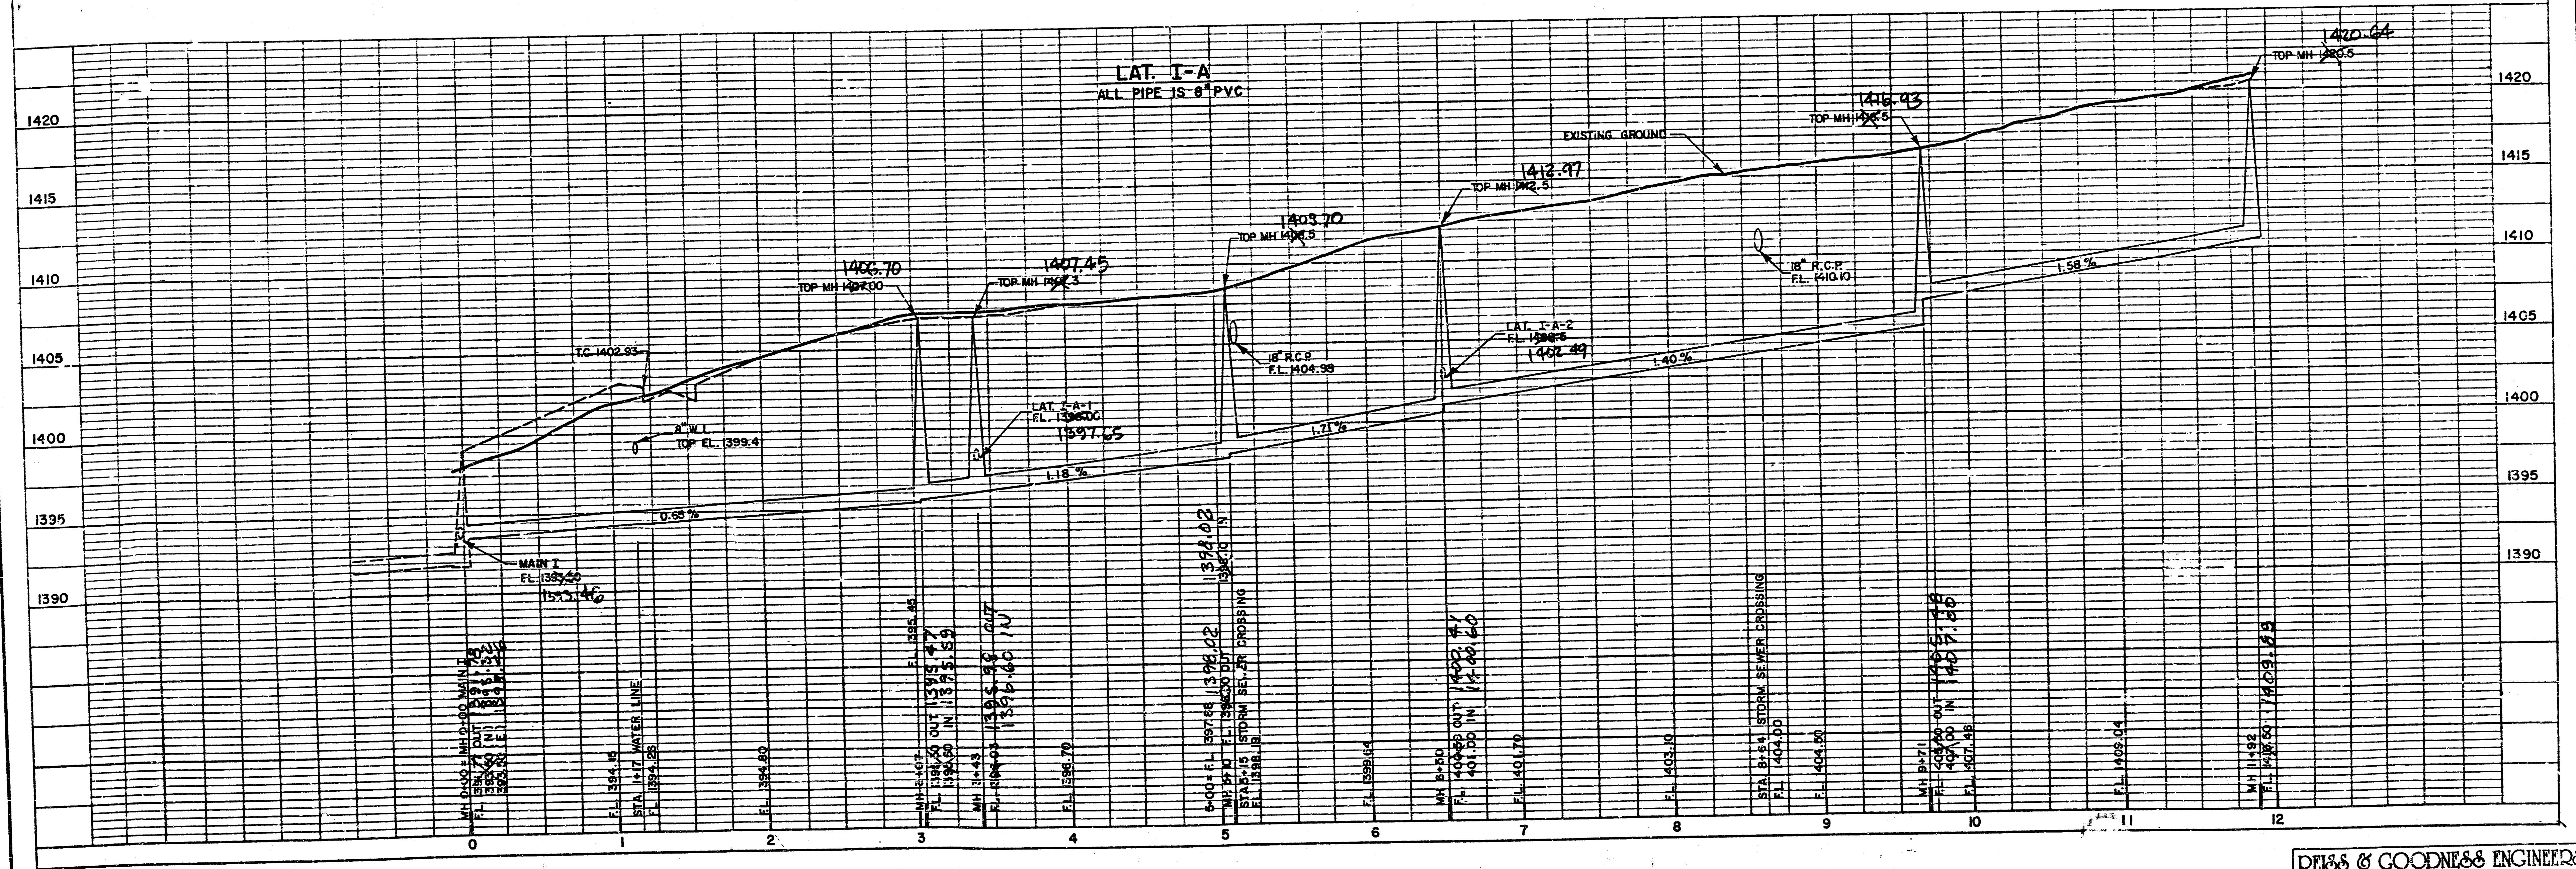

DEISS & GOODNESS ENGINEERS
2160 WEST 21ST STREET
WICHITA, KANSAS 67203
(316) 832-0225


REVISION	DRAWN BY	CHECKED BY	DESIGNED BY	PROJECT	CUSTOMER	SCALE	DATE	PROJECT NO.	SHEET
				SANITARY SEWER EXTENSIONS	EAGLE LAKE 2nd. ADDITION - BEL AIRE - SEDGWICK COUNTY, KANSAS	NOTED	9/9/87	SE 0787	3 OF 3

FILMED FROM THE BEST
AVAILABLE COPY

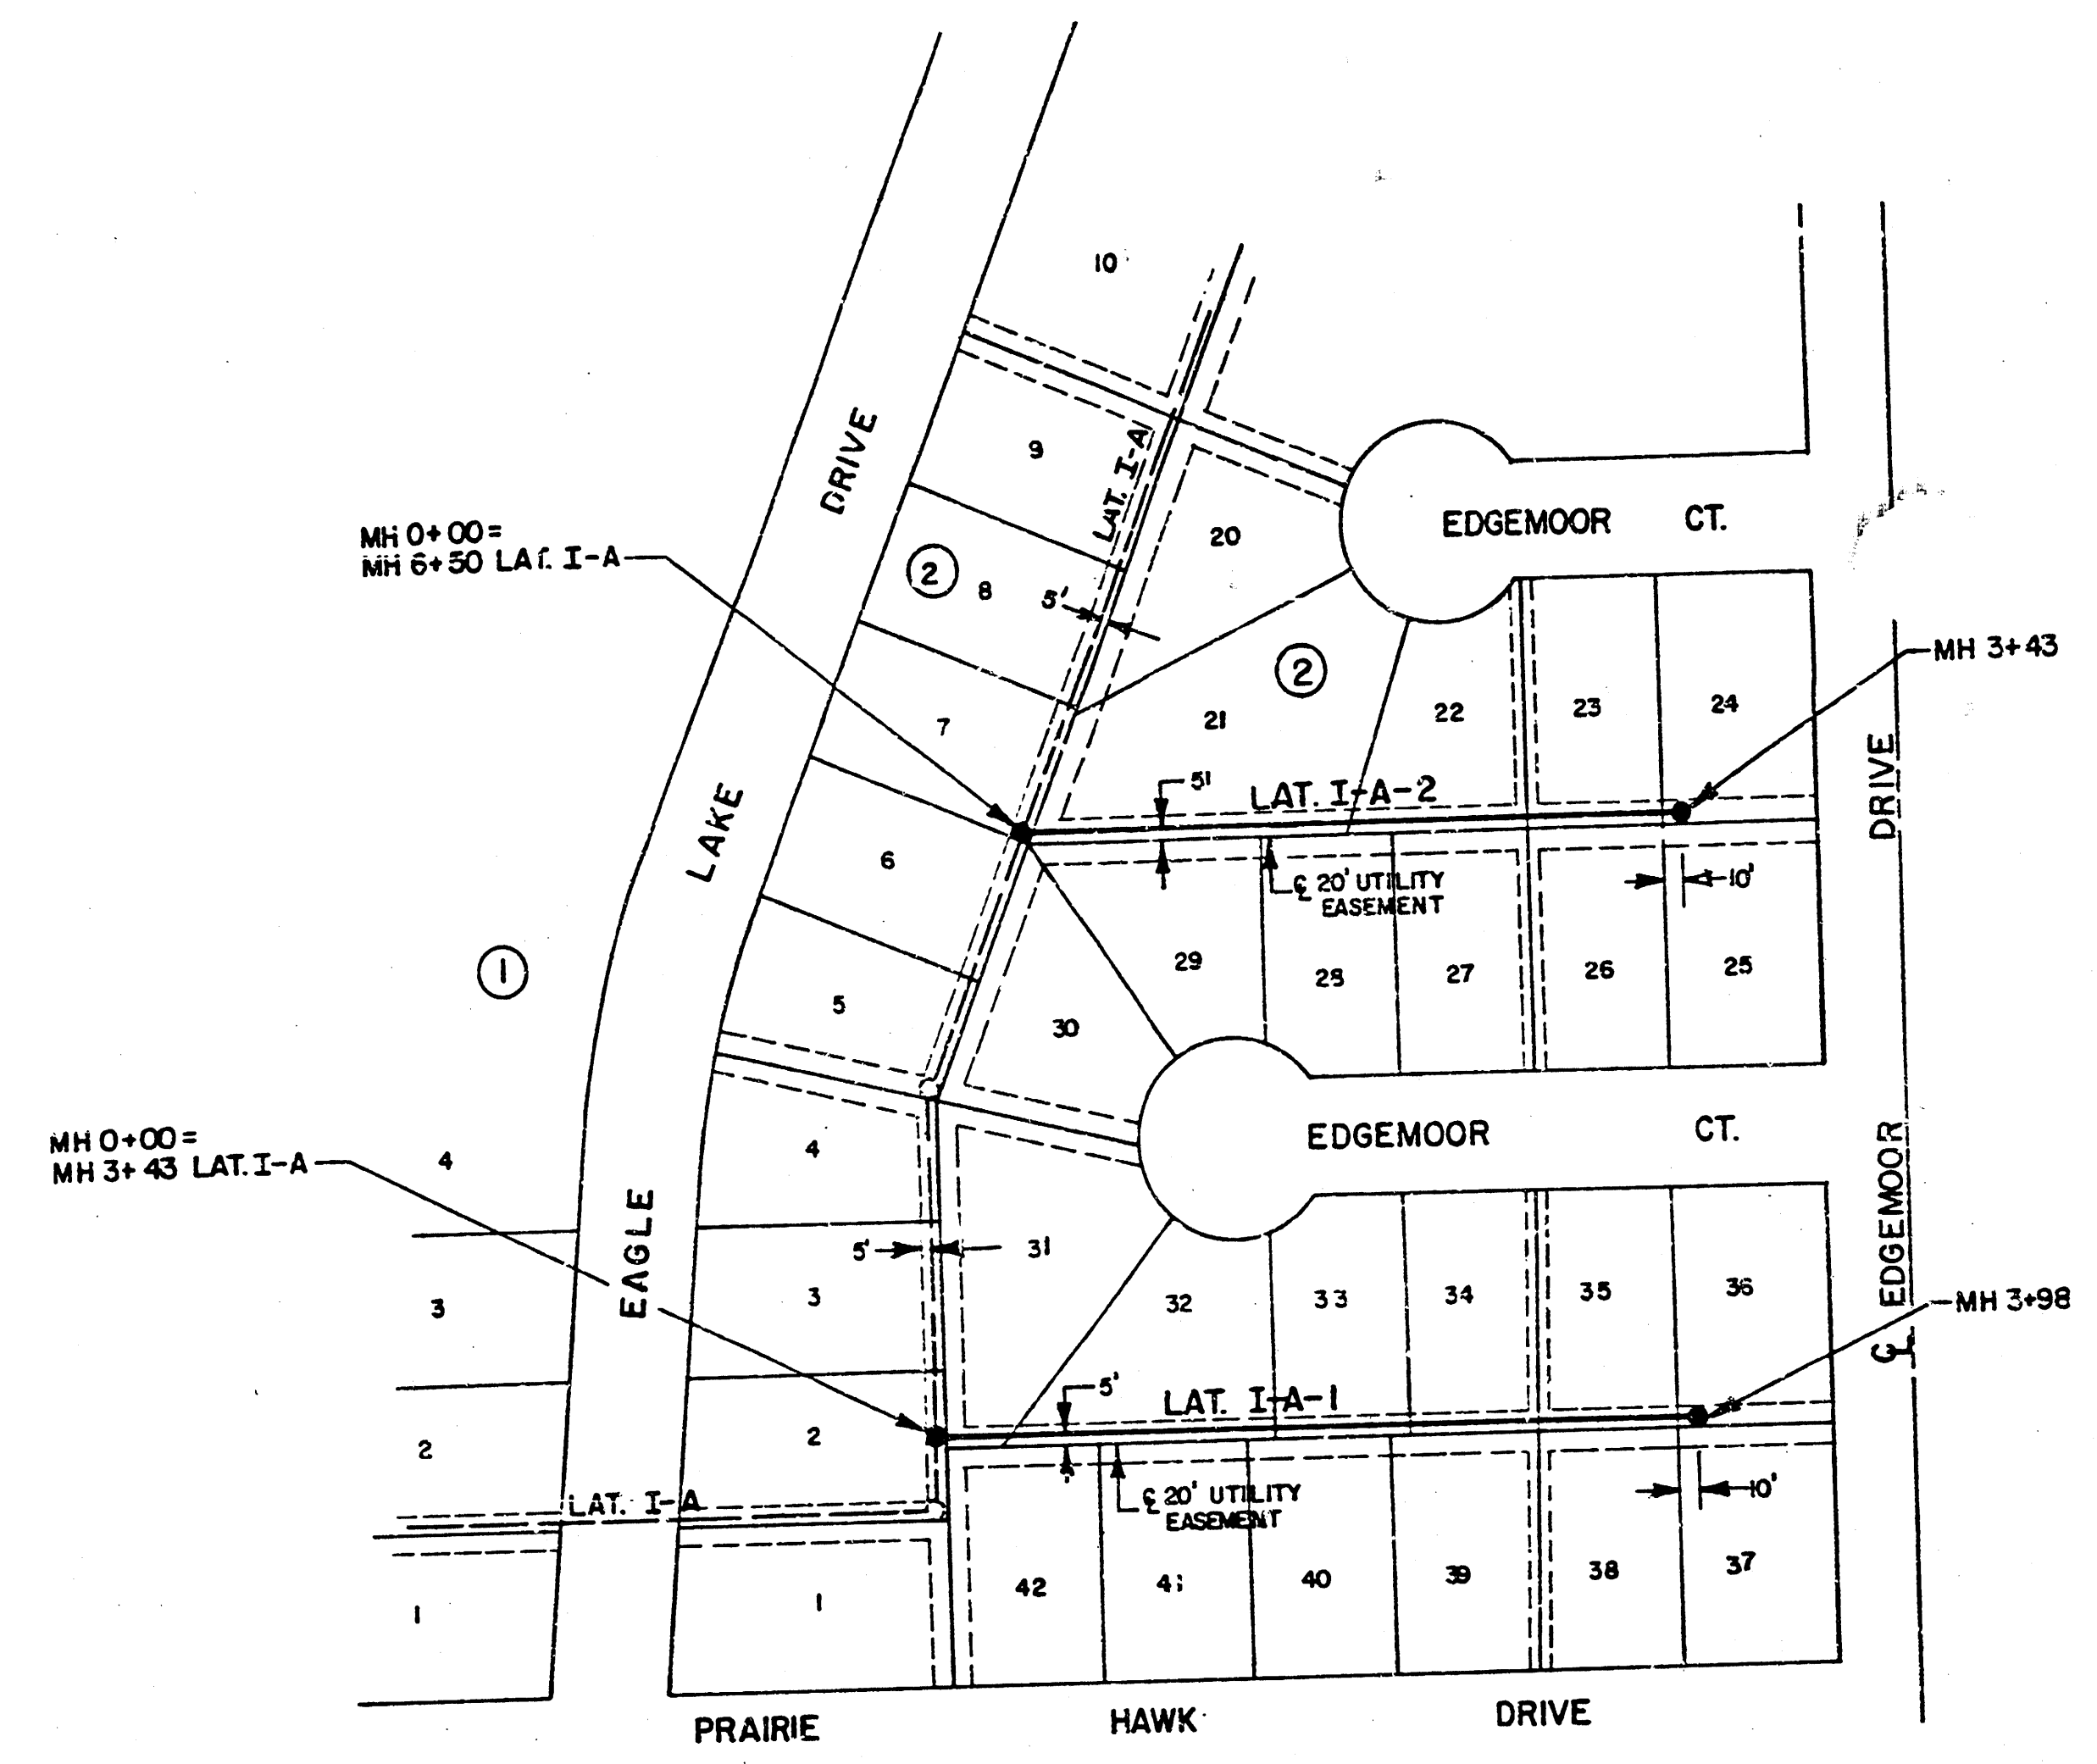

NOTE:
ALL MANHOLES ARE STANDARD

SCALE
PLAN 1"=100'
PROFILE HORIZ. 1"=50'
VERT. 1"=5'

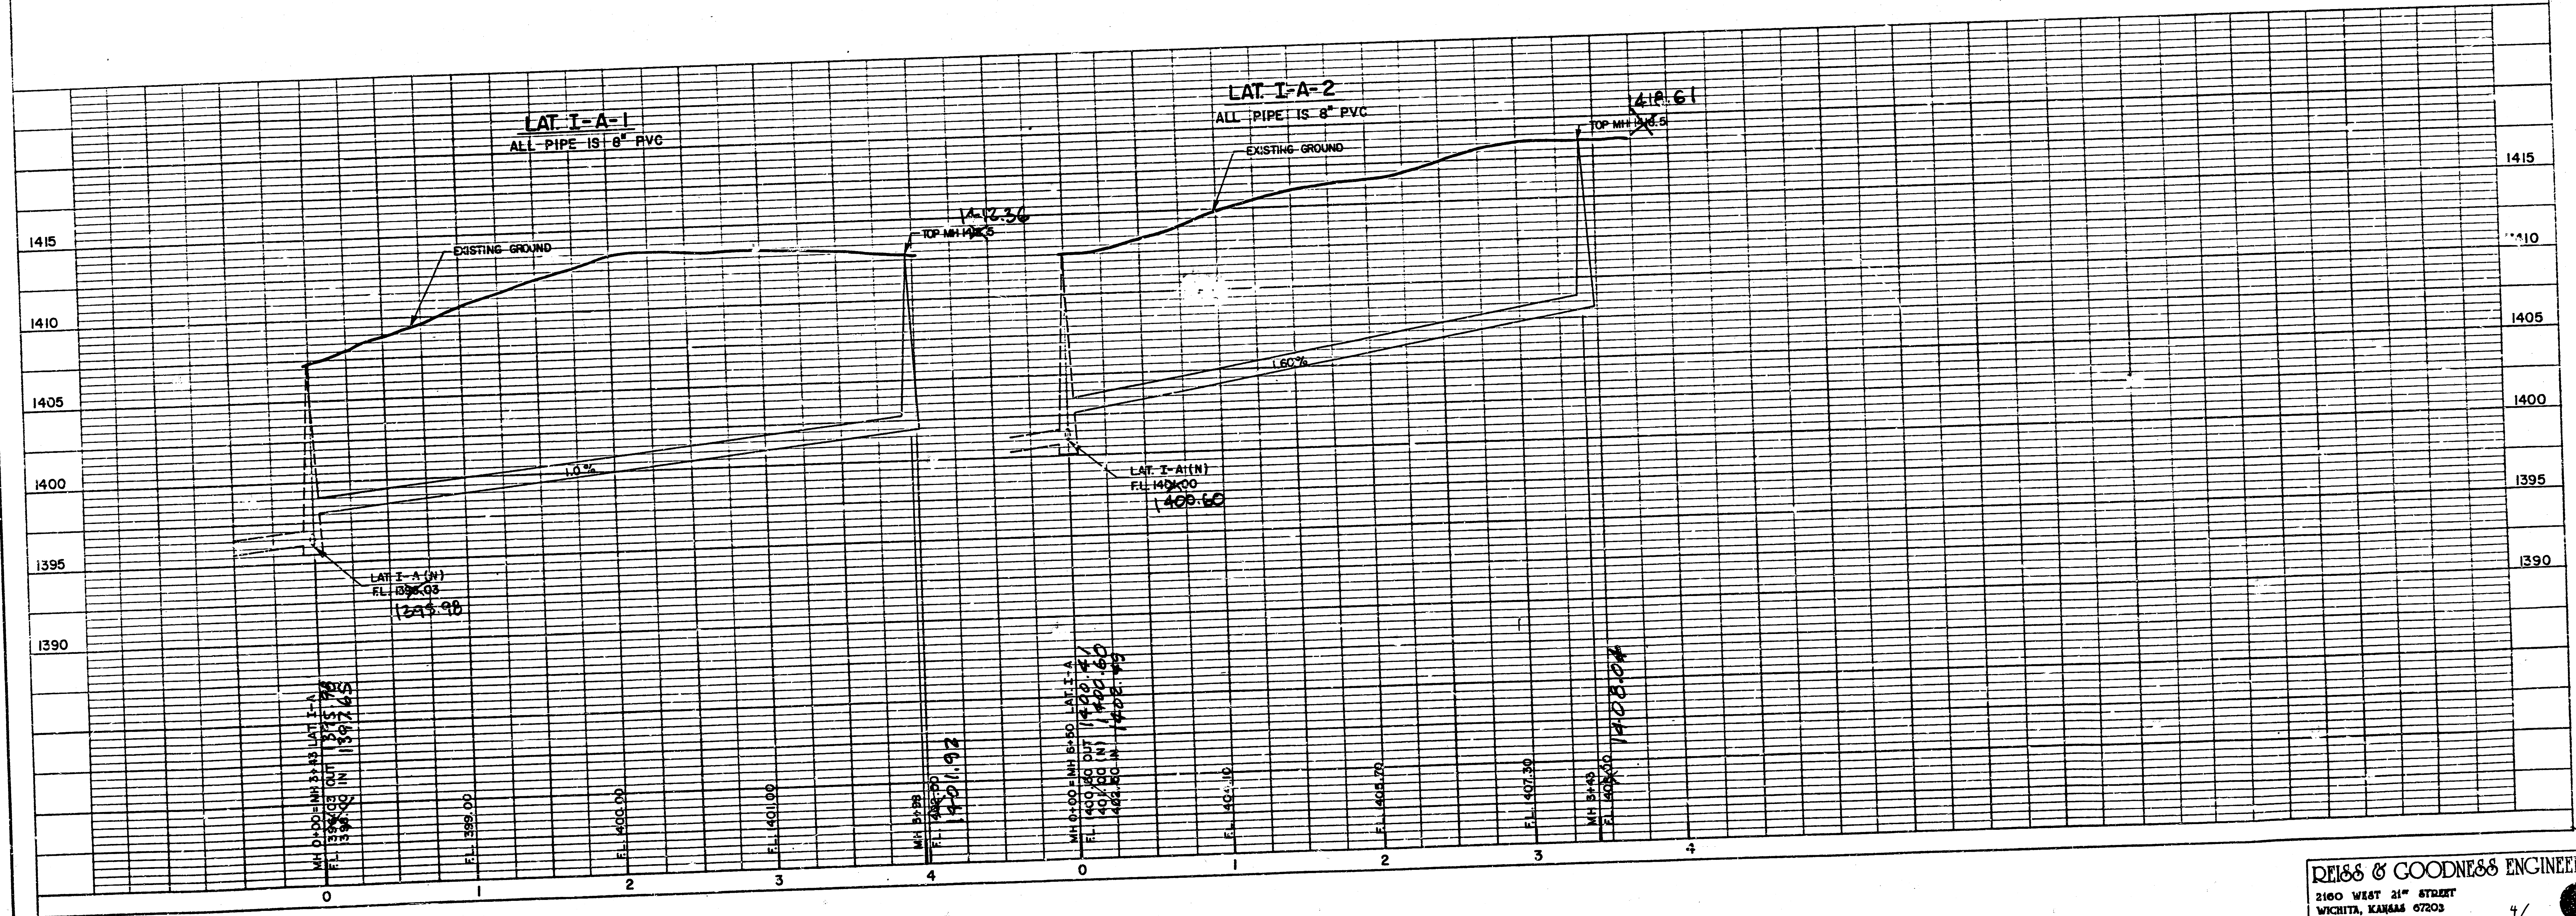

REISS & GOODNESS ENGINEERS
2100 WEST 21ST STREET
WICHITA, KANSAS 67203
(316) 832-0253

REVISION	DRAWN BY	CHECKED BY	DESIGNED BY	PROJECT	CUSTOMER	DATE	SCALE	PROJECT NO.
				SANITARY SEWER EXTENSIONS	EAGLE LAKE 2nd. ADDITION - BEL AIRE - SEDGWICK COUNTY, KANSAS	9/9/87	1"=50'	0787
				LAT. I-A-1 & LAT. I-A-2				SHEET 4 OF 8

FILMED FROM THE BEST
AVAILABLE COPY