

PLANS

SANITARY SEWER SYSTEM

CRESTVIEW COUNTRY CLUB ESTATES

EAST MEADOWS ADDITION

NORTH
POINT

ADD.

EAST

MEADOWS

ADD.

LEGEND


1" = 100' (Horizontal Scale)

1" = 10' (Vertical Scale)

AS RECONSTRUCTED

SANITARY SEWER LINES

CRESTVIEW IMPROVEMENT DISTRICT

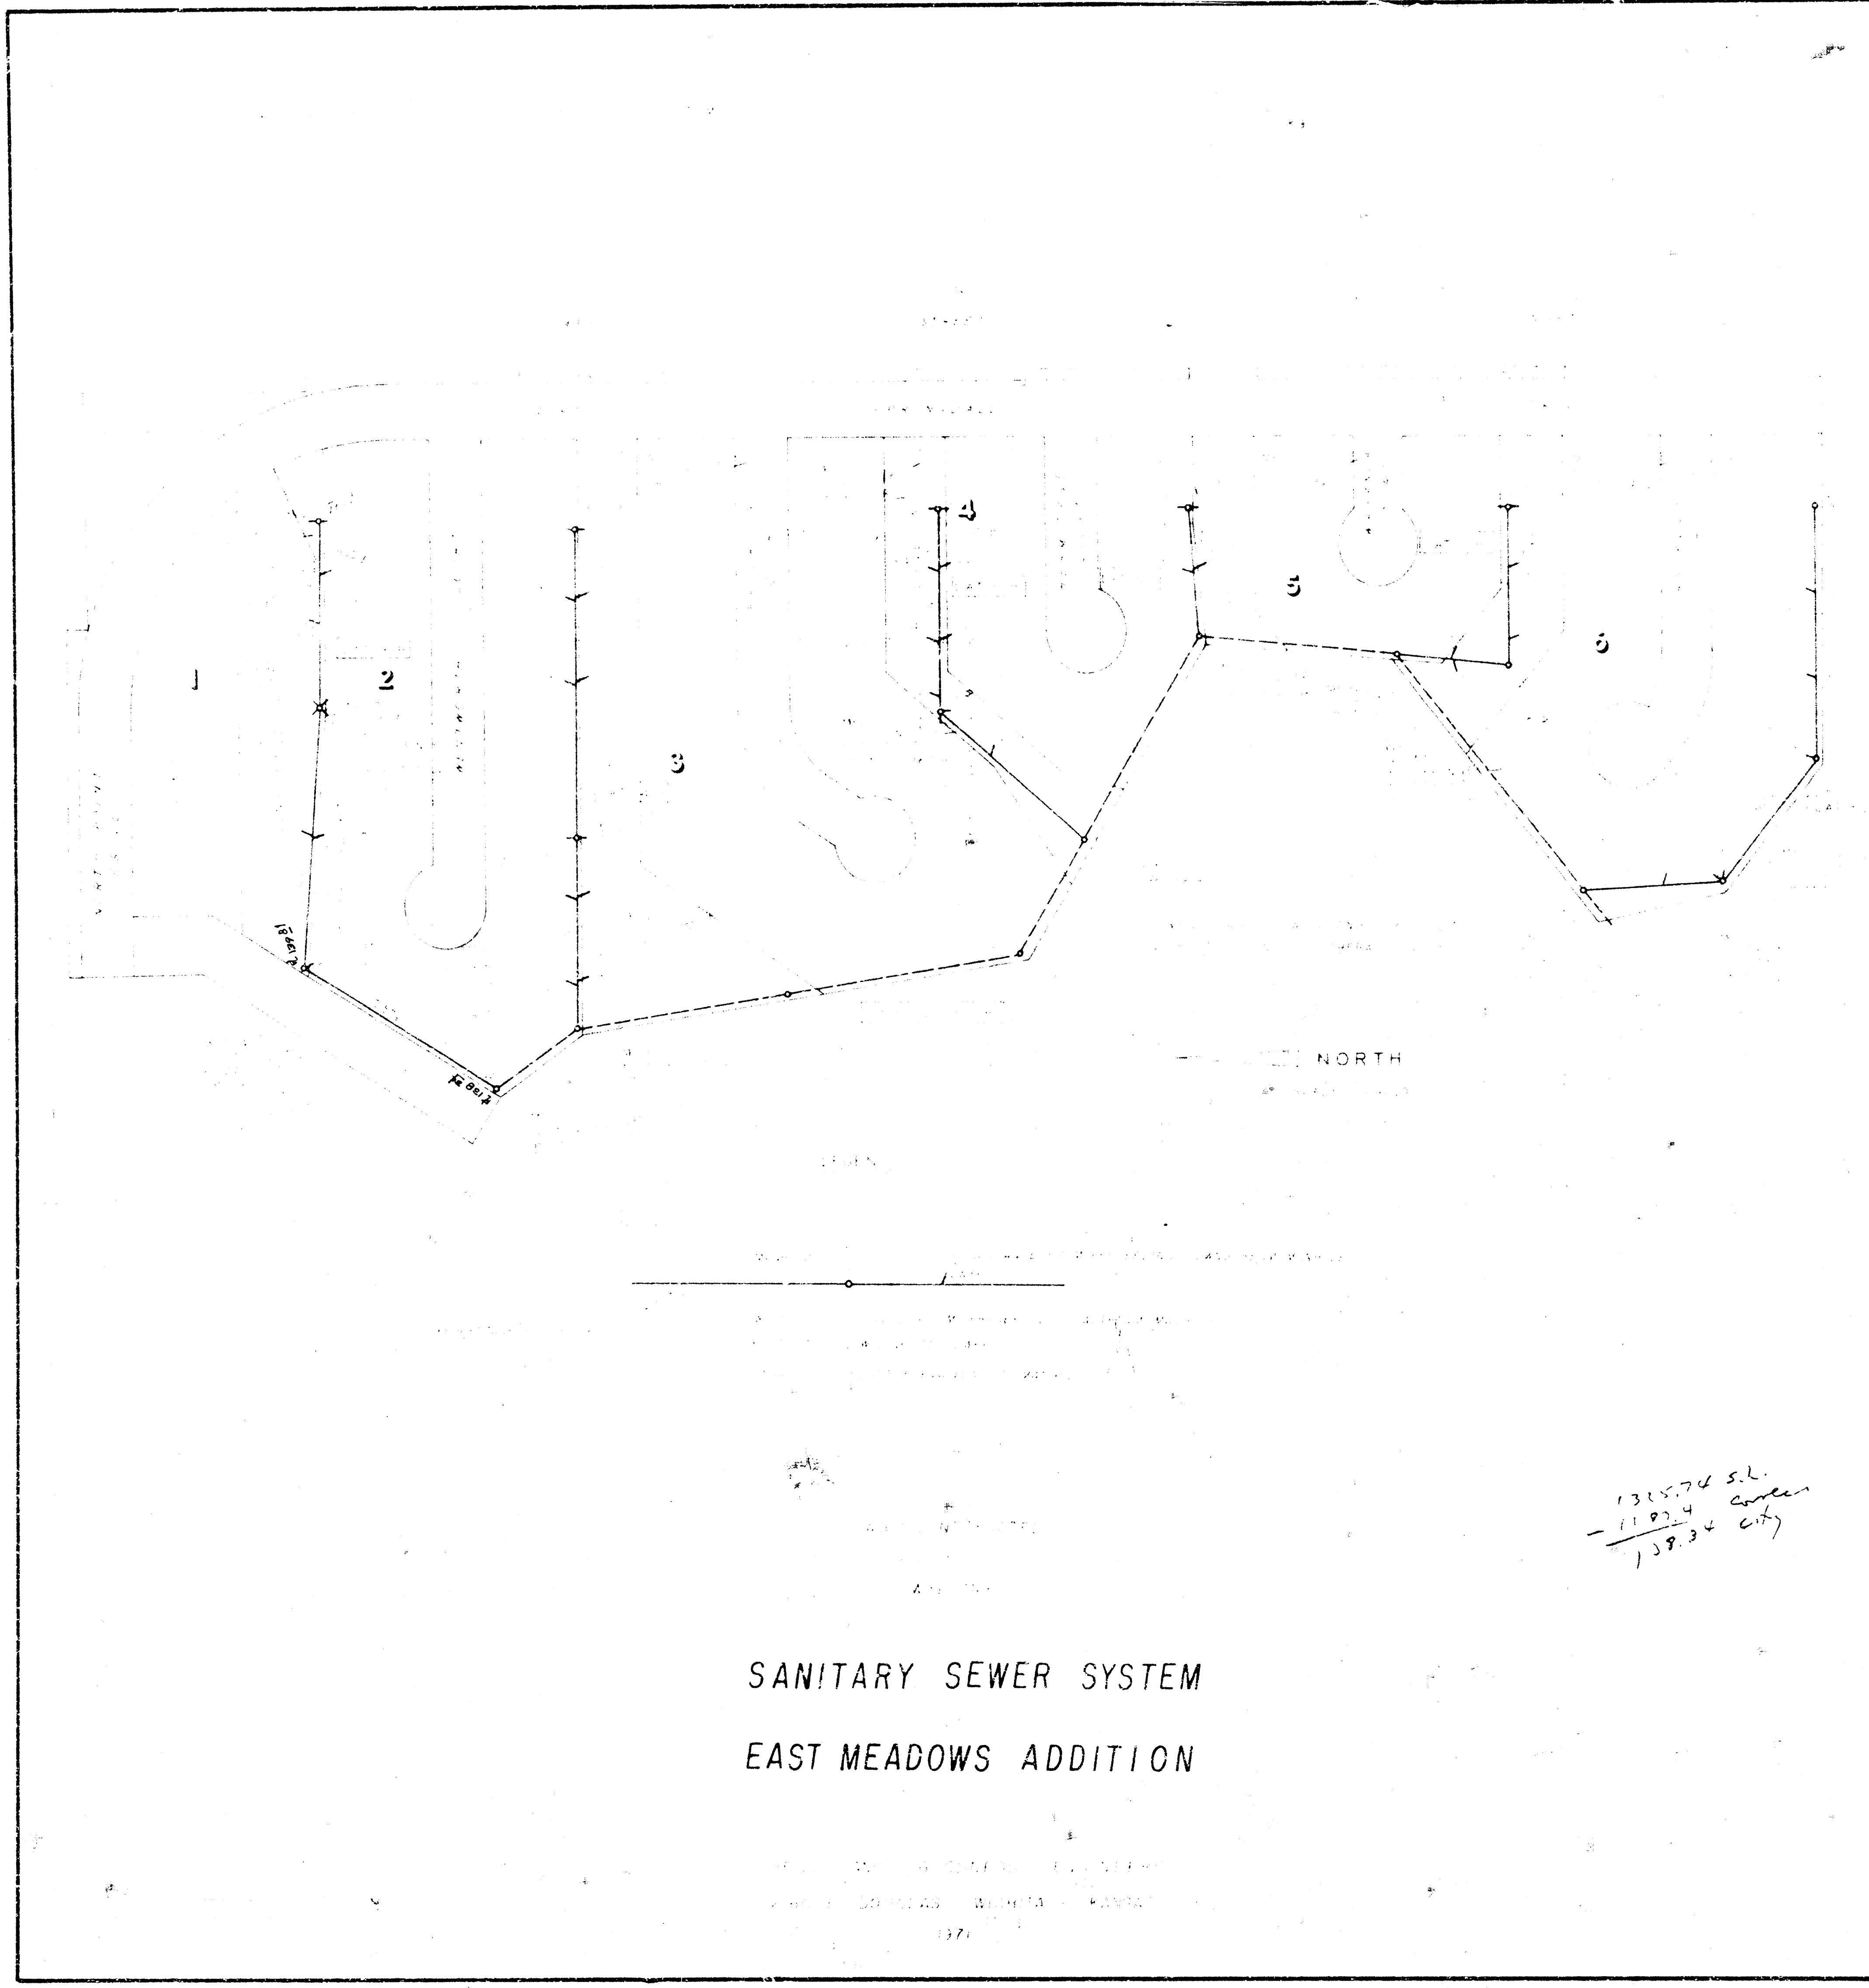

DATE: 11-11-66	DESIGN AND ADDRESS: ENGINEERS	SANITARY SEWER SYSTEM	FIG. NO. 2
	PINE & BOLLAS - RICHITA - PAUSAC	EAST WENDERS ADDITION	OF 5



DATE	NO. OF TESTS	TEST NO.	TEST DATE	TEST TIME	TEST PLACE

