

PLANS

SANITARY SEWER SYSTEM

CRESTVIEW COUNTRY CLUB ESTATES

EAST MEADOWS ADDITION

NORTH
POINT

ADD.

EAST

MEADOWS

ADD.

LEGEND

1" = 100' (AS SHOWN ON MAP)


1" = 100' (AS SHOWN ON MAP)

1" = 100' (AS SHOWN ON MAP)


AS RECONSTRUCTED

SANITARY SEWER LINES



CRESTVIEW IMPROVEMENT DISTRICT

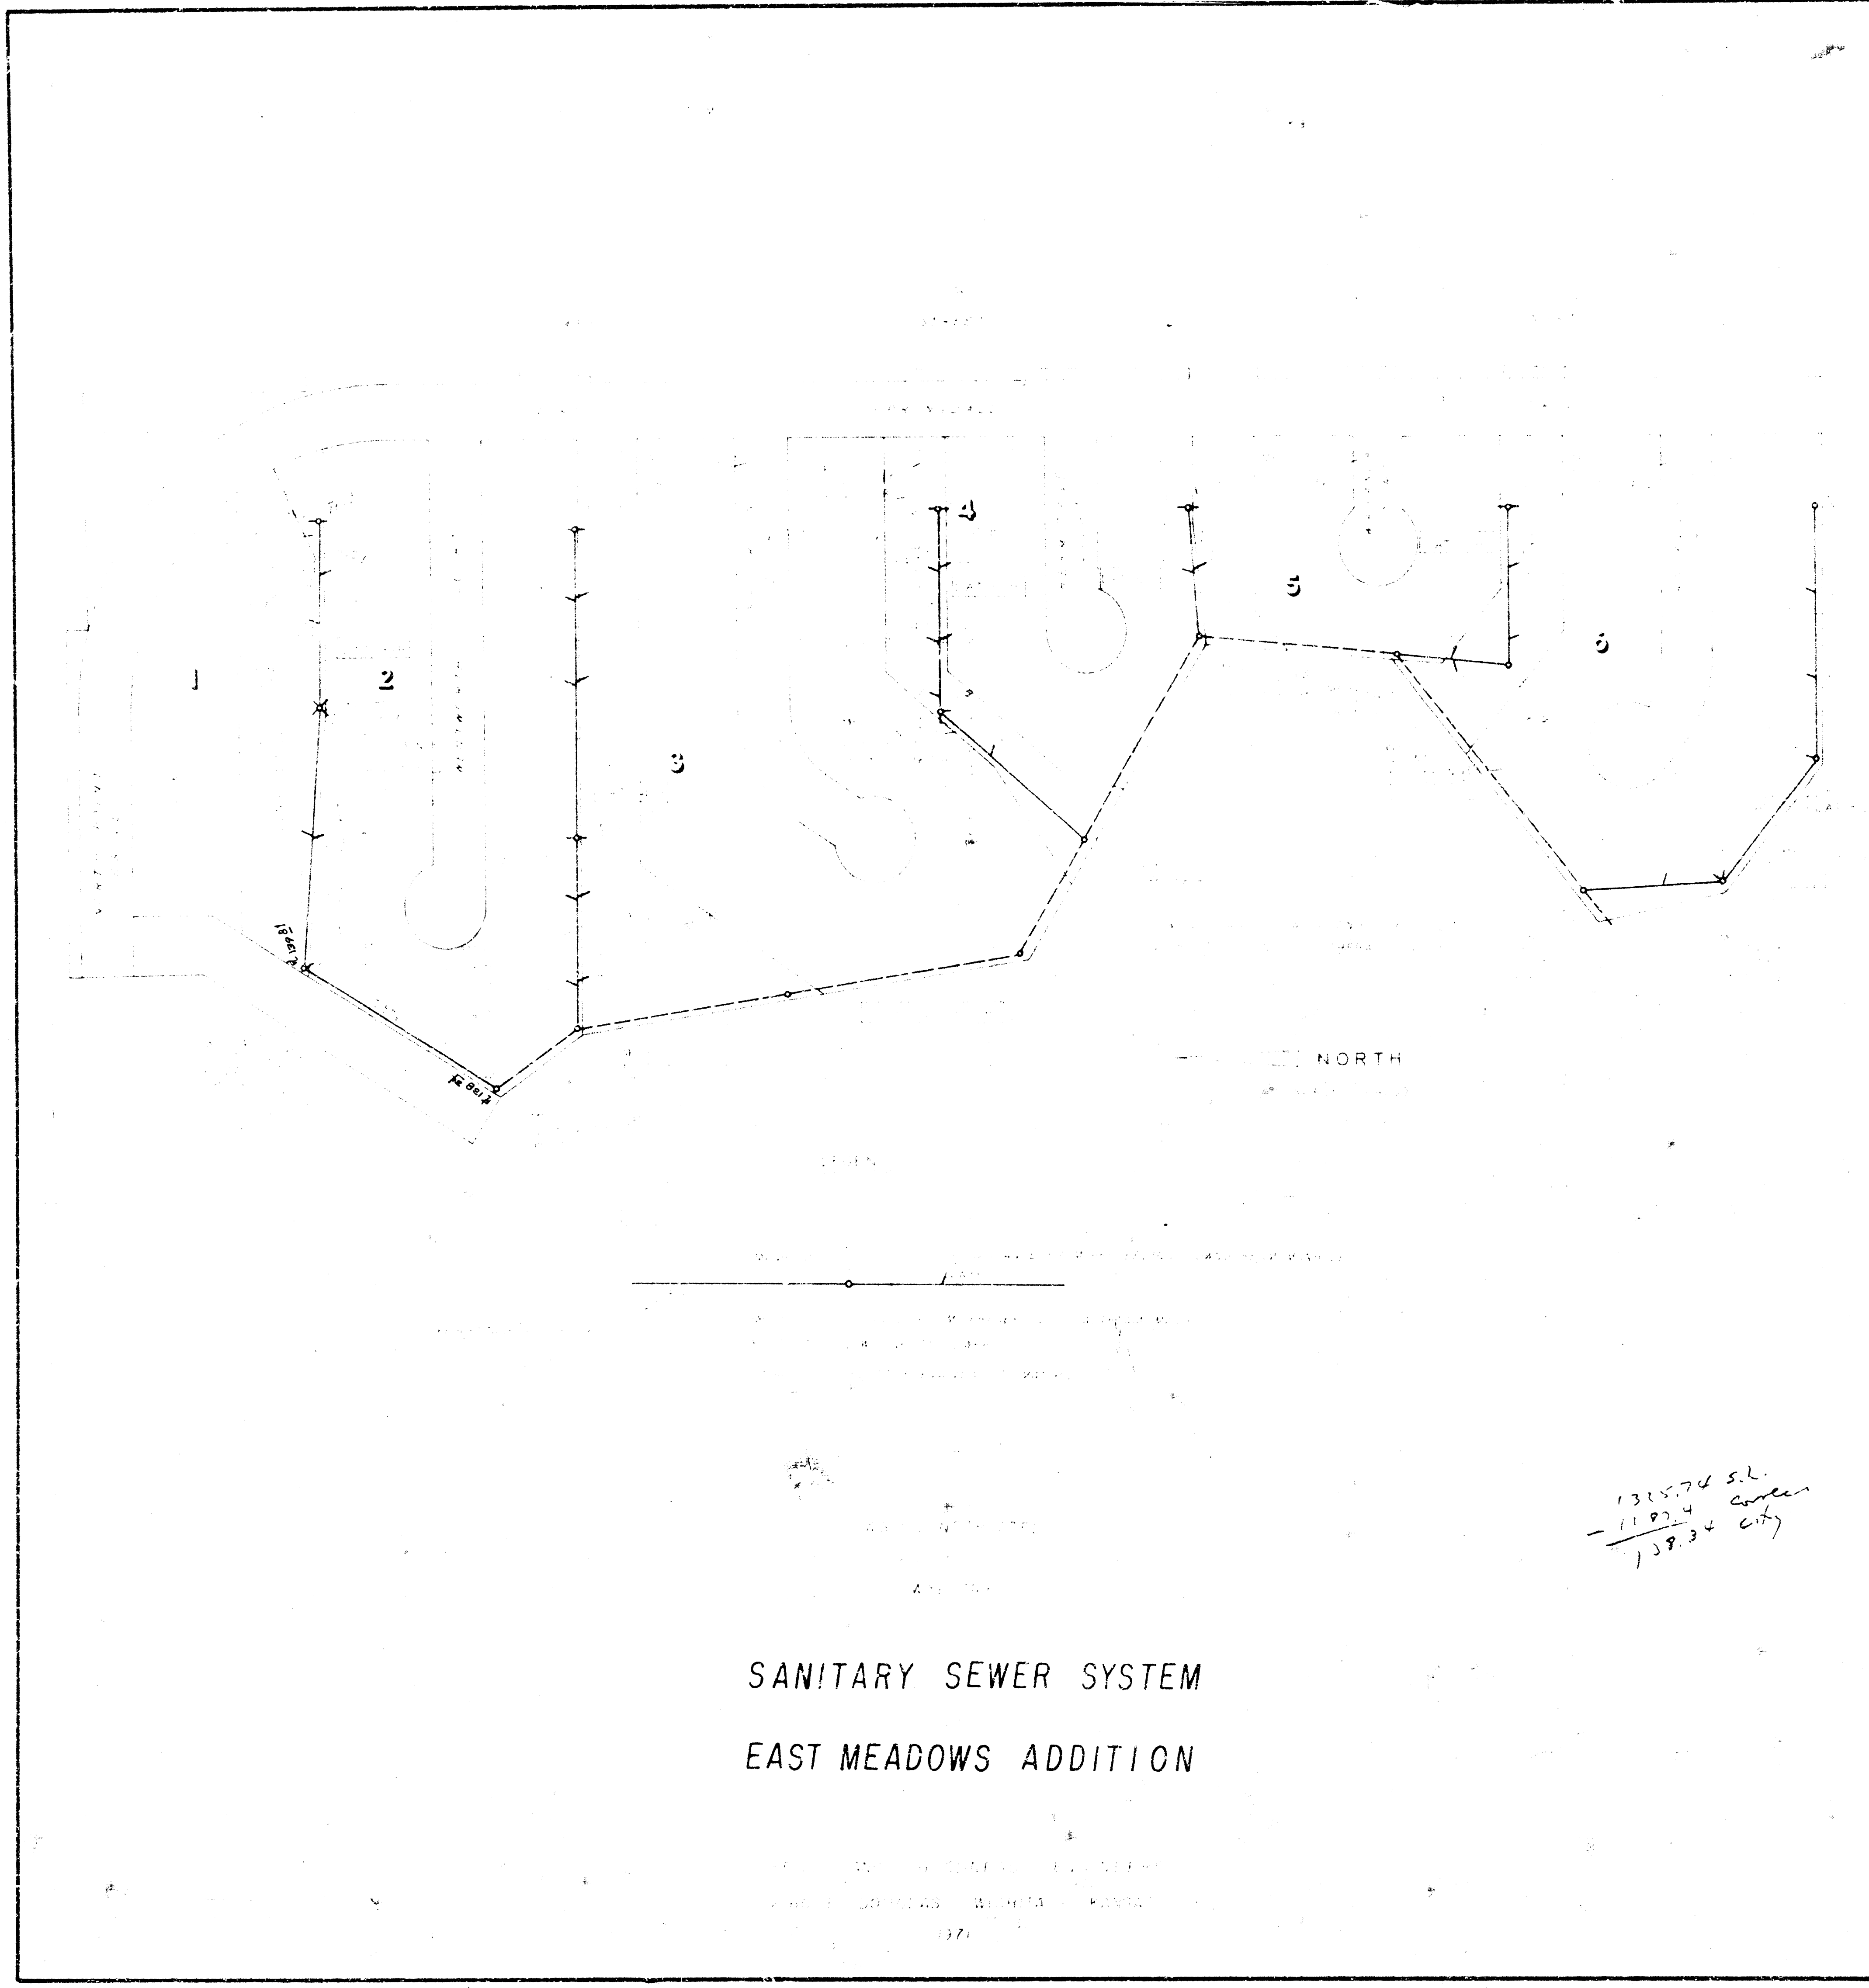

DATE: 11-11-66	DESIGN AND ADDRESS: ENGINEERS	SANITARY SEWER SYSTEM	SECTION NO. 2
	PINE & BOULDER - RICHITA - PAUSAD	EAST WENDERS ADDITION	OF 5

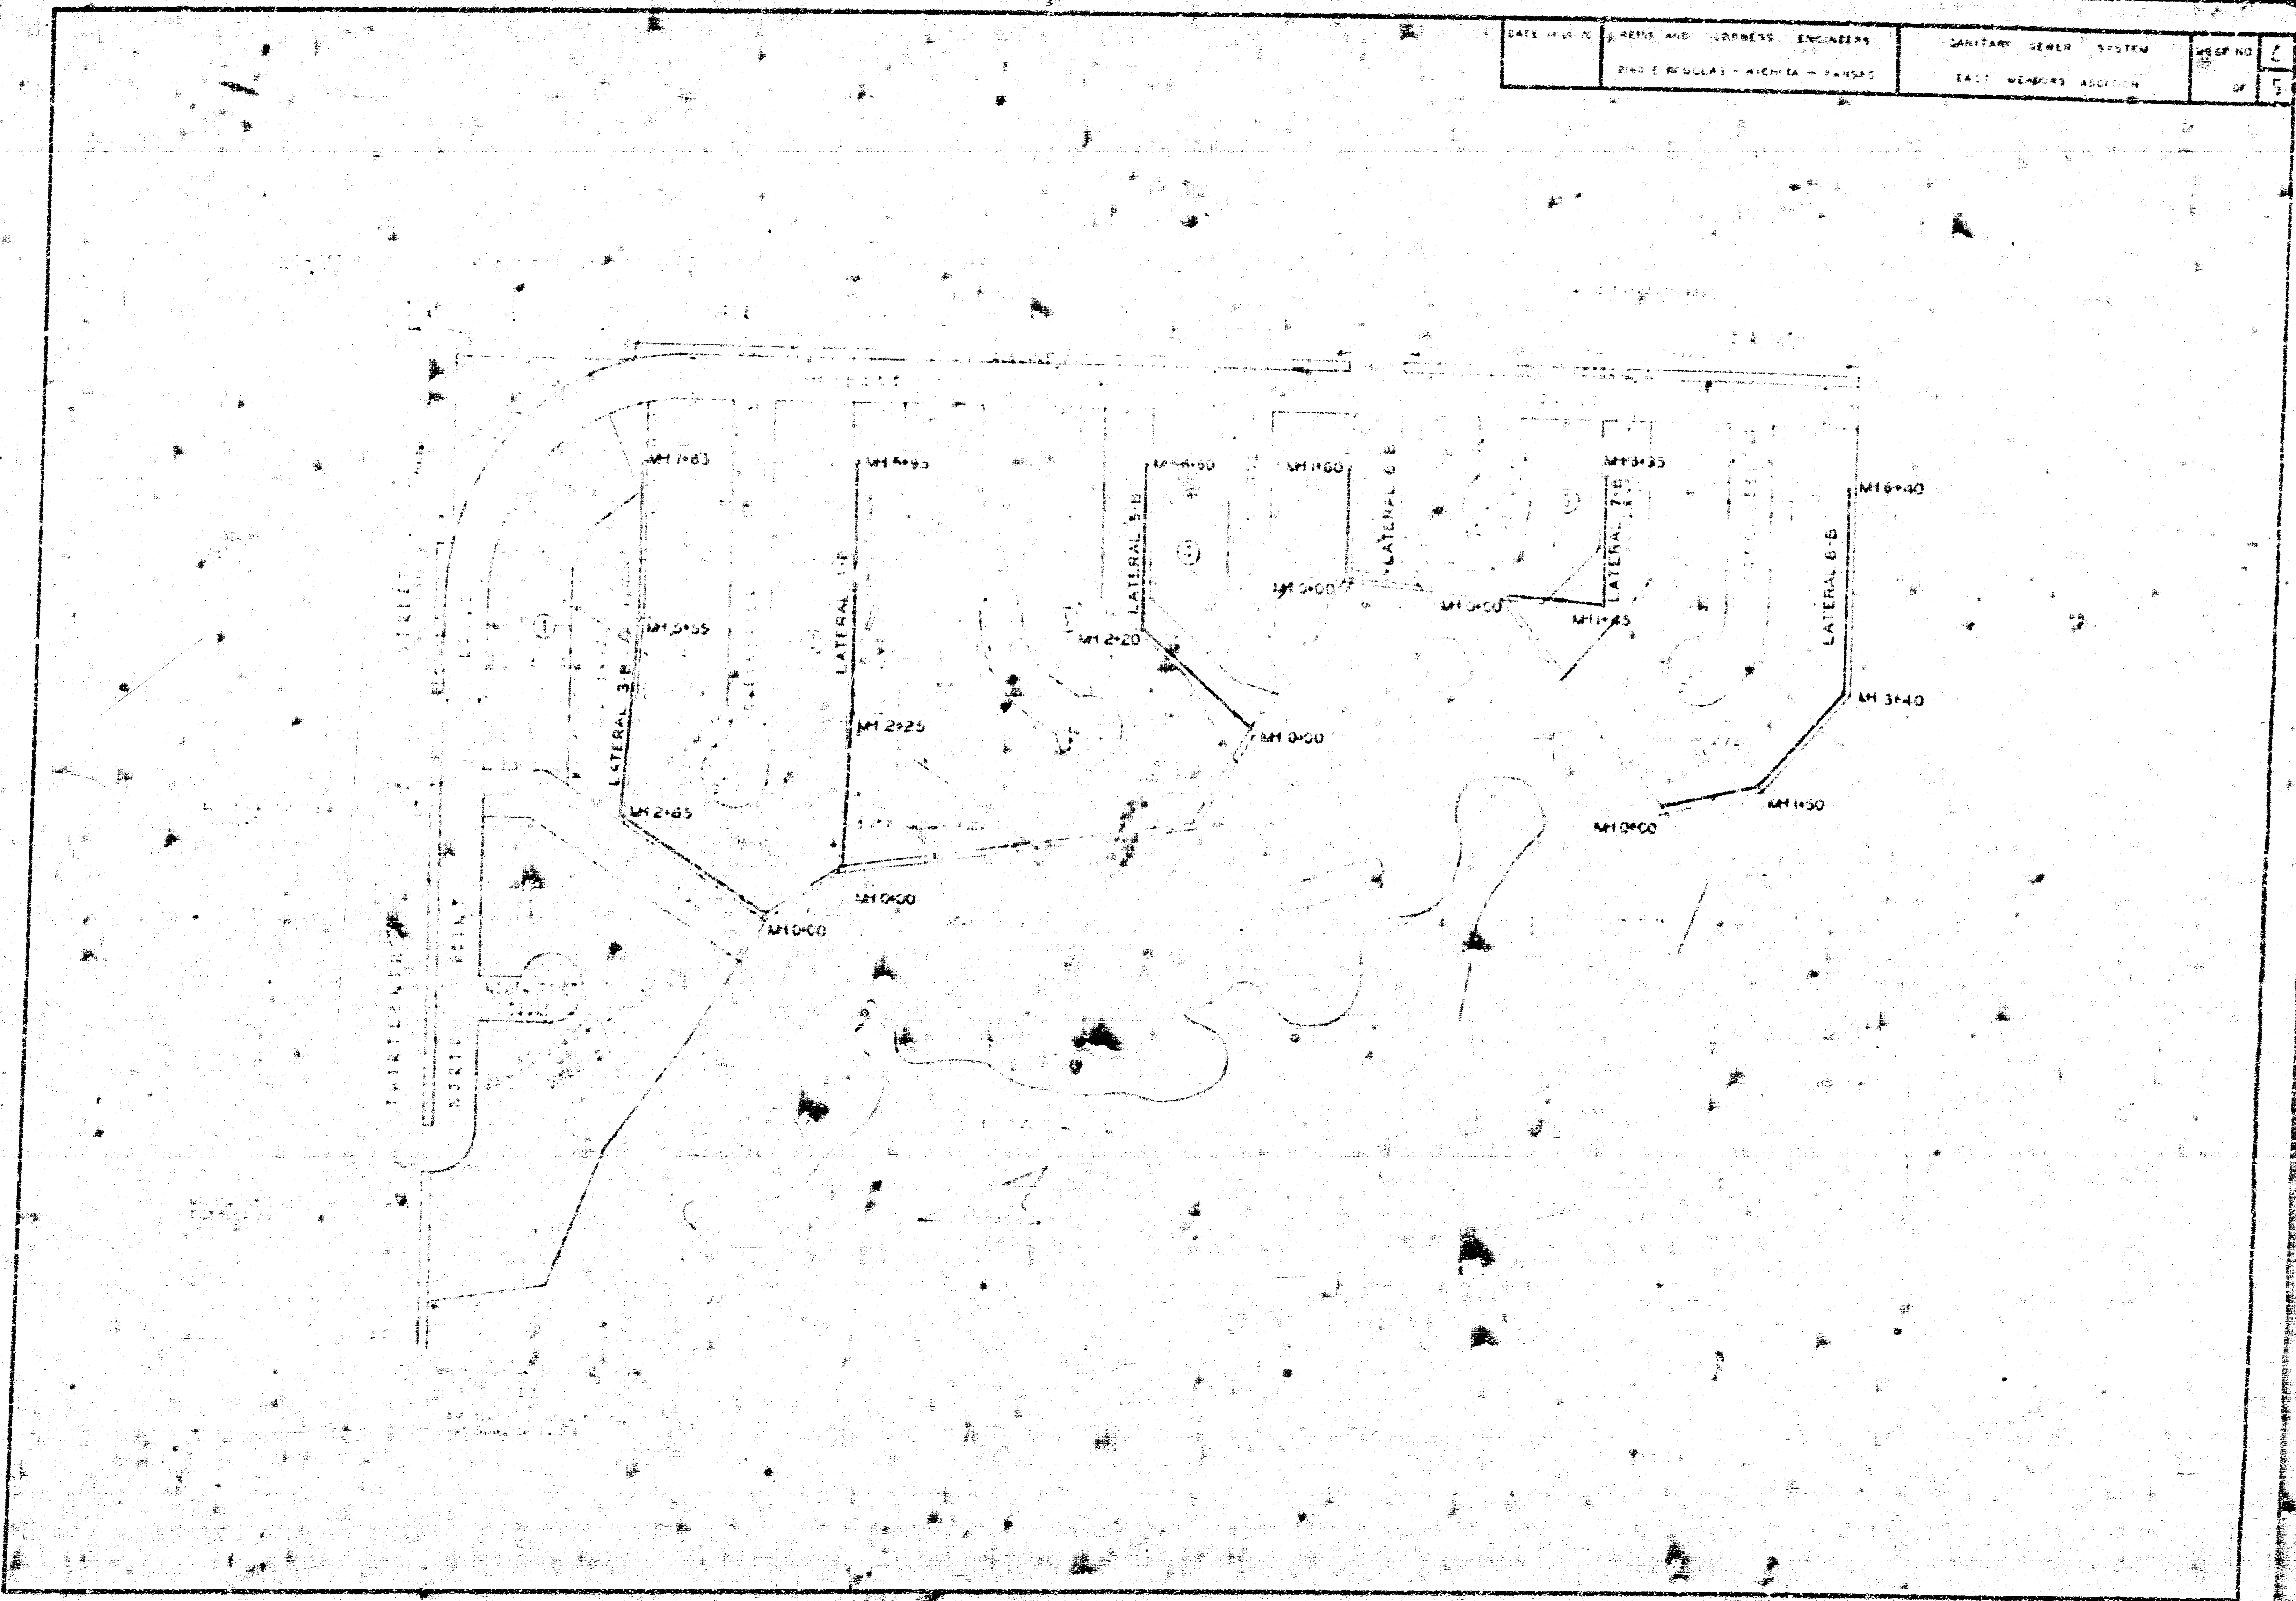

DATE	NO. OF TESTS	TEST NO.	TEST DATE	TEST TIME	TEST PLACE

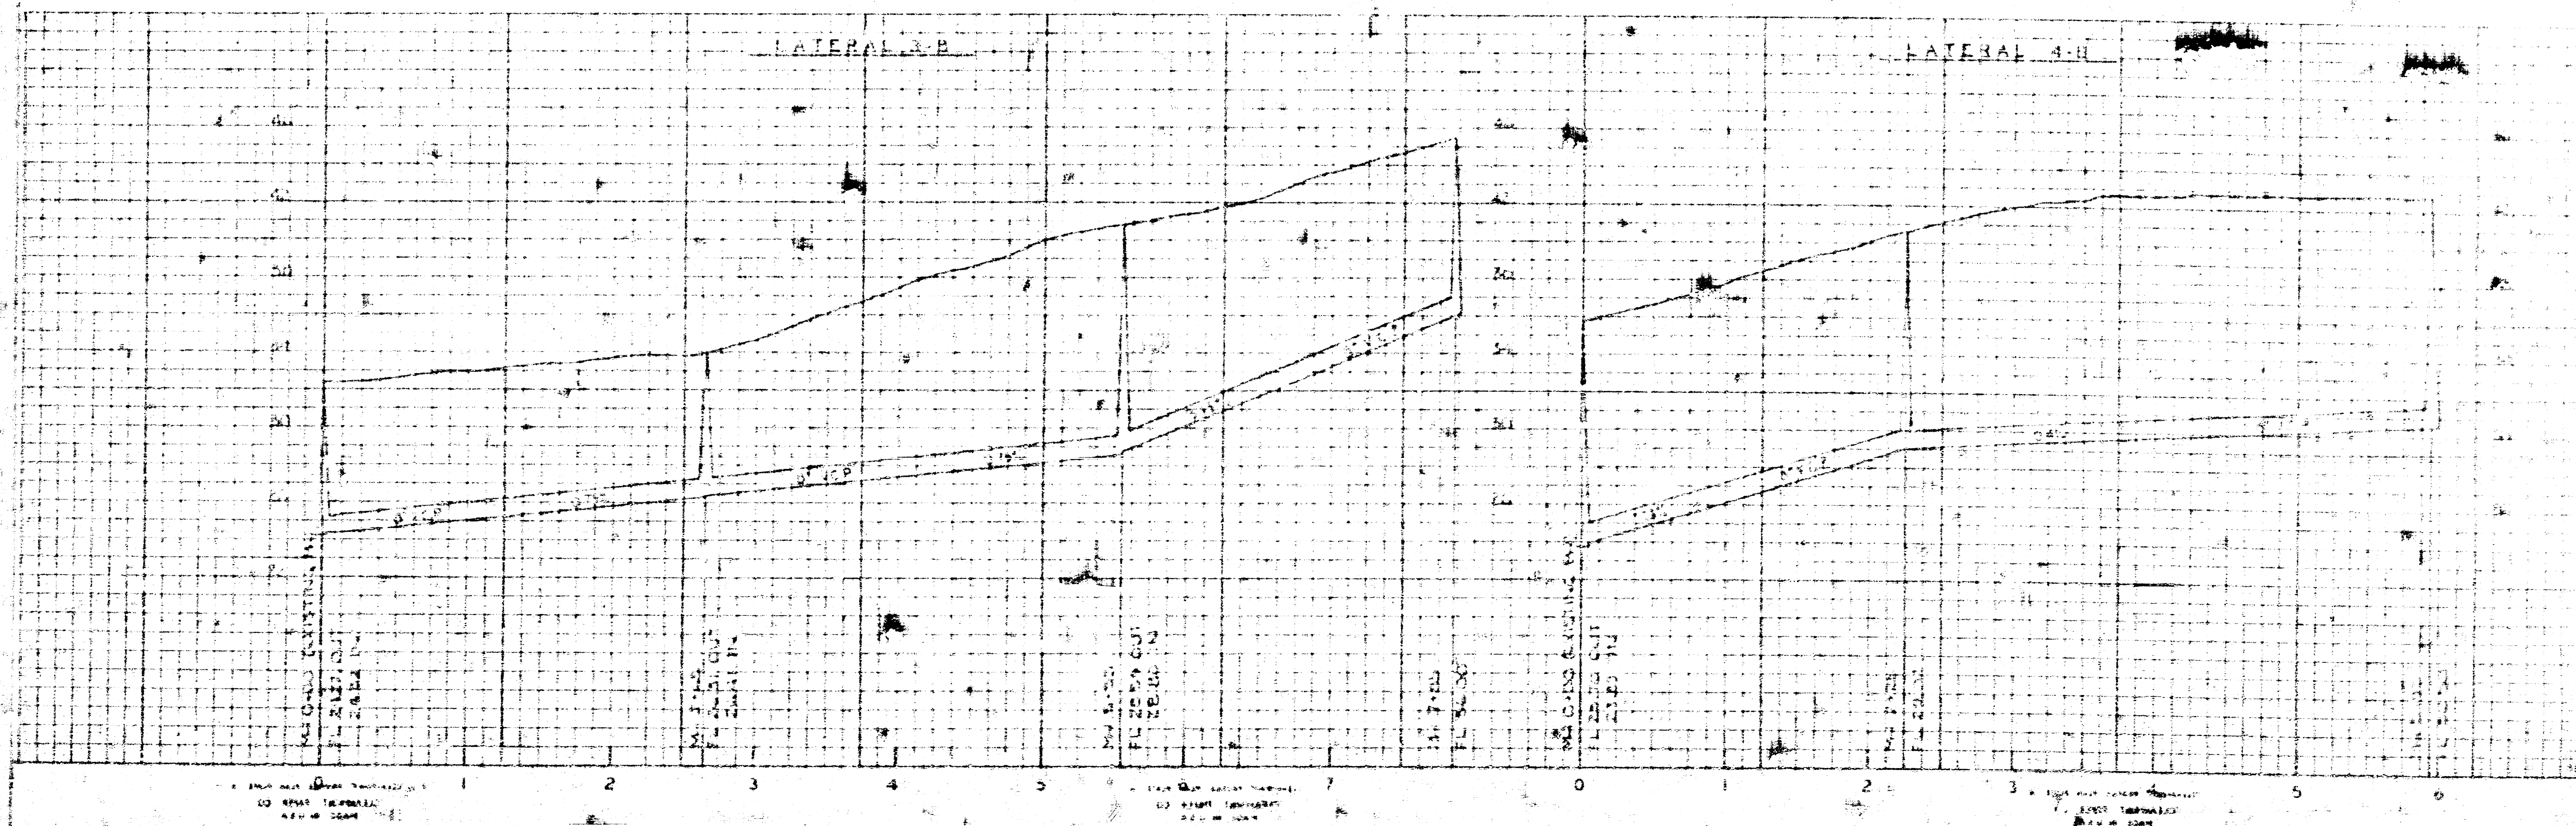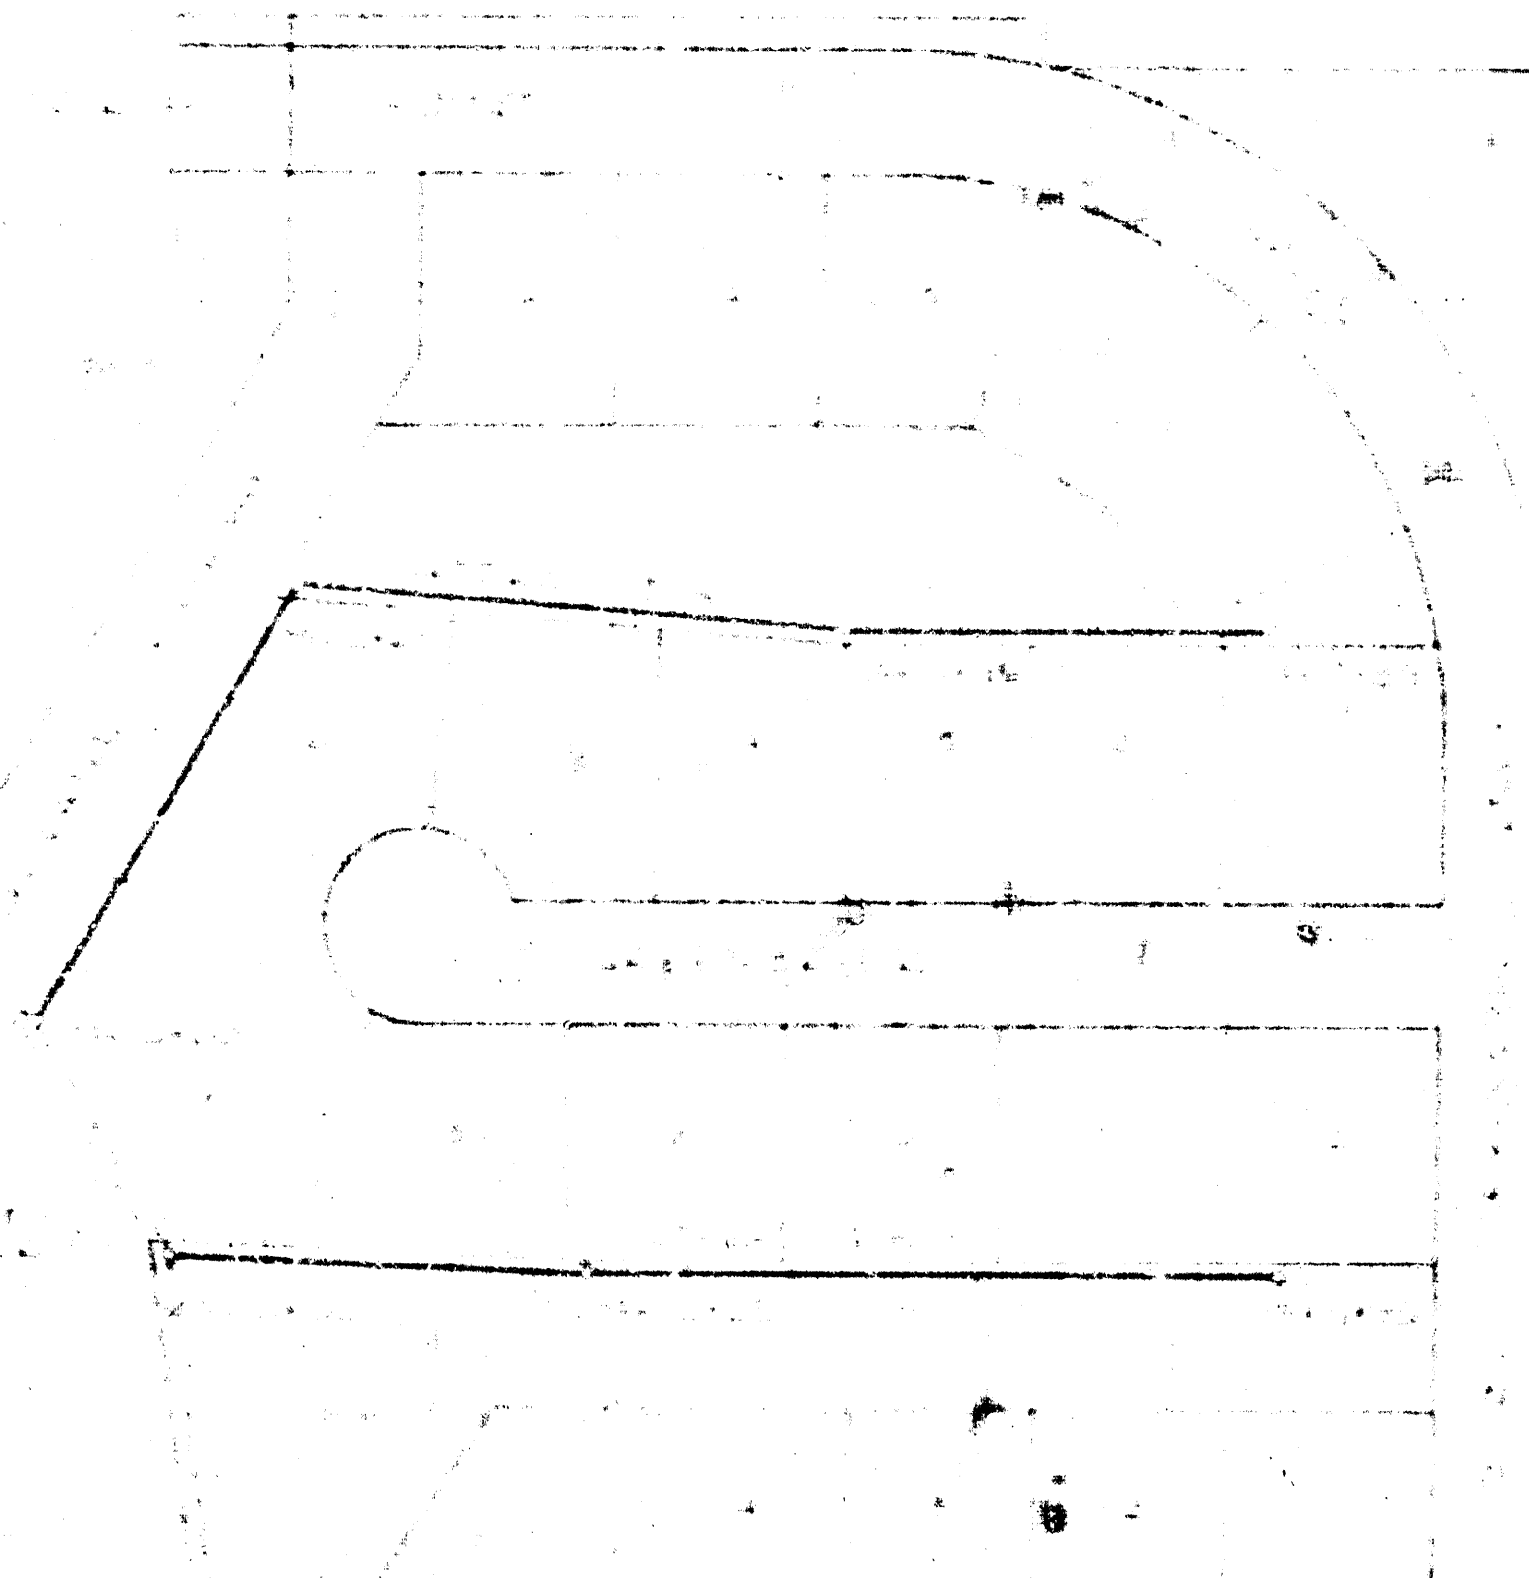

AS 114-20	HEAVY AND BUSINESS ENGINEERS	ANTHONY, MERRILL & ASSOCIATES	SHEET NO.	1
	1440 E. CHICAGO ST. CHICAGO - ILLINOIS	1000 N. WABASH ST. CHICAGO - ILLINOIS	DATE	5/1/50

