

LOT 26

LOT 25

10-14-75
 APPROVED AS NOTED
 By CITY ENGINEER OF WICHITA
 Sanitary Sewer: D.E.S.
 Storm Sewers:
 Driveway Approaches:

RE SURVEY OF FAIRLAWN ACRES

N
 SCALE 1"=40'

TYPE A OR C
2+85

2-6" STUBS 1-NE
1-NW

DE-437-S

DE-438-J

NOTE TO CONTRACTOR
 This project will be constructed under the supervision of the CITY ENGINEER and conforming to the SPECIFICATIONS of the CITY OF WICHITA. The CONTRACTOR will reimburse the City of Wichita for all cost of ~~inspection~~, inspection.

WOODCHUCK LANE

IRVING

EXIST 8" SEWER


0+48 M.H. 'A' OR 'C'
- REM & REP CONC PAVING

AVE

0+00 EXIST M.H.

MIDLAND INDUSTRIES

DATE: 10-14-75
 BY: [Signature]
 TITLE: [Title]
 CHECKED: [Signature]
 DATE: [Date]
 BY: [Signature]
 TITLE: [Title]

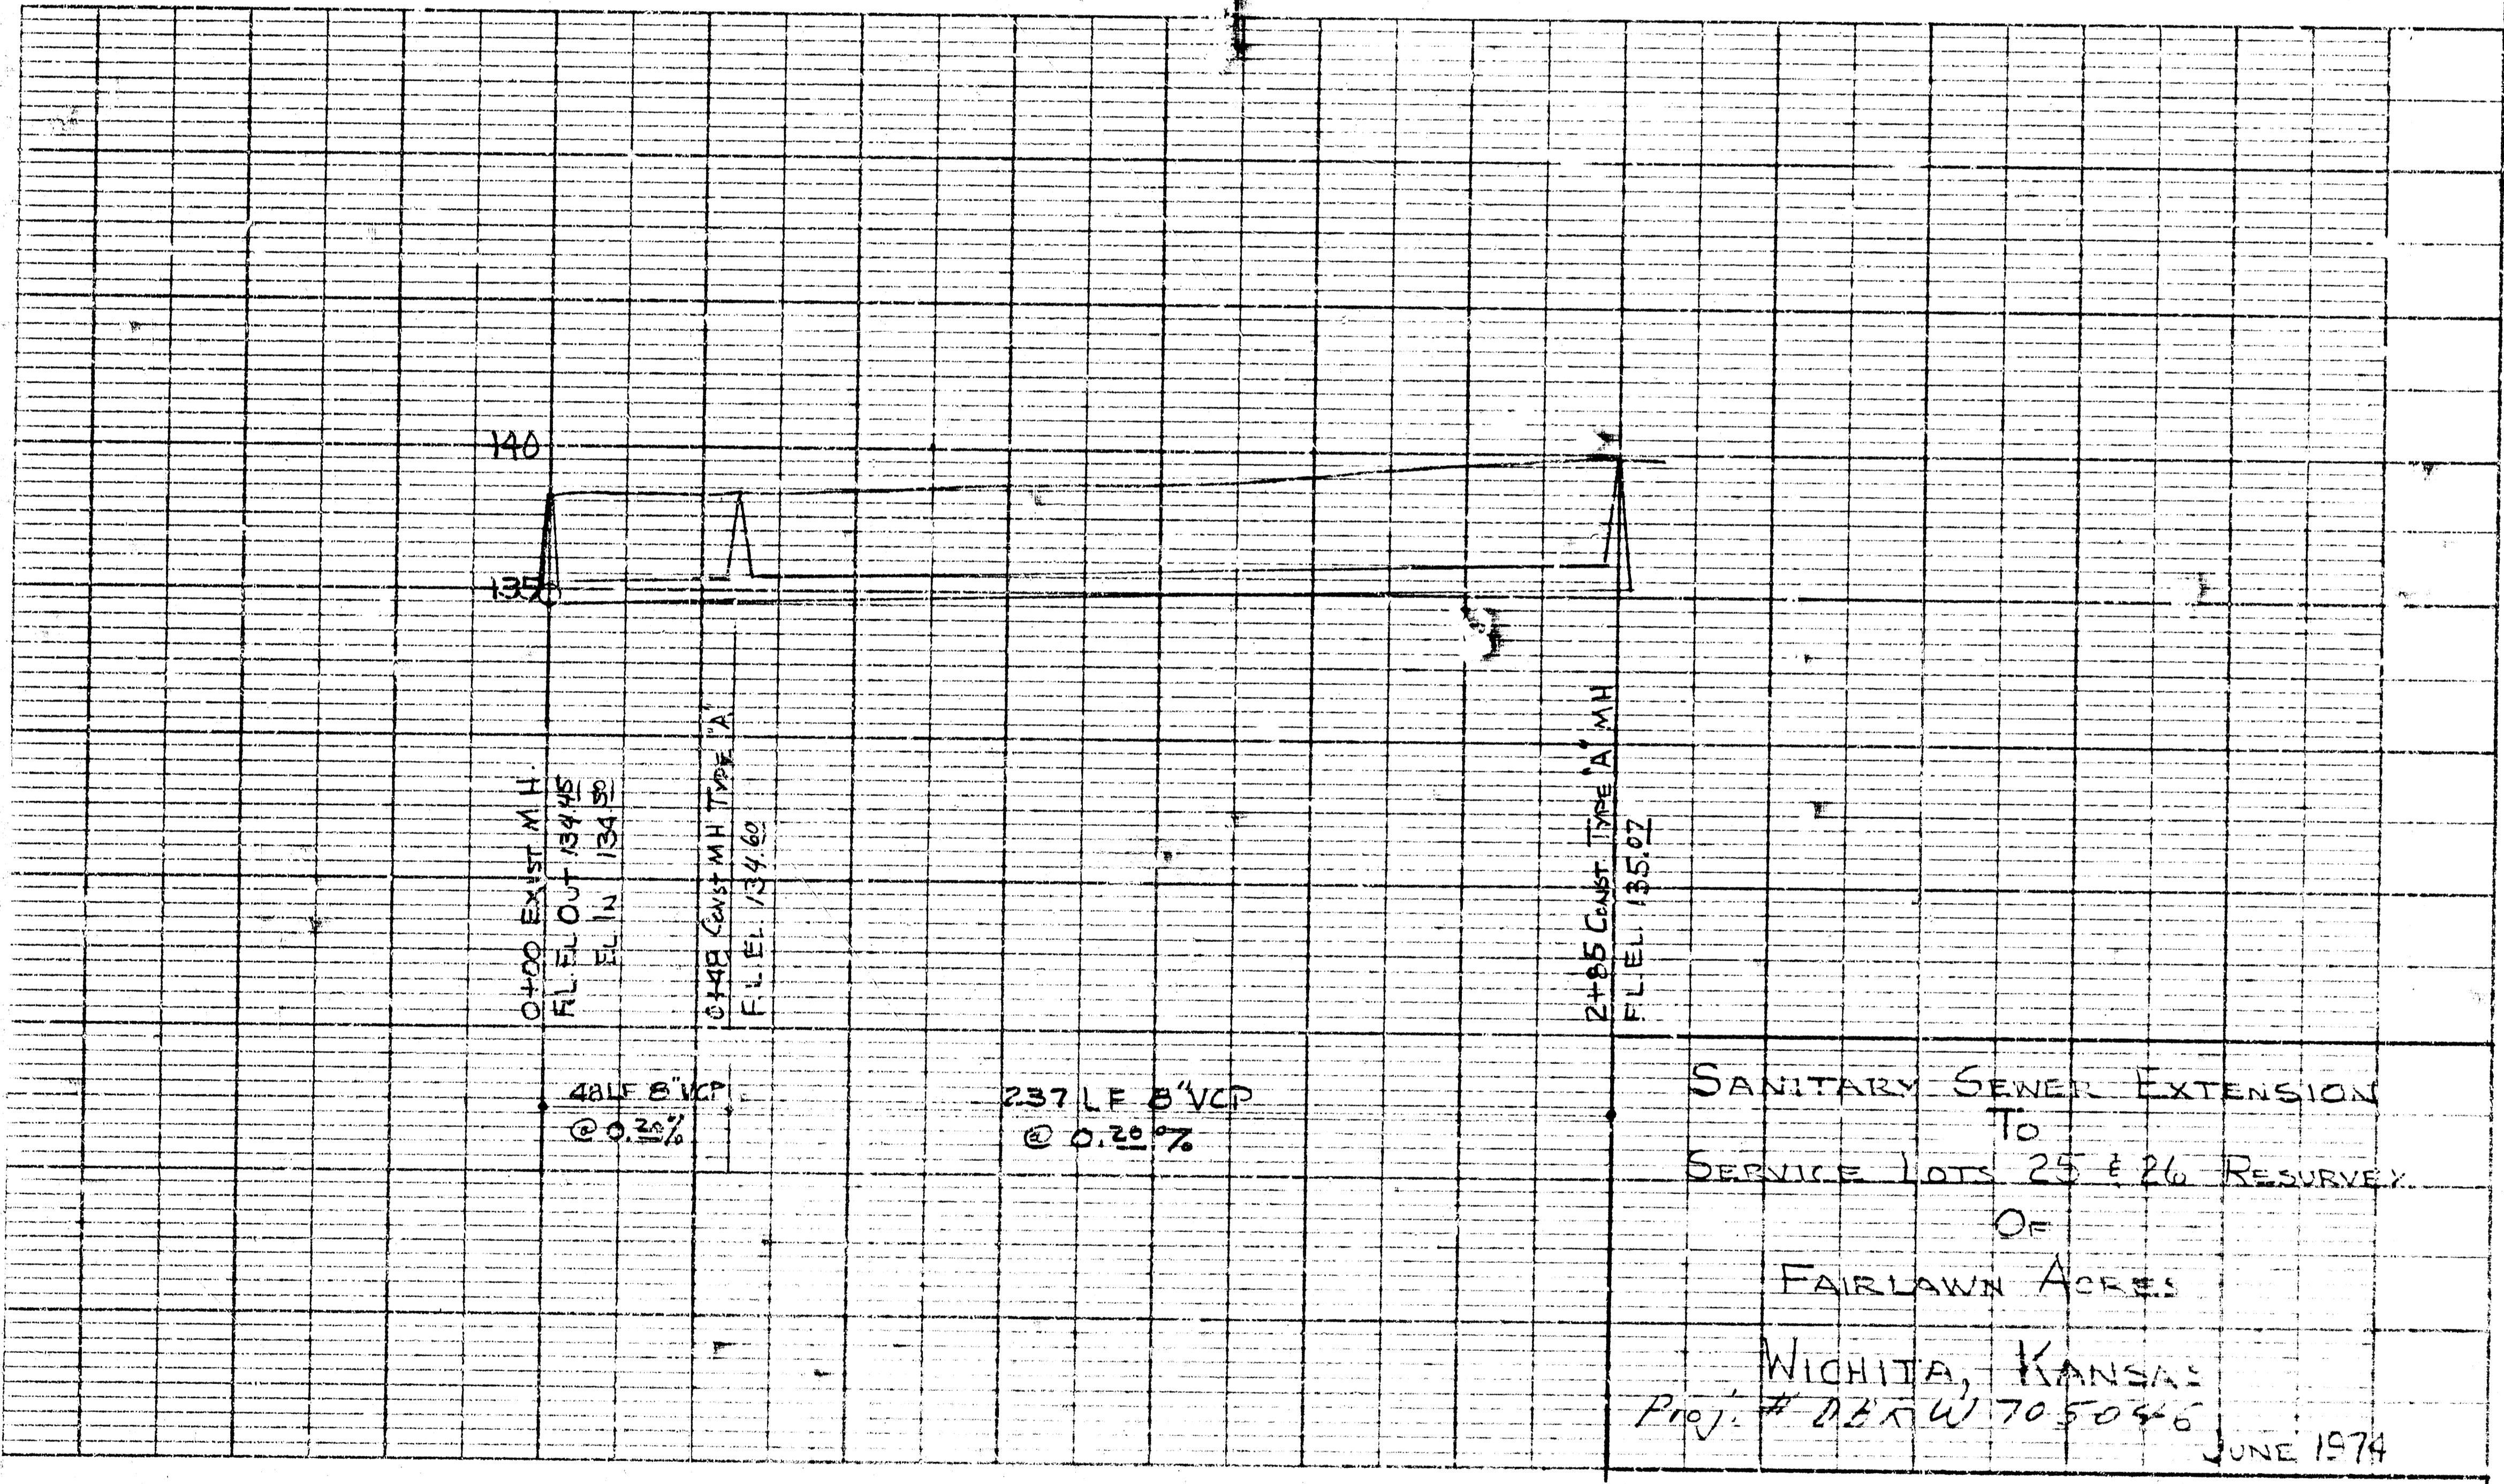

DATE: 10-14-75
 BY: [Signature]
 TITLE: [Title]
 CHECKED: [Signature]
 DATE: [Date]
 BY: [Signature]
 TITLE: [Title]

14 8 2 18