



PLAN
 SHOWN
 NOT TO SCALE
 1" = 30'

PROFILE
 SHOWN
 NOT TO SCALE
 1" = 10'

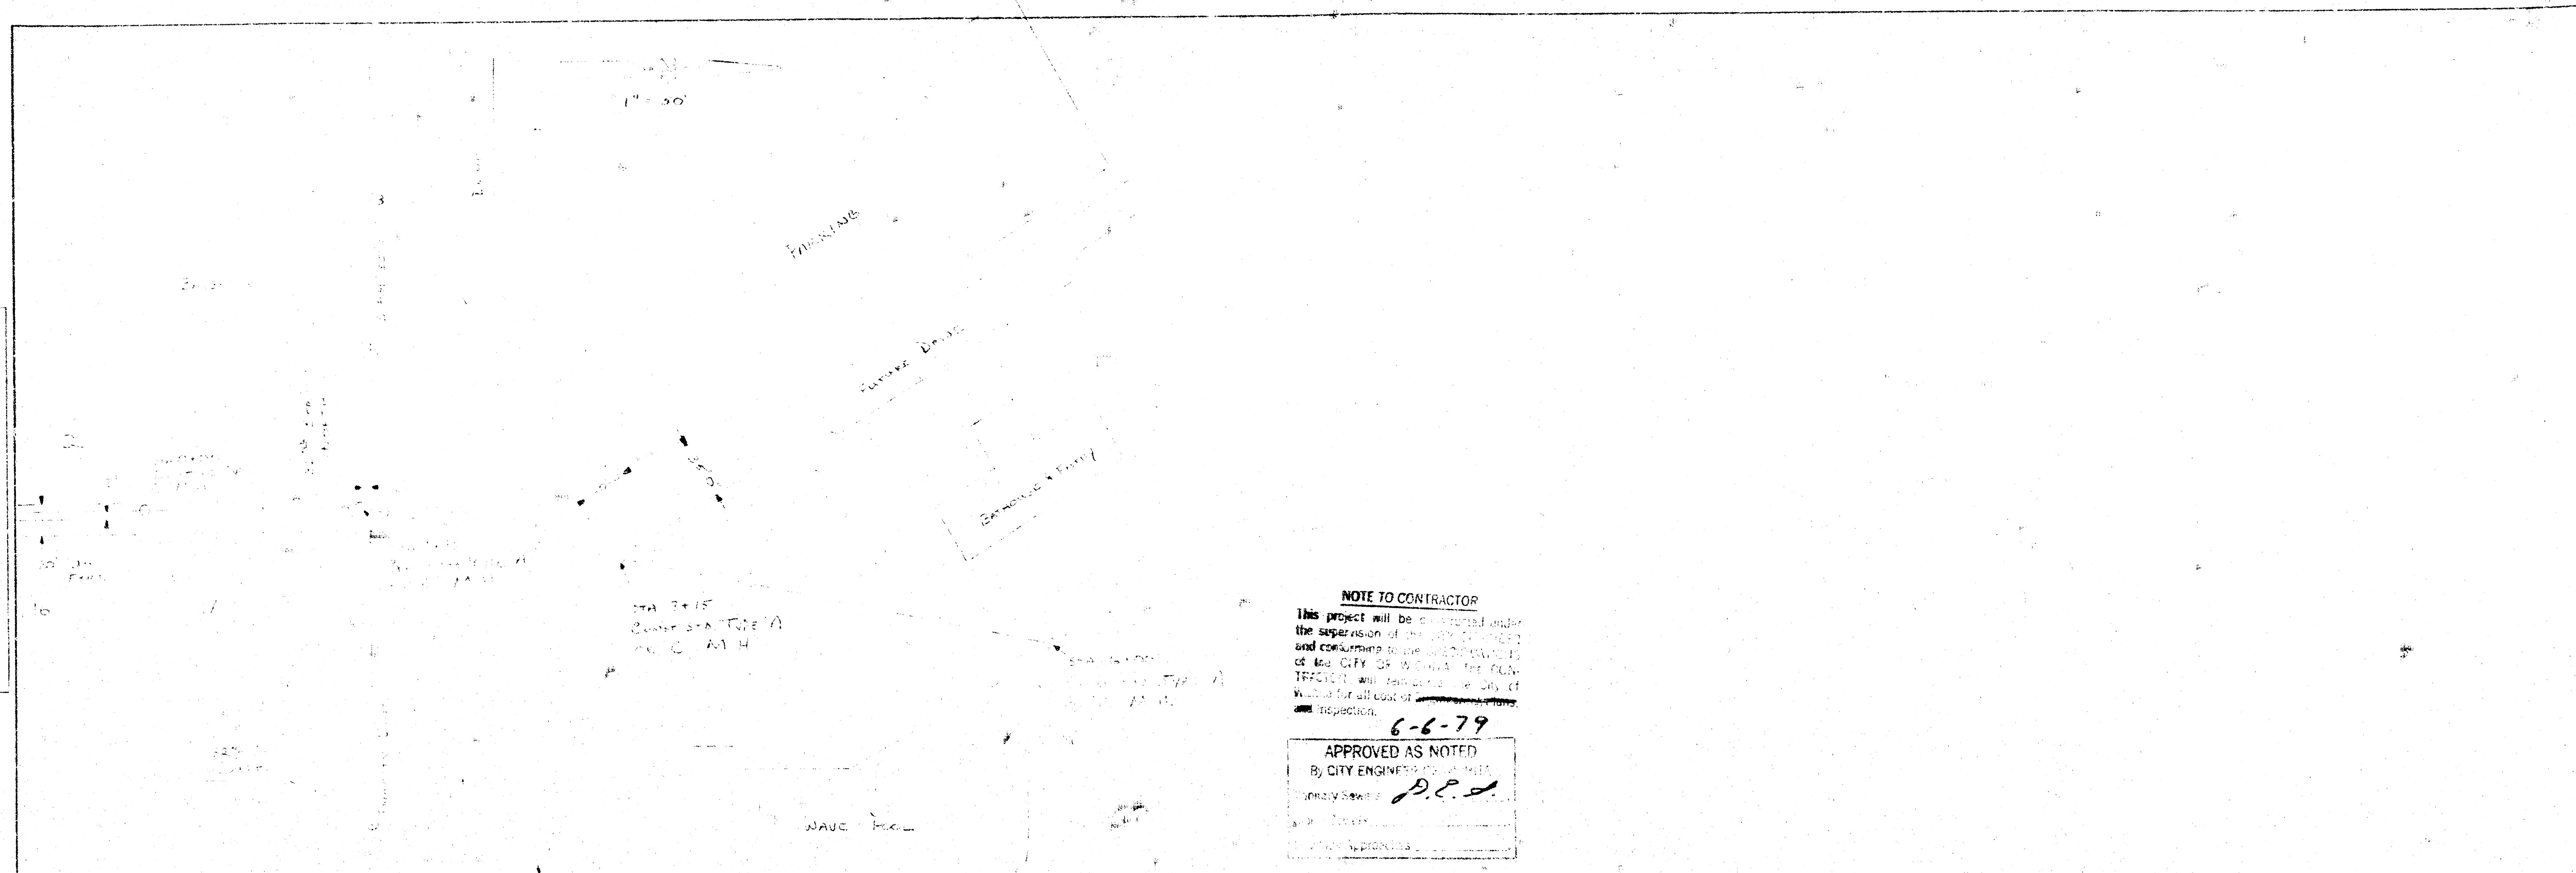

NOTE TO CONTRACTOR
 This project will be completed under the supervision of the City Engineer and conforming to the specifications of the City of Los Angeles. The CONTRACTOR will be responsible for all costs of inspection.

6-6-79
APPROVED AS NOTED
 By CITY ENGINEER
P.P.L.

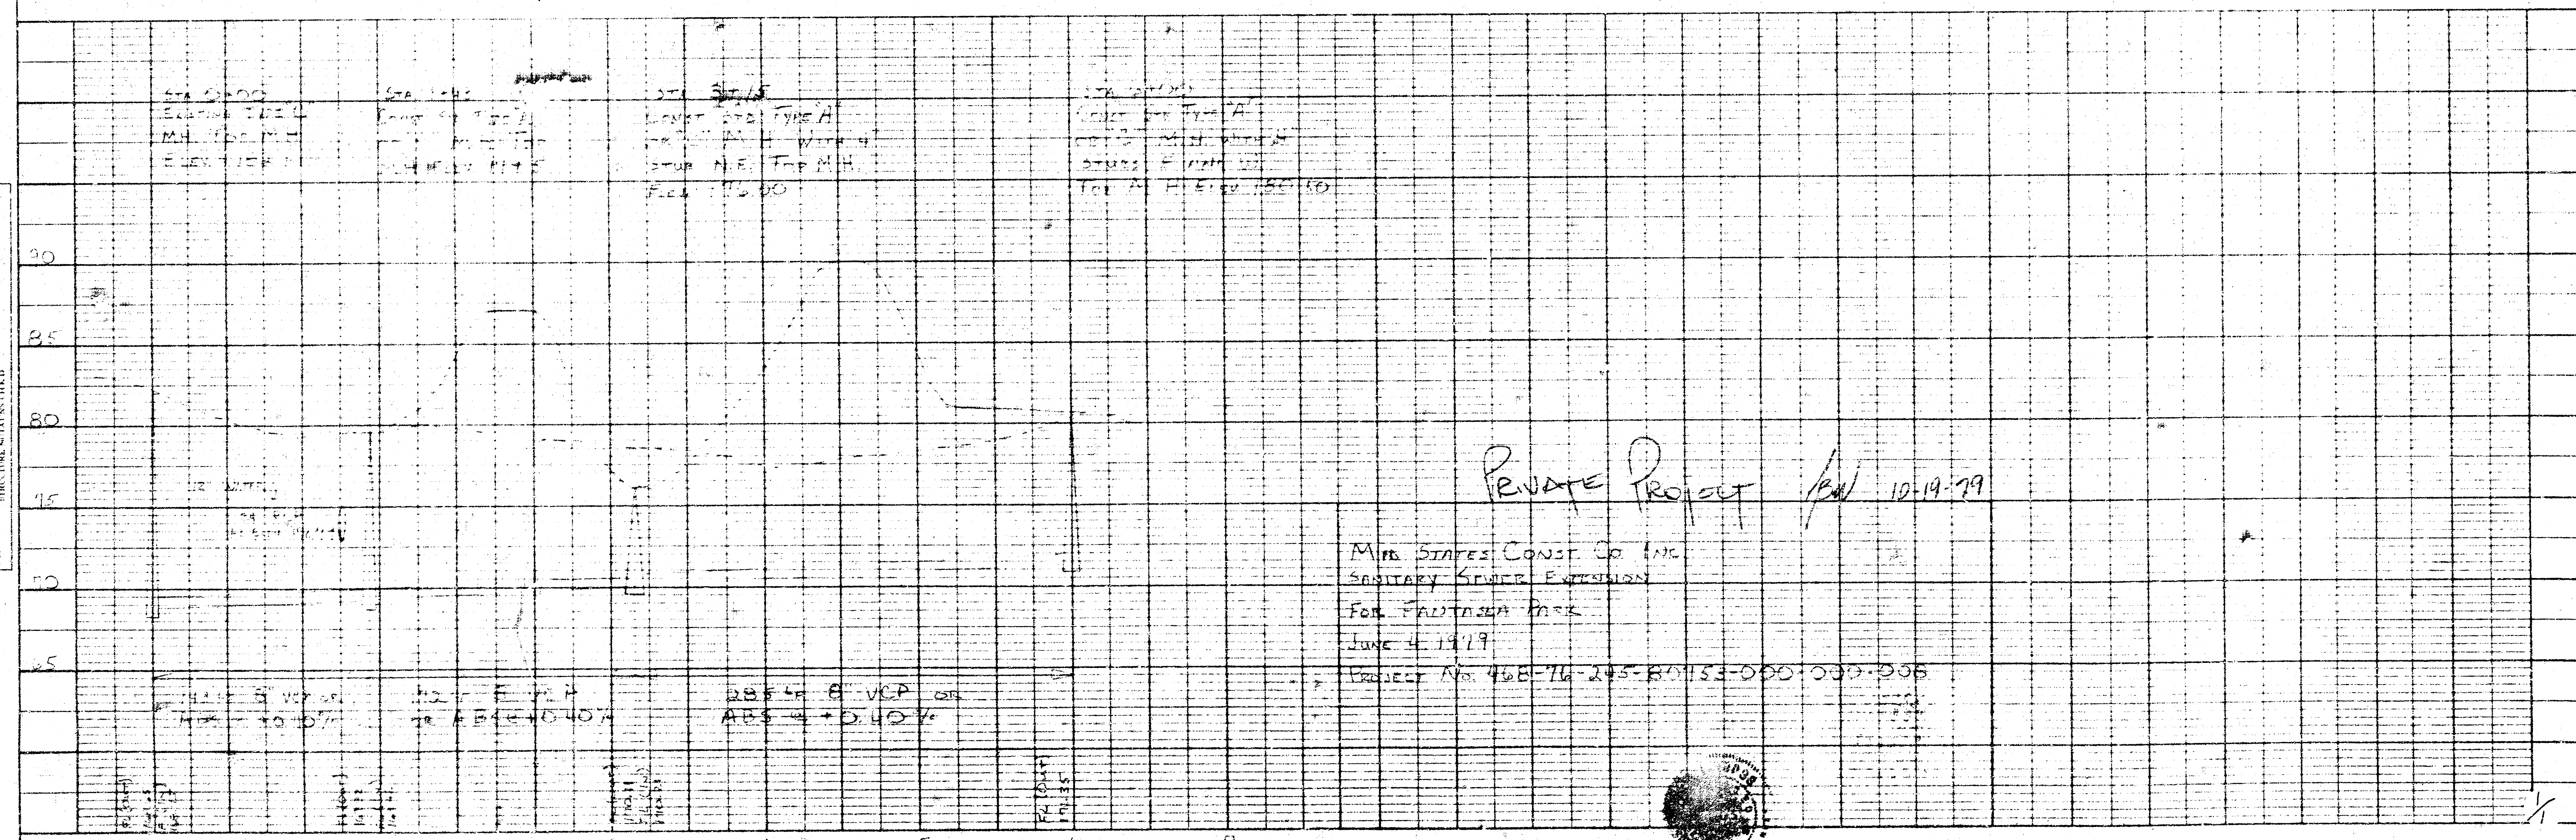

PRIVATE PROJECT /BW 10-19-79
 MRS. STATES CONST. CO. INC.
 SEWAGE SERVICE EXTENSION
 FOR FAUNTSEA PARK
 June 4, 1979
 PROJECT NO. 468-74-245-B0155-000-000-000

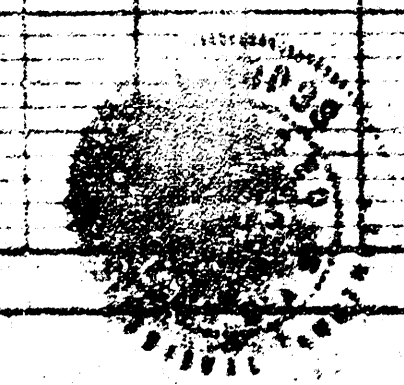


PLATE 1: PLAN, PROFILE, ELEVATION
 6/14/79
 NO. 10001

14 2 5 10