

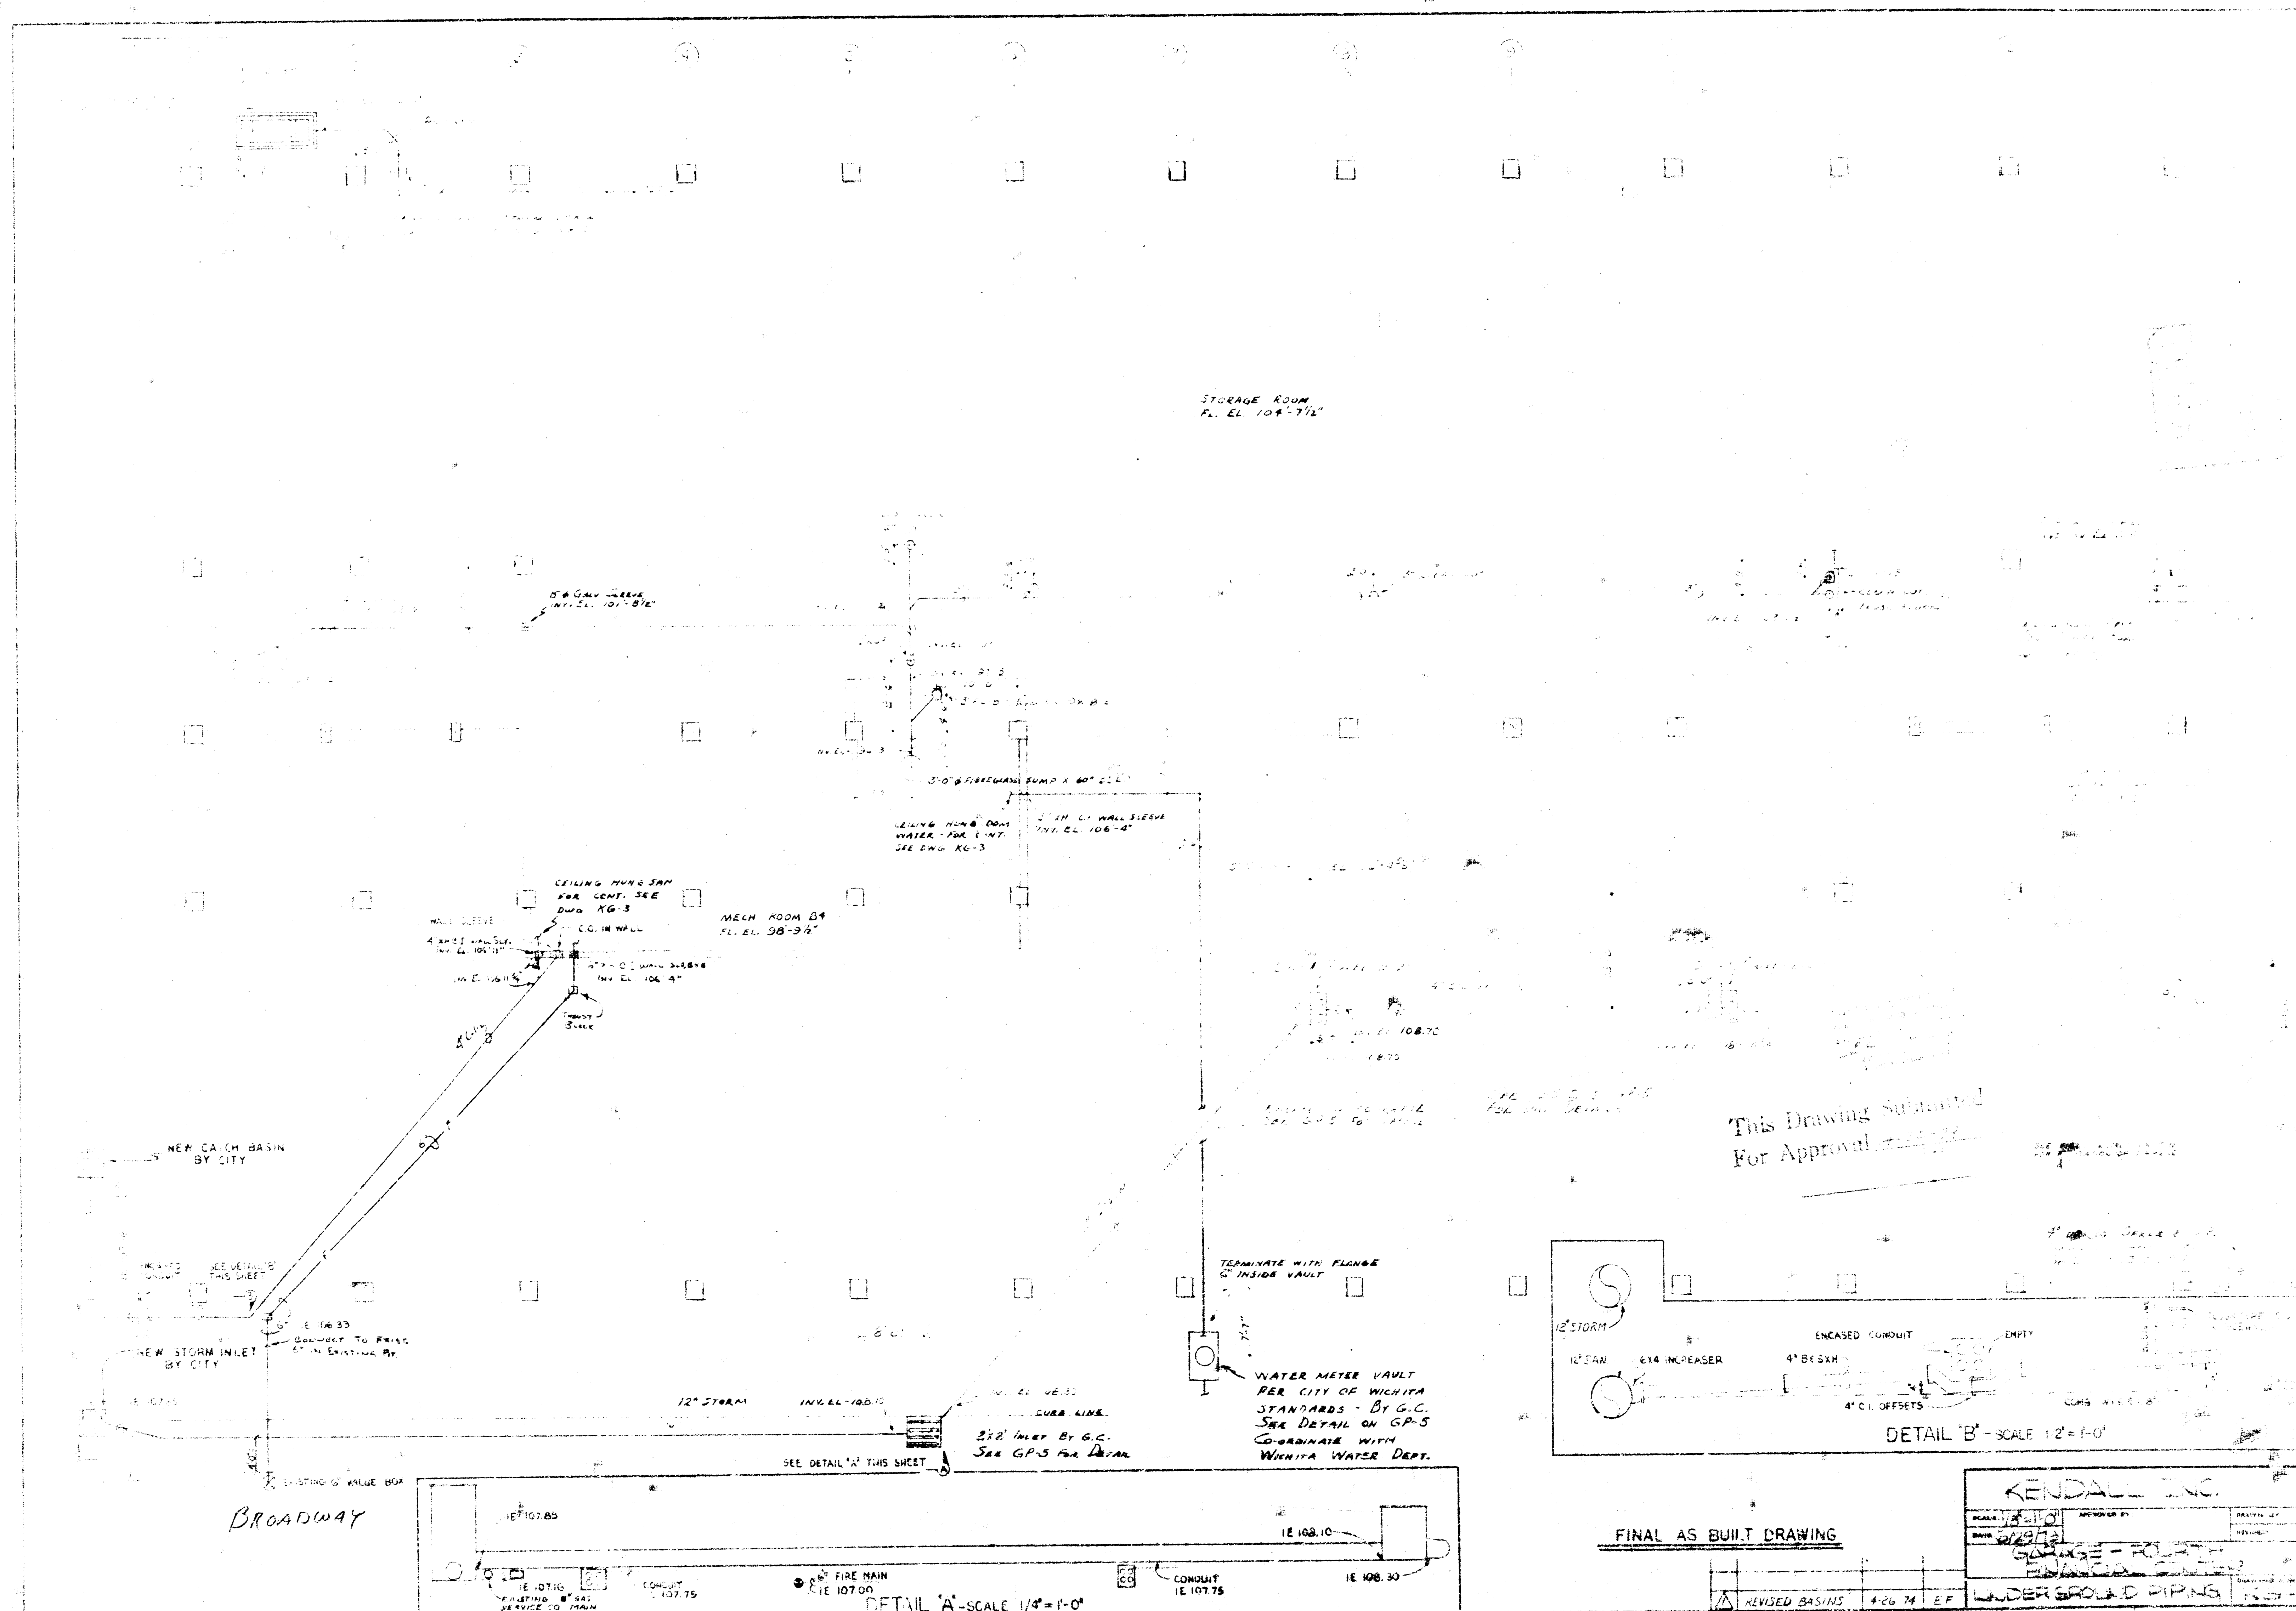


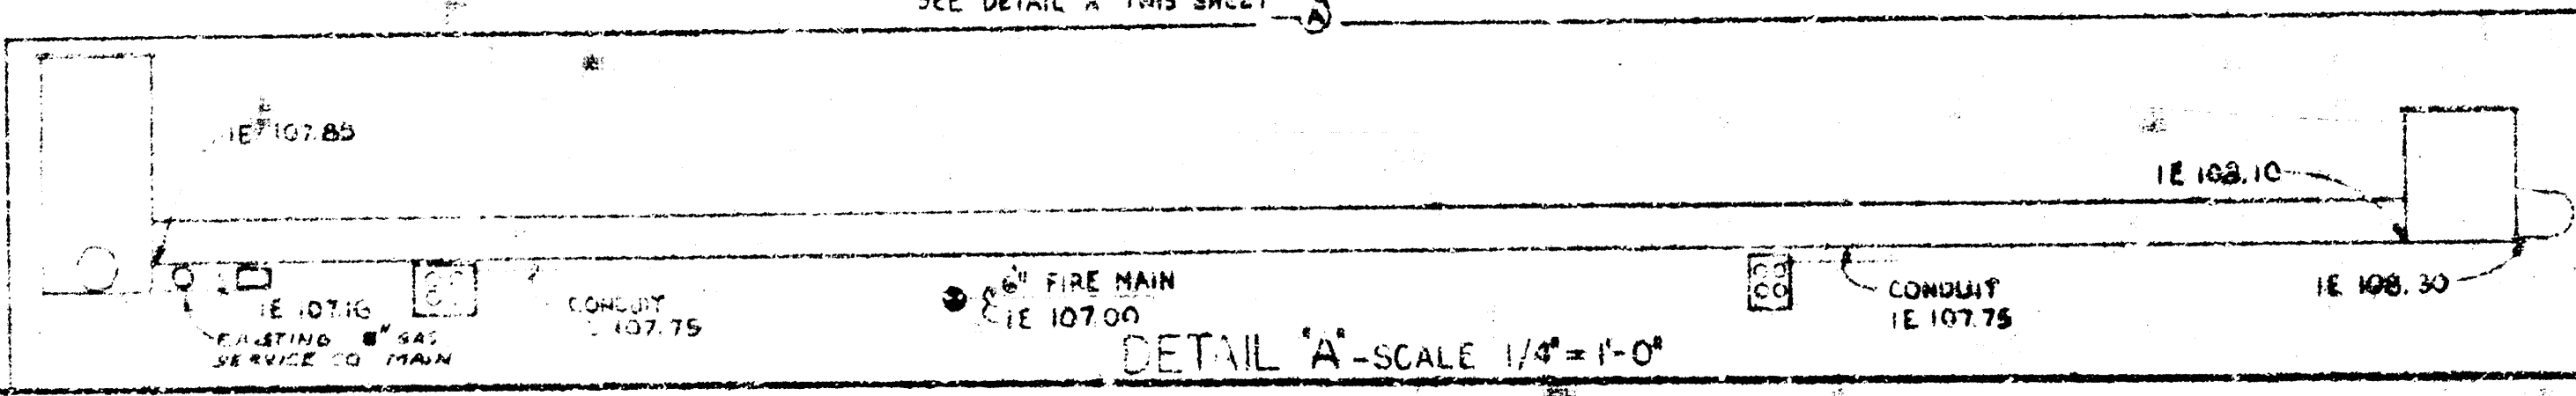

This Drawing Submitted
For Approval

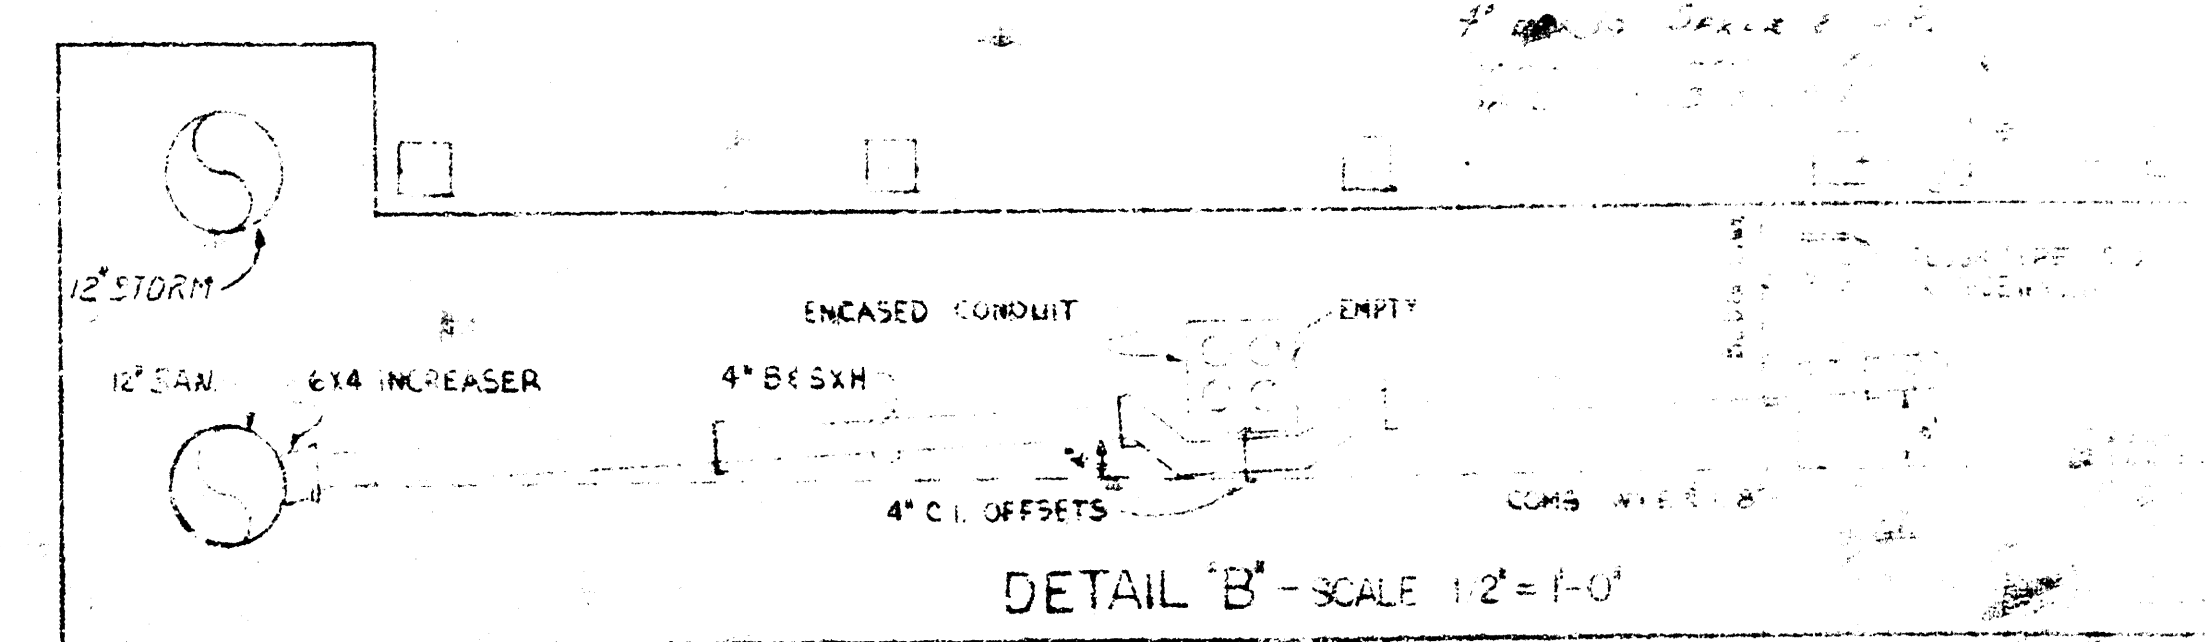

FINAL AS BUILT DRAWING

RENDALL INC.			
SCALE 1/8\"=1'-0"	DATE 11/10/10	APPROVED BY	DRAWN BY
11/10/10	11/10/10		
CHANGE - RUSH			
REVISIONS			
1	11/10/10	11/10/10	11/10/10
UNDERGROUND PIPING			