


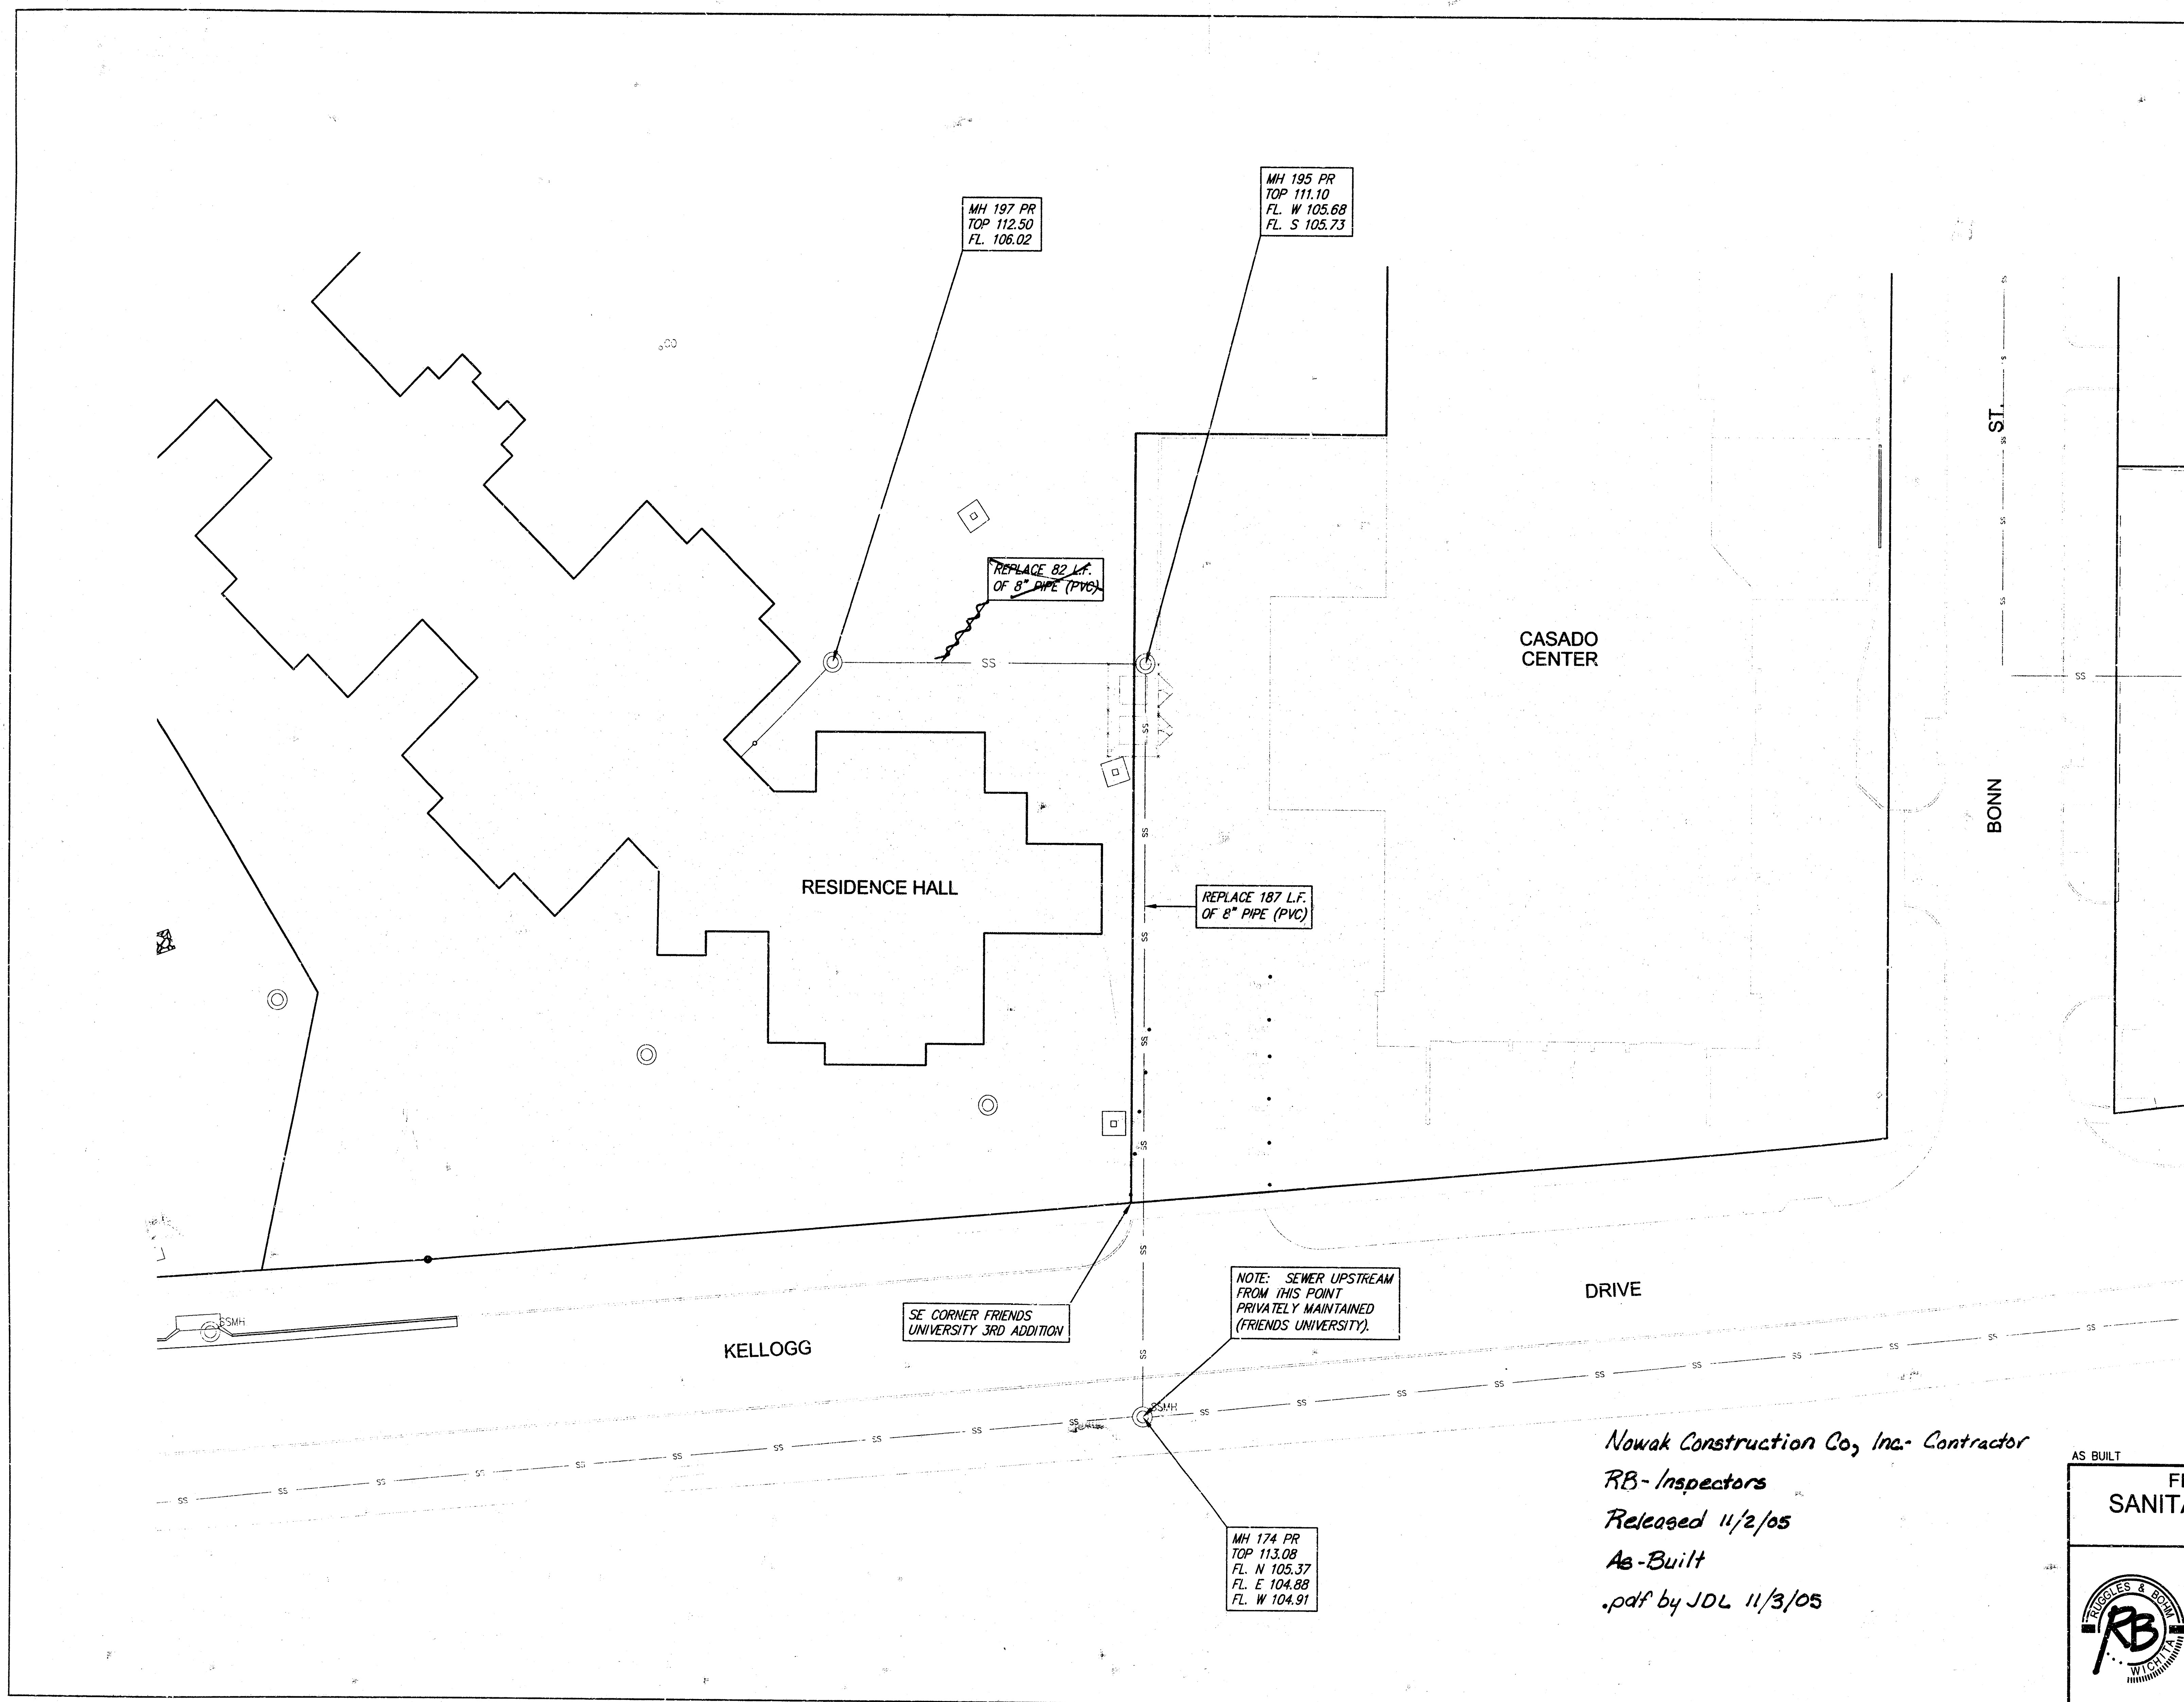

Nowak Construction Co, Inc. Contractor
RB-Inspectors
Released 11/2/05
As-Built
.pdf by JDL 11/3/05

AS BUILT	
FRIENDS UNIVERSITY 3RD ADDITION SANITARY SEWER RECONSTRUCTION WICHITA, KANSAS	
 Ruggles & Bohm, P.A. Engineering, Surveying, Land Planning 924 North Main Wichita, Kansas 67203 www.rbkansas.com (316) 264-8008 (316) 264-4621 fax E-mail: info@rbkansas.com	DESIGN TCR DRAWN EJB REVIEW UTILITY DATE Apr. 5, 2004 PROJECT NUMBER 1411 PPS (607861) DRAWING FILE Base {As Built}
SHEET 1 OF 1	DATE 11/3/05