


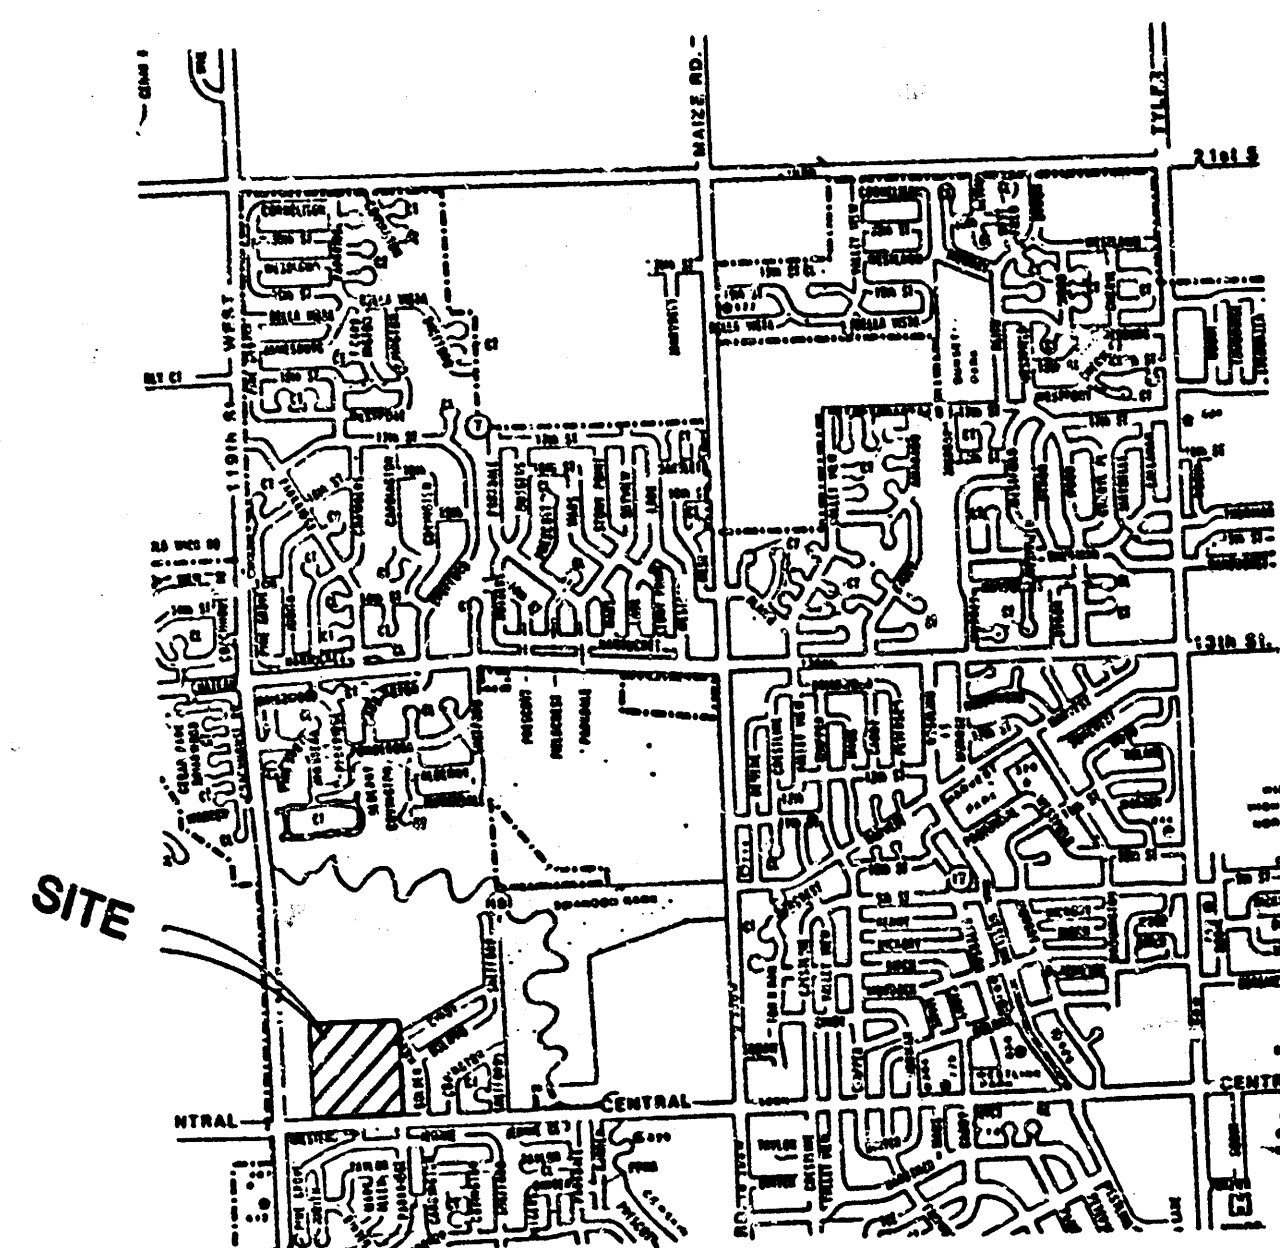


LOCATION MAP

1" = 40'
PROFILE SCALE
1" = 40' H.
1" = 5' V.

B.M.
"D" 3 End of S.E. Curb
Return at Milstead & Delano
Elev. = 160.51


CENTRAL AVE.

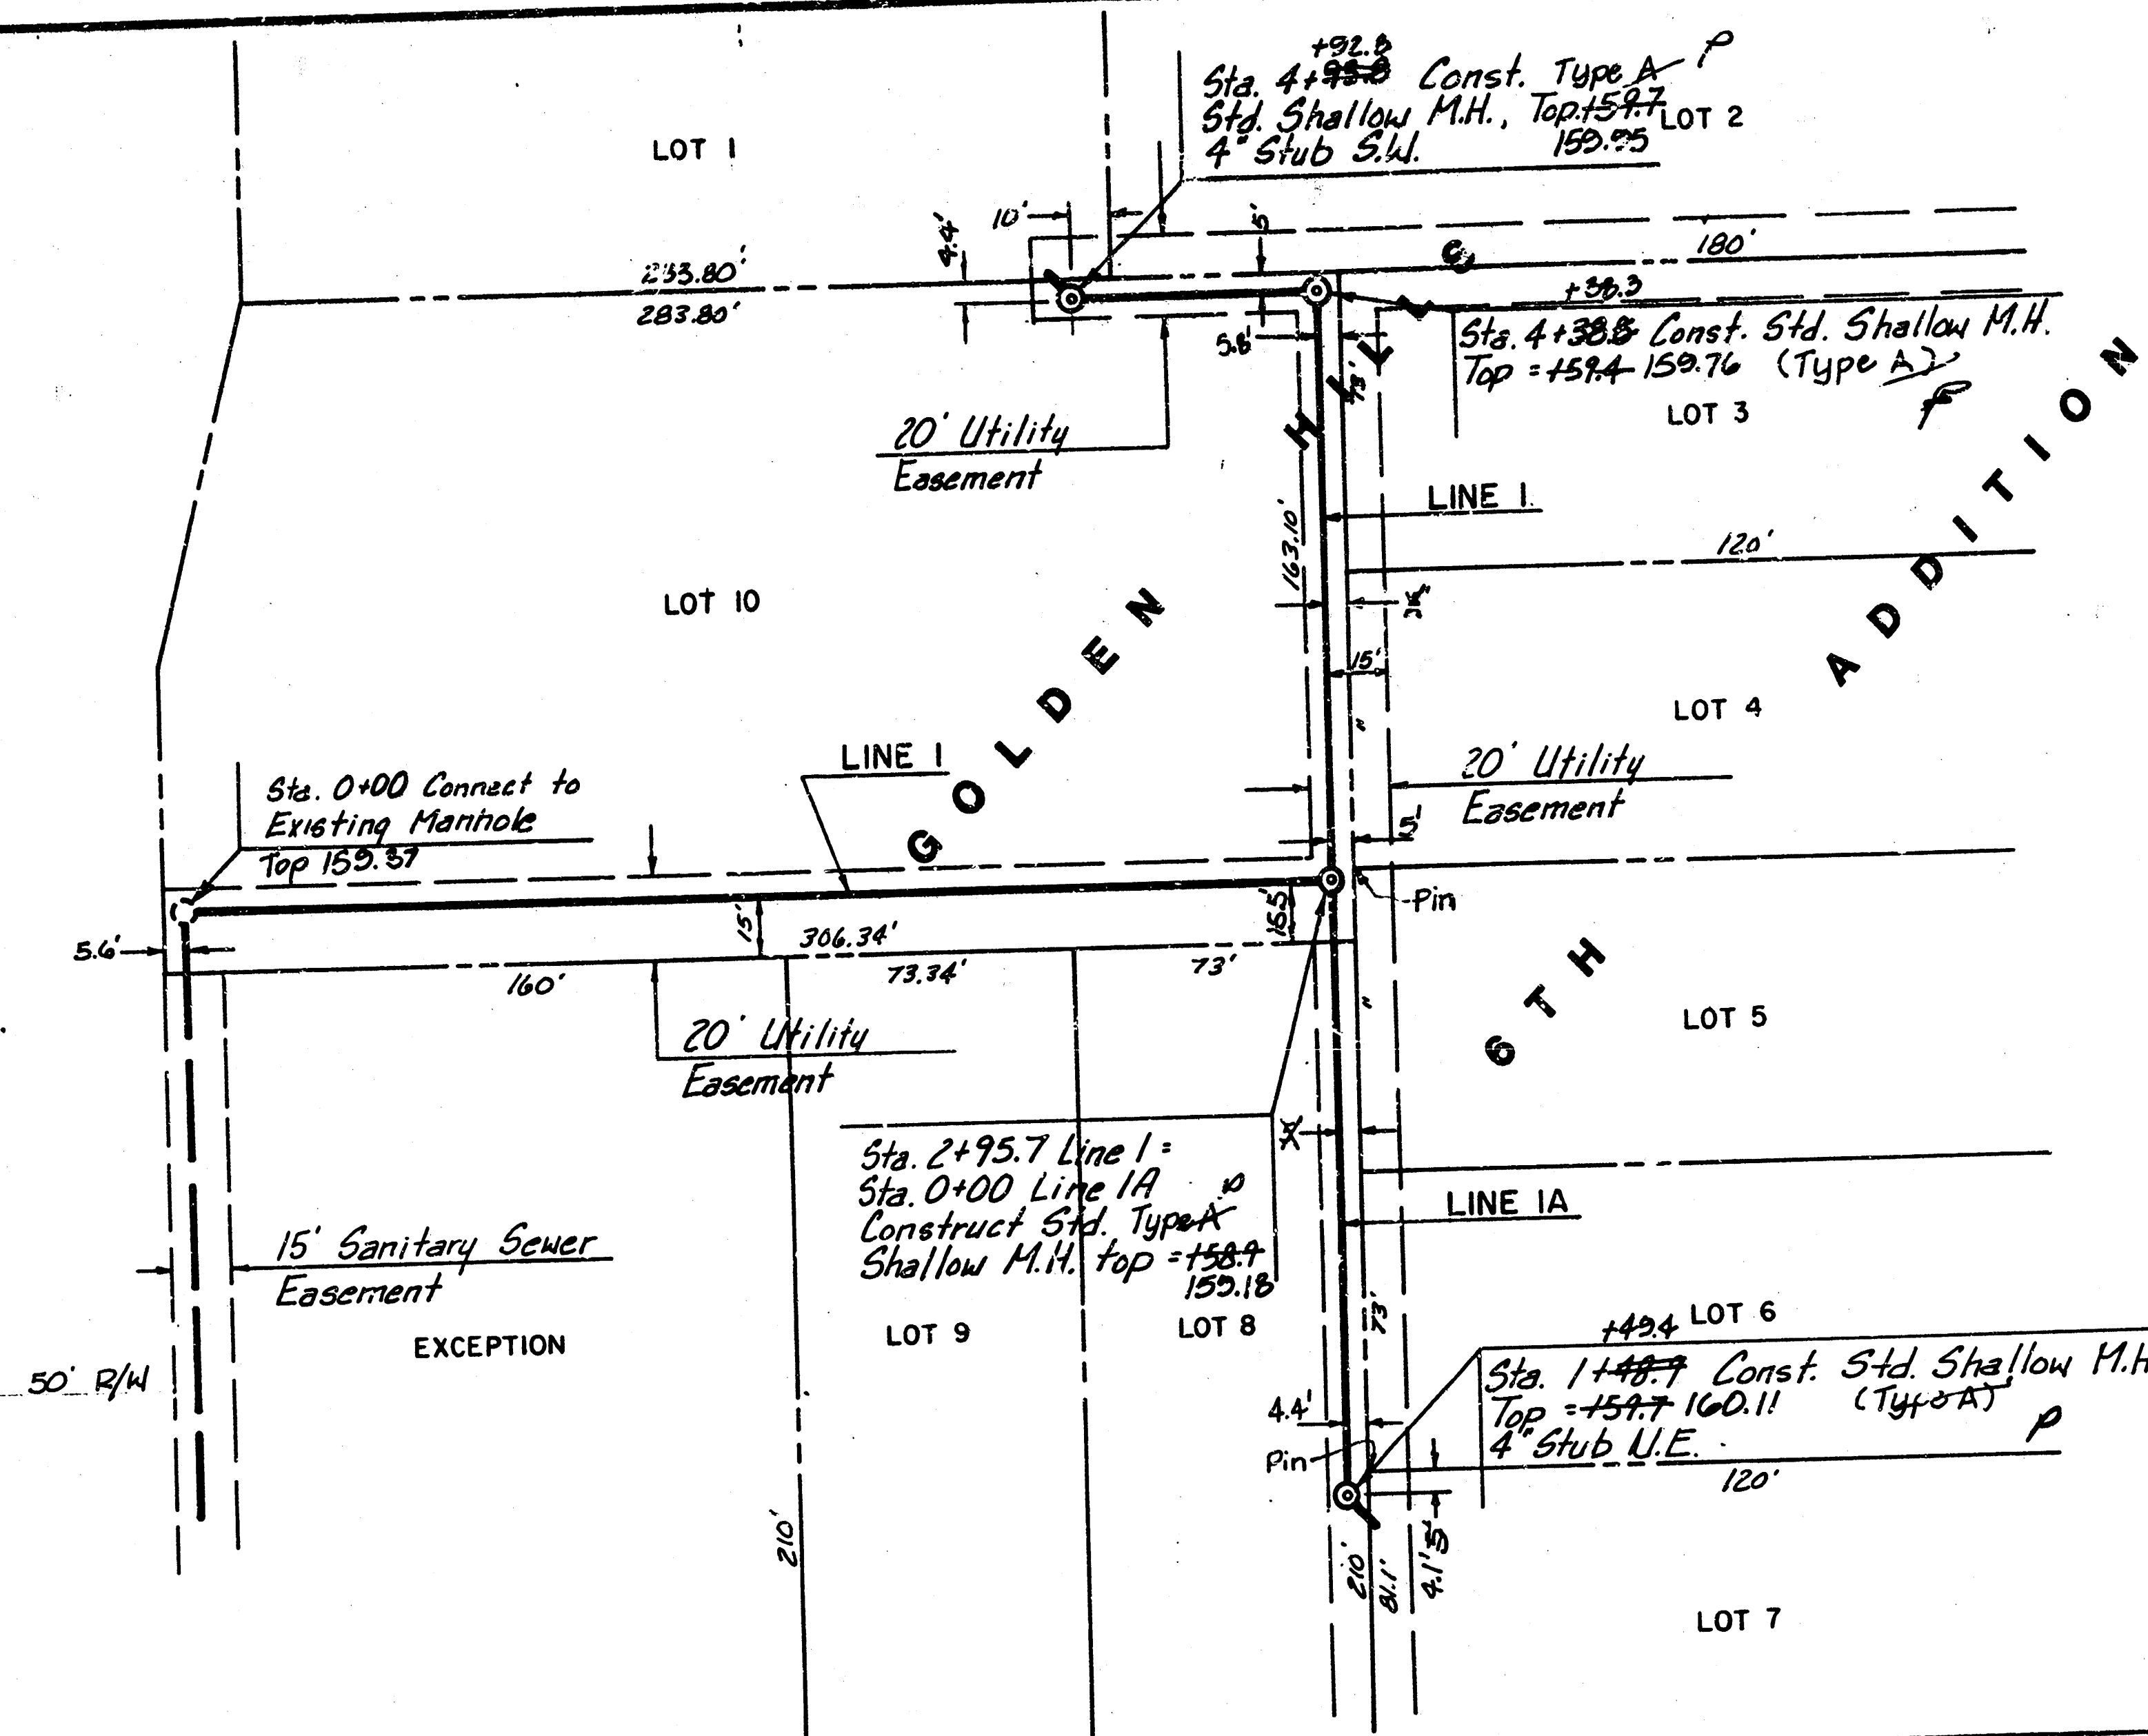

GENERAL NOTES

1. The Contractor shall be responsible for preserving property irons. The Contractor will be required to re-establish any property irons which are damaged or destroyed by his construction operations. Such irons shall be re-established by a licensed land surveyor in accordance with state laws.
2. Manholes to be constructed on this project are to be Standard Type "A" Shallow.
3. Traffic will not be affected by this project.
4. Construction of this project shall comply with the latest revision of the City of Wichita PROCEDURE FOR CONSTRUCTION OF PUBLIC WORKS PROJECTS BY PRIVATE CONTRACT.


Booked
2-90
RPL

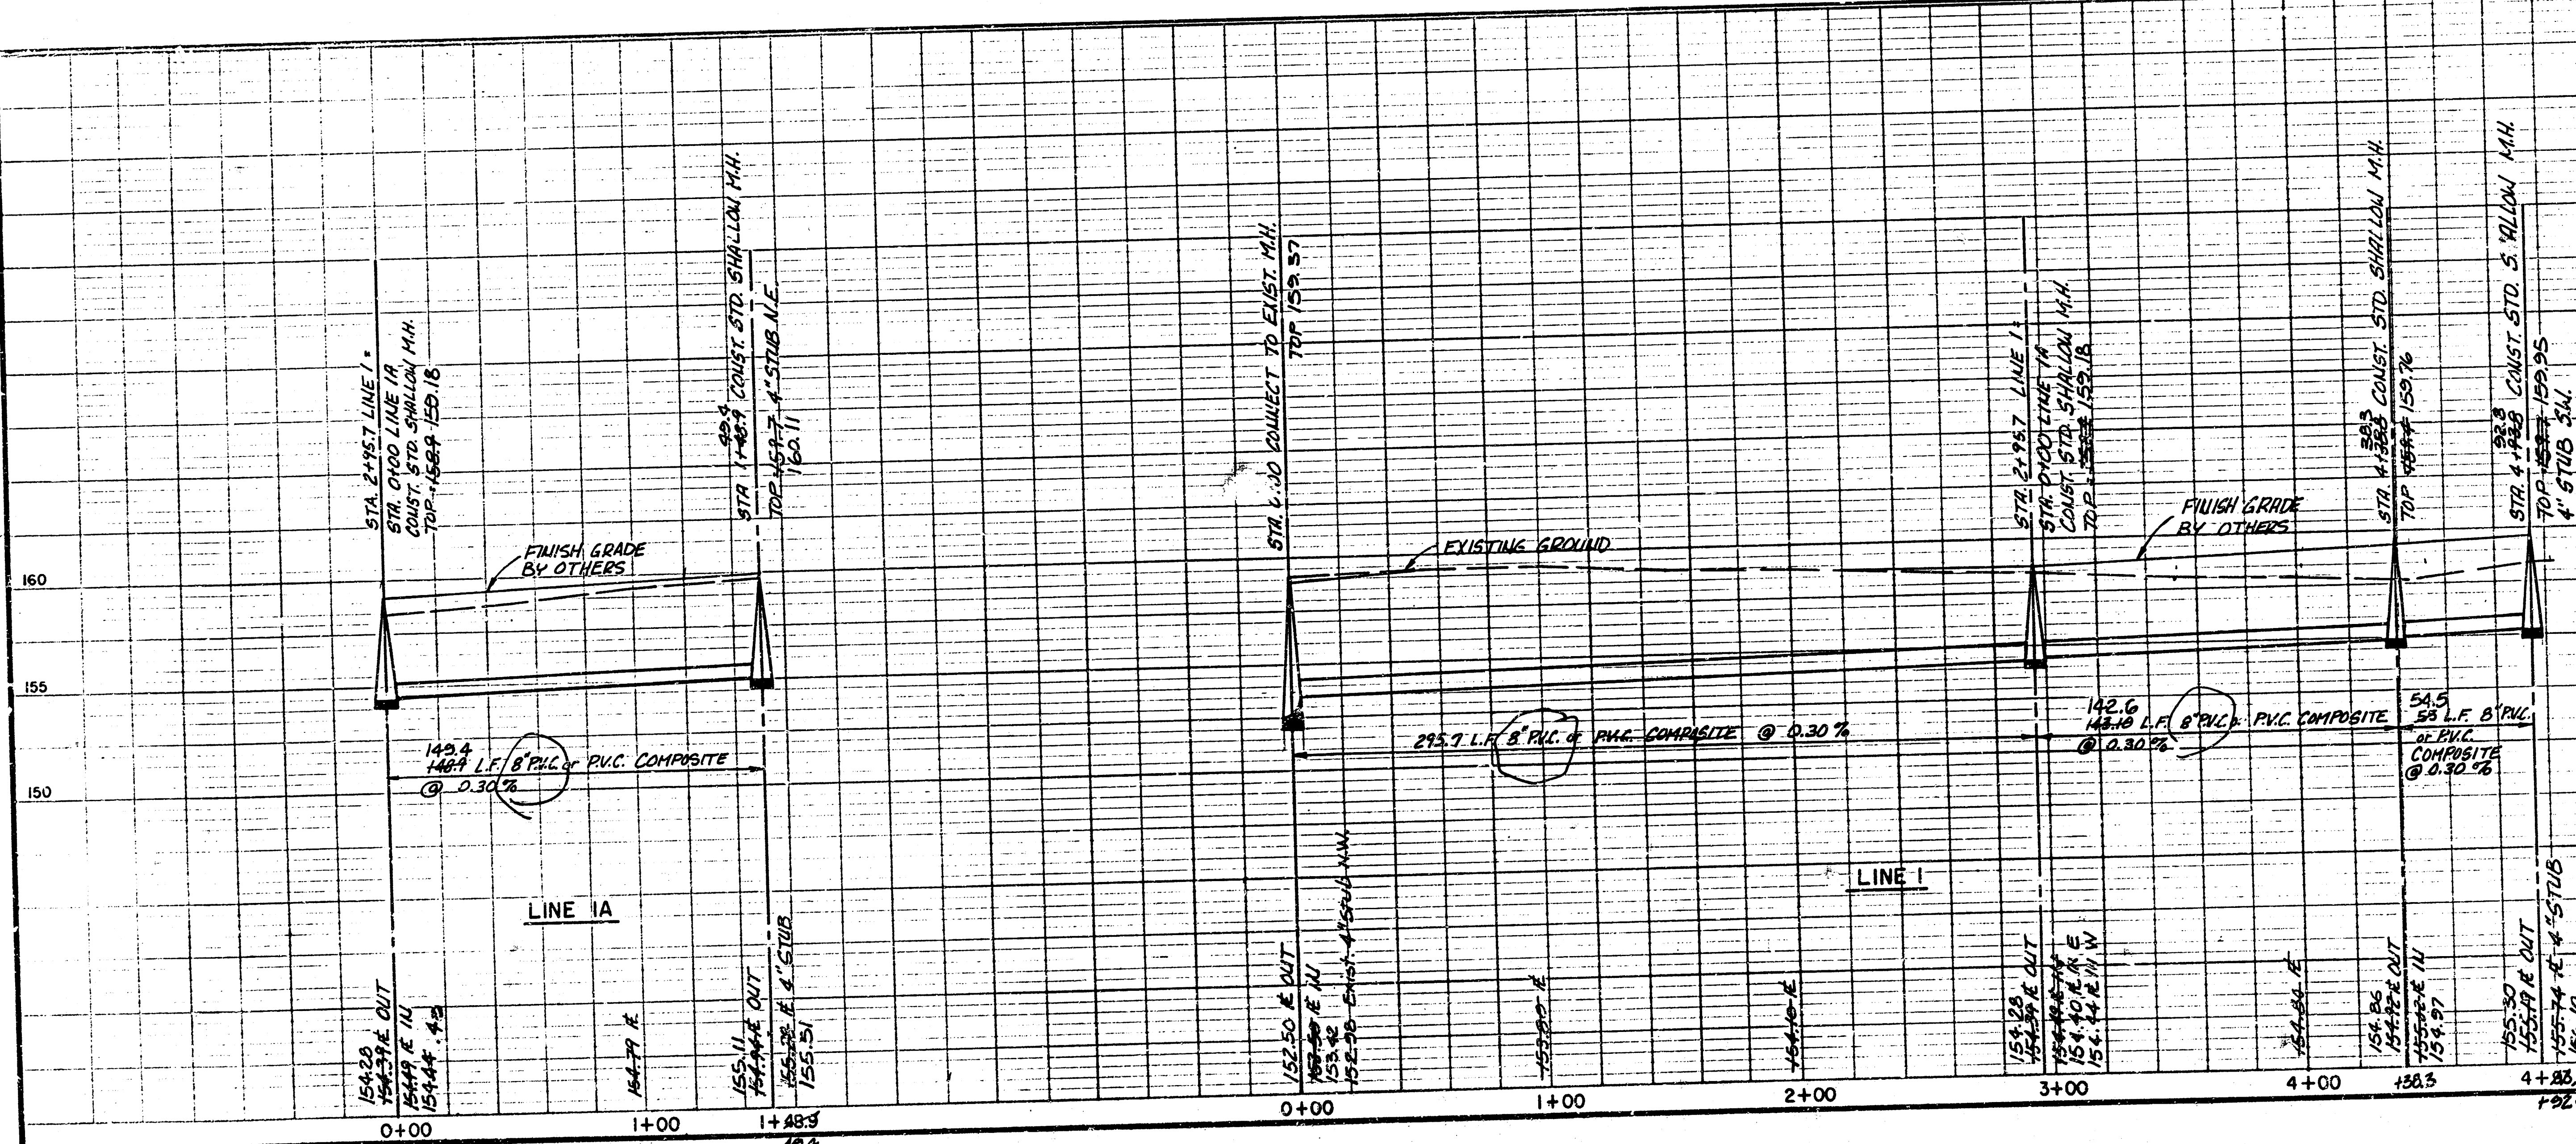

APPROVED AS NOTED
By CITY ENGINEER OF WICHITA
Sanitary Sewers *[Signature]* 1/18/89
Storm Sewers
Driveway Approaches
Water Mains
Paving

NOTE TO CONTRACTOR
INSPECTION AND TESTING FOR THIS PROJECT IS TO BE PROVIDED BY A LICENSED CONSULTING ENGINEERING FIRM UNDER CONTRACT WITH THE OWNER/DEVELOPER. SAID INSPECTION TO BE IN ACCORDANCE WITH THE CITY OF WICHITA STANDARD CONSTRUCTION ENGINEERING PRACTICES AND CERTIFIED BY A LICENSED PROFESSIONAL ENGINEER. NO WORK SHALL BE PERFORMED IN DEDICATED EASEMENTS OR PUBLIC RIGHT-OF-WAY BY THE CONTRACTOR WITHOUT SUCH INSPECTION NOR SHALL ANY WORK BE COMMENCED WITHOUT WRITTEN AUTHORIZATION BY THE CITY ENGINEER.

Revised as built 12-21-89 TCR

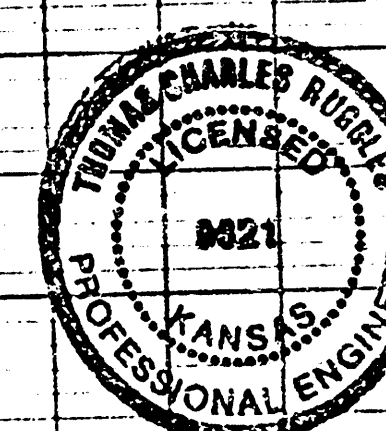


PRIVATE SANITARY SEWER TO SERVE
GOLDEN HILLS 6TH ADDITION
WICHITA, KANSAS

BAUGHMAN COMPANY, P.A.
SURVEYING & ENGINEERING
316250-7211 • 315 GILLS • WICHITA, KANSAS 67211
Design: TCR Drawn: DSN Approved: Date: 9-14-89 Scale: NOTED

INDEX CODE 225 PPS 607853

89-09-C968

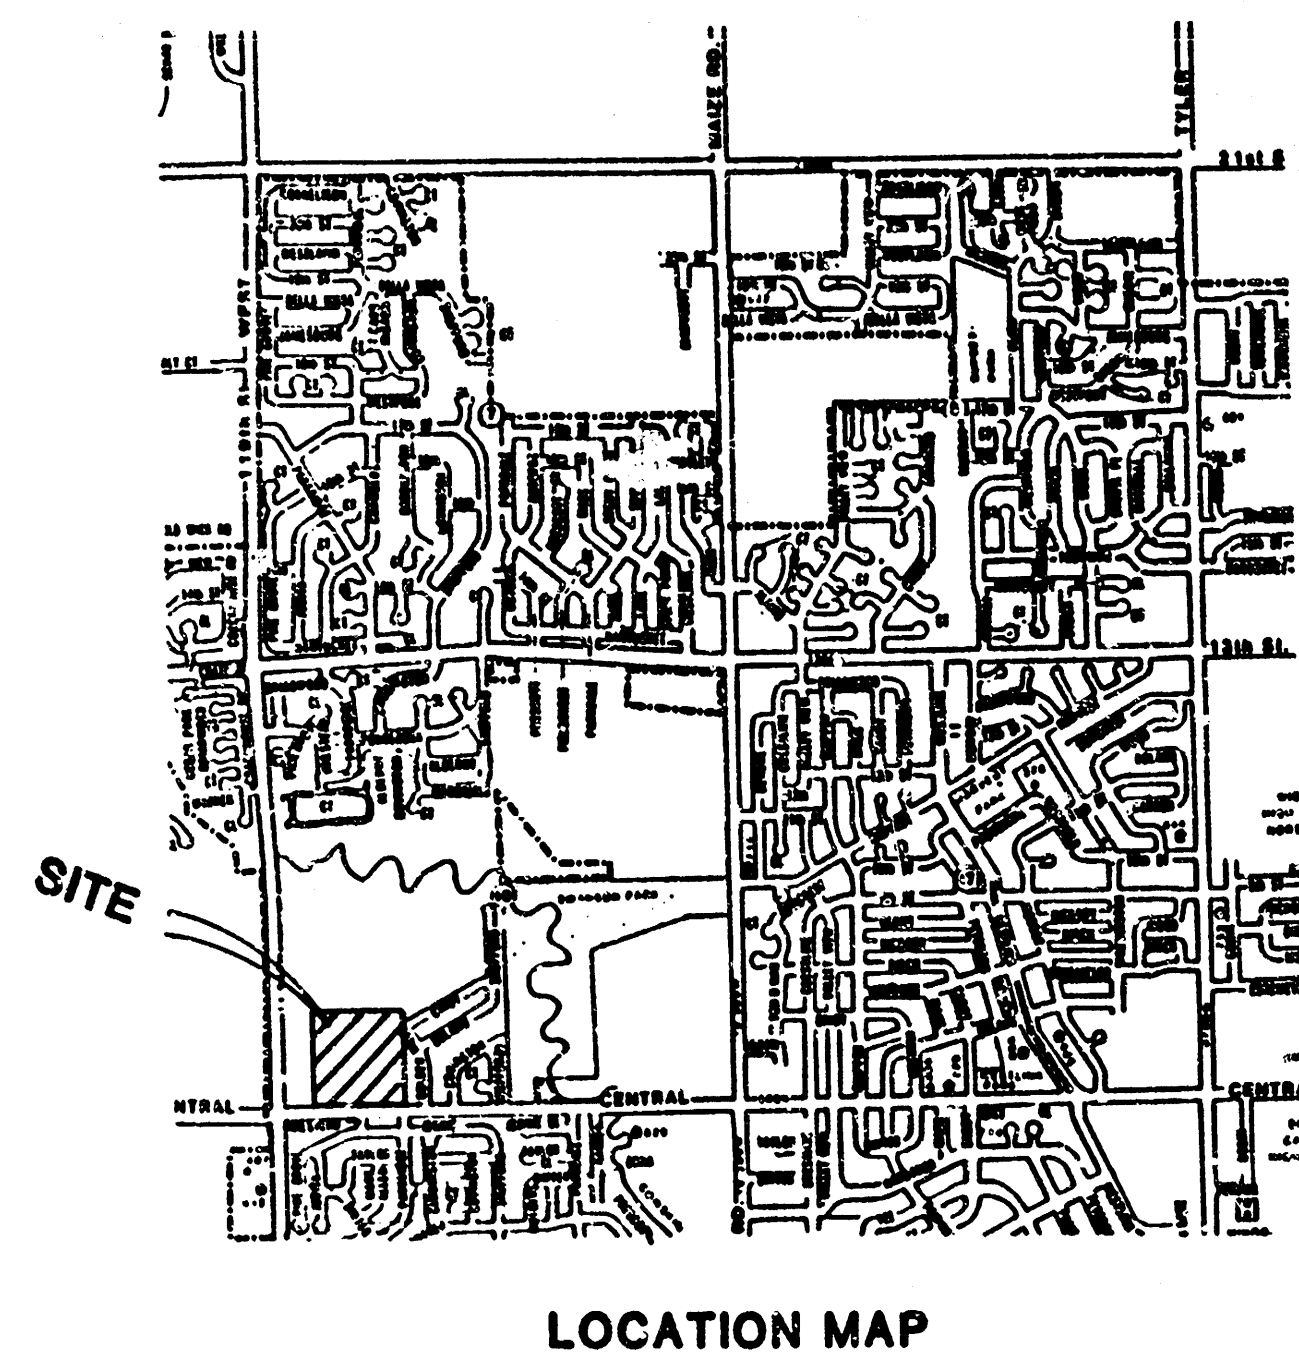


LOCATION MAP

B.M.
"S" S. End of S.E. Curb
Return at Milstead & Delano
Elev. = 160.51

1" = 40'


PROFILE SCALE
1" = 40' H.
1" = 5' V.

6th CENTRAL AVE.

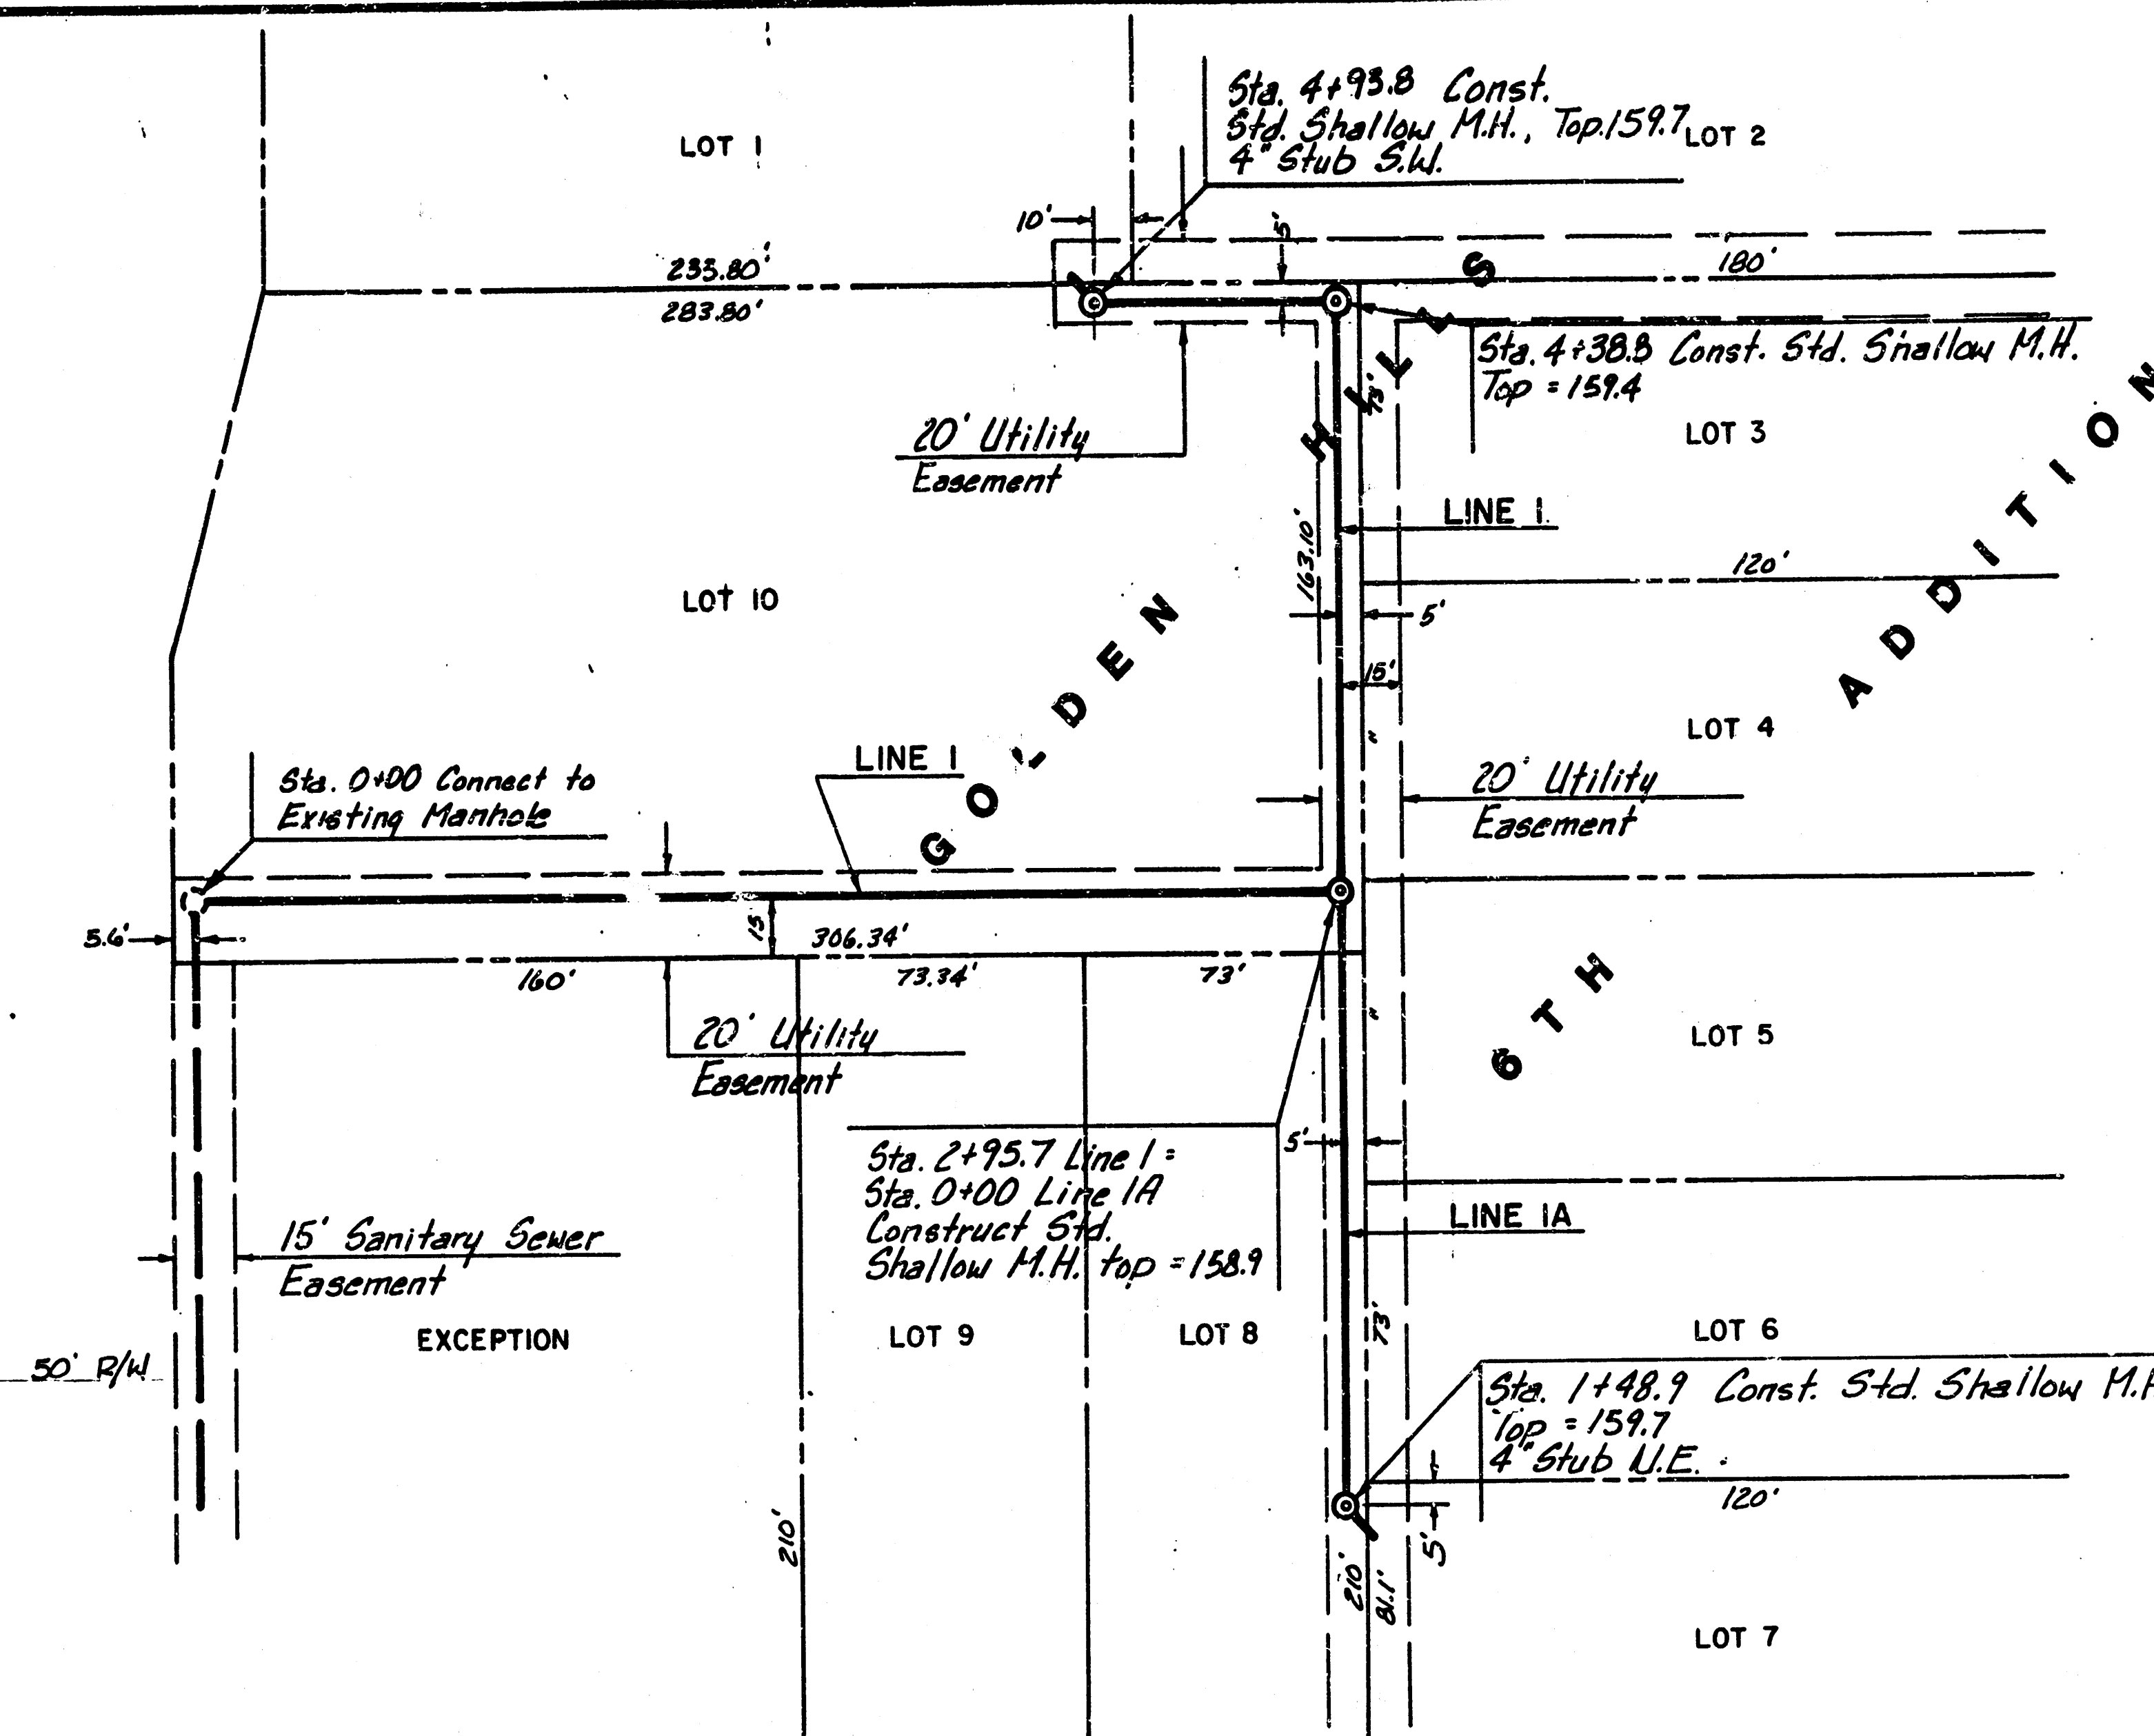

GENERAL NOTES

1. The Contractor shall be responsible for preserving property irons. The Contractor will be required to re-establish any property irons which are damaged or destroyed by his construction operations. Such irons shall be re-established by a licensed land surveyor in accordance with state laws.
2. Manholes to be constructed on this project are to be Standard Type "A" Shallow.
3. Traffic will not be affected by this project.
4. Construction of this project shall comply with the latest revision of the City of Wichita PROCEDURE FOR CONSTRUCTION OF PUBLIC WORKS PROJECTS BY PRIVATE CONTRACT.

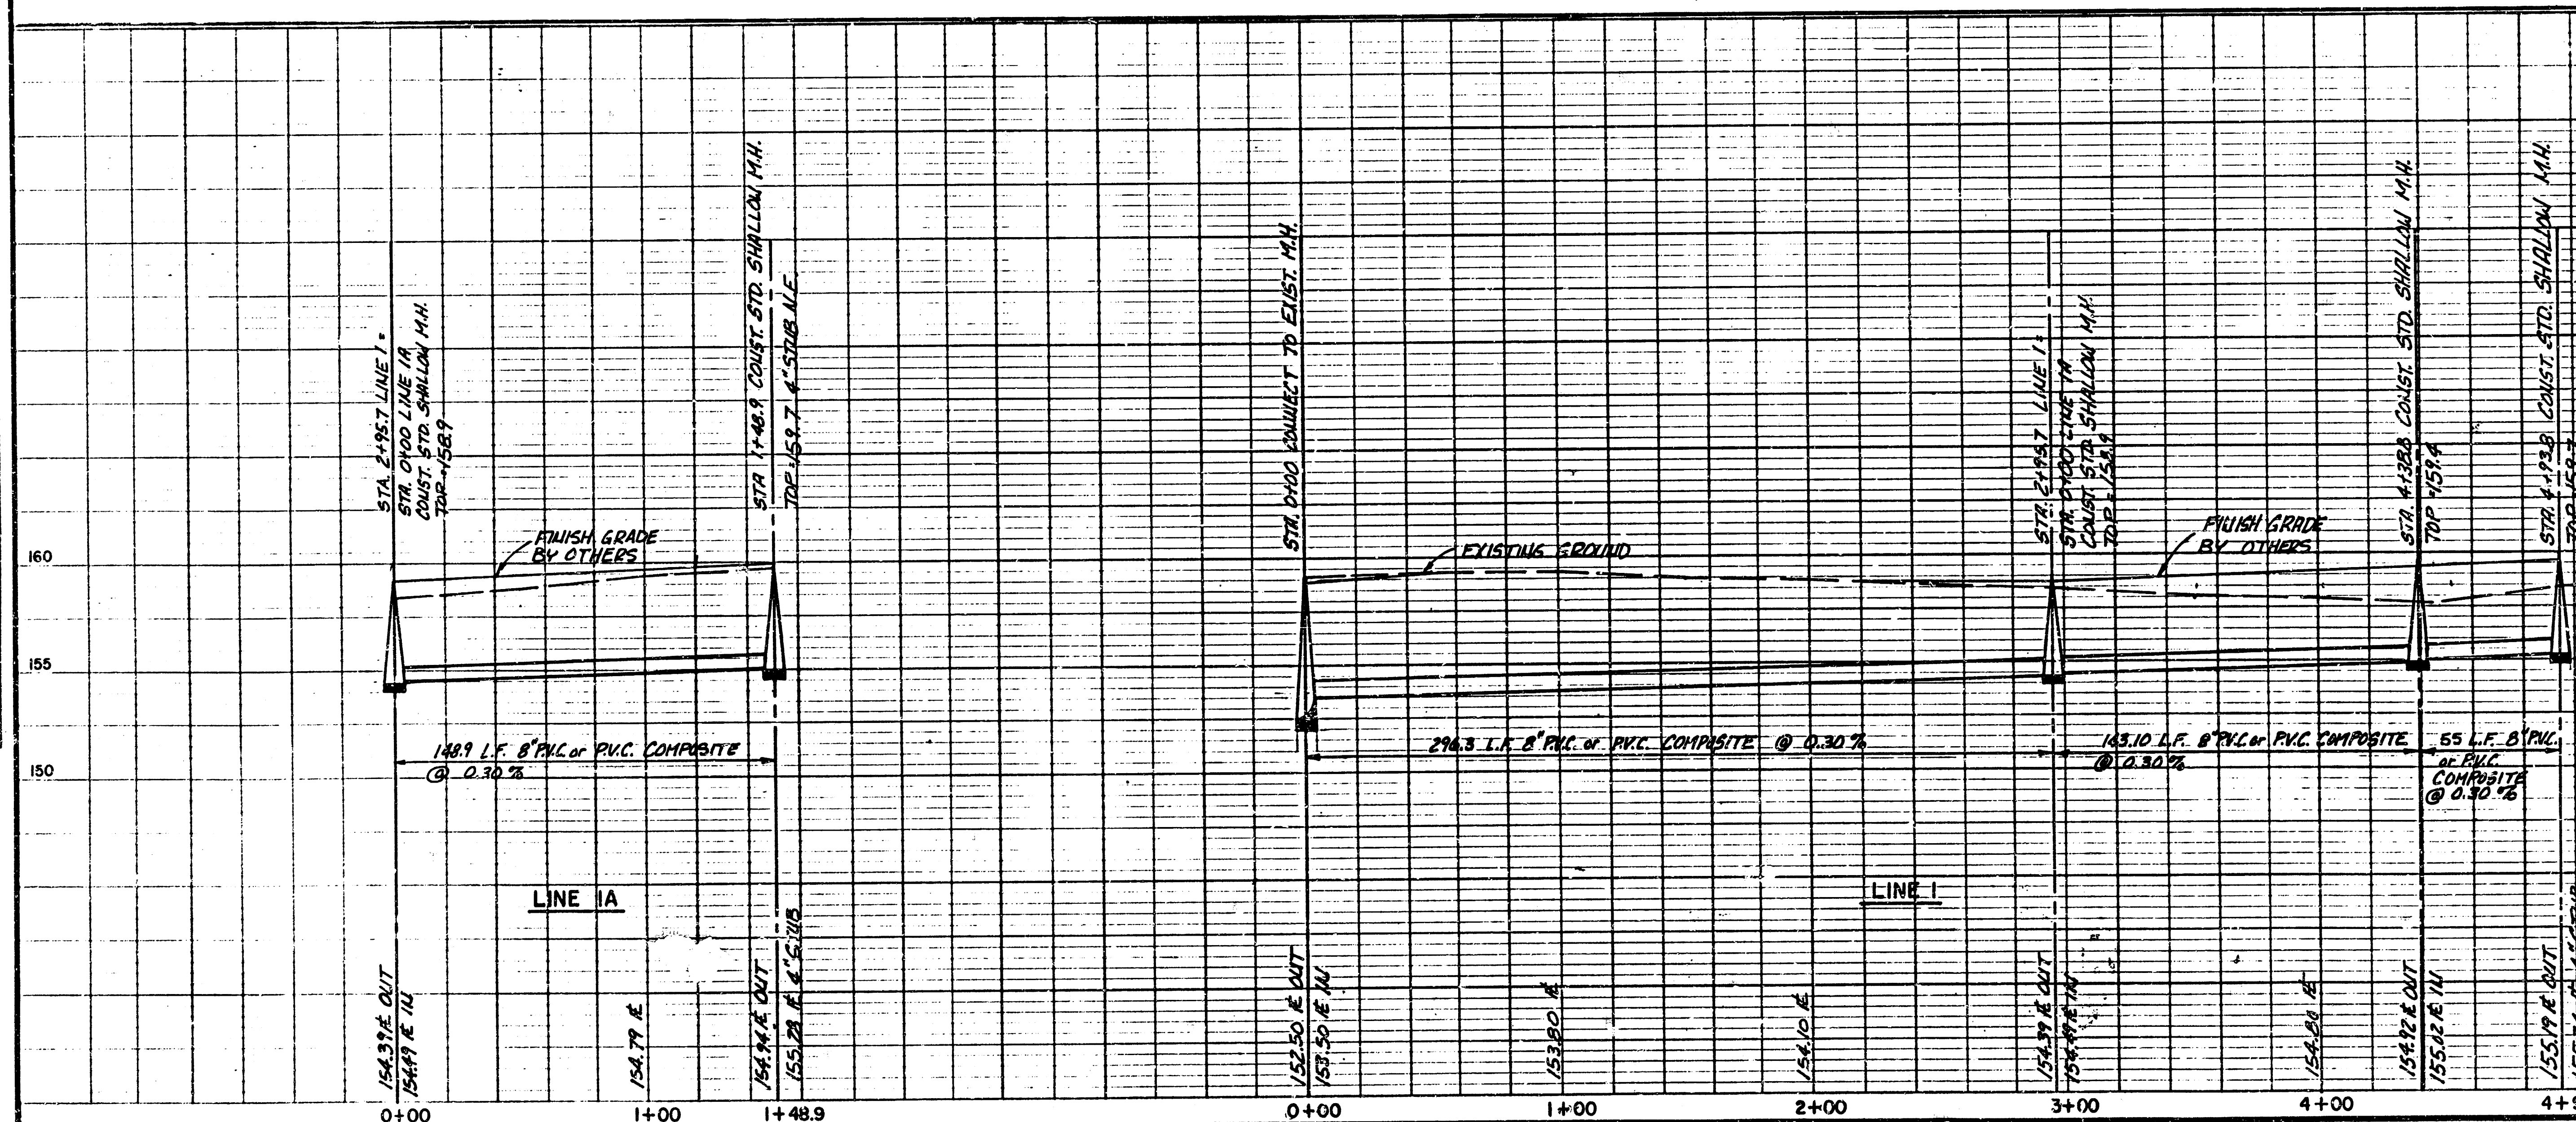


APPROVED AS NOTED
By CITY ENGINEER OF WICHITA

Sanitary Sewer *22-2/7/80*
Storm Sewers
Driveway Approaches
Water Mains
Paving

NOTE TO CONTRACTOR

INSPECTION AND TESTING FOR THIS PROJECT IS TO BE PROVIDED BY A LICENSED CONSULTING ENGINEERING FIRM UNDER CONTRACT WITH THE OWNER/DEVELOPER. SAID INSPECTION TO BE IN ACCORDANCE WITH THE CITY OF WICHITA STANDARD CONSTRUCTION-ENGINEERING PRACTICES AND CERTIFIED BY A LICENSED PROFESSIONAL ENGINEER. NO WORK SHALL BE PERFORMED IN DEDICATED EASEMENTS OR PUBLIC RIGHT-OF-WAY BY THE CONTRACTOR WITHOUT SUCH INSPECTION NOR SHALL ANY WORK BE COMMENCED WITHOUT WRITTEN AUTHORIZATION BY THE CITY ENGINEER.

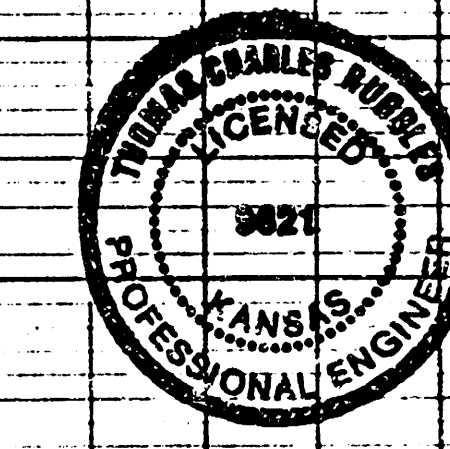

PRIVATE SANITARY SEWER TO SERVE
GOLDEN HILLS 8TH ADDITION
WICHITA, KANSAS

BAUGHMAN COMPANY, P.A.
SURVEYING & ENGINEERING
310222-7271 • 315 ELLIS • WICHITA, KANSAS 67211
Design: TCR Drawn: DSN Approved: Date: 9-14-89 Scale: NOTED

INDEX CODE 225 PPS 607853

10 2 3 3 1/2

FILMED FROM THE BEST AVAILABLE COPY