

SCALE 1" = 60'

— SANITARY SEWER PLAN —
 GREEN ACRES MOBILE HOME PARK
 4480 S. MERIDIAN
 522-6454
 WICHITA, KS. 67217

*Install 4-8" V.C.P. & 6-4" V.C.P.
 @ Owners Request & Location*

NOTE TO CONTRACTOR
 This project will be constructed under the supervision of the CITY ENGINEER and conform to the SPECIFICATIONS of the CITY OF WICHITA. The CONTRACTOR will reimburse the City of Wichita for all Sanitary Engineering Plans, and Inspections.

*Submit As Built Plans
 Showing location of all V's
 installed & changes in Orig. Plan*

B.M. Ch. 'c' on Sidewalk
 50' East of N.E. Corner of
 Swimming Pool
 M.S.L. Elev. 1280.84
 C.of H. Elev. 93.44


APPROVED AS NOTED
 By CITY ENGINEER OF WICHITA
 Sanitary Sewer Plans 3-26-73
 Storm Sewers
 Driveway Approaches
 Prod. No. BHEB503019

GREEN ACRES MOBILE HOME RESORT
LOCATIONS SAN SEWERS SHEET 2 of 2

LINE #7	NOTE	LINE #8	NOTE	LINE #9	NOTE
0+00	HT	0+00	HT	0+00	HT
0+38	Y	1+00	Y	0+20	Y
0+88	Y	2+43	HT	1+10	Y
1+28	Y	2+05	Y	1+72	Y
1+58	Y	3+00	Y	2+22	Y
2+88	Y	4+00	Y	2+72	Y
3+28	Y	4+50	Y	3+22	Y
3+78	Y	5+00	Y	3+72	Y
4+28	Y	5+50	Y	4+22	Y
4+78	Y	5+72	HT	4+72	Y
5+28	Y			5+22	Y
5+78	Y			5+72	Y
6+28	Y			6+22	Y
6+78	Y			6+72	Y
7+28	Y			7+22	Y
8+00	HT			8+00	HT

GREEN ACRES MOBILE HOME RESORT
LOCATIONS SAN SEWERS

LINE #1	NOTE	LINE #3	NOTE	LINE #5	NOTE
0+00	HT	0+00	HT	0+00	HT
0+08	Y	0+31	Y	0+49	Y
0+58	Y	0+31	Y	0+98	Y
1+08	Y	1+31	Y	1+47	Y
1+58	Y	1+31	Y	1+96	Y
2+08	Y	2+31	Y	2+00	HT
2+58	Y	2+31	Y		
3+08	Y	3+31	Y	LINE #6	
3+58	Y	3+31	Y	0+00	HT
4+20	HT	4+31	Y	0+49	Y
4+55	Y	4+31	Y	0+98	Y
5+09	Y	5+10	HT	1+47	Y
5+59	Y			1+96	Y
6+09	Y	LINE #4		2+45	Y
6+85	Y			2+94	Y
8+09	HT	0+00	HT	2+94	Y
		0+20	Y	3+43	Y
		0+70	Y	3+92	Y
		1+20	Y	4+30	HT
		1+70	Y		
		2+20	Y		
		2+70	Y		
		3+20	Y		
		3+70	Y		
		4+20	Y		
		5+15	Y		
		5+25	HT		

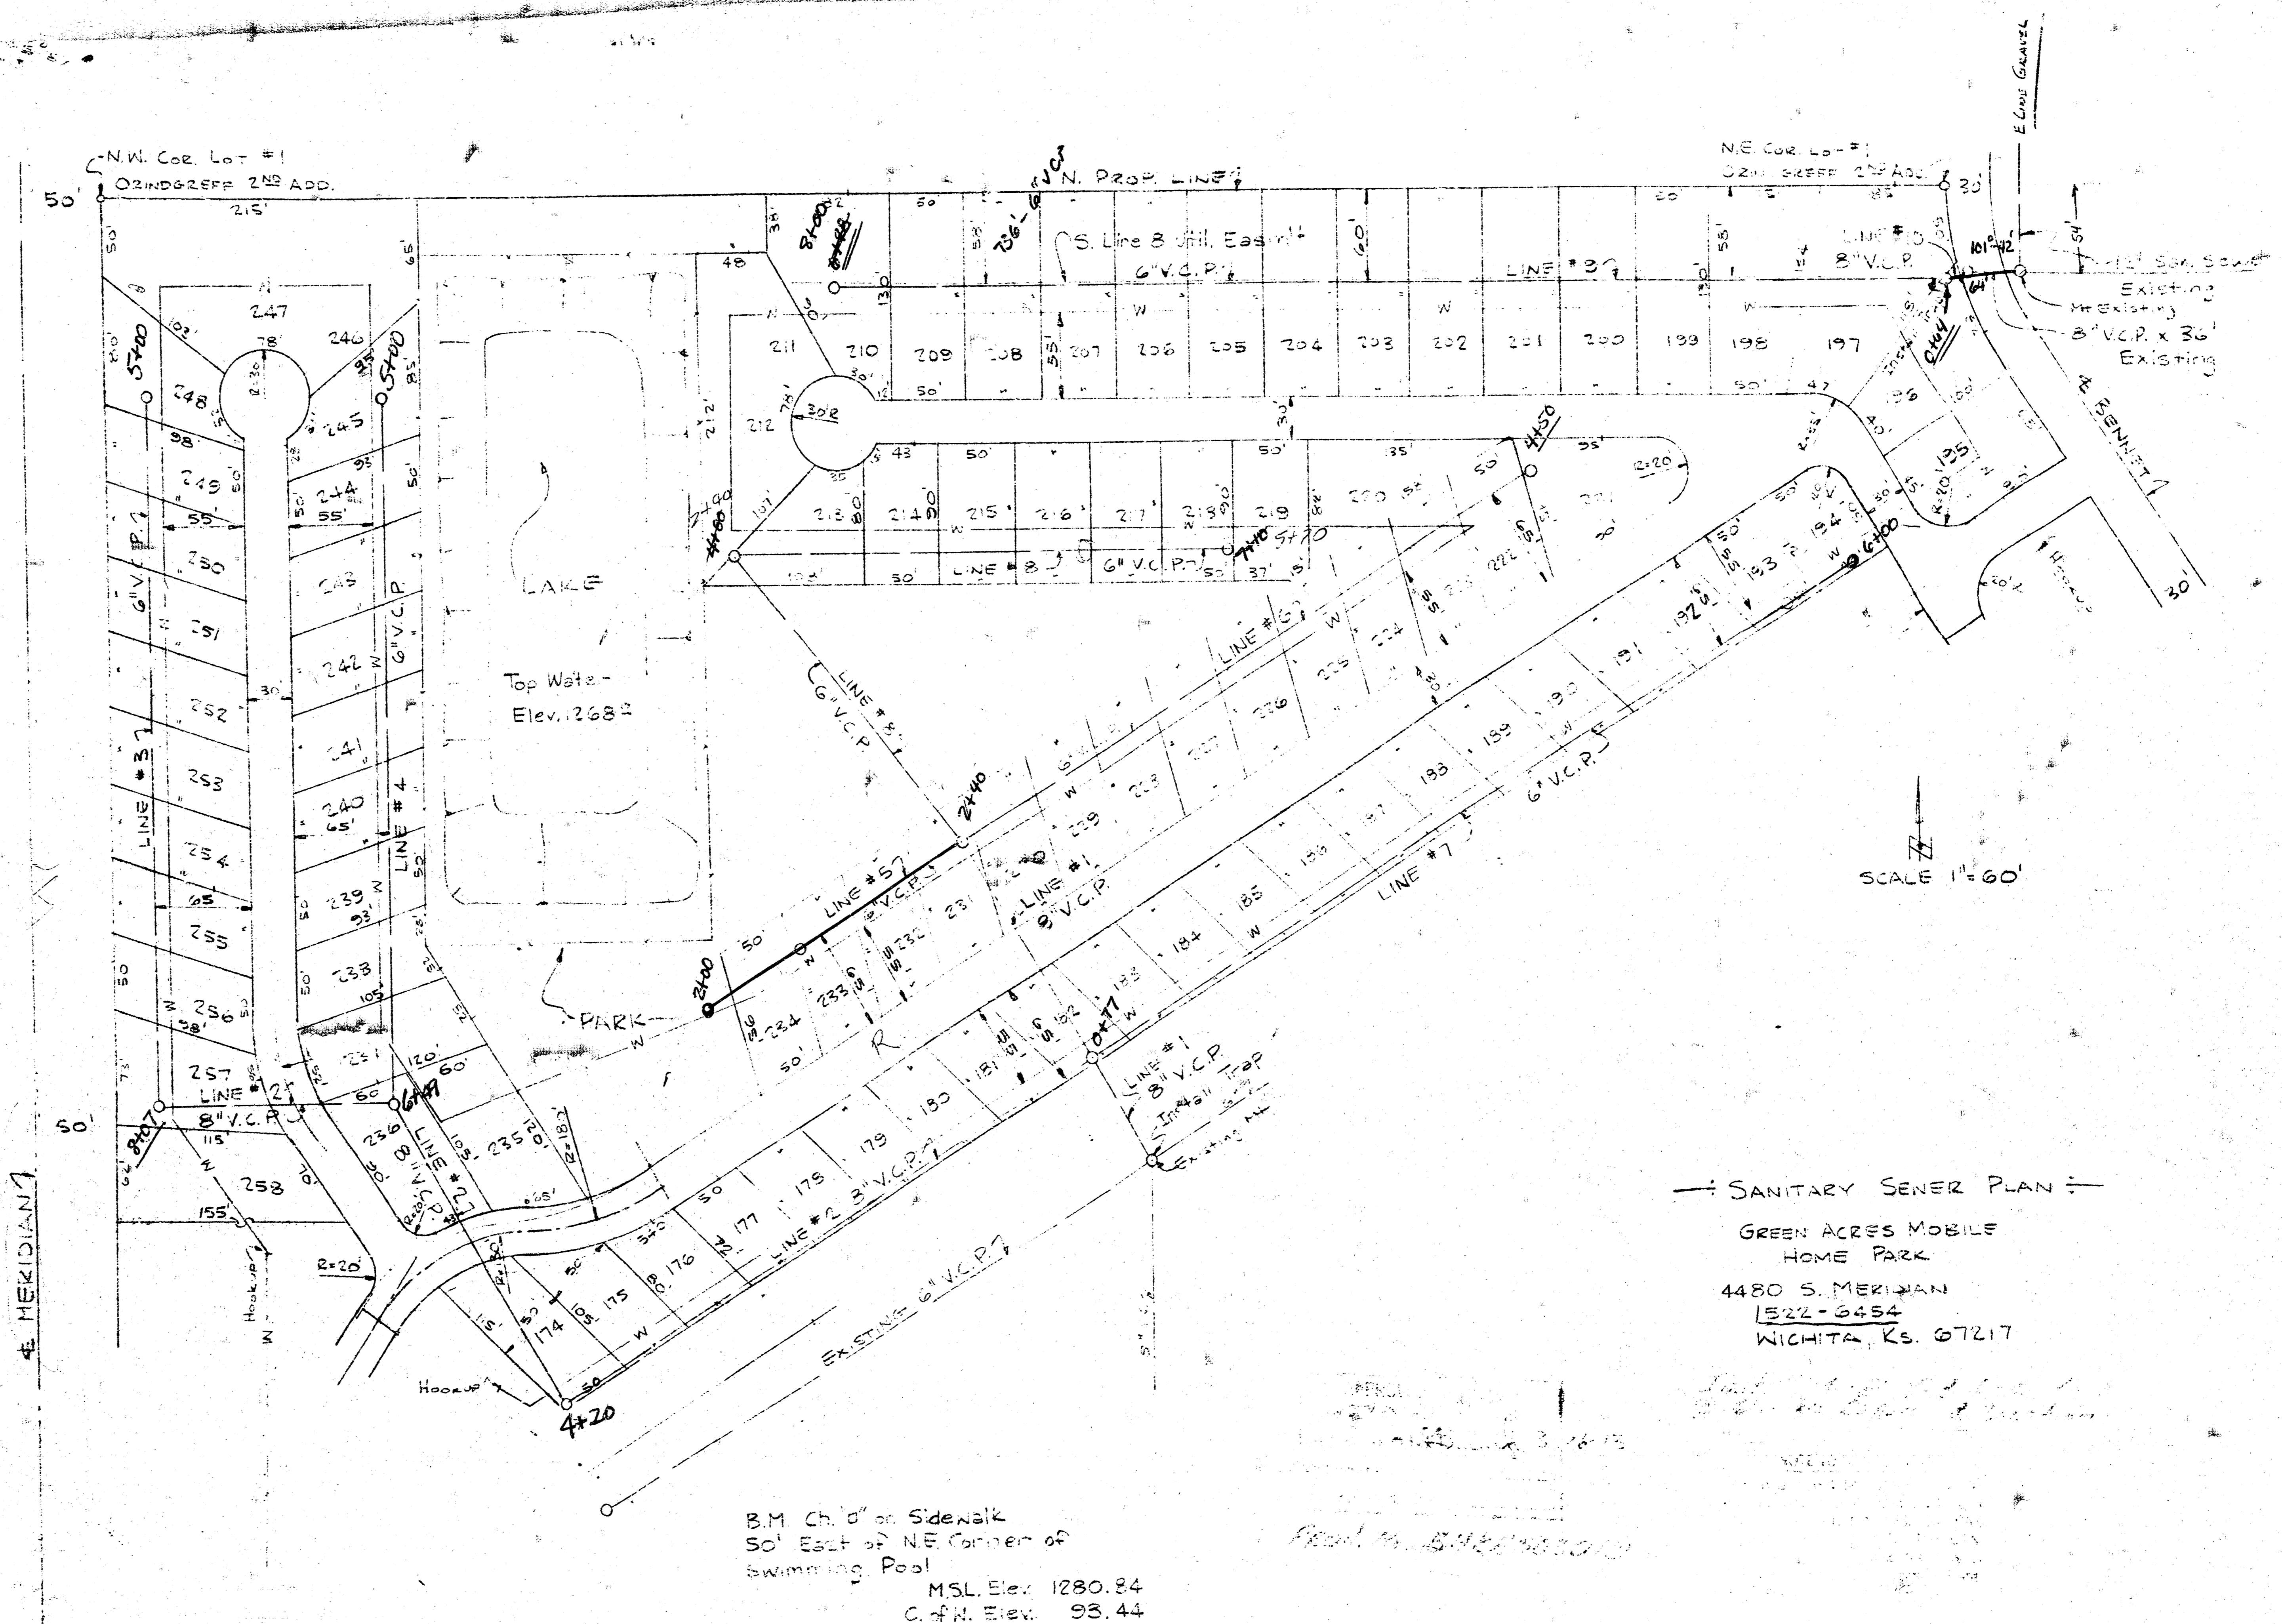

— SANITARY SEWER PLAN —
GREEN ACRES MOBILE HOME PARK
4480 S. MERIDIAN
1522-3454
WICHITA, KS. 67217

B.M. Ch. 0' on Sidewalk
50' East of NE Corner of
Swimming Pool
MSL Elev. 1280.84
C.F.M. Elev. 98.44

*As Built Plans
Green Acres Mobile Homes
H.C. Ladd*