



1. M. # 2 17.26 "A" cut S.W. cor. 4' x 4' S.W.S.
 M.H. 24' N. of N. cb. Hiway 54 & 46' E. of
 W. L. K. T. A. R/W.

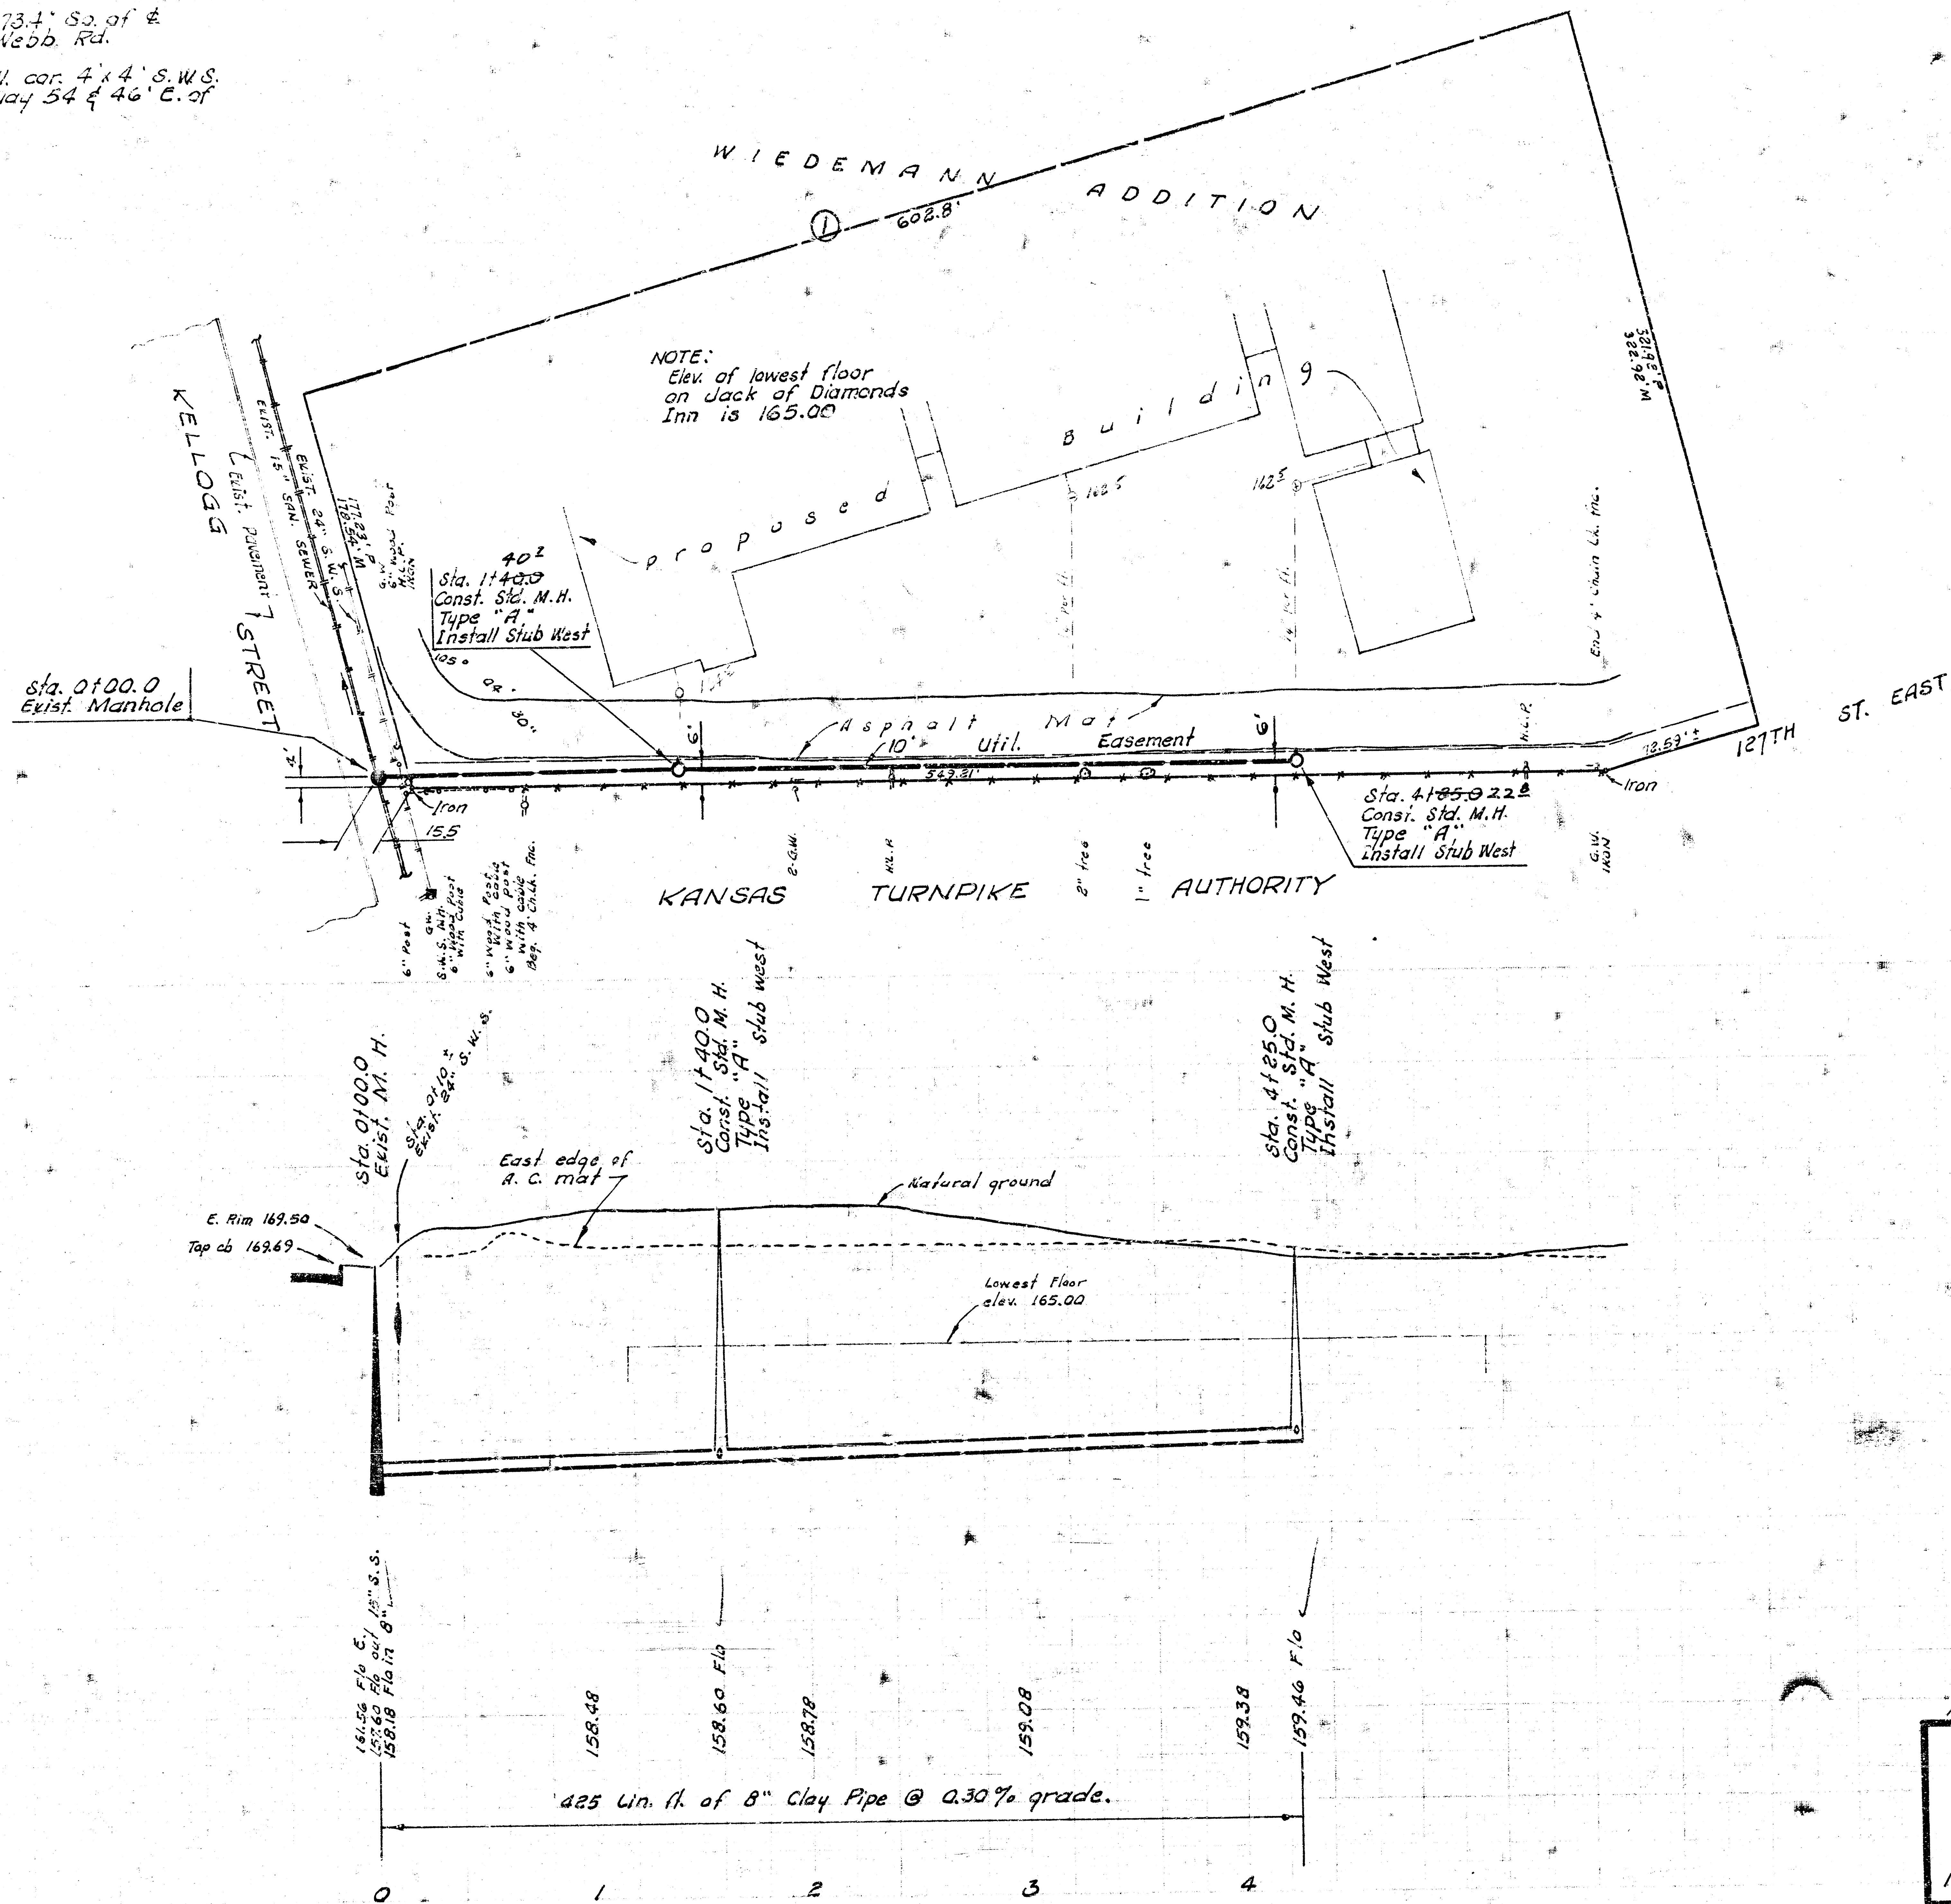

Plan Scale 1" = 40'
 Profile Scale 1" = 40' horiz.
 1" = 5' Vert.

NOTE TO CONTRACTOR
 This project will be constructed under
 the supervision of the CITY ENGINEER
 and conforming to the SPECIFICATIONS
 of the CITY OF WICHITA. The CON-
 TRACTOR will reimburse the City of
 Wichita for all cost of Engineering, Plans,
 and Inspection.

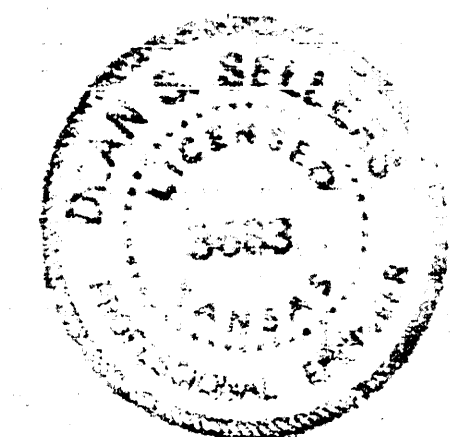

"As Built" Final Measurements I.H.-78

JACK OF DIAMONDS INN
PRIVATE SANITARY SEWER
N. W. KELLOGG ST. & K. T. A.
CITY OF WICHITA, KANSAS
R. W. LINN - CITY ENGINEER
MARCH 1973 - PROJECT NO. BHK5030