

JEFF

LOT 5

0+93.8 A.B.
STA. 0+93.8-0; Line;
Const. Std. Type "C" or "P"
Manhole, Top Elev. = 195.75

20' of Conc. Encasement
10' either side of C. 54" R.C.P.
Cradle 54" R.C.P. w/ Reinf Conc. (see detail)

UTILITY EASEMENT

JAY

20'

5'

90°

1

THIRD

PROPOSED PARKING

LOT 3

ADDITION

LOT 4

LEGEND
A.B. = As Built

STA. 0+00, Line 1
Const. Std. Type "C" or "P"
Manhole, Top Elev. = 196.00

190.6'

78.7'

5'

20' UTILITY EASEMENT

Exist. 8" Sanitary Sw

Exist. 54" R.C.P.



20' UTILITY EASEMENT

NORTH

29TH STREET

€ ROCK RD. B.M.

PROP. BLDG.

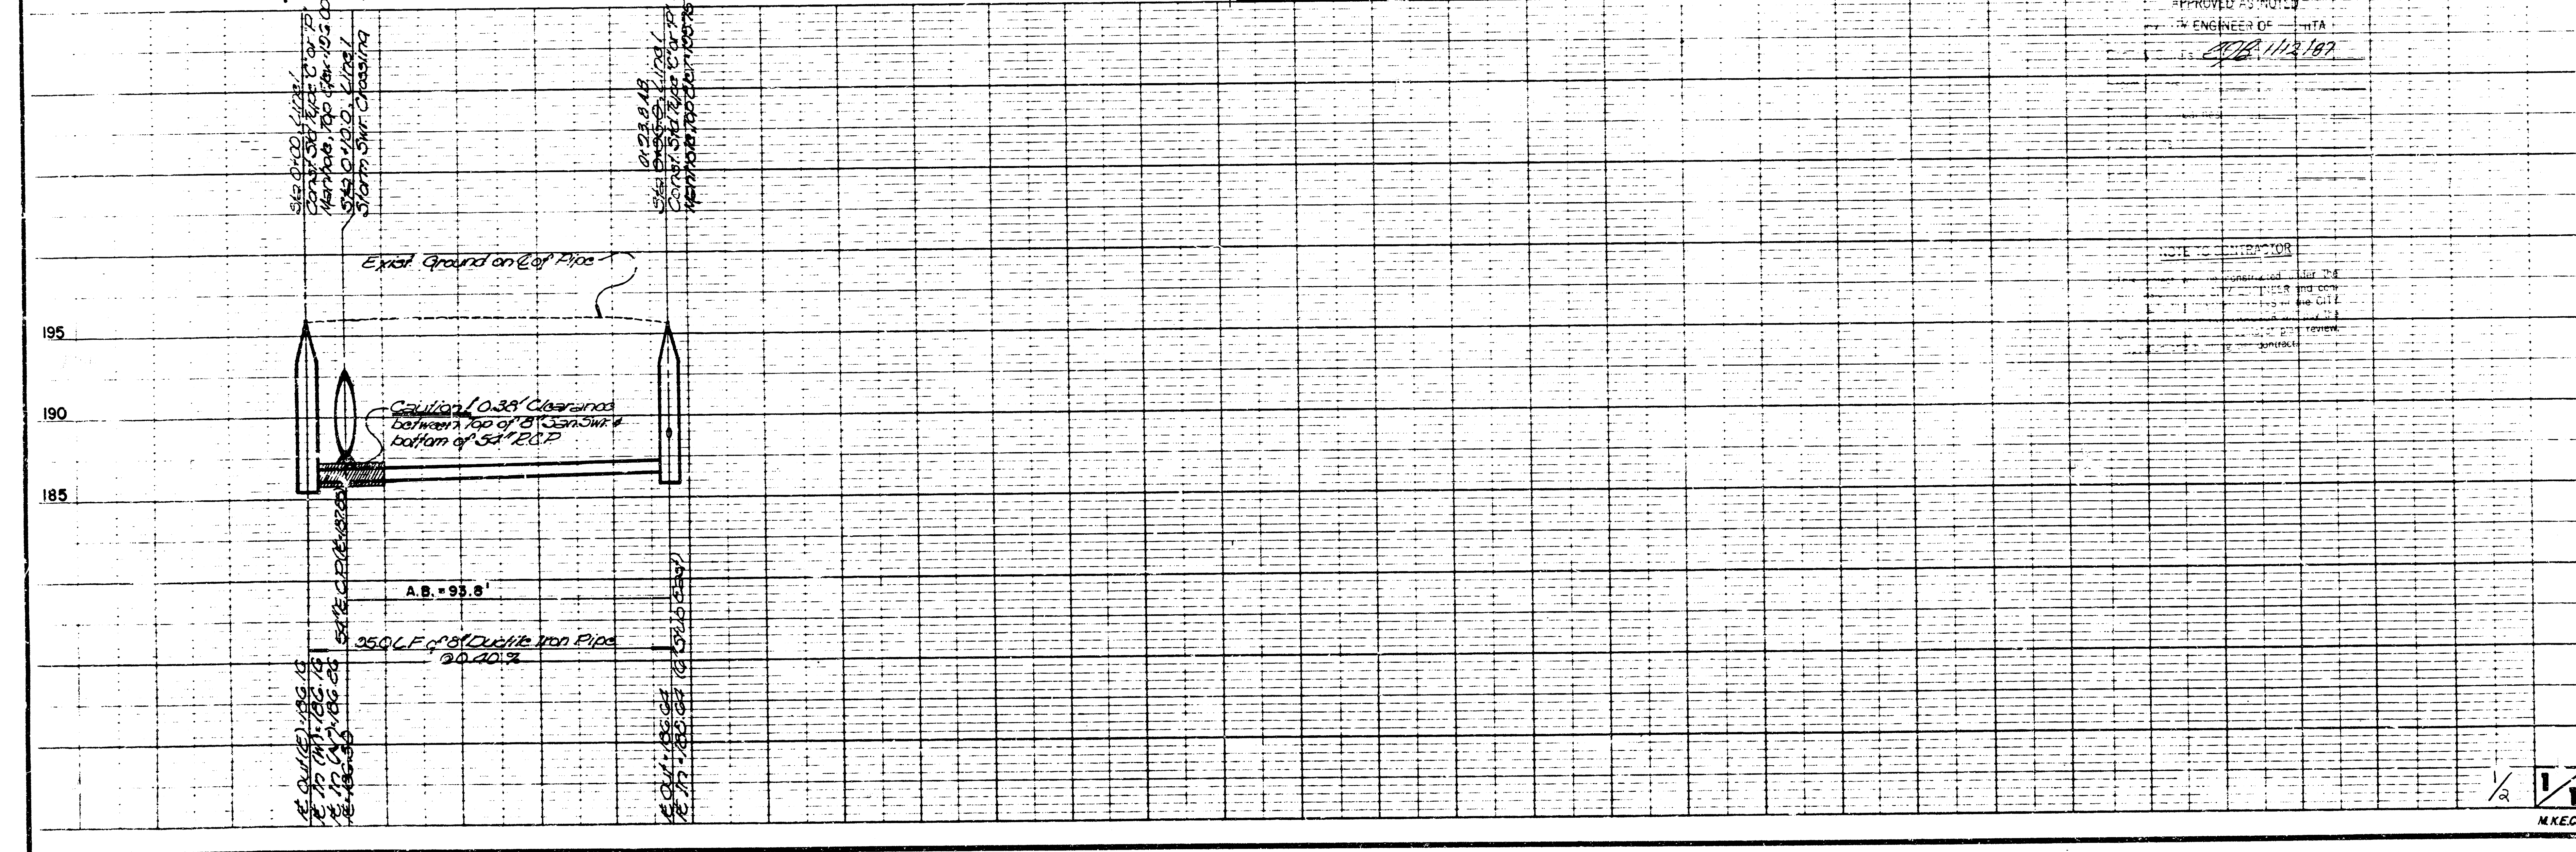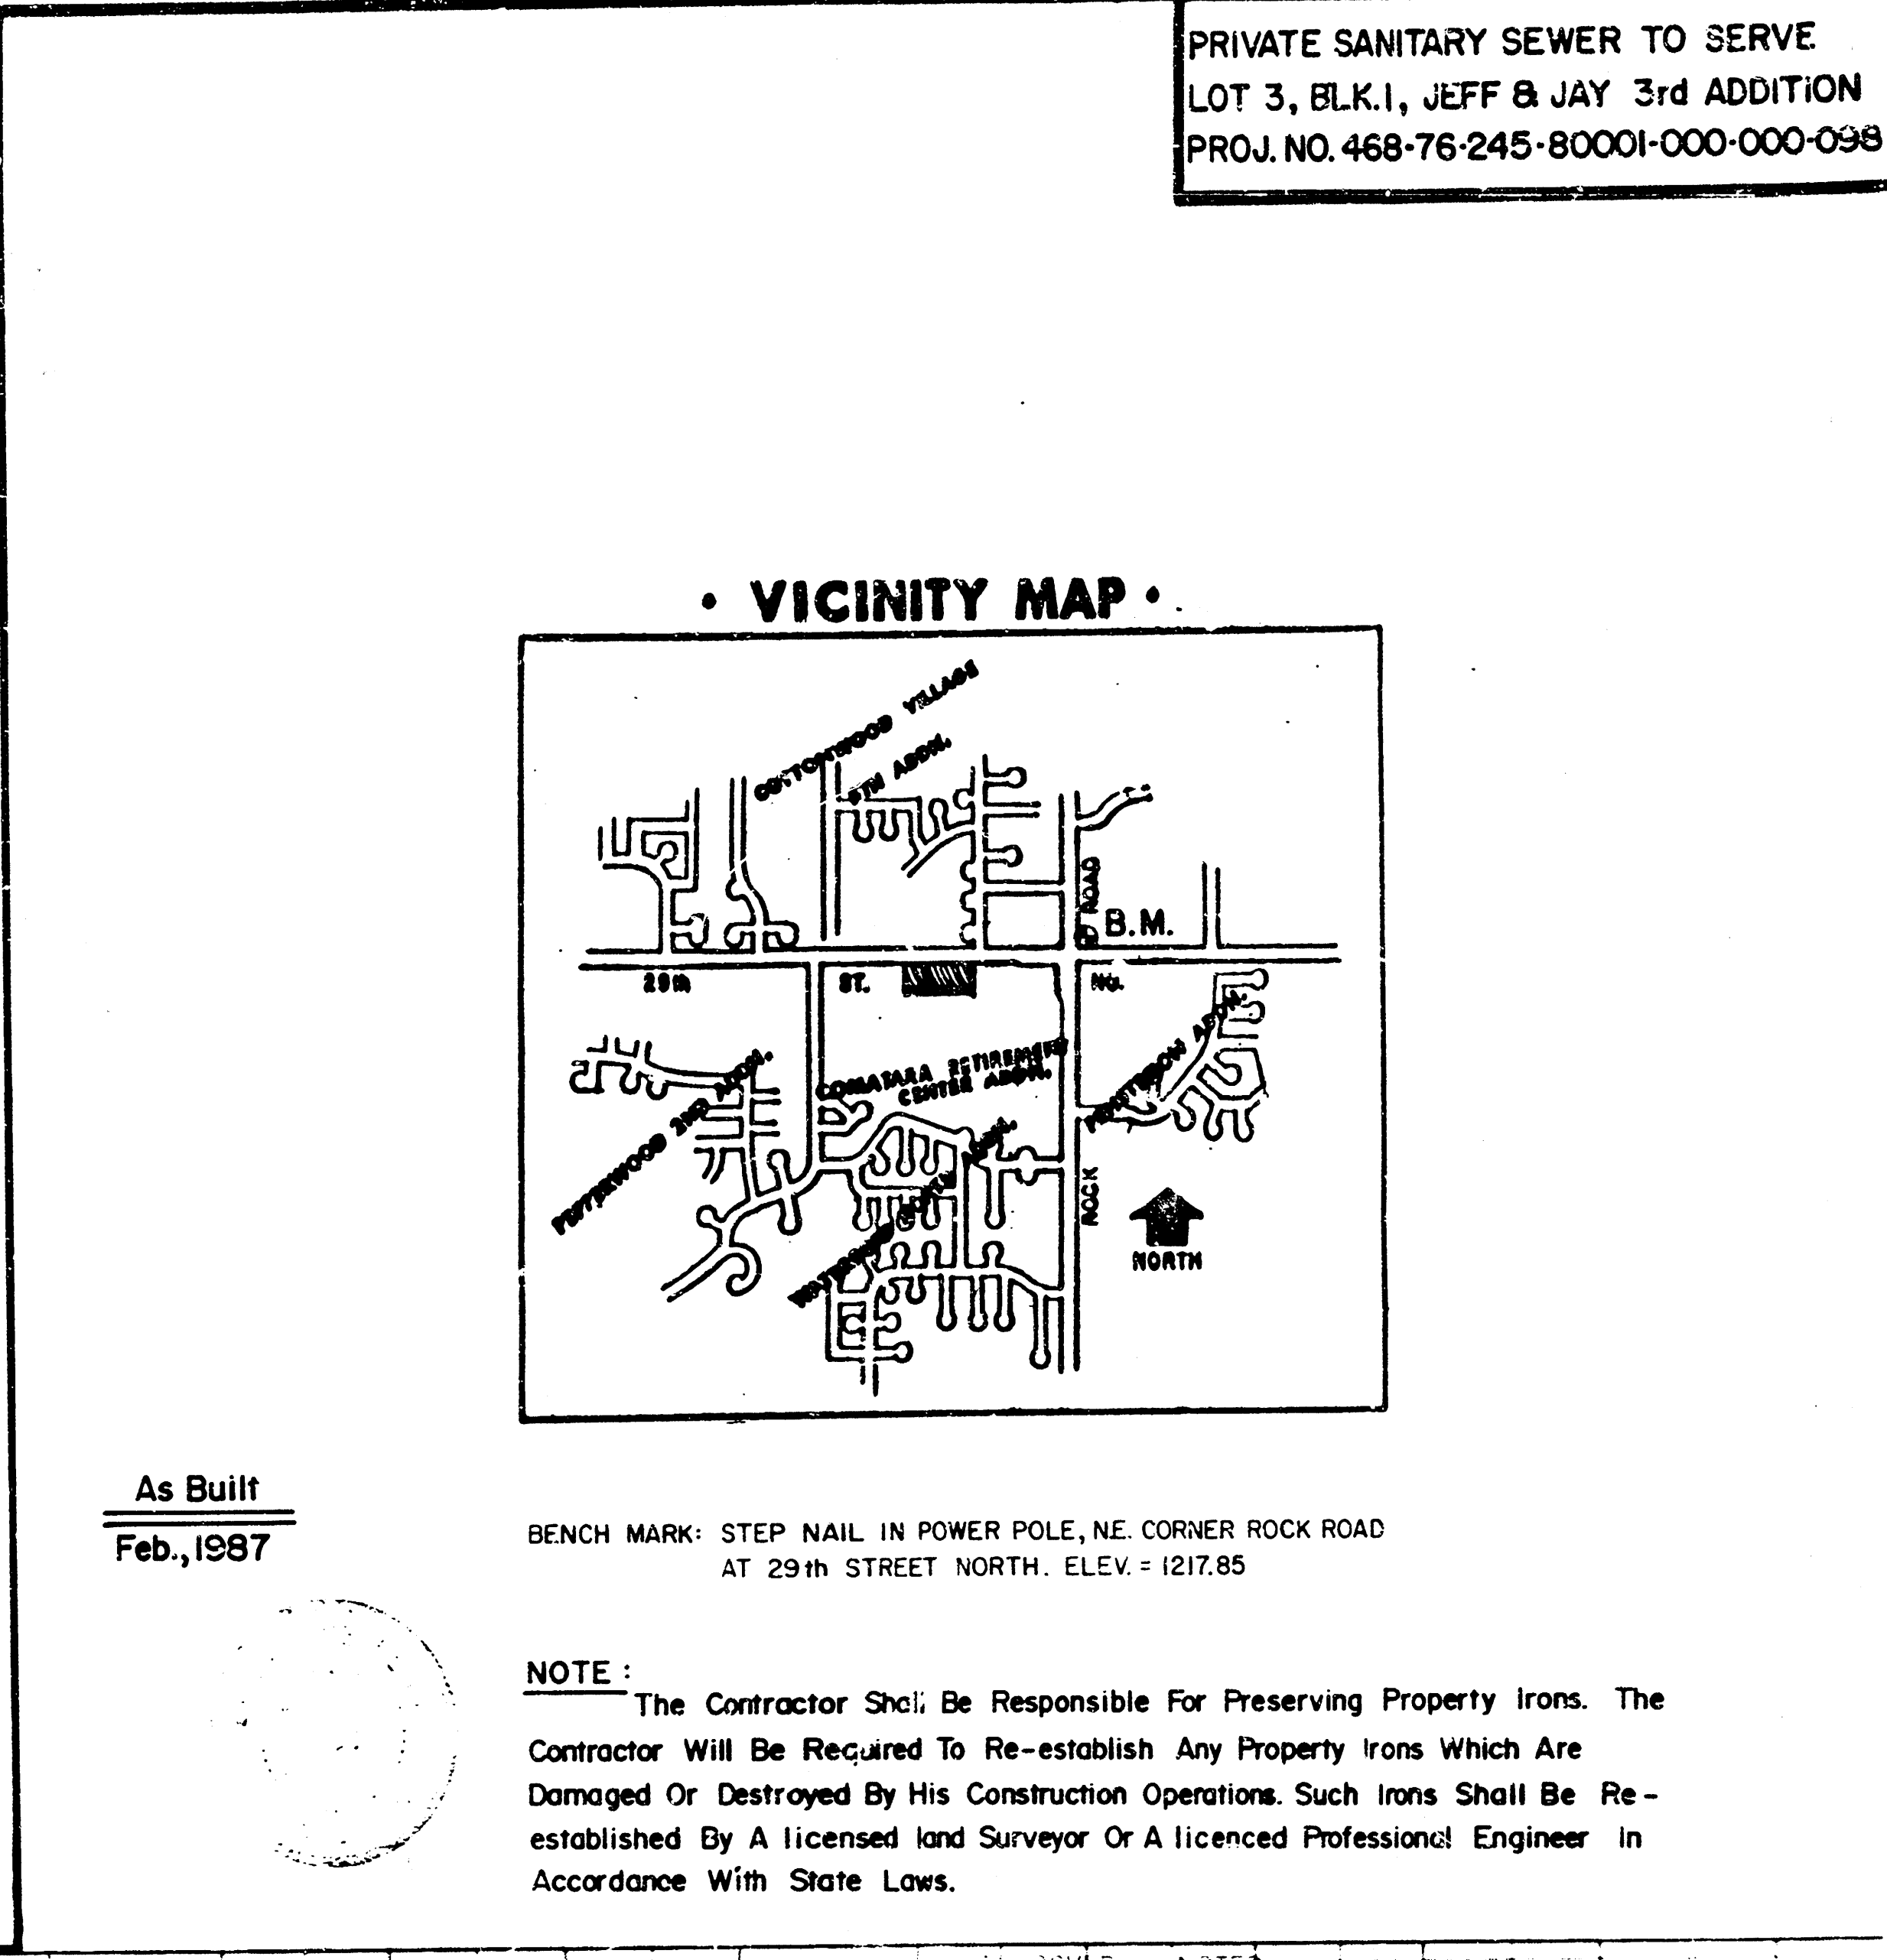

7



APPROVED AS NOTED
By CITY ENGINEER OF WICHITA
Sanitary Sewers *2005 11/2/07*
Storm *sewers*
approached
sanitary
Permit *n*

This project will be constructed under the supervision of the CITY ENGINEER and conform to the SPECIFICATIONS of the CITY OF WASHINGTON. The CONTRACTOR will pay the City of Washington for a series of plan review, inspection and boring per contract.

