

BM: City of Wichita Dist. 44' West
and 56' North of Centerline
of Woodlawn and Central
Elevation 192.27 City Datum

NE cor sidewalk @ Sta. 0+10, 20'
Left, Elevation 193.94

Saw, Remove & Replace
Asphalt, and Decor.
as necessary

Station 0+00 Remove 4" Slab
and begin Const. Service to
501 N. Woodlawn is to be
reconnected to new 8"
San. Sewer (See Note 4)

Saw 4' 0" from back of Curb,
Remove & Replace Concrete
Pavement, as Necessary
for Construction. (5' Concrete
44" curb per detail this sheet)

CAUTION: Existing K.P.L. Gas
Serv. Co. Service Line Crossing

CAUTION: Existing K.G. & E. Under-
ground Primary & Secondary
Lines (Crosses @ 3 Locations)

KAPAUN
Sta. 0+11, 4" Tap (501 N. Woodlawn)

EXISTING
BUILDING

Do not disturb Trees

EXISTING
BUILDING

FIRST

Remove & Replace
Concrete Walk to
the Nearest Joint.

5' x 10' Add. Sewer Eas't.
(Film 1013, Page 62)

ADDITION

Remove & Replace 4" Cast Iron
Pipe Roof Drain as necessary


Remove & Replace 6"
Asphalt Pavement
as necessary

EXISTING
ASPHALT

ADDITION

Station 1+48.0 Construct Std.
Manhole, Top Elevation 194.2
6" Stub Northwest.
(Ring offset 0.8' S.W.)


LOCATION MAP

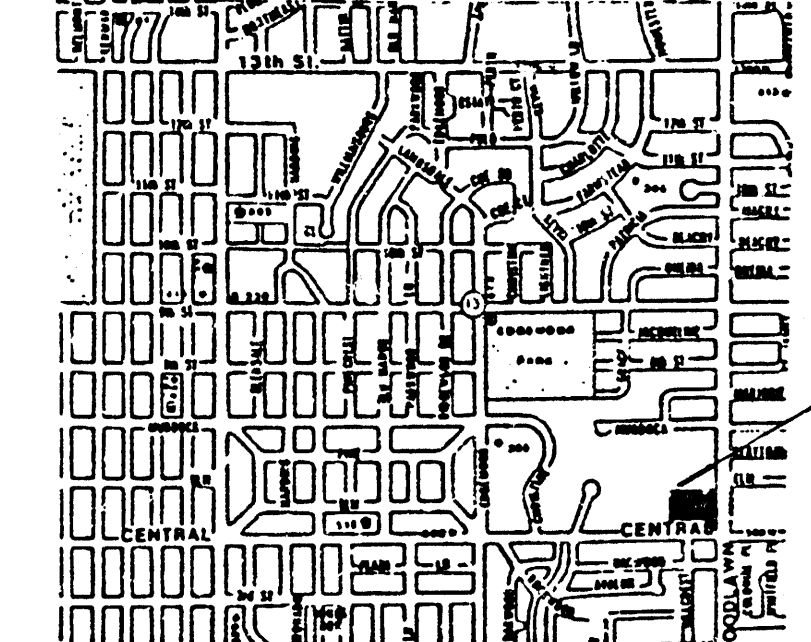

APPROVED AS NOTED
BY CITY ENGINEER OF WICHITA


Sanitary Sewers
Storm Sewers
Driveway Approaches
Water Mains

LEGEND
For Existing Lines
—ss— San. Sewer
—sus— Storm Sewer
—e— K.G. & E. Lines
—t— S.L.I. Bell Lines
—g— K.P.L. Gas Lines

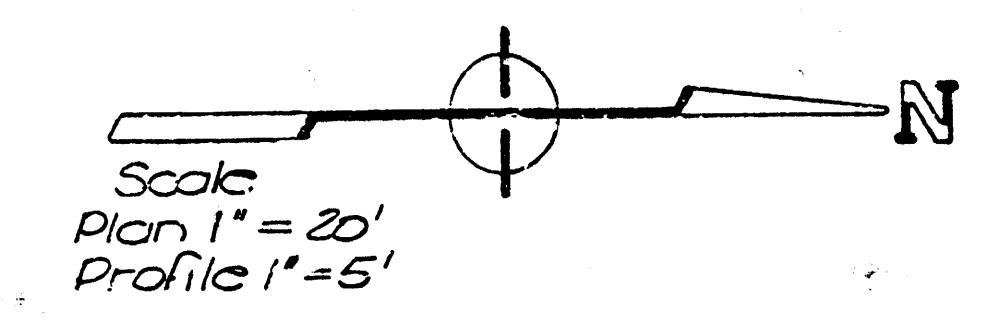



GENERAL NOTES

- Existing utilities and their locations, as shown on the plans, represent the best information obtainable for design. It shall be the Contractor's responsibility to contact the utility companies to verify locations and depths at least 48 hours prior to any excavation.
- The Contractor shall protect trees adjacent to the project from damage.
- The Contractor shall notify property owners or tenants of the buildings adjacent to the project a minimum of 10 days prior to construction, and make arrangements for the closing of the driveway for construction.
- The Contractor shall maintain continuous flow of sewage through construction. Active building sewer lines are to be reconnected to the sewer. All work involved with building sewer lines and connections shall conform to the applicable section of the Standard Specifications.

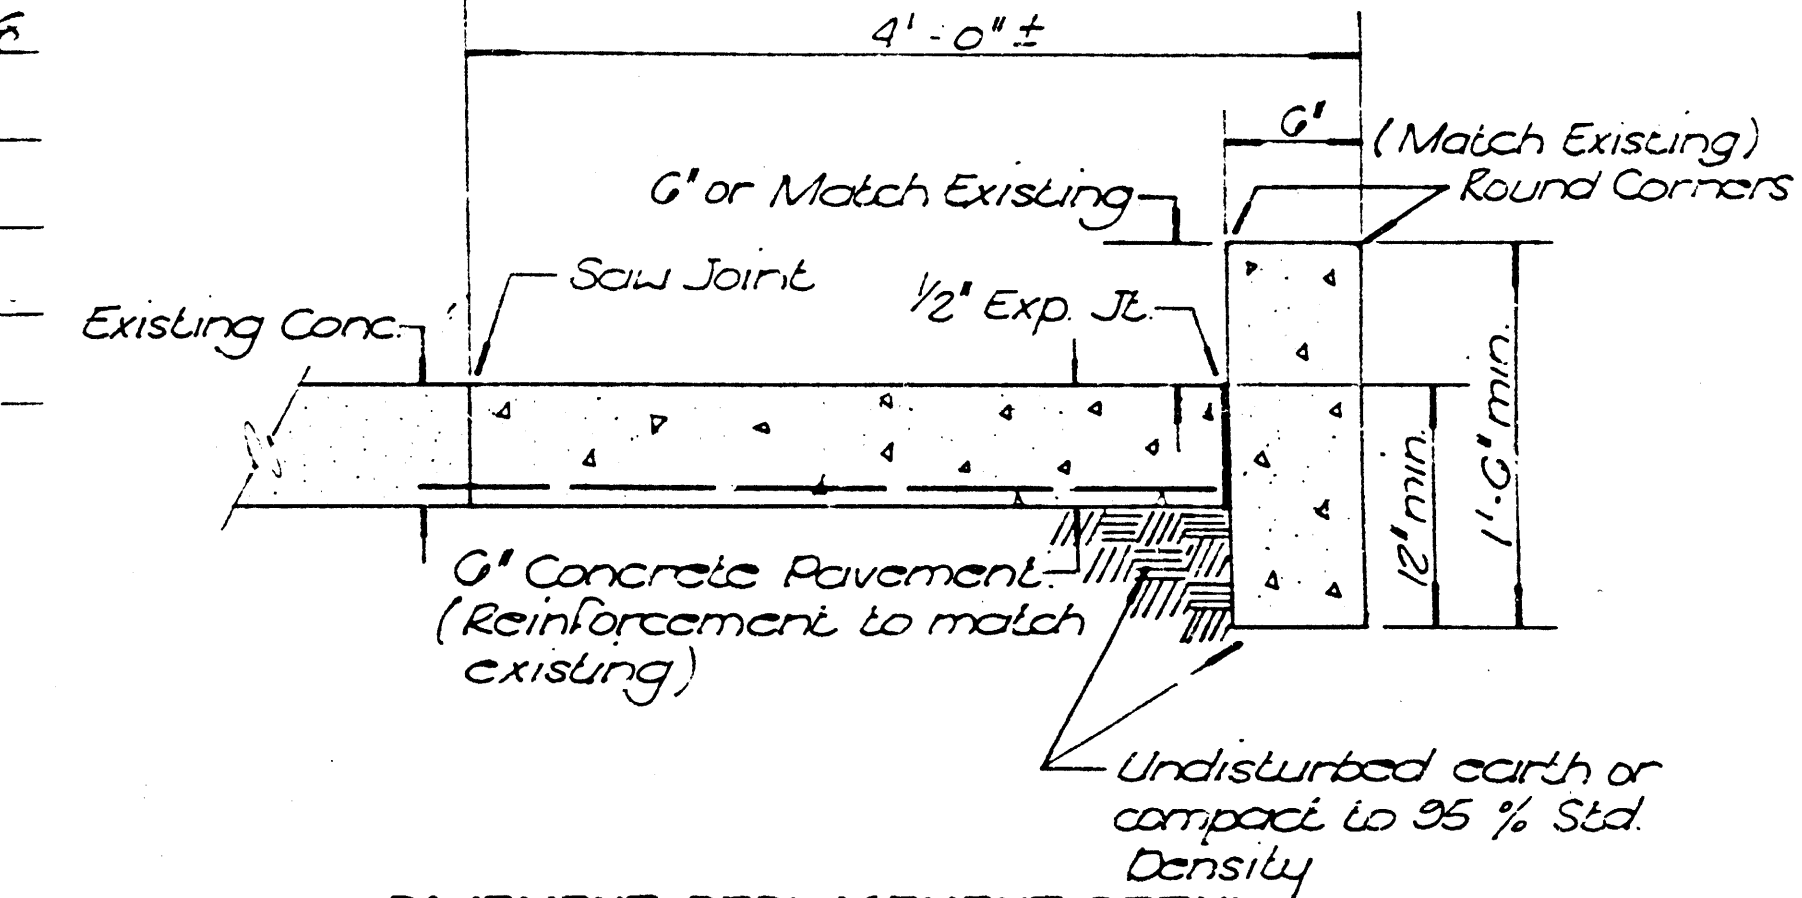

PAVEMENT REPLACEMENT DETAIL

NOTE TO CONTRACTOR
INSPECTION AND TESTING FOR THIS PROJECT IS TO BE PROVIDED BY THE LICENSED CONSULTING ENGINEERING FIRM IN CONTRACT WITH THE OWNER. DEPT. OF PUBLIC WORKS SHALL BE IN ACCORDANCE WITH THE CITY OF WICHITA STANDARD SPECIFICATIONS FOR CONSTRUCTION. THE ENGINEERING FIRM SHALL BE LICENSED IN THE STATE OF KANSAS AND SHALL BE A MEMBER OF THE KANSAS SOCIETY OF PROFESSIONAL ENGINEERS. ALL WORK SHALL BE IN ACCORDANCE WITH THE CITY OF WICHITA STANDARD SPECIFICATIONS FOR CONSTRUCTION. ALL WORK SHALL BE IN ACCORDANCE WITH THE CITY OF WICHITA STANDARD SPECIFICATIONS FOR CONSTRUCTION. ALL WORK SHALL BE IN ACCORDANCE WITH THE CITY OF WICHITA STANDARD SPECIFICATIONS FOR CONSTRUCTION.

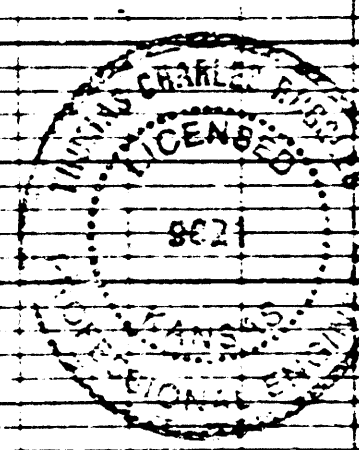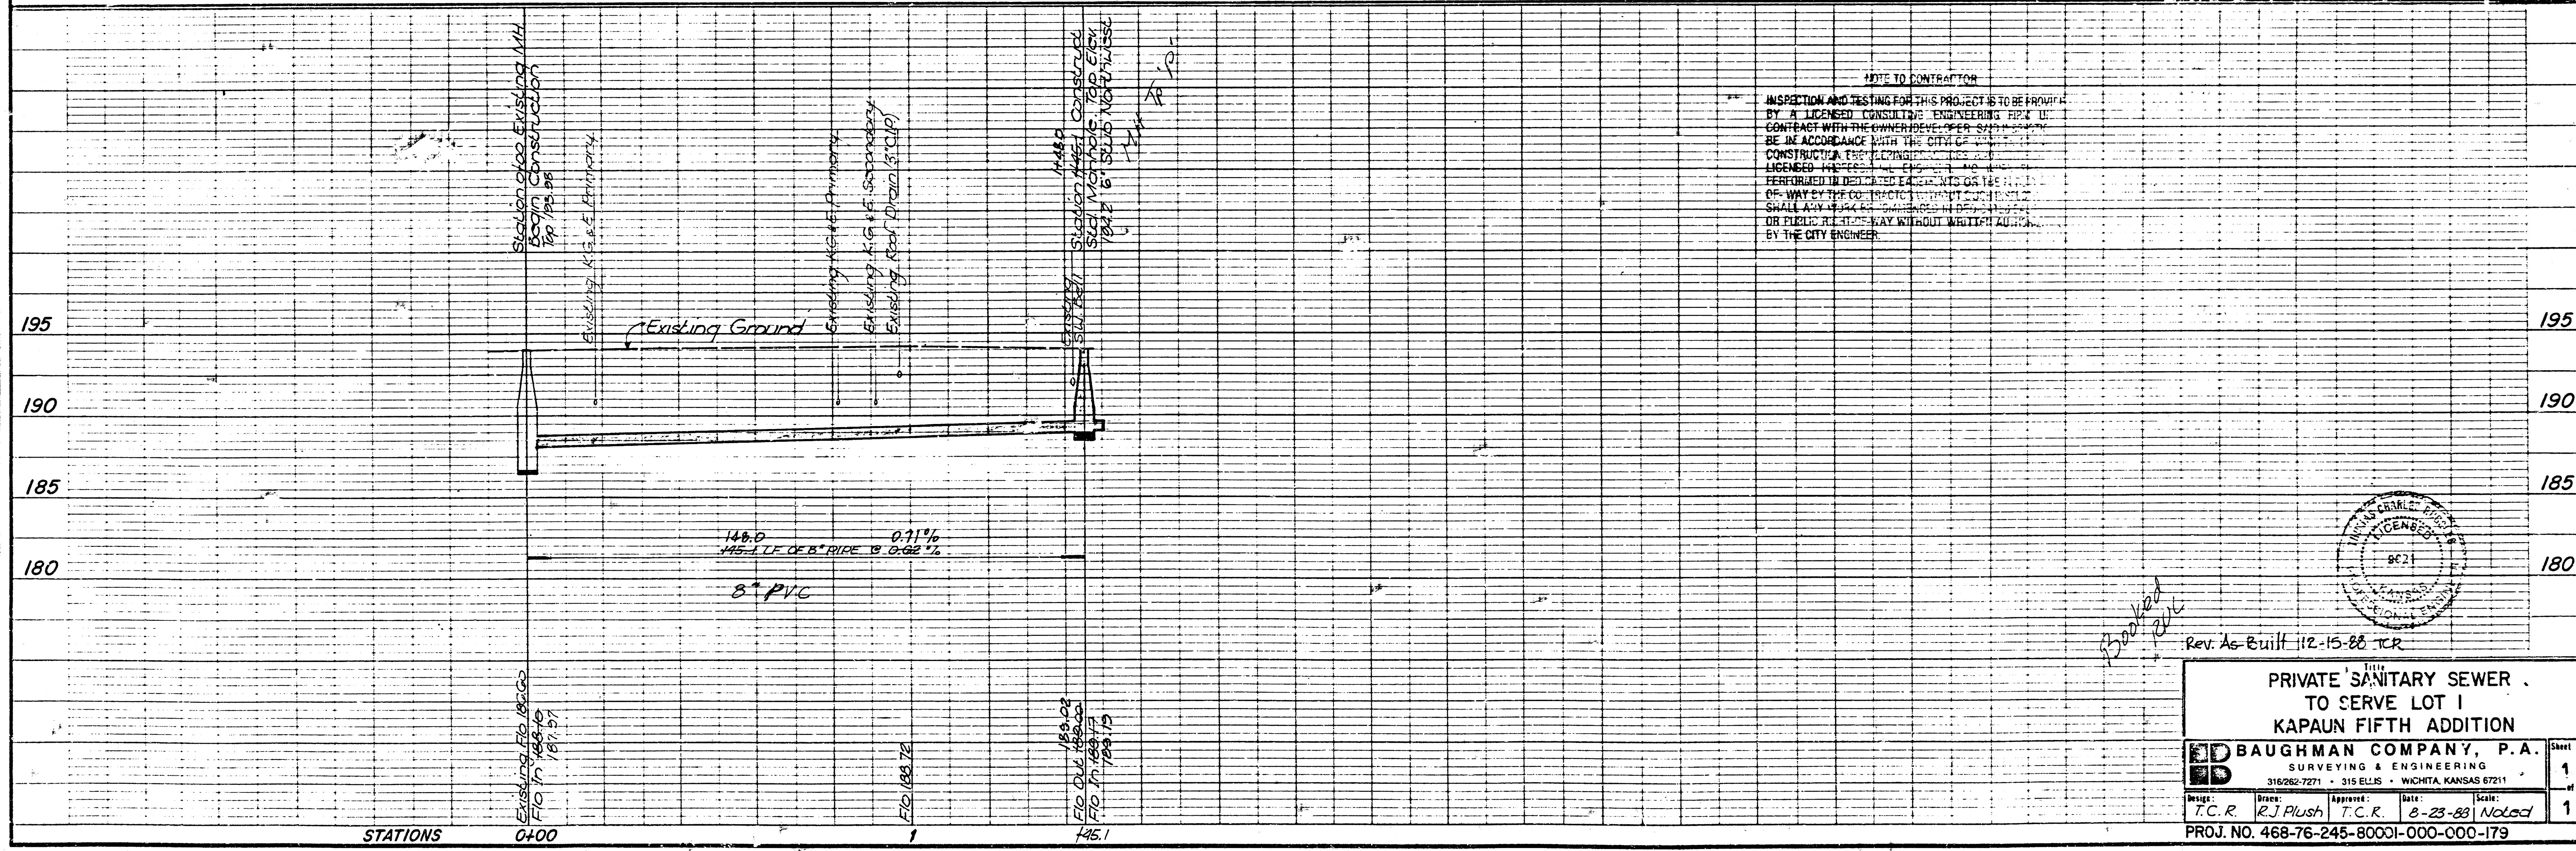

Rev. As-Built 12-15-88 TCR

PRIVATE SANITARY SEWER
TO SERVE LOT 1
KAPAUN FIFTH ADDITION

BAUGHMAN COMPANY, P.A.
SURVEYING & ENGINEERING
316262-7271 • 315 ELLIS • WICHITA, KANSAS 67211

Design: T.C.R. Drawn: R.J. Plush Approved: T.C.R. Date: 8-23-88 Scale: 1/2"

Proj. No. 468-76-245-80001-000-000-179

FILMED FROM THE BEST
AVAILABLE COPY.....

Benck Mark: City of Wichita Disc. 44' West
and 50' North of Centerline
of Woodlawn and Central.
Elevation 192.27 City Datum

Save, Remove & Replace Curb,
Asphalt, and Decorative Rack
as necessary

Station 0+00 Remove 4" Stub
and begin Const. Service to
Sol. N. Woodlawn is to be
reconnected to new 8"
San. Sewer. (See Note 4)

Save 4'0"± From back of Curb;
Remove & Replace Concrete
Pavement as Necessary
for Construction. (5' Concrete
4'0" curb per detail this sheet)

CAUTION: Existing KPL Gas
Serv. Co. Service Line Crossing

CAUTION: Existing K.G. & E. Under
ground Primary & Secondary
Lines (Crosses & 3 Locations)

KAPAUN FIFTH

Remove & Replace
Concrete Walk to
the Nearest Joint


ADDITION

Remove & Replace 4" Cast Iron
Pipe Roof Drain as necessary

Remove & Replace 5"
Asphalt Pavement
as necessary

Station 1+45.1 Construct Std.
Manhole, Top Elevation 194.2
6" Stub Northwest

LOCATION MAP

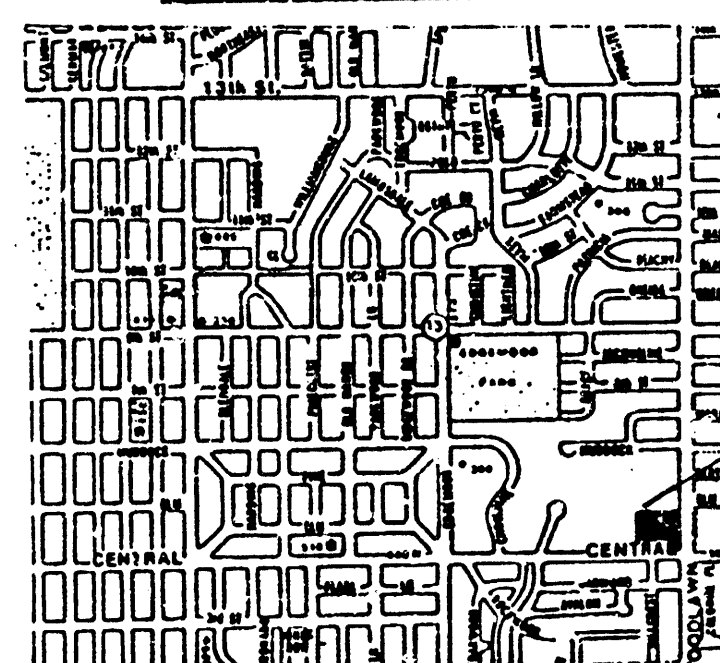

PROJECT
VICINITY

GENERAL NOTES

- Existing utilities and their locations, as shown on the plans, represent the best information obtainable for design. It shall be the Contractor's responsibility to contact the utility companies to verify locations and depths at least 48 hours prior to any excavation.
- The Contractor shall protect trees adjacent to the project from damage.
- The Contractor shall notify property owners or tenants of the buildings adjacent to the project a minimum of 10 days prior to construction, and make arrangements for the closing of the driveway for construction.
- The Contractor shall maintain continuous flow of sewage through construction. Active building sewer lines are to be reconnected to the sewer. All work involved with building sewer lines and connections shall conform to the applicable section of the Standard Specifications.

APPROVED AS NOTED

By CITY ENGINEER OF WICHITA

Sanitary Sewers *8/24/88*

Storm Sewers


Driveway Approaches

Water Mains

Pavement

LEGEND


- For Existing Lines
- ss— San Sewer
 - sus— Storm Sewer
 - e— K.G. & E. Lines
 - r— S.W. Ball Lines
 - g— K.P.L. Gas Lines

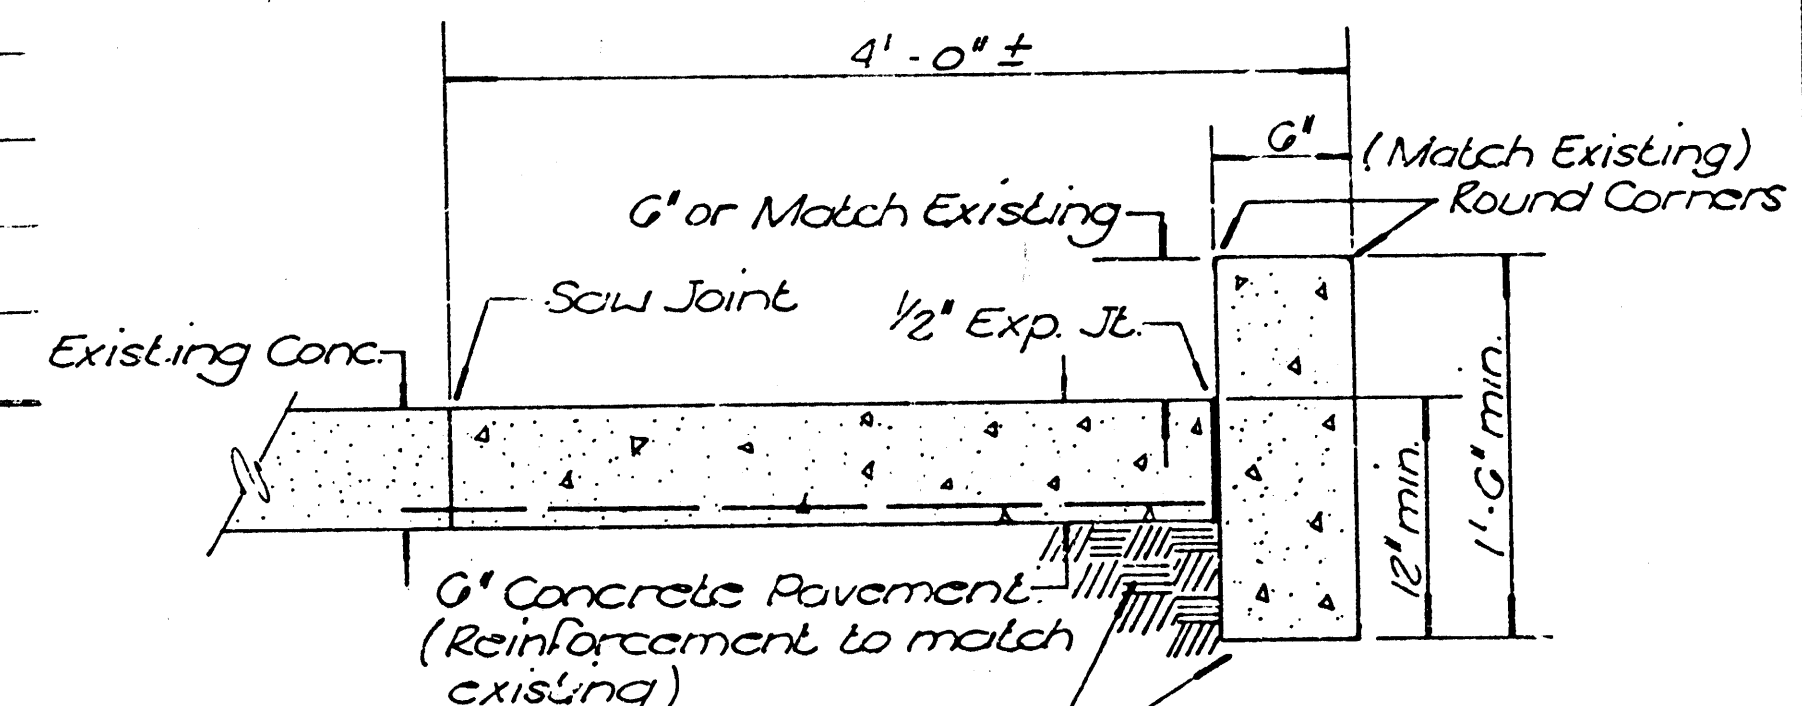

PAVEMENT REPLACEMENT DETAIL

NOTE TO CONTRACTOR

INSPECTION AND TESTING FOR THIS PROJECT IS TO BE PROVIDED BY A LICENSED CONSULTING ENGINEERING FIRM IN CONTRACT WITH THE OWNER/DEVELOPER. SAID INSPECTION SHALL BE IN ACCORDANCE WITH THE CITY OF WICHITA'S CONSTRUCTION ENGINEERING PRACTICES AND STANDARDS. LICENSED PROFESSIONAL ENGINEERS NO WORK SHALL BE PERFORMED IN DESIGNATED EASEMENTS OR THE RIGHT-OF-WAY EXCEPT AS NOTED HEREON. SUCH INSPECTION SHALL BE THE RESPONSIBILITY OF THE CONTRACTOR. NO PUBLIC RIGHT-OF-WAY WITHOUT WRITTEN AUTHORIZATION BY THE CITY ENGINEER.

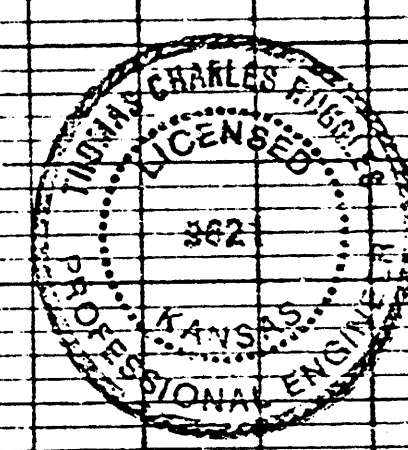

PRIVATE SANITARY SEWER
TO SERVE LOT 1
KAPAUN FIFTH ADDITION

BAUGHMAN COMPANY, P.A.
SURVEYING & ENGINEERING
316/262-7271 • 315 ELLIS • WICHITA, KANSAS 67211
Design: T.C.R. R.J. Plush T.C.R. 8-23-88 Noted
Proj. No. 468-76-245-80001-000-000-179

FILMED FROM THE BEST
AVAILABLE COPY