

B.M. - 124.52 - City std. disc. 34" N.  
 42' W. of E's of Central &  
 Anna

Note:  
 Existing 4" stub connection to  
 M.H. from the north. Use caution  
 with construction so service  
 line is not damaged or contractor  
 shall reconnect the service line.

Sta. 0+00  
 Existing Manhole  
 Begin 8" pipe const.

Contractor shall regrade the  
 lot back in good condition after  
 construction is completed.

Contractor to Remove and  
 Replace the existing storm drain  
 force in good condition as is  
 necessary.

Sta 0+32.5 Const.  
 Type 'A' std. Manhole  
 Top Elev. = 124.9  
 4" stub - NE.

CLARA

CENTRAL AVE.


PLAN  
 SCALE: 1" = 20' HOR.  
 1" = 5' VERT.

PROFILE  
 SCALE: 1" = 5' VERT.


Scale: 1" = 20' Plan  
 1" = 20' Profile Hor.  
 1" = 5' Profile Vert.

APPROVED AS NOTED  
 By CITY ENGINEER OF WICHITA  
 Sanitary Sewers *[Signature]*  
 Storm Sewers \_\_\_\_\_  
 Driveway Approaches \_\_\_\_\_

NOTE TO CONTRACTOR  
 This project will be constructed under  
 the supervision of the CITY ENGINEER  
 and conforming to the SPECIFICATIONS  
 of the CITY OF WICHITA. The CON-  
 TRACTOR will prepay the City or Wichita  
 for all costs of Inspection.

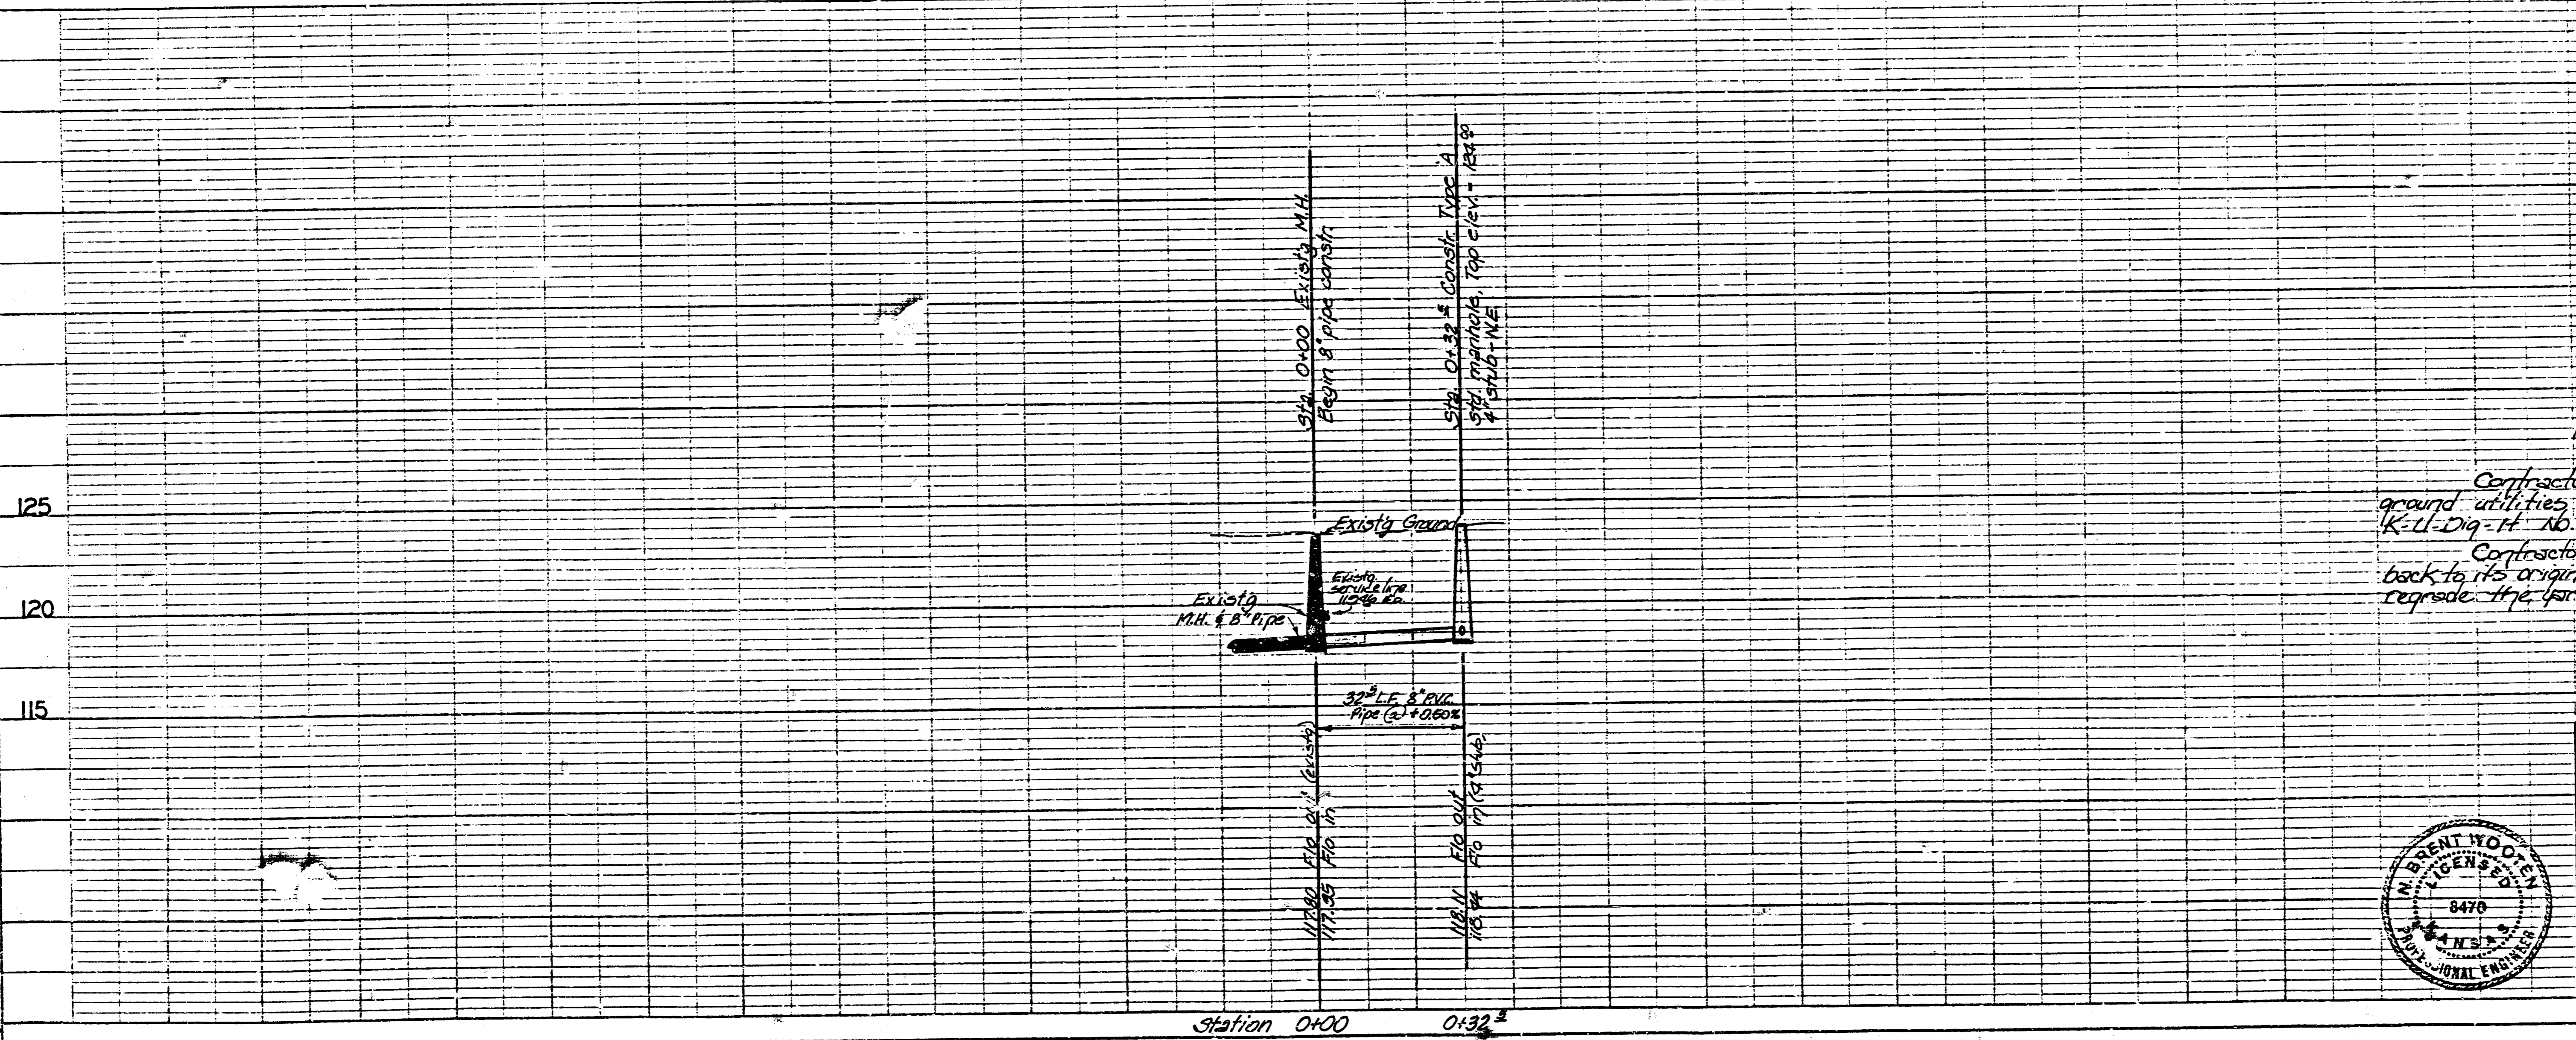

Note:  
 Contractor to verify location of any RGE or other under-  
 ground utilities within the utility basement. Contact  
 K-L-Dig-It No. 267-2080 prior to construction.  
 Contractor to Remove & Replace the existing storm drain pipe force  
 back to its original condition and location. Contractor also shall  
 regrade the land area of lots back to good condition after const.

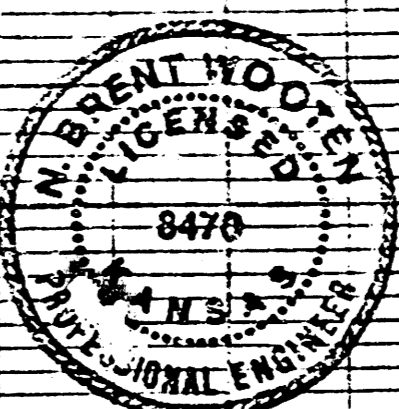

JUNE 1984  
 PRIVATE SANITARY SEWER EXTENSION TO SERVE  
 E. 49.5 OF LOT 2 & W. 39.5 OF LOT 3, BLK B,  
 KELL HAWKINS 2ND ADD.  
 PROJECT NO.  
 488-76-245-80000-000-000-008  
 CITY OF WICHITA, KS.  
 BAUGHMAN COMPANY, P.A.  
 SURVEYING & ENGINEERING  
 316-262-7271 • 330 LAURA • WICHITA, KANSAS 67211

PLATE 1 - PLAN - PROFILE - F.A.S.  
 CLEARPRINT PAPER CO., S.F. CAL.  
 © 1981

FILMED FROM THE BEST  
 AVAILABLE COPY