


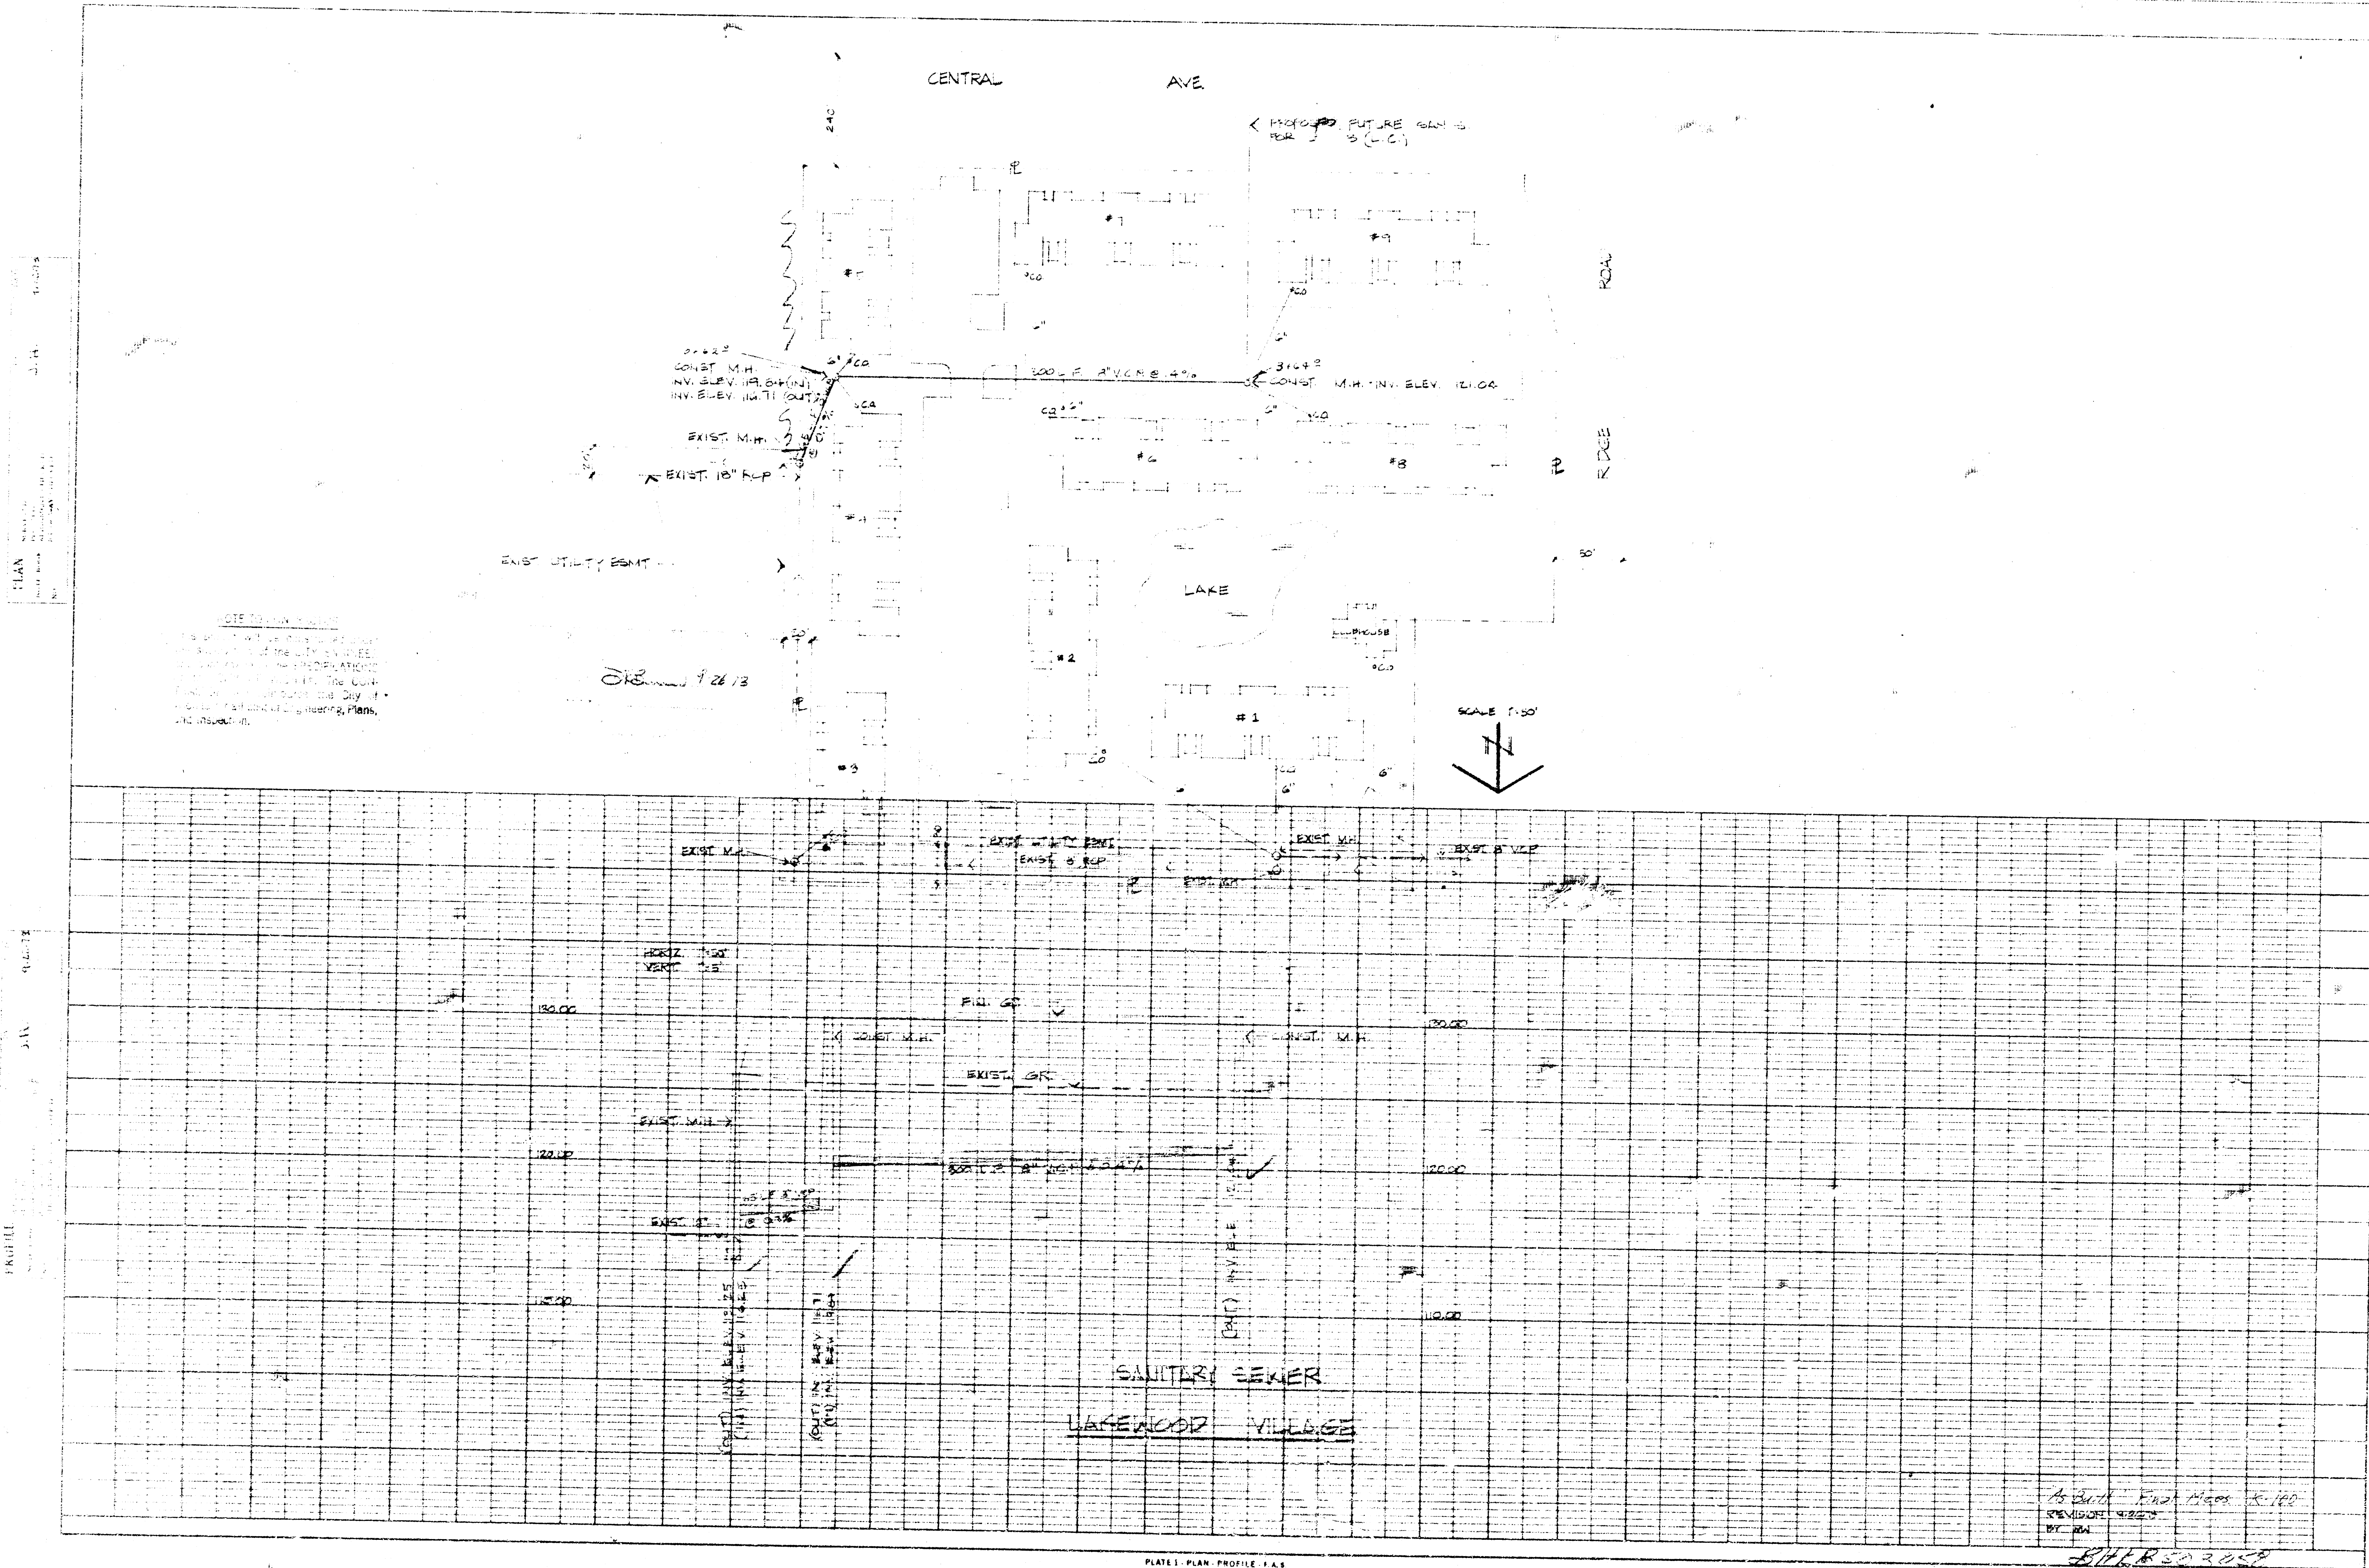

PLAN
Scale: 1\"/>

PROFILE
Scale: 1\"/>

PLATE: PLAN PROFILE 3-1
SHEET: 1 OF 1

As Built, End Sheet 3-100
REVISION: 11/22/00
BY: RM
RHS 503058