


PLANS
FOR
PHASE IV
SANITARY SEWER SYSTEM
FOR
LAMPLIGHTER MOBILE HOME PARK
WICHITA, SEDGWICK COUNTY, KANSAS

CITY OF WICHITA PRIVATE PROJECT NO. ~~466-76-245-8000-000-000-055~~
407 PP5 (607861)

1986

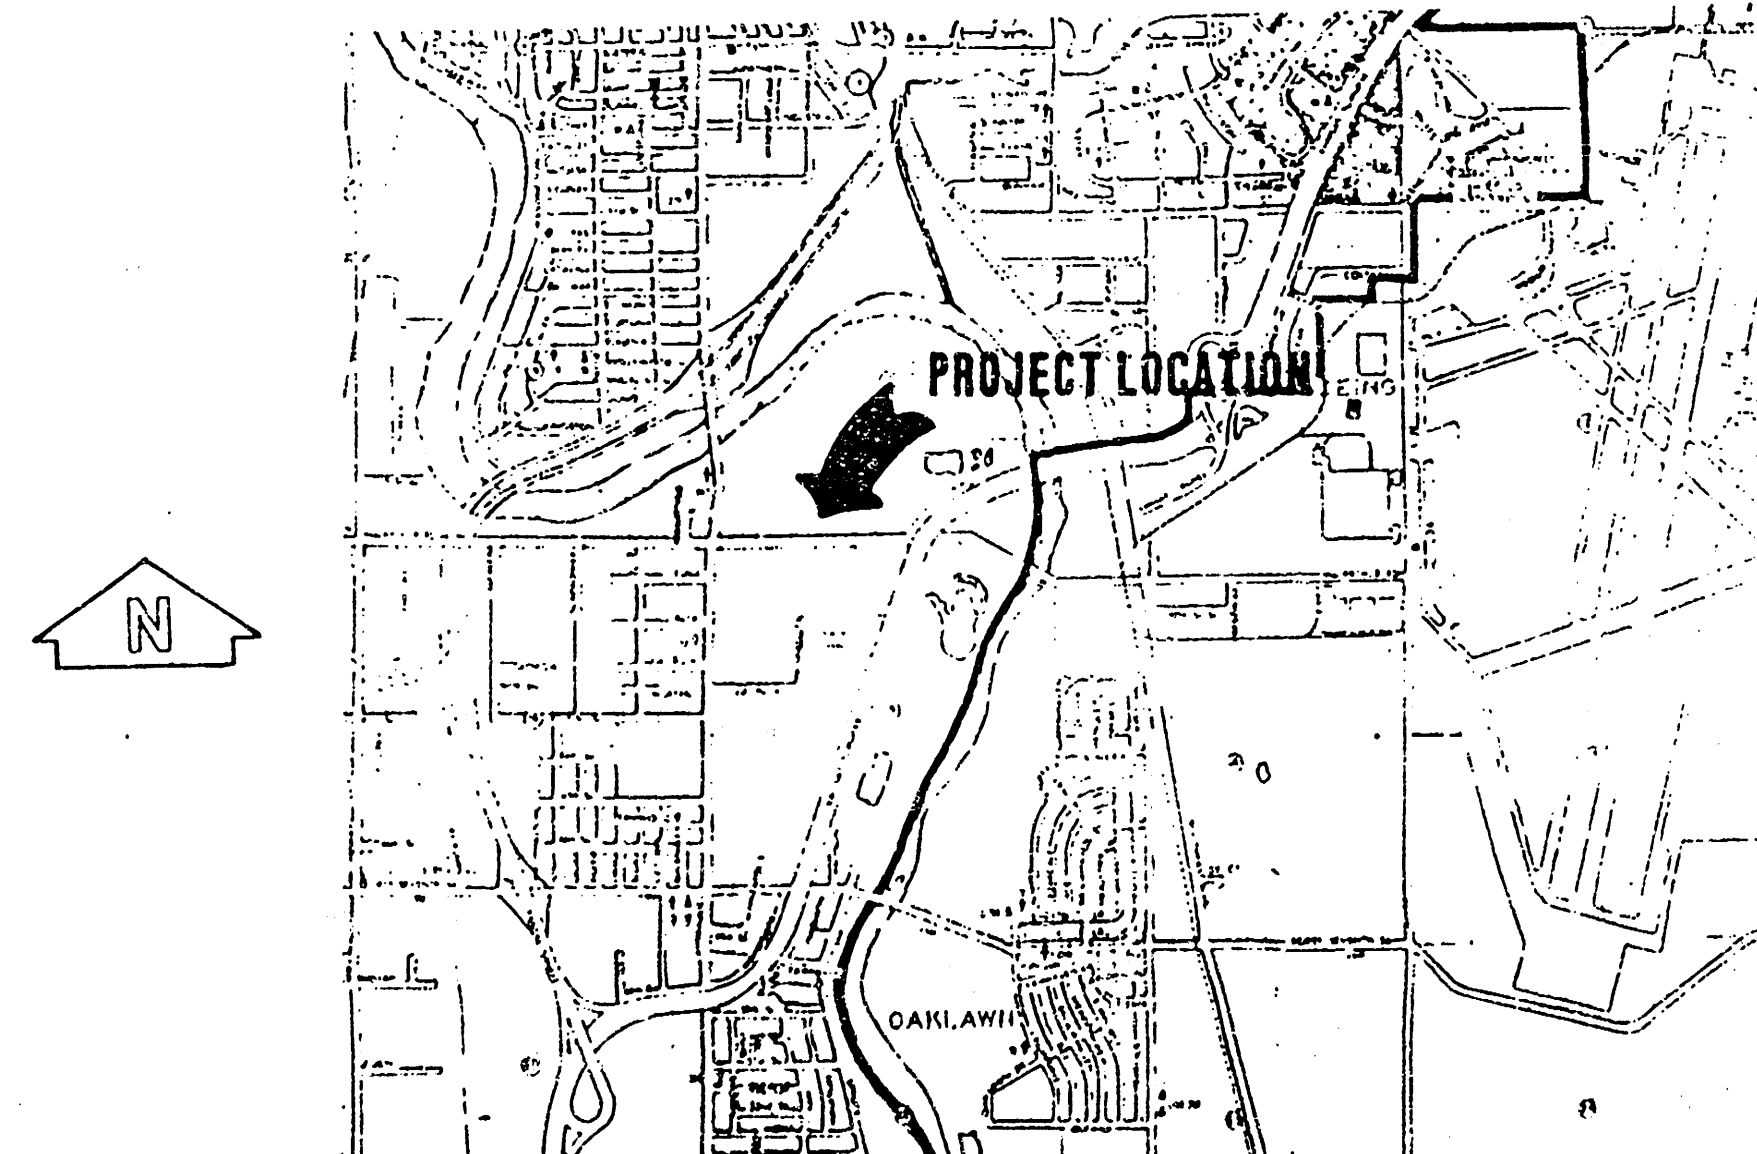

BM:
RAILROAD SPIKE IN POWER POLE AT THE
SW COR. OF THE PLAT.
ELEV. 85.23
CITY OF WICHITA DATUM

Booked 11-5-93
JKB
From As Builts

NOTE:
CONTRACTOR HAS THE OPTION OF
USING THE TYPE "C" MANHOLE WITH
APPROVAL OF THE ENGINEER

Phase IV Revised as built 10-9-95 (Lat. I-H) JCR (SRB)
Phase III Revised as built 8-27-92 (Main 1) Sta. 14+31
to 16+74 (3+10.1 to 5+66.5) Baughman Co.
Phase II Revised as built 7-5-90 (Lat. F & G and
Main 1, Sta. 0+00 (11+12) to 3+191 (14+31))

REISS & GOODNESS ENGINEERS
2100 WEST 21ST STREET
WICHITA, KANAS 67203
(316) 832-0303


APPROVED AS NOTED
By CITY ENGINEER OF WICHITA
Sanitary Sewers *11-5-93*
Storm Sewers _____
Driveway Approaches _____
Water Mains _____
Paving _____

NOTE TO CONTRACTOR

This project will be constructed under the
supervision of the CITY ENGINEER and con-
forming to the SPECIFICATIONS of the CITY
OF WICHITA. The CONTRACTOR will pay the
City of Wichita for all costs of plan review,
inspection and booking per contract.

INDEX OF SHEETS

SHEET 1 TITLE SHEET
SHEET 2 LAYOUT MAP
SHEET 3 UTILITY MAP
SHEET 4 MAIN 1
SHEET 5 LATERAL A
SHEET 6 LATERAL B
SHEET 7 LATERALS C, D, E
SHEET 8 LATERALS F, G, H, I, J
SHEET 9 TYPE "A" & "B" MANHOLES & CONCRETE ENCASUREMENT
SHEET 10 SHALLOW MANHOLES, TYPE "A" & "B"
SHEET 11 MANHOLE ADJUSTMENT DETAILS
SHEET 12 RISER DETAILS
SHEET 13 MANHOLE DETAIL, TYPE "C"

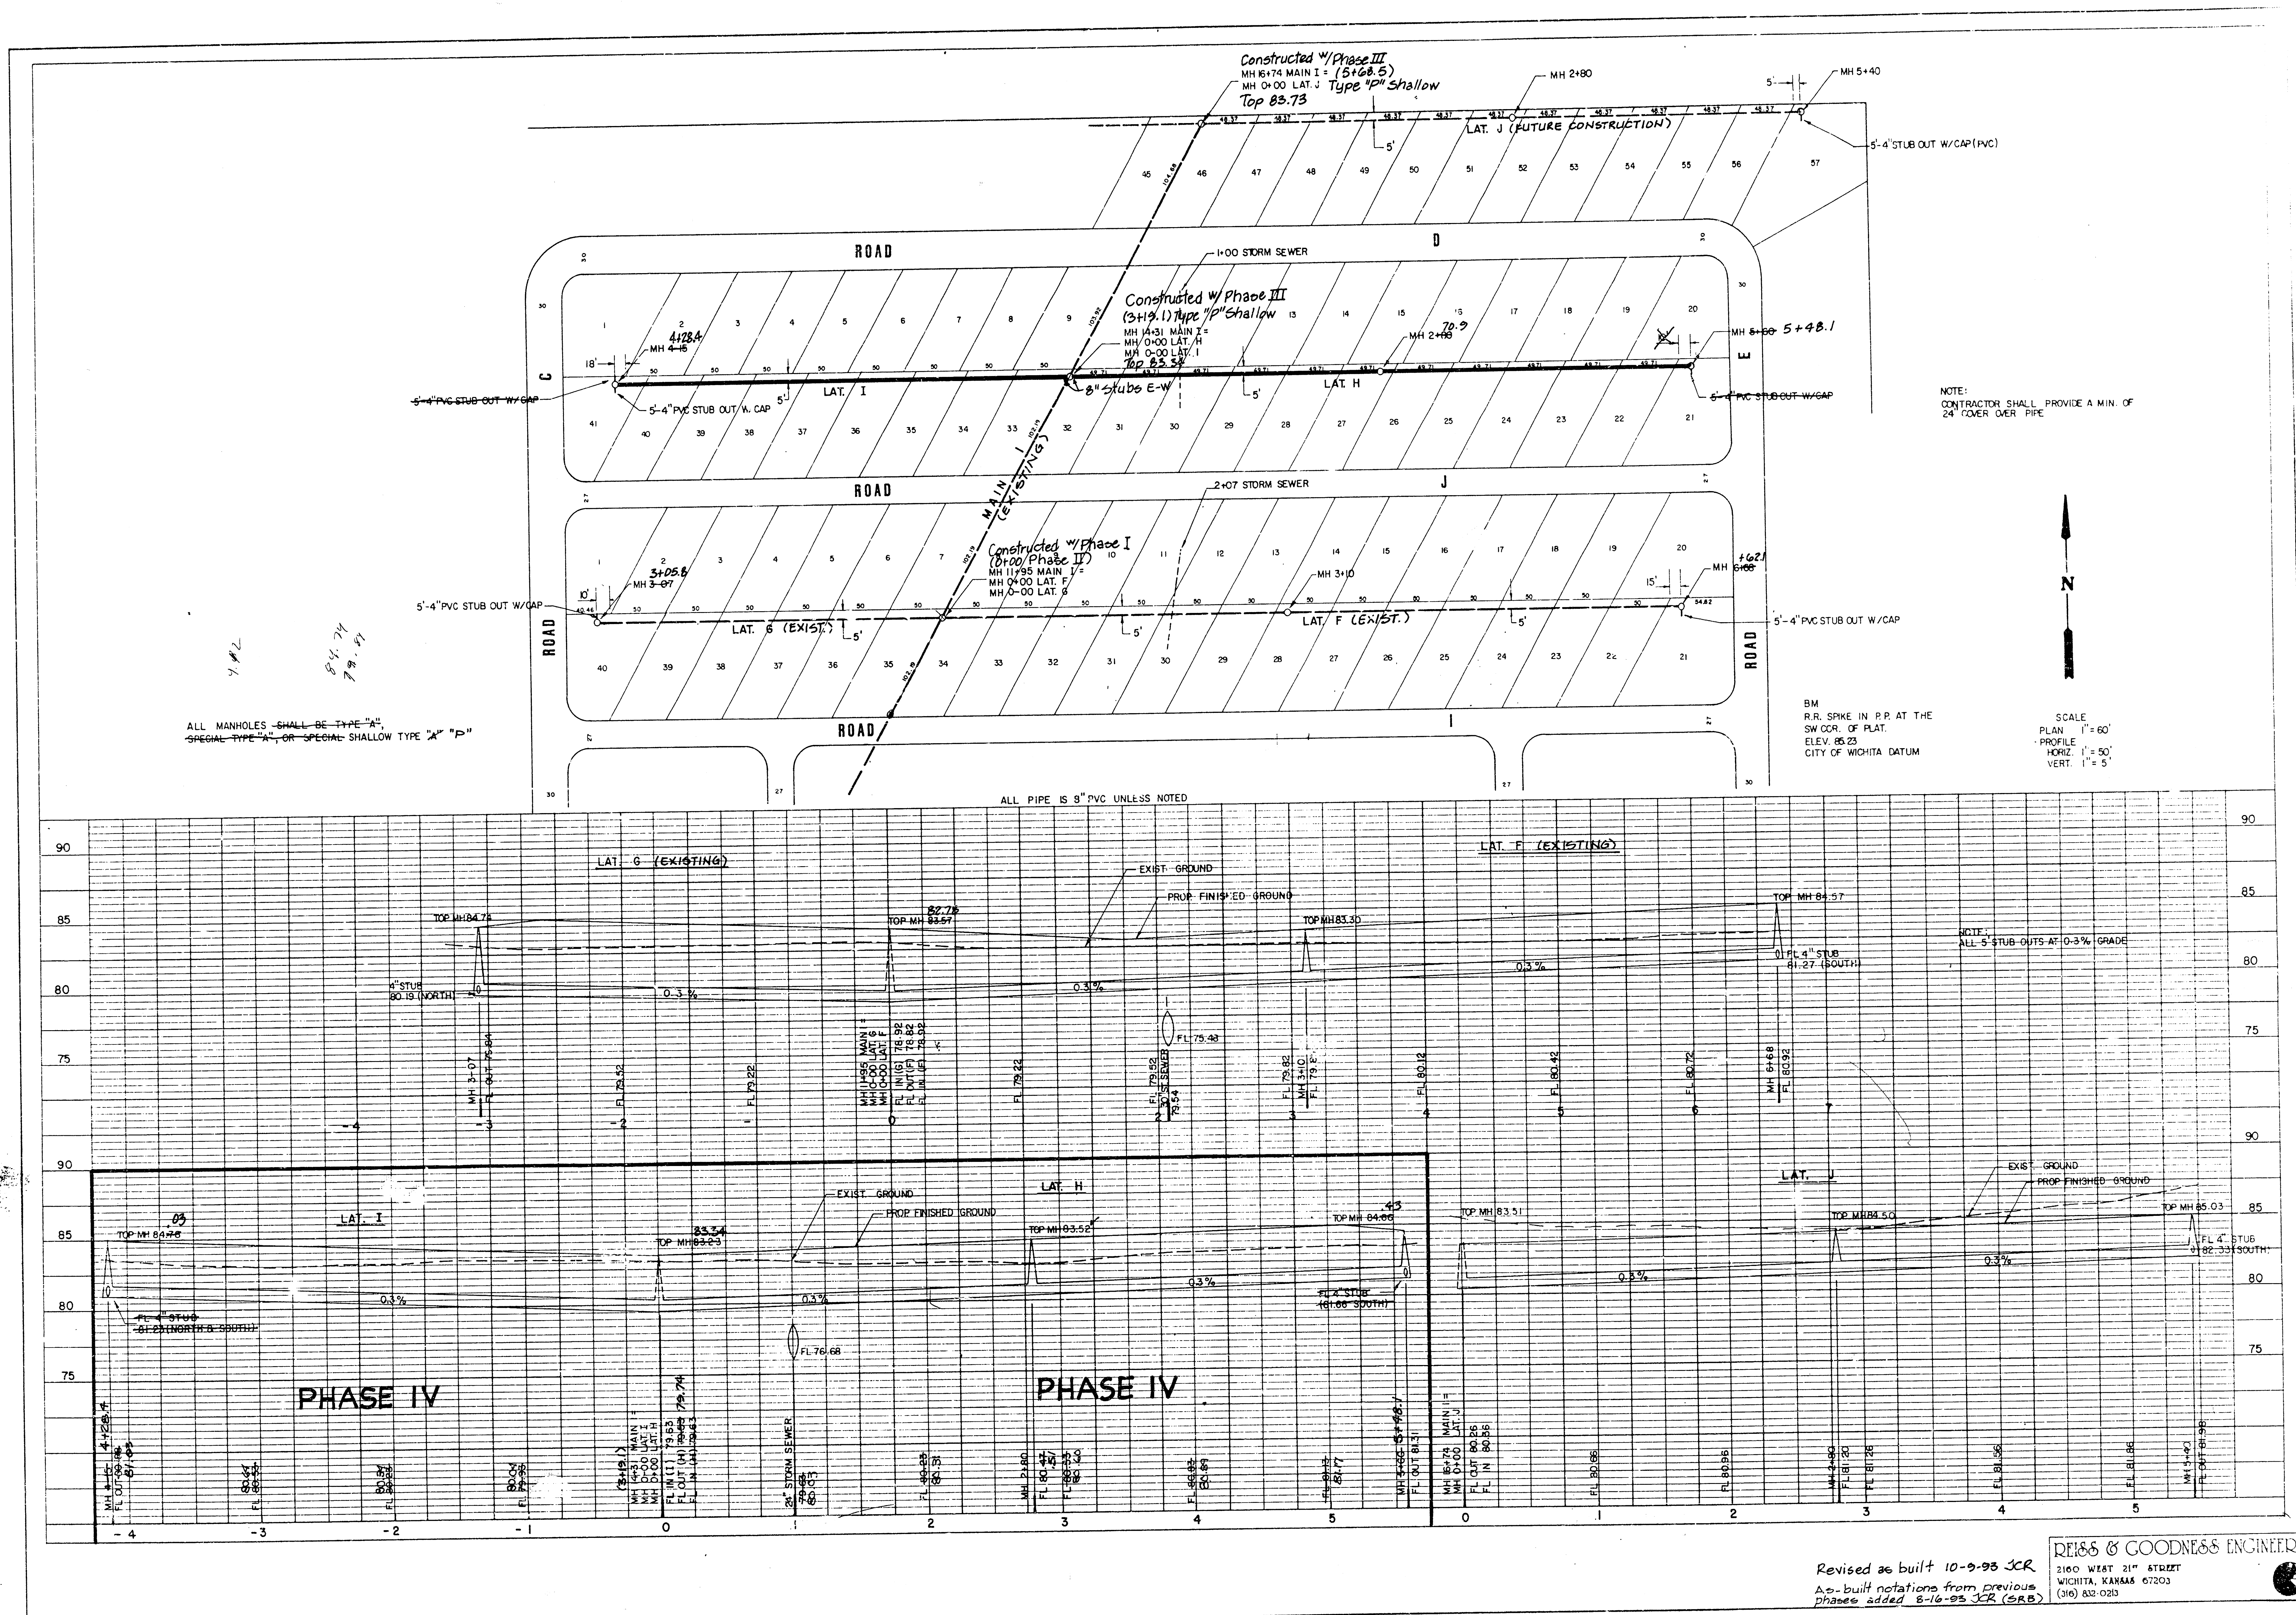

ALL MANHOLES SHALL BE TYPE "A",
SPECIAL TYPE "A", OR SPECIAL SHALLOW TYPE "A" "P"

NOTE:
CONTRACTOR SHALL PROVIDE A MIN. OF
24" COVER OVER PIPE

BM
R.R. SPIKE IN P.P. AT THE
SW COR. OF PLAT.
ELEV. 85.23
CITY OF WICHITA DATUM



SCALE
PLAN 1" = 60'
PROFILE 1" = 50'
VERT. 1" = 5'

ALL PIPE IS 8" PVC UNLESS NOTED

NOTE:
ALL 5" STUB-OUTS AT 0.3% GRADE

Revised as built 10-9-93 JCR
As-built notations from previous
phases added 8-16-93 JCR (SRB)

REISS & GOODNESS ENGINEERS
2100 WEST 21ST STREET
WICHITA, KANSAS 67203
(316) 832-0213