


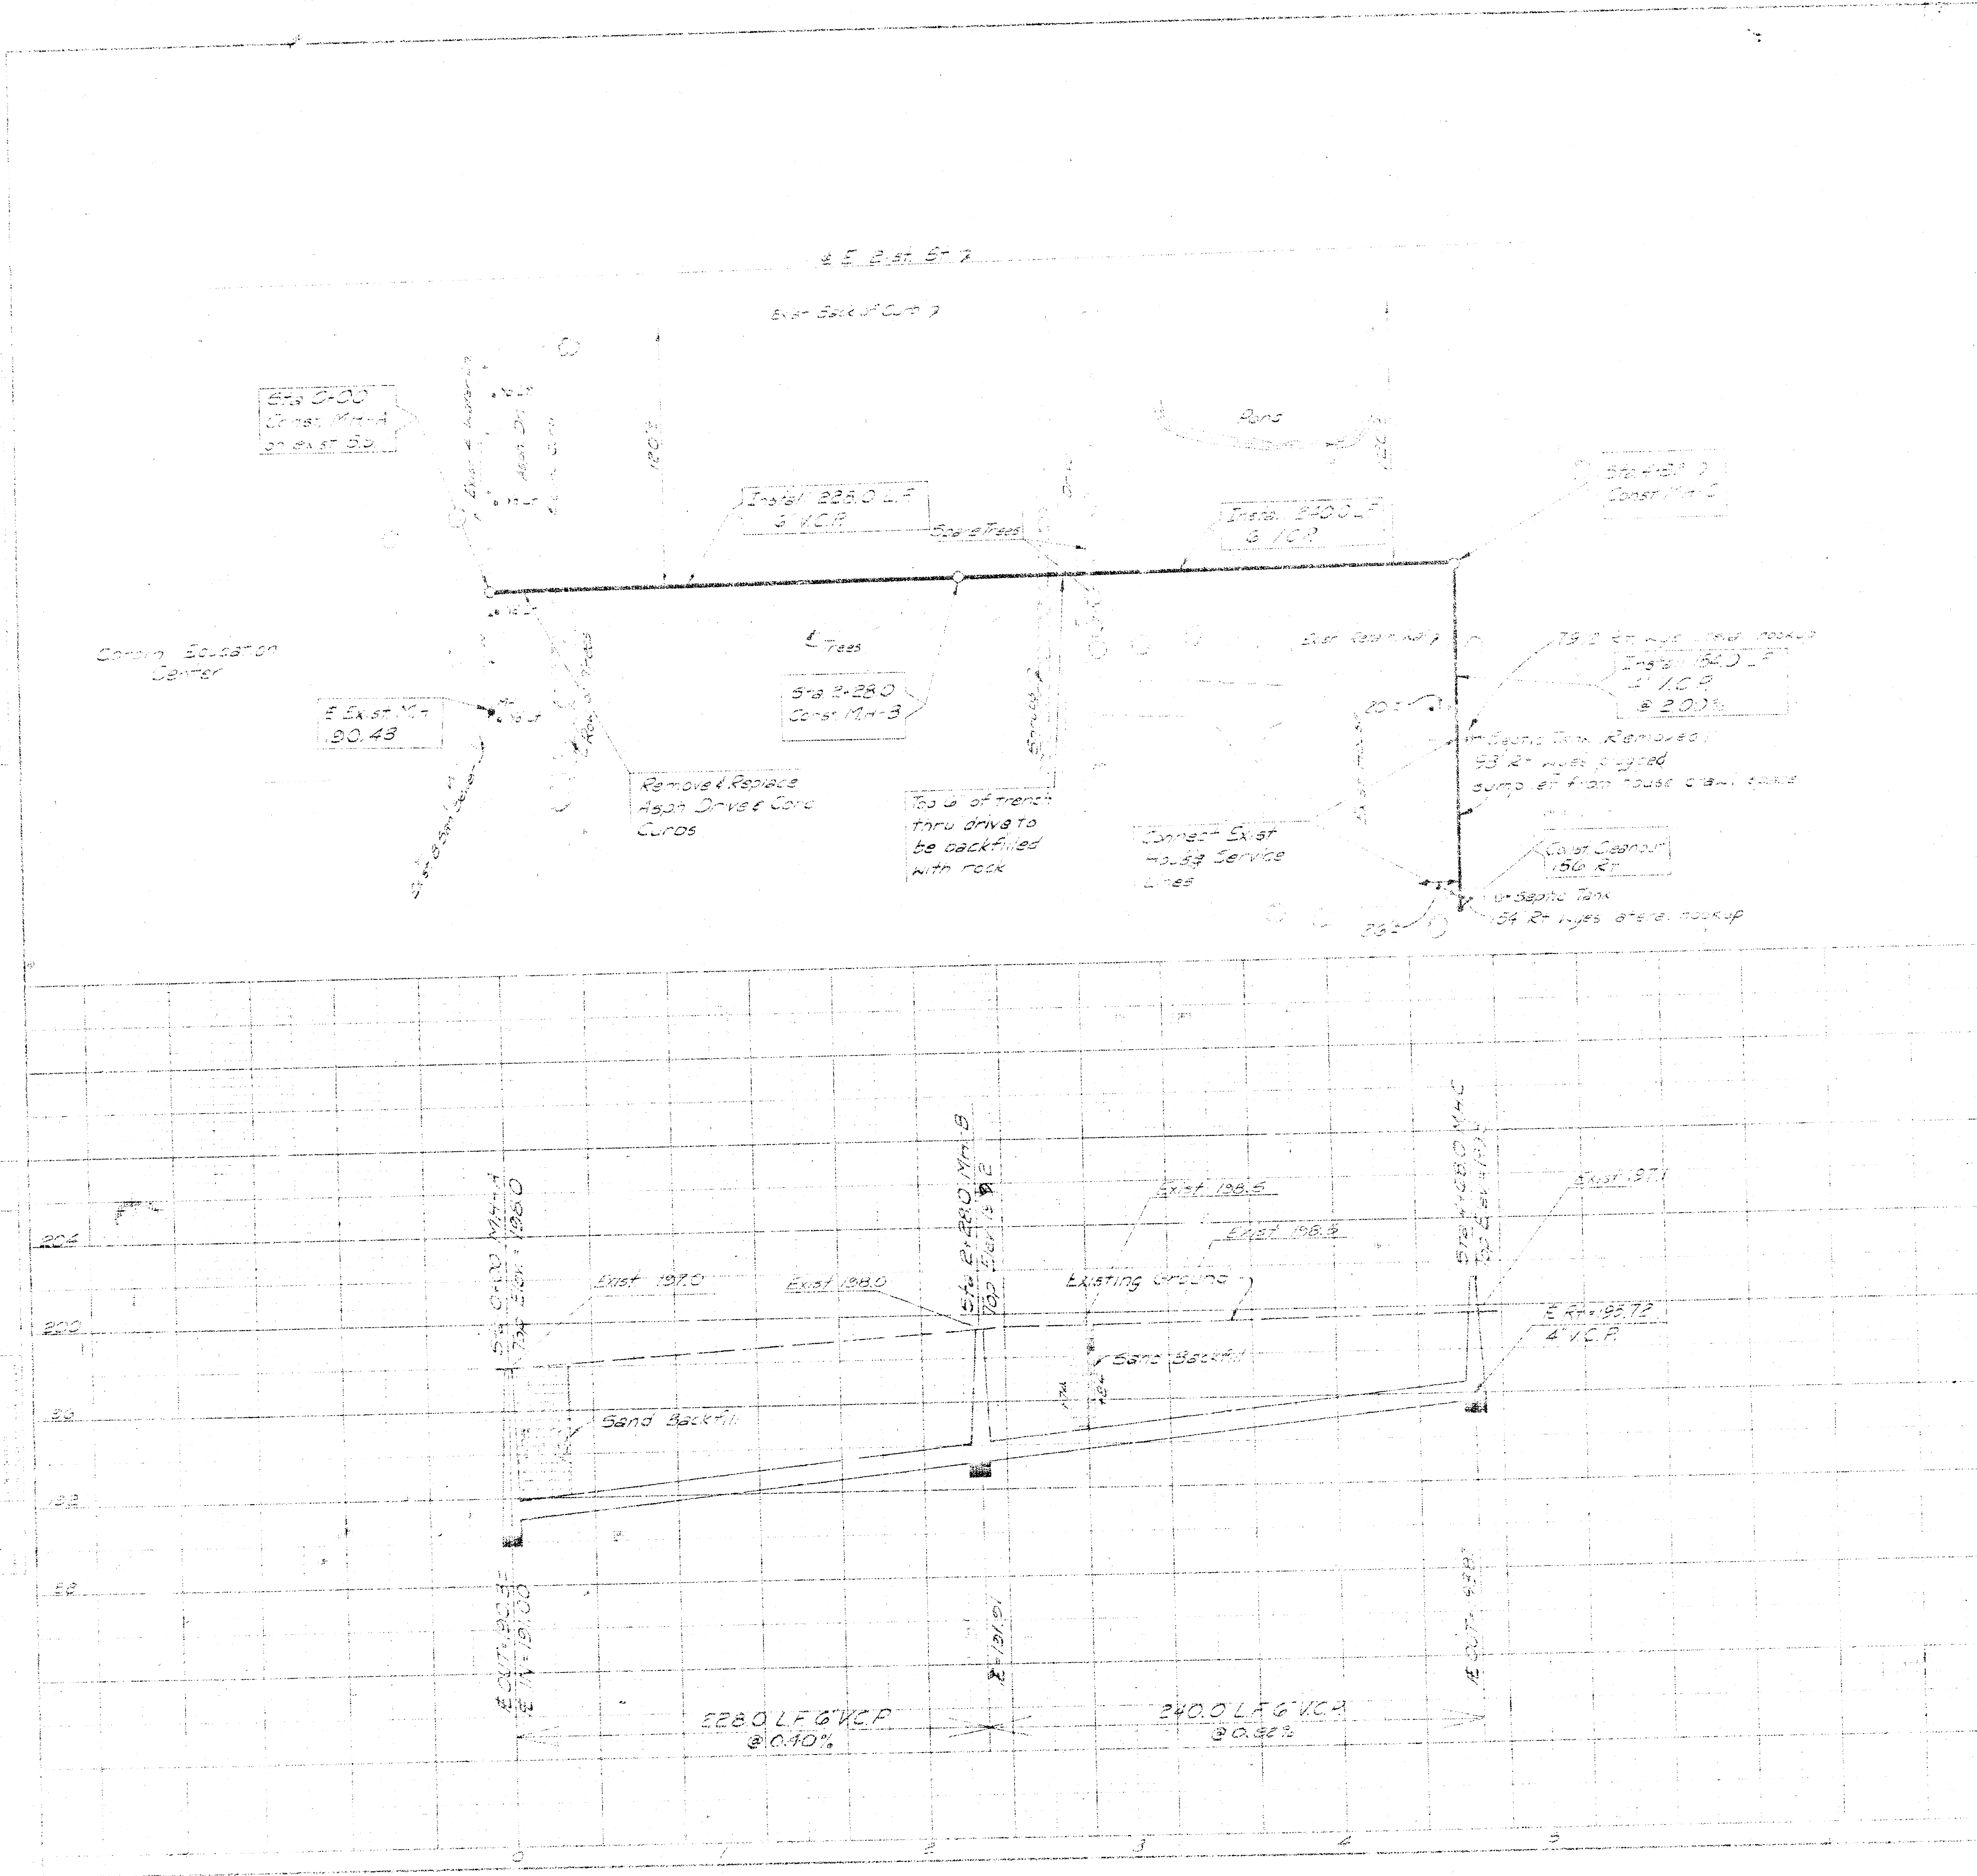

Scale:  
1" = 40'  
1" = 80'  
1" = 120'

NOTES

1. Manholes to be City of Wichita Standard Manholes. This includes manholes 2, 3, 4, 99, 100.
2. Manholes and Sewer Lines to be constructed in accordance with City of Wichita Sewer Regulations for these items.

"As Built" Booked on J-148

WICHITA STATE UNIVERSITY  
LANDSHAWNE HOUSE  
SEWER REPLACEMENT

6-22-79

BHKB 503040