


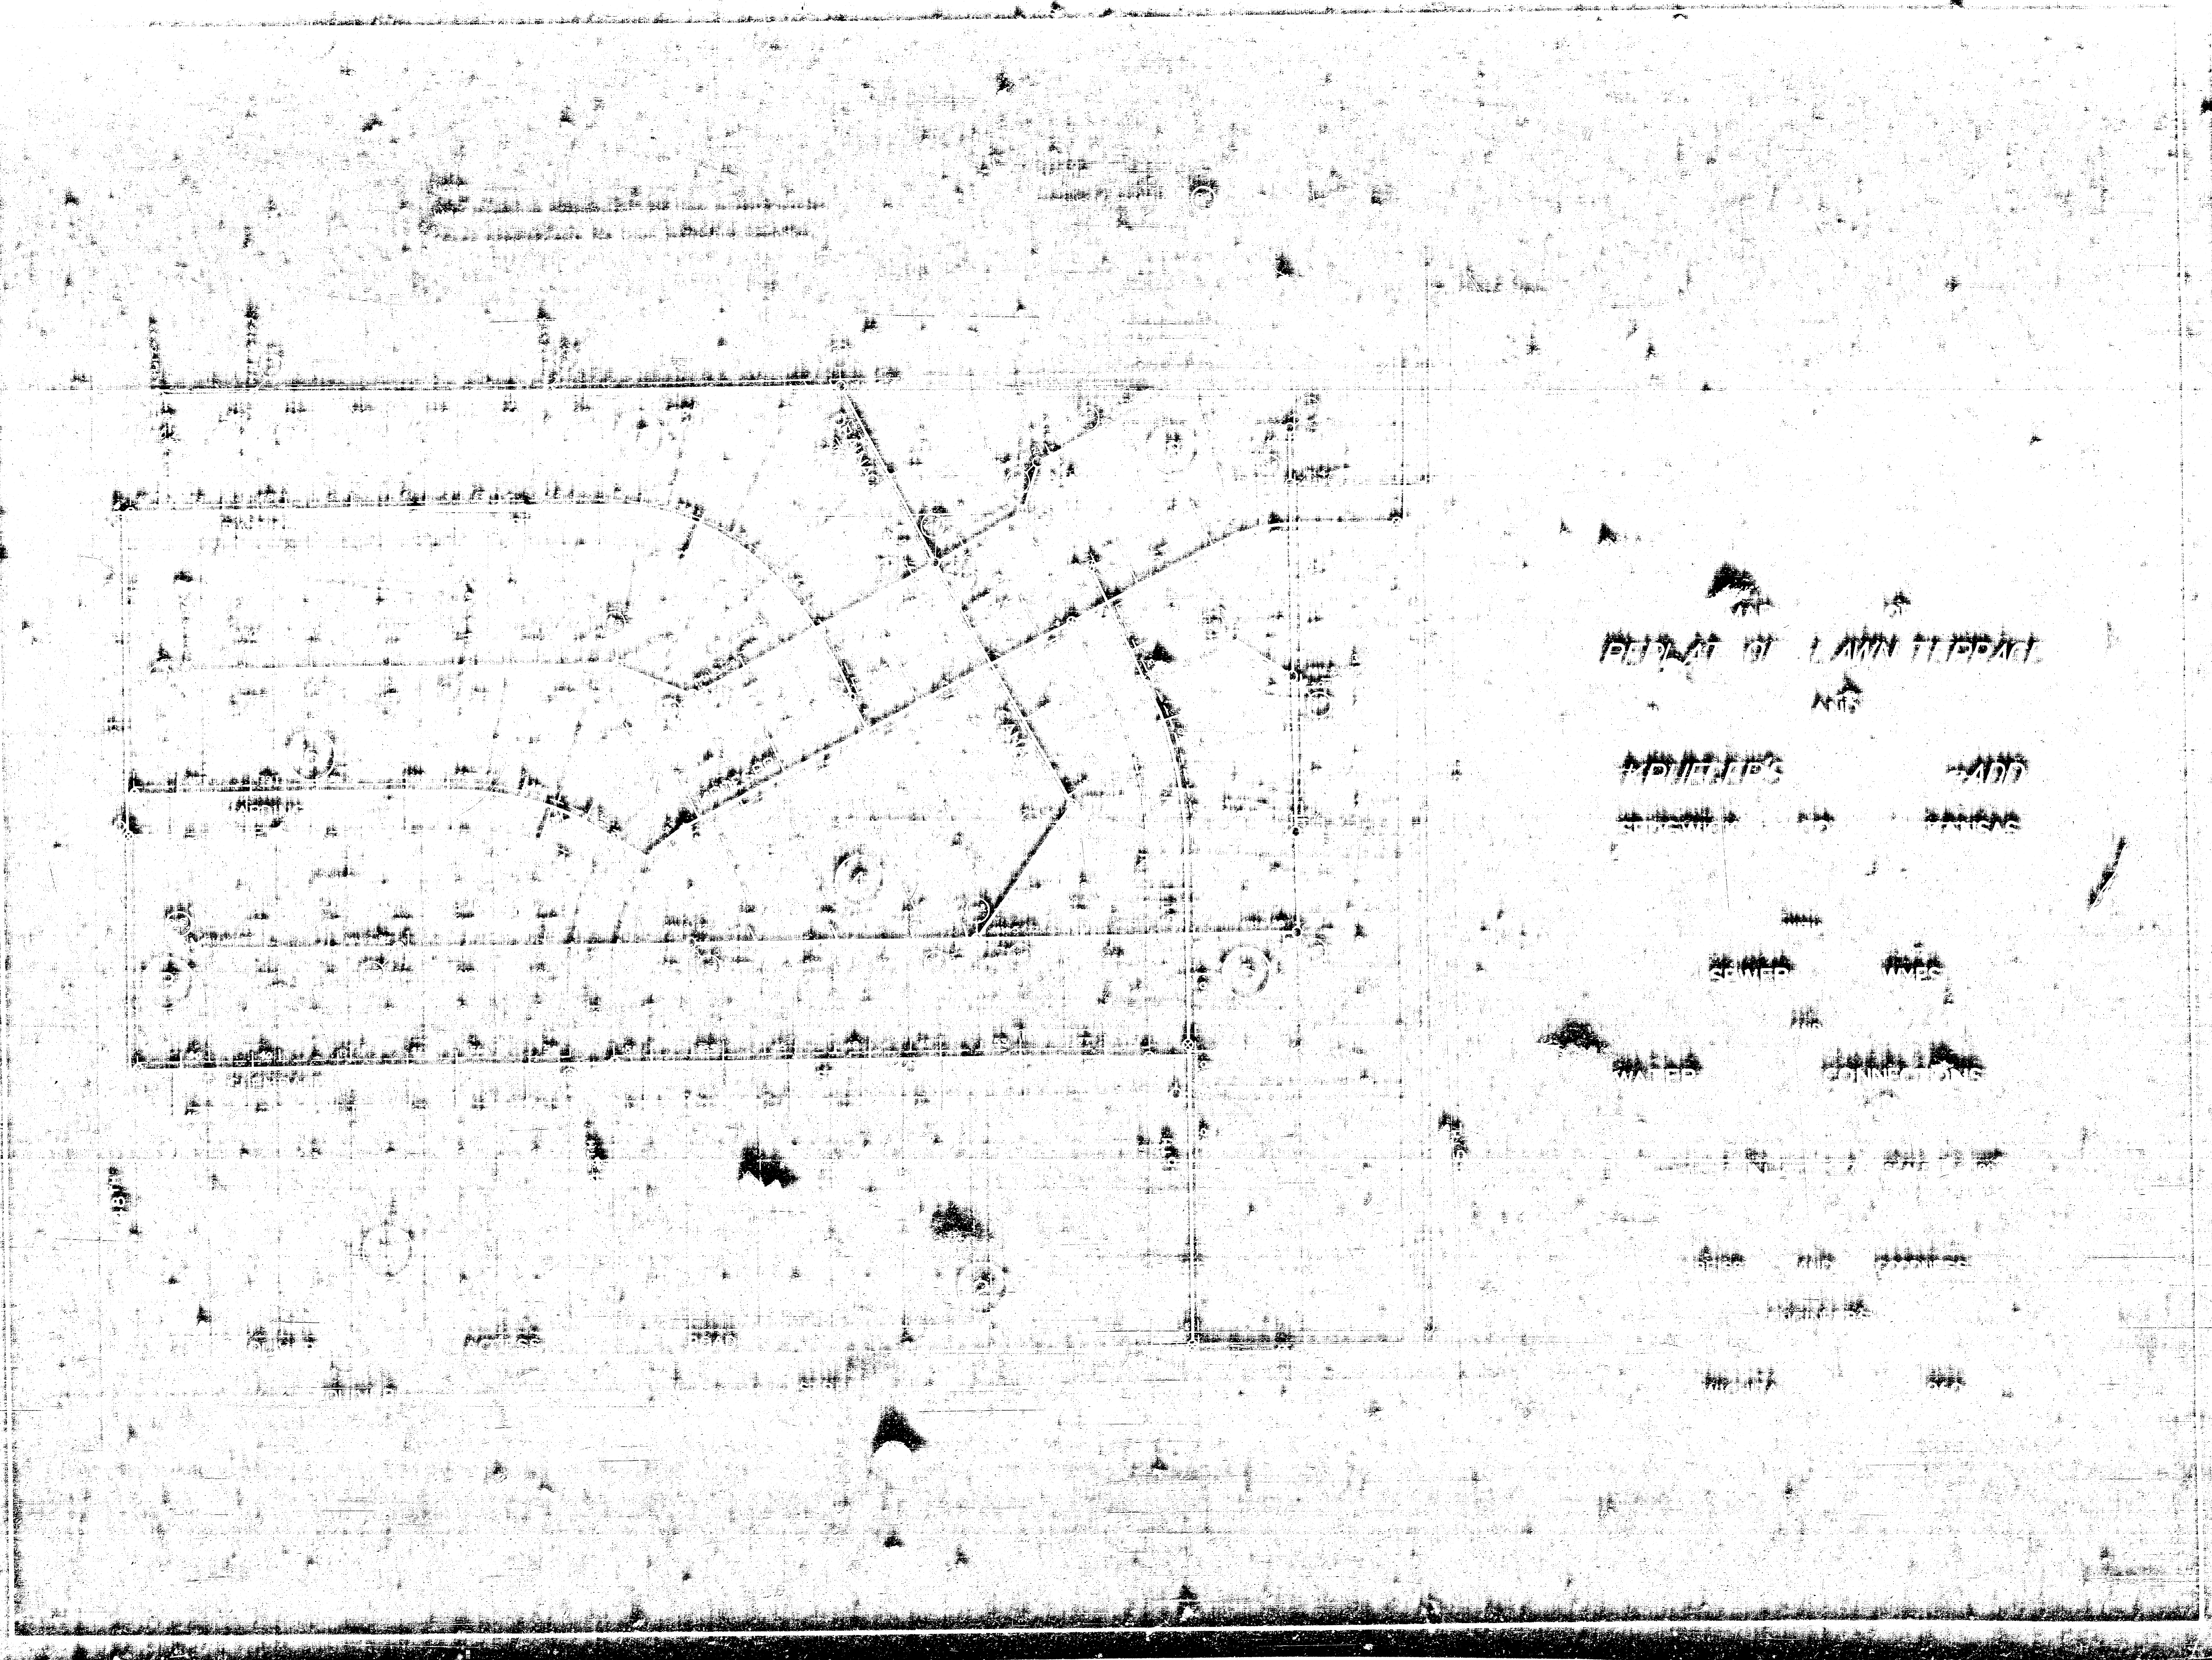


NOTE

Water connection measurements are shown property corners.

Survey measurements are shown preceding markers.

NOTED

NOTED DEPTH (5')

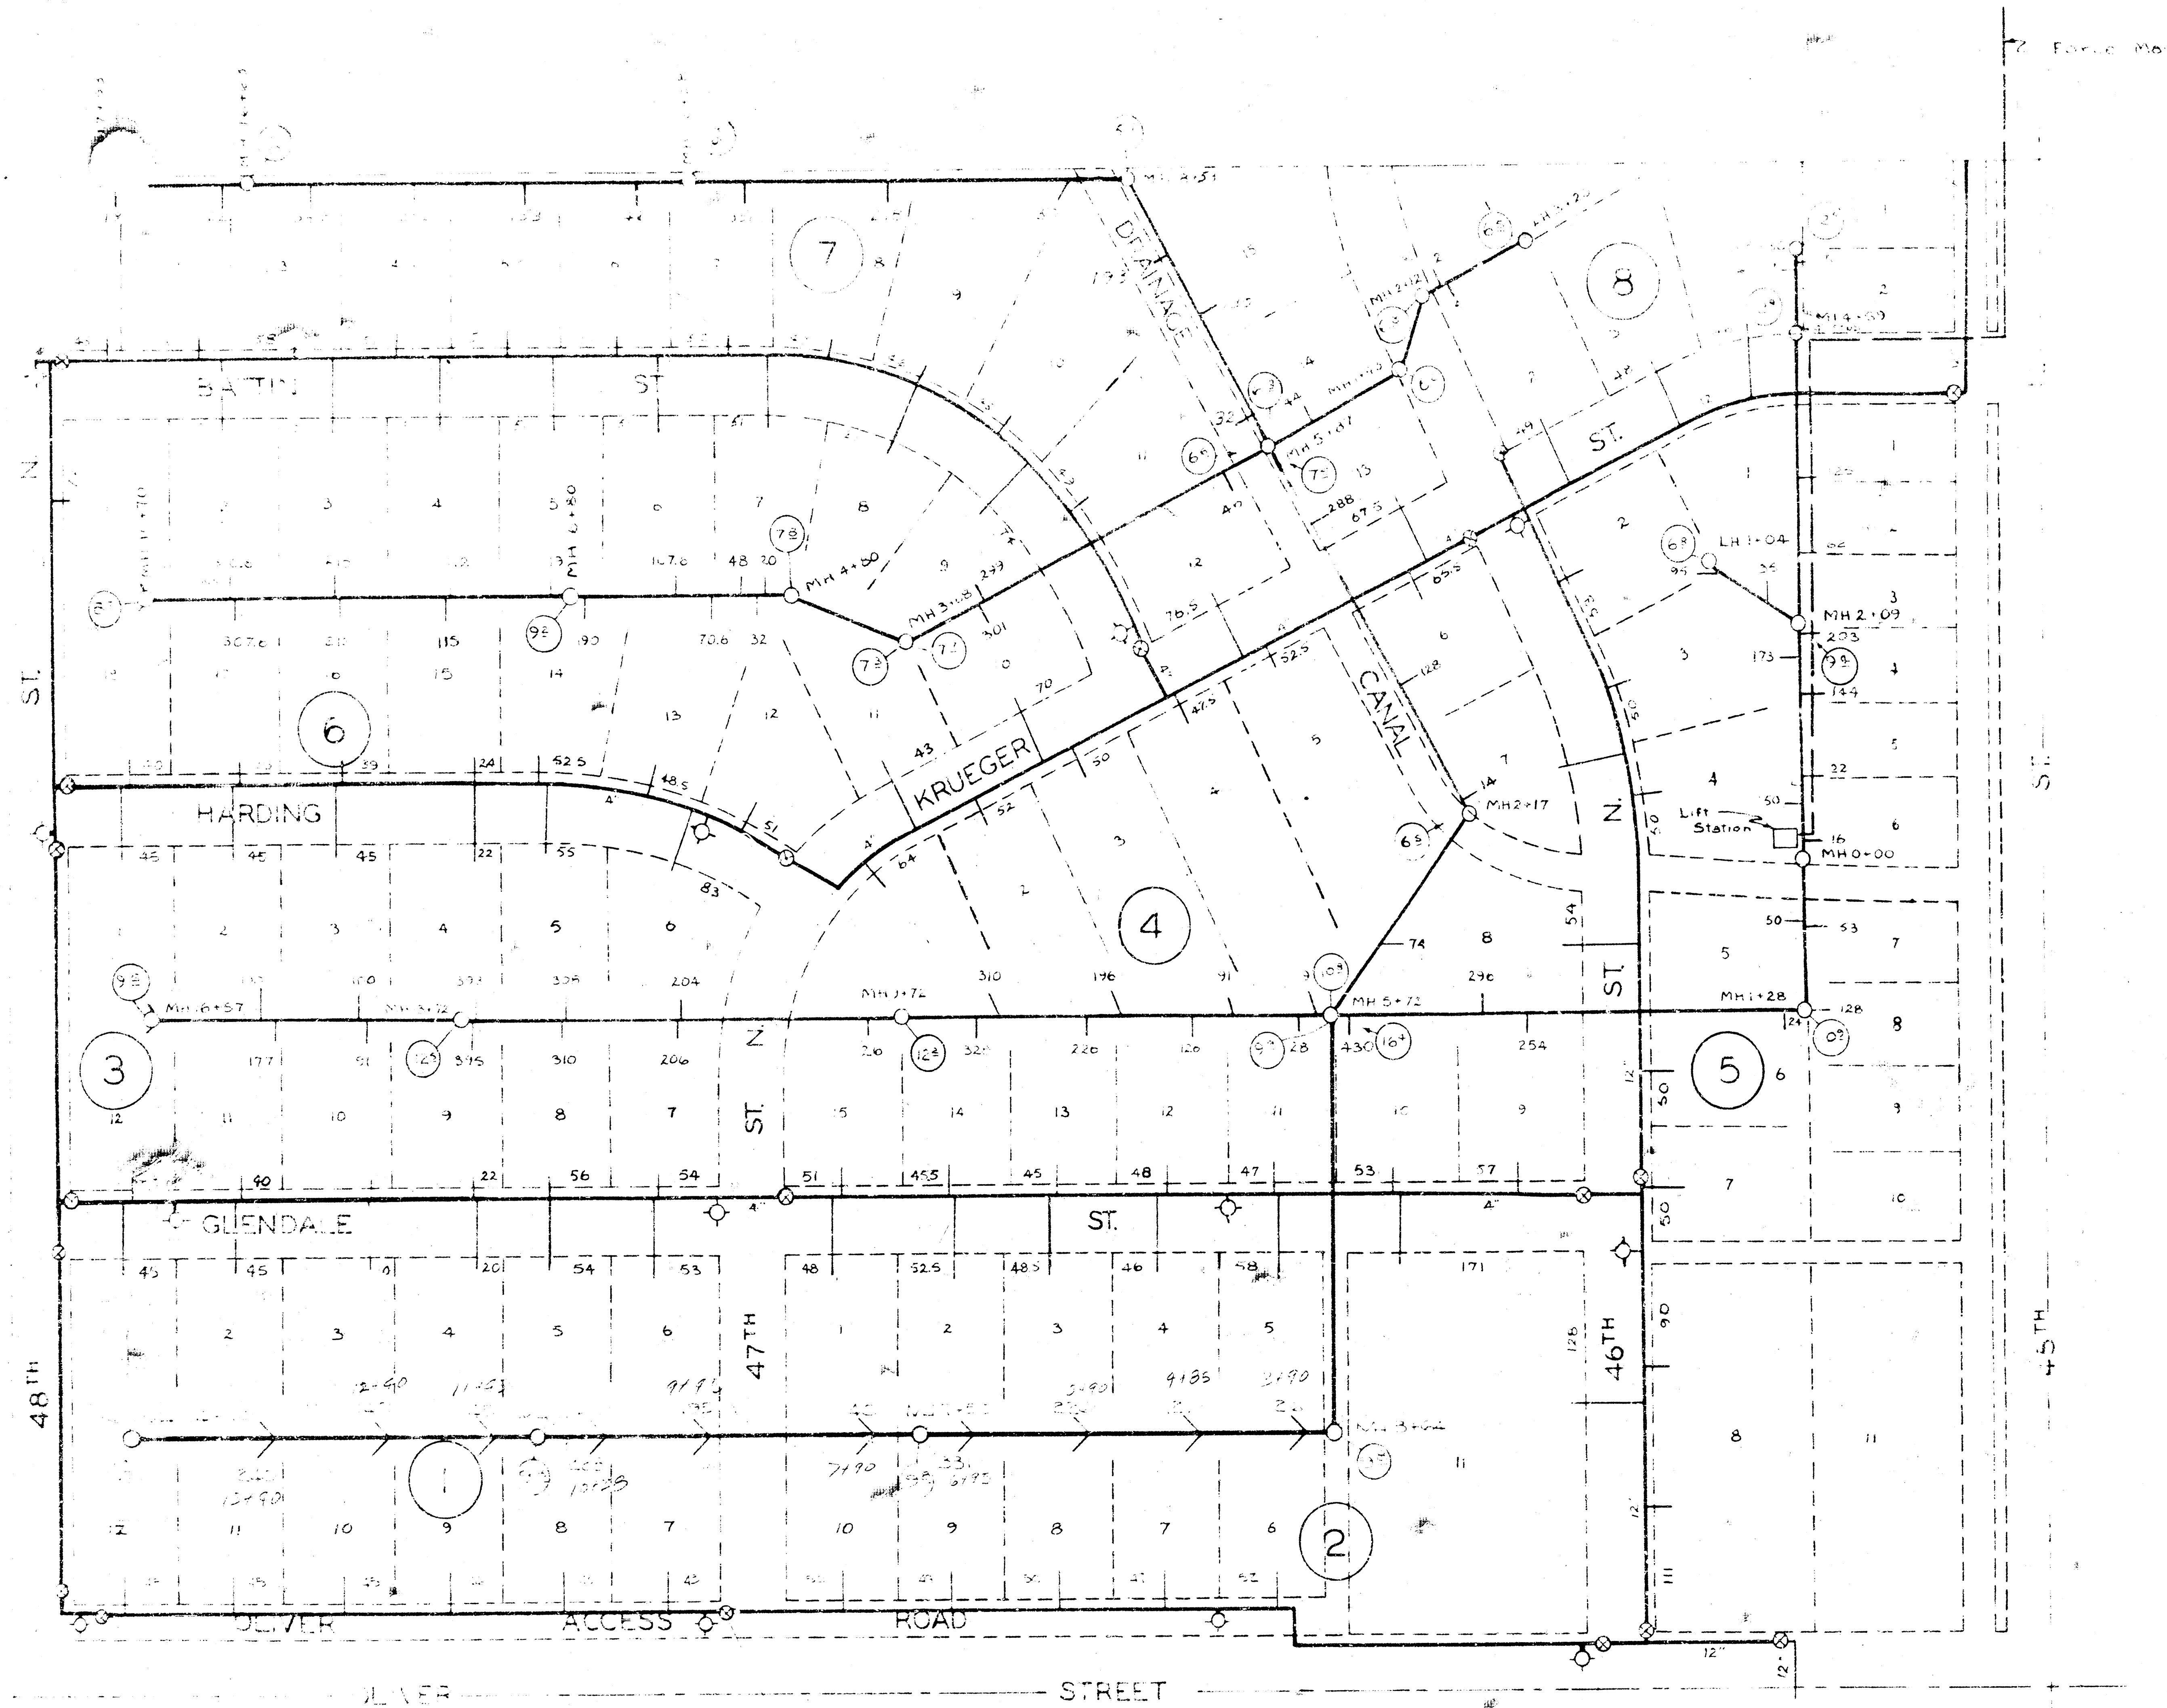

MAP OF
REPLAT OF LAWN TERRACE
AND
KRUEGER'S ADD.
SEDGWICK CO. KANSAS

WITH
SEWER WYES
AND
WATER CONNECTIONS

SCALE 1" = 100'

REISS AND GOODNESS
ENGINEERS

WICHITA 1960

SEE TO BACK OF MAP
FOR TO POWER POLE
AND TO BRICK ENTRANCE

SEE TO POWER POLE
AND TO BRICK ENTRANCE
AND TO BRICK ENTRANCE

SEE TO POWER POLE
AND TO BRICK ENTRANCE
AND TO BRICK ENTRANCE