
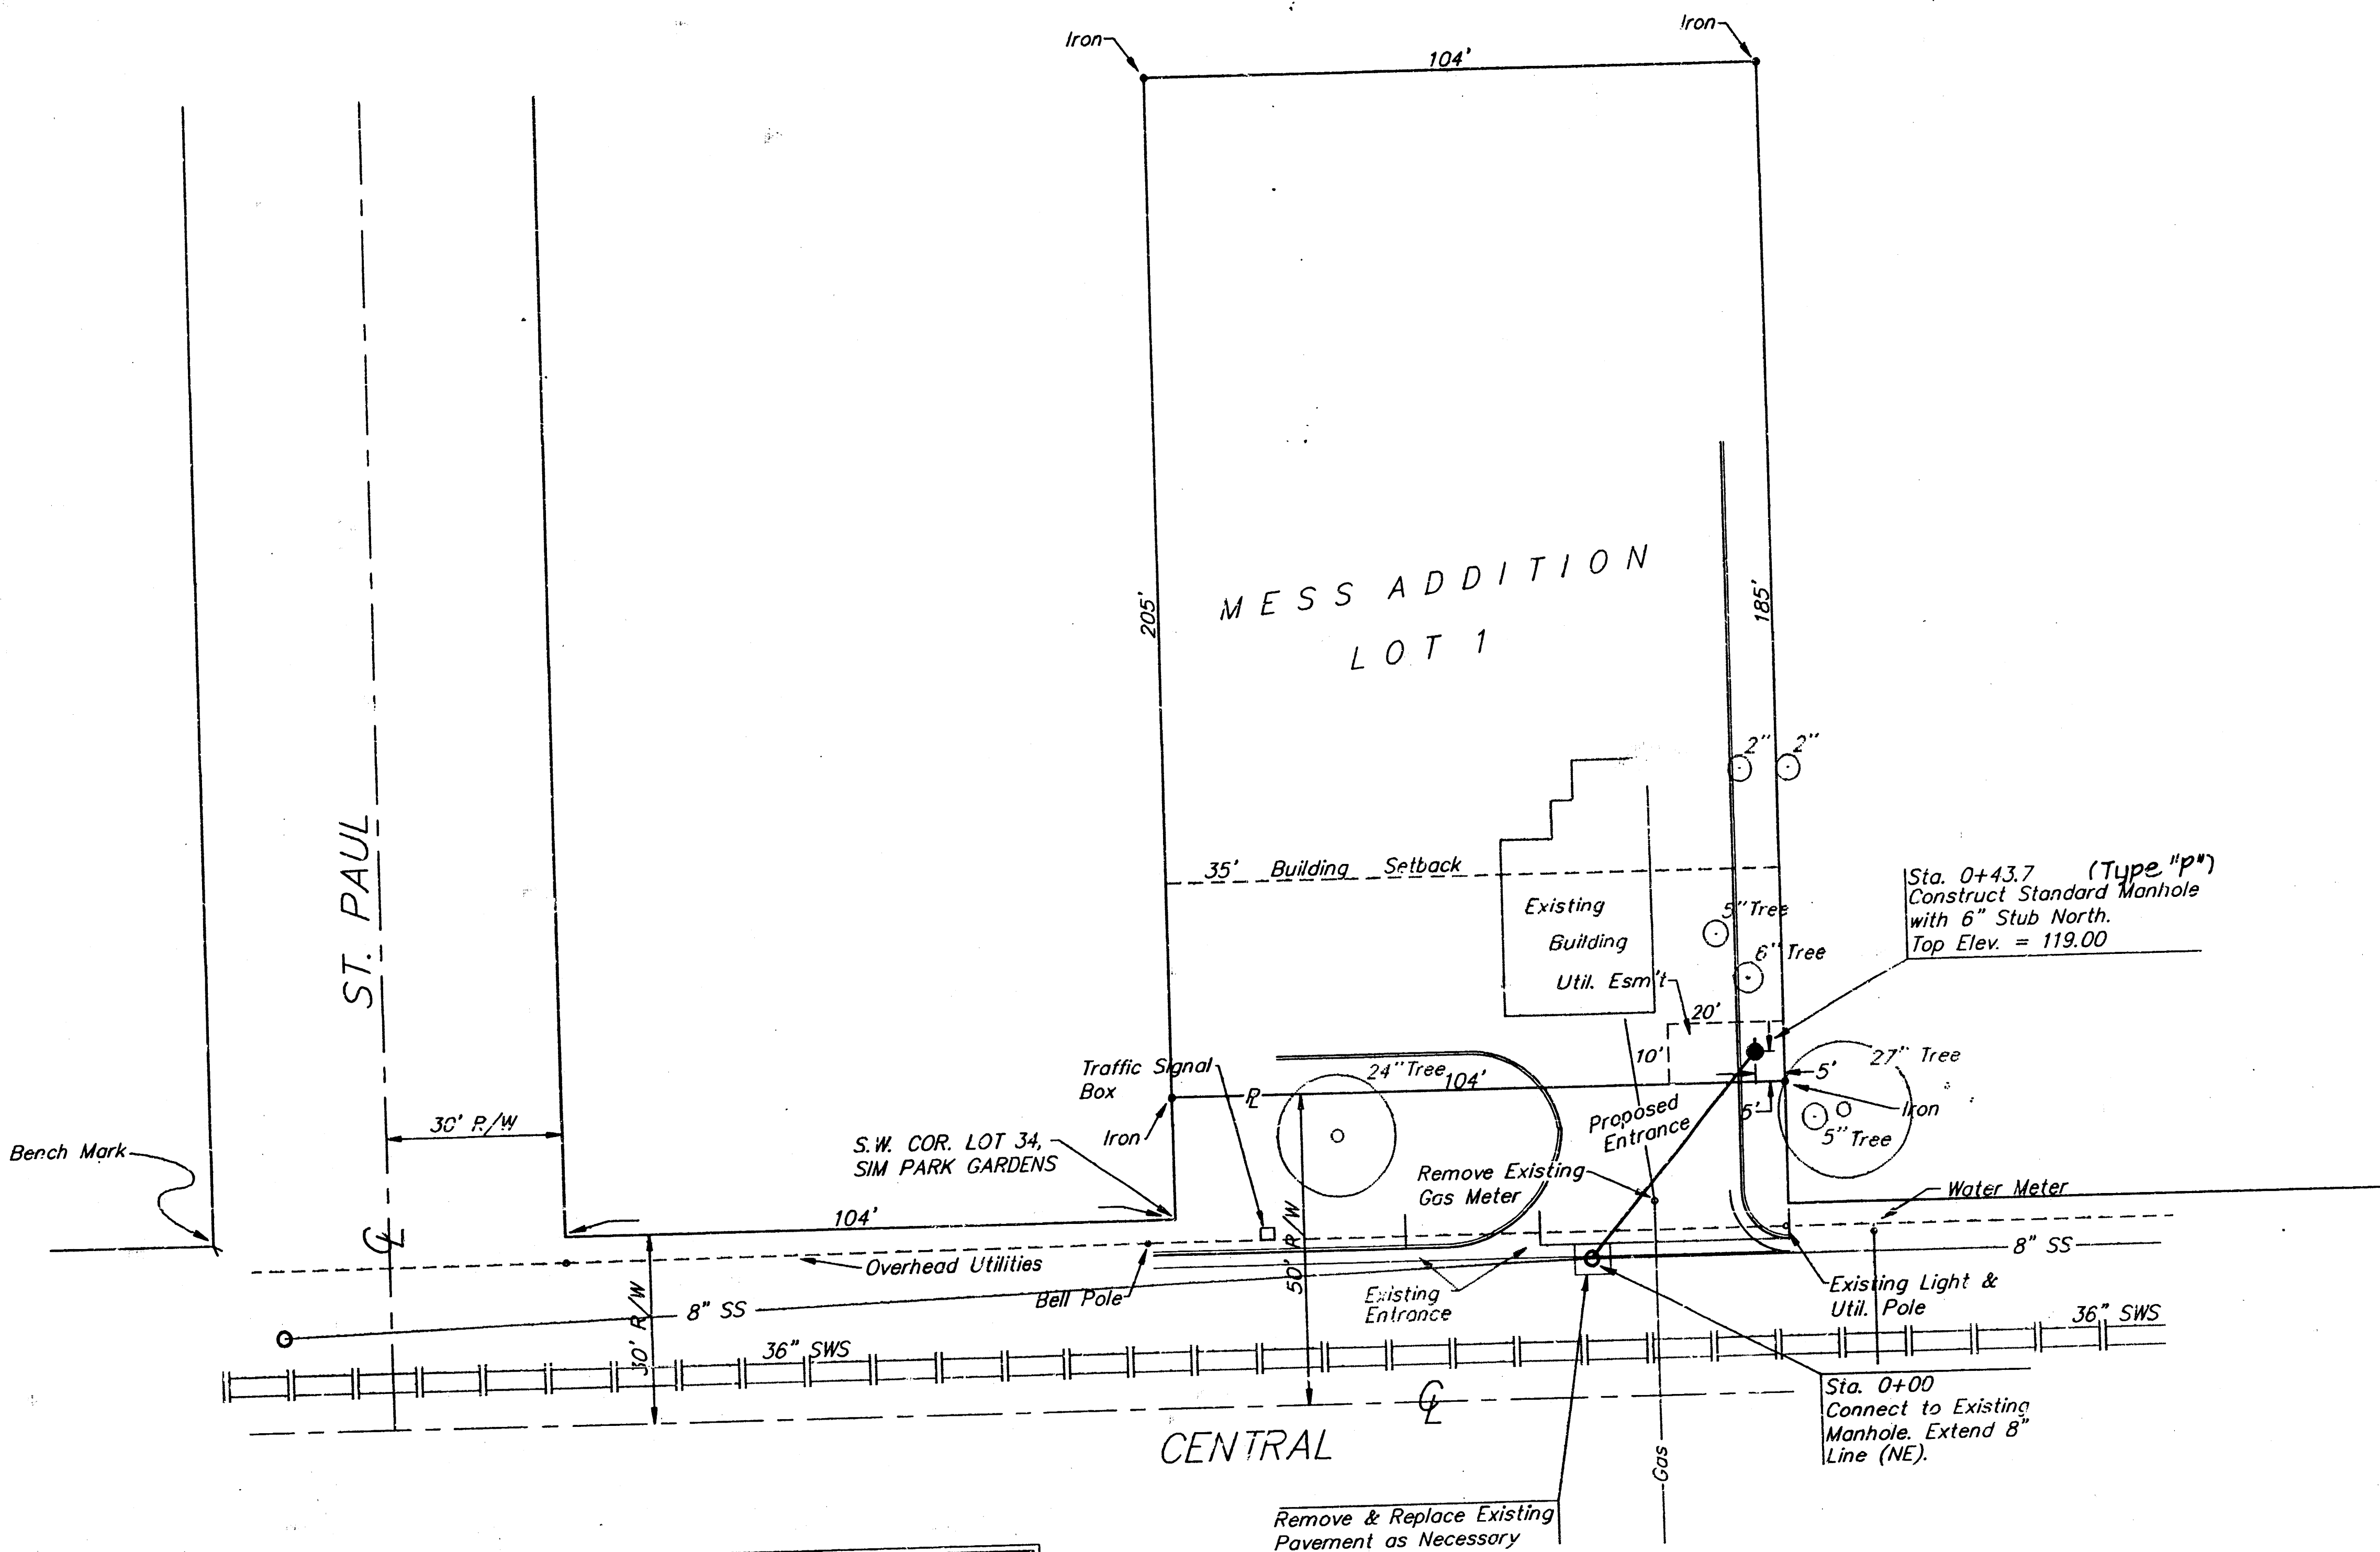



Bench Mark: V-Notch Chisled at N.W. Corner
of St. Paul & Central.
Elev. = 118.84 City Datum

SCALE:
1" = 20' HORIZONTAL
1" = 5' VERTICAL
• = IRON

Location Map

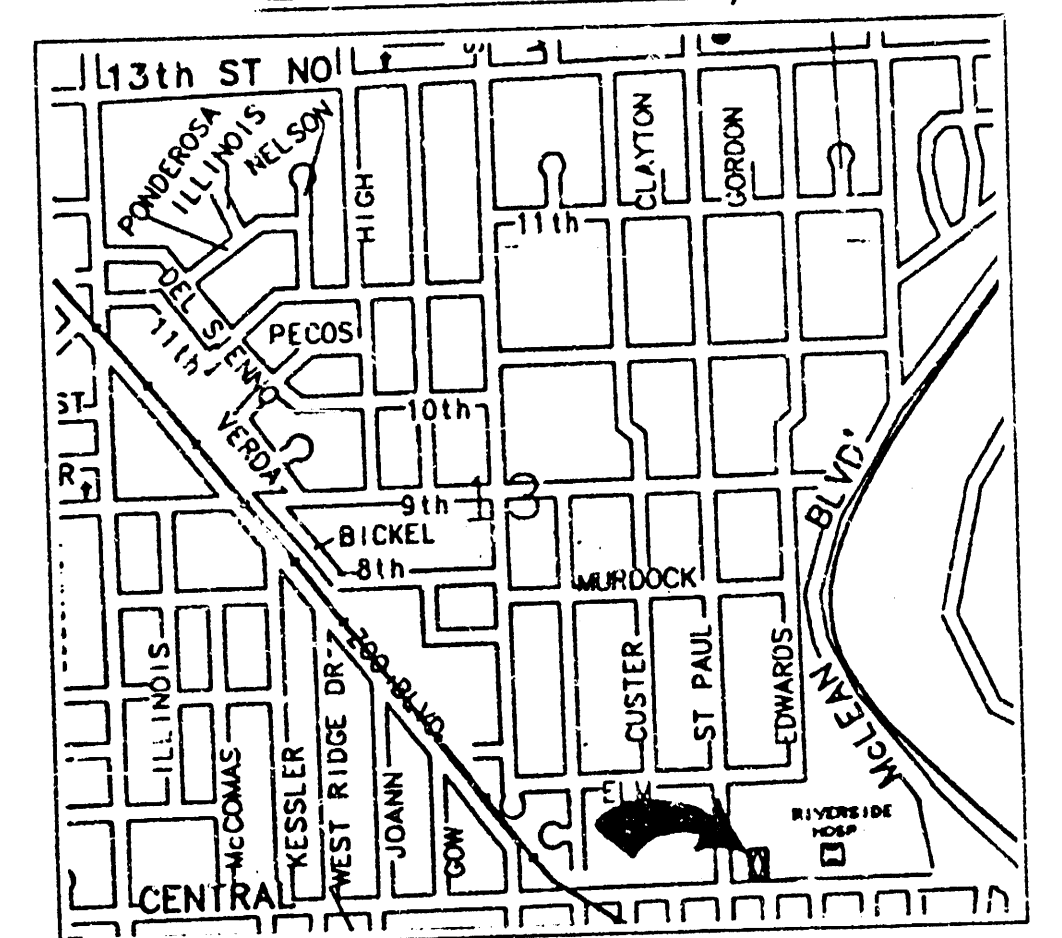

Note:
The Contractor shall maintain (1) one west bound
lane as to carry traffic through construction.

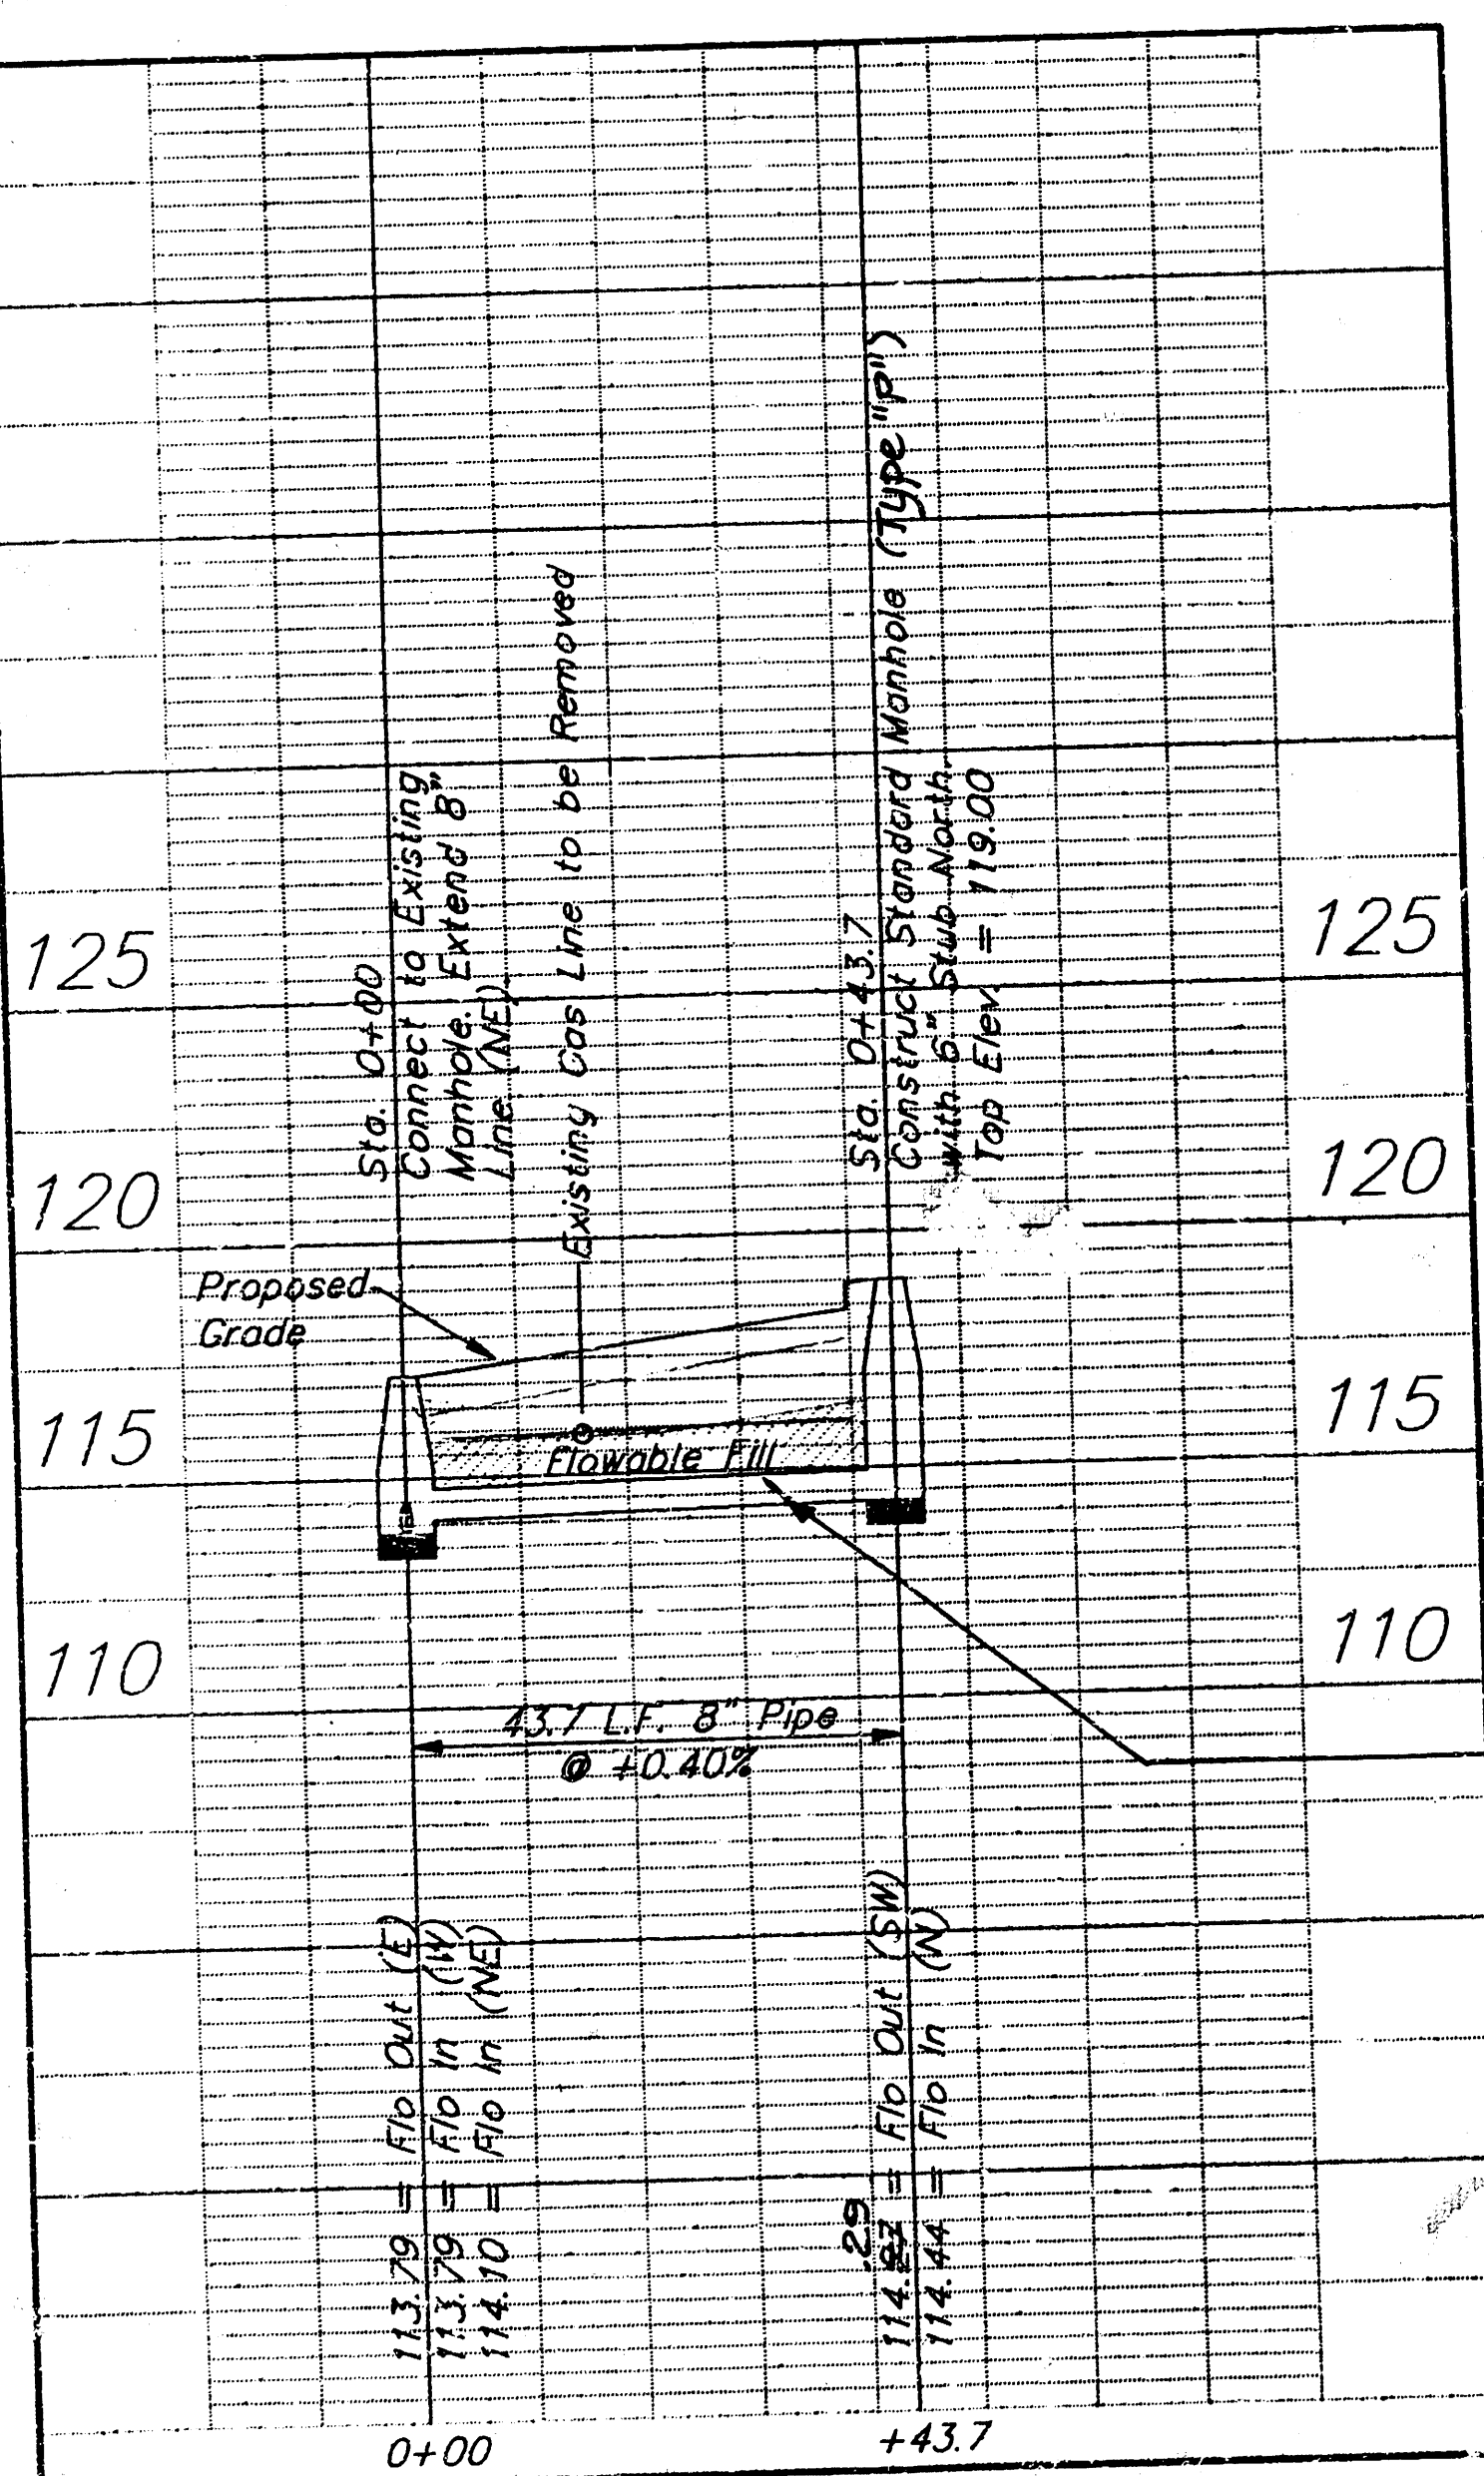

NOTE: Flushed sand backfill was used
in place of flowable fill

APPROVED AS NOTED
BY CITY ENGINEER OF WICHITA

Sanitary Sewers VRH 11/26/91

Storm Sewers _____

Driveway Approaches _____

Water Mains _____

Paving _____

NOTE TO CONTRACTORS

Inspection and testing for this project is to be provided by a Licensed Consulting Engineering Firm under contract with the Owner/Developer. Said inspection to be in accordance with the City of Wichita standard construction engineering practices and certified by a Licensed Professional Engineer. No work shall be performed in dedicated easements or public right-of-way by the Contractor without such inspection nor shall any work be commenced without written authorization by the City Engineer.

Booked JKB 2-7-92
Revised as built 12-23-91 TCR


Private Sanitary Sewer To Serve
MESS ADDITION

BAUGHMAN COMPANY P. A.
ENGINEERING & SURVEYING
316/262-7271 • 315 ELLIS • WICHITA, KANSAS 67211

PROJECT NUMBER
318PPS (607861)

DESIGN B.P. DRAWN B.P. UTIL CHECKED DATE 11-15-91 SCALE NOTED

SHEET 1 OF 1

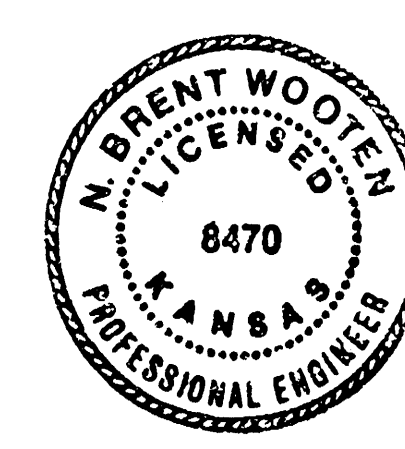

FILMED FROM THE BEST
AVAILABLE COPY