


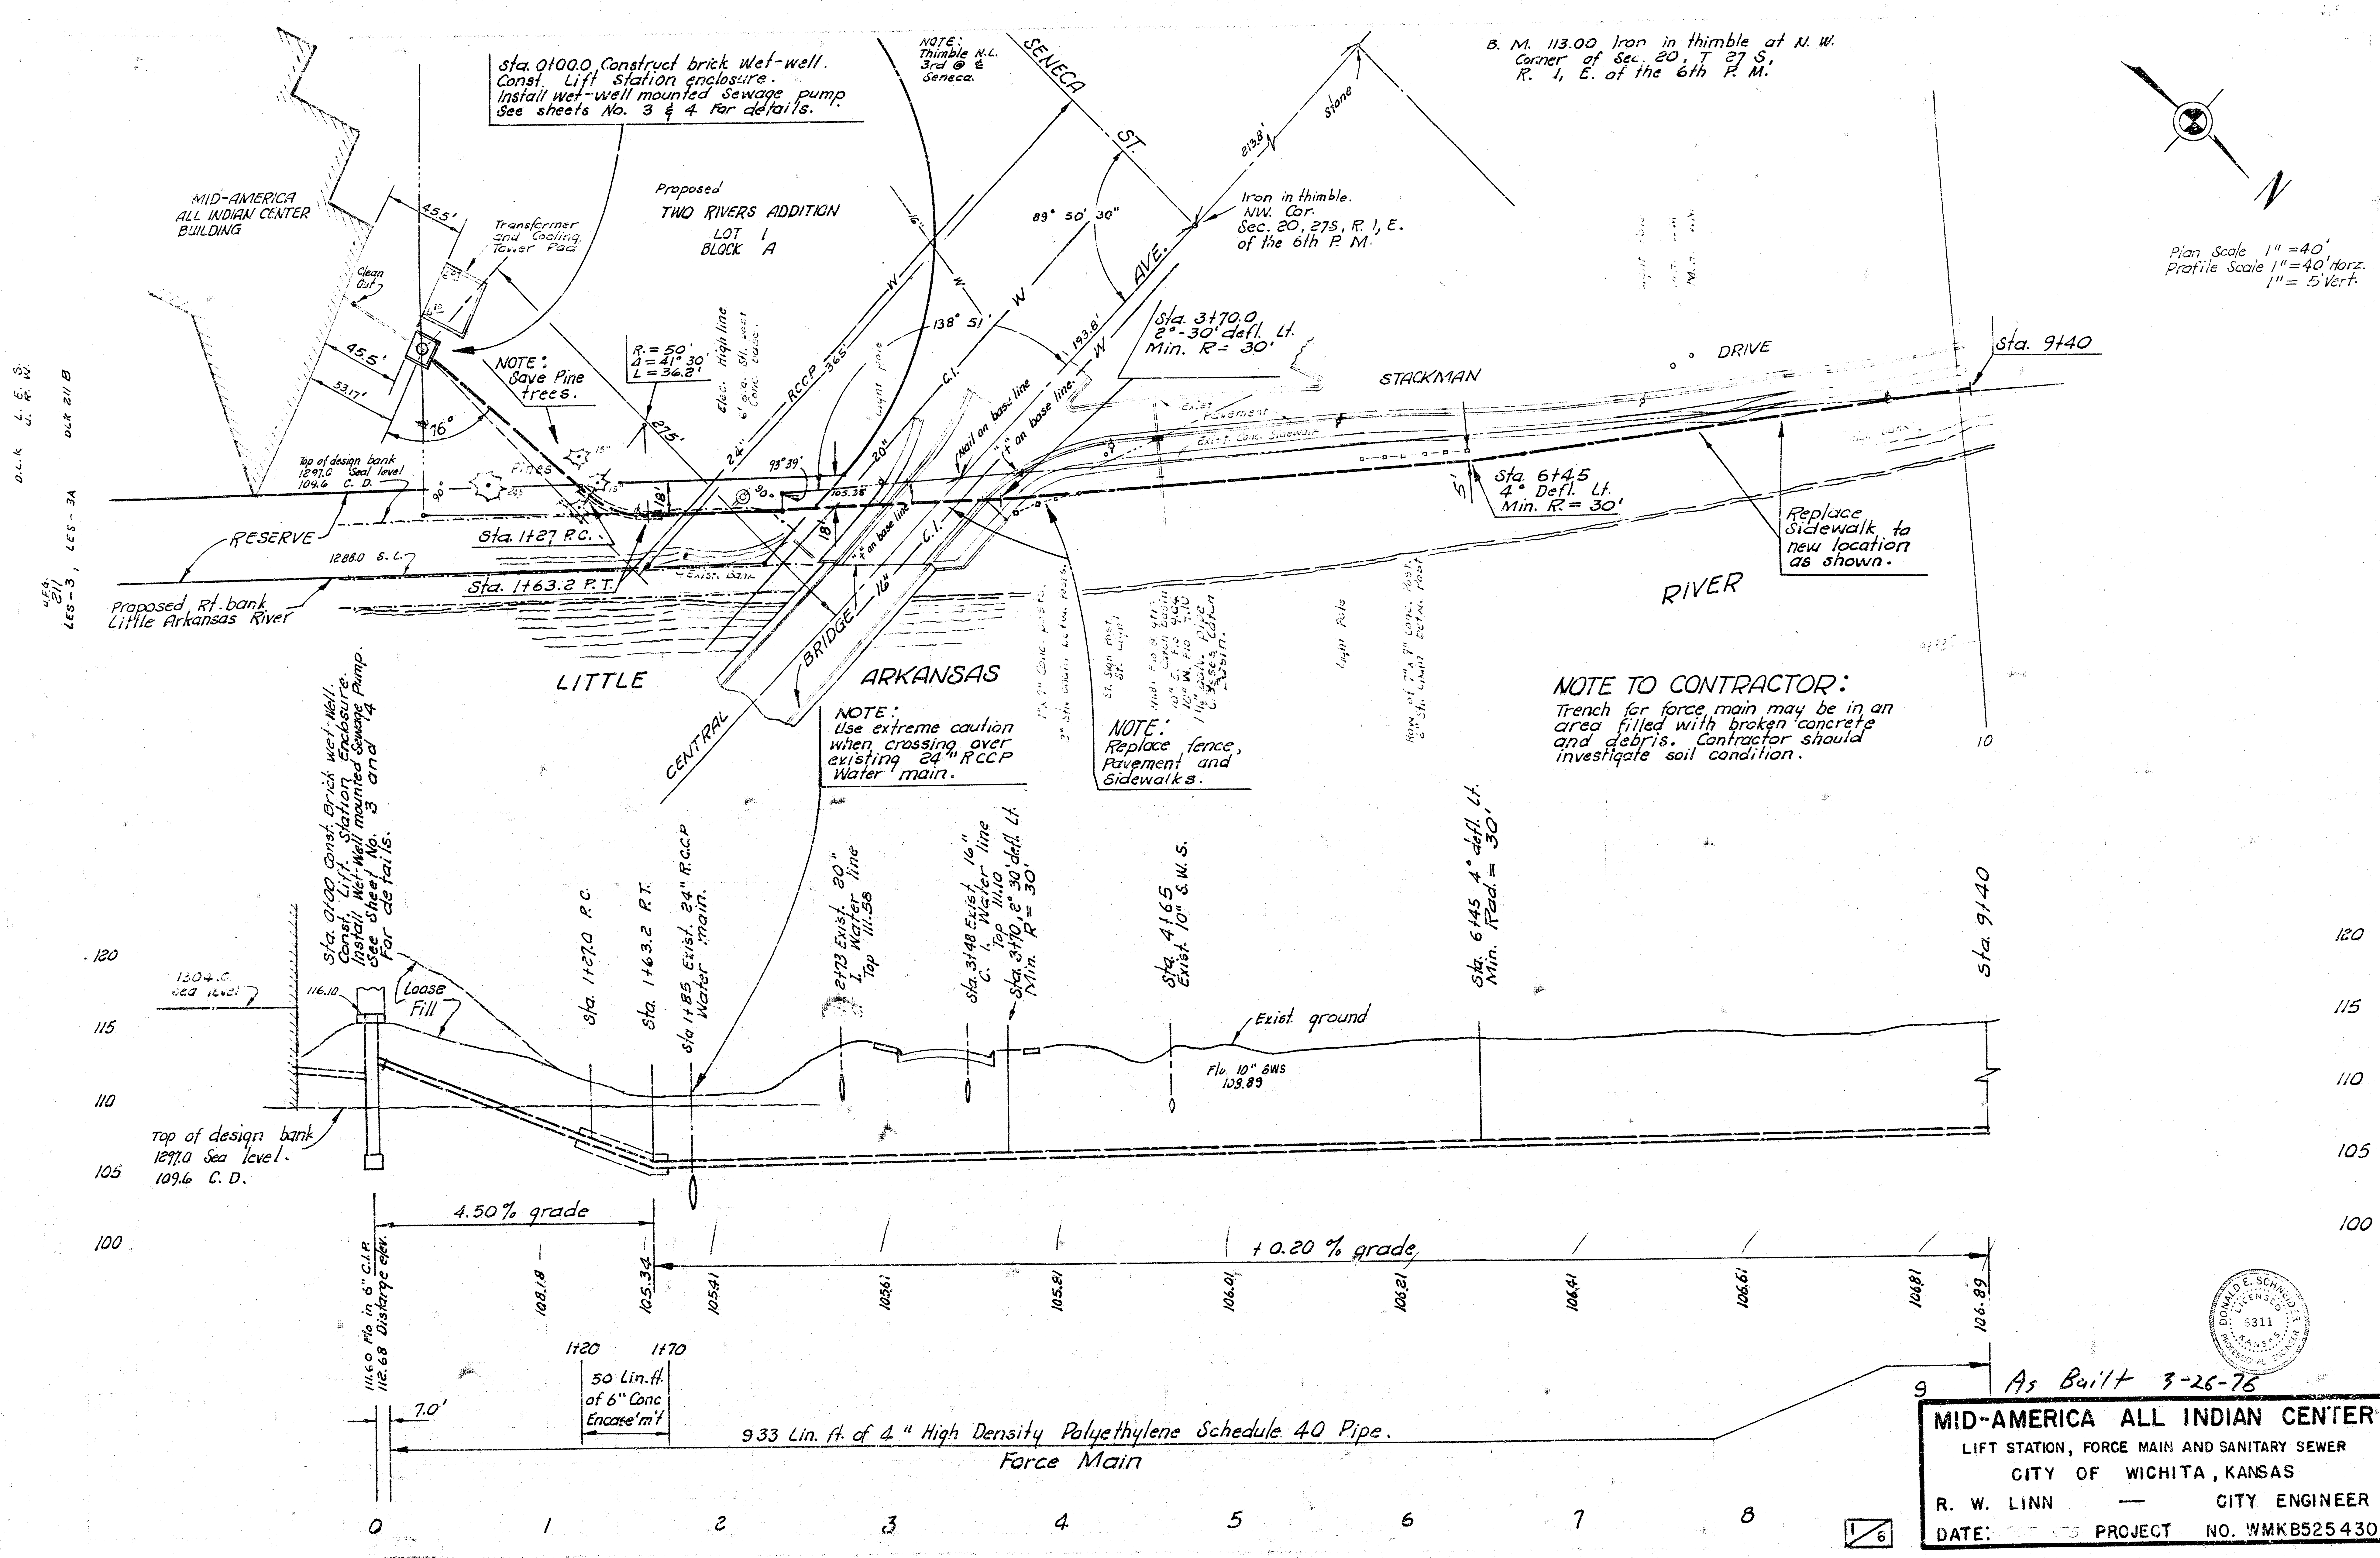


Plan Scale 1" = 40'
 Profile Scale 1" = 40' Horiz.
 1" = 5' Vert.

As Built 3-26-76


MID-AMERICA ALL INDIAN CENTER
 LIFT STATION, FORCE MAIN AND SANITARY SEWER
 CITY OF WICHITA, KANSAS
 R. W. LINN — CITY ENGINEER
 DATE: 3-26-76 PROJECT NO. WMKB525430


B. M. 114.78 "d" Top N. cb. Pine
 @ E. 4' walk N. on W. L.
 Stackman Dr.

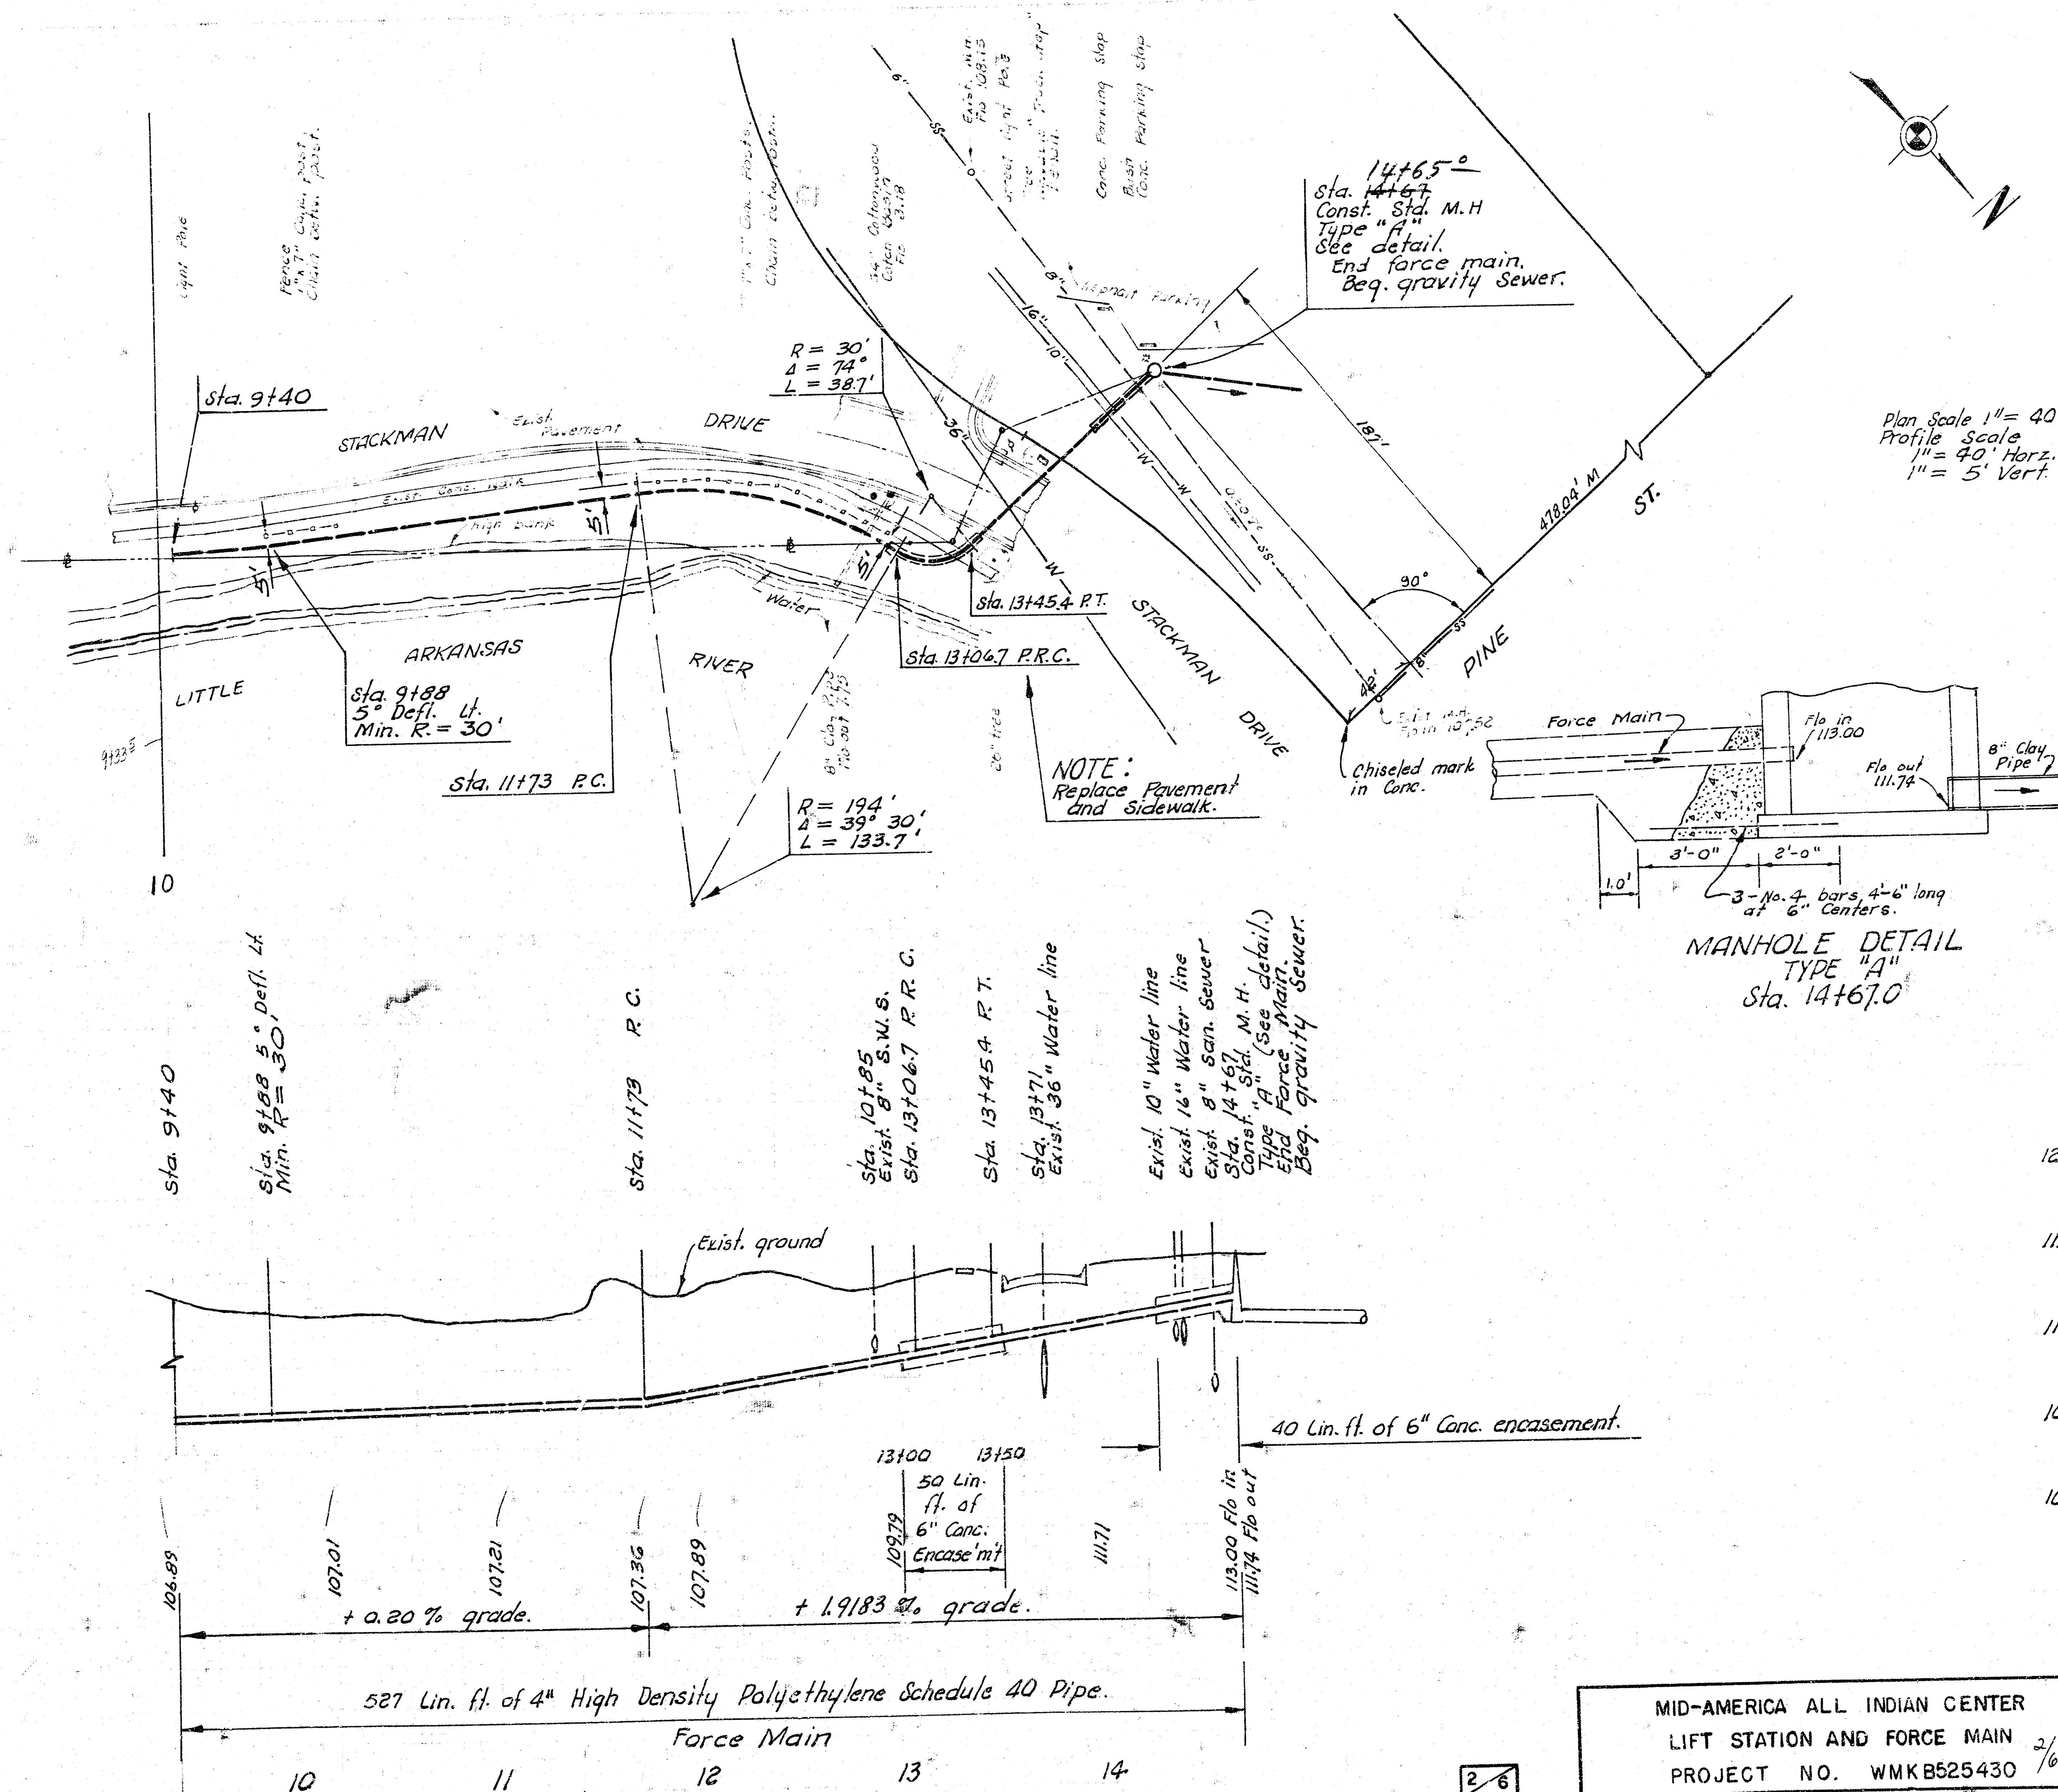

Plan Scale 1" = 40'
 Profile Scale 1" = 40' Horiz.
 1" = 5' Vert.

MID-AMERICA ALL INDIAN CENTER
 LIFT STATION AND FORCE MAIN
 PROJECT NO. WMKB525430 2/6

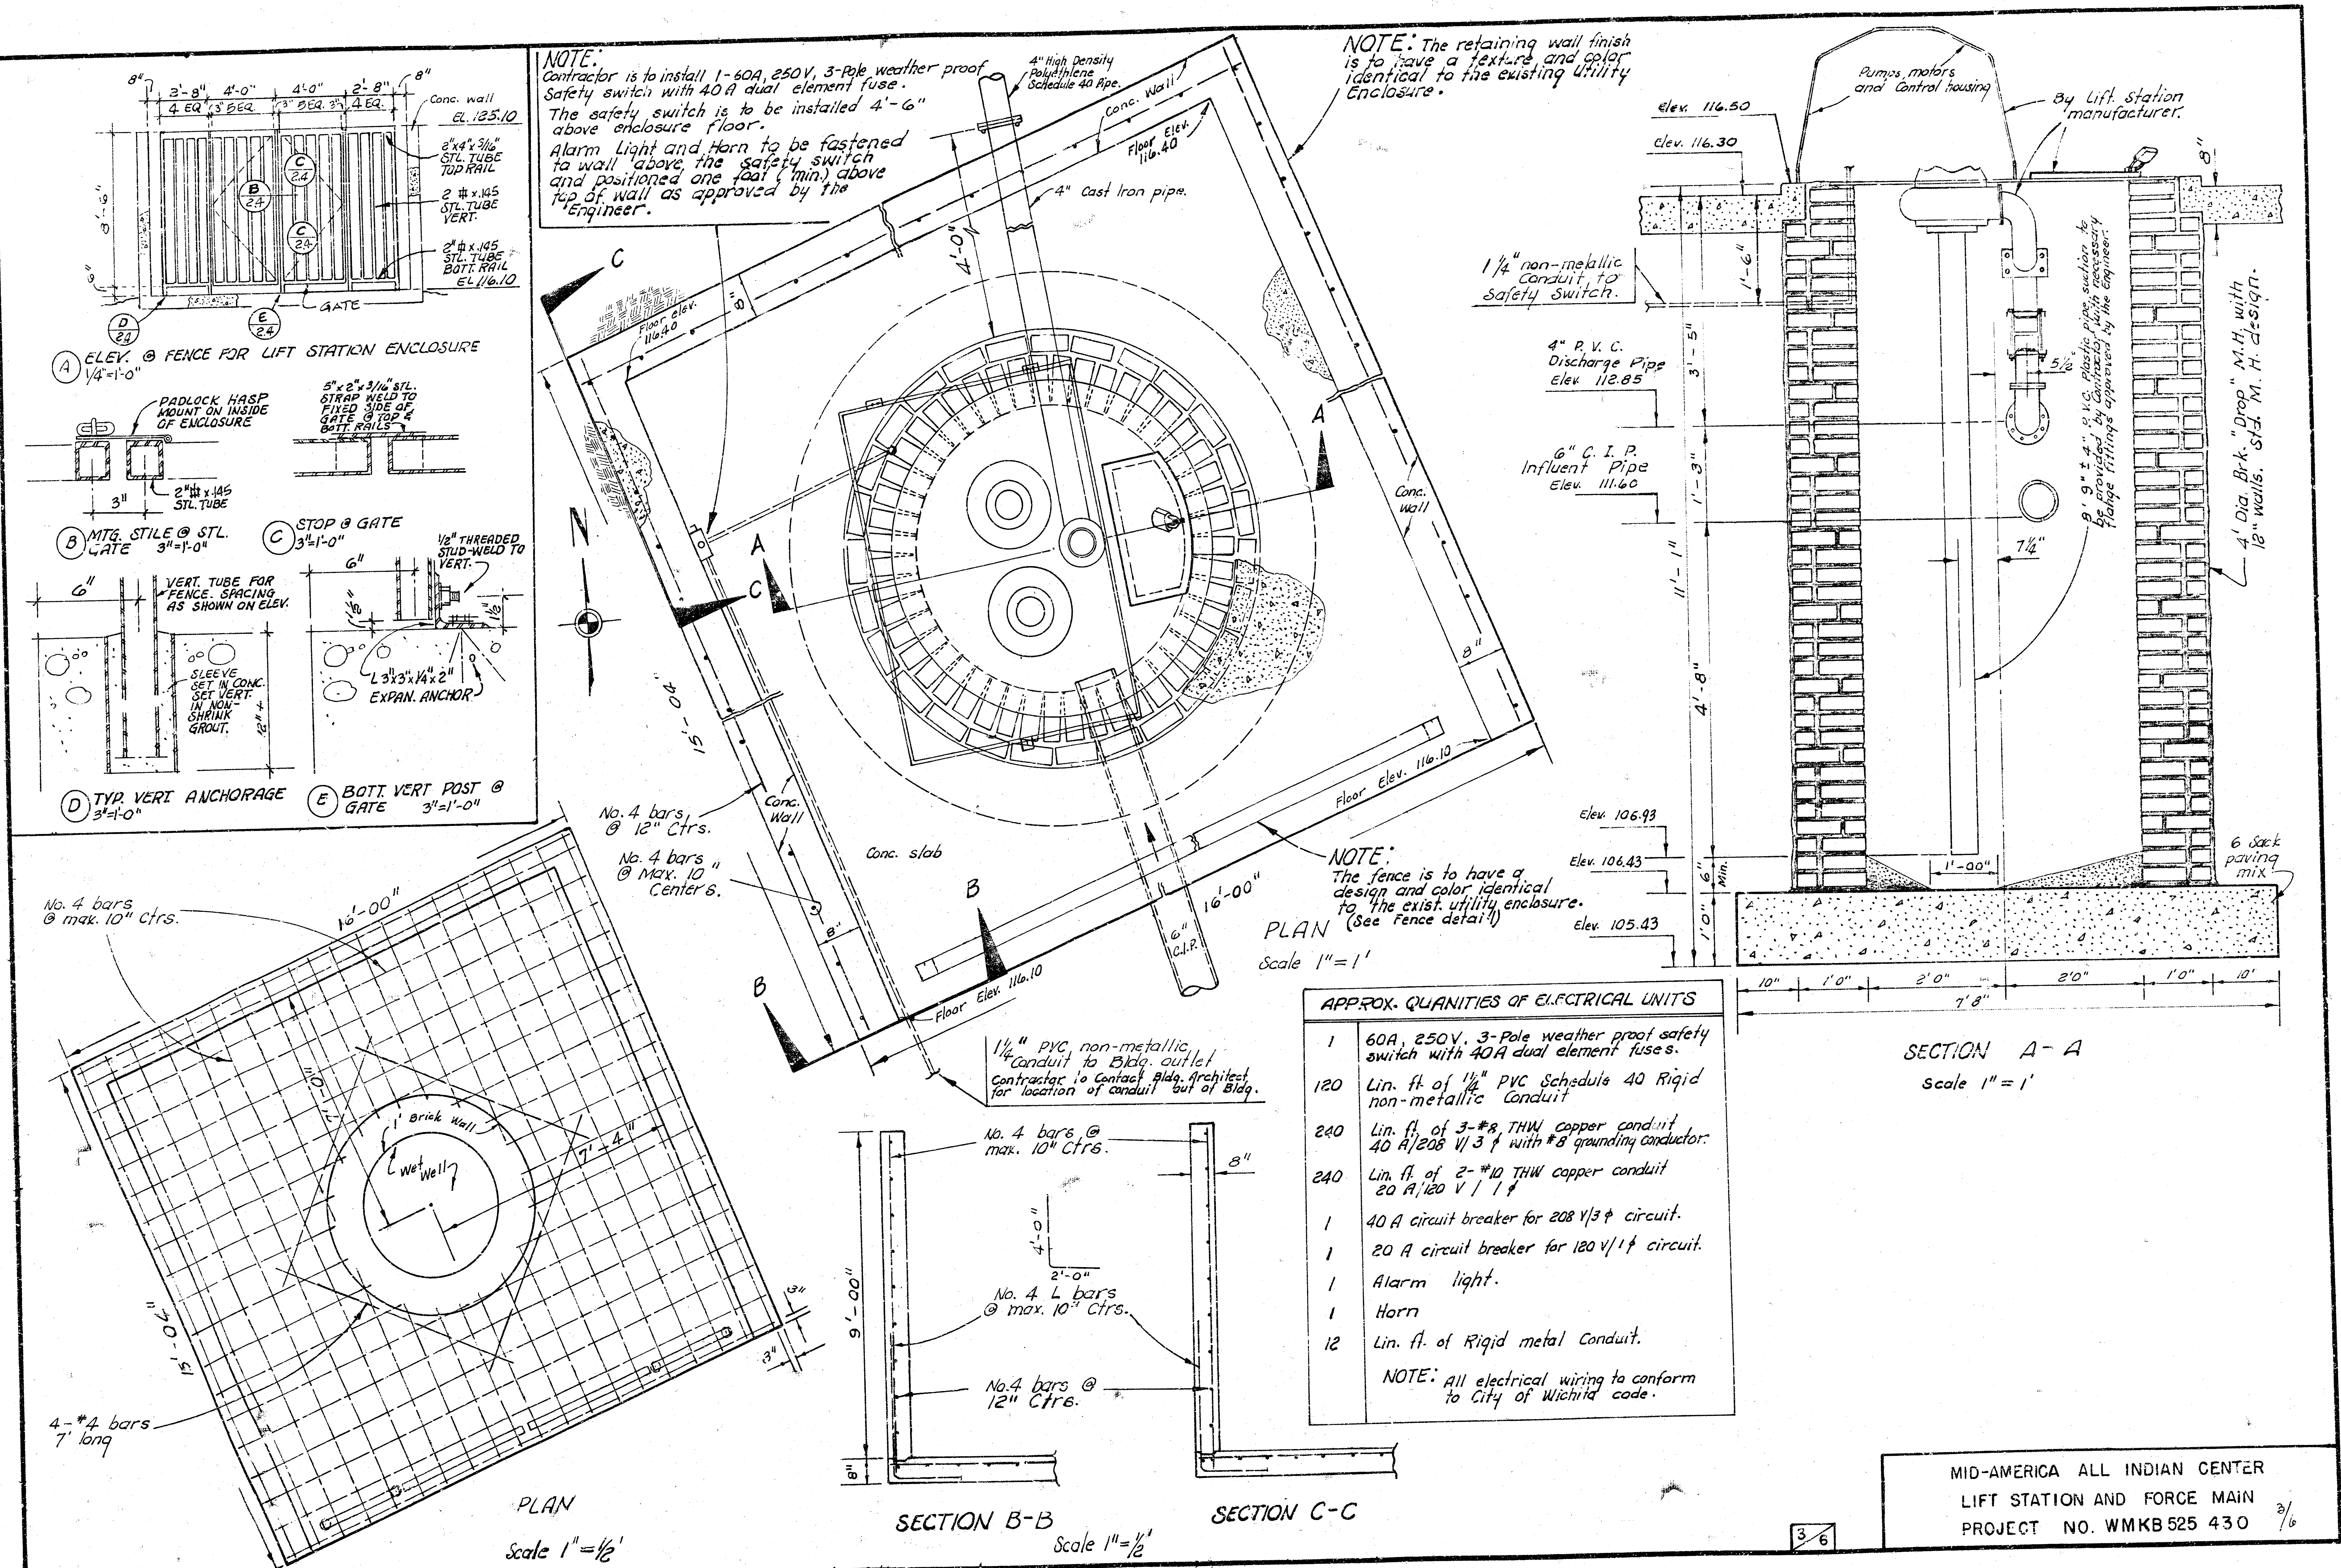

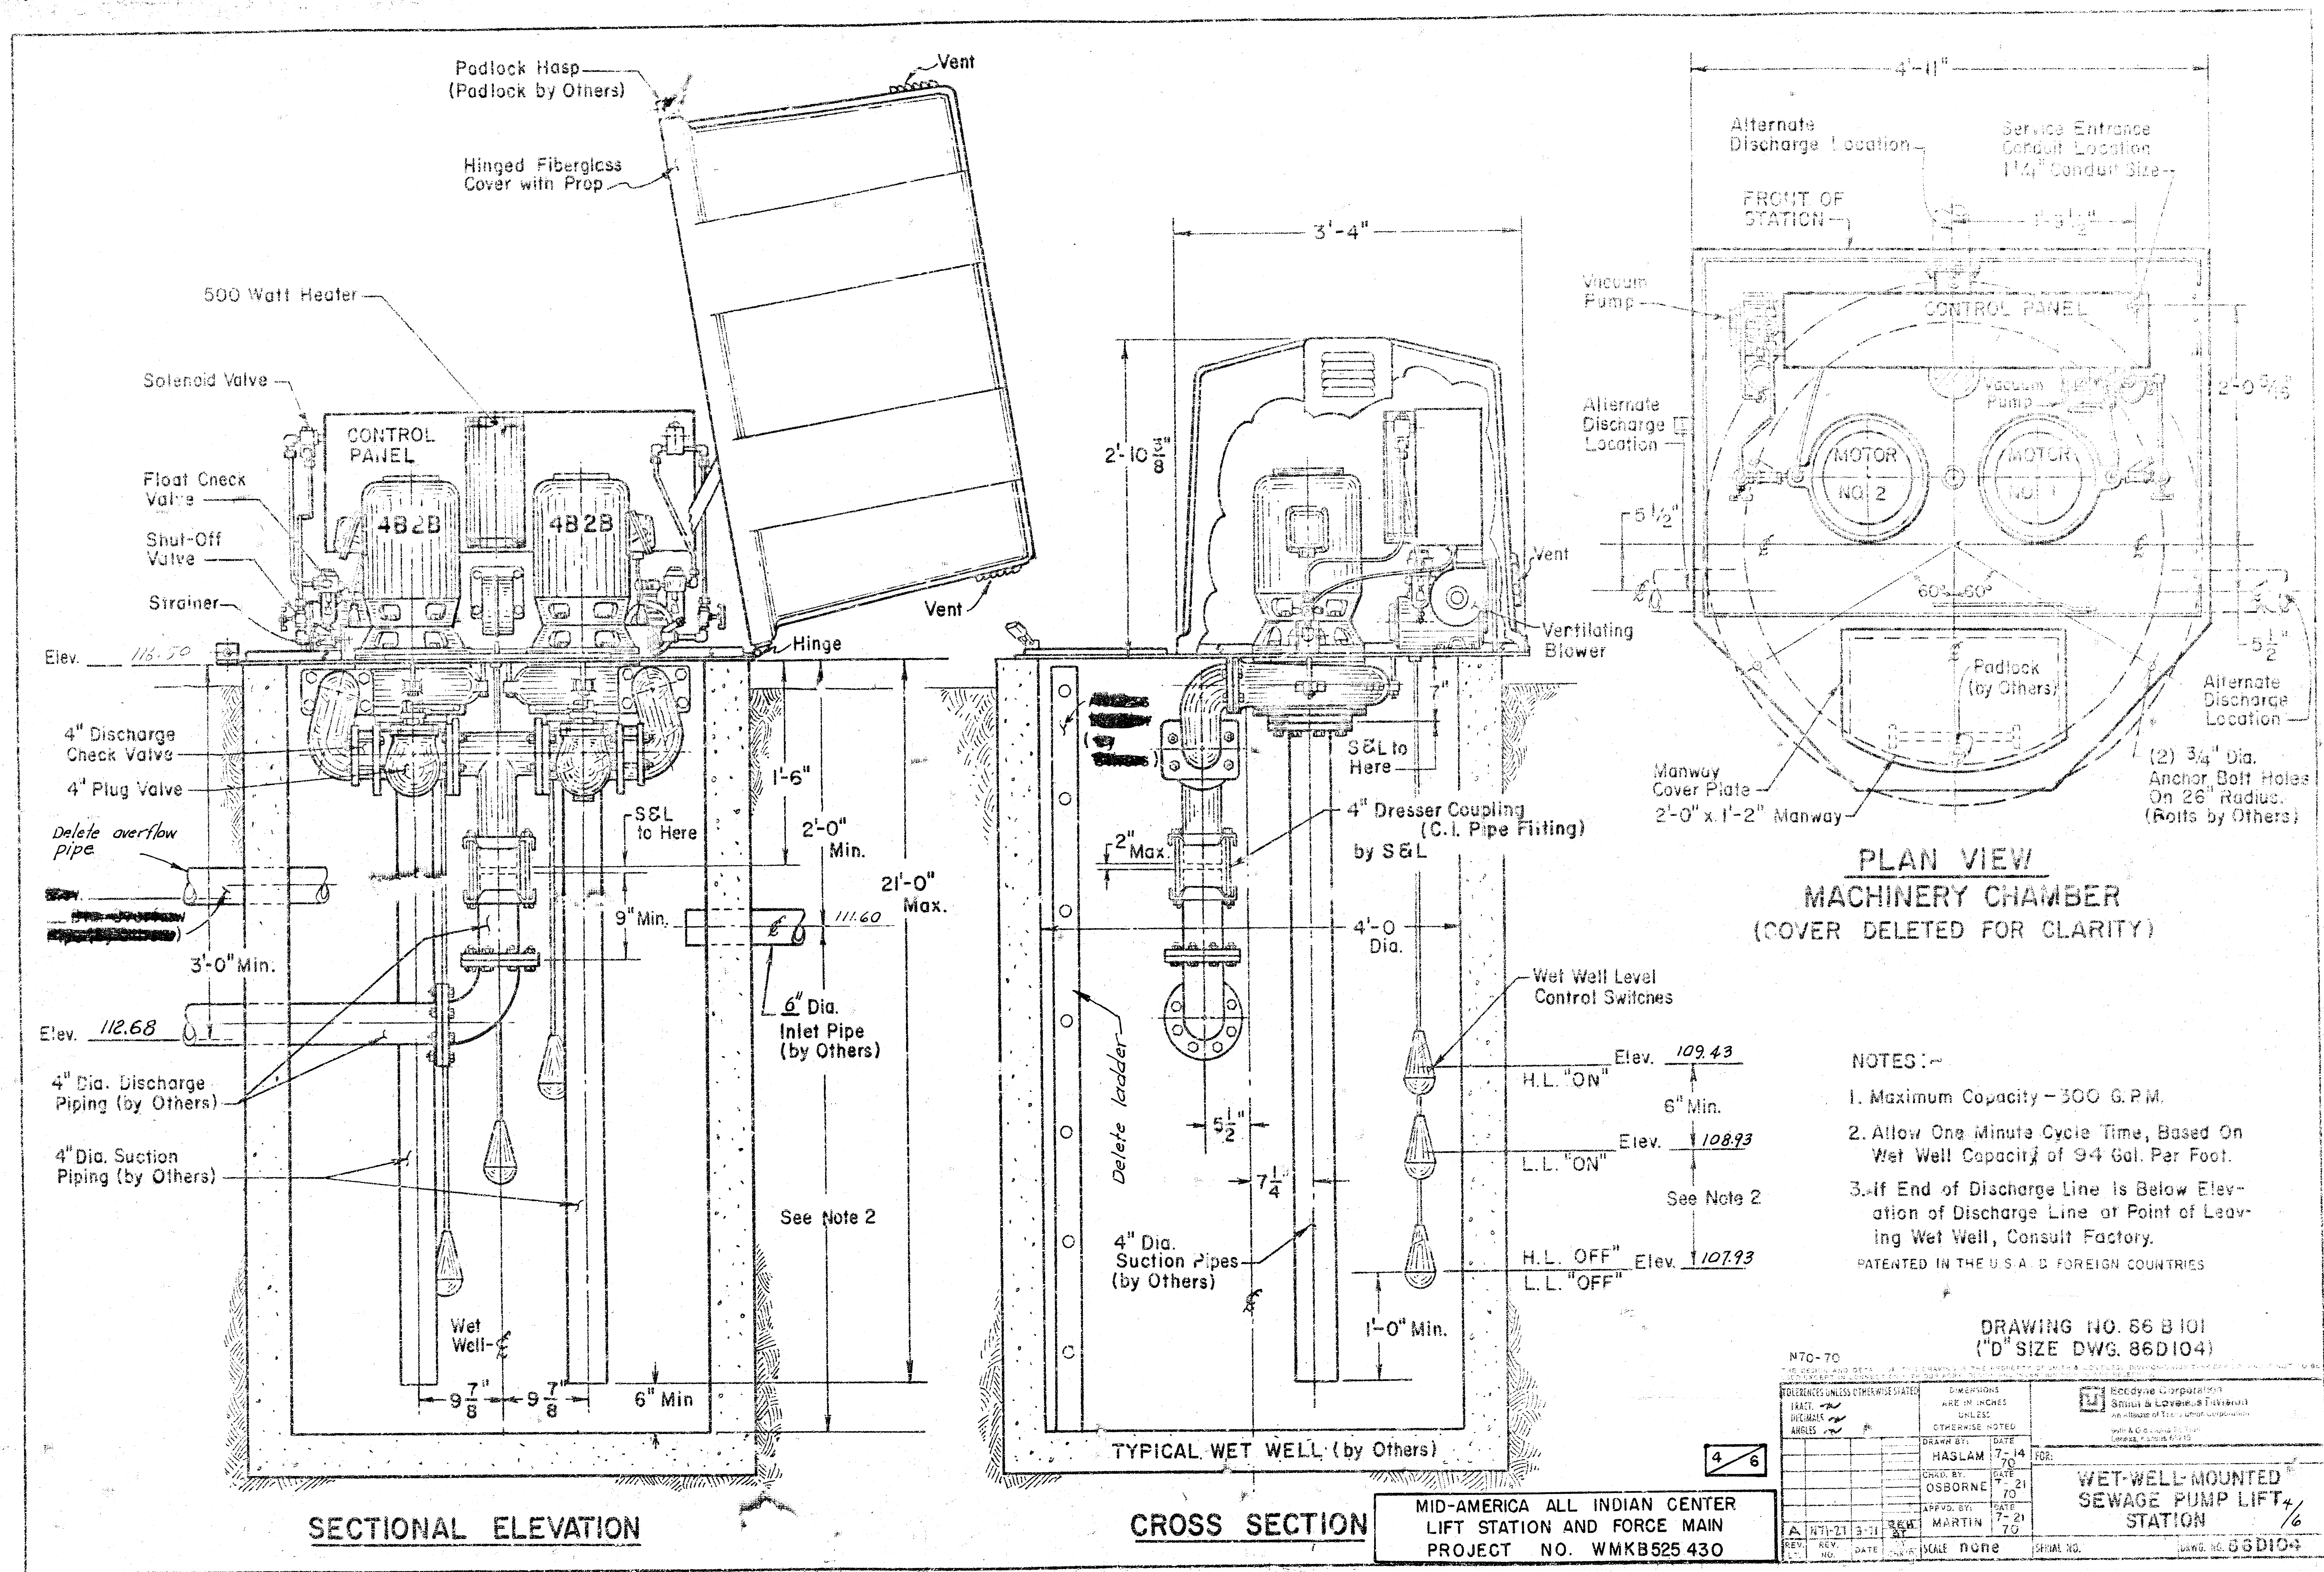

B.M. 113.00 Iron in thimble of N.W. corner of Sec. 20, T27S, R. 1, E. of the 6th P.M.

B.M. 114.78 "a" top N. curb Pine St. @ 4' walk N. on west line Stackman Drive.

NOTE:
Removal and Replacement of conc. Areas north of Right-of-way line on Pine St. shall be paid as conc. slab removed and Replaced.

Sta. 0+00.0 Existing manhole Beg. removal of exist. 6" S.S.
Remove exist. manhole. Const. new manhole Type "A" or "C"

CAUTION:
Sta. 0+94 Exist. K.G. & E. Underground conduit.

Remove exist. M.H. Plug 6" San. Sewer north & south. Extend exist. pipe west to new M.H. with same kind and size of pipe.
Extension of pipe west will not be paid for directly and this work shall be considered as subsidiary.

0+74.5
Sta. 0+74.0 Const. Sta. M.H. Type "A" or "C" Intercept San. Sewer from the east. Sta. 0+00.0 Line No. 2

NOTE:
Replace pavement and sidewalk.

Exist. 6" San. Sewer South to Art Museum building.

Plan Scale 1" = 20'
Profile Scale 1" = 20' Horiz.
1" = 5' Vert.

3+2.3
Sta. 3+20.0 = Sta. 14+67 in Force Main.
14+65

Sta. 3+20.0 = Sta. 14+67 in force main.

CAUTION:
K.G. & E. Underground conduit.

Basement floor Proposed Art Museum Elev. 103.60

MID-AMERICA ALI. INDIAN CENTER
SANITARY SEWER
PROJECT NO. WMKB 525 430 5/6

